



5060  
5050  
5040  
5030  
5020  
5010  
5000  
4990  
4980

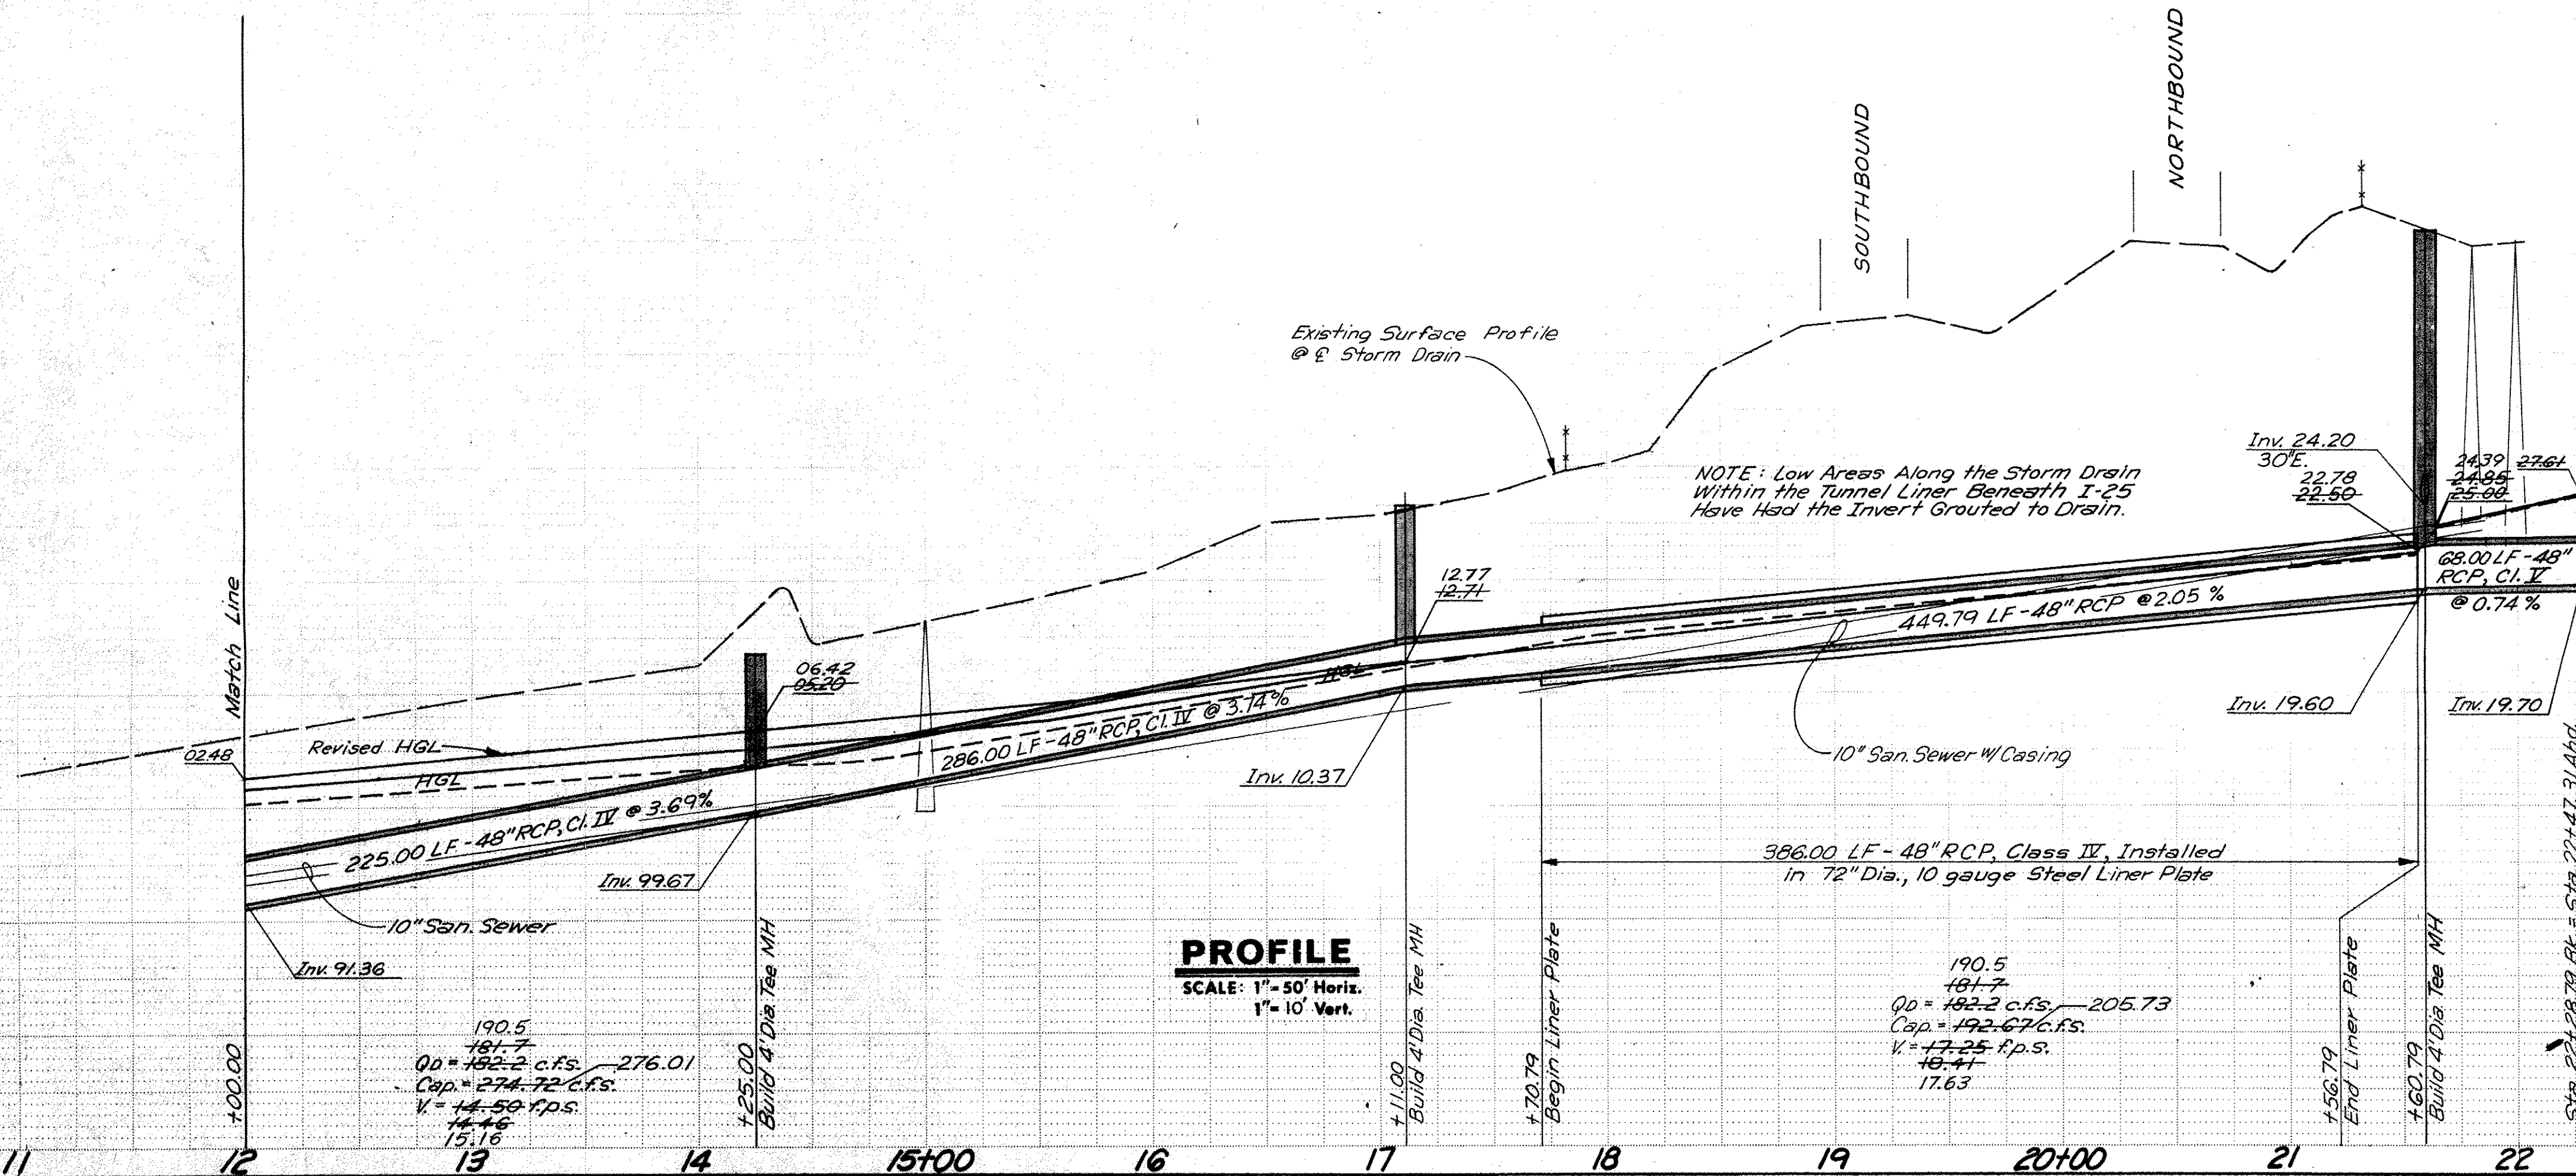


**PROFILE**  
SCALE: 1" = 50' Horiz.  
1" = 10' Vert.

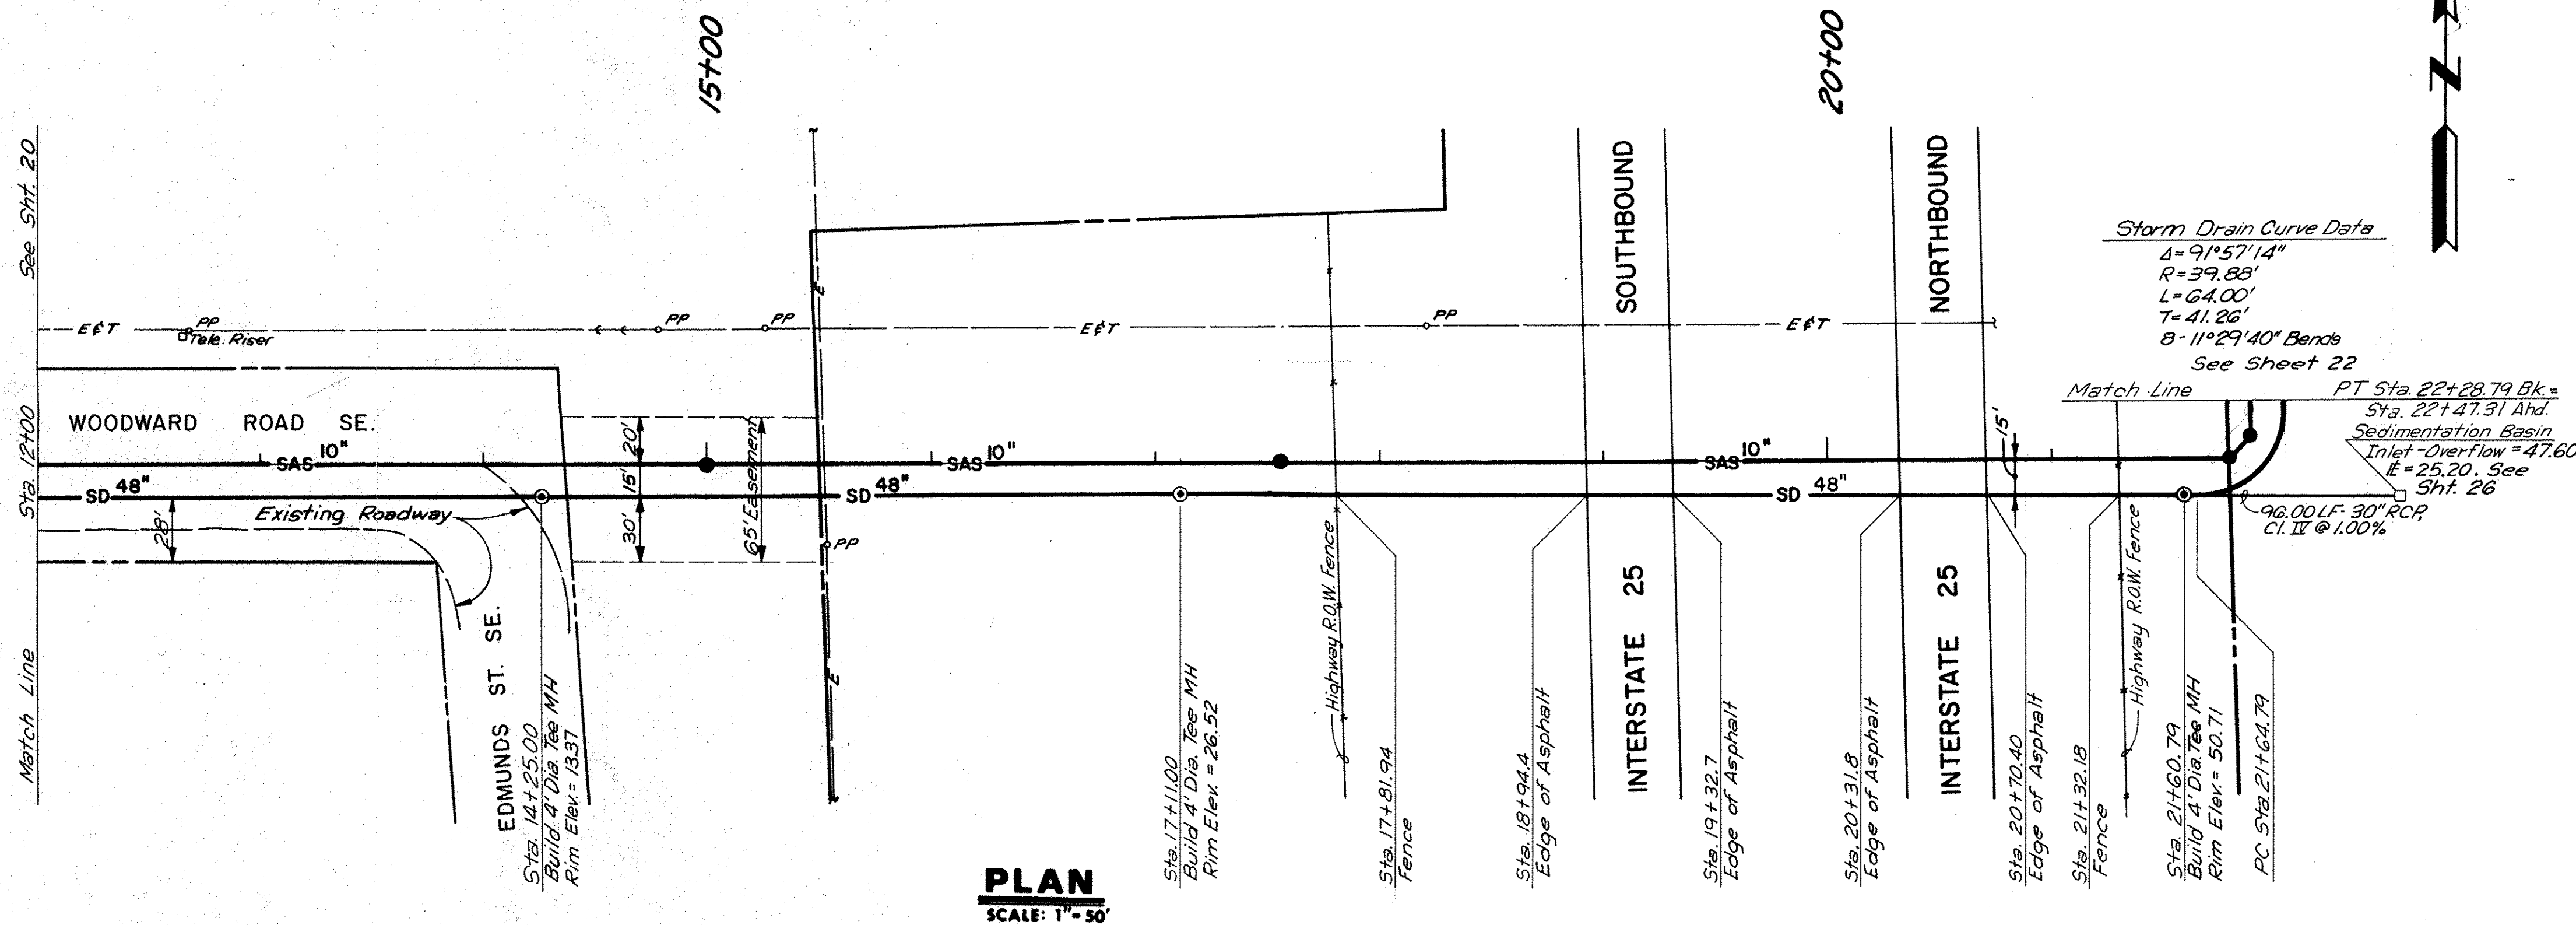

**PLAN**  
SCALE: 1" = 50'

*John D. Anderson*  
**RECORD DRAWING**  
2-8-89

| CITY OF ALBUQUERQUE<br>PUBLIC WORKS DEPARTMENT        |                         |              |                |
|-------------------------------------------------------|-------------------------|--------------|----------------|
| SUNPORT PARK<br>INFRASTRUCTURE IMPROVEMENTS - PHASE 1 |                         |              |                |
| STORM DRAIN PLAN & PROFILE<br>WOODWARD ROAD SE.       |                         |              |                |
| APPROVALS                                             | ENGINEER                | DATE         | APPROVALS      |
| D.R.C. Chair                                          | <i>John D. Anderson</i> | 1/15/89      | HYDROLOGY      |
| Trans. Dev.                                           | <i>N. J. P. H.</i>      | 5/22/87      | DESIGN         |
| Utility Dev.                                          | <i>Ed. J. H.</i>        | 5/22/87      | DATE           |
| DRAWING NO. 2950                                      |                         | MAP NO. M-15 | SHEET 21 OF 26 |
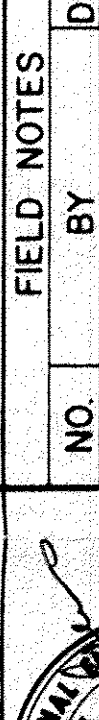
| ENGINEER'S SEAL                                                                      |  | SURVEY INFORMATION |    | BENCH MARKS                                                                                                                                                                                                                                                |  | AS BUILT INFORMATION                |                 |
|--------------------------------------------------------------------------------------|--|--------------------|----|------------------------------------------------------------------------------------------------------------------------------------------------------------------------------------------------------------------------------------------------------------|--|-------------------------------------|-----------------|
|  |  | FIELD NOTES        |    | STA. "1-25-31" ELEVATION 5002.528<br><br>STANDARD IMPRCS BRASS TABLET SET IN CONCRETE POST LOCATED AT THE NORTHEAST CORNER OF THE HIGHWAY 1-25 BRIDGE CROSSING OVER AN ABANDONED RAILROAD SPUR LINE APPROXIMATELY 1.15 MILES NORTH OF RIO BRAVO BOULEVARD. |  | CONTRACTOR <i>New Concepts Inc.</i> |                 |
|                                                                                      |  | NO.                | BY |                                                                                                                                                                                                                                                            |  | DATE                                | WORK STARTED BY |
|                                                                                      |  |                    |    |                                                                                                                                                                                                                                                            |  |                                     | INSPECTOR'S     |
|                                                                                      |  |                    |    |                                                                                                                                                                                                                                                            |  |                                     | FIELD           |
|                                                                                      |  |                    |    |                                                                                                                                                                                                                                                            |  |                                     | VERIFICATION BY |
|                                                                                      |  |                    |    |                                                                                                                                                                                                                                                            |  | DATE <i>1-89</i>                    |                 |
|                                                                                      |  |                    |    |                                                                                                                                                                                                                                                            |  | DATE                                |                 |
|                                                                                      |  |                    |    |                                                                                                                                                                                                                                                            |  | DATE                                |                 |
|                                                                                      |  |                    |    |                                                                                                                                                                                                                                                            |  | DATE</                              |                 |

| SURVEY INFORMATION |    | FIELD NOTES |    | DATE |      |
|--------------------|----|-------------|----|------|------|
| NO.                | BY | NO.         | BY | DATE | DATE |
|                    |    |             |    |      |      |
|                    |    |             |    |      |      |
|                    |    |             |    |      |      |

| BENCH MARKS |           | AS BUILT INFORMATION |      |
|-------------|-----------|----------------------|------|
| STA.        | ELEVATION | CONTRACTOR           | DATE |
|             |           |                      |      |
|             |           |                      |      |
|             |           |                      |      |