


SUNPORT PARK

INFRASTRUCTURE IMPROVEMENTS

PHASE I

DESCRIPTION	INDEX	SHEET No.
TITLE SHEET & INDEX.....	1	
SUBDIVISION PLAT.....	2	
SUBDIVISION PLAT.....	3	
SUBDIVISION PLAT.....	4	
SUBDIVISION PLAT.....	4A	
PAVING LAYOUT PLAN.....	5	
WATER & SANITARY SEWER.....	6	
PAVING PLAN & PROFILE.....		
TRANSPORT STREET SE.....	7	
TRANSPORT STREET SE - FLIGHTWAY AVENUE SE.....	8	
FLIGHTWAY AVENUE SE.....	9	
GEORGE ROAD SE.....	10	
GEORGE ROAD SE.....	11	
SANITARY SEWER PLAN & PROFILE.....		
WOODWARD ROAD SE.....	12	
WOODWARD ROAD SE.....	13	
OUTFALL.....	14	
WATER & SANITARY SEWER PLAN & PROFILE.....		
TRANSPORT STREET SE.....	15	
TRANSPORT STREET SE - FLIGHTWAY AVENUE SE.....	16	
FLIGHTWAY AVENUE SE.....	17	
GEORGE ROAD SE.....	18	
GEORGE ROAD SE.....	19	
STORM DRAIN PLAN & PROFILE.....		
WOODWARD ROAD SE.....	20	
WOODWARD ROAD SE.....	21	
OUTFALL.....	22	
TRANSPORT STREET SE.....	23	
TRANSPORT STREET SE - FLIGHTWAY AVENUE SE.....	24	
DRAINAGE EASEMENT PLAN & PROFILE.....	25	
STORM DRAIN DETAILS.....	26	

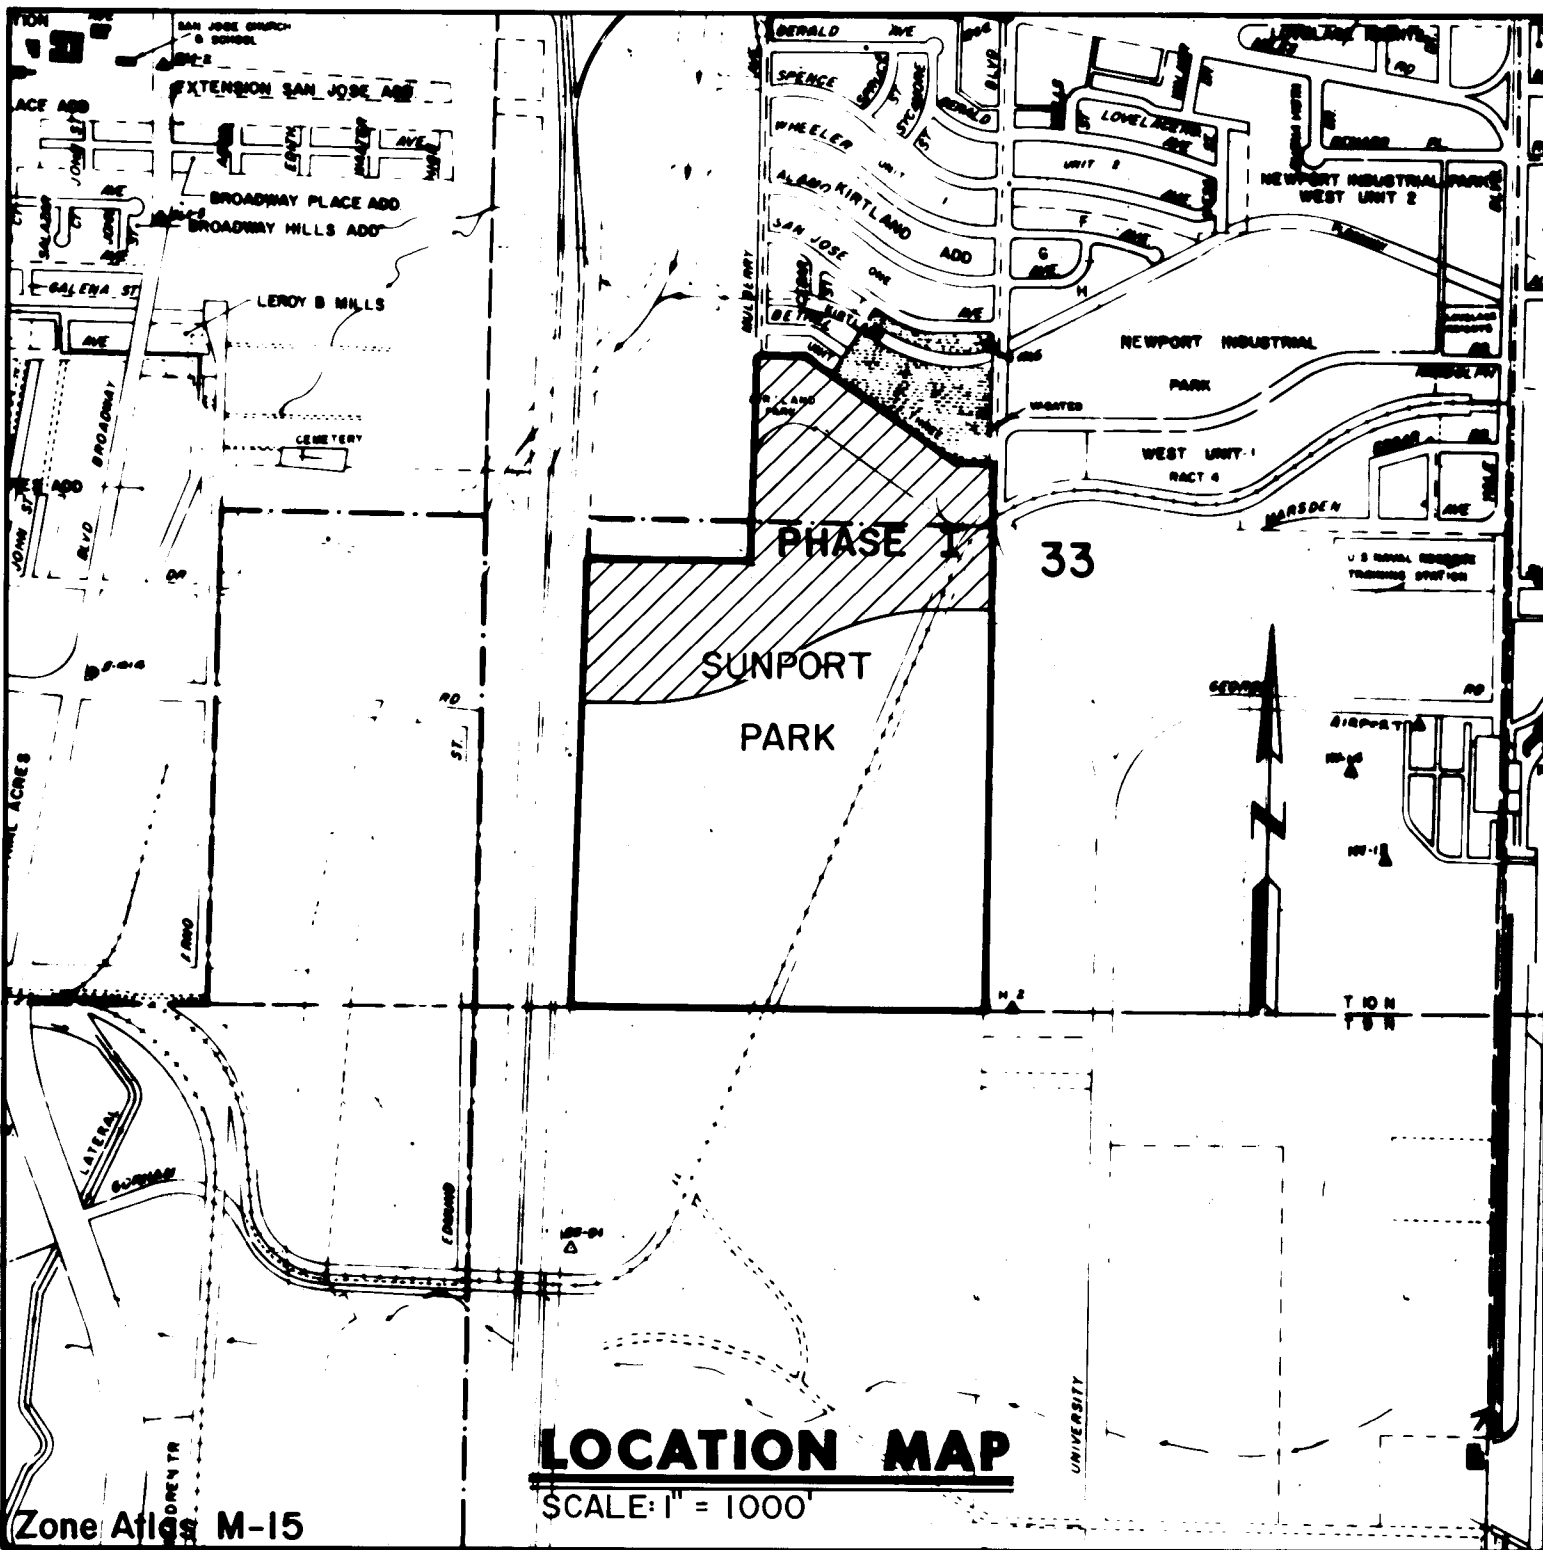

GENERAL NOTES:

1. ALL WORK DETAILED ON THESE PLANS TO BE PERFORMED UNDER THIS CONTRACT SHALL, EXCEPT AS OTHERWISE STATED OR PROVIDED FOR HEREON, BE CONSTRUCTED IN ACCORDANCE WITH CITY OF ALBUQUERQUE, STANDARD SPECIFICATIONS, PUBLIC WORKS CONSTRUCTION, 1986 EDITION.
2. REFERENCES MADE TO STANDARD DRAWINGS REFER TO CITY OF ALBUQUERQUE STANDARD DRAWINGS.
3. TWO WORKING DAYS PRIOR TO ANY EXCAVATION, CONTRACTOR MUST CONTACT LINE LOCATING SERVICE, 765-1234, FOR LOCATION OF EXISTING UTILITIES.
4. PRIOR TO CONSTRUCTION, THE CONTRACTOR SHALL EXCAVATE AND VERIFY THE HORIZONTAL AND VERTICAL LOCATIONS OF ALL OBSTRUCTIONS. SHOULD A CONFLICT EXIST, THE CONTRACTOR WILL NOTIFY THE ENGINEER OR SURVEYOR SO THAT THE CONFLICT CAN BE RESOLVED WITH A MINIMUM AMOUNT OF DELAY.
5. ALL UTILITIES AND UTILITY SERVICE LINES SHALL BE INSTALLED PRIOR TO PAVING.
6. BACKFILL COMPACTION SHALL BE ACCORDING TO SPECIFIED STREET USE.
7. TACK COAT REQUIREMENTS SHALL BE DETERMINED BY ENGINEER.
8. CONTRACTOR MUST SUBMIT A CONSTRUCTION SIGNING AND BARRACADING PLAN TO TRAFFIC ENGINEERING TO RECEIVE A BARRACADING PERMIT 48 HOURS PRIOR TO CONSTRUCTION.
9. CONTRACTOR SHALL PROVIDE 12" SUBGRADE PREPARATION UNDER ALL NEW PAVEMENT, CURBS & GUTTERS, VALLEY GUTTERS, AND CONCRETE FILLETS.
10. WHEN ABUTTING NEW PAVEMENT TO EXISTING, CUT BACK EXISTING PAVEMENT TO A NEAT STRAIGHT LINE AS REQUIRED TO REMOVE ANY BROKEN OR CRACKED PAVEMENT, AND PATCH NEW TO EXISTING. NO SEPARATE PAYMENT SHALL BE MADE FOR SUCH CUTTING OF EXISTING PAVEMENT BUT SHALL BE IN CONFORMANCE WITH THE SPECIFICATIONS.
11. CURB & GUTTER SHOWN AS EXISTING AND NOT TO BE REMOVED UNDER THE CONTRACT WHICH IS DAMAGED OR DISPLACED BY THE CONTRACTOR SHALL BE REMOVED AND REPLACED BY THE CONTRACTOR AT HIS EXPENSE.
12. MATCH FLOWLINES OF GUTTER WHEN CONNECTING NEW CURB & GUTTER TO EXISTING.
13. ALL WATER VALVE BOXES AND SEWER MANHOLES IN THE CONSTRUCTION AREA ARE TO BE ADJUSTED TO FINISH GRADE UNDER THE CONTRACT. SEE STD. DWG. P-24.
14. ALL PERMANENT PAVEMENT MARKING AND TRAFFIC SIGNING WILL BE PERFORMED BY THE CITY OF ALBUQUERQUE, TRAFFIC ENGINEERING DEPARTMENT.

SUNPORT JOINT VENTURE

ALBUQUERQUE, NEW MEXICO

John A. Andrews
RECORD DRAWING
2-8-89

APPROVAL OF AS BUILT DRAWINGS
CHIEF CONSTRUCTION ENGINEER
Robert B. Smith
DATE 2-17-89


1 2 3 4 5 6 7 8 9 10 11 12
26 29500189

REV SHEETS	CITY ENGR.	DATE	USER DEPT.	DATE	USER DEPT.	DATE
APPROVAL OF REVISIONS						

	ANDREWS, ASBURY & ROBERT, INC. CONSULTING ENGINEERS ALBUQUERQUE NEW MEXICO	APPROVED FOR CONSTRUCTION <i>Robert B. Smith</i> CITY ENGINEER DATE 12/10/87
	2950	SHEET 1 OF 26

SET NUMBER

ENGR'S FILE No. 85-415D

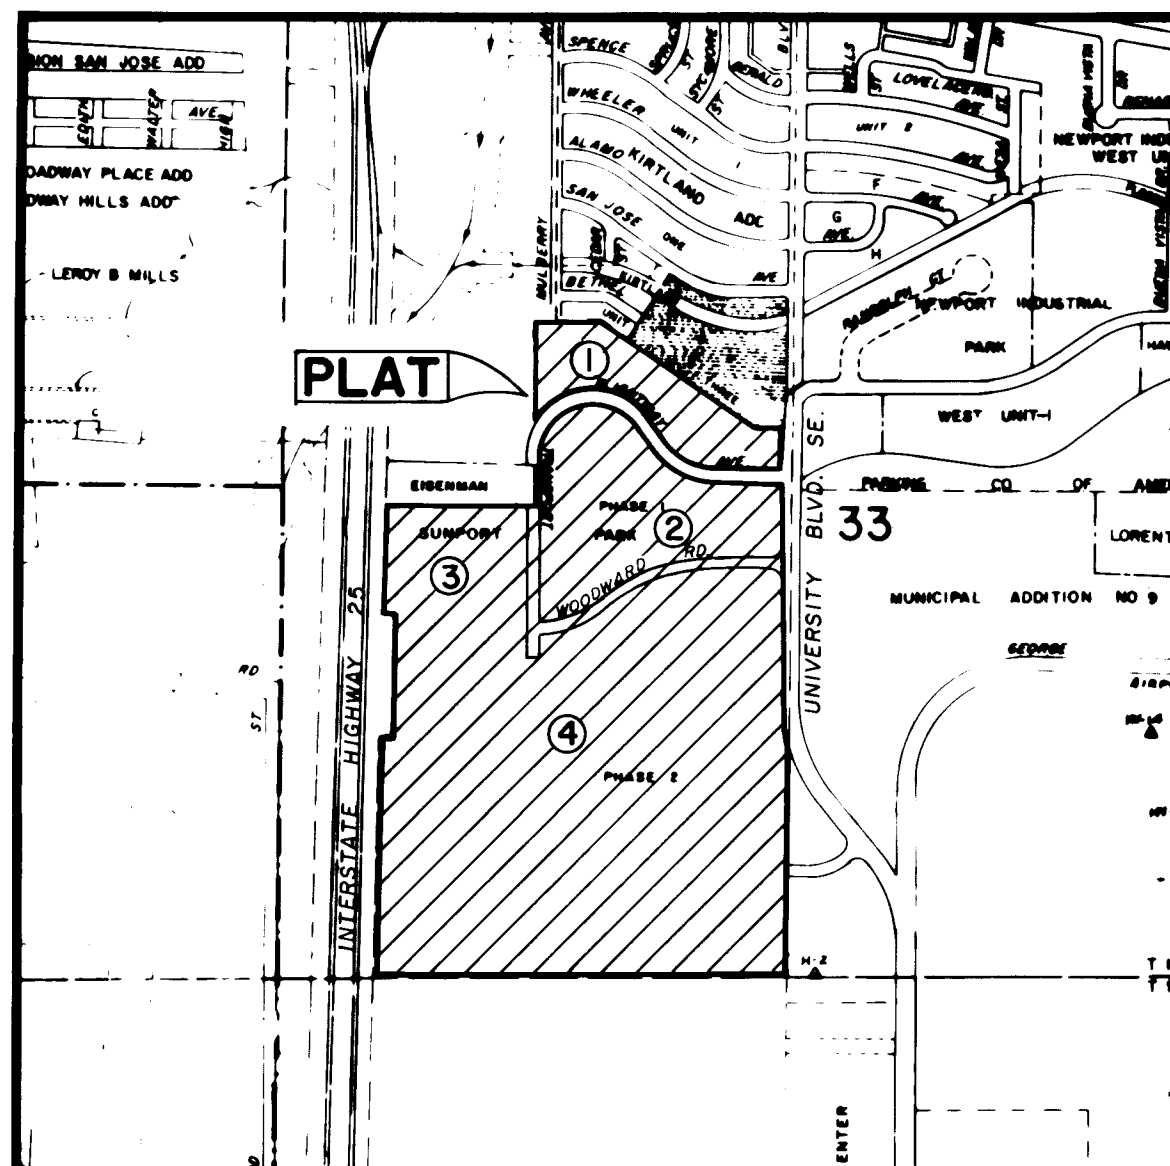

LOCATION MAP
ZONE ATLAS MAP M-15
SCALE: 1" = 1000'

SUBDIVISION DATA

- CASE NO. V-88-22, DRB-88-63
- TOTAL NUMBER OF LOTS CREATED: 9
- TOTAL MILEAGE OF FULL-WIDTH STREETS CREATED: 0.40
- TOTAL MILEAGE OF HALF-WIDTH STREETS CREATED: 0
- DATE OF SURVEY: MAY, 1987
- NET AREA OF VACATED RIGHT-OF-WAY: 216,115 SQ. FT.

NOTICE OF SUBDIVISION PLAT CONDITIONS

PURSUANT TO SECTION 7 OF THE CITY OF ALBUQUERQUE SUBDIVISION ORDINANCE, A VARIANCE OR WAIVER FROM CERTAIN SUBDIVISION REQUIREMENTS HAS BEEN GRANTED BY THE CITY AND THE ALBUQUERQUE METROPOLITAN ARROYO FLOOD CONTROL AUTHORITY IN CONNECTION WITH THIS PLAT.

FUTURE SUBDIVISION OF LANDS WITHIN THIS PLAT, ZONING SITE DEVELOPMENT PLAN APPROVALS, AND DEVELOPMENT PERMITS MAY BE CONDITIONED UPON DEDICATION OF RIGHTS-OF-WAY AND EASEMENTS, AND/OR SEWER, STREETS, DRAINAGE, GRADING AND PARKS IN ACCORDANCE WITH CURRENT RESOLUTIONS, ORDINANCES AND POLICIES IN EFFECT AT THE TIME FOR ANY SPECIFIC PROPOSAL.

THE CITY (AND AMFCA WITH REFERENCE TO DRAINAGE) MAY REQUIRE AND/OR PERMIT EASEMENTS TO BE ADDED, MODIFIED OR REMOVED WHEN FUTURE PLATS AND/OR SITE DEVELOPMENT PLANS ARE APPROVED.

BY ITS APPROVAL OF THIS SUBDIVISION THE CITY MAKES NO REPRESENTATION OR WARRANTIES AS TO AVAILABILITY OF UTILITIES, OR FINAL APPROVAL OF ALL REQUIREMENTS INCLUDING (BUT NOT LIMITED TO) THE FOLLOWING ITEMS: IMPROVEMENTS; PARK AND OPEN SPACE REQUIREMENTS; DRAINAGE REQUIREMENTS AND/OR IMPROVEMENTS; AND EXCAVATION, FILLING OR GRADING REQUIREMENTS. ANY PERSON INTENDING DEVELOPMENT OF LANDS WITHIN THIS SUBDIVISION IS CAUTIONED TO INVESTIGATE THE STATUS OF THESE ITEMS.

A SEPARATE NOTICE OF THESE CONDITIONS IS RECORDED WITH THE COUNTY CLERK ON Ms 202 A, PAGE 688-689, 1987 IN BOOK

DESCRIPTION

A CERTAIN TRACT OF LAND SITUATE WITHIN THE WEST ONE-HALF (W $\frac{1}{2}$) OF SECTION 33, TOWNSHIP 10 NORTH, RANGE 3 EAST, N.M.P.M., BERNALILLO COUNTY, NEW MEXICO, BEING AND COMPRISING ALL OF BLOCK ONE (1) OF SUNPORT PARK AS THE SAME IS SHOWN AND DESIGNATED ON THE SUBDIVISION PLAT THEREOF FILED IN THE OFFICE OF THE COUNTY CLERK OF BERNALILLO COUNTY, NEW MEXICO ON JULY 22, 1986 IN VOLUME C31, FOLIO 15; AND BEING MORE PARTICULARLY DESCRIBED AS FOLLOWS:

BEGINNING AT THE SOUTHWEST CORNER OF SAID BLOCK 1, SUNPORT PARK FROM WHENCE THE N.M.S.H.C. BRASS CAP MONUMENT "1-25-31" BEARS S 10°25'37" W, 4,179.48 FEET DISTANT; THENCE, FROM SAID POINT OF BEGINNING,
N 00°07'31" E, 638.01 FEET DISTANCE TO THE NORTHWEST CORNER OF SAID BLOCK 1; THENCE,
S 89°52'29" E, 221.03 FEET DISTANCE TO A POINT; THENCE,
S 58°32'29" E, 1,067.82 FEET DISTANCE TO A POINT; THENCE,
S 89°52'29" E, 144.14 FEET DISTANCE TO THE NORTHEAST CORNER OF SAID BLOCK 1; THENCE,
S 00°08'03" E, 265.51 FEET DISTANCE TO A POINT OF CURVATURE; THENCE,
SOUTHWESTERLY, 47.92 FEET DISTANCE ALONG THE ARC OF A CURVE BEARING TO THE RIGHT HAVING A RADIUS OF 30.00 FEET AND A CENTRAL ANGLE OF 90°30'45" TO A POINT OF TANGENCY; THENCE,
N 88°37'18" W, 310.34 FEET DISTANCE TO A POINT OF CURVATURE; THENCE,
NORTHWESTERLY, 342.26 FEET DISTANCE ALONG THE ARC OF A CURVE BEARING TO THE RIGHT HAVING A RADIUS OF 370.00 FEET AND A CENTRAL ANGLE OF 53°00'00" TO A POINT OF TANGENCY; THENCE,
N 35°37'18" W, 132.67 FEET DISTANCE TO A POINT OF CURVATURE; THENCE,
SOUTHWESTERLY, 689.04 FEET DISTANCE ALONG THE ARC OF A CURVE BEARING TO THE LEFT HAVING A RADIUS OF 330.00 FEET AND A CHORD WHICH BEARS S 84°33'43" W, 570.52 FEET TO A POINT ON CURVE AND THE SOUTHWEST CORNER AND POINT OF BEGINNING OF THE TRACT HEREIN DESCRIBED, CONTAINING 11.8720 ACRES, MORE OR LESS.

AND,

A CERTAIN TRACT OF LAND SITUATE WITHIN SECTION 33, TOWNSHIP 10 NORTH, RANGE 3 EAST, N.M.P.M., BERNALILLO COUNTY, NEW MEXICO BEING AND COMPRISING ALL OF BLOCKS NUMBERED TWO (2), THREE (3), AND FOUR (4) TOGETHER WITH THE VACATED PORTIONS OF WOODWARD ROAD AND TRANSPORT STREET OF SUNPORT PARK AS THE SAME ARE SHOWN AND DESIGNATED ON THE SUBDIVISION PLAT THEREOF FILED IN THE OFFICE OF THE COUNTY CLERK OF BERNALILLO COUNTY, NEW MEXICO ON JULY 22, 1986 IN VOLUME C31, PAGE 15; AND BEING MORE PARTICULARLY DESCRIBED AS FOLLOWS:

BEGINNING AT THE SOUTHWEST CORNER OF SAID BLOCK 4, SUNPORT PARK, FROM WHENCE THE SOUTHWEST CORNER OF SAID SECTION 33, BEARS N 89°39'34" W, 611.81 FEET DISTANCE AND THE N.M.S.H.C. MONUMENT "1-25-31" BEARS S 03°37'51" W, 1,318.77 FEET DISTANCE; THENCE FROM SAID POINT OF BEGINNING,
N 01°03'08" E, 1,199.38 FEET DISTANCE TO A POINT; THENCE,
S 89°38'22" E, 52.62 FEET DISTANCE TO A POINT; THENCE,
N 00°22'59" E, 629.03 FEET DISTANCE TO A POINT; THENCE,
N 88°56'52" W, 45.27 FEET DISTANCE TO A POINT; THENCE,
N 01°03'08" E, 565.49 FEET DISTANCE TO THE NORTHWEST CORNER OF SAID BLOCK 3; THENCE,
S 89°28'29" E, 628.06 FEET DISTANCE TO A POINT; THENCE,
S 89°52'29" E, 30.00 FEET DISTANCE TO A POINT ON THE WESTERLY LINE OF SAID BLOCK 2; THENCE,
N 00°07'31" E, 268.52 FEET DISTANCE TO A POINT OF CURVATURE; THENCE,
NORTHEASTERLY, 679.78 FEET DISTANCE ALONG THE ARC OF A CURVE BEARING TO THE RIGHT HAVING A RADIUS OF 270.00 FEET AND A CENTRAL ANGLE OF 144°15'11" TO A POINT OF TANGENCY; THENCE,
S 35°37'18" E, 132.67 FEET DISTANCE TO A POINT OF CURVATURE; THENCE,
SOUTHEASTERLY, 397.76 FEET DISTANCE ALONG THE ARC OF A CURVE BEARING TO THE LEFT HAVING A RADIUS OF 430.00 FEET AND A CENTRAL ANGLE OF 53°00'00" TO A POINT OF TANGENCY; THENCE,
S 88°37'18" E, 313.72 FEET DISTANCE TO A POINT OF CURVATURE; THENCE,
SOUTHEASTERLY, 46.25 FEET DISTANCE ALONG THE ARC OF A CURVE BEARING TO THE RIGHT HAVING A RADIUS OF 30.00 FEET AND A CENTRAL ANGLE OF 88°19'54" TO A POINT OF TANGENCY ON THE WEST LINE OF UNIVERSITY BOULEVARD; THENCE,
S 00°17'24" E, 1,080.96 FEET DISTANCE ALONG THE SAID WEST LINE OF UNIVERSITY BLVD. TO A POINT OF CURVATURE; THENCE,
SOUTHEASTERLY, 270.41 FEET DISTANCE ALONG THE ARC OF A CURVE BEARING TO THE LEFT HAVING A RADIUS OF 843.00 FEET AND A CENTRAL ANGLE OF 18°22'44" TO A NON-TANGENT POINT ON CURVE; THENCE,
LEAVING THE SAID WEST LINE OF UNIVERSITY BLVD.
S 00°17'24" E, 1,154.10 FEET DISTANCE TO THE SOUTHEAST CORNER OF SAID BLOCK 4, SUNPORT PARK; THENCE,
N 89°39'45" W, 2,007.14 FEET DISTANCE TO THE SOUTHWEST CORNER AND POINT OF BEGINNING OF THE TRACT HEREIN DESCRIBED, CONTAINING 115.7000 ACRES, MORE OR LESS.

FREE CONSENT & DEDICATION STATEMENT

THE PLAT SHOWN HEREON IS WITH THE FREE CONSENT OF, AND IN ACCORDANCE WITH THE WISHES AND DESIRES OF THE UNDERSIGNED OWNERS AND/OR PROPRIETORS THEREOF, AND SAID OWNERS AND/OR PROPRIETORS DO HEREBY DEDICATE THE PUBLIC RIGHTS-OF-WAY AS SHOWN HEREON TO THE CITY OF ALBUQUERQUE. THE UNDERSIGNED OWNERS DO HEREBY GRANT UNDEFINED ROADWAY EASEMENTS AS SHOWN HEREON, AND DO RESERVE FOR FUTURE DEDICATION OF PUBLIC RIGHT-OF-WAY AND AREA EQUAL TO THE ENTIRE WOODWARD ROAD AS ORIGINALLY PLATTED WHEN REQUESTED BY THE CITY OF ALBUQUERQUE; AND DO GRANT AN EASEMENT FOR FUTURE RAIL TRANSIT SYSTEM AS SHOWN HEREON. THE UNDERSIGNED OWNERS DO HEREBY GRANT ALL UTILITY EASEMENTS SHOWN HEREON BY DASHED LINES, INCLUDING THE RIGHT OF INGRESS AND EGRESS AND THE RIGHT TO TRIM INTERFERING TREES, AND DO GRANT TO THE CITY OF ALBUQUERQUE ALL SANITARY SEWER, WATERLINE, AND DRAINAGE EASEMENTS AS SHOWN HEREON INCLUDING TEMPORARY EASEMENT FOR EXISTING FLOOD PLAIN (SEE NOTE 4). THE UNDERSIGNED OWNERS DO HEREBY FREELY CONSENT TO ALL THE FOREGOING AND DO HEREBY REPRESENT THAT WE ARE AUTHORIZED TO SO ACT.

SUNPORT JOINT VENTURE - A REGISTERED NEW MEXICO PARTNERSHIP

By: Howard Mock
HOWARD MOCK - MANAGING PARTNER

ACKNOWLEDGEMENT

STATE OF NEW MEXICO } SS
COUNTY OF BERNALILLO }



OFFICIAL SEAL
Caroline A. Ford
NOTARY PUBLIC - STATE OF NEW MEXICO
Notary Bond Filed with Secretary of State
My Commission Expires

THE FOREGOING INSTRUMENT WAS ACKNOWLEDGED BEFORE ME THIS 2nd DAY OF March, 1988 BY HOWARD MOCK, A MANAGING PARTNER IN SUNPORT JOINT VENTURE, A REGISTERED NEW MEXICO PARTNERSHIP.

Caroline A. Ford
NOTARY PUBLIC

MY COMMISSION EXPIRES: 7/28/91

896761

REPLAT OF
SUNPORT PARK
ALBUQUERQUE, NEW MEXICO
NOVEMBER, 1988

APPROVALS
PUBLIC SERVICE COMPANY OF NEW MEXICO
MOUNTAIN BELL TELEPHONE COMPANY
CITY OF NEW MEXICO
CHIEF CITY SURVEYOR
PROPERTY MANAGEMENT
TRAFFIC ENGINEER
PARKS AND RECREATION DIRECTOR
WATER RESOURCES DEPARTMENT
ALBUQUERQUE METROPOLITAN ARROYO FLOOD CONTROL AUTHORITY
CITY ENGINEER, ENGINEERING DIVISION
PLANNING DIRECTOR, CITY/COUNTY PLANNING DIVISION
PLAT No. S-88-11

SURVEYOR'S CERTIFICATE

I, GAYLE D. JEWELL, A REGISTERED LAND SURVEYOR UNDER THE LAWS OF THE STATE OF NEW MEXICO, DO HEREBY CERTIFY THAT THIS PLAT WAS PREPARED BY ME OR UNDER MY SUPERVISION, SHOWS ALL EASEMENTS OF RECORD, MEETS THE MINIMUM REQUIREMENTS FOR MONUMENTATION AND SURVEYS OF THE ALBUQUERQUE SUBDIVISION ORDINANCE, AND IS TRUE AND CORRECT TO THE BEST OF MY KNOWLEDGE AND BELIEF.

Gayle D. Jewell
GAYLE D. JEWELL, L.S. NO. 4071
DATE 2-24-88
11-4-88

ACKNOWLEDGMENT

STATE OF NEW MEXICO } SS
COUNTY OF BERNALILLO }

THE FOREGOING INSTRUMENT WAS ACKNOWLEDGED BEFORE ME THIS 24th DAY OF February, 1988 BY GAYLE D. JEWELL, REGISTERED NEW MEXICO LAND SURVEYOR NO. 4071.

Caroline A. Ford
NOTARY PUBLIC

MY COMMISSION EXPIRES: 7/28/91



ANDREWS, ASBURY & ROBERT, INC.
ALBUQUERQUE CONSULTING ENGINEERS 85-415 NEW MEXICO

SHEET 1 OF 4

AS BUILT INFORMATION			BENCH MARKS			SURVEY INFORMATION			ENGINEER'S SEAL		
CONTRACTOR	NEW CONCEPTS INC.	DATE	1-88	STATION	1-25-31	ELEVATION	5062.528	FIELD NOTES	DATE	BY	NO.
STAKED BY	AA&P	DATE	12-88	POST LOCATED AT	THE NORTHEAST CORNER OF THE HIGHWAY 1-25 BRIDGE CROSSING OVER AN ABANDONED RAILROAD SPUR LINE APPROXIMATELY 1.5 MILES NORTH OF RIO BRAVO BOULEVARD						
FIELD ACCEPTANCE BY	RE	DATE	2-89								
REVISIONS											
DATE	1-89										
CORRECTED BY	AA&P										
RECORDED BY											
NO											

John A. Andrews
RECORD DRAWING
2-8-89


1 2 3 4 5 6 7 8 9 10 11 12
26 295000289

CITY OF ALBUQUERQUE PUBLIC WORKS DEPARTMENT					
SUNPORT PARK INFRASTRUCTURE IMPROVEMENTS - PHASE I SUBDIVISION PLAT					
APPROVALS	ENGINEER	DATE	APPROVALS	ENGINEER	DATE
City Engineer			Liquid Waste	<u>2951</u>	5-22-87
A C E - Design			Traffic	<u>W.D.W.H.</u>	5-22-87
A C E - Hydrology	<u>R.A.</u>	6-1-87	Water	<u>2951</u>	5-22-87
DRAWING NO.	2950	MAP NO.	M-15	SHEET	2 OF 26

[illegible]

CITY OF ALBUQUERQUE PUBLIC WORKS DEPARTMENT					
SUNPORT PARK INFRASTRUCTURE IMPROVEMENTS - PHASE I SUBDIVISION PLAT					
APPROVALS	ENGINEER	DATE	APPROVALS	ENGINEER	DATE
City Engineer			Liquid Waste		5-22-87
A C E - Design			Traffic	WAD:WH	5/22/87
A C E - Hydrology		6-1-87	Water		5-22-87
DRAWING NO. 2950		MAP NO. M-15		SHEET 3 OF 26	

CURVE DATA			
NO.	DELTA	RADIUS	LENGTH
①	53°00'00"	430.00'	397.76'
②	88°19'54"	30.00'	46.25'
③	24°35'05"	1,444.00'	619.60'
④	28°55'37"	1,400.00'	706.82'
⑤	41°59'31"	400.00'	293.16'
⑥	25°35'55"	800.00'	357.42'
⑦	15°58'41"	1,448.00'	403.80'
⑧	90°00'00"	30.00'	47.12'

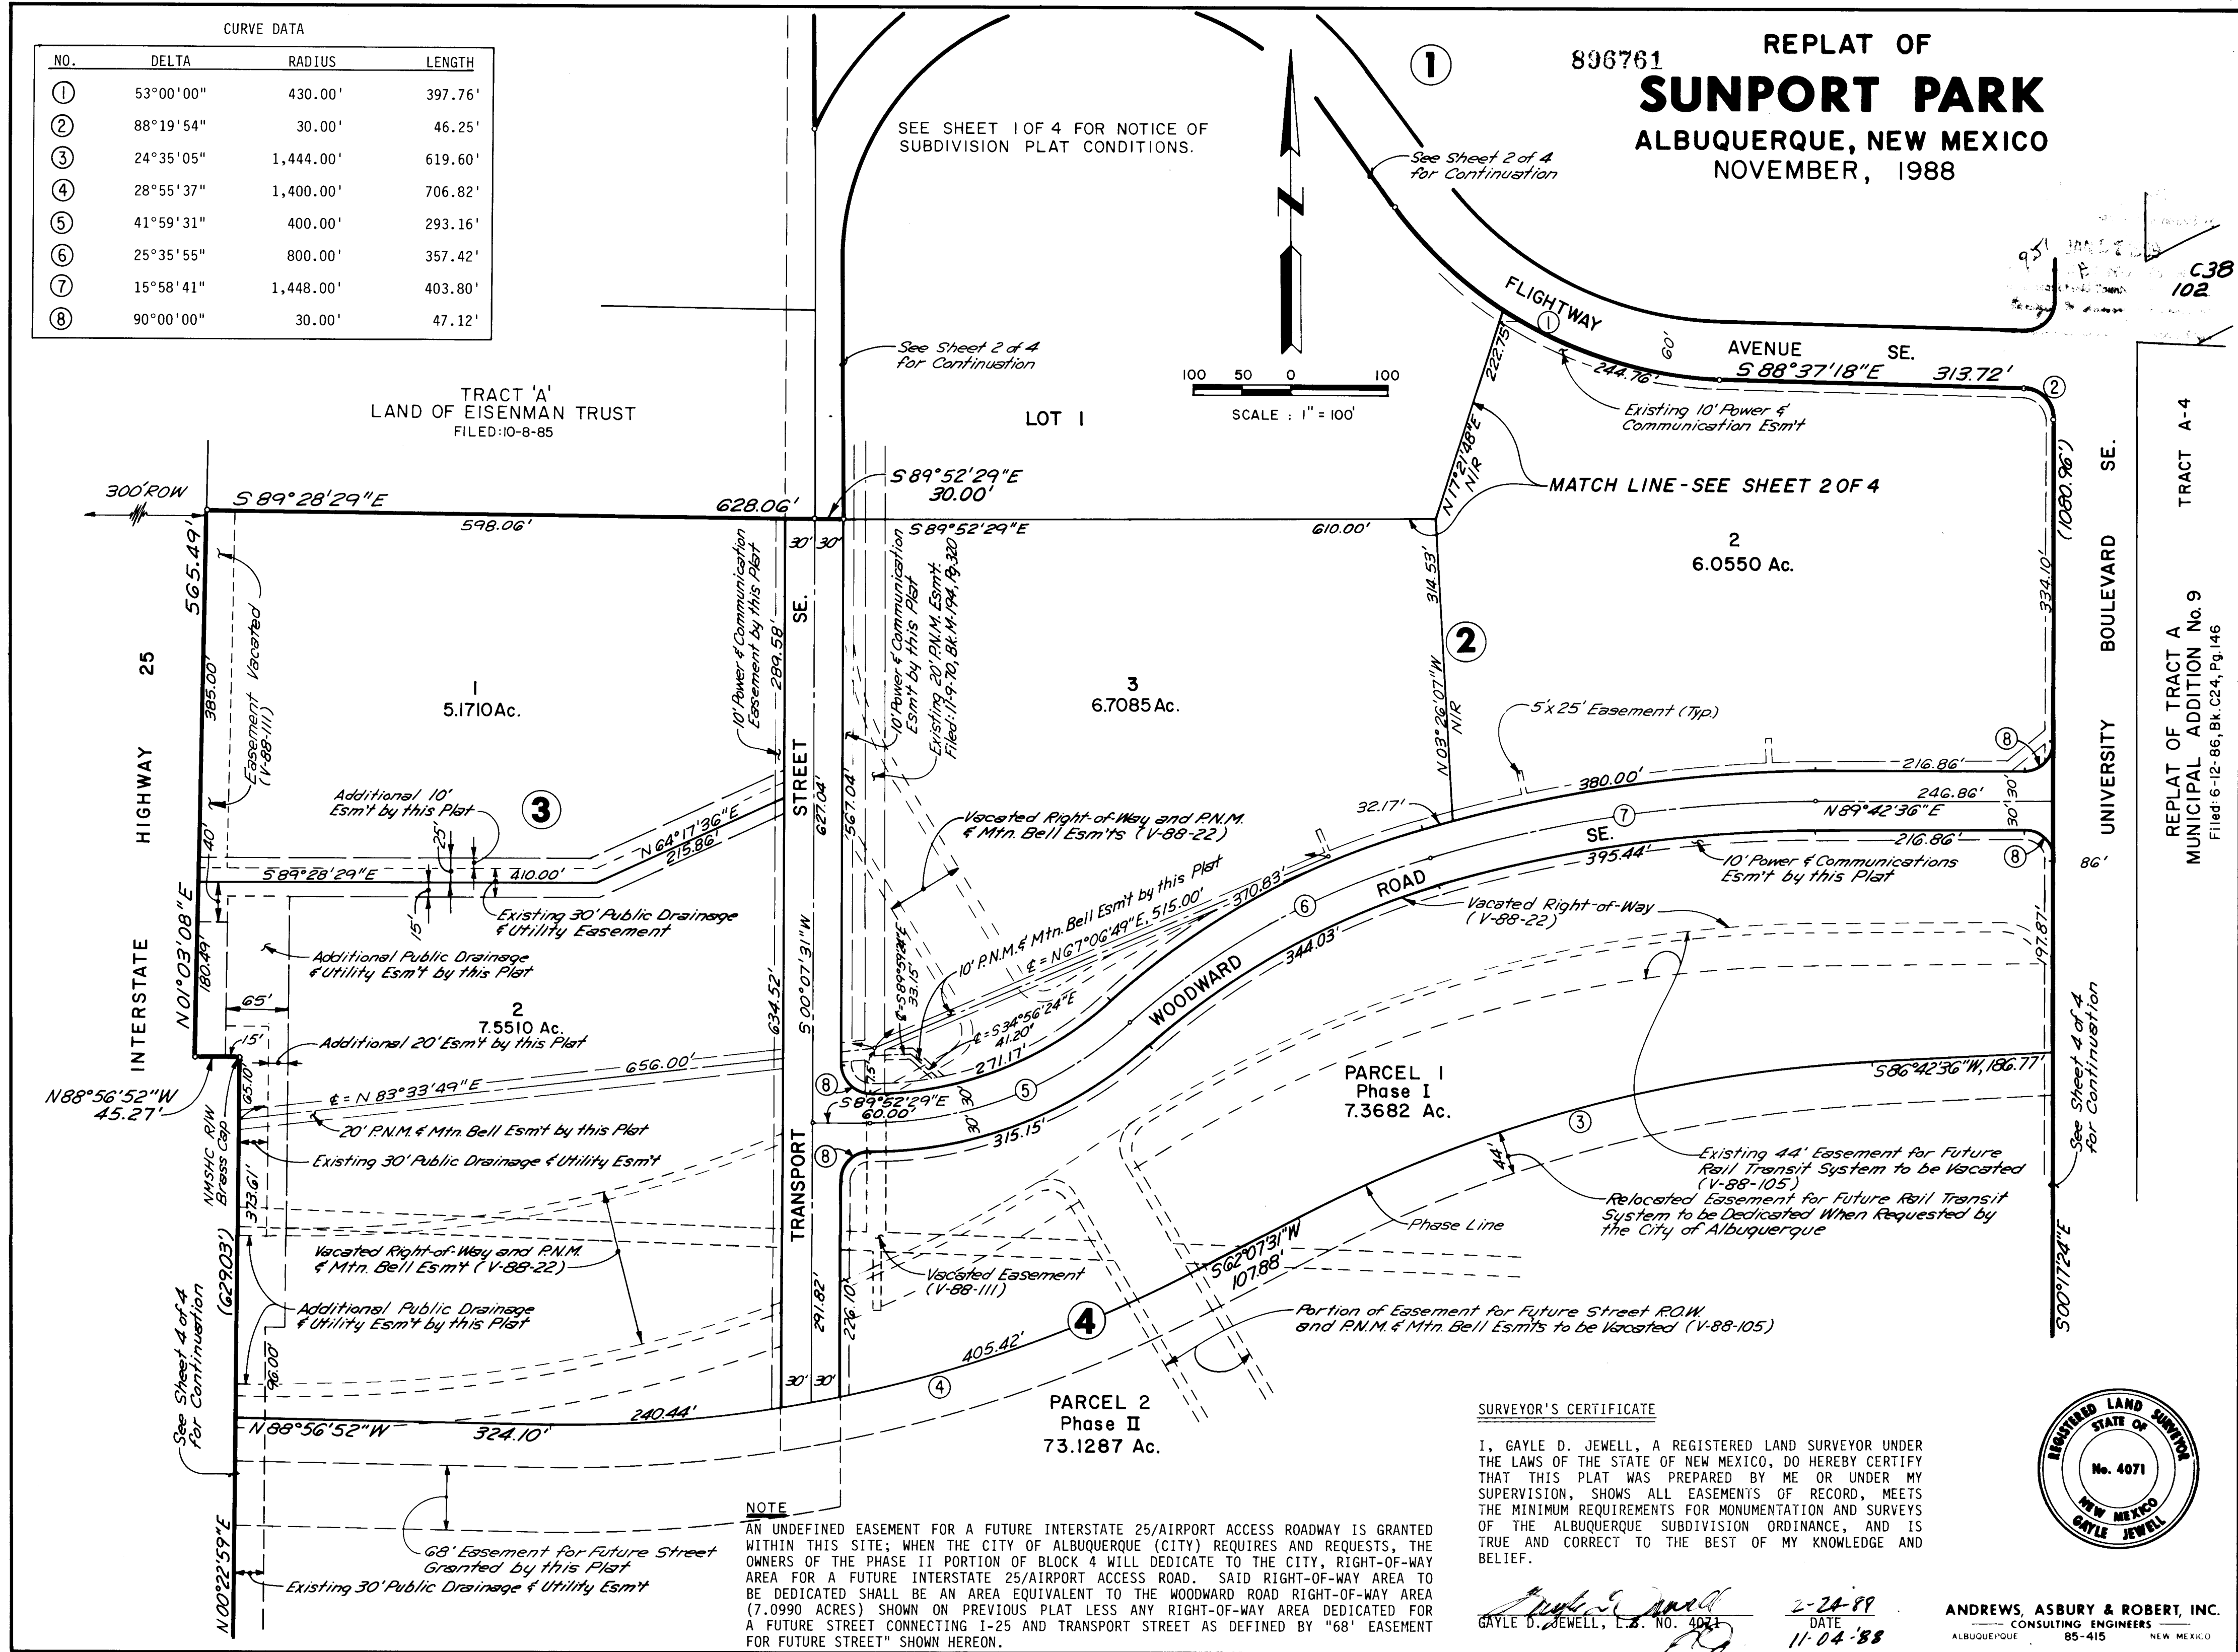


John A. Andrews
RECORD DRAWING
2-8-89

1 2 3 4 5 6 7 8 9 10 11 12
26 29500489

ENGINEER'S SEAL				SURVEY INFORMATION		BENCH MARKS		AS BUILT INFORMATION	
				NO.	BY	DATE	STA. "1-25-31"	ELEVATION 5062.528	CONTRACTOR <i>New Concepts Inc.</i>
							STANDARD	MNSHC BRASS TABLE SET IN CONCRETE	WORK COMPLETED BY <i>A.A.P.R.</i>
							POST LOCATED AT THE NORTHEAST CORNER OF THE		INSPECTOR'S ACCEPTANCE BY <i>R.E.</i>
							HIGHWAY I-25 BRIDGE CROSSING OVER AN ABANDONED		FIELD DATE <i>2-89</i>
							RAILROAD SPUR LINE APPROXIMATELY 1.5 MILES		DESIGNATION BY <i>AAFP</i>
							NORTH OF RIO BRAVO BOULEVARD		CORRECTED BY <i>AAFP</i>
									DATE <i>1-89</i>
									<i>MICRO-FILM INFORMATION</i>
						RECORDED BY		DATE	
								NO	
								DATE	

CITY OF ALBUQUERQUE PUBLIC WORKS DEPARTMENT					
SUNPORT PARK INFRASTRUCTURE IMPROVEMENTS - PHASE I SUBDIVISION PLAT					
APPROVALS	ENGINEER	DATE	APPROVALS	ENGINEER	DATE
City Engineer			Liquid Waste	JLM	5-22-87
A.C.E. - Design			Traffic	NADW	5-22-87
A.C.E. - Hydrology			Water	JLM	5-22-87
DRAWING NO.	2950	MAP NO.	M-15	SHEET	4 OF 26

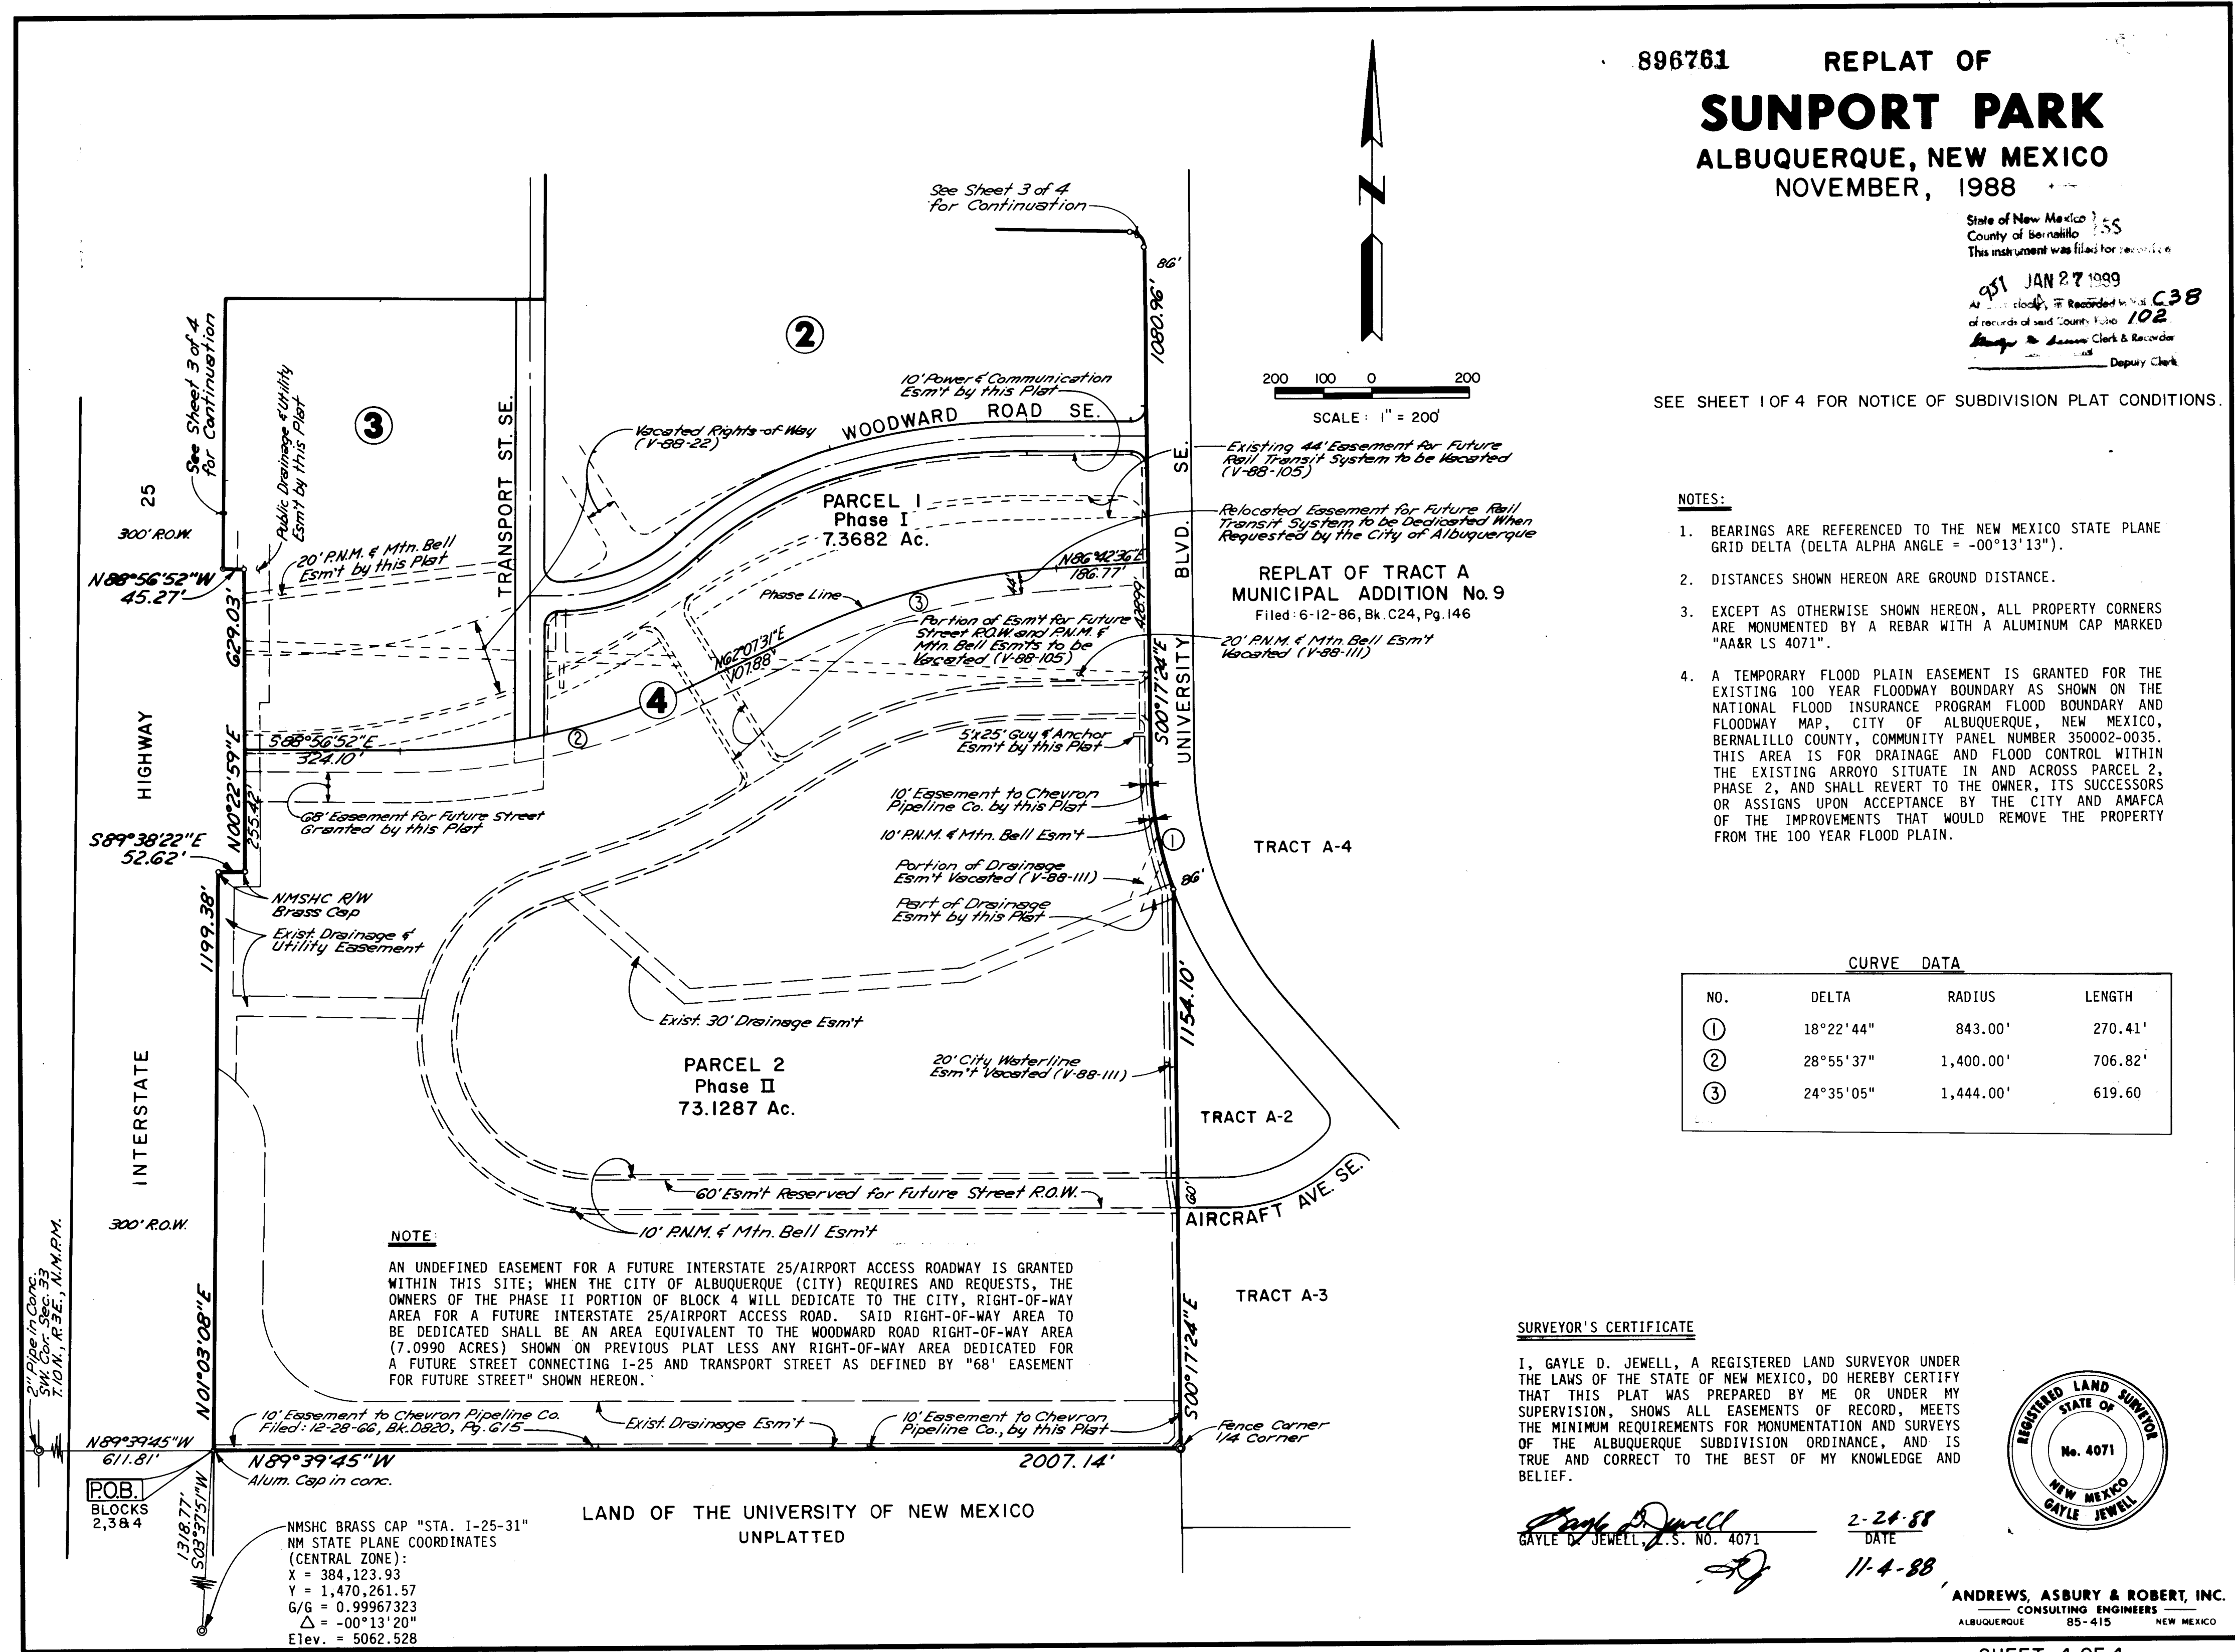

896761 REPLAT OF
SUNPORT PARK
ALBUQUERQUE, NEW MEXICO
NOVEMBER, 1988

State of New Mexico
County of Bernalillo
This instrument was filed for record on
JAN 27 1989
at 10:00 AM, at the County Clerk's Office, Albuquerque, New Mexico.
C38
of records of said County, Book 102
Page 146
Surveyor's Seal
Gayle D. Jewell, Surveyor
Deputy Clerk

SEE SHEET 1 OF 4 FOR NOTICE OF SUBDIVISION PLAT CONDITIONS.


- NOTES:
1. BEARINGS ARE REFERENCED TO THE NEW MEXICO STATE PLANE GRID DELTA (DELTA ALPHA ANGLE = -00°13'13").
 2. DISTANCES SHOWN HEREON ARE GROUND DISTANCE.
 3. EXCEPT AS OTHERWISE SHOWN HEREON, ALL PROPERTY CORNERS ARE MONUMENTED BY A REBAR WITH A ALUMINUM CAP MARKED "AAR LS 4071".
 4. A TEMPORARY FLOOD PLAIN EASEMENT IS GRANTED FOR THE EXISTING 100 YEAR FLOODWAY BOUNDARY AS SHOWN ON THE NATIONAL FLOOD INSURANCE PROGRAM FLOOD BOUNDARY AND FLOODWAY MAP, CITY OF ALBUQUERQUE, NEW MEXICO, BERNALILLO COUNTY, COMMUNITY PANEL NUMBER 350002-0035. THIS AREA IS FOR DRAINAGE AND FLOOD CONTROL WITHIN THE EXISTING ARROYO SITUATE IN AND ACROSS PARCEL 2, PHASE 2, AND SHALL REVERT TO THE OWNER, ITS SUCCESSORS OR ASSIGNS UPON ACCEPTANCE BY THE CITY AND AMAFCA OF THE IMPROVEMENTS THAT WOULD REMOVE THE PROPERTY FROM THE 100 YEAR FLOOD PLAIN.

CURVE DATA			
NO.	DELTA	RADIUS	LENGTH
①	18°22'44"	843.00'	270.41'
②	28°55'37"	1,400.00'	706.82'
③	24°35'05"	1,444.00'	619.60'

SURVEYOR'S CERTIFICATE

I, GAYLE D. JEWELL, A REGISTERED LAND SURVEYOR UNDER THE LAWS OF THE STATE OF NEW MEXICO, DO HEREBY CERTIFY THAT THIS PLAT WAS PREPARED BY ME OR UNDER MY SUPERVISION, SHOWS ALL EASEMENTS OF RECORD, MEETS THE MINIMUM REQUIREMENTS FOR MONUMENTATION AND SURVEYS OF THE ALBUQUERQUE SUBDIVISION ORDINANCE, AND IS TRUE AND CORRECT TO THE BEST OF MY KNOWLEDGE AND BELIEF.

Gayle D. Jewell
GAYLE D. JEWELL, S.S. NO. 4071
DATE 2-24-88
11-4-88

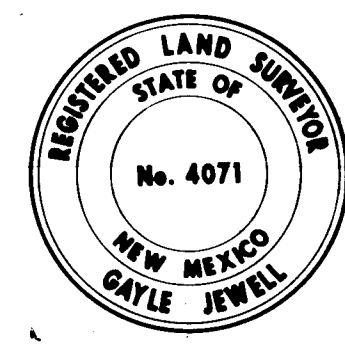


ANDREWS, ASBURY & ROBERT, INC.
ALBUQUERQUE CONSULTING ENGINEERS
85-4150 NEW MEXICO


John A. Andrews
RECORD DRAWING
2-8-89
1 2 3 4 5 6 7 8 9 10 11 12
26 29500489A

CITY OF ALBUQUERQUE PUBLIC WORKS DEPARTMENT					
SUNPORT PARK INFRASTRUCTURE IMPROVEMENTS-PHASE I SUBDIVISION PLAT					
APPROVALS	ENGINEER	DATE	APPROVALS	ENGINEER	DATE
City Engineer			Liquid Waste	JWA	5-22-87
A.C.E.-Design			Traffic	NADWH	5/22/87
A.C.E.-Hydrology	JWA	6-1-87	Water	JWA	5-22-87
DRAWING NO.	2950	MAP NO.	M-15	SHEET OF	4A 26

--	--	
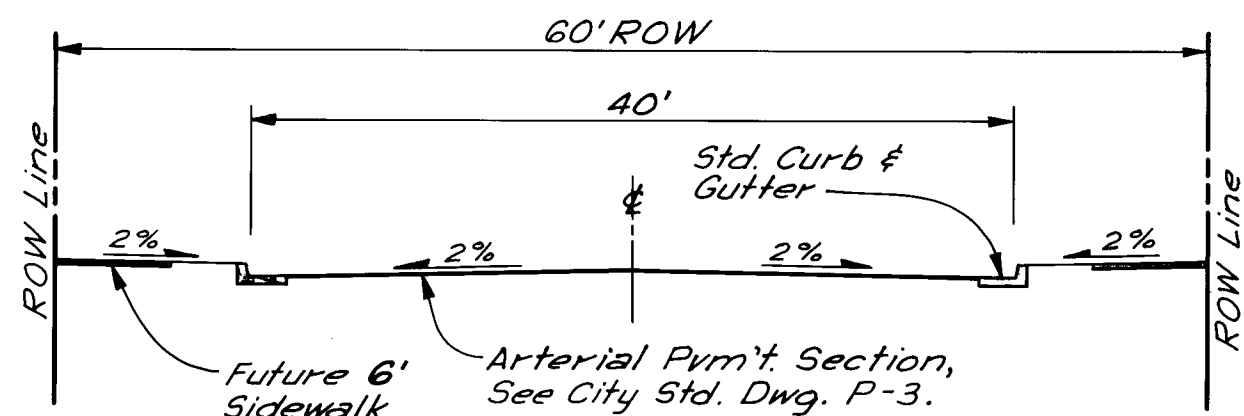

TYPICAL STREET SECTION
FLIGHTWAY AVE., TRANSPORT ST. & WOODWARD RD.

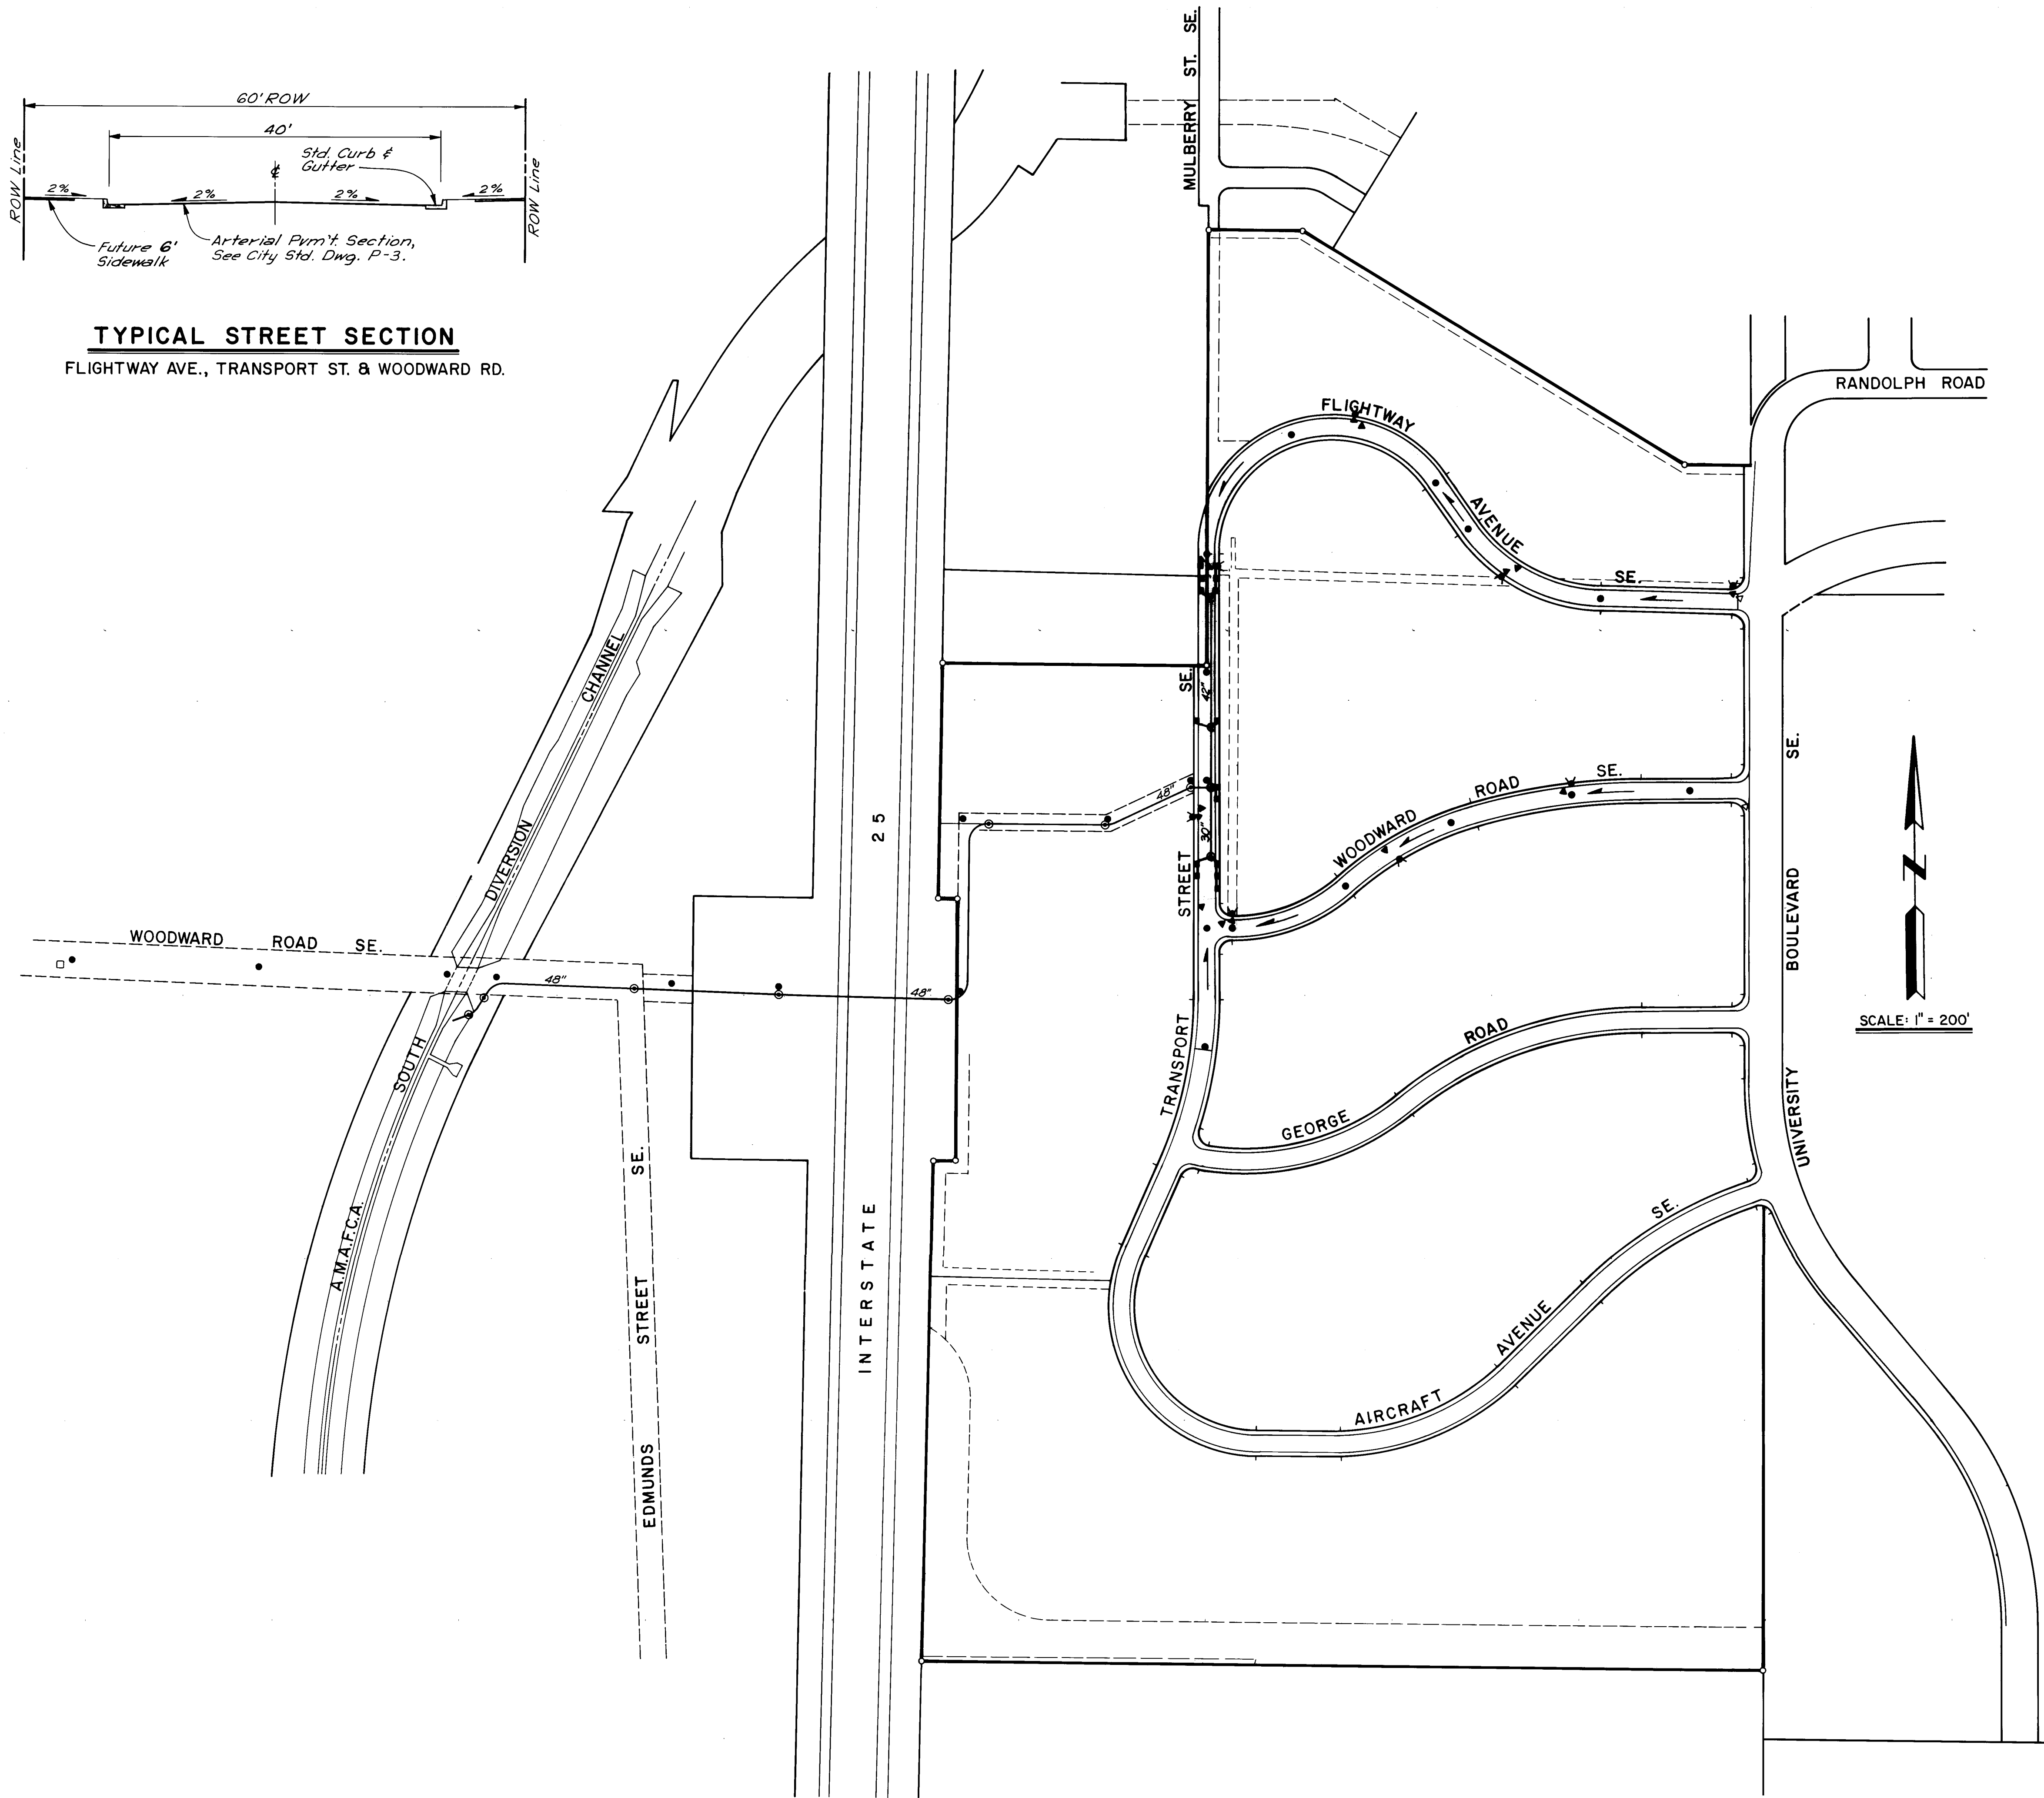

NOTES:


1. ALL NEW PAVEMENT THIS PROJECT SHALL BE CITY OF ALBUQUERQUE ARTERIAL STANDARD SECTION. SEE STD. DWG. P-3.

LEGEND

- NEW PAVEMENT
- DIRECTION OF SURFACE FLOW
- STORM DRAIN WITH SIZE
- STORM DRAIN MANHOLE
- CATCH BASIN
- MANHOLE - SANITARY SEWER
- NEW WATER VALVE
- EXISTING WATER VALVE
- FIRE HYDRANT

John A. Andrews
RECORD DRAWING
2-8-89

26 29500589

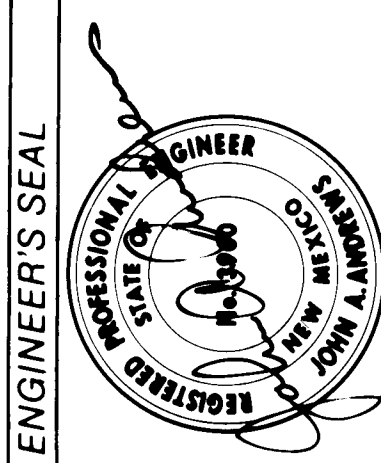

ANDREWS, ASBURY & ROBERT, INC.
CONSULTING ENGINEERS
ALBUQUERQUE, N.M.


SURVEY INFORMATION		BENCH MARKS		AS BUILT INFORMATION	
NO.	DATE	STA.	ELEVATION	CONTRACTOR	DATE
		1+25.31	5062.528	New Concepts Inc.	1-89
				INSPECTED BY	DATE
				AAFP	1-89
				ACCEPTANCE BY	DATE
				RE	2-89
				VERIFICATION BY	DATE
				AAFP	1-89
				VERIFICATION BY	DATE
				AAFP	1-89
				RECORDED BY	DATE
				NO	

CITY OF ALBUQUERQUE
PUBLIC WORKS DEPARTMENT

**SUNPORT PARK
INFRASTRUCTURE IMPROVEMENTS - PHASE I
PAVING & STORM DRAIN PLAN**

APPROVALS	ENGINEER	DATE	APPROVALS	ENGINEER	DATE
City Engineer	<i>John A. Andrews</i>	6/5/87	Liquid Waste	<i>John A. Andrews</i>	5-22-87
A.C.E. - Design	<i>John A. Andrews</i>	6-1-87	Traffic	<i>John A. Andrews</i>	5-22-87
A.C.E. - Hydrology	<i>John A. Andrews</i>	6-1-87	Water	<i>John A. Andrews</i>	5-22-87

DRAWING NO. 2950 MAP NO. M-15 SHEET 5 OF 26

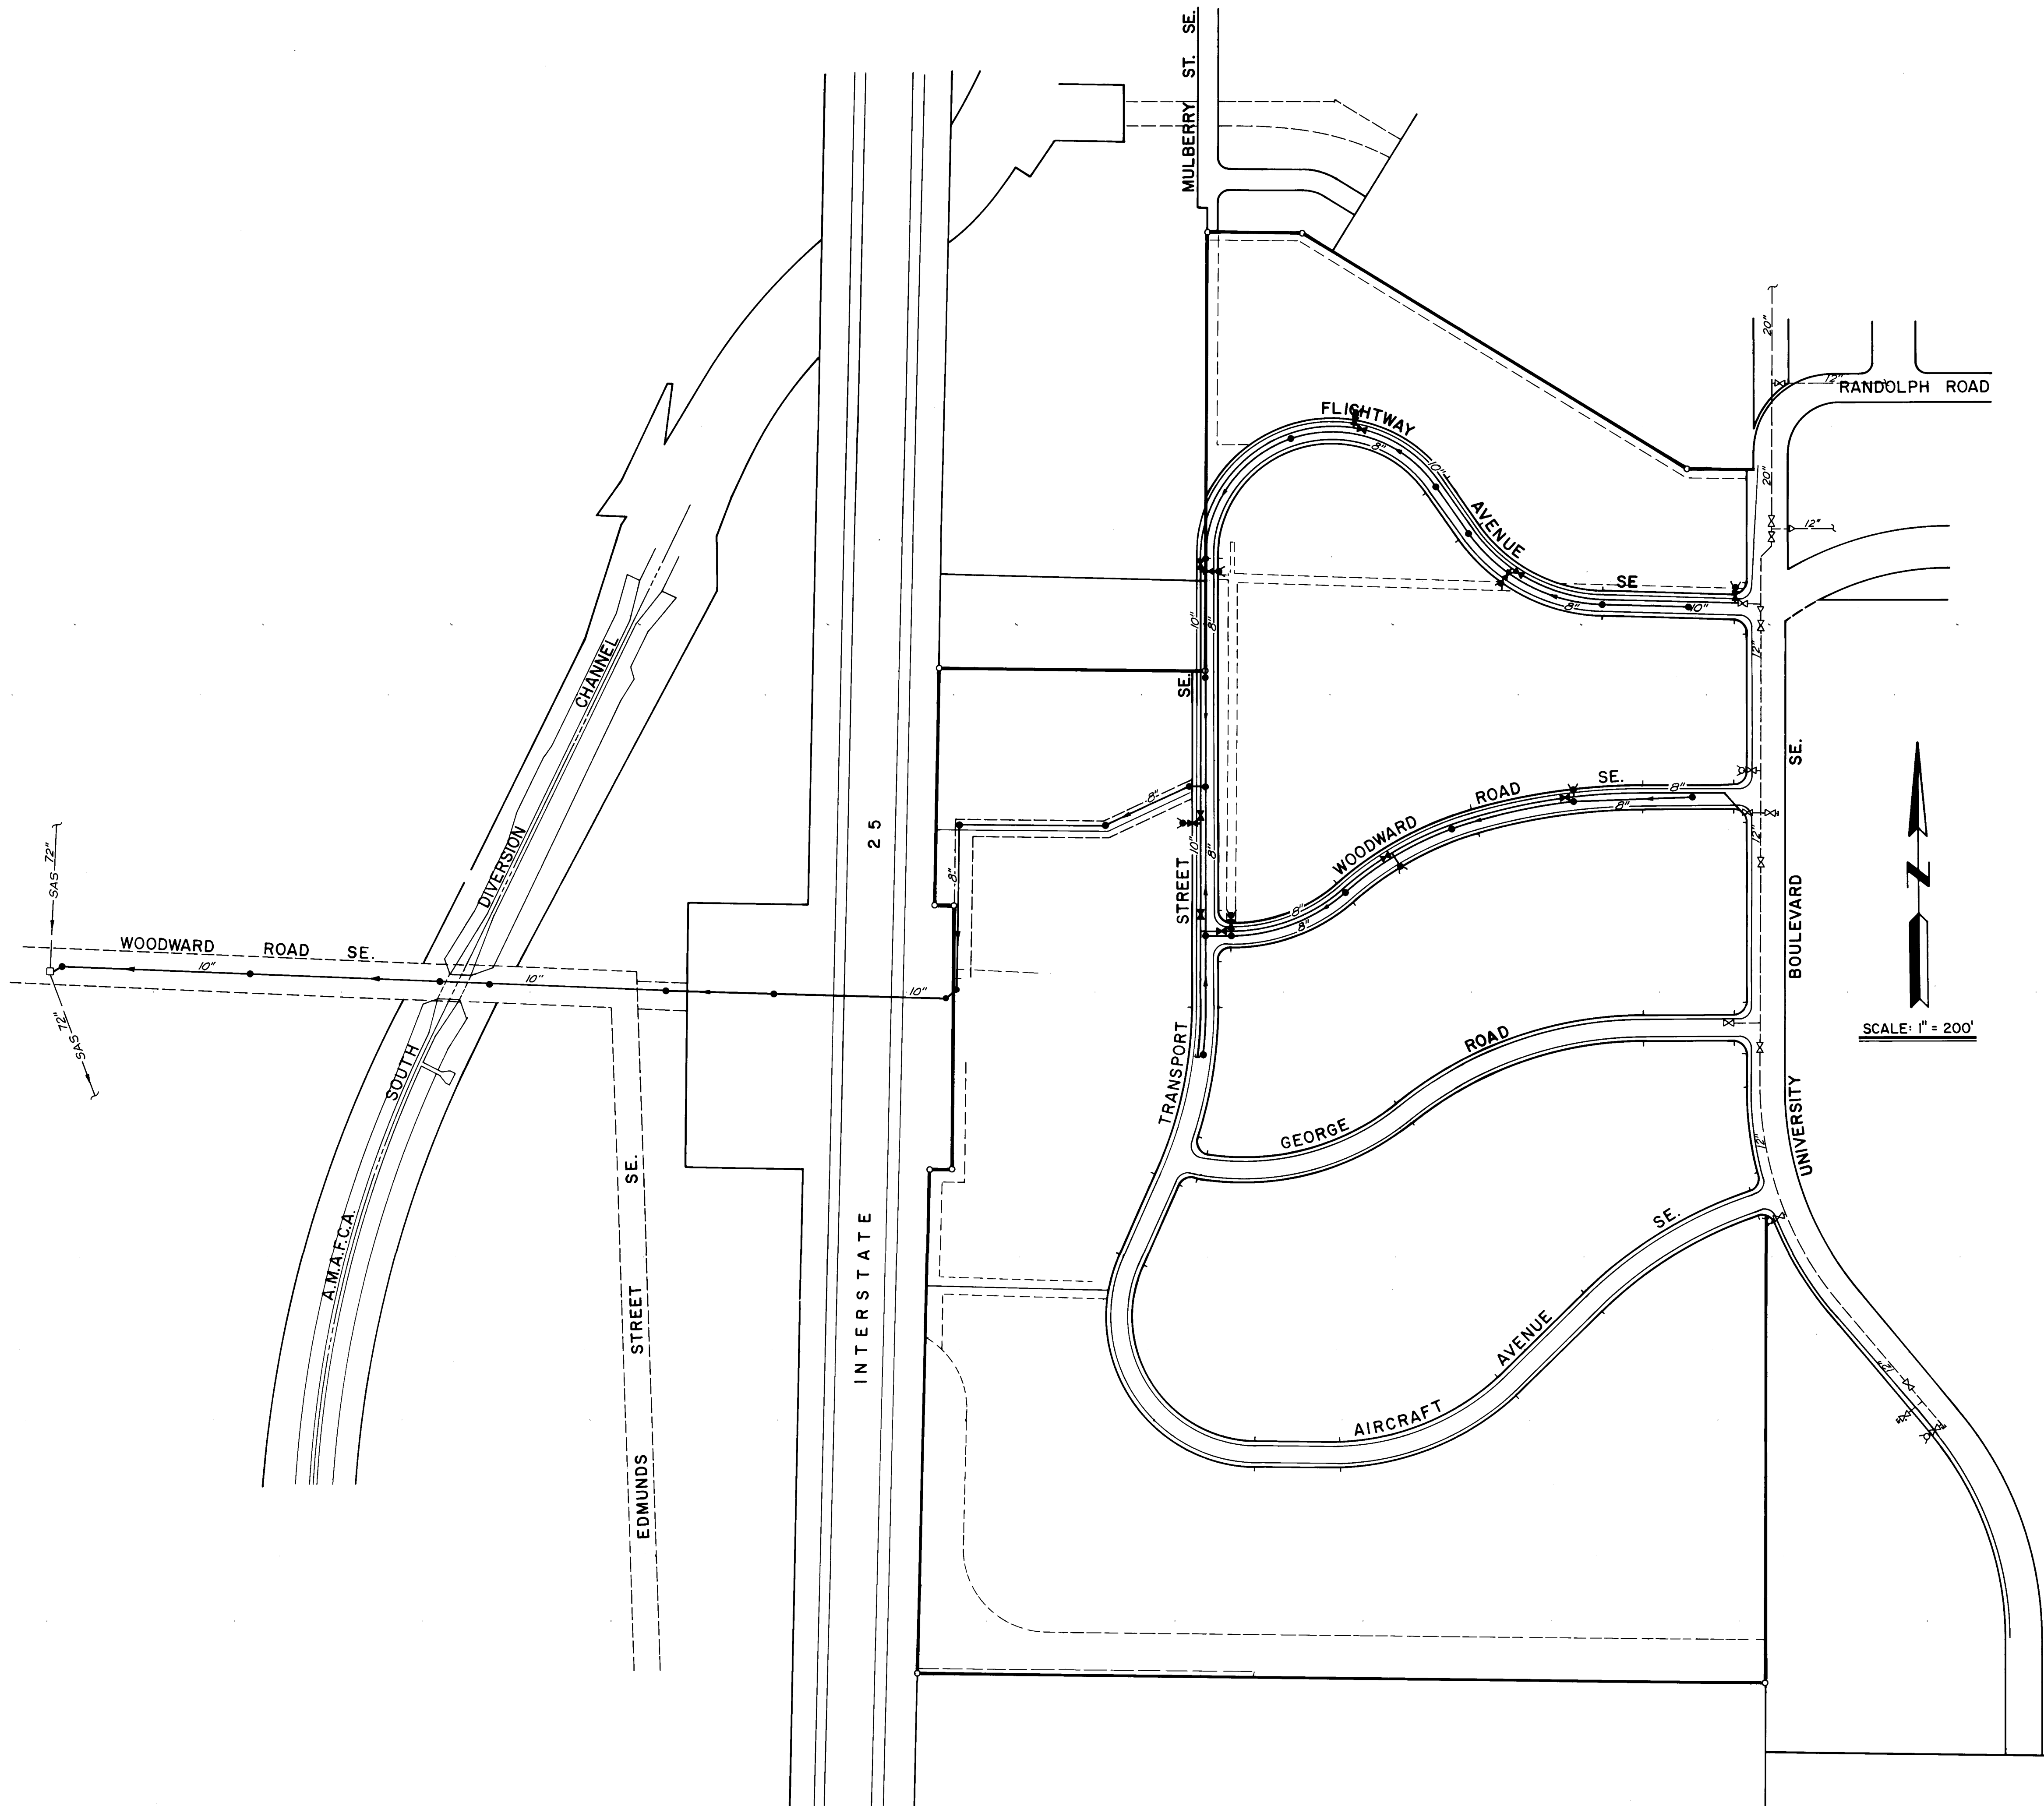


26 2950 00 689

John A. Andrews
RECORD DRAWING
2-8-89

CITY OF ALBUQUERQUE PUBLIC WORKS DEPARTMENT					
SUNPORT PARK INFRASTRUCTURE IMPROVEMENTS-PHASE I WATER & SANITARY SEWER PLAN					
APPROVALS	ENGINEER	DATE	APPROVALS	ENGINEER	DATE
City Engineer	<i>John A. Andrews</i>	6/5/87	Liquid Waste	<i>John A. Andrews</i>	5/22/87
A.C.E. - Design	"	"	Traffic	<i>John A. Andrews</i>	5/22/87
A.C.E. - Hydrology	<i>John A. Andrews</i>	6-1-87	Water	<i>John A. Andrews</i>	5/22/87
DRAWING NO.	2950	MAP NO.	M-15	SHEET	6 OF 26

ENGINEER'S SEAL		SURVEY INFORMATION		BENCH MARKS		AS BUILT INFORMATION	
		NO.	BY	DATE	STA. "1-25-31"	ELEVATION 5062.528	CONTRACTOR
							New Concepts Inc.
							STAKED BY
							AAEP
							INSPECTOR'S
							DATE 1-28
							FIELD
							DATE 2-87
							VERIFICATION BY
							DATE 1-89
							CORRECTED BY
							AAEP
							DATE 1-89
							RECORDED BY
							NO
							DATE

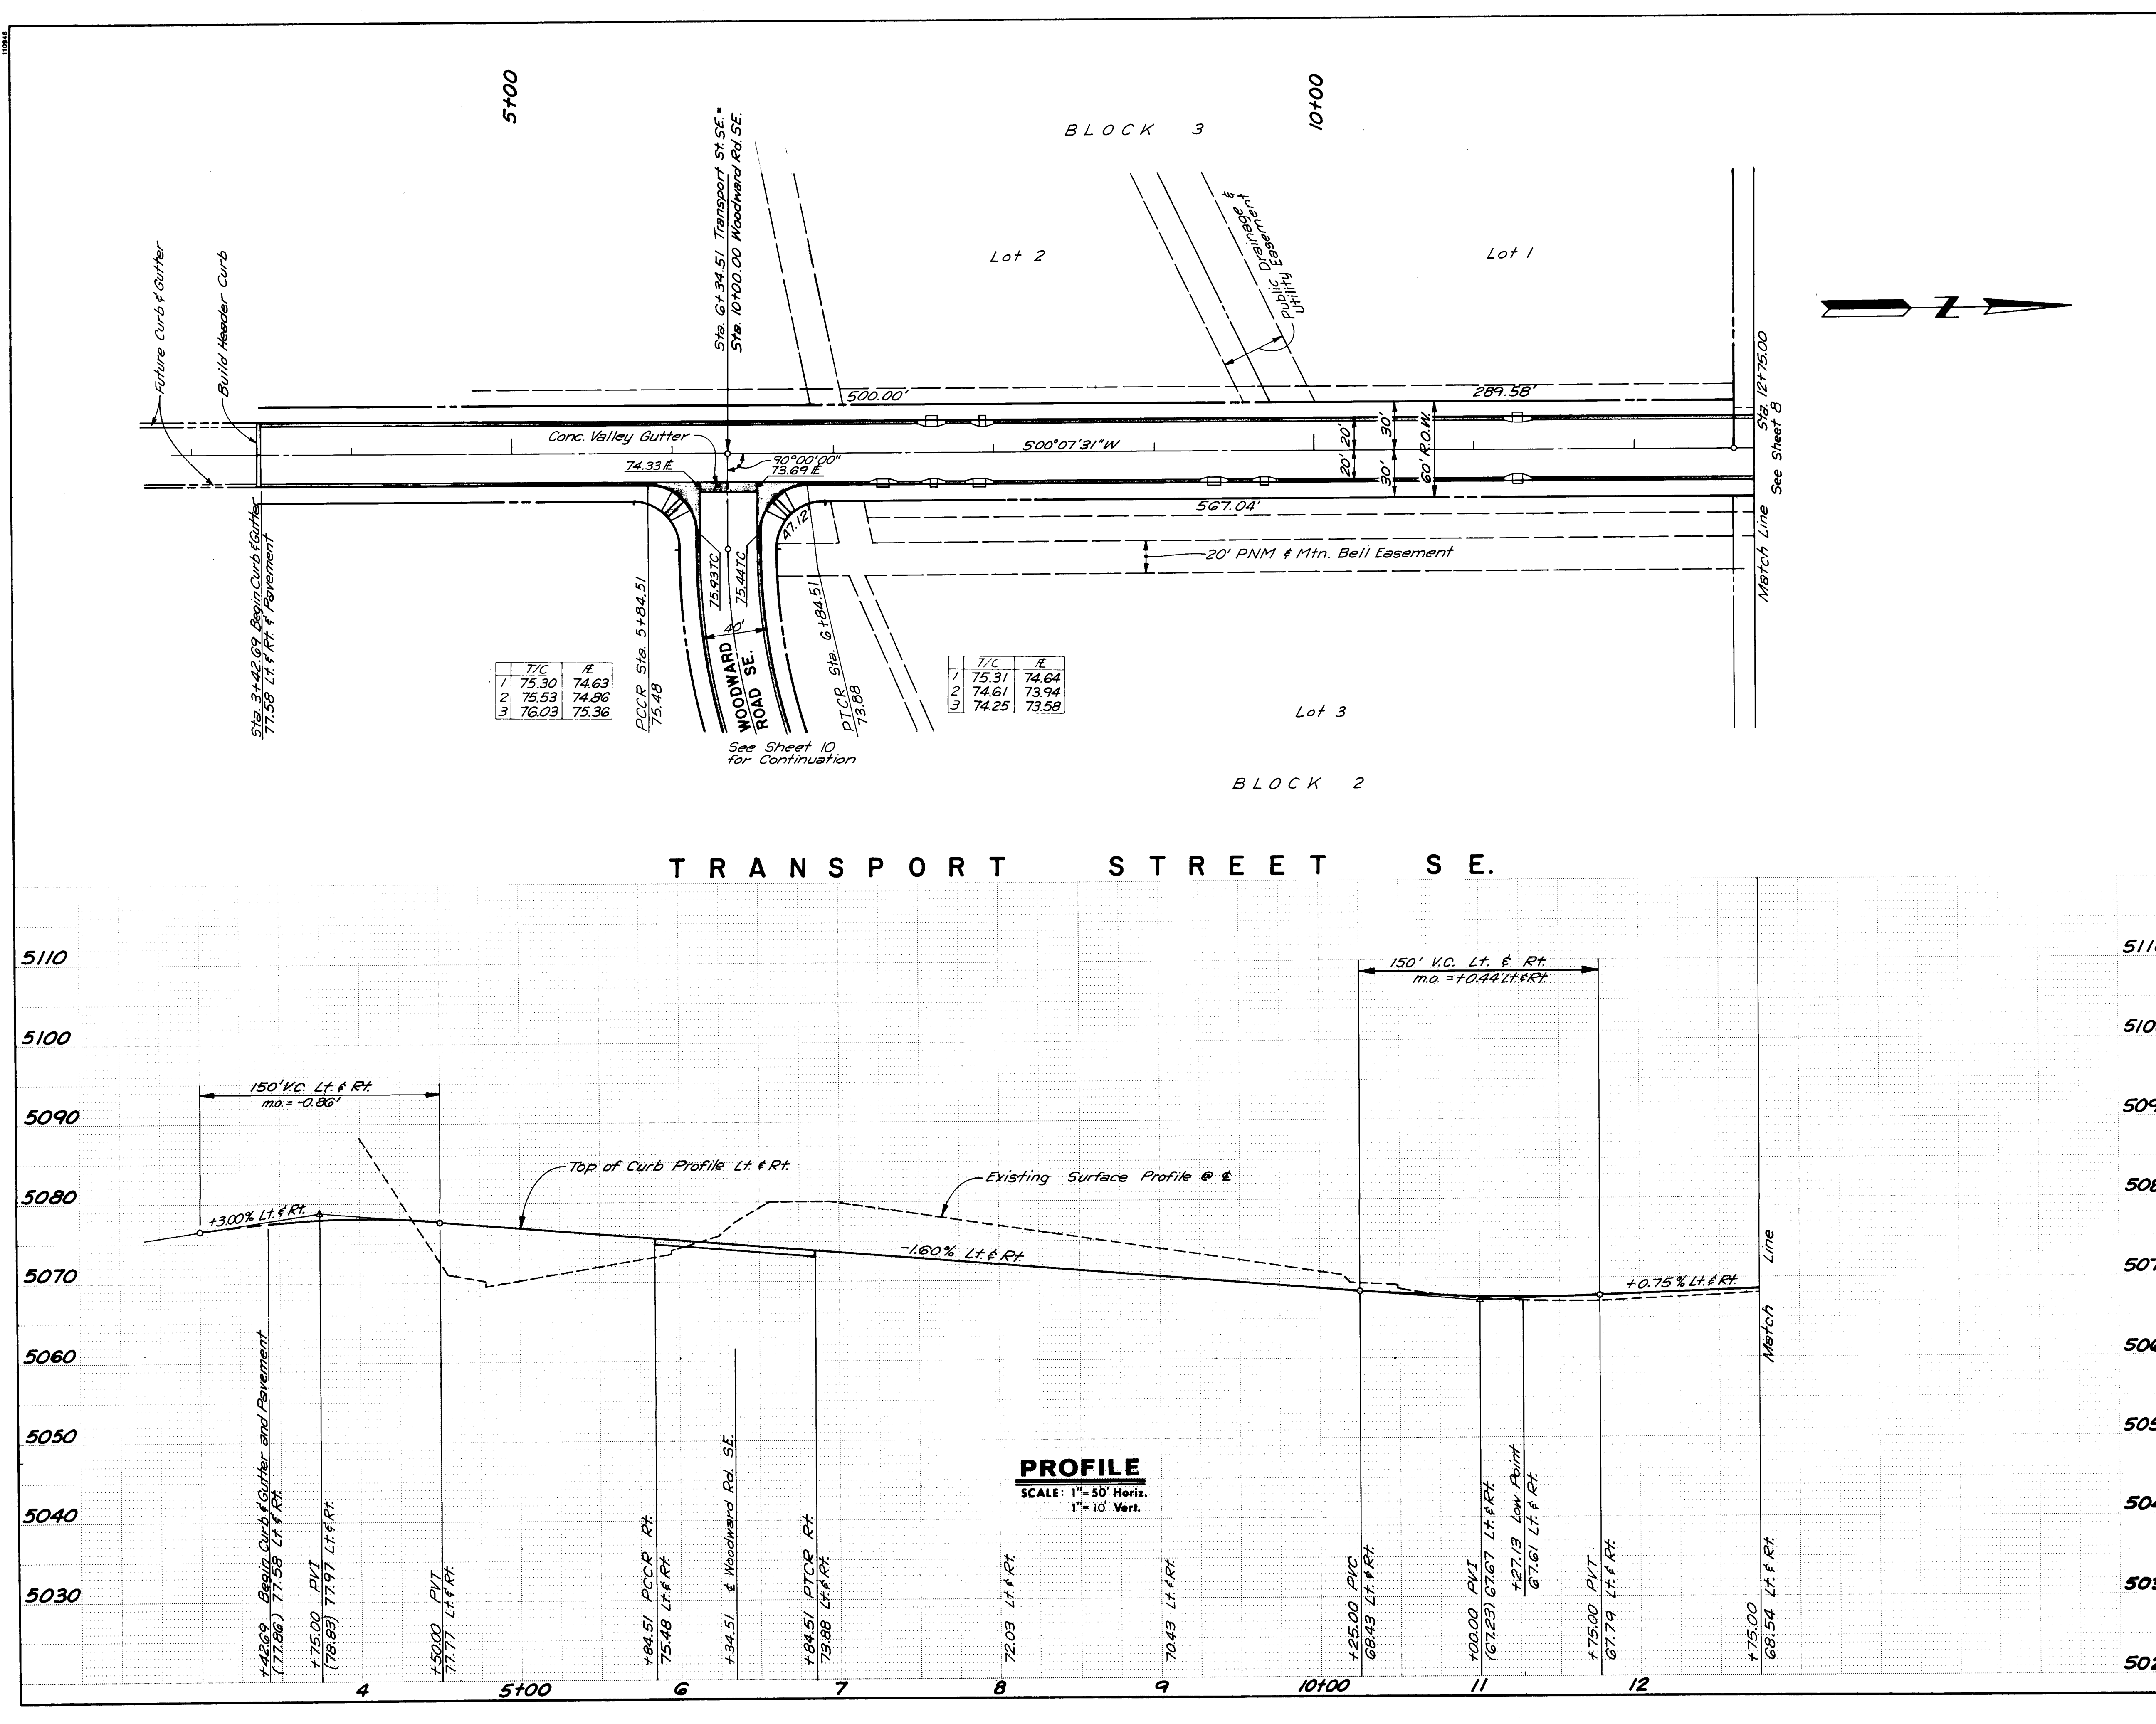

	T/C	E
1	75.30	74.63
2	75.53	74.86
3	76.03	75.36


	T/C	E
1	75.31	74.64
2	74.61	73.94
3	74.25	73.58

John A. Andrews
RECORD DRAWING
2-8-89


26 29500789

CITY OF ALBUQUERQUE PUBLIC WORKS DEPARTMENT					
SUNPORT PARK INFRASTRUCTURE IMPROVEMENTS - PHASE I PAVING PLAN & PROFILE TRANSPORT STREET SE.					
APPROVALS	ENGINEER	DATE	APPROVALS	ENGINEER	DATE
D.R.C. Chair					
Trans. Dev					
Utility Dev					
DRAWING NO. 2950		MAP NO. M-15		SHEET 7 OF 26	

ENGINEER'S SEAL		AS BUILT INFORMATION			
		CONTRACTOR: New Concepts Inc. WORK: PAVING DATE: 1-88			
REVISIONS		BENCH MARKS			
NO.	DATE	STA. "1-25-31" ELEVATION 5062.528 STANDARD MNSHC. BRASS TABLE SET IN CONCRETE POST LOCATED AT THE NORTHEAST CORNER OF THE HIGHWAY 1-25 BRIDGE CROSSING OVER AN ABANDONED RAILROAD SPIR LINE APPROXIMATELY 1.15 MILES NORTH OF RIO BRAVO BOULEVARD			
DESIGNED BY	DATE	NO.		DATE	
DRAWN BY	DATE	NO.		DATE	
CHECKED BY	DATE	NO.		DATE	

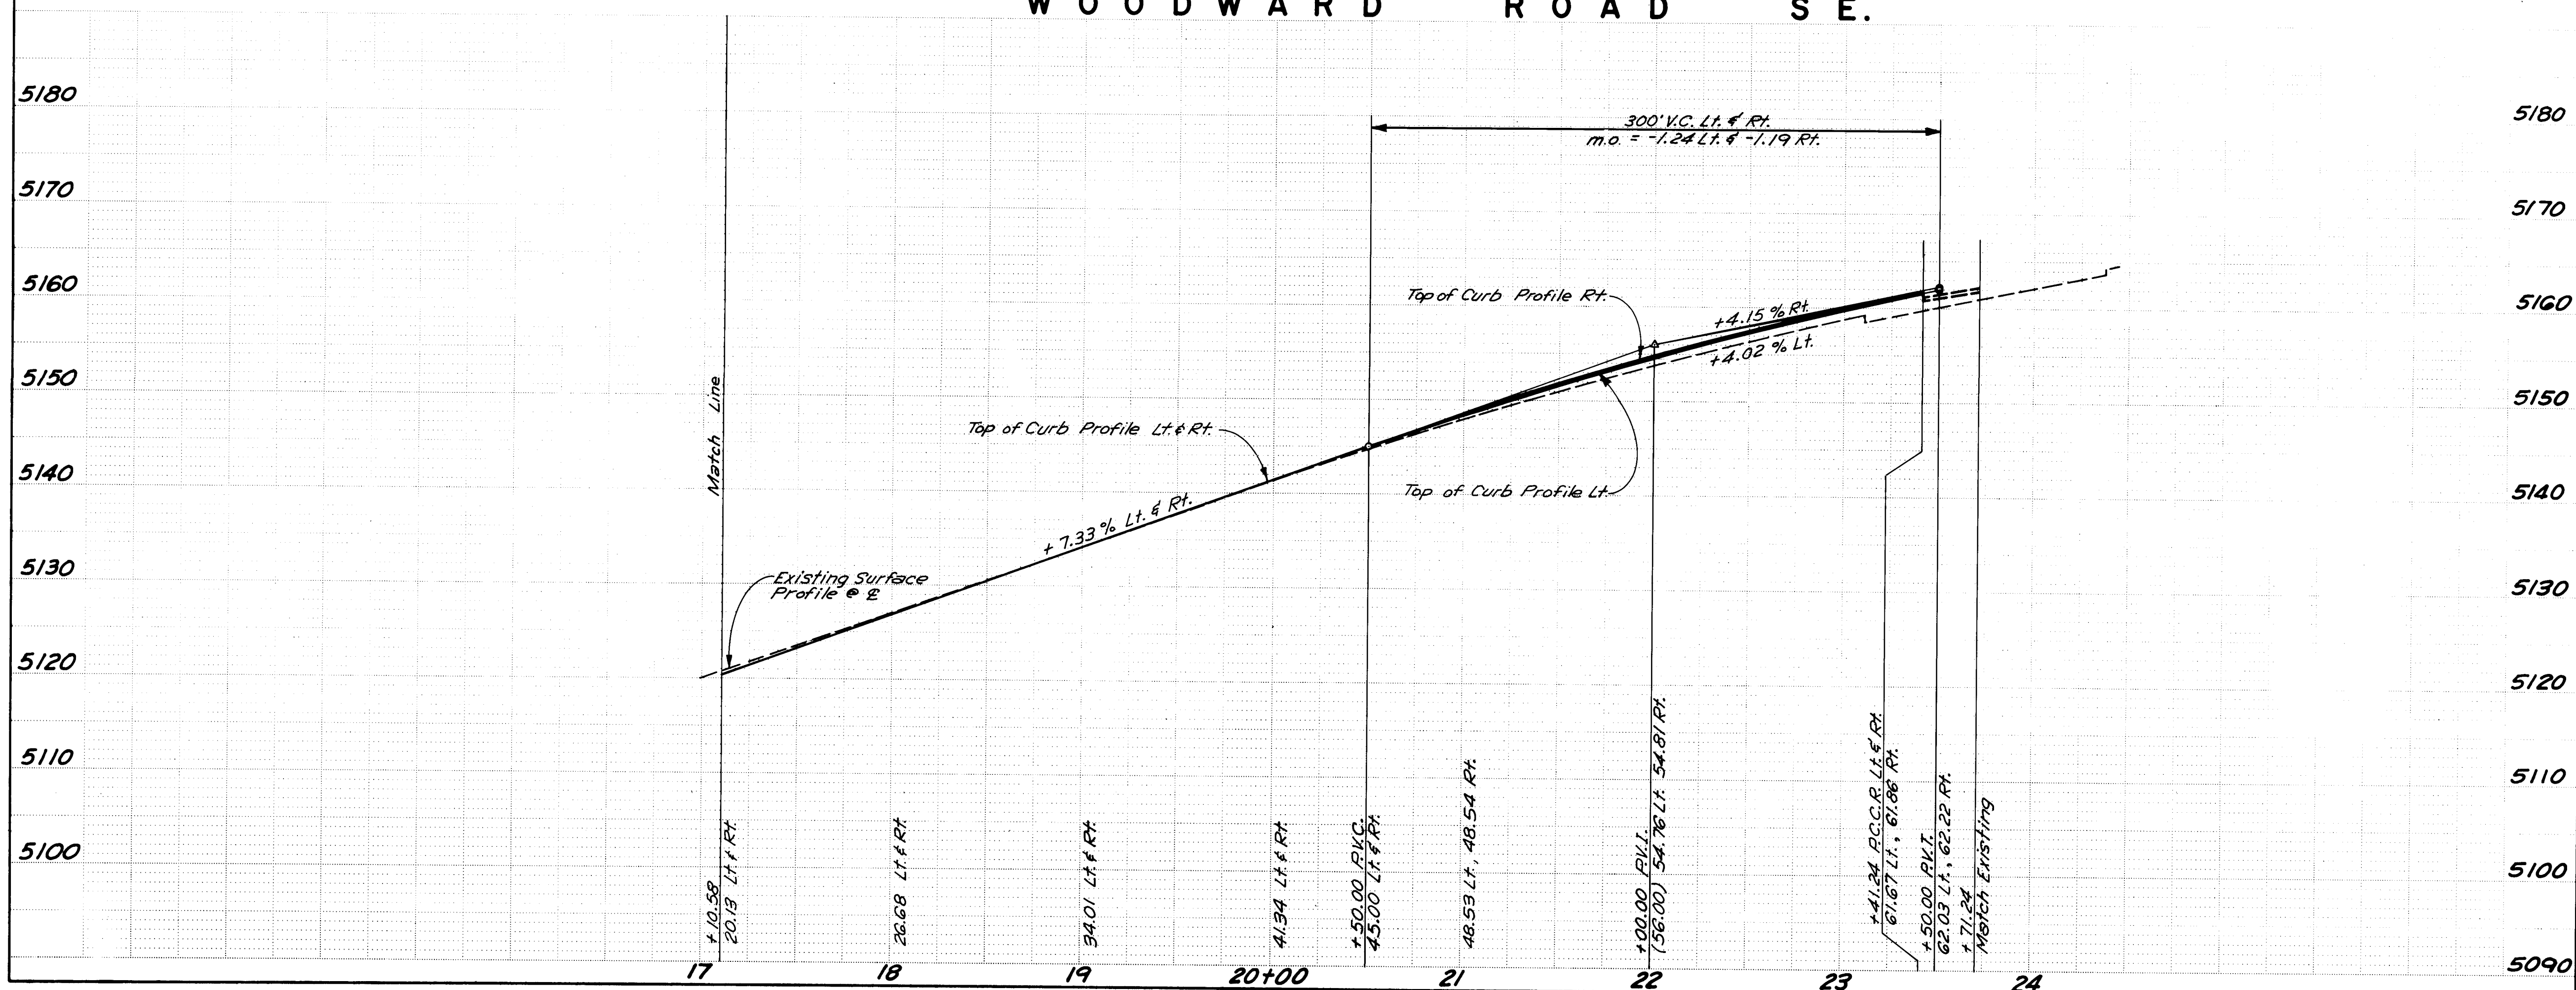

WOODWARD ROAD SE.

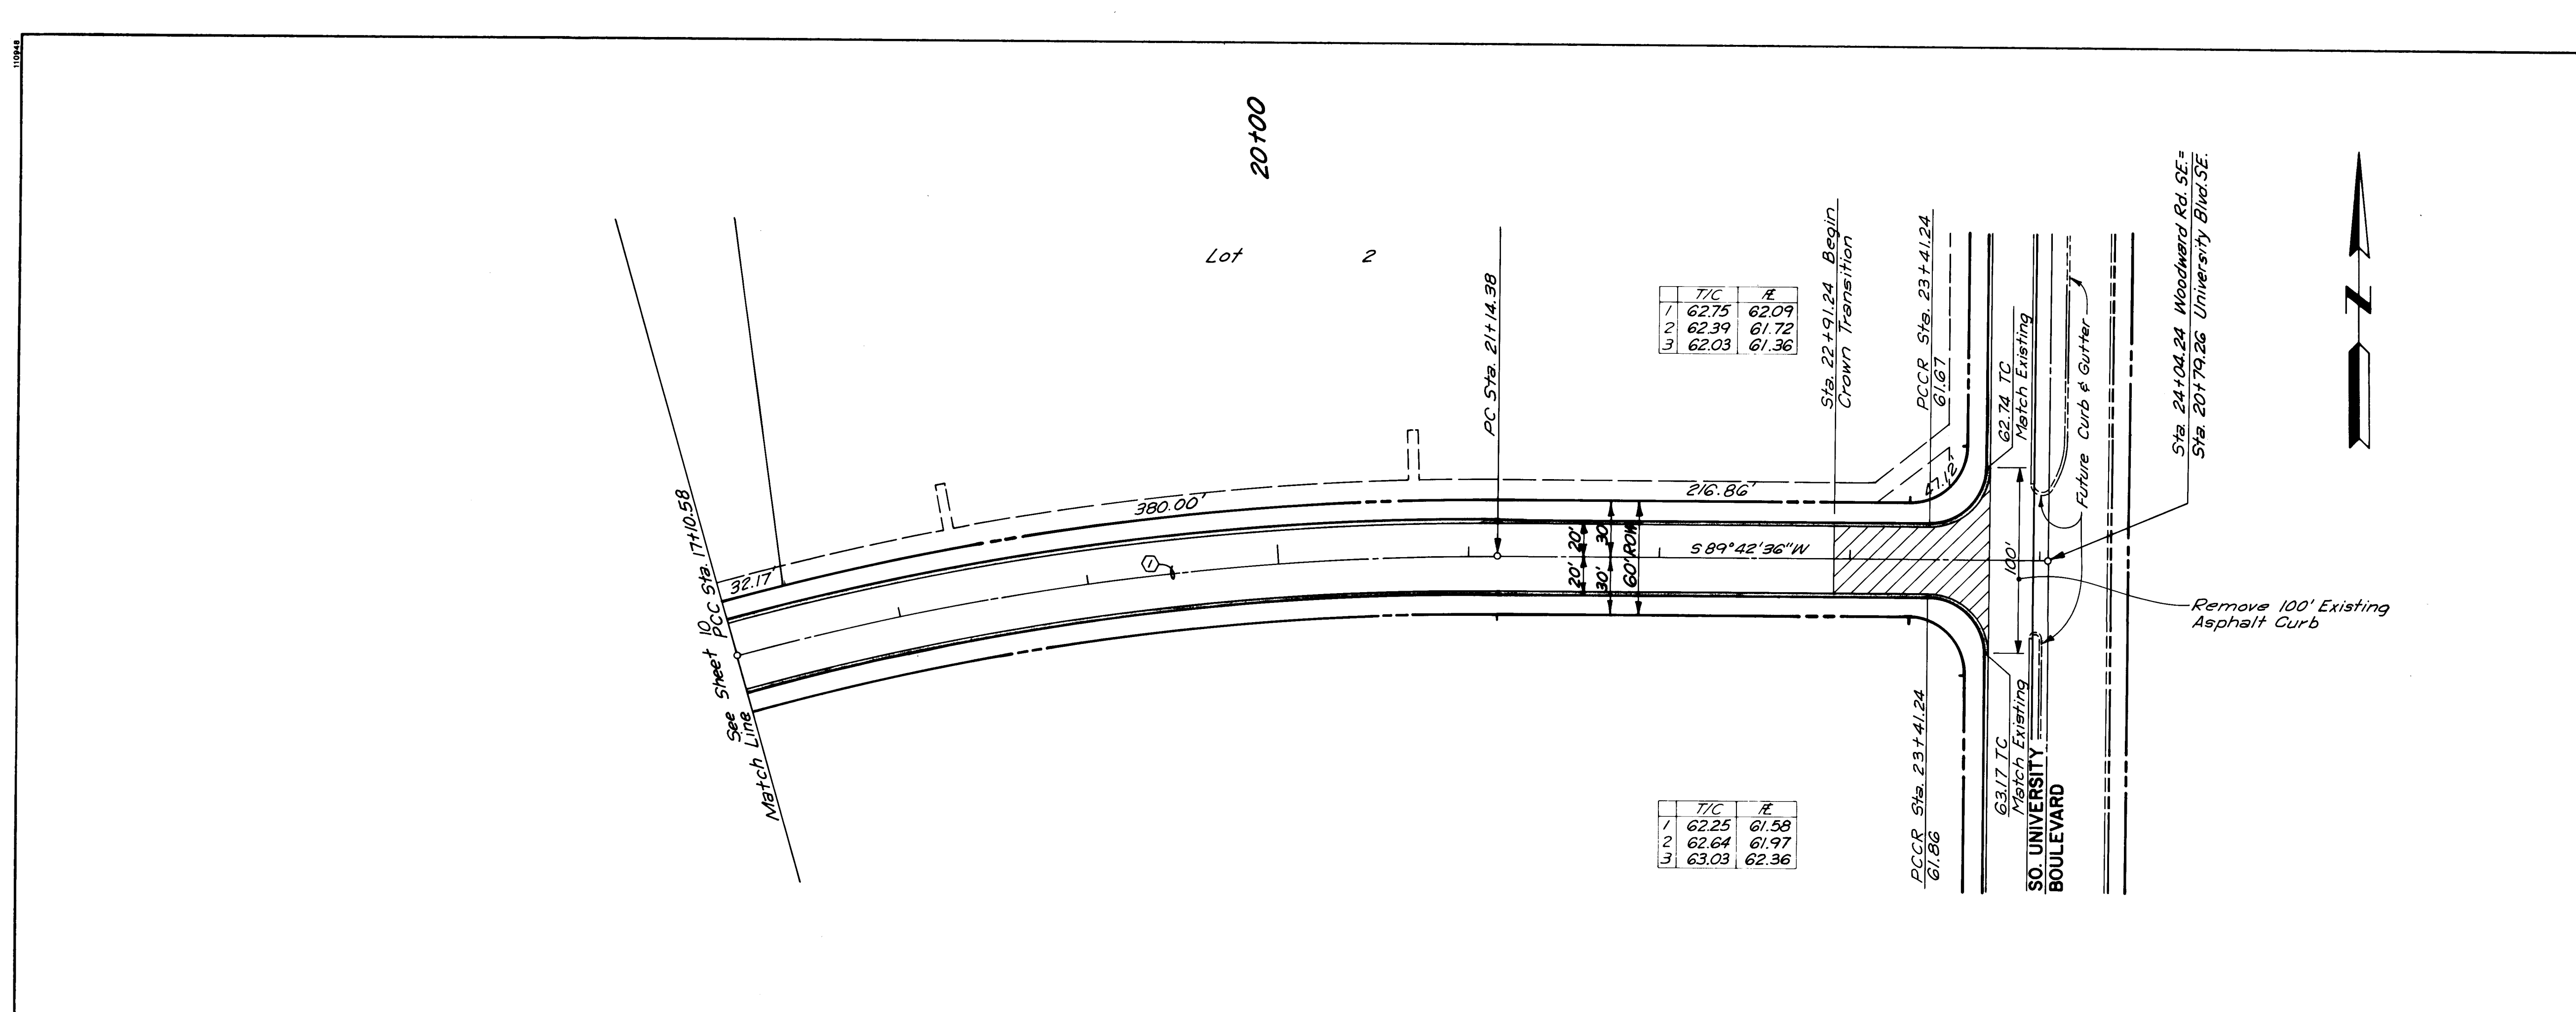

CURVE DATA

$\Delta = 15^\circ 58' 41''$
$R = 1448.00'$
$L = 403.80'$
$T = 203.22'$

John A. Anderson
RECORD DRAWING
2-8-89


CITY OF ALBUQUERQUE
PUBLIC WORKS DEPARTMENT

SUNPORT PARK
INFRASTRUCTURE IMPROVEMENTS - PHASE I
PAVING PLAN & PROFILE
WOODWARD ROAD SE.

APPROVALS	ENGINEER	DATE	APPROVALS	ENGINEER	DATE
D.R.C. Chair					
Trans. Dev					
Utility Dev					


DRAWING NO. **2950** MAP NO. **M-15** SHEET **11** OF **26**

ENGINEER'S SEAL		SURVEY INFORMATION		BENCH MARKS		AS BUILT INFORMATION	
		FIELD NOTES		STATIONING		CONTRACTOR	
		NO.	BY	DATE	NO.	NO.	NO.
REVISIONS		NO.		DATE		DATE	
DESIGN		NO.		DATE		DATE	
DRAWN BY		NO.		DATE		DATE	
CHECKED BY		NO.		DATE		DATE	

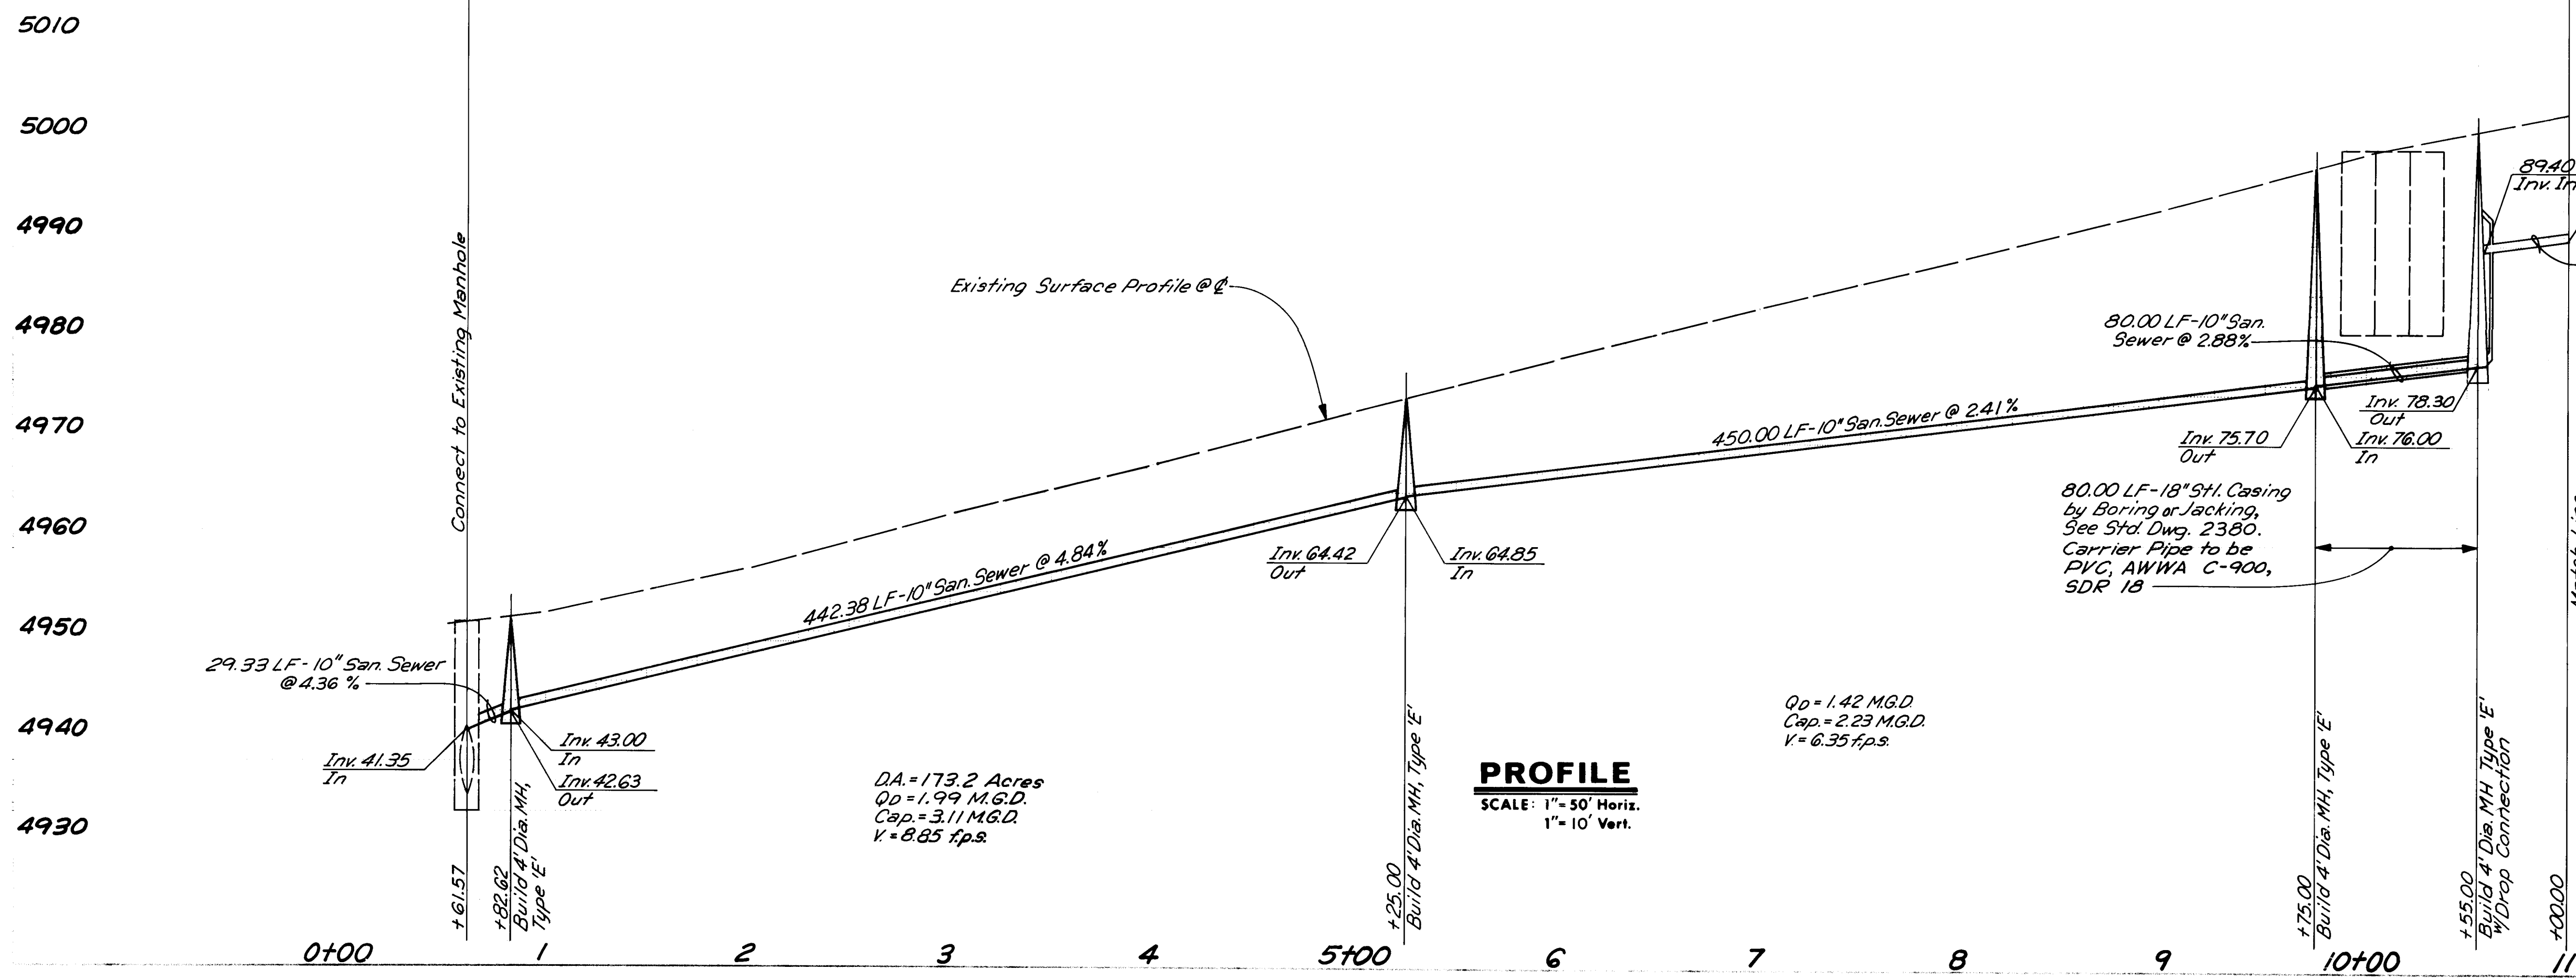

PLAN
SCALE: 1" = 50'

PROFILE
SCALE: 1" = 50' Horiz.
1" = 10' Vert.

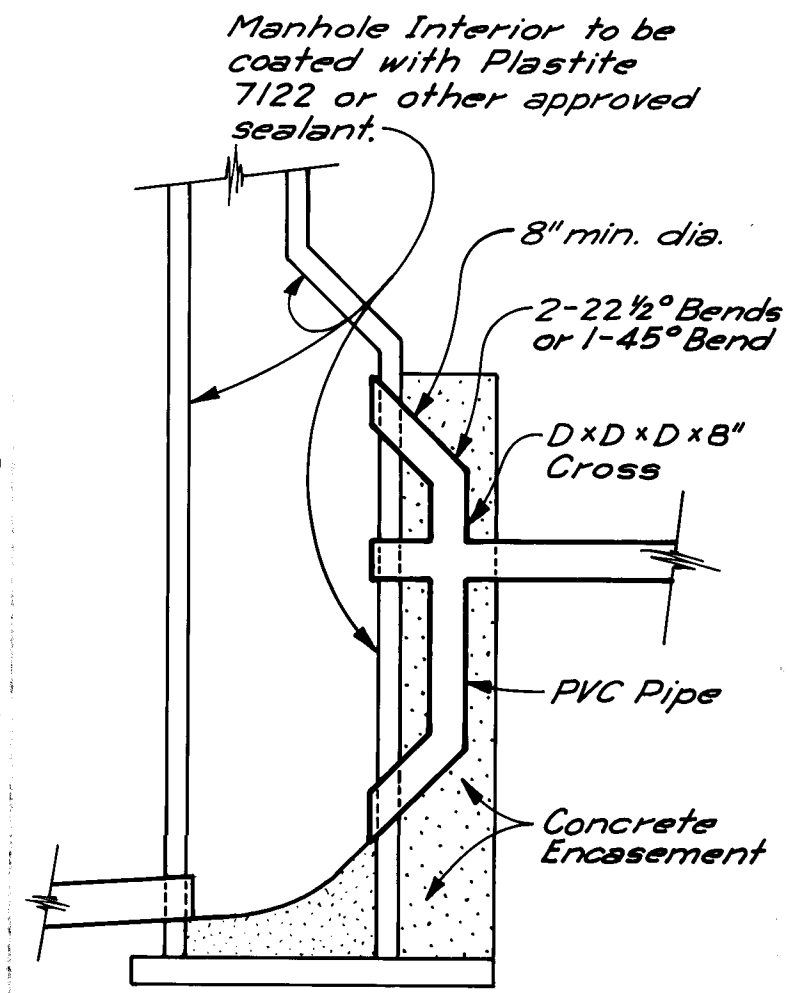

SANITARY MANHOLE
WITH DROP CONNECTION
NO SCALE

SUNPORT PARK
INFRASTRUCTURE IMPROVEMENTS-PHASE I
SANITARY SEWER PLAN & PROFILE
WOODWARD ROAD SE.

STA. "1-25-31" ELEVATION 5062.528
STANDARD MNSHC BRASS TABLET SET IN CONCRETE
POST LOCATED AT THE NORTHEAST CORNER OF
THE HIGHWAY I-25 BRIDGE CROSSING OVER AN
ABANDONED RAILROAD SPUR LINE APPROXIMATELY
1.15 MILES NORTH OF RIO BRAVO BOULEVARD



New Concepts, Inc.
1-88
12-88
2-89
1-89
AA&P
RE
AA&P

REGISTERED PROFESSIONAL ENGINEER
STATE OF NEW MEXICO
No. 1060
JOHN LANDAU
ANDREWS, ASBURY & ROBERT, INC.
CONSULTING ENGINEERS
88-450
ALBUQUERQUE, NEW MEXICO

Feb., 1987
Feb., 1987
Feb., 1987
REVISIONS
DESIGN
JM
CB, JCS
JA, RF

RECORD DRAWING
2-8-89

4/25/87
5/2/87
5/2/87
5/2/87

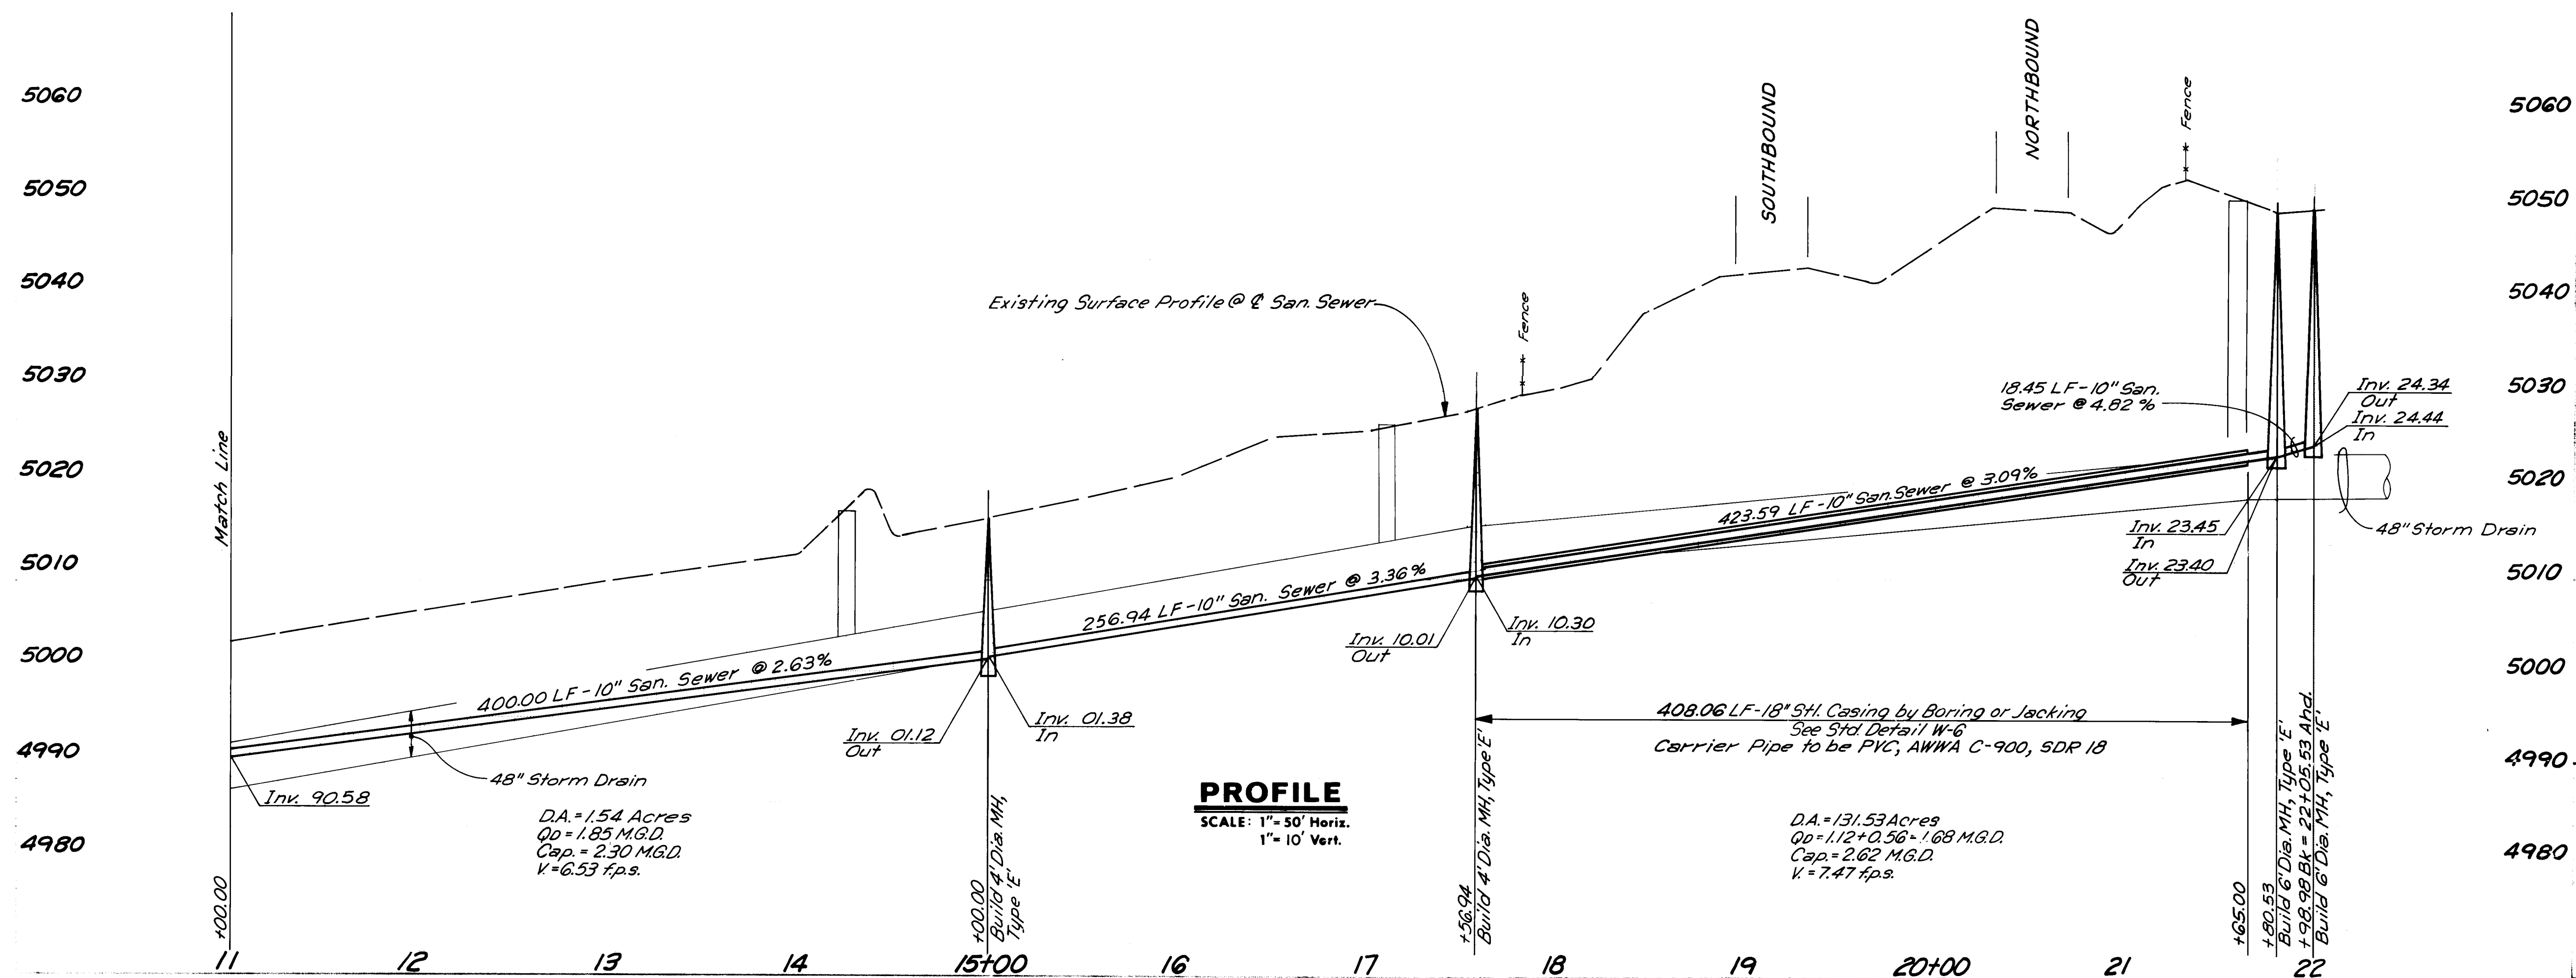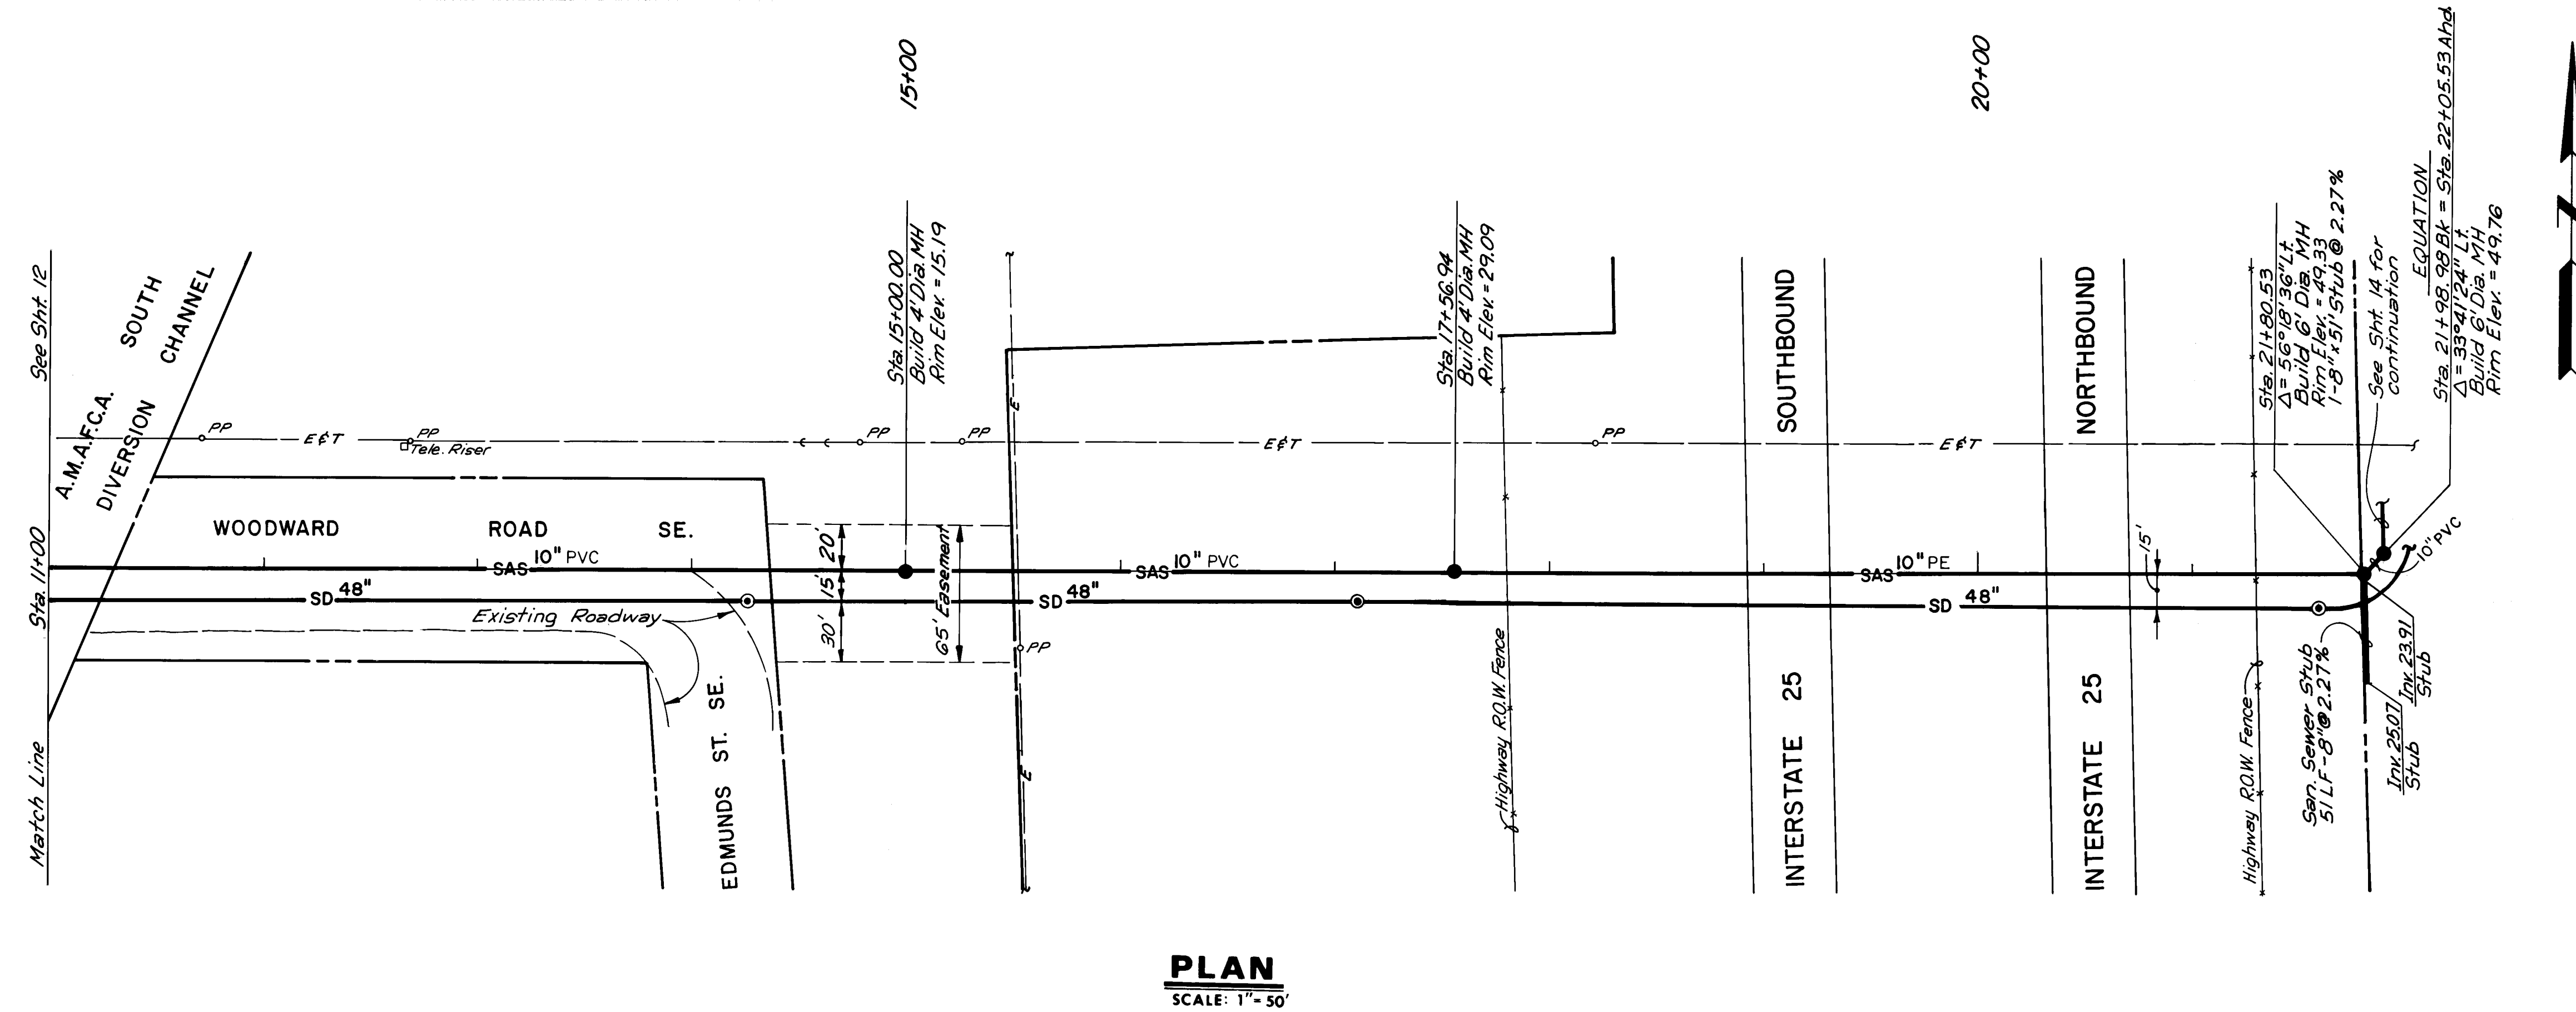

John A. Andrew
RECORD DRAWING
2-8-89

**SUNPORT PARK
INFRASTRUCTURE IMPROVEMENTS-PHASE I
SANITARY SEWER PLAN & PROFILE
WOODWARD ROAD SE.**

Admittance 6/25/87
NADWH 5/22/87
25 taught 5-22-87


DRAWING NO	2950	MAP NO	M-15	SHEET	13	OF	26
---------------	------	--------	------	-------	----	----	----

STA. "1-25-31" ELEVATION 5602.528
STANDARD INMSHC BRASS TABLET SET IN CONCRETE
POST LOCATED AT THE NORTHEAST CORNER OF
THE HIGHWAY 1-25 BRIDGE CROSSING OVER AN
ABANDONED RAILROAD SPUR LINE APPROXIMATELY
1.15 MILES NORTH OF RIO BRAVO BOULEVARD




ANDREWS, ASBURY & ROBERT, INC.
CONSULTING ENGINEERS
85-415D
ALBUQUERQUE — NEW MEXICO

Author	Year
JM	Feb., 1987
CB, JCS	Feb., 1987
IA, RF	Feb., 1987

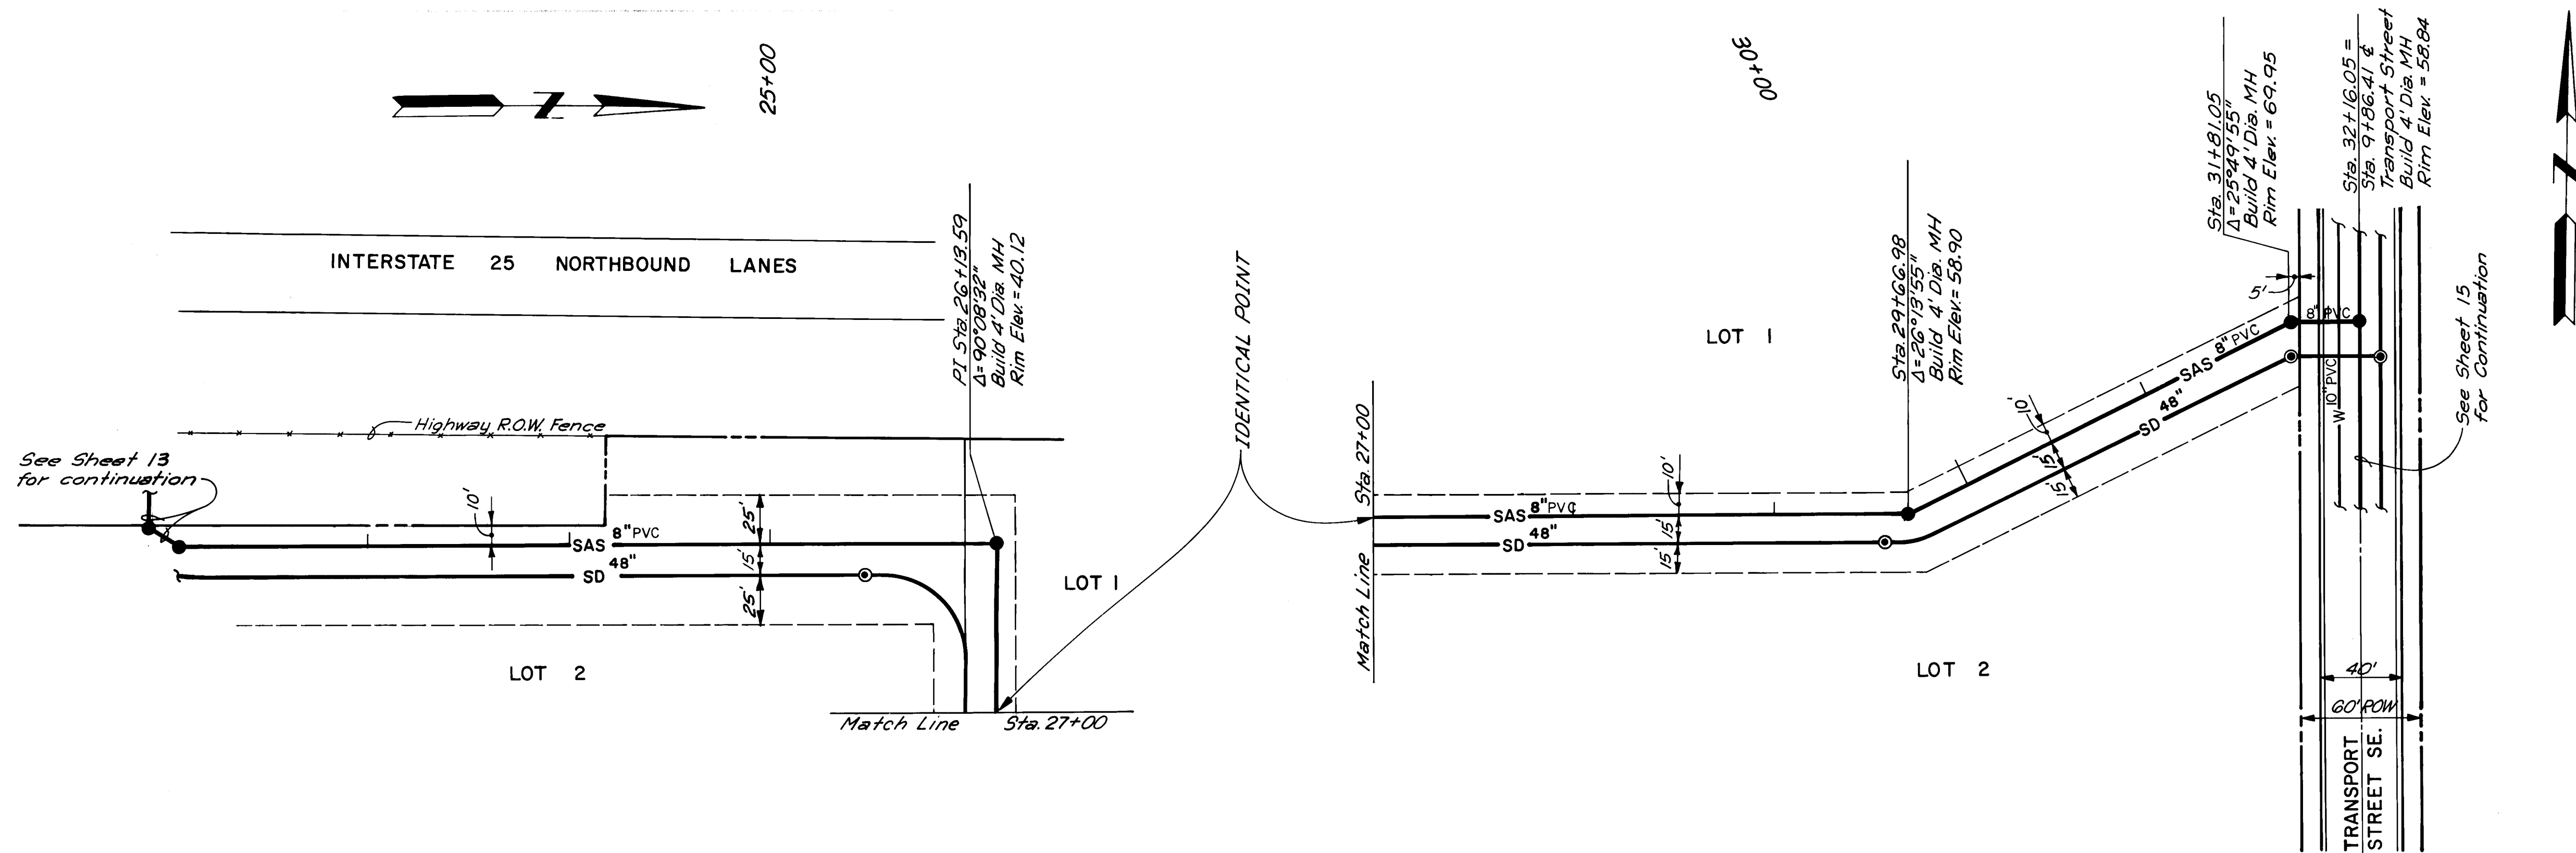

PLAN
SCALE: 1" = 50'

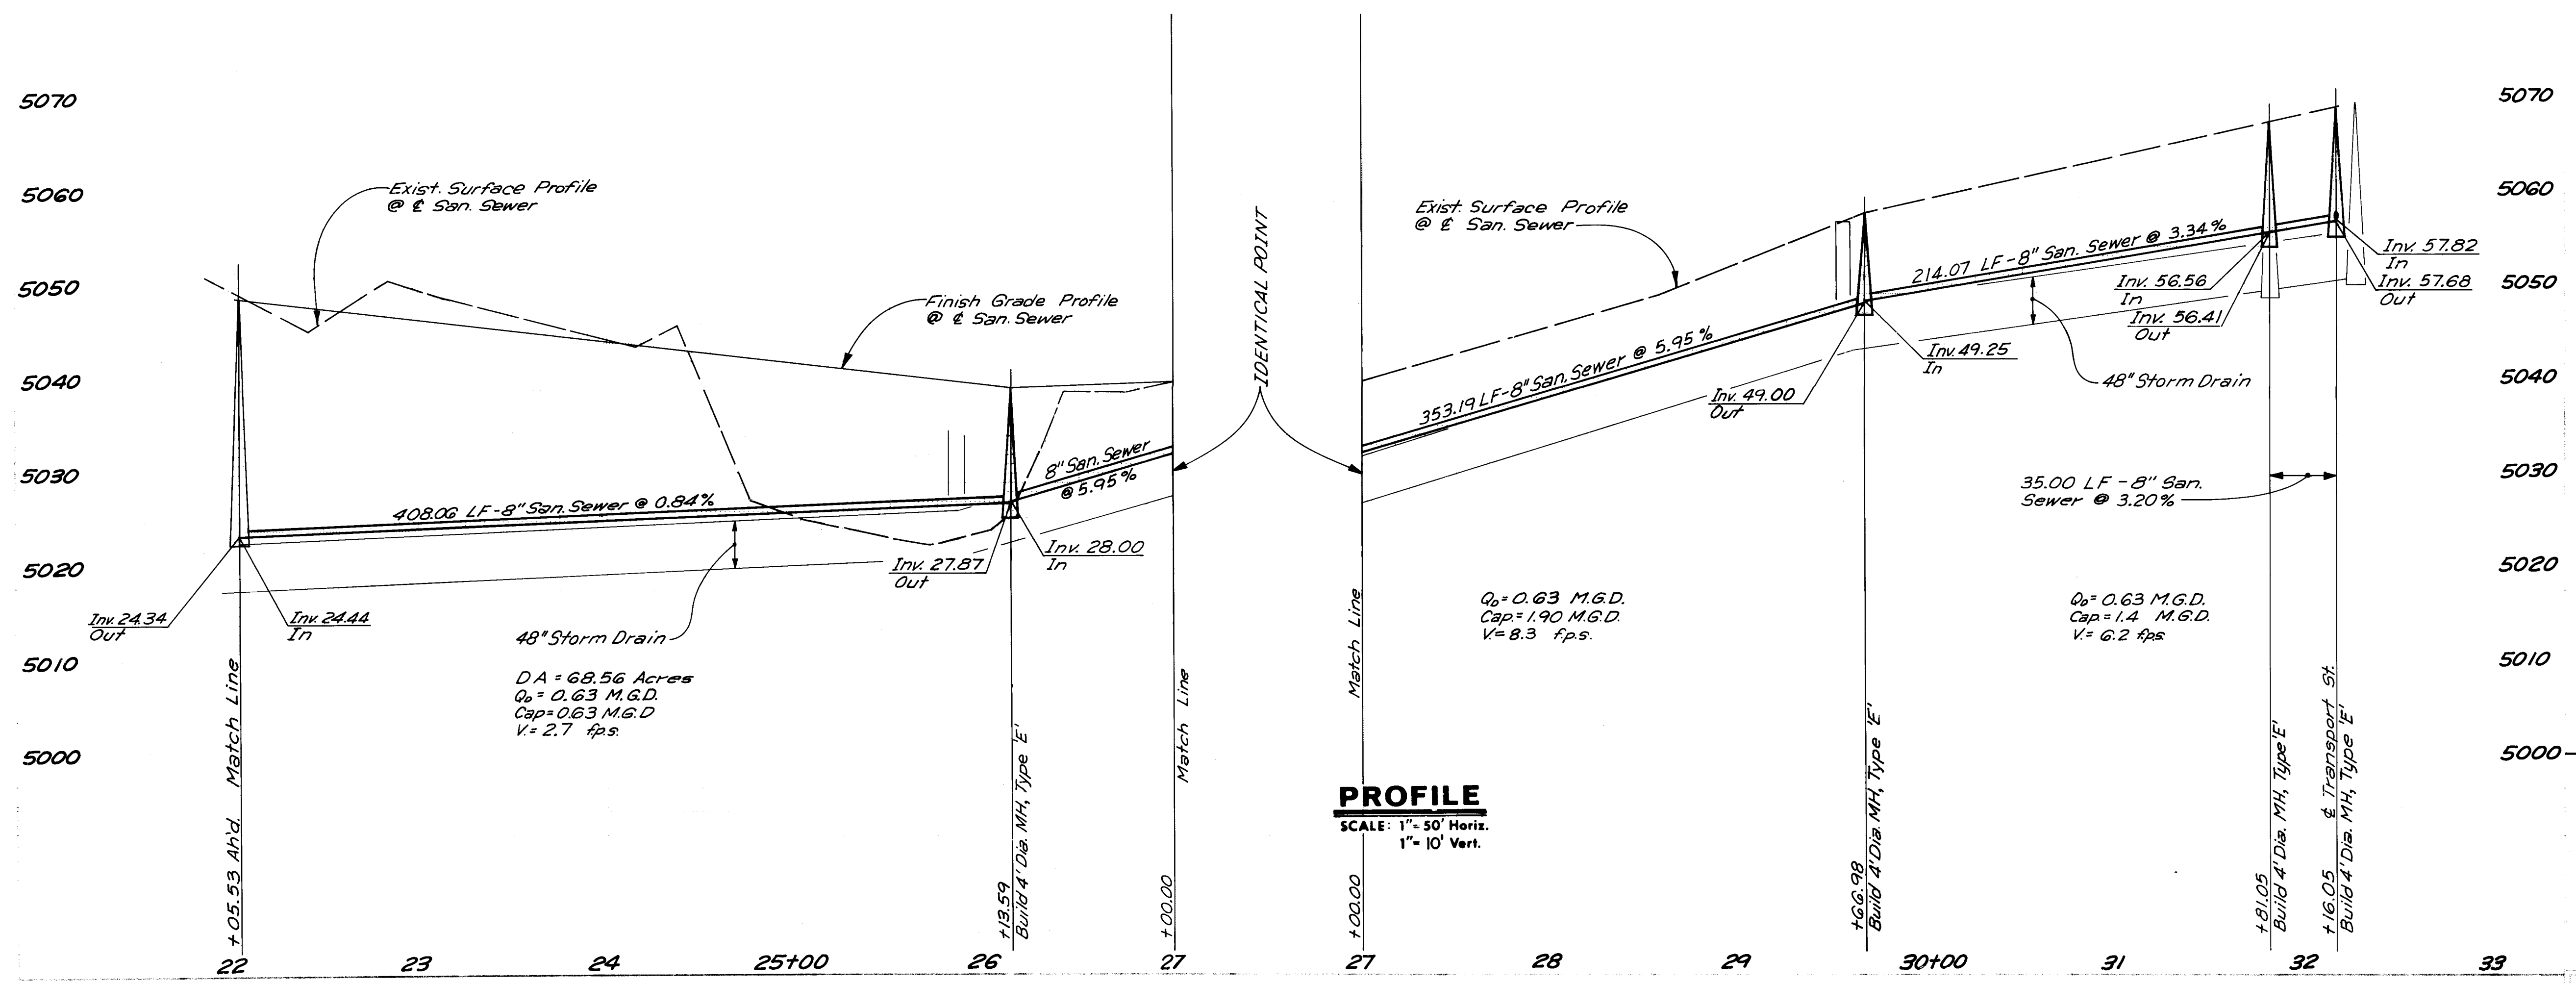

PROFILE
SCALE: 1" = 50' Horiz.
1" = 10' Vert.

John A. Andrews
RECORD DRAWING
2-8-89

**SUNPORT PARK
INFRASTRUCTURE IMPROVEMENTS - PHASE I**
SANITARY SEWER PLAN & PROFILE
OUTFALL

Handwritten notes and signatures

New Concepts Inc. 09
AA&P 12-98
RE 2-89
AA&P 1-89

STA. "I-25-31" ELEVATION 5062.528
STANDARD MMSHC BRASS TABLET SET IN CONCRETE
POST LOCATED AT THE NORTHEAST CORNER OF
THE HIGHWAY 1-25 BRIDGE CROSSING OVER AN
ABANDONED RAILROAD SPUR LINE APPROXIMATELY
1.15 MILES NORTH OF RIO BRAVO BOULEVARD


PROFESSIONAL ENGINEER
STATE OF NEW MEXICO
JOHN A. ANDREWS
ANDREWS, ASBURY & ROBERT, INC.
CONSULTING ENGINEERS
85-415D NEW MEXICO

March, 1987
March, 1987
March, 1987

REMARKS:
REVISIONS
BY J.A.A.
DATE

JM
CB, JCS
JA, RF

11994

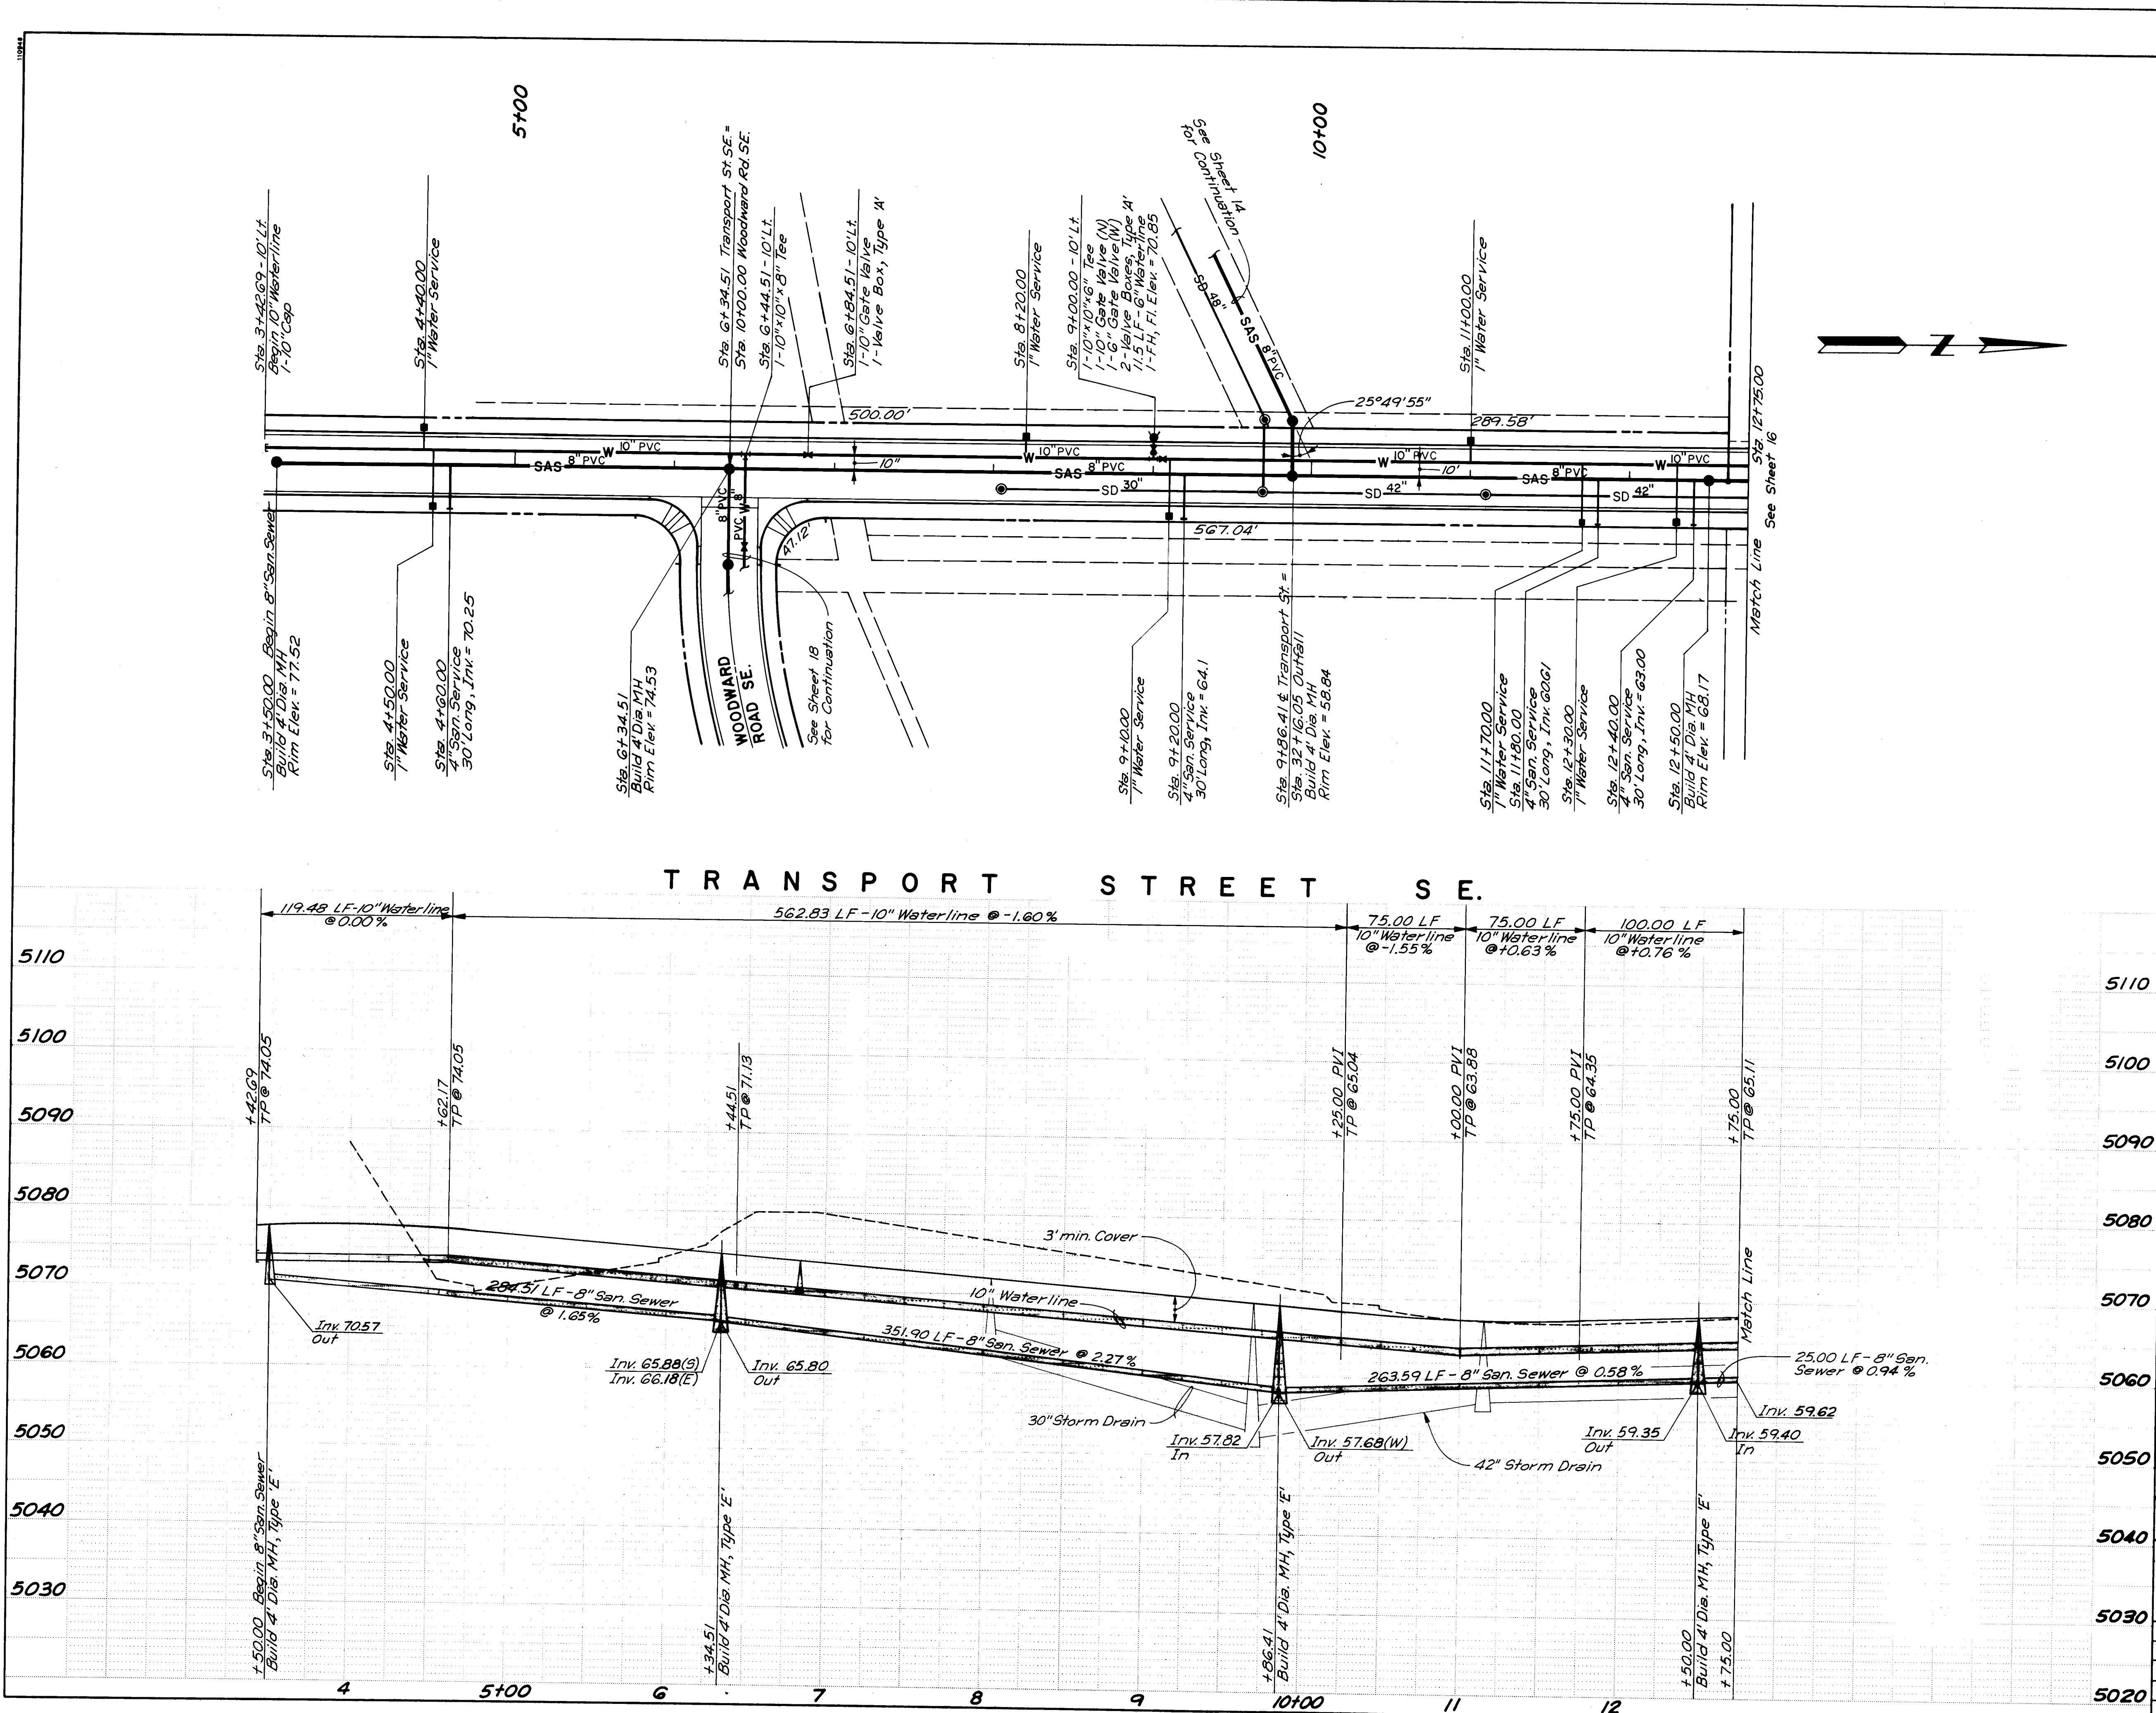

John A. Andrews
RECORD DRAWING
2-8-89

26 29501589

CITY OF ALBUQUERQUE PUBLIC WORKS DEPARTMENT					
SUNPORT PARK INFRASTRUCTURE IMPROVEMENTS - PHASE I WATER & SANITARY SEWER PLAN & PROFILE TRANSPORT STREET SE.					
APPROVALS		ENGINEER	DATE	APPROVALS	
D.R.C. Chair				ENGINEER	
Trans. Dev.					
Utility Dev.					
DRAWING NO.		MAP NO.		SHEET OF	
2950		M-15		15 26	

DESIGNED BY JA, RF		DATE Oct, 1987
DRAWN BY CB, JCS		DATE Oct, 1987
CHECKED BY JA, RF		DATE Oct, 1987



REVISIONS	
NO.	DATE
1	12-7-88
REMARKS	
Extend Water & San Sewer to South A.A.P.	

ENGINEER'S SEAL	
ANDREWS, ASHLEY & ROBERT, INC. ALBUQUERQUE, NEW MEXICO	

SURVEY INFORMATION	
FIELD NOTES	DATE
NO.	BY
STANDARD MNSHC BRASS TABLET SET IN CONCRETE POST LOCATED AT THE NORTHEAST CORNER OF THE HIGHWAY 1-25 BRIDGE CROSSING OVER AN ABANDONED RAILROAD SPUR LINE APPROXIMATELY 1.15 MILES NORTH OF RIO BRAVO BOULEVARD	

BENCH MARKS	
STA. "1-25-31"	ELEVATION 502.528

AS BUILT INFORMATION	
CONTRACTOR	NEW CONCEPTS, INC.
INSPECTOR	AA&P
DATE	12-8-88
FILED BY	AA&P
DATE	2-8-89
VERIFICATION BY	AA&P
DATE	1-1-89
MICRO-FILM INFORMATION	
RECORDED BY	NO
DATE	


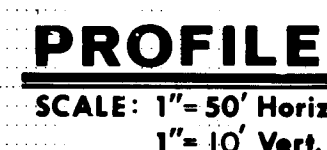
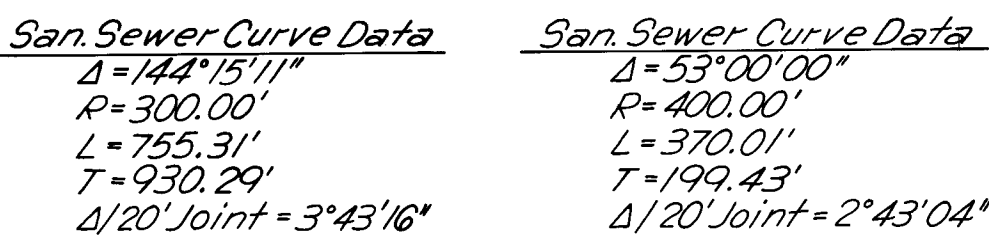


John A. Andrews
RECORD DRAWING
2-8-89

[illegible]

10944

5130
5120
5110
5100
5090
5080
5070
5060
5050

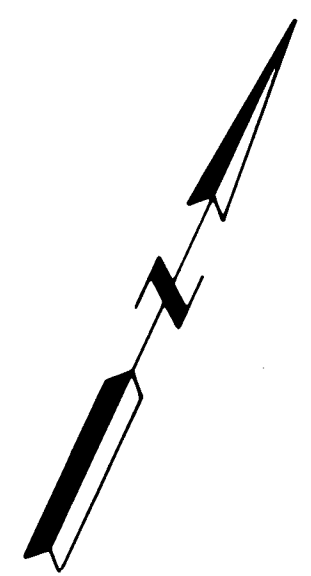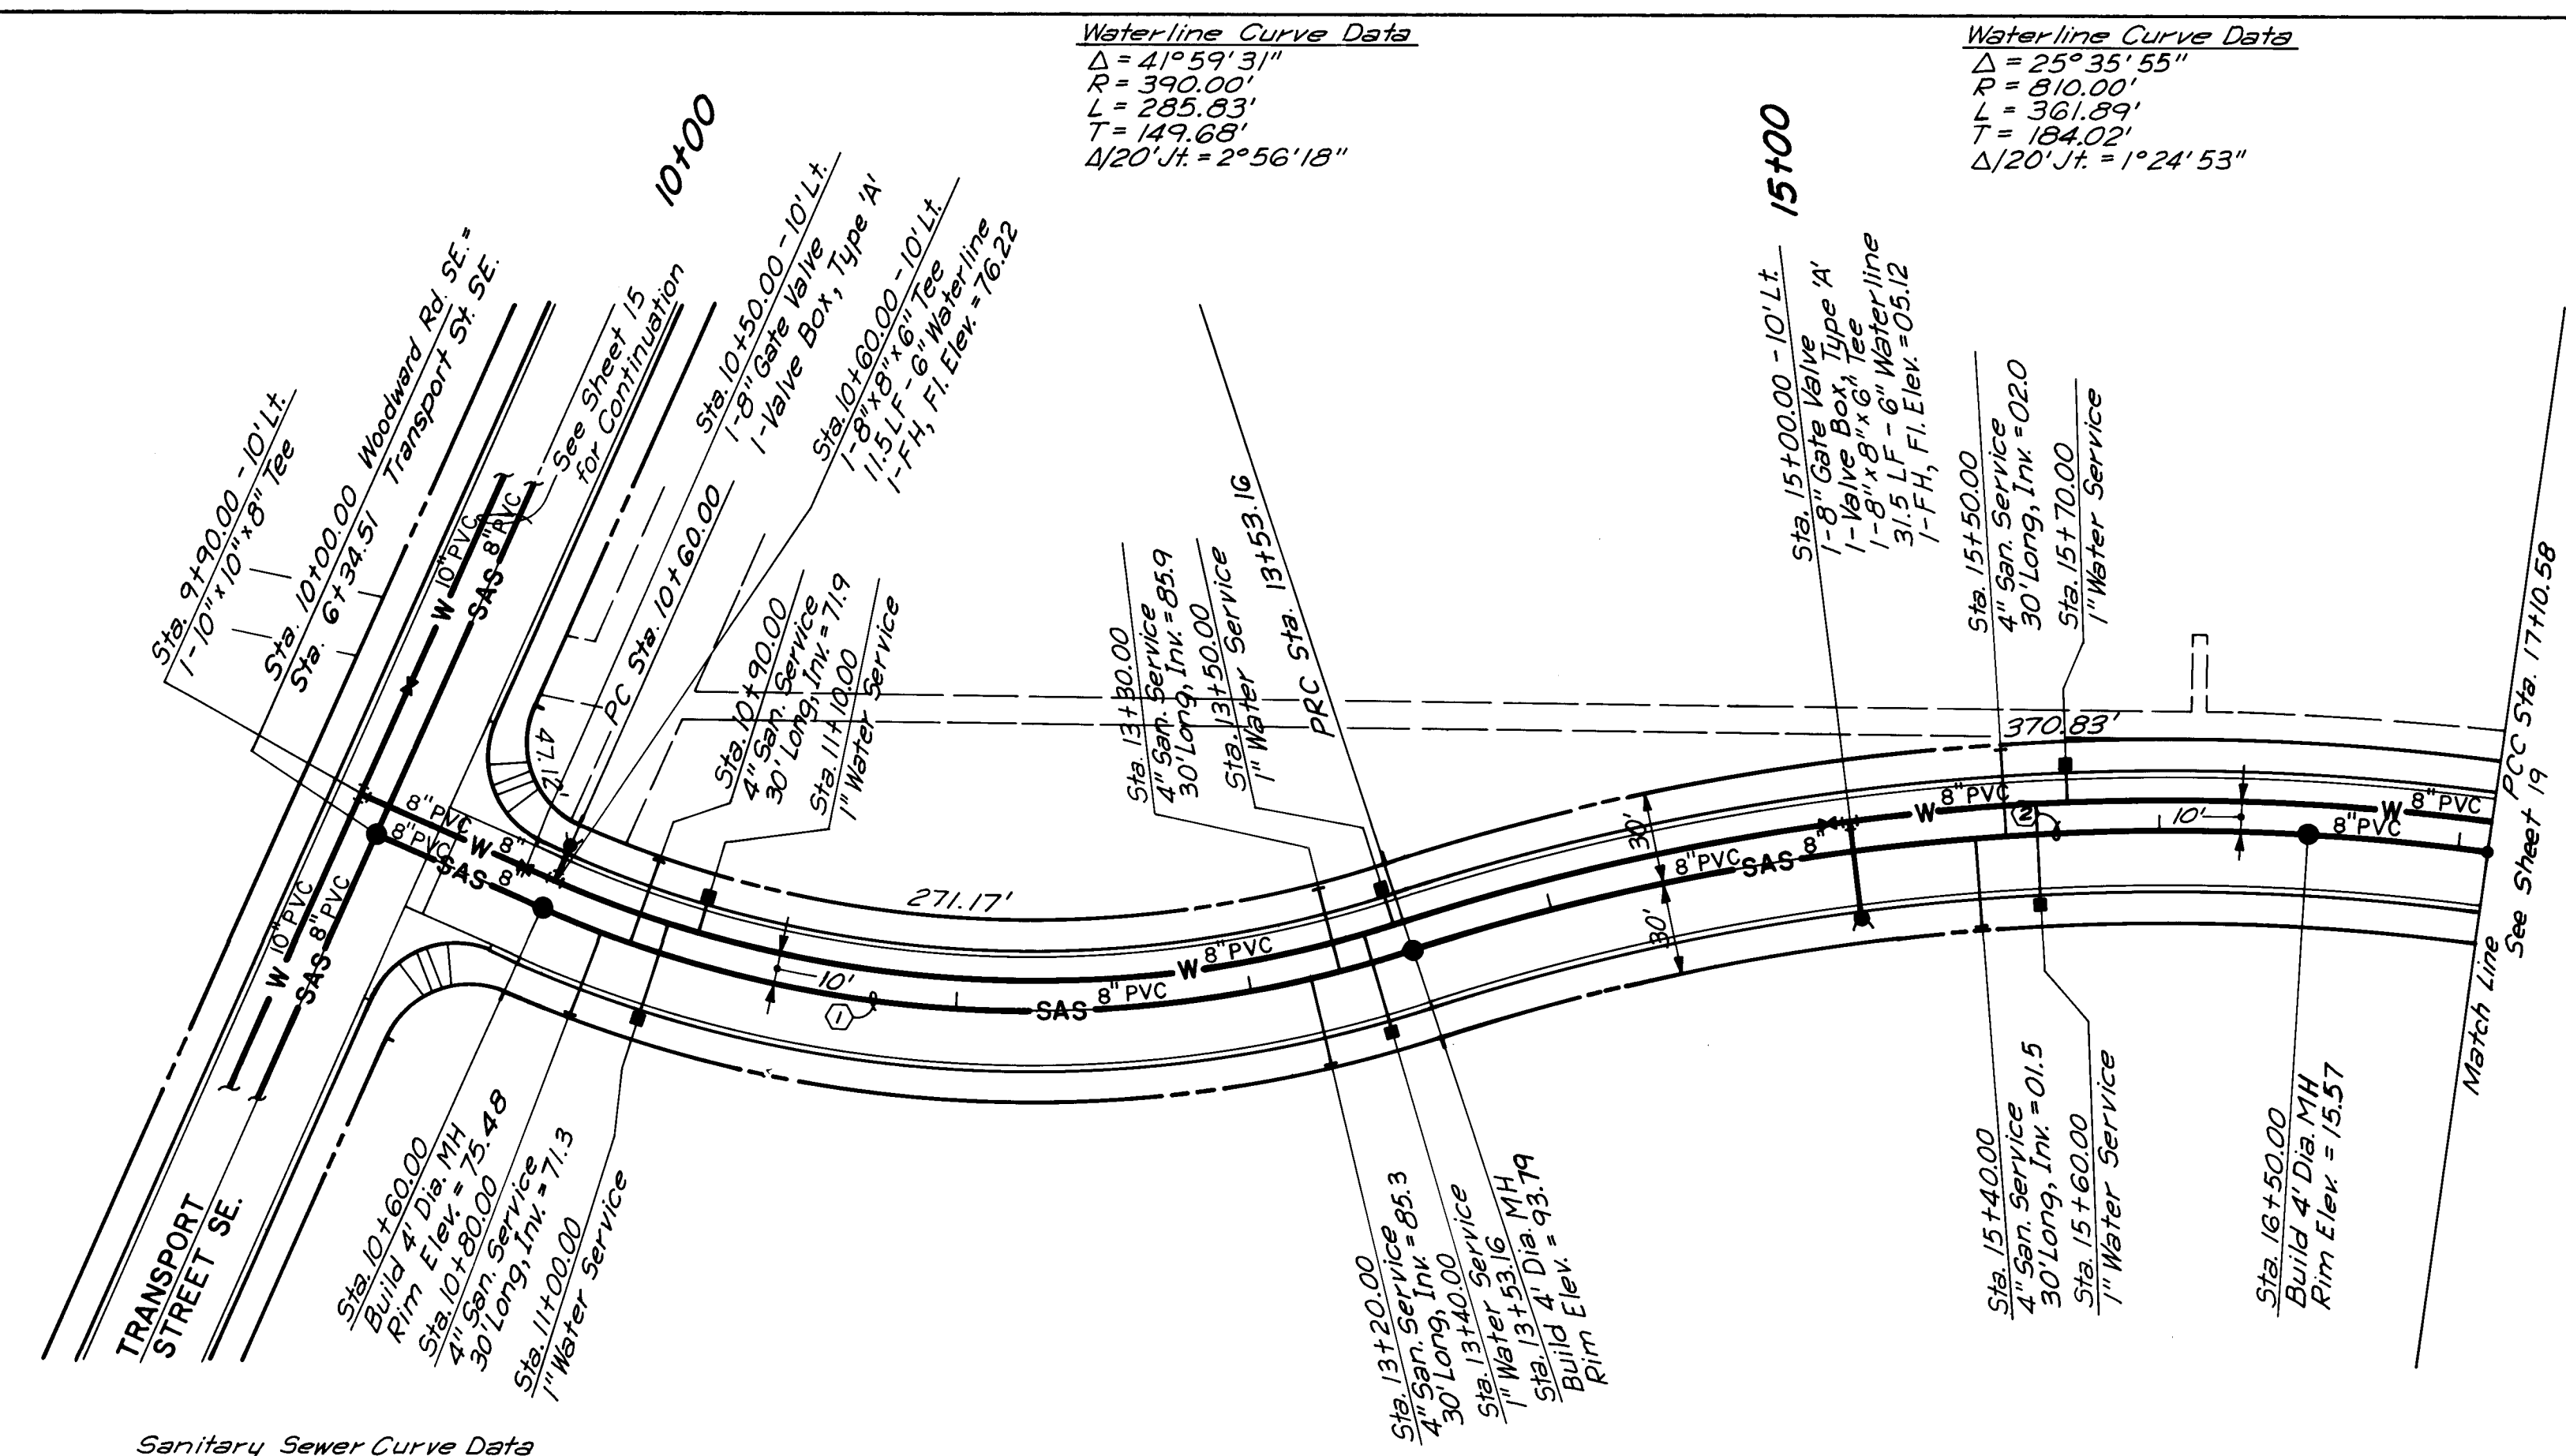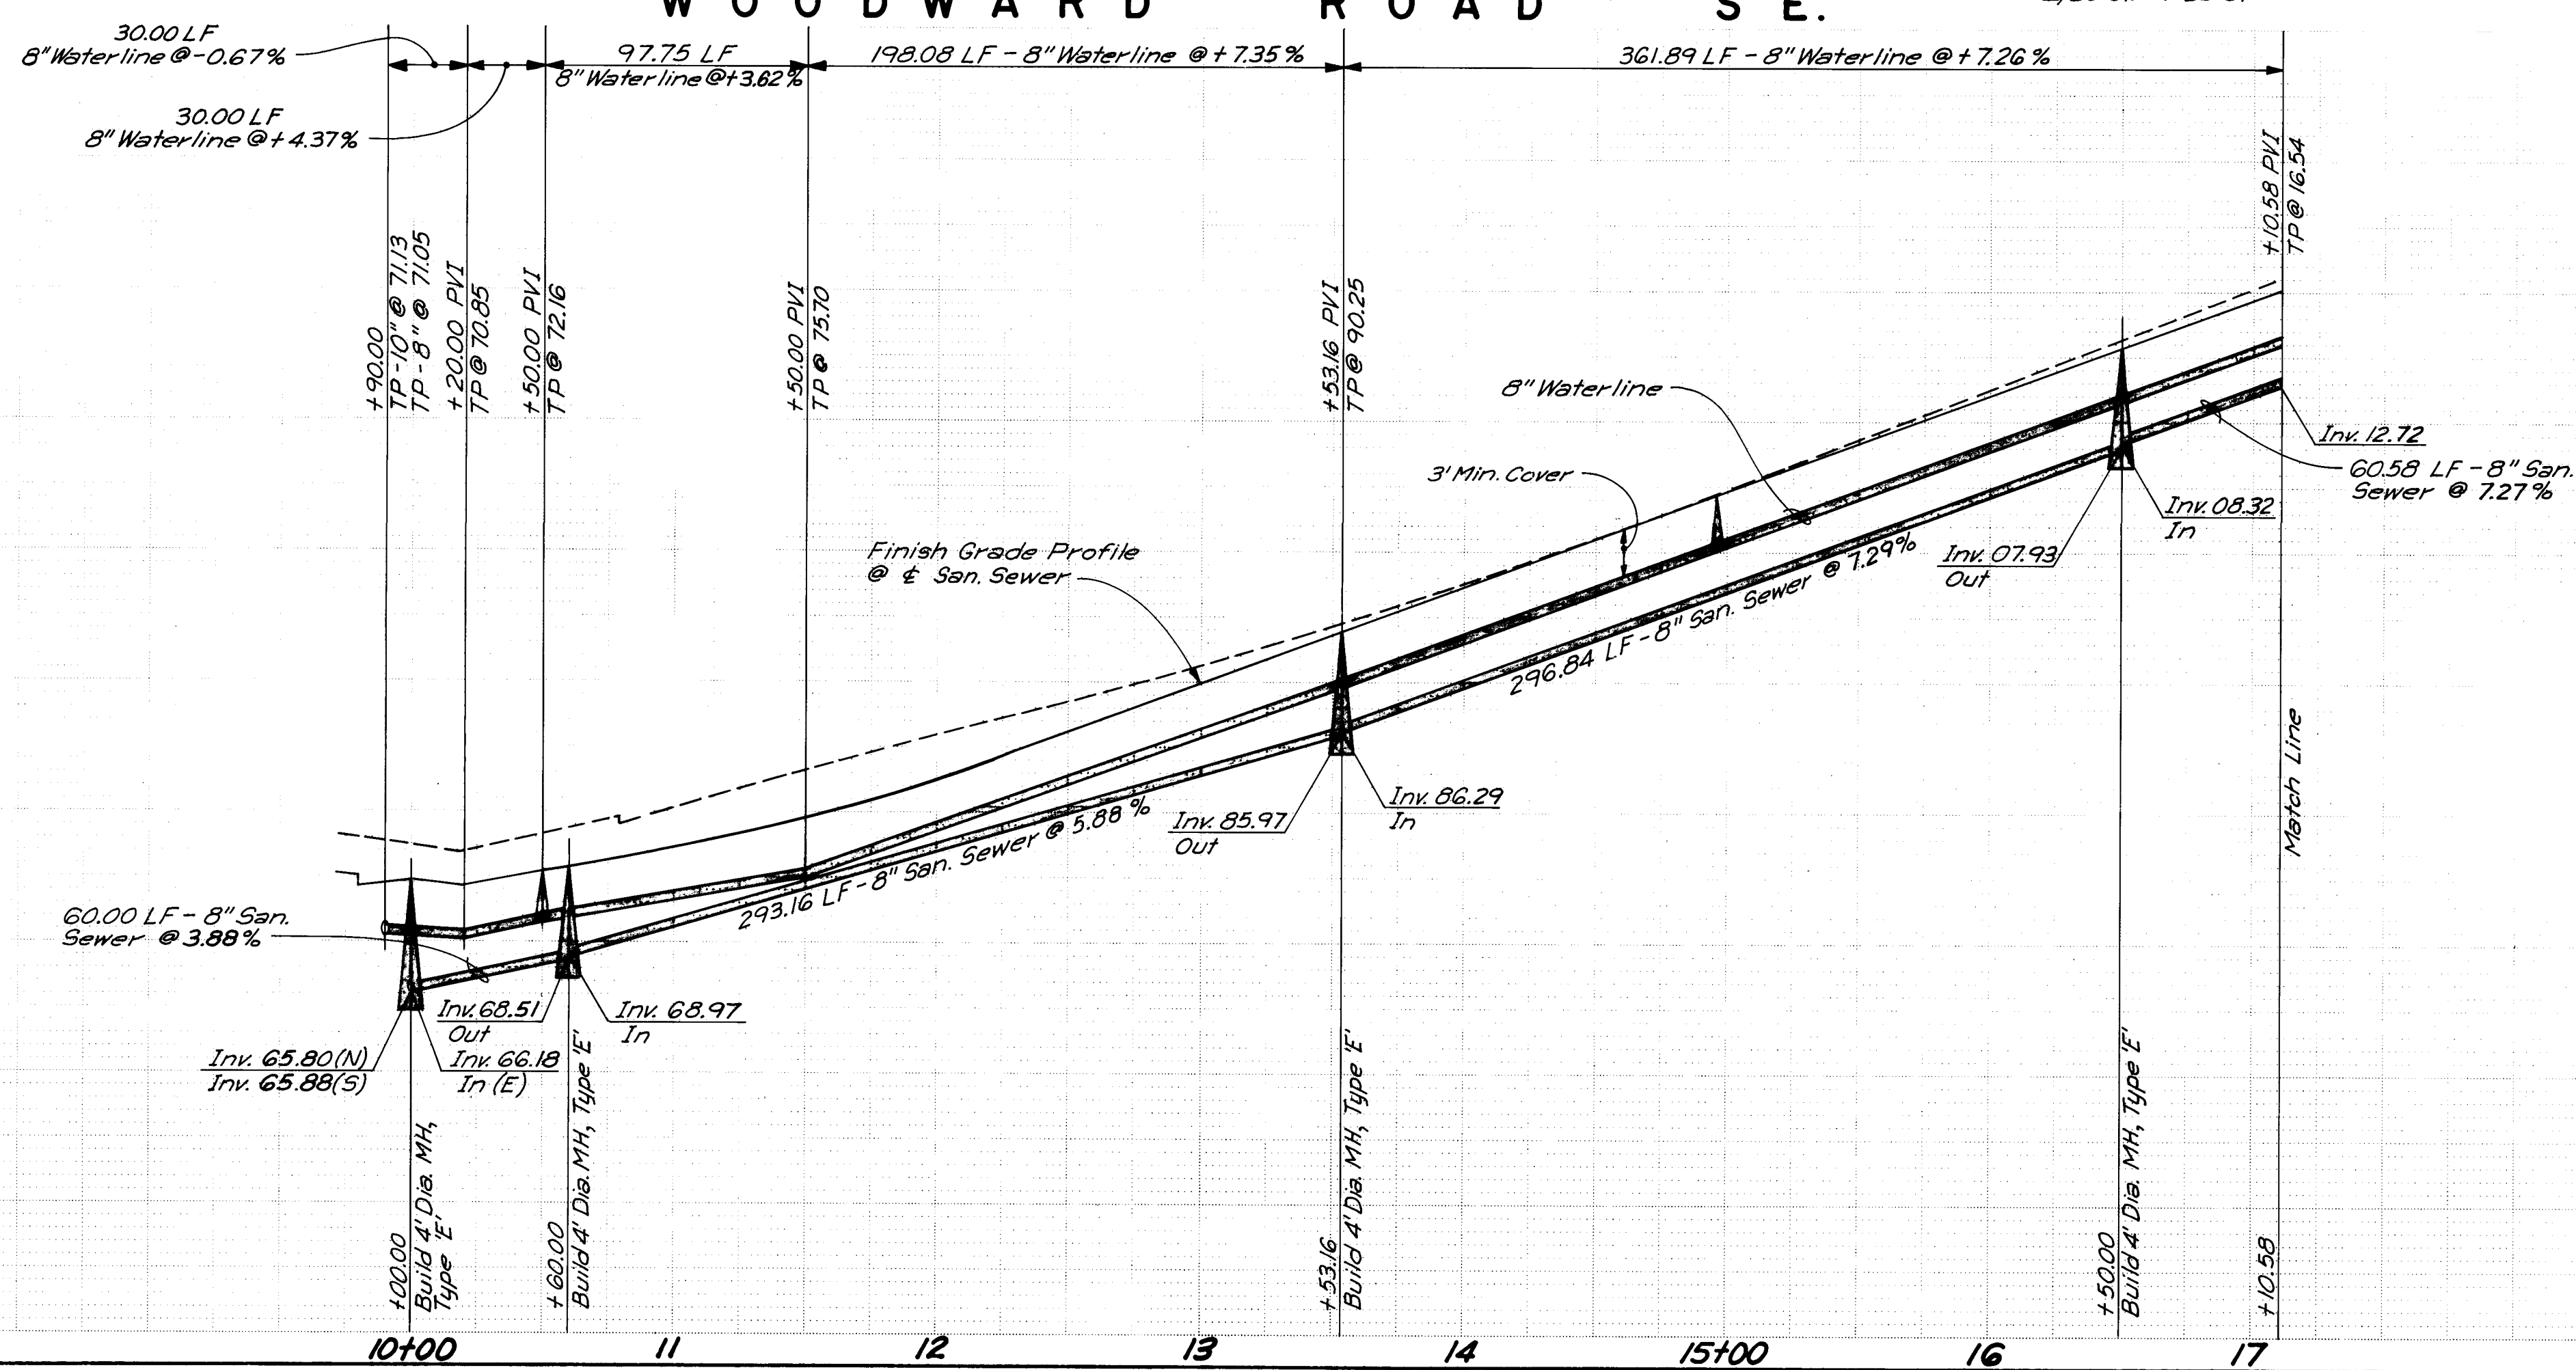

CURVE DATA
① Δ = 41° 59' 31"
R = 400.00'
L = 293.16'
T = 153.51'
② Δ = 25° 35' 55"
R = 800.00'
L = 357.42'
T = 181.75'

John A. Andrews
RECORD DRAWING
1-8-89


26 2950 1889

CITY OF ALBUQUERQUE PUBLIC WORKS DEPARTMENT					
SUNPORT PARK INFRASTRUCTURE IMPROVEMENTS-PHASE I WATER & SANITARY SEWER PLAN & PROFILE WOODWARD ROAD SE.					
APPROVALS	ENGINEER	DATE	APPROVALS	ENGINEER	DATE
D.R.C. Chair					
Trans. Dev.					
Utility Dev.					
DRAWING NO. 2950		MAP NO. M-15		SHEET 18 OF 26	

ENGINEER'S SEAL		REVISIONS		DESIGN		DATE	
		NO.	DATE	BY	DATE	NO.	DATE
REMARKS		DESIGN		DATE Oct. 1987		DATE Oct. 1987	
DRAWN BY		C.B. JCS		DATE Oct. 1987		DATE Oct. 1987	
CHECKED BY		JA		DATE Oct. 1987		DATE Oct. 1987	
AS BUILT INFORMATION		BENCH MARKS		SURVEY INFORMATION		MICRO-FILM INFORMATION	
CONTRACTOR New Concepts Inc.		STATION 1-25-31" ELEVATION 5062.528		FIELD NOTES		RECORDED BY	
WORK STATIONED BY AA#P		DATE 1-28-89		NO.		NO.	
FIELD ACCEPTANCE BY RE		DATE 2-2-89		BY		DATE	
FIELD CORRECTION BY		DATE		NO.		DATE	
DATE 1-28-89		DATE 2-2-89		NO.		DATE	

10044


5180
5170
5160
5150
5140
5130
5120
5110
5100

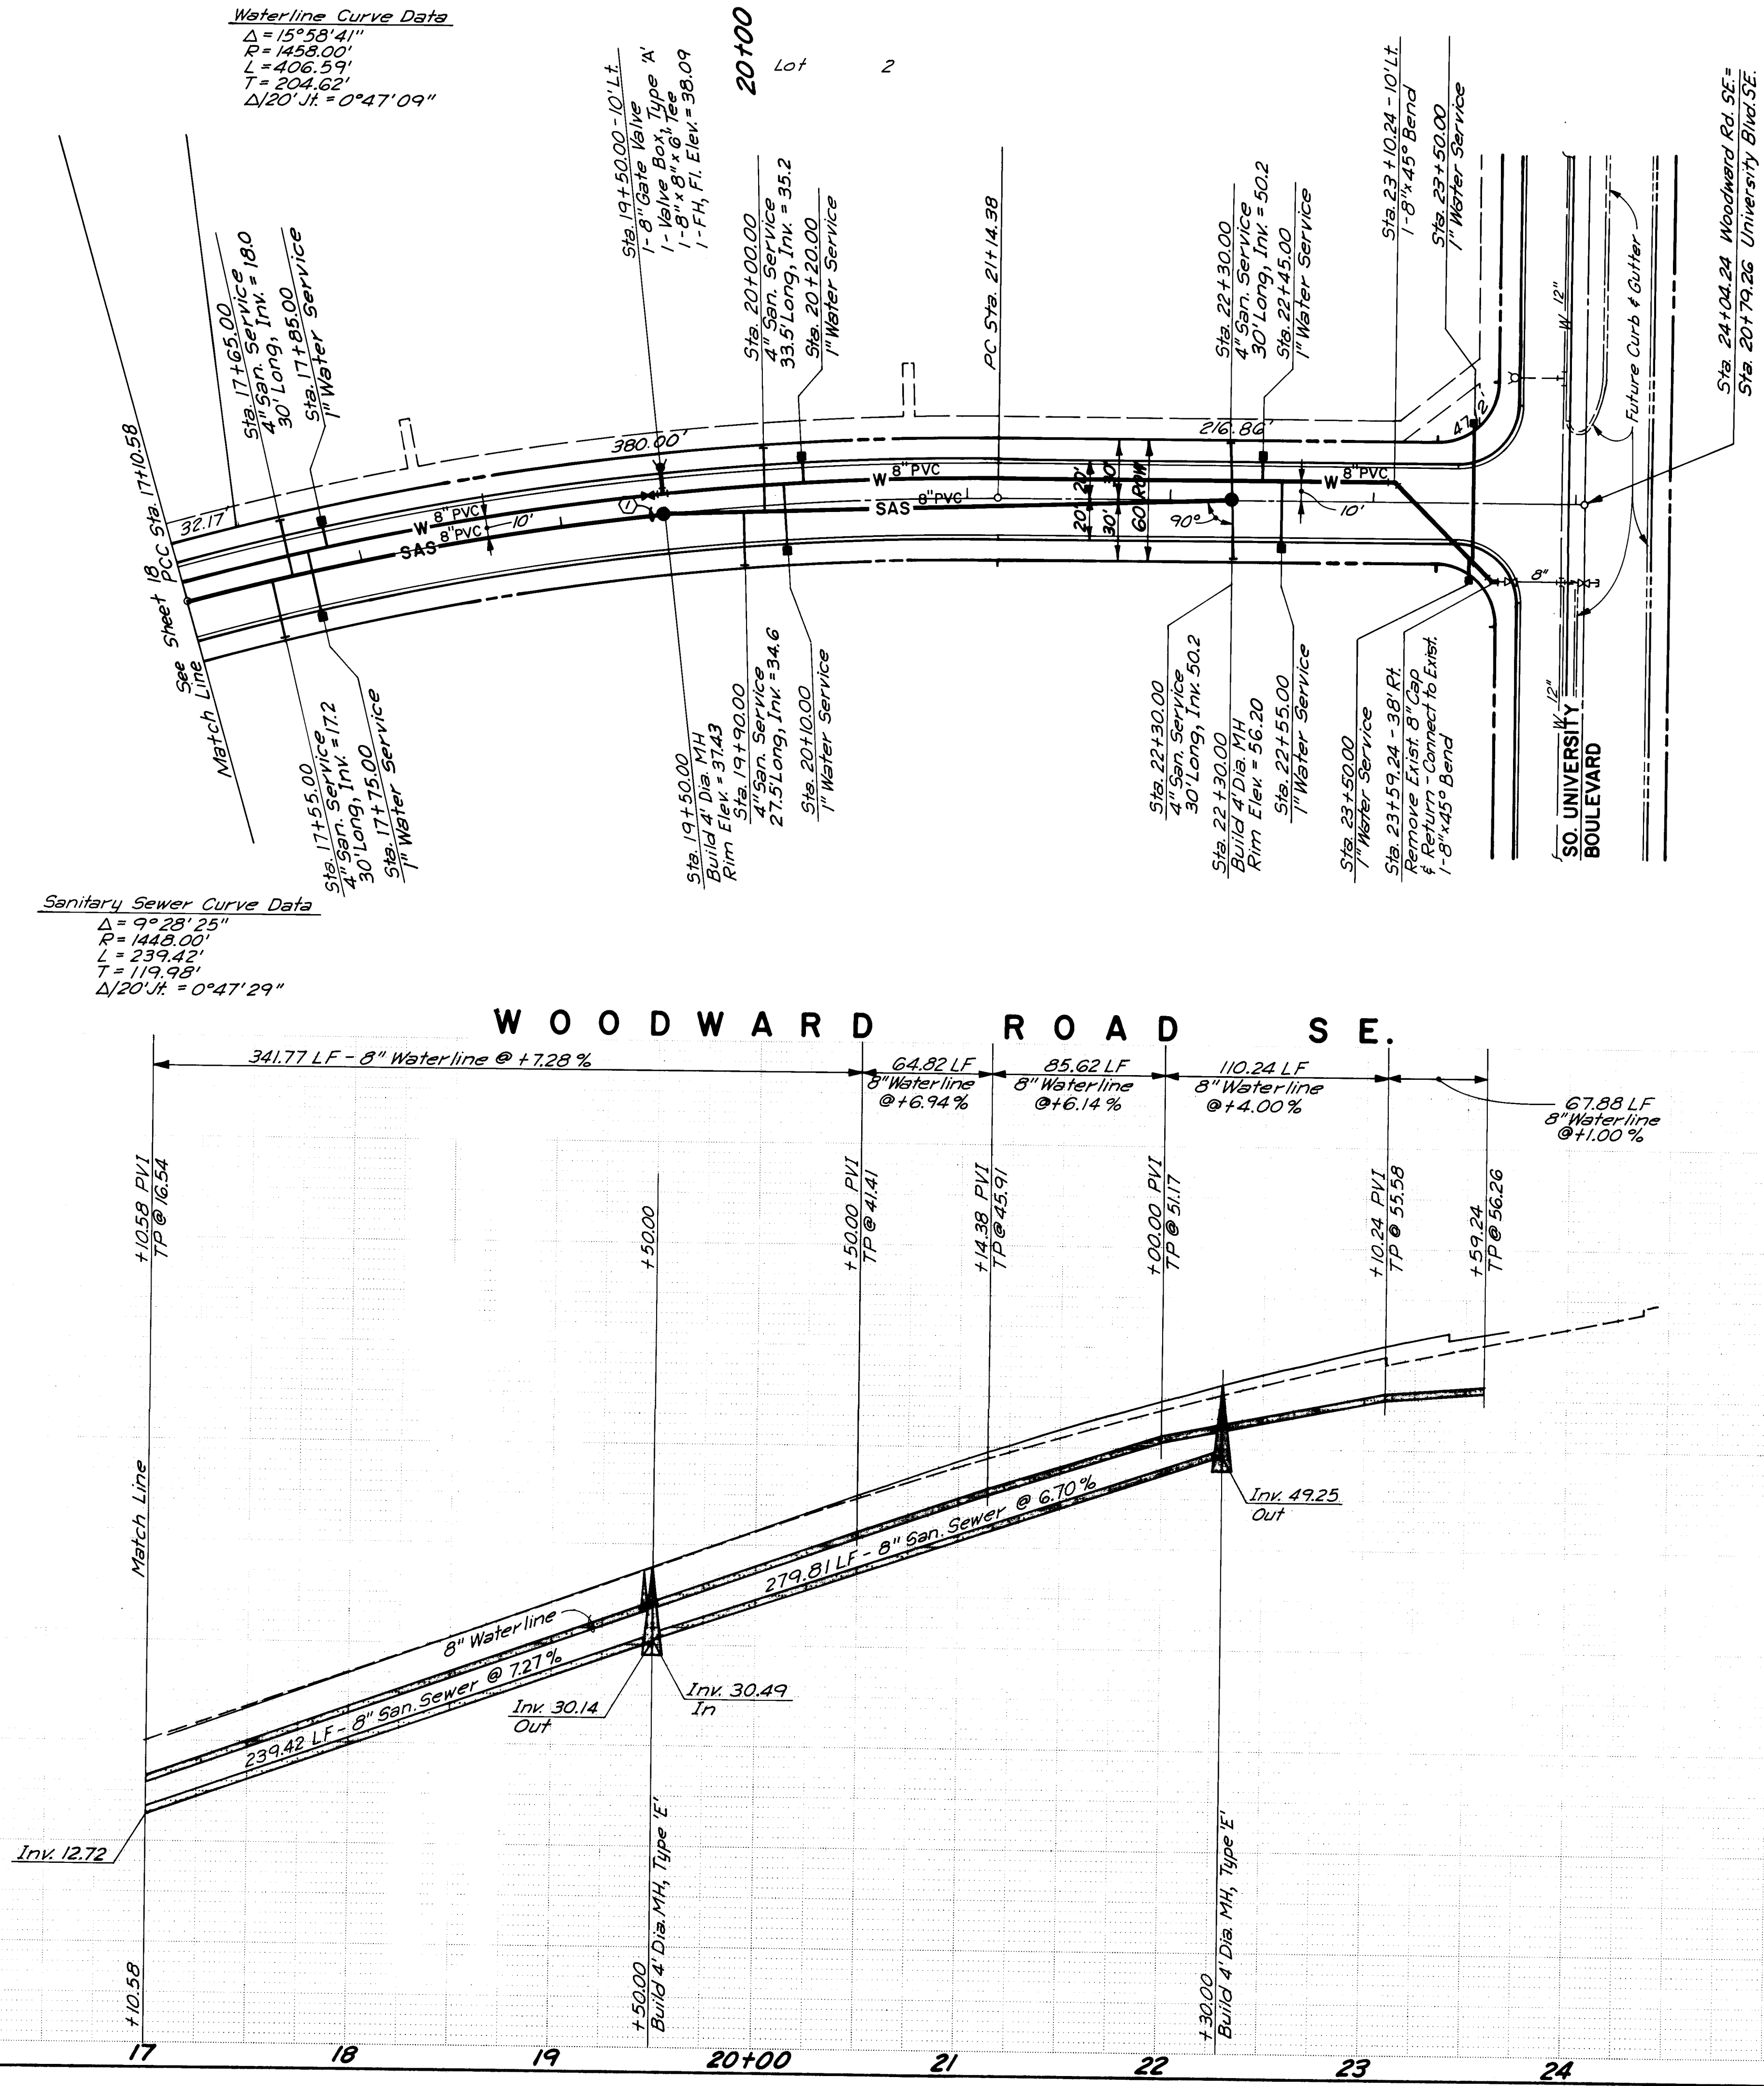

Sanitary Sewer Curve Data
 $\Delta = 9^\circ 28' 25''$
 $R = 1448.00'$
 $L = 239.42'$
 $T = 119.98'$
 $\Delta/20' \text{ Jt.} = 0^\circ 47' 29''$

Waterline Curve Data
 $\Delta = 15^\circ 58' 41''$
 $R = 1448.00'$
 $L = 406.59'$
 $T = 204.62'$
 $\Delta/20' \text{ Jt.} = 0^\circ 47' 09''$

CURVE DATA
 $\Delta = 15^\circ 58' 41''$
 $R = 1448.00'$
 $L = 406.59'$
 $T = 204.62'$

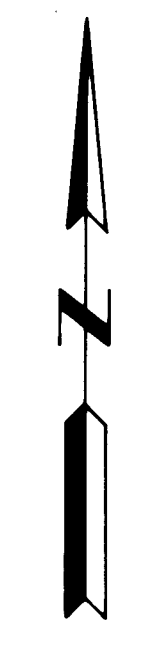


John A. Anderson
RECORD DRAWING
2-8-89

26 29501989

CITY OF ALBUQUERQUE PUBLIC WORKS DEPARTMENT					
SUNPORT PARK INFRASTRUCTURE IMPROVEMENTS - PHASE I WATER & SANITARY SEWER PLAN & PROFILE WOODWARD ROAD SE.					
APPROVALS	ENGINEER	DATE	APPROVALS	ENGINEER	DATE
D.R.C. Chair					
Trans. Dev.					
Utility Dev.					
DESIGNED BY JA		DATE Oct. 1987	CHECKED BY JA		DATE Oct. 1987
DRAWN BY C.B. JCS		DATE Oct. 1987	DESIGNED BY JA		DATE Oct. 1987
CHECKED BY JA		DATE Oct. 1987	DESIGNED BY JA		DATE Oct. 1987
DRAWING NO. 2950		MAP NO. M-15		SHEET 19 OF 26	


ENGINEER'S SEAL		SURVEY INFORMATION		BENCH MARKS		AS BUILT INFORMATION	
 ANDREWS, ASSURRY & ROBERT, INC. ALBUQUERQUE, NM 87102		FIELD NOTES		STATION: 1-25-31" ELEVATION 5082.528		CONTRACTOR: New Concepts, Inc.	
		NO.	DATE	STANDARD INCH BRASS TABLET SET IN CONCRETE POST LOCATED AT THE NORTHEAST CORNER OF THE HIGHWAY 1-25 BRIDGE CROSSING OVER AN ABANDONED RAILROAD SPUR LINE APPROXIMATELY 1.15 MILES NORTH OF RIO BRAVO BOULEVARD		INSPECTED BY: AA&P DATE 12-88	
REVISIONS		NO.		DATE		DATE	
DESIGN		NO.		DATE		DATE	
DESIGNED BY JA		NO.		DATE		DATE	
DRAWN BY C.B. JCS		NO.		DATE		DATE	
CHECKED BY JA		NO.		DATE		DATE	
MICRO-FILM INFORMATION		NO.		DATE		DATE	

5010
5000
4990
4980
4970
4960
4950
4940
4930

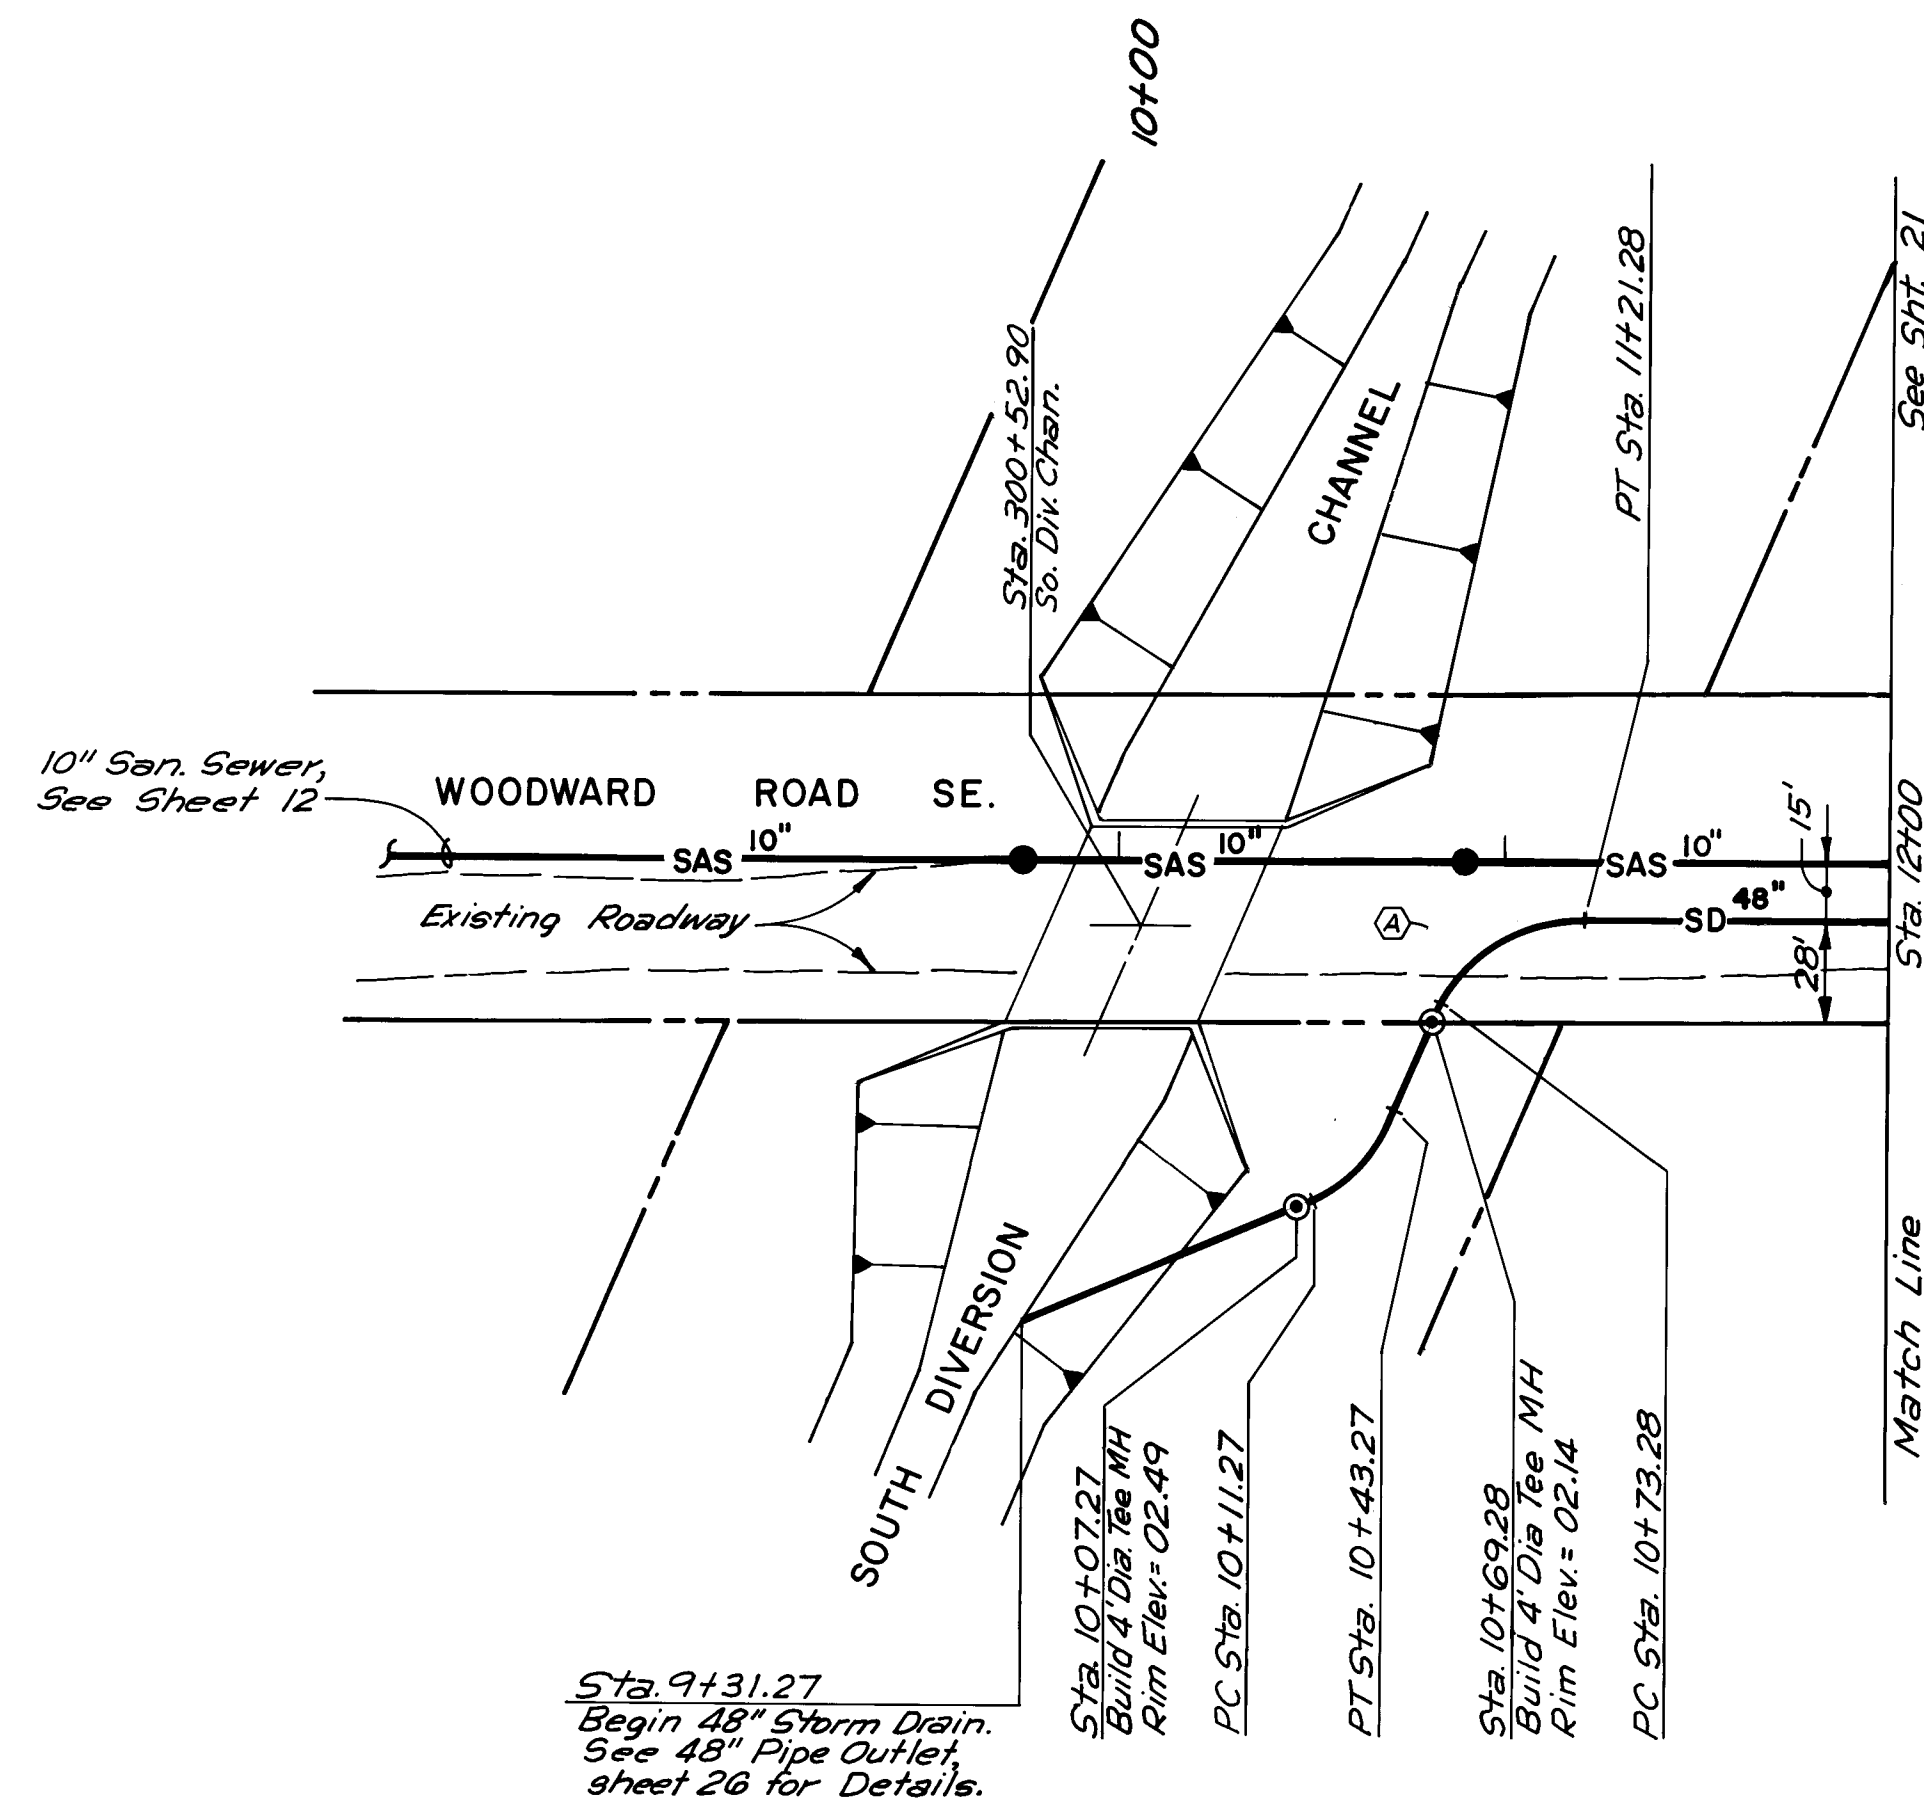

PLAN
SCALE: 1" = 50'

Curve Data (@ Storm Drain)	
A $\Delta = 66^\circ 45' 10''$	B $\Delta = 45^\circ 00' 00''$
R = 41.20'	R = 40.74'
L = 48.00'	L = 32.00'
T = 27.14'	T = 16.88'
6 - 11' 07' 32" Bends	4 - 11' 15' 00" Bends

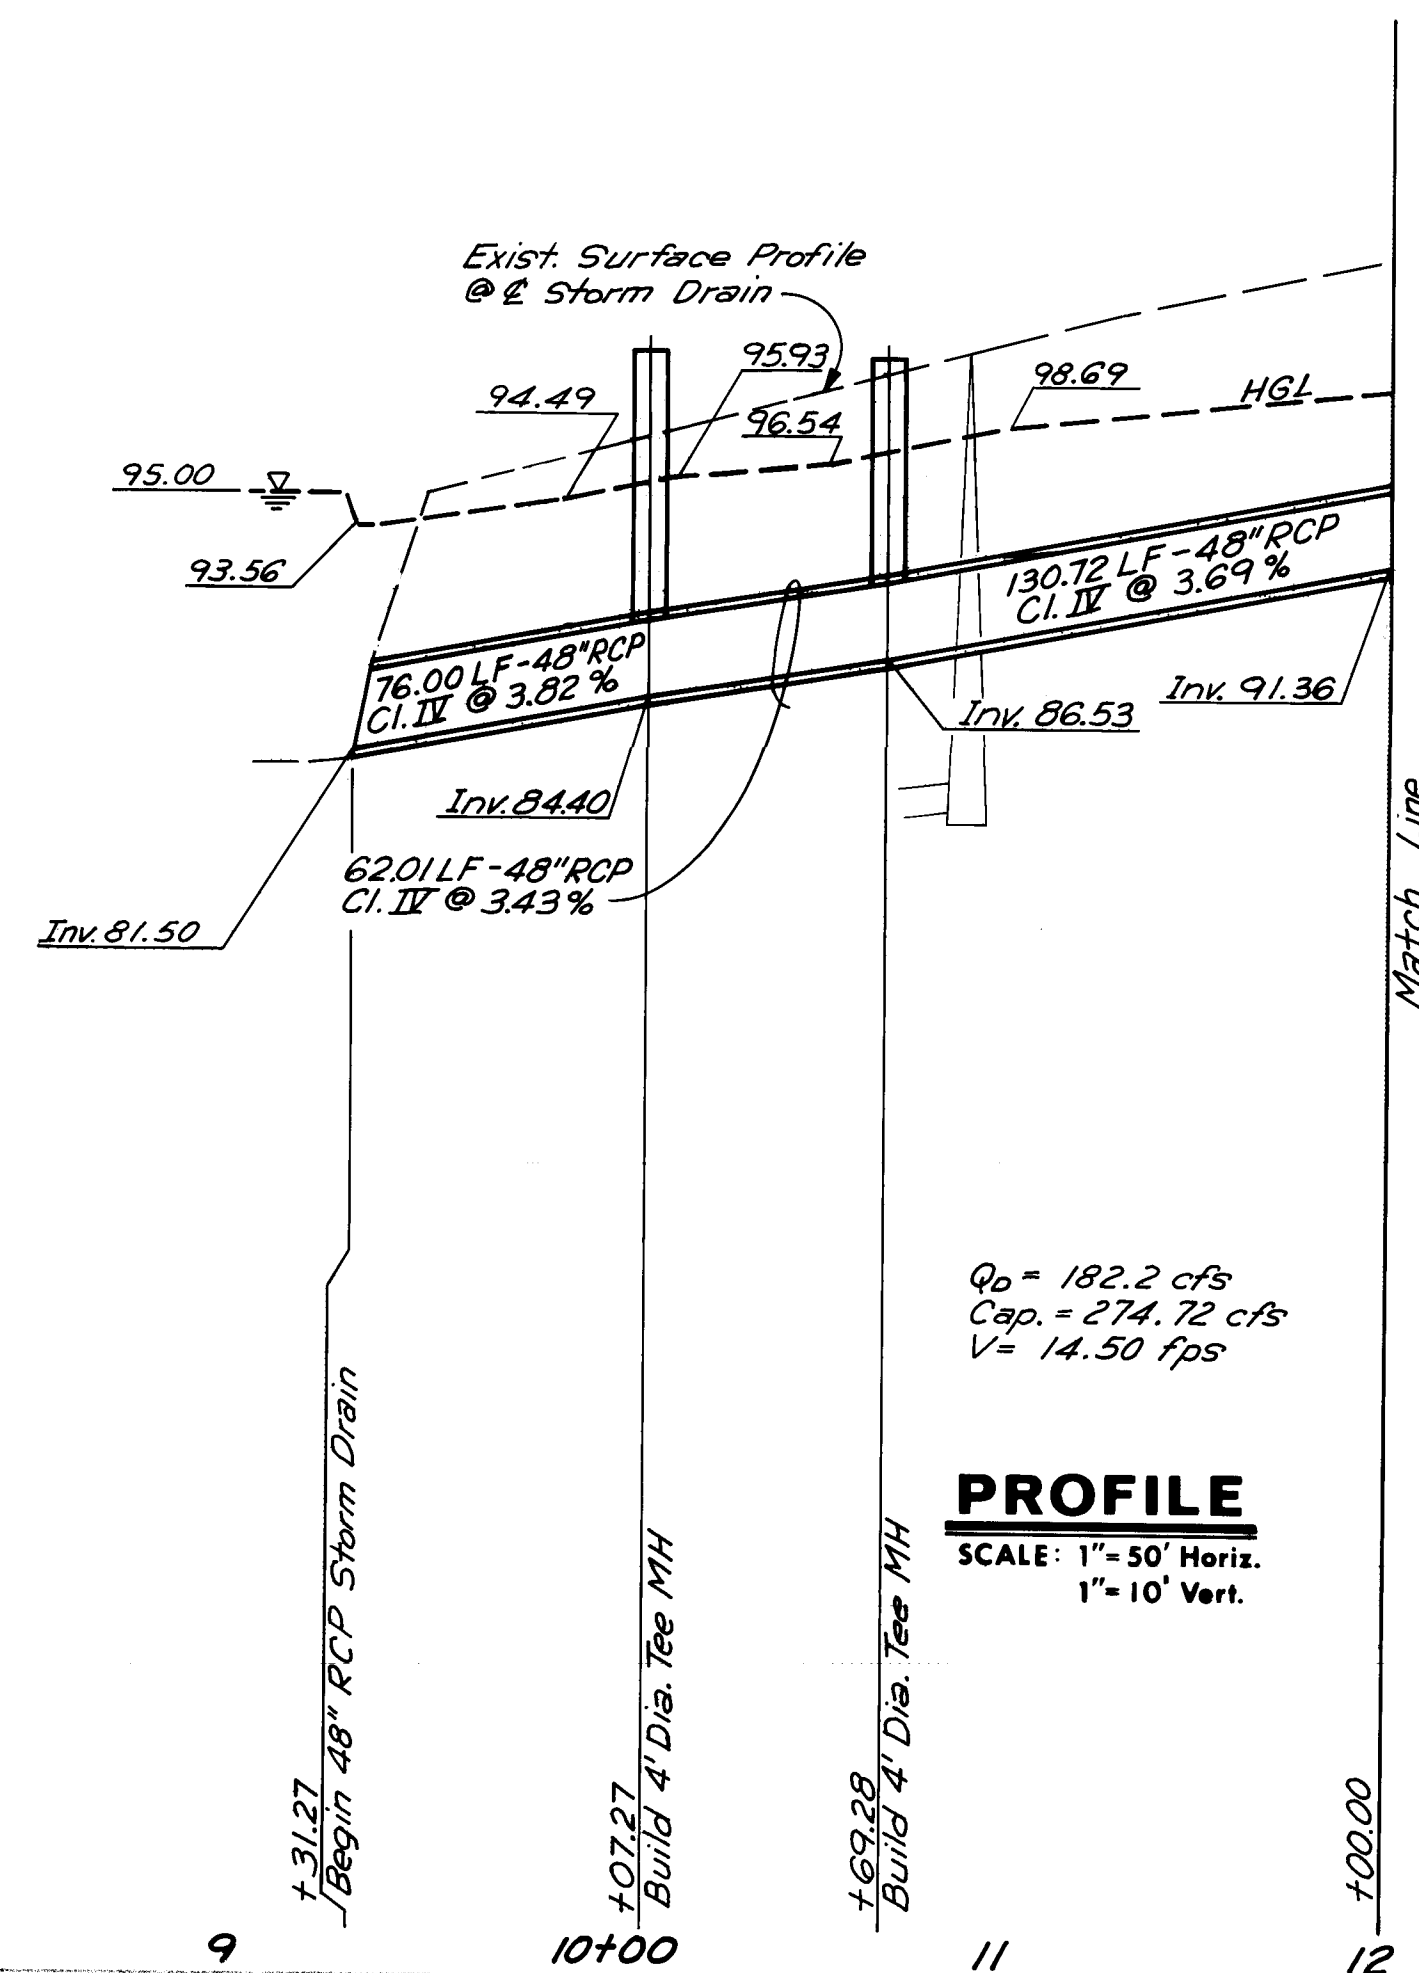


5010
5000
4990
4980
4970
4960
4950
4940
4930

John D. Andrews
RECORD DRAWING
2-8-89

26 29502089

SUNPORT PARK
INFRASTRUCTURE IMPROVEMENTS-PHASE I
STORM DRAIN PLAN & PROFILE
WOODWARD ROAD SE.


Handwritten notes:
Hydrology Report Due 6-1-87
5/22/87
2-8-89

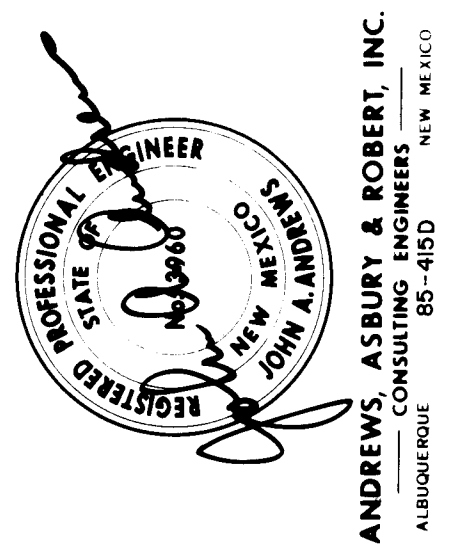

March, 1987
March, 1987
March, 1987
JIM
CB, TL
JA, JM, RF

STA. "I-25-31" ELEVATION 5062.528
STANDARD INSHC BRASS TABLET SET IN CONCRETE
POST LOCATED AT THE NORTHEAST CORNER OF
THE HIGHWAY I-25 BRIDGE CROSSING OVER AN
ABANDONED RAILROAD SPUR LINE APPROXIMATELY
1.15 MILES NORTH OF RIO BRAVO BOULEVARD

New Concepts Inc.
AA & P 1-88
RE 12-88
2-89
AA & P 1-89

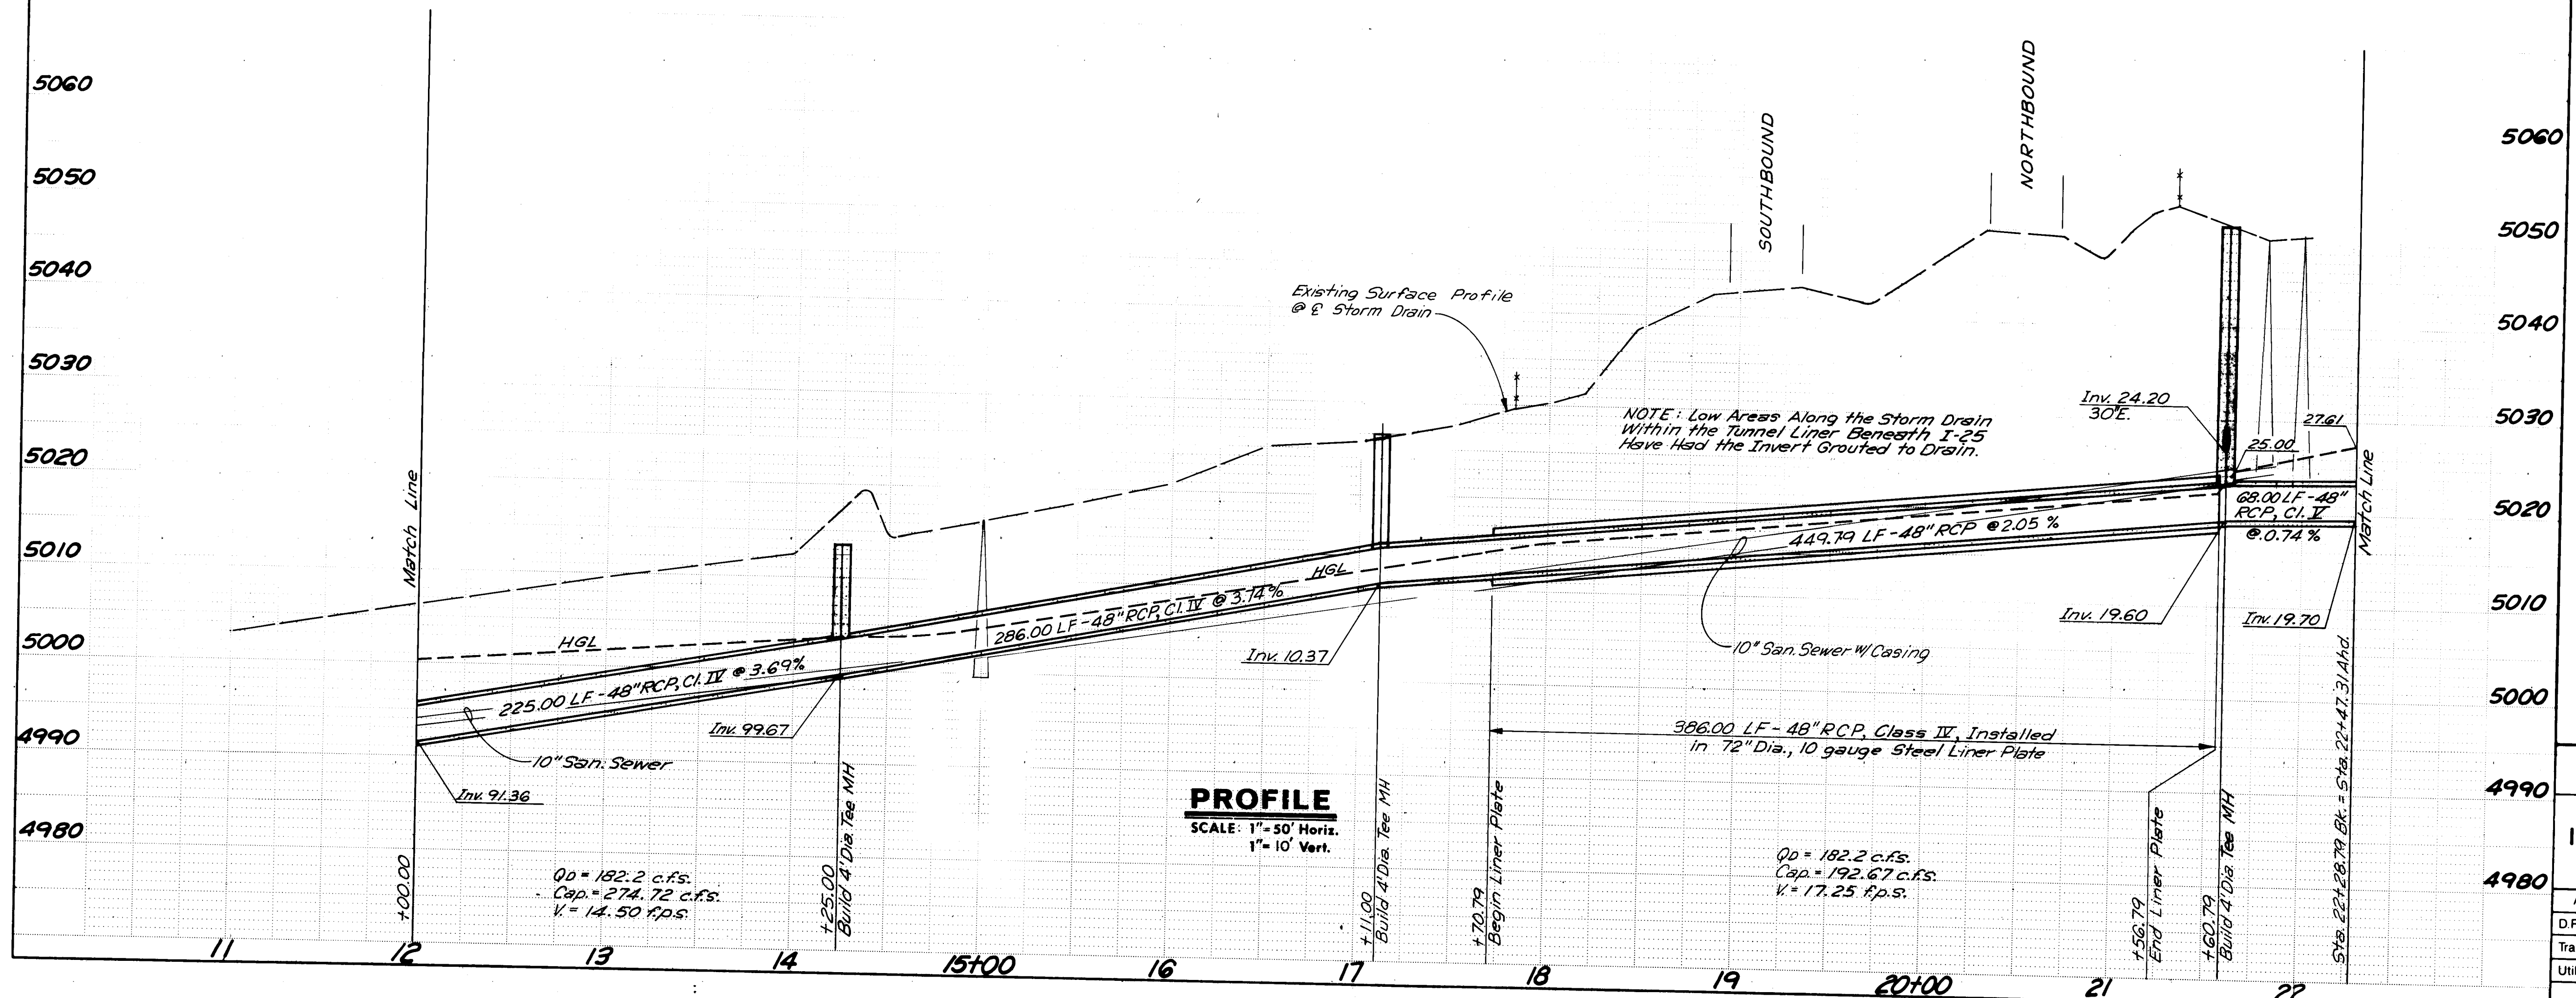

ENGINEER'S SEAL		SURVEY INFORMATION		BENCH MARKS		AS BUILT INFORMATION	
		FIELD NOTES				CONTRACTOR <i>New Concepts Inc.</i>	
		NO.	BY	DATE			WORK STARTED BY <i>AAFP</i>
					STA. "I-25-31" ELEVATION 5062.528		DATE <i>2-88</i>
					STANDARD INMSIC BRASS TABLET SET IN CONCRETE		INSPECTORS
					POST LOCATED AT THE NORTHEAST CORNER OF		DATE <i>2-89</i>
					THE HIGHWAY I-25 BRIDGE CROSSING OVER AN		RECEIVED BY <i>RE</i>
					ABANDONED RAILROAD SPIR LINE APPROXIMATELY		VERIFICATION BY
					1.15 MILES NORTH OF RIO BRAVO BOULEVARD		DRAWINGS SOUND BY <i>AAFP</i> DATE <i>1-89</i>
							<i>MICRO-FILM INFORMATION</i>
							RECORDED BY
							DATE
							NO



ANDREWS, ASBURY & ROBERT, INC.
ALBUQUERQUE 85-415D NEW MEXICO
CONSULTING ENGINEERS

DESIGNED BY *JM* DATE *Feb., 1987*

DRAWN BY *CB, TL* DATE *Feb., 1987*

CHECKED BY *JA, JM* DATE *Feb., 1987*

John D. Anderson
RECORD DRAWING
2-8-89



1	2	3	4	5	6	7	8	9	10	11	12
2	6		2	9	5	0	2	1	8	9	

CITY OF ALBUQUERQUE
PUBLIC WORKS DEPARTMENT

SUNPORT PARK
INFRASTRUCTURE IMPROVEMENTS - PHASE I
STORM DRAIN PLAN & PROFILE
WOODWARD ROAD SE.

APPROVALS	ENGINEER	DATE	APPROVALS	ENGINEER	DATE
D.R.C. Chair	<i>[Signature]</i>	1/6/87	HYDROLOGY	<i>[Signature]</i>	6-18
Trans. Dev.	NAP/H	5/22/87			
Utility Dev.	<i>[Signature]</i>	5-22-87			

DRAWING NO.	2950	MAP NO.	M-15	SHEET	21	OF	26
-------------	------	---------	------	-------	----	----	----

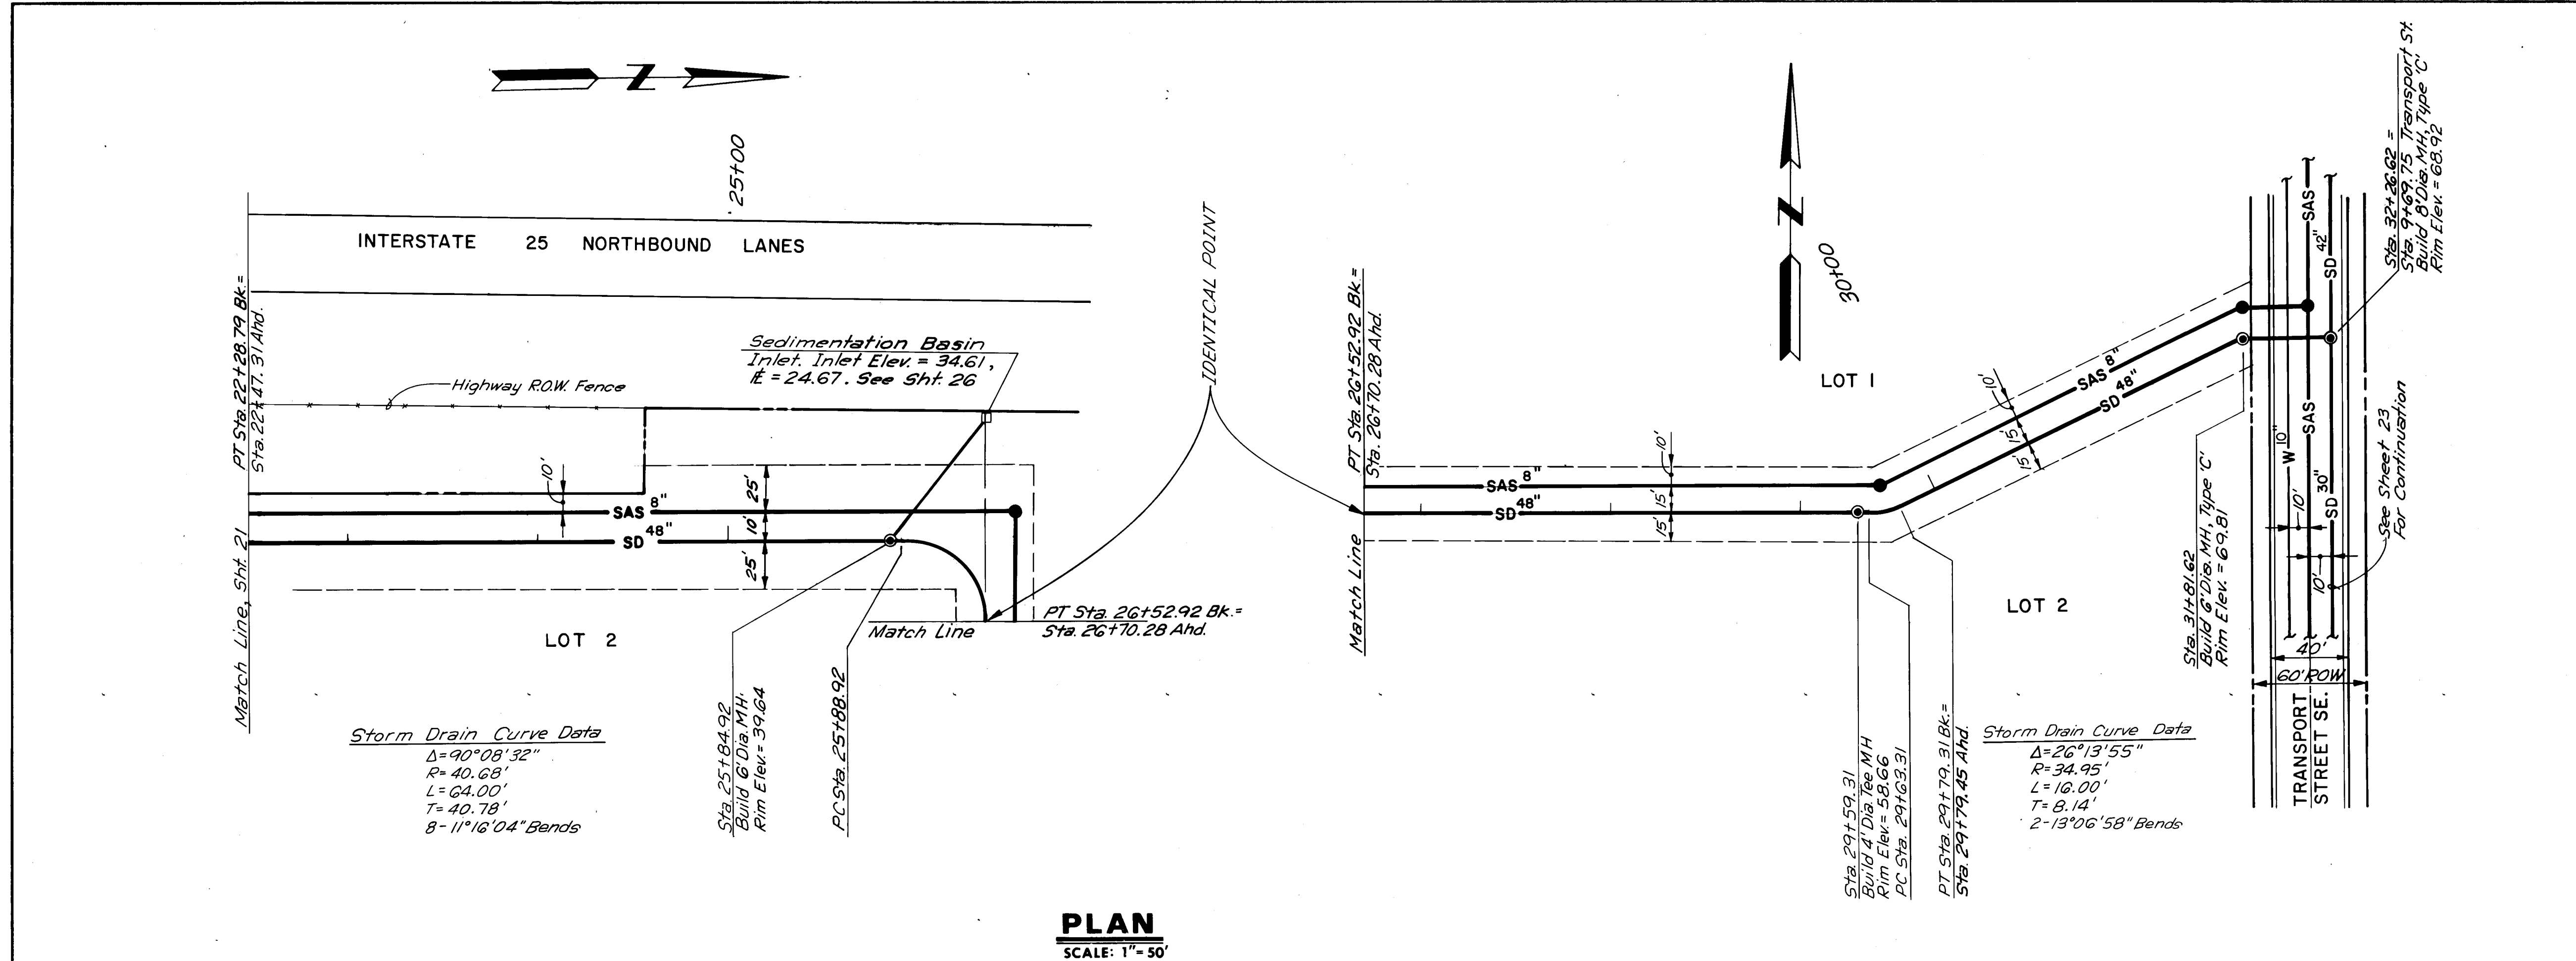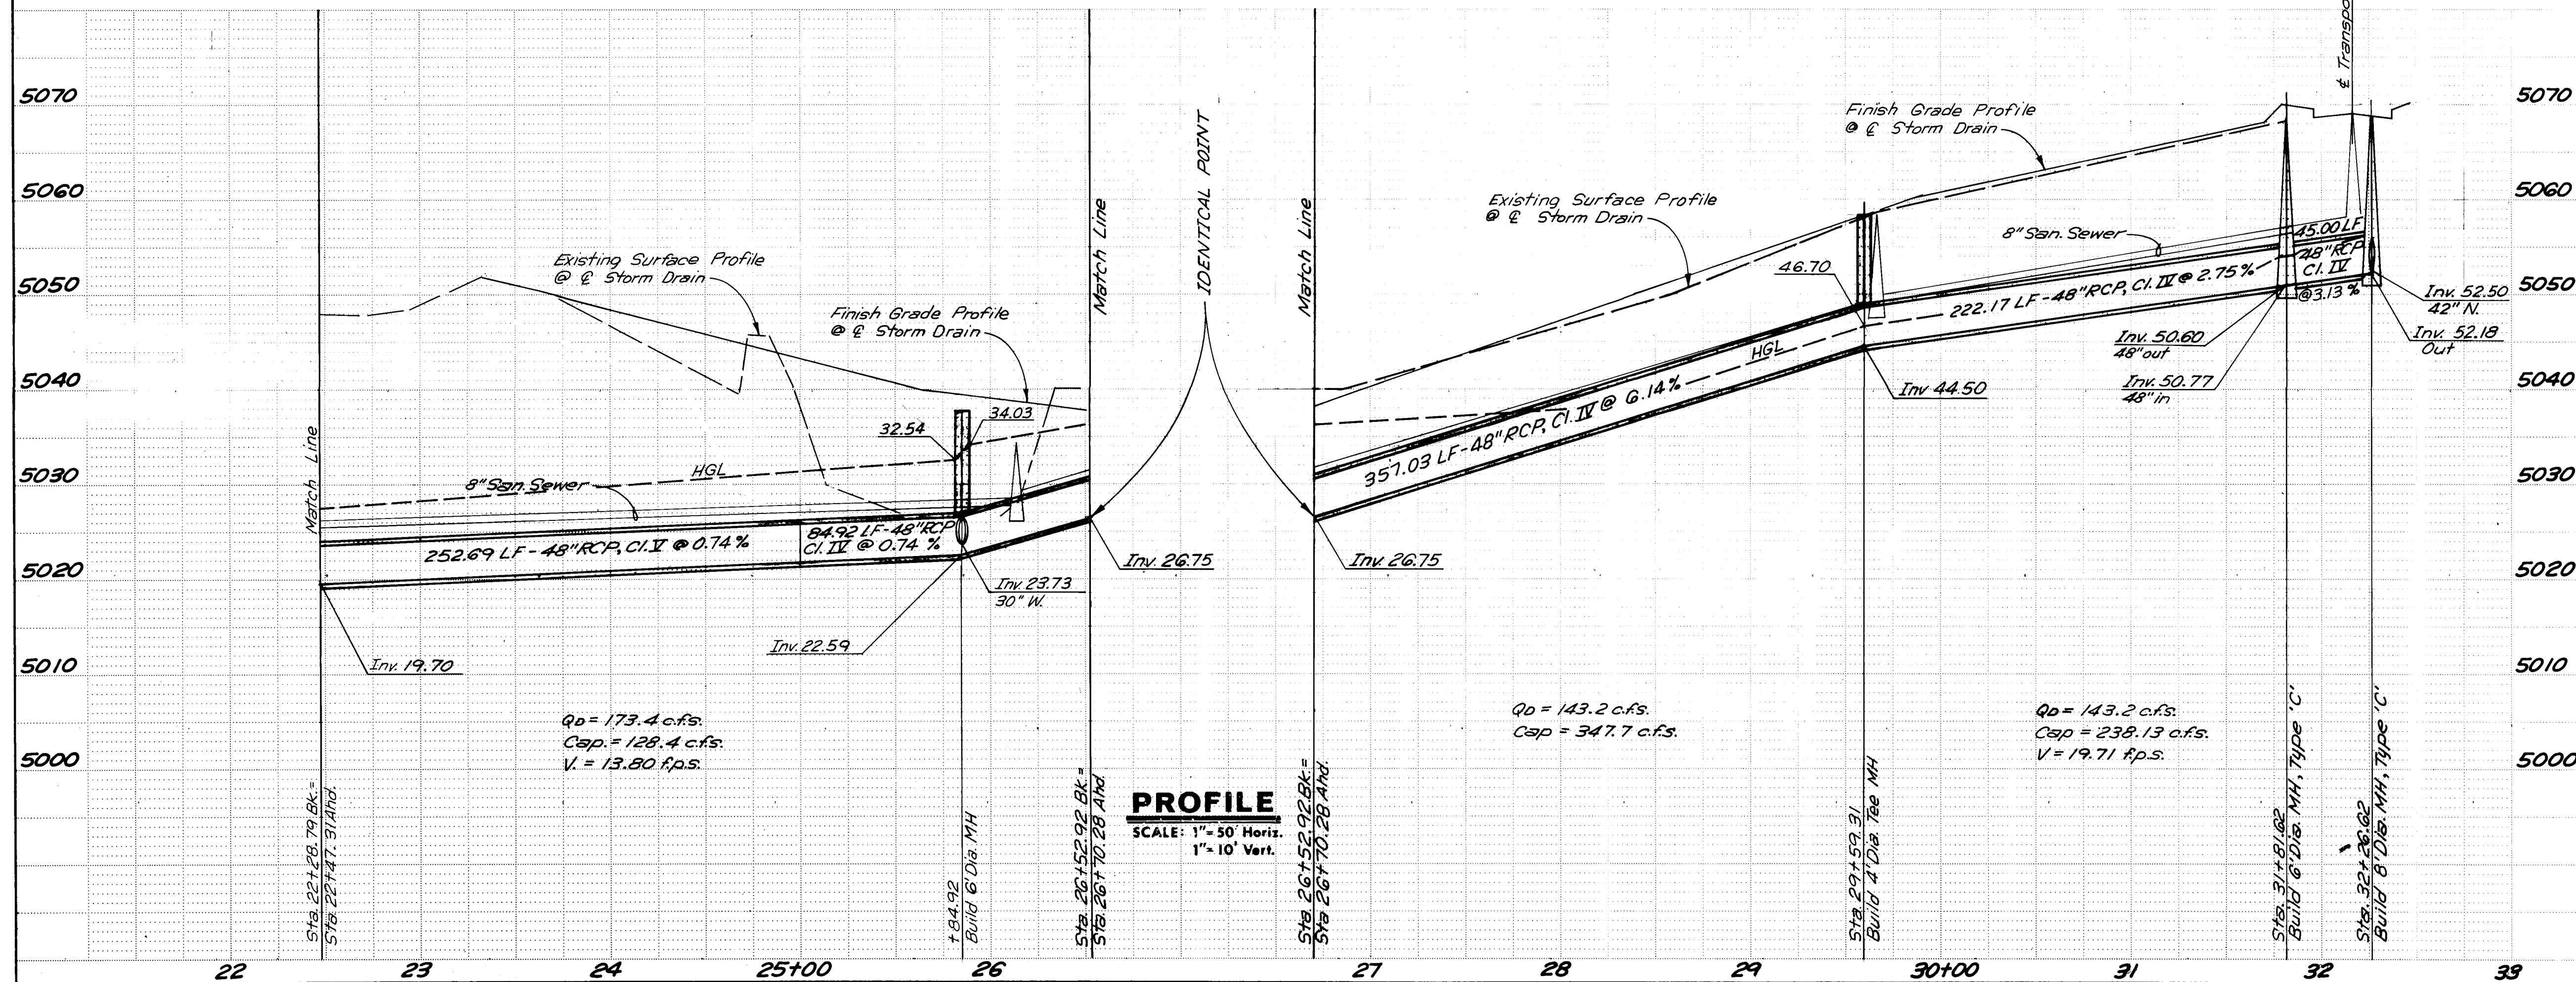

APPROVALS	ENGINEER	DATE	APPROVALS	ENGINEER	DATE
D.R.C. Chair	<i>[Signature]</i>	6/25/87	Hydrology	<i>[Signature]</i>	6-1-87
Trans. Dev.	<i>[Signature]</i>	5/22/87			
Utility Dev.	<i>[Signature]</i>	5-22-87			

DRAWING NO. 2950 MAP NO. M-15 SHEET 22 OF 26


CITY OF ALBUQUERQUE
PUBLIC WORKS DEPARTMENT
**SUNPORT PARK
INFRASTRUCTURE IMPROVEMENTS-PHASE I**
STORM DRAIN PLAN & PROFILE
OUTFALL

DESIGNED BY J.M. DATE March, 1987
 DRAWN BY C.B. DATE March, 1987
 CHECKED BY J.A., J.M., R.F. DATE March, 1987

REVISIONS
 NO. DATE BY
 1 2 3 4 5 6 7 8 9 10 11 12
 26 2950 2289


ENGINEER'S SEAL
[Seal]
 ANDREWS ASSURANCE & ROBERT, INC.
 65-4150 NEW MEXICO

SURVEY INFORMATION			BENCH MARKS		AS BUILT INFORMATION		
NO.	FIELD NOTES		STA.	"1-25-31" STANDARD MMSHC BRASS TABLET SET IN CONCRETE POST LOCATED AT THE NORTHEAST CORNER OF THE HIGHWAY 1-25 BRIDGE CROSSING OVER AN ABANDONED RAILROAD SPUR LINE APPROXIMATELY 1.15 MILES NORTH OF RIO BRAVO BOULEVARD	CONTRACTOR <i>New Concepts Inc.</i>		
	BY	DATE			WORK STARTED BY	DATE	
					INSPECTORS BY <i>AA&P</i>	DATE <i>12-88</i>	
					FIELD ELEVANCE BY <i>RE</i>	DATE <i>2-89</i>	
					VERIFICATION BY	DATE	
					CORRECTED BY <i>AA&P</i>	DATE <i>1-89</i>	
					<i>MICRO-FILM INFORMATION</i>		
					RECORDED BY	DATE	
					NO		

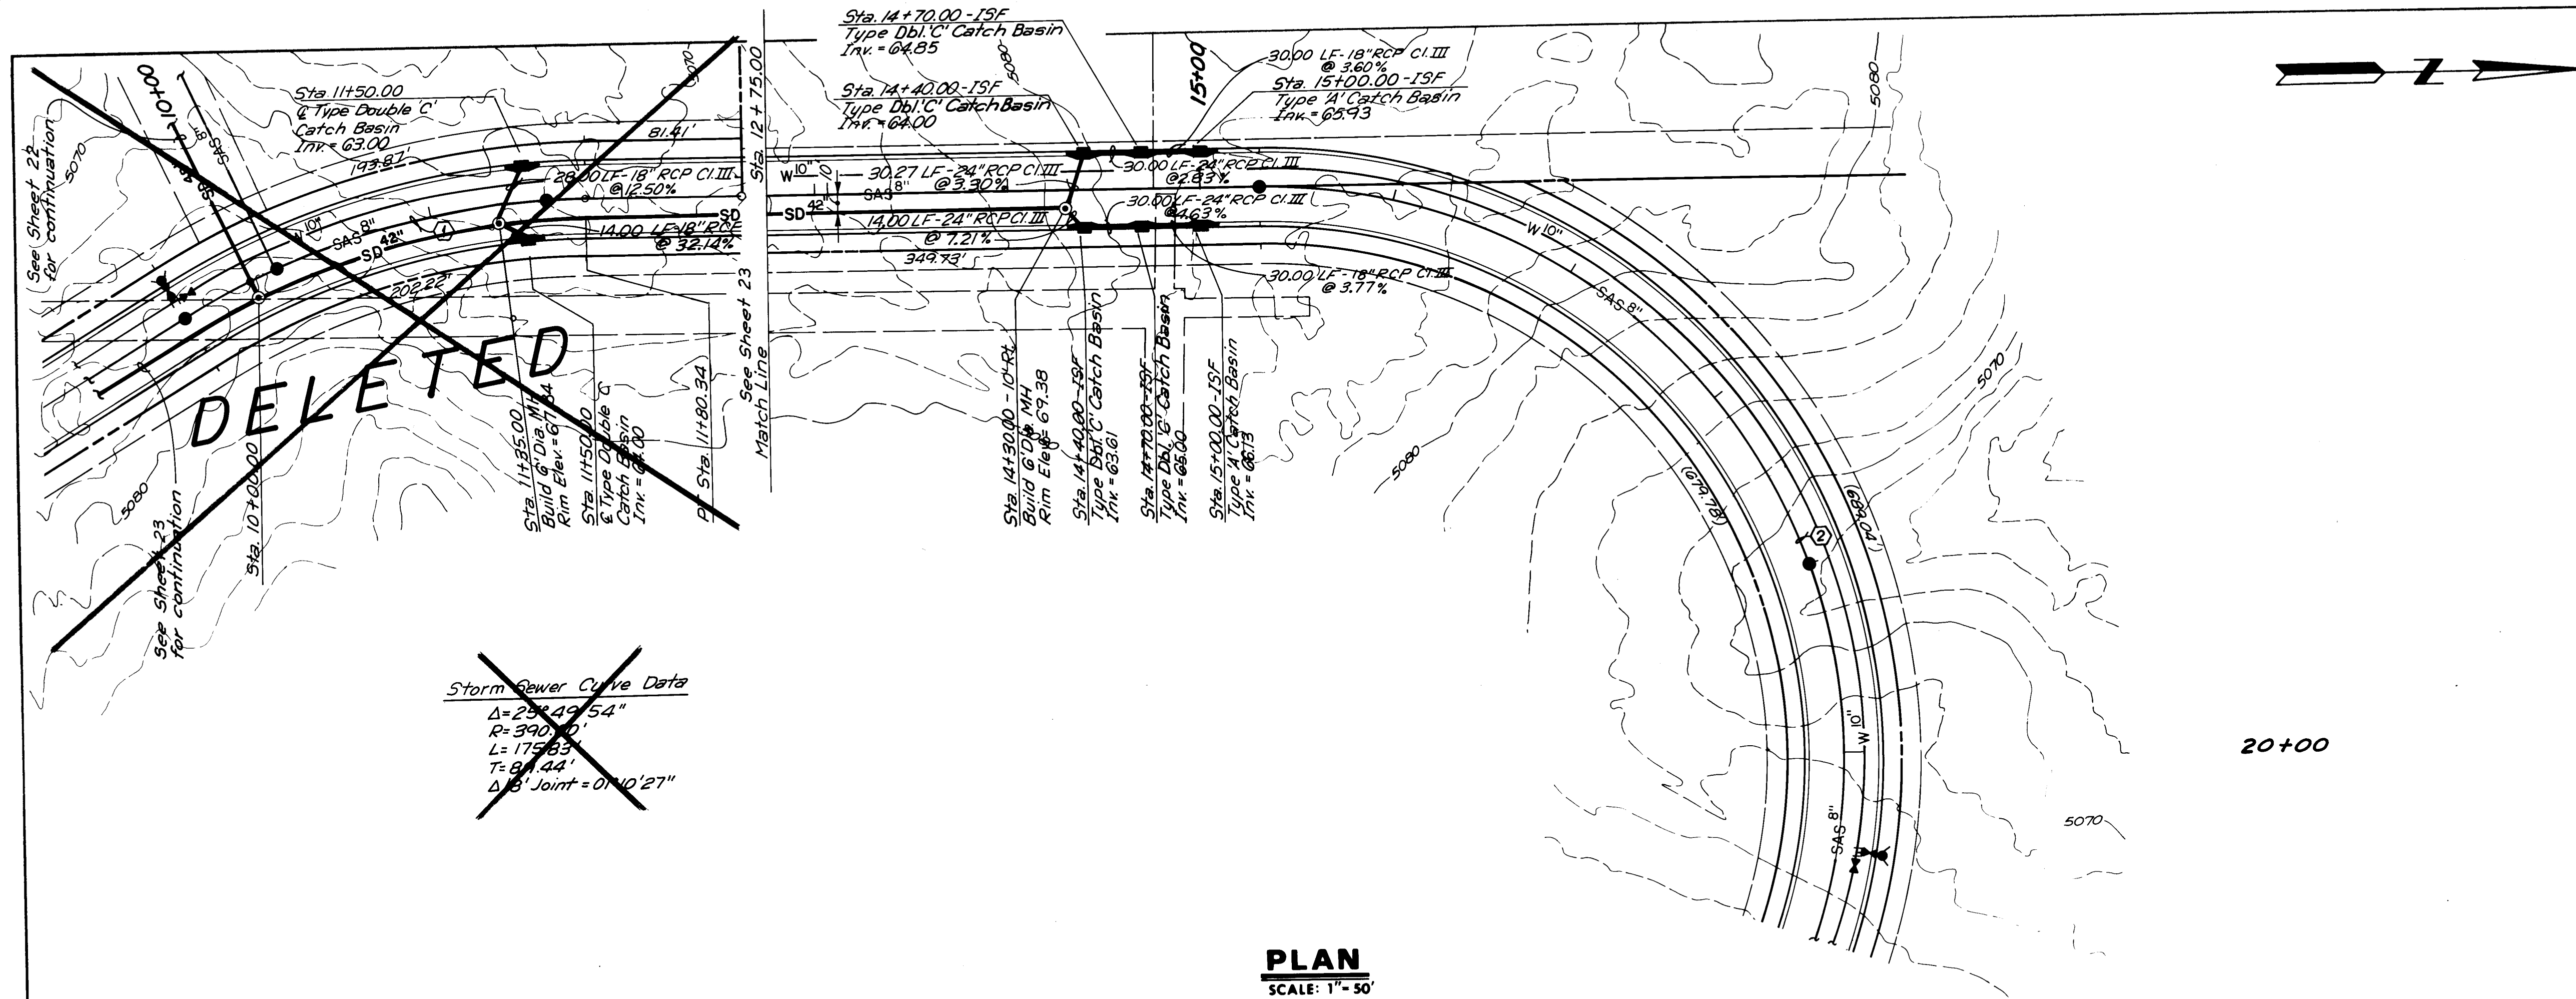

PLAN
SCALE: 1" = 50'

TRANSPORT STREET SE. - FLIGHTWAY AVENUE SE.

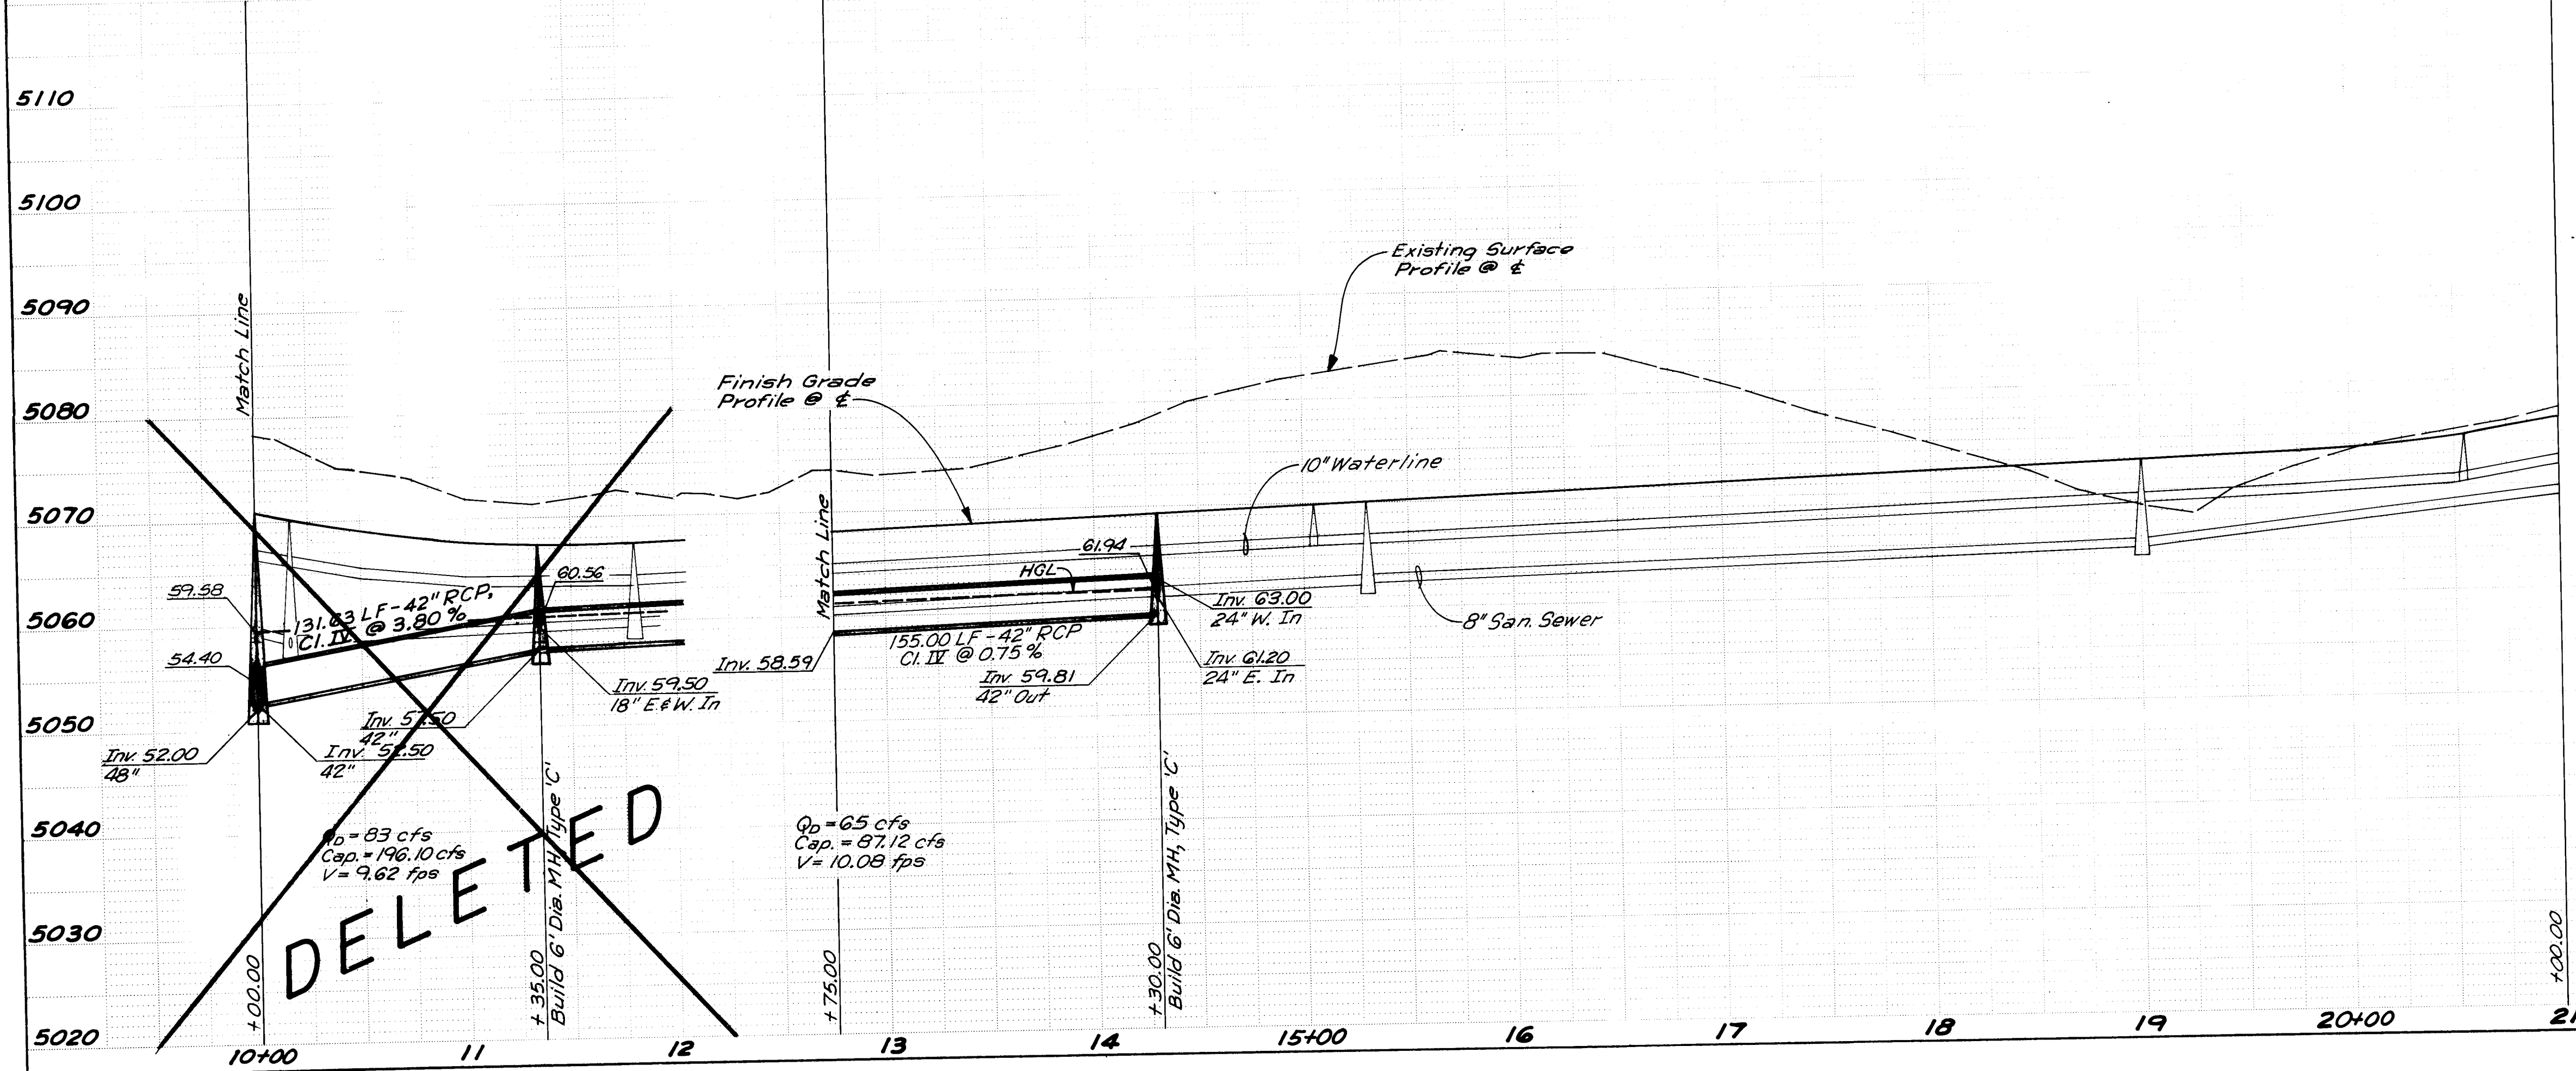

5110
5100
5090
5080
5070
5060
5050
5040
5030
5020

1 2 3 4 5 6 7 8 9 10 11 12
26 29 50 24 89

CITY OF ALBUQUERQUE
PUBLIC WORKS DEPARTMENT

SUNPORT PARK
INFRASTRUCTURE IMPROVEMENTS - PHASE I
STORM DRAIN PLAN & PROFILE
TRANSPORT STREET SE. - FLIGHTWAY AVENUE SE.

APPROVALS	ENGINEER	DATE	APPROVALS	ENGINEER	DATE
City Engineer	Andrews	6/25/07	Liquid Waste	NA	5/22/07
A.C.E. - Design	"	"	Traffic	NA	5/22/07
A.C.E. - Hydrology	"	"	Water	NA	5/22/07

DRAWING NO. 2950 MAP NO. M-15 SHEET 24 OF 26

CURVE DATA

Δ = 31°18'54"
R = 400.00'
L = 218.62'
T = 112.11'

Δ = 144°15'11"
R = 300.00'
L = 755.31'
T = 930.29'

AS BUILT INFORMATION

CONTRACTOR: New Concepts Inc.
DATE: 12/09

BENCH MARKS

STA. "1-25-31" ELEVATION 5062.528
STANDARD INCH BRASS TABLET SET IN CONCRETE
POST LOCATED AT THE NORTHEAST CORNER OF
THE HIGHWAY 1-25 BRIDGE CROSSING OVER AN
ABANDONED RAILROAD SPUR LINE APPROXIMATELY
1.15 MILES NORTH OF RIO BRAVO BOULEVARD

SURVEY INFORMATION

FIELD NOTES
NO. BY DATE

ENGINEER'S SEAL



REGISTERED PROFESSIONAL ENGINEER
STATE OF NEW MEXICO
ANDREWS, ASBURY & ROBERT, INC.
CONSULTING ENGINEERS
ALBUQUERQUE, NEW MEXICO

REVISIONS

NO.	DATE	REMARKS	BY
1	10/1/06	DESIGN	JM
2	10/1/06	DESIGN	JM

DESIGNED BY: JM DATE: 10/1/06
DRAWN BY: JCS, JEV DATE: 10/1/06
CHECKED BY: DATE:

John A. Andrews
RECORD DRAWING
2-8-89

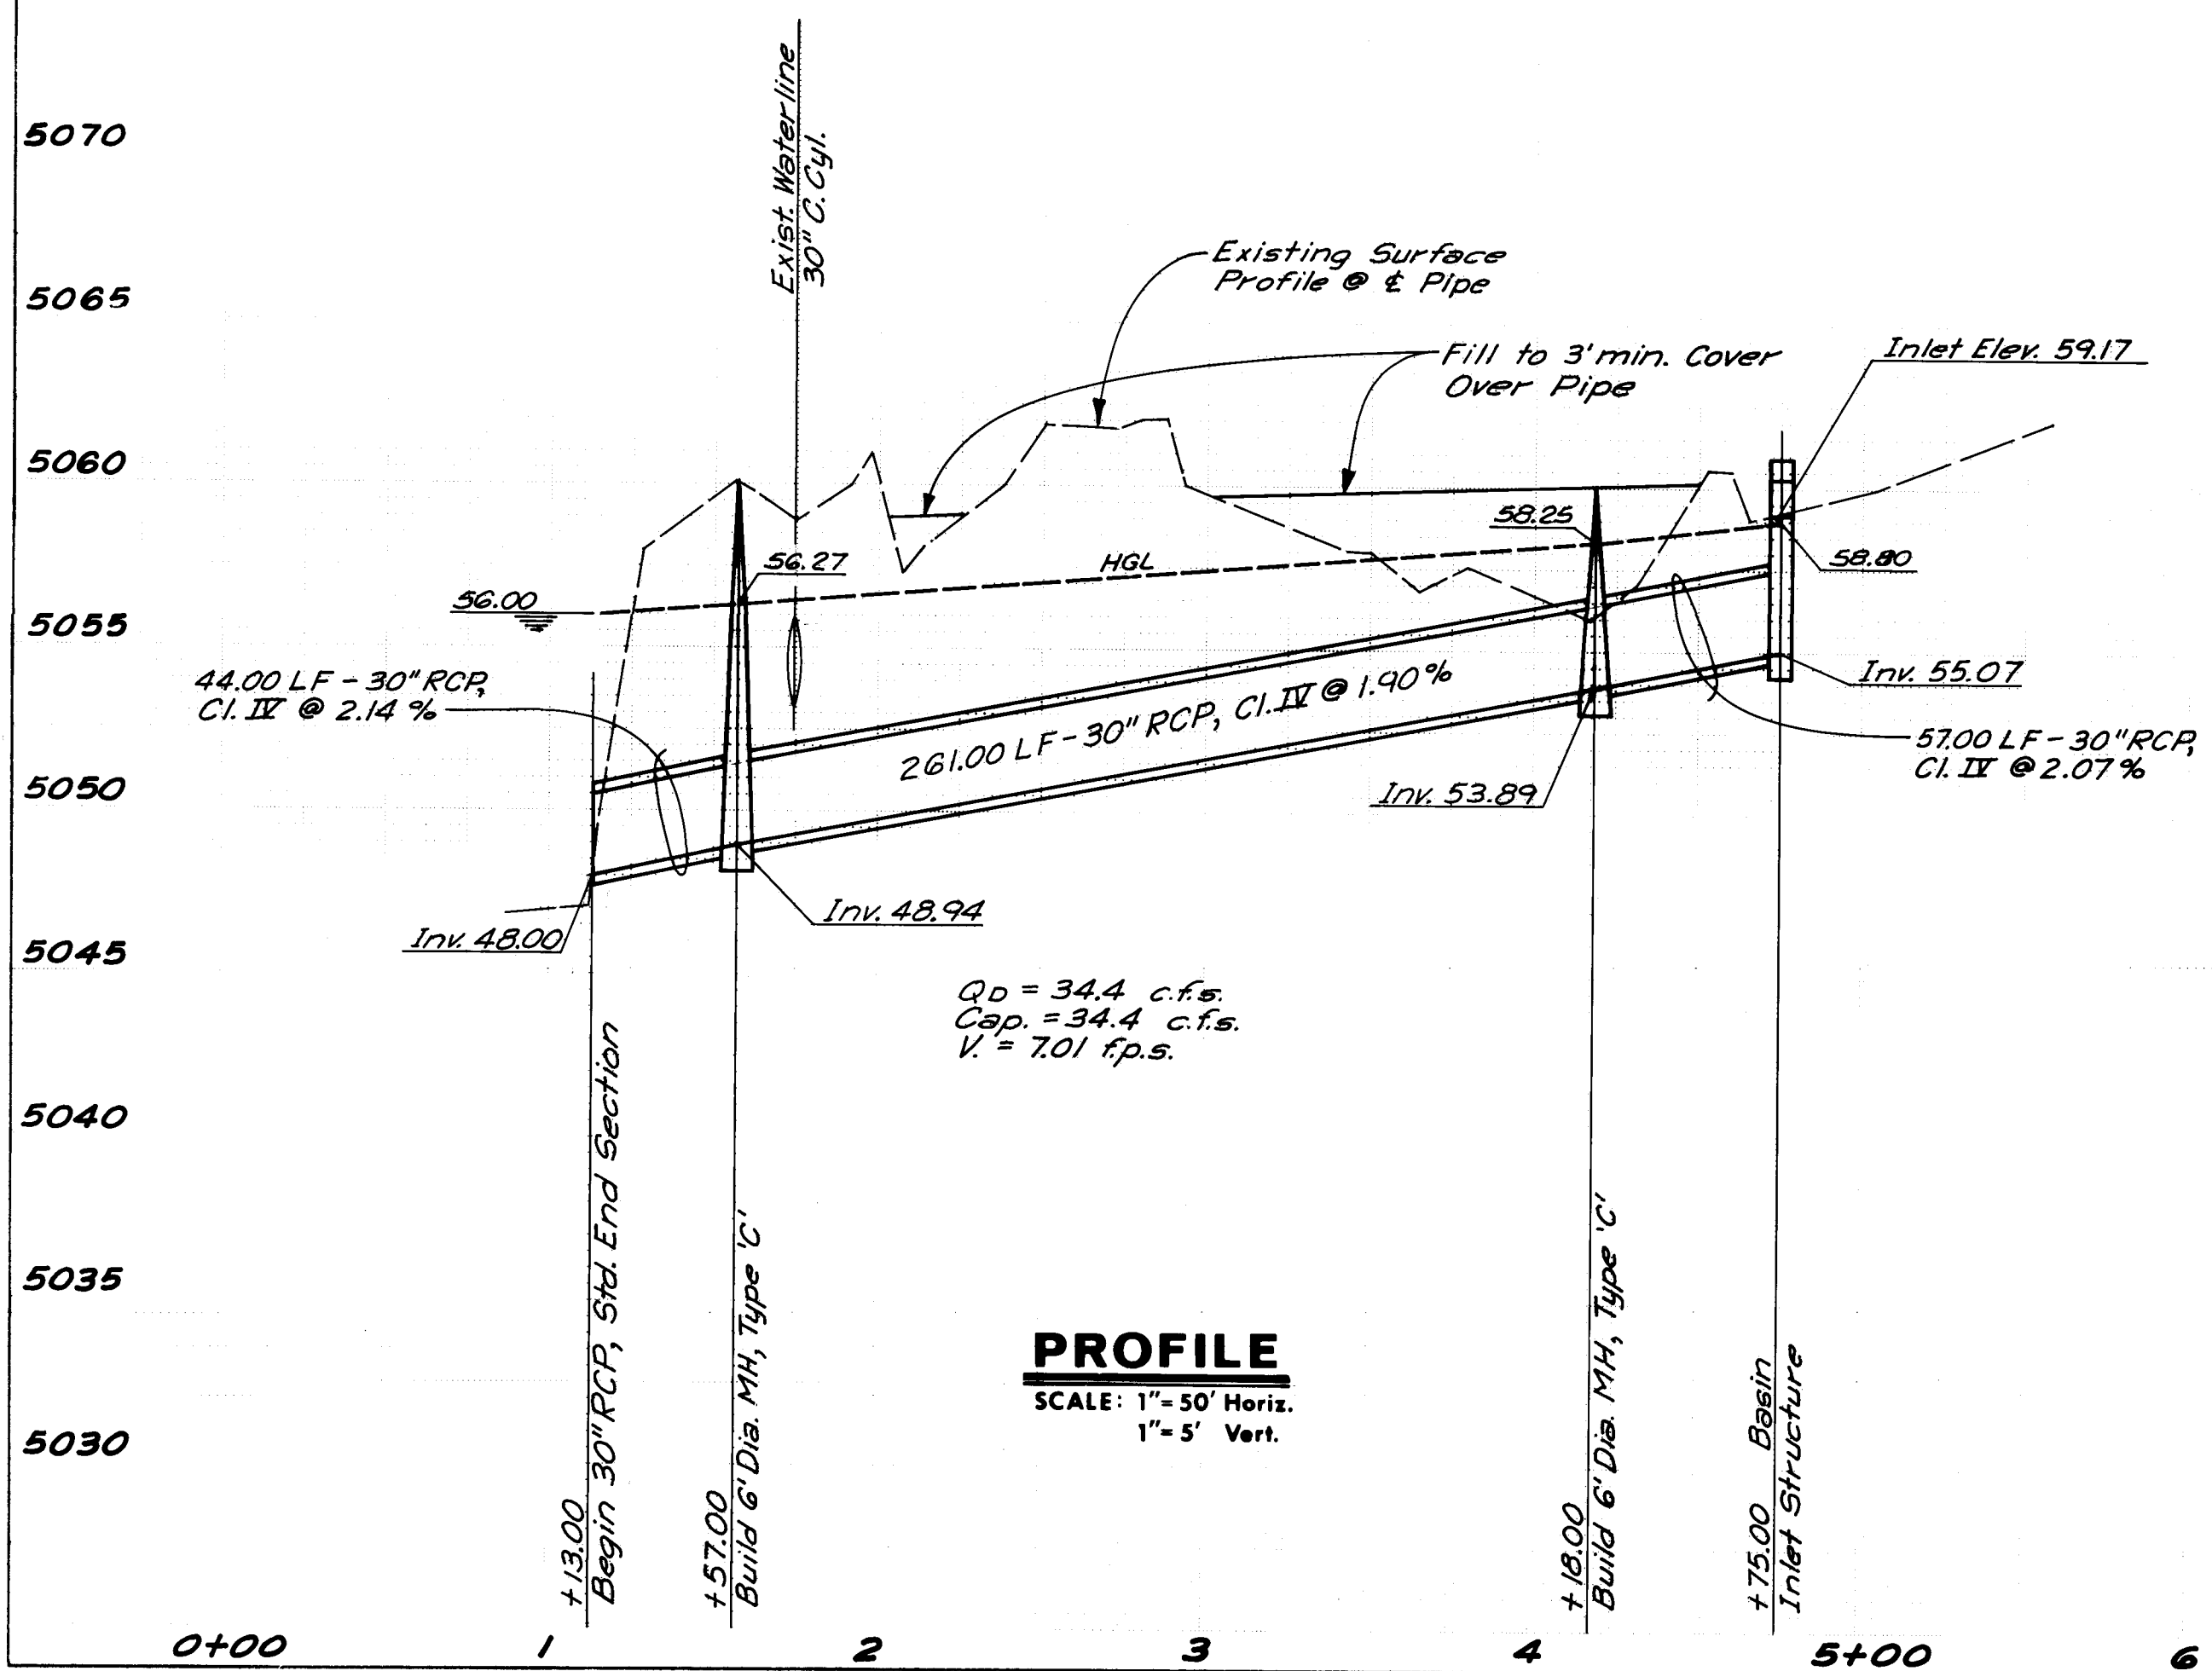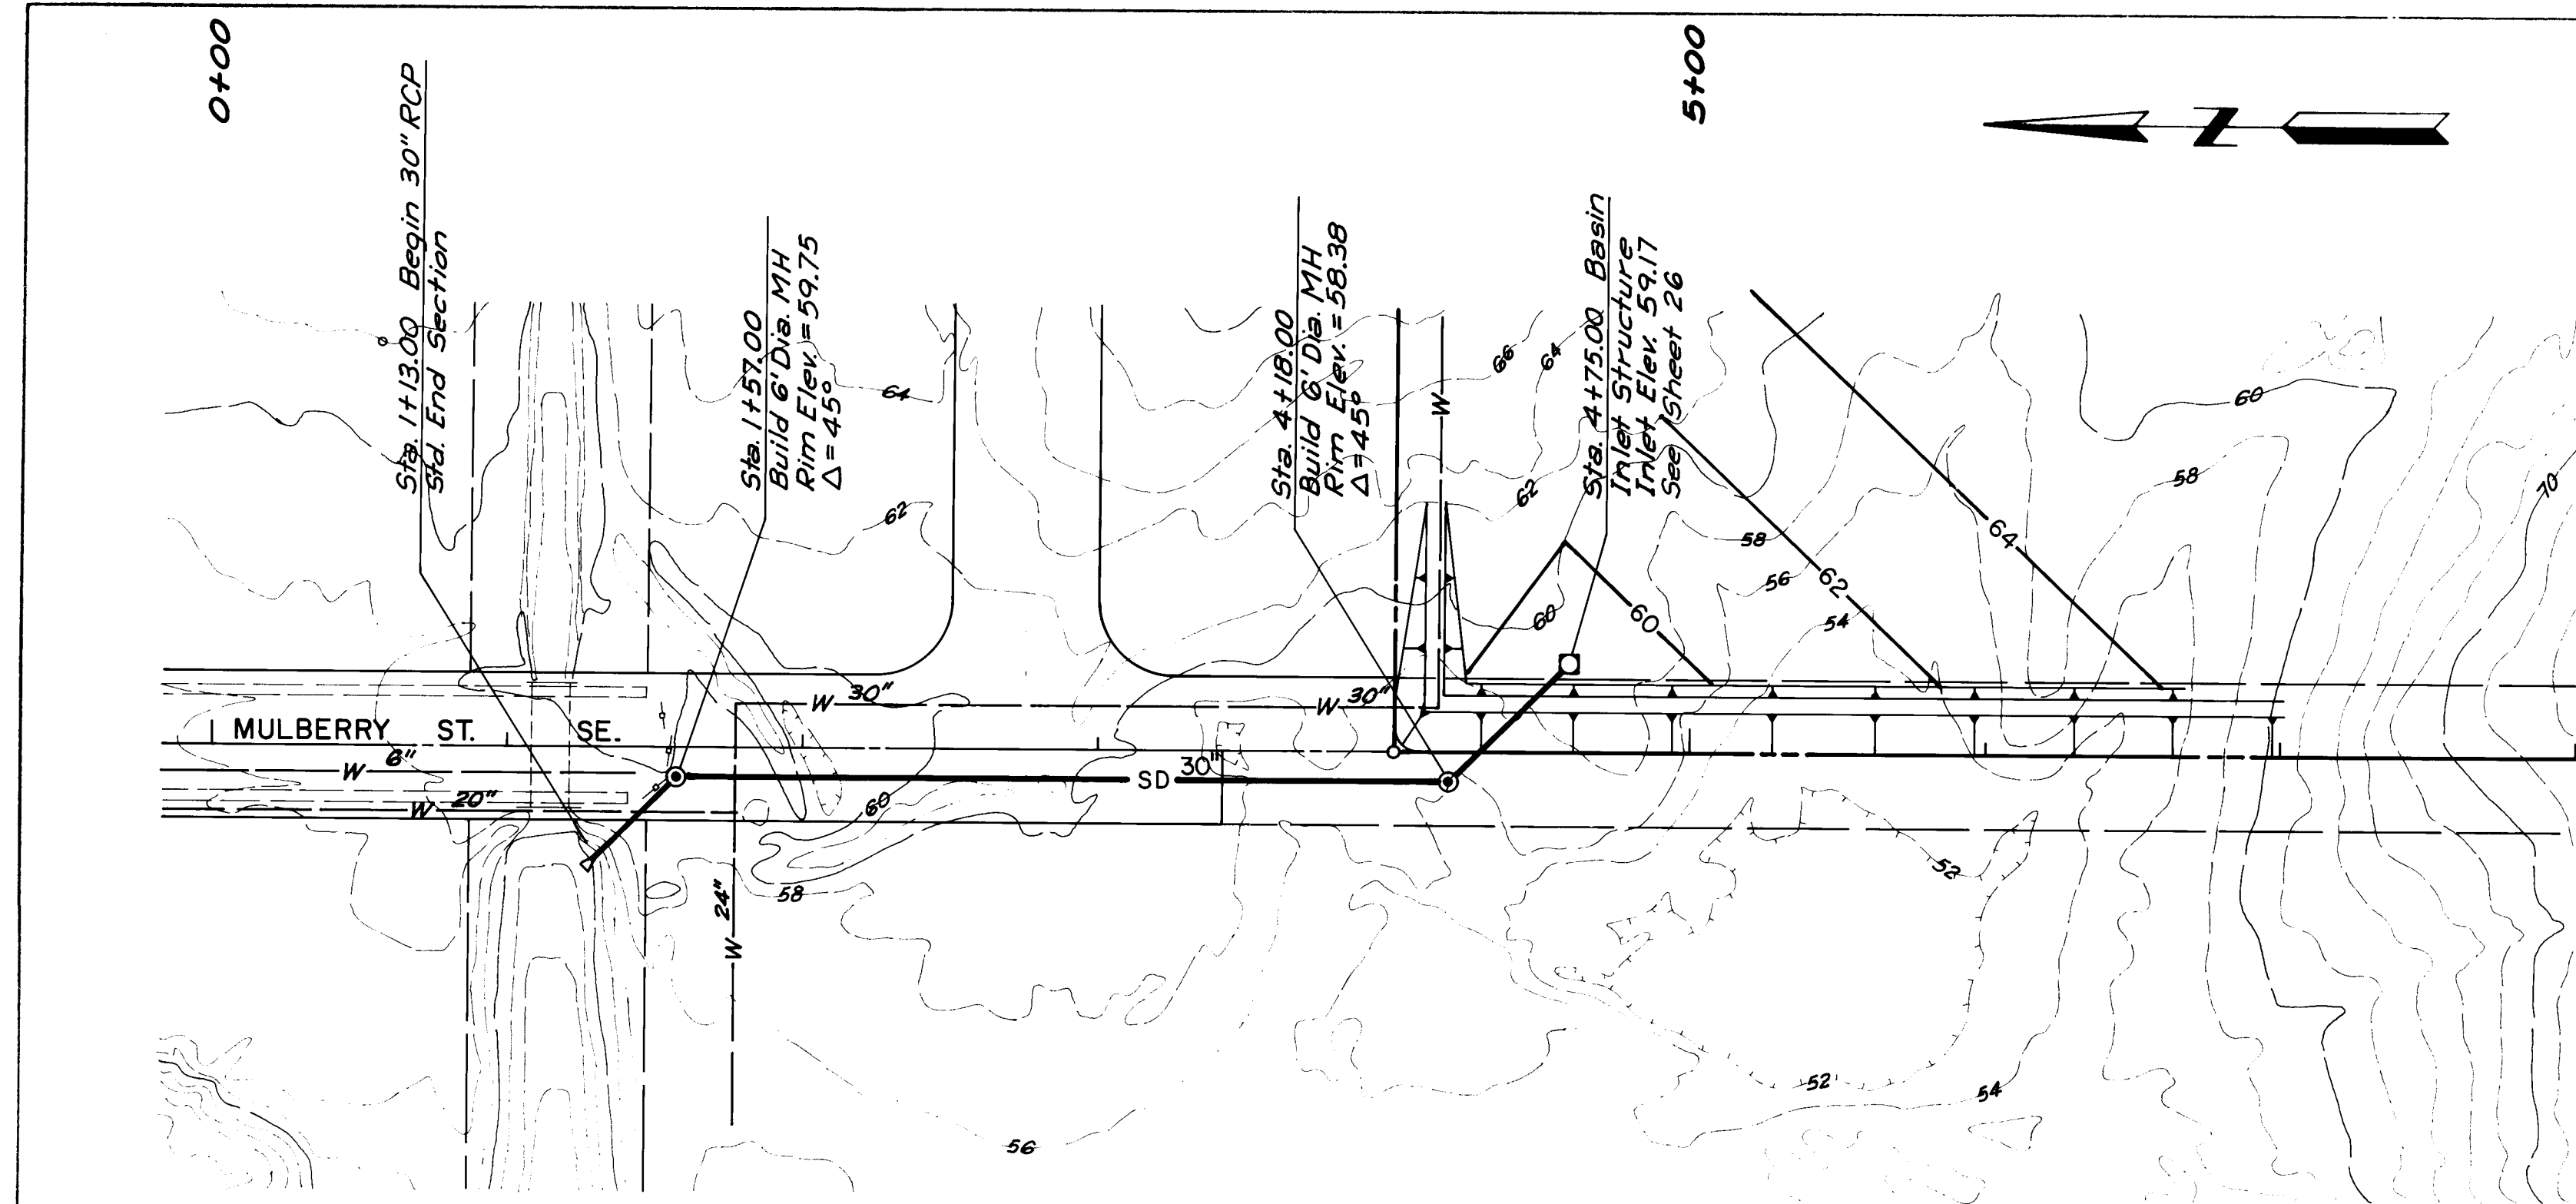

Joseph A. Andrews
RECORD DRAWING
2-8-89

26 29 50 25 89

CITY OF ALBUQUERQUE PUBLIC WORKS DEPARTMENT					
SUNPORT PARK INFRASTRUCTURE IMPROVEMENTS - PHASE I DRAINAGE EASEMENT PLAN & PROFILE					
APPROVALS	ENGINEER	DATE	APPROVALS	ENGINEER	DATE
City Engineer	<i>Andrews</i>	6/25/87	Liquid Waste	<i>JDH</i>	5/22/87
A.C.E. - Design	"	"	Traffic	<i>NADWH</i>	5/22/87
A.C.E. - Hydrology	<i>JDH</i>	5/22/87	Water	<i>JDH</i>	5/22/87
DESIGNED BY JM DATE March, 1987					
DRAWN BY JCS DATE March, 1987					
CHECKED BY JA, JM DATE March, 1987					
DRAWING NO.	2950	MAP NO.	M-15	SHEET OF	25 26

SURVEY INFORMATION		BENCH MARKS		AS BUILT INFORMATION	
NO.	BY	DATE	STA. "1-25-31" ELEVATION 5062.528 STANDARD MNSHC BRASS TABLET SET IN CONCRETE POST LOCATED AT THE NORTHEAST CORNER OF THE HIGHWAY 1-25 BRIDGE CROSSING OVER AN ABANDONED RAILROAD SPUR LINE APPROXIMATELY 1.15 MILES NORTH OF RIO BRAVO BOULEVARD	CONTRACTOR New Concepts Inc.	DATE 1-89
				WORK BY 44#R	DATE 1-89
				INSPECTORS	DATE 2-89
				ACCEPTANCE BY RE	DATE 2-89
				REVISIONS	DATE 1-89
				DRAWING BY 44#R	DATE 1-89
				CHECKED BY	DATE
				RECORDED BY	DATE
				NO	DATE

ENGINEER'S SEAL
REGISTERED PROFESSIONAL ENGINEER
STATE OF NEW MEXICO
JOSEPH A. ANDREWS
ANDREWS, ASBURY & ROBERT, INC.
ALBUQUERQUE, NEW MEXICO

