


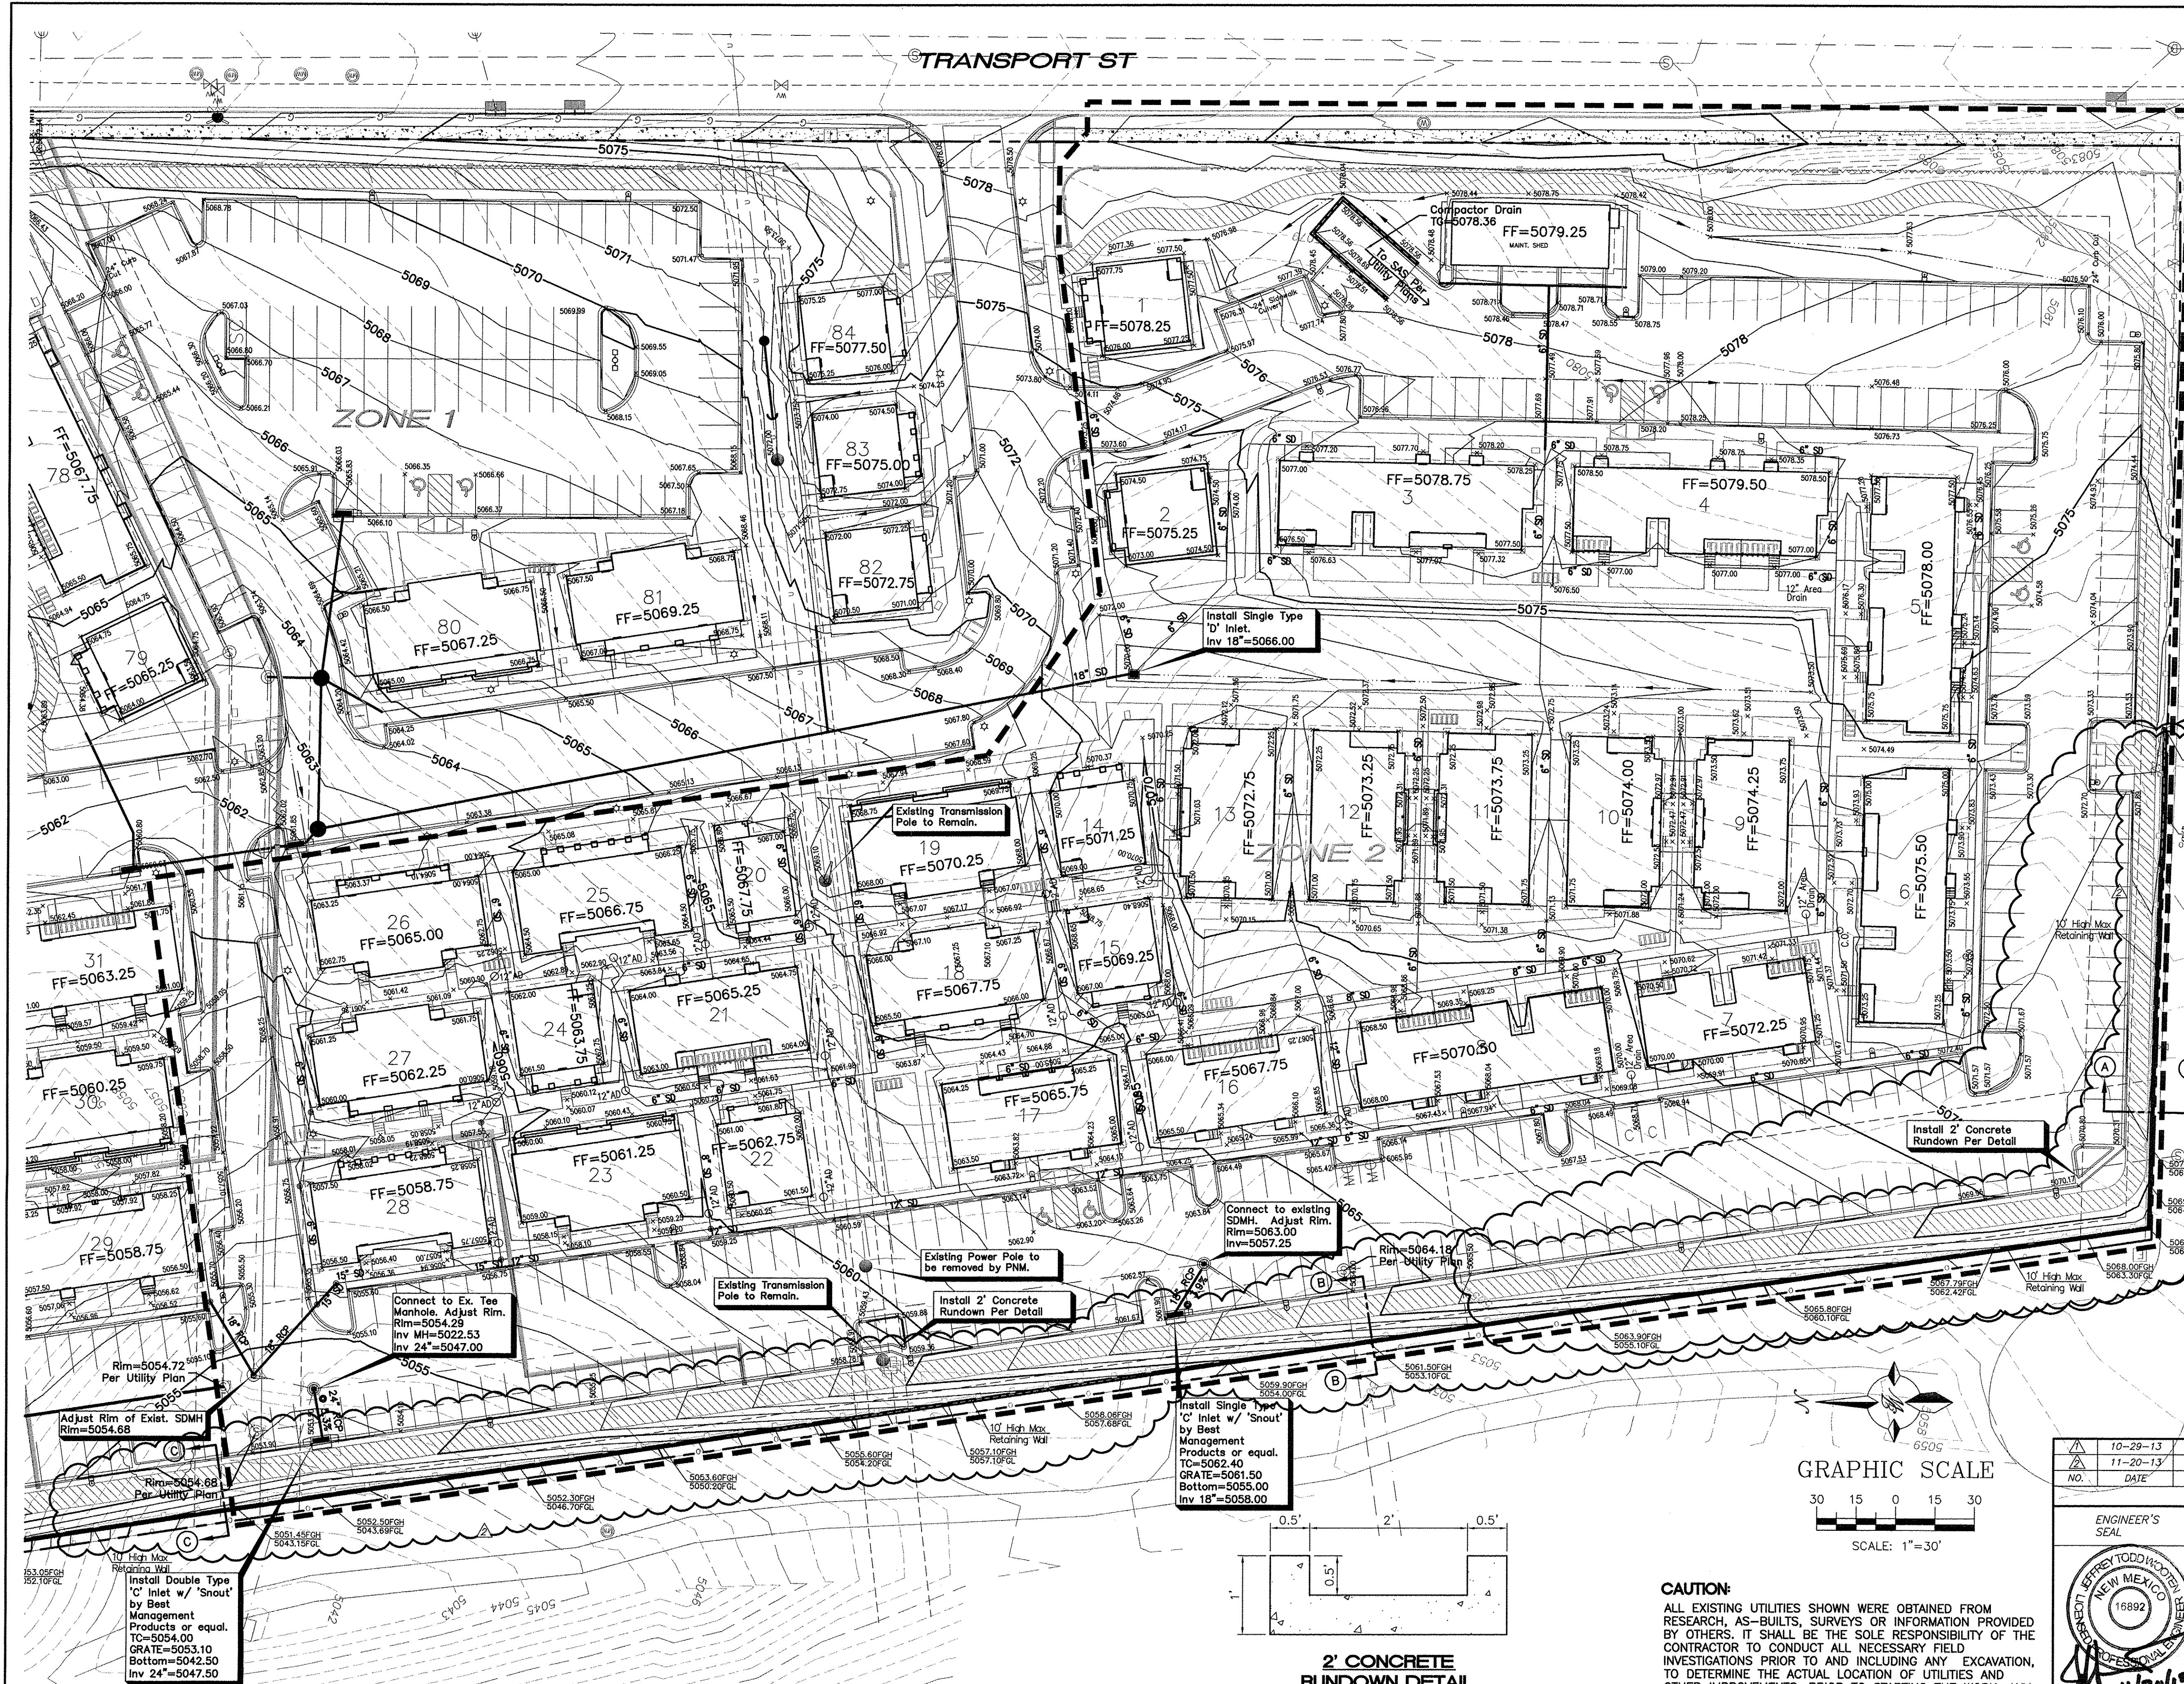


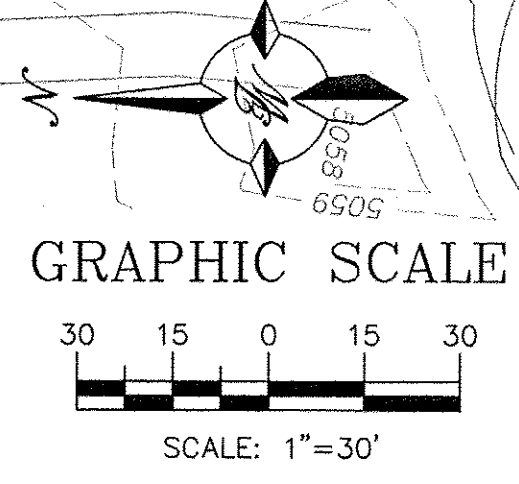

- LEGEND**
- CURB & GUTTER
 - BOUNDARY LINE
 - EASEMENT
 - SIDEWALK
 - EXISTING CURB & GUTTER
 - SINGLE CLEAN OUT
 - DOUBLE CLEAN OUT
 - EXISTING SD MANHOLE
 - EXISTING SAS MANHOLE
 - EXISTING FIRE HYDRANT
 - EXISTING WATER METER
 - EXISTING POWER POLE
 - EXISTING GAS VALVE
 - EXISTING OVERHEAD UTILITIES
 - EXISTING GAS
 - EX. 8" SAS
 - EX. WL
 - EX. RCP
 - EXISTING SANITARY SEWER LINE
 - EXISTING WATER LINE
 - EXISTING STORM SEWER LINE
 - EXISTING INDEX CONTOUR
 - EXISTING CONTOUR

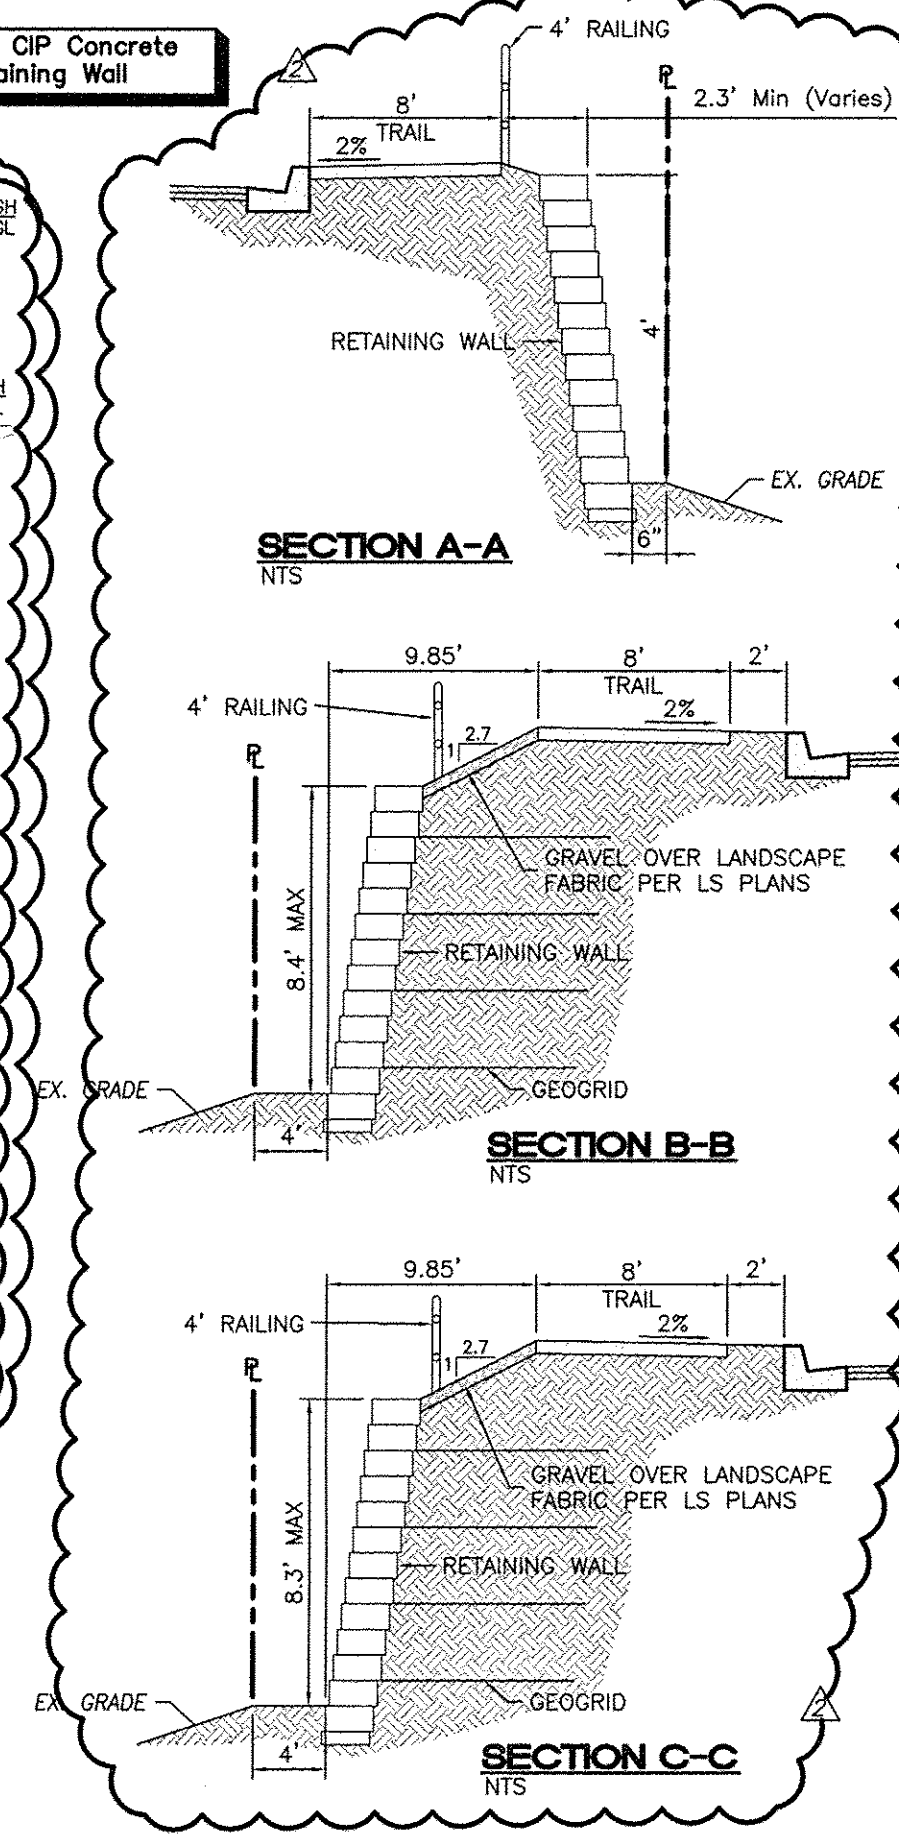

CAUTION:
ALL EXISTING UTILITIES SHOWN WERE OBTAINED FROM RESEARCH, AS-BUILTS, SURVEYS OR INFORMATION PROVIDED BY OTHERS. IT SHALL BE THE SOLE RESPONSIBILITY OF THE CONTRACTOR TO CONDUCT ALL NECESSARY FIELD INVESTIGATIONS PRIOR TO AND INCLUDING ANY EXCAVATION, TO DETERMINE THE ACTUAL LOCATION OF UTILITIES AND OTHER IMPROVEMENTS, PRIOR TO STARTING THE WORK. ANY CHANGES FROM THIS PLAN SHALL BE COORDINATED WITH AND APPROVED BY THE ENGINEER.

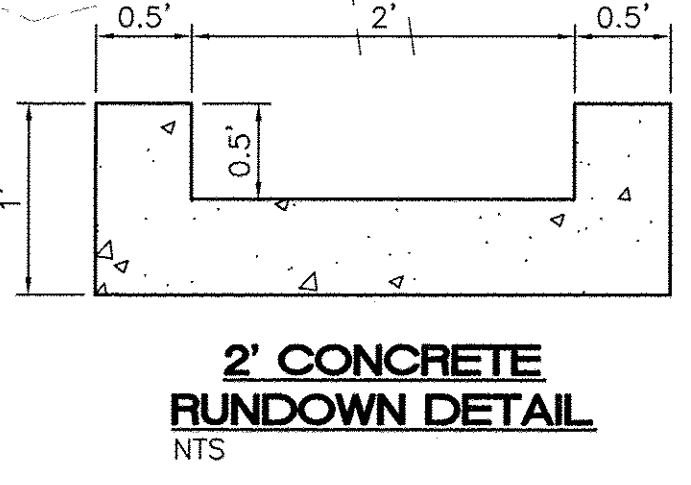

10-29-13		GRADING REVISIONS	JTW
11-20-13		REVISE MULTI-USE TRAIL GRADES AND SHIFT WALL LOCATION	JTW
NO. DATE		REMARKS	BY
REVISIONS			
ENGINEER'S SEAL			
CAPSTONE STUDENT HOUSING			DRAWN BY
ALBUQUERQUE, NM			SH
ZONE 2			DATE
DETAILED GRADING PLAN			8-28-13
			DRAWING
			2011064-GR
			SHEET #
			C5D
			JOB #
			2011064

TIERRA WEST, LLC

5571 MIDWAY PARK PL NE

ALBUQUERQUE, NEW MEXICO 87109

(505) 858-3100

www.tierrawestllc.com