

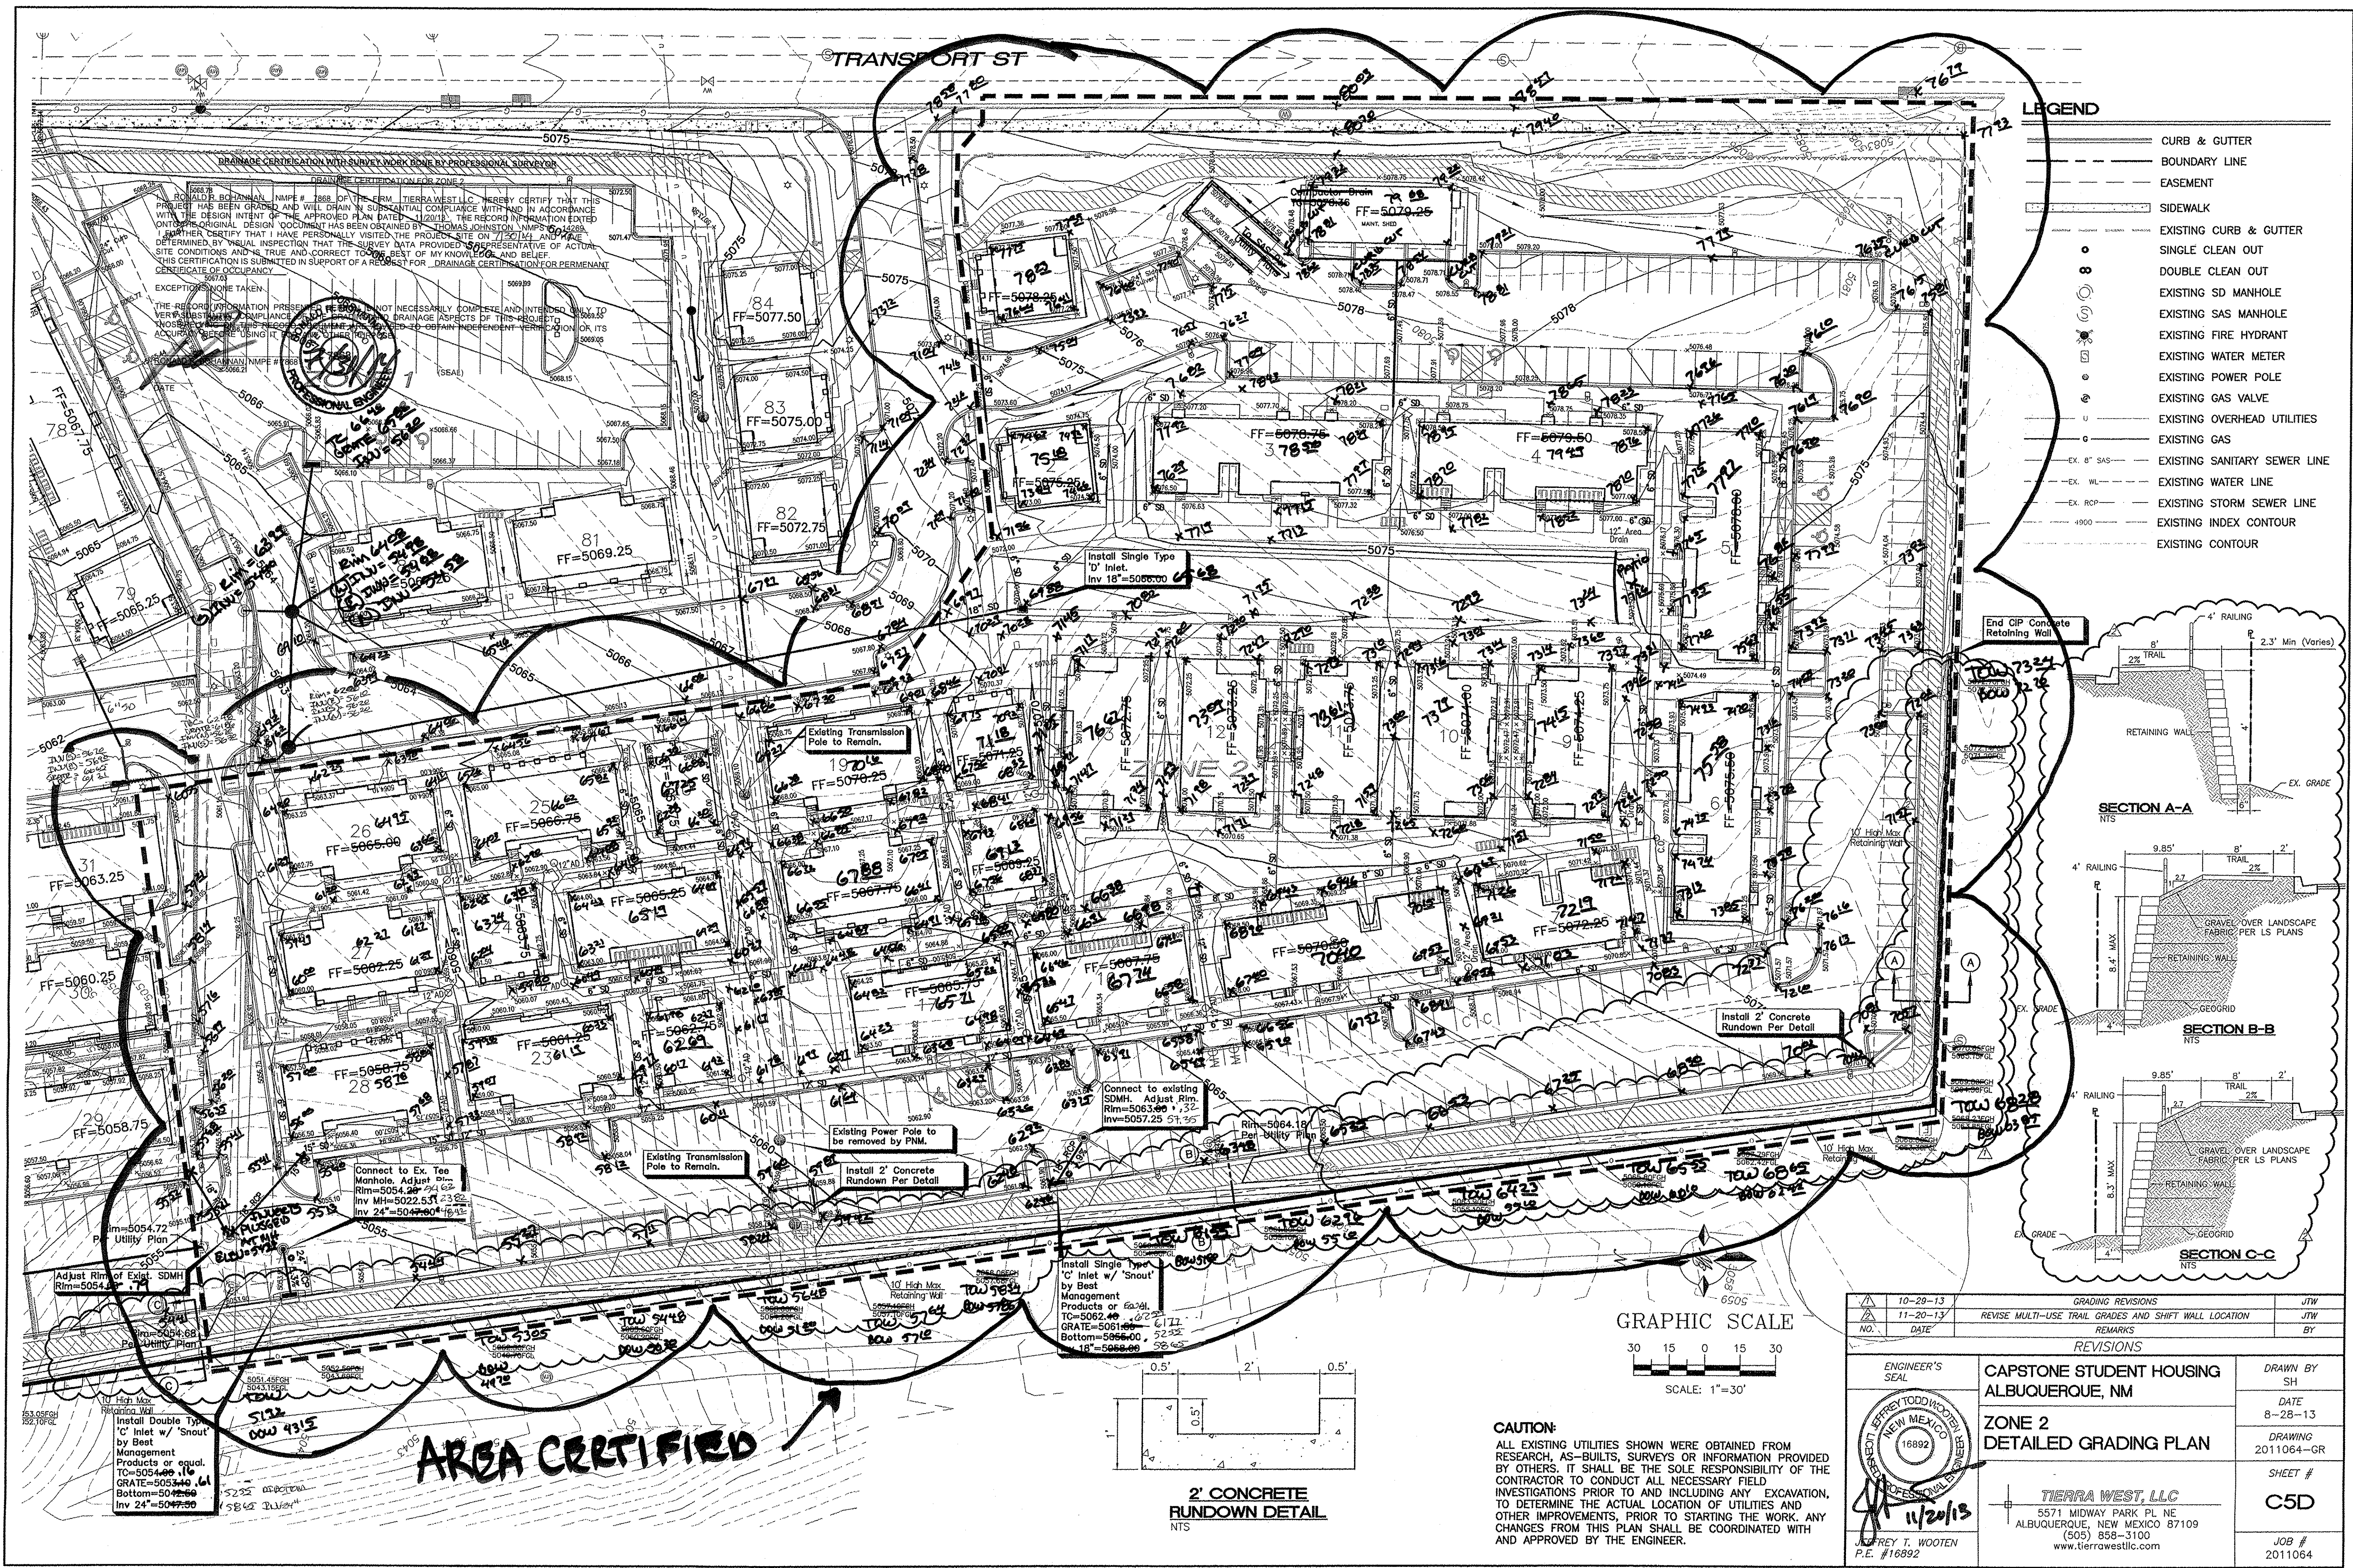


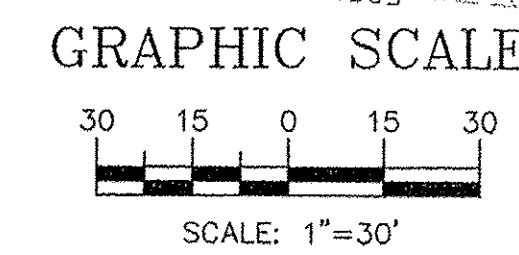

- LEGEND**
- CURB & GUTTER
 - BOUNDARY LINE
 - EASEMENT
 - SIDEWALK
 - EXISTING CURB & GUTTER
 - SINGLE CLEAN OUT
 - DOUBLE CLEAN OUT
 - EXISTING SD MANHOLE
 - EXISTING SAS MANHOLE
 - EXISTING FIRE HYDRANT
 - EXISTING WATER METER
 - EXISTING POWER POLE
 - EXISTING GAS VALVE
 - EXISTING OVERHEAD UTILITIES
 - EXISTING GAS
 - EXISTING SANITARY SEWER LINE
 - EXISTING WATER LINE
 - EXISTING STORM SEWER LINE
 - EXISTING INDEX CONTOUR
 - EXISTING CONTOUR

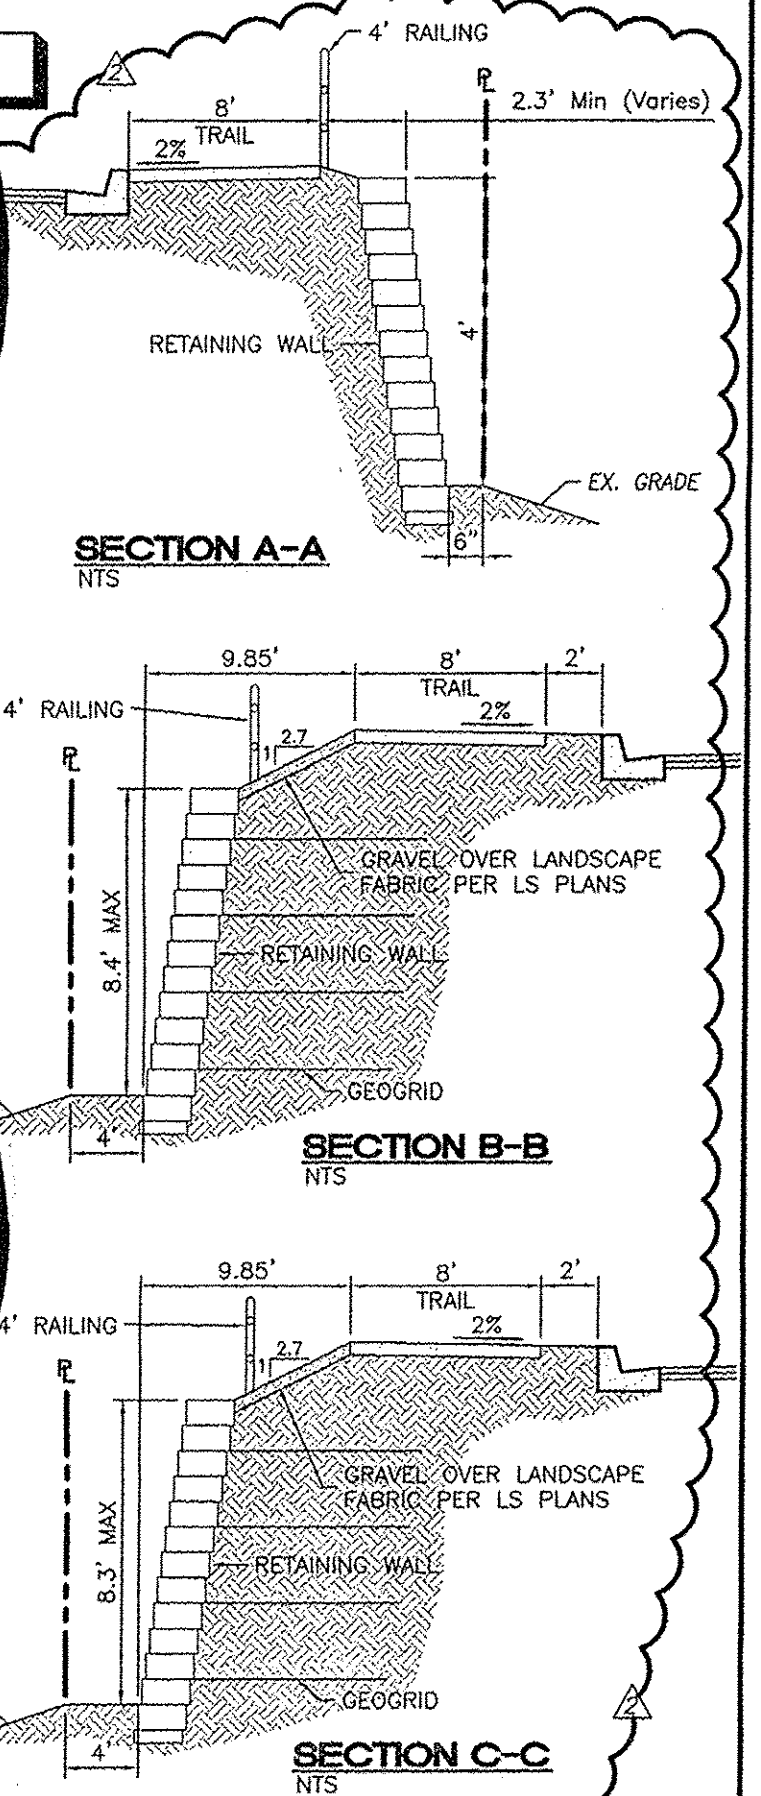

CAUTION:
ALL EXISTING UTILITIES SHOWN WERE OBTAINED FROM RESEARCH, AS-BUILTS, SURVEYS OR INFORMATION PROVIDED BY OTHERS. IT SHALL BE THE SOLE RESPONSIBILITY OF THE CONTRACTOR TO CONDUCT ALL NECESSARY FIELD INVESTIGATIONS PRIOR TO AND INCLUDING ANY EXCAVATION, TO DETERMINE THE ACTUAL LOCATION OF UTILITIES AND OTHER IMPROVEMENTS, PRIOR TO STARTING THE WORK. ANY CHANGES FROM THIS PLAN SHALL BE COORDINATED WITH AND APPROVED BY THE ENGINEER.

GRADING REVISIONS		JTW
NO.	DATE	REMARKS
10-29-13		REVISE MULTI-USE TRAIL GRADES AND SHIFT WALL LOCATION
11-20-13		
REVISIONS		
CAPSTONE STUDENT HOUSING ALBUQUERQUE, NM		
ZONE 2 DETAILED GRADING PLAN		
TERRA WEST, LLC 5571 MIDWAY PARK PL NE ALBUQUERQUE, NEW MEXICO 87109 (505) 858-3100 www.tierrawestllc.com		
ENGINEER'S SEAL JEFFREY T. WOOTEN P.E. #16892		DRAWN BY SH
		DATE 8-28-13
		DRAWING 2011064-GR
		SHEET # C5D
		JOB # 2011064