




CALIFORNIA
ST. SE

SP 06-12-112

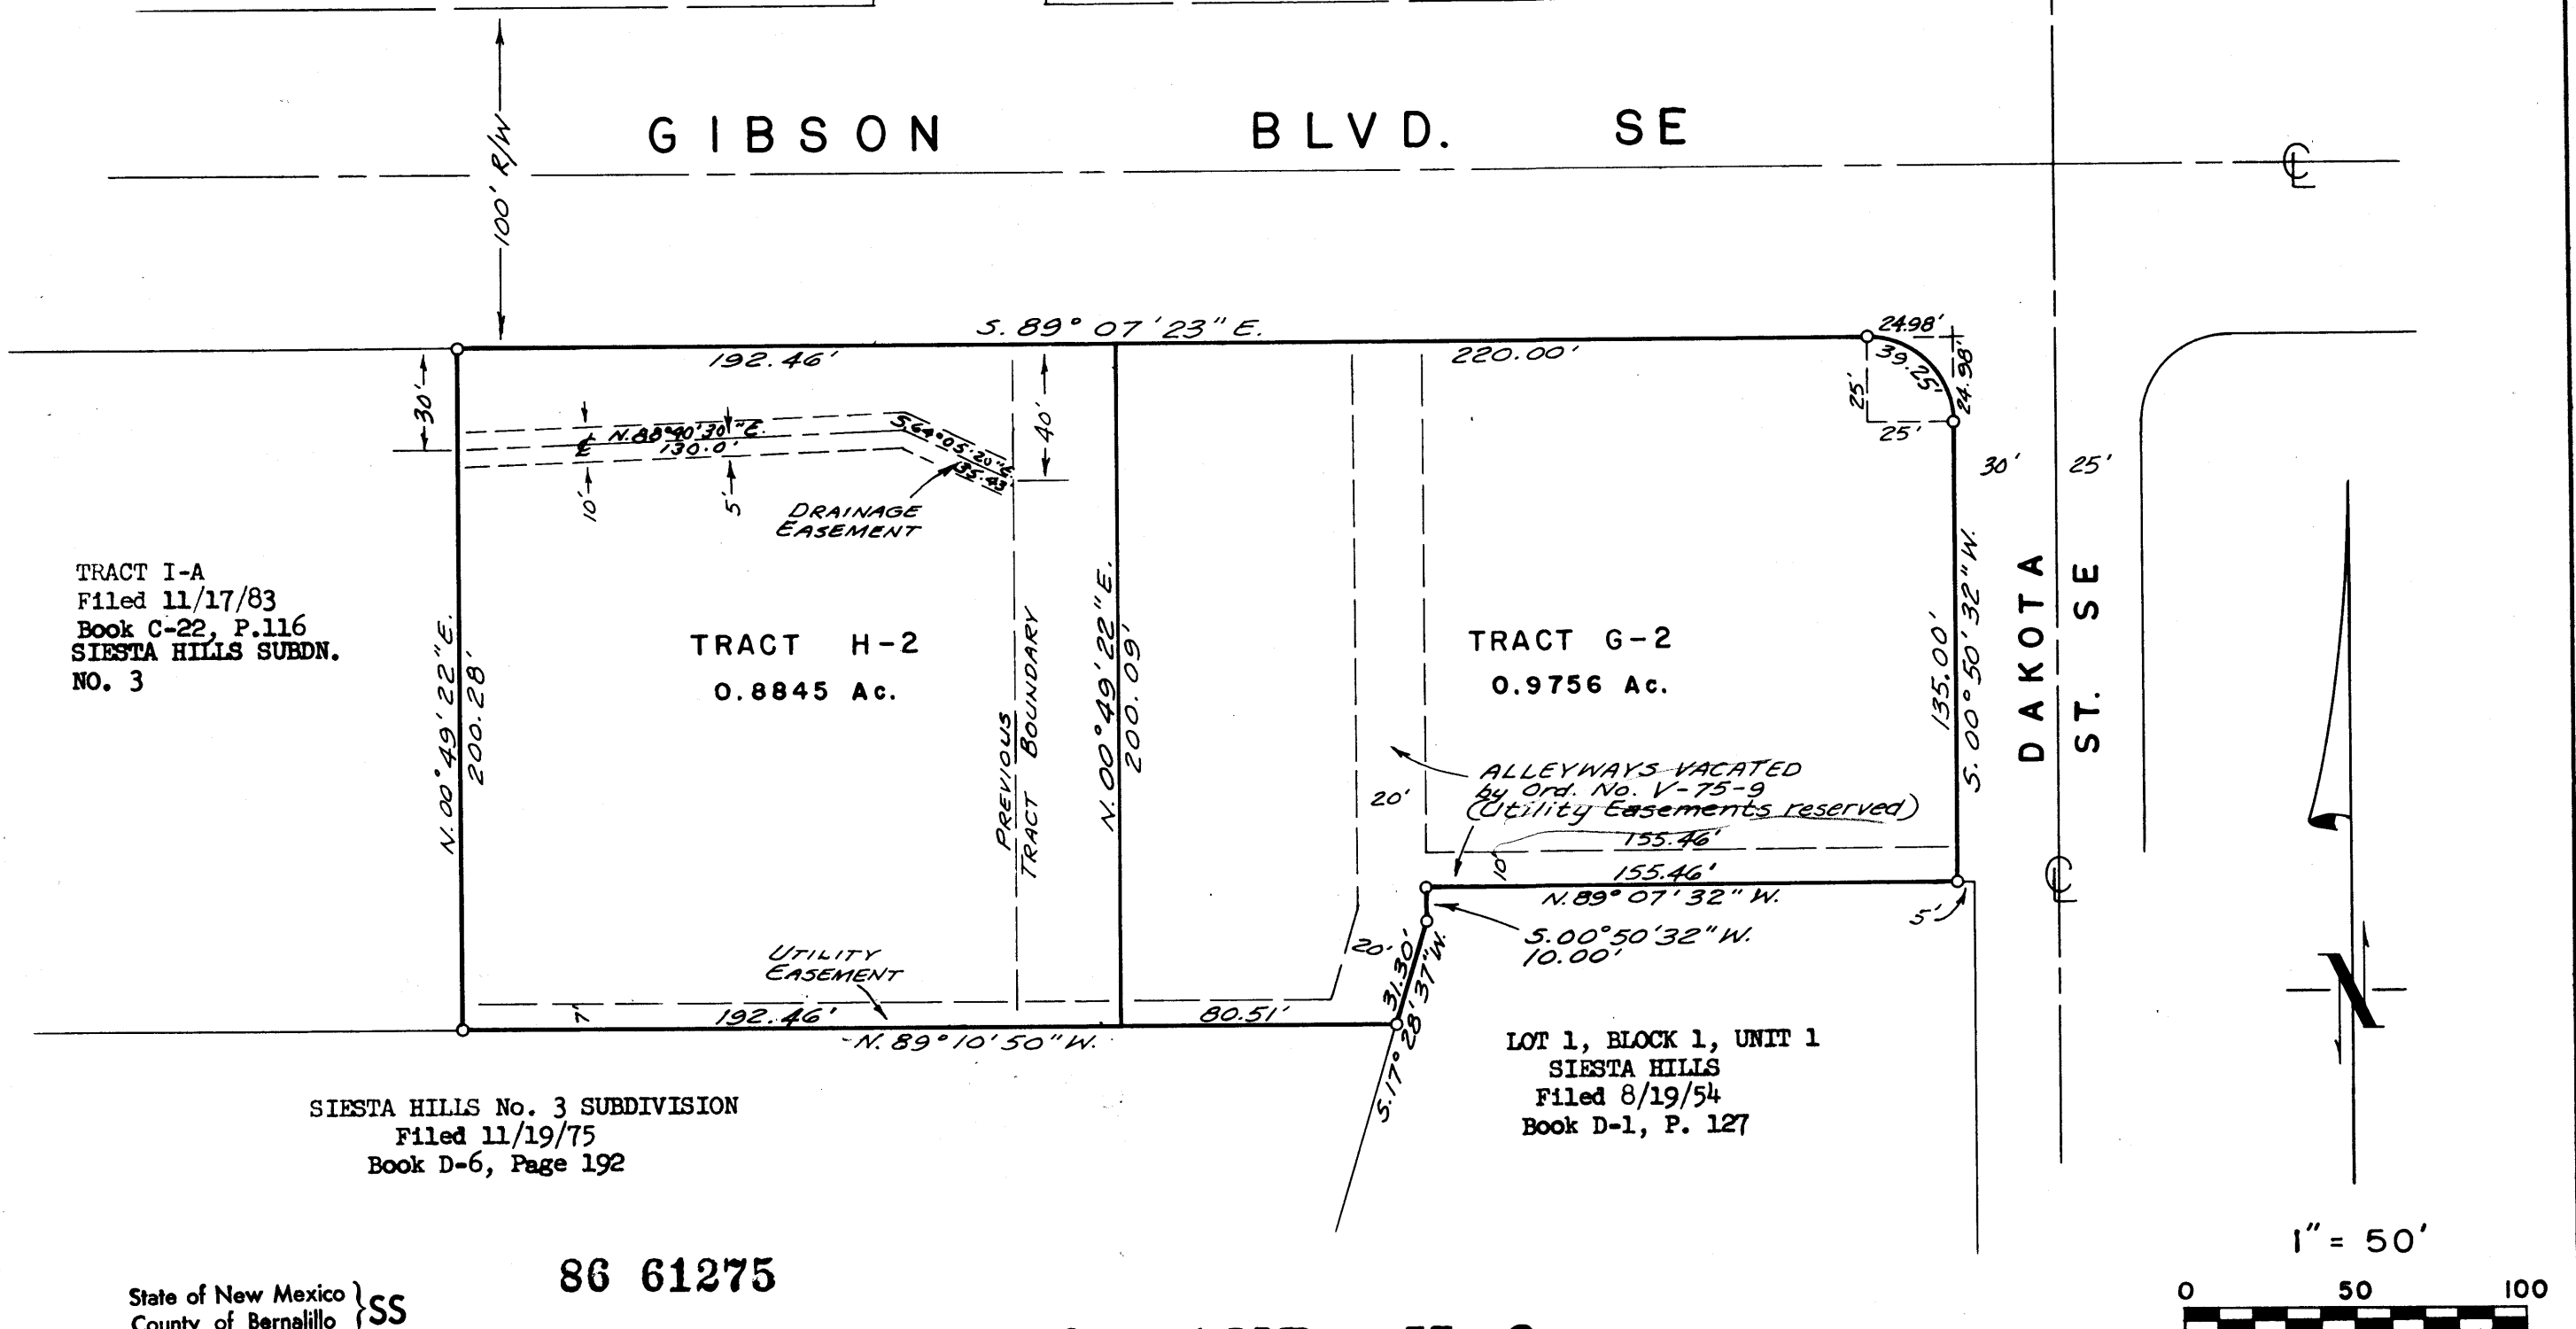

TRACT I-A
Filed 11/17/83
Book C-22, P. 116
SIESTA HILLS SUBDN.
NO. 3

TRACT H-2
0.8845 Ac.

TRACT G-2
0.9756 Ac.

LOT 1, BLOCK 1, UNIT 1
SIESTA HILLS
Filed 8/19/54
Book D-1, P. 127

SIESTA HILLS No. 3 SUBDIVISION
Filed 11/19/75
Book D-6, Page 192

State of New Mexico } SS
County of Bernalillo }
This instrument was filed for record on

JUL 7 1986
At o'clock m. Recorded in Vol. _____
of records of said County Folio _____
Deputy Clerk

86 61275
TRACTS G-2 AND H-2
SIESTA HILLS
SUBDIVISION NO. 2
ALBUQUERQUE, NEW MEXICO

JUNE 1986 ERE AFS #4295
Being a REPLAT of TRACTS G-1-A-1 and H-1-A-1 thereof

DESCRIPTION, FREE CONSENT & DEDICATION:

The above and foregoing Replat of that certain tract of land in the City of Albuquerque, New Mexico, comprising Tracts G-1-A-1 and H-1-A-1 of SIESTA HILLS SUBDIVISION No. 2, as the same are shown and designated on the REPLAT OF TRACTS "G-1-A" & "H-1-A" OF REPLAT OF ALL OF TRACT "I" AND ALL OF TRACTS "H-1" AND "G-1" of said Subdivision filed in the office of the County Clerk of Bernalillo County, New Mexico, March 12, 1985, now replatted and redivided as shown hereon and now comprising Tracts G-2 and H-2 thereof, is with the free consent and in accordance with the desires of the undersigned owners and proprietors thereof, and said owners and proprietors hereby grant the easement(s) shown hereon.

OWNERS AND PROPRIETORS:

LOVELACE MEDICAL FOUNDATION, a Non-profit Organization, By Richard E. Gillock

Nancy Odell
NANCY ODELL

Helen R. Brungardt
HELEN R. BRUNGARDT

Patti Bear Paw
PATTI BEAR PAW

Kenneth Odell
KENNETH ODELL

Guy M. Brungardt
GUY M. BRUNGARDT

STATE OF NEW MEXICO)
COUNTY OF BERNALILLO) ss. The foregoing instrument was acknowledged before me on
JUNE 30, 1986, by RICHARD E. GILLOCK
on behalf of LOVELACE MEDICAL FOUNDATION, a Non-profit
Organization, and by NANCY ODELL, KENNETH ODELL, HELEN
R. BRUNGARDT, GUY M. BRUNGARDT, and PATTI BEAR PAW.

Edward Ross Elder
EDWARD ROSS ELDER, Notary Public
My Commission expires July 18, 1987.


SURVEYOR'S CERTIFICATE:

I, EDWARD ROSS ELDER, a duly qualified Land Surveyor licensed under the laws of the State of New Mexico, hereby certify that this Plat was prepared by me, that it is true and correct to the best of my knowledge and belief, that it shows all easements of record, and that it meets the minimum requirements for monumentation and surveys of the Albuquerque Subdivision Ordinance.

Edward Ross Elder
EDWARD ROSS ELDER, N.M.R.L.S. No. 4690

The foregoing certificate was acknowledged before me on
June 12, 1986, by EDWARD ROSS ELDER.

Edward K. Elder
EDWARD K. ELDER, Notary Public
My Commission expires August 26, 1986.

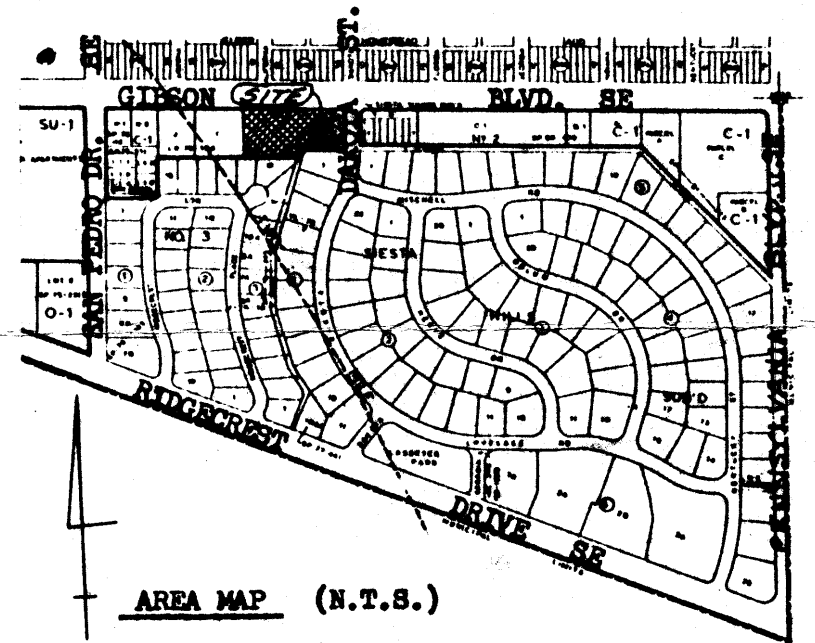

M-18-Z

NOTES:

1. The purpose of this Replat is to move the boundary between Tracts G-1-A-1 and H-1-A-1 eastward 30.46 feet.
2. The basis of bearings and distances shown hereon is the REPLAT OF TRACT "I" AND ALL OF TRACTS "H-1" AND "G-1", SIESTA HILLS SUBDIVISION NO. 2, filed November 17, 1983, Book C-22, P. 116, Records of Bernalillo County.
3. No field work was done in preparing this Replat.
4. City of Albuquerque water and sanitary sewer service to Tracts G-2 and H-2 must be verified and co-ordinated with the Water Resource Department, City of Albuquerque, New Mexico.



APPROVALS:

<u>Frank J. Leguina</u> 7/3/86 CITY ENGINEER	<u>Terry D. Brown</u> 7-3-86 TRAFFIC ENGINEERING
<u>NA</u> WATER RESOURCES DEPT.	<u>NA</u> CITY SURVEYOR
<u>Frank J. Leguina</u> 7/3/86 A.M.A.F.C.A.	<u>NA</u> PARKS & RECREATION
<u>Loan Elvick</u> 6-20-86 PROPERTY MANAGEMENT	<u>Richard Brown</u> 7-9-86 CITY/COUNTY PLANNING
DRB-86-413	SP-86-243

RECEIVED
JUL 18 1986
HYDROLOGY SECTION

KEYED NOTES


- CONSTRUCT NEW ASPHALT PAVING PER TYPICAL SECTION, SHEET 2.
- CONSTRUCT EXTRUDED CONCRETE CURB PER TYPICAL SECTION, SHEET 2.
- NEATLY SAWCUT, REMOVE AND DISPOSE OF EXISTING CURB AND GUTTER AND 1'-0" MINIMUM ASPHALT PAVING, CONSTRUCT 24" DRIVEPAD PER C.O.A. STD. DWG. 2425 AND REPLACE ASPHALT PAVING PER C.O.A. STD. DWG. 2465.
- PAINT 4" WIDE WHITE PARKING LOT STRIPES (TRAFFIC PAINT), TYPICAL.
- PAINT 4" WIDE YELLOW CROSS HATCH PAVEMENT MARKINGS AT 45 DEGREE ANGLE.
- INSTALL ONE PREFABRICATED GUARD SHELTER.
- INSTALL 6" FENCE PER TYPICAL SECTION, SHEET 2.
- INSTALL 24" WIDE X 6' HIGH DOUBLE LEAF GATE TO CONFORM WITH TYPICAL FENCE SECTION.
- REMOVE AND DISPOSE OF EXISTING TREES.
- REMOVE AND DISPOSE OF EXISTING SHRUBS.
- REMOVE AND DISPOSE OF EXISTING SIGN.
- INSTALL PARKING AREA LIGHTING IN ACCORDANCE WITH SECTION 14-16-3-9 OF THE C.O.A. COMPREHENSIVE ZONING CODE, MARCH 29, 1994, COMPLETE IN PLACE INCLUDING ALL CONDUIT, CONDUCTORS, METER, RISERS AND CONNECTIONS TO EXISTING POWER SOURCE.
- TRIM AND/OR REMOVE EXISTING TREES TO FACILITATE CONSTRUCTION.
- EXISTING BILLBOARD TO REMAIN.
- EXISTING SIGN TO REMAIN.
- NEATLY SAWCUT, REMOVE AND DISPOSE OF EXISTING CURB AND GUTTER AND 1'-0" MINIMUM ASPHALT PAVING, CONSTRUCT THREE (3) 24" SIDEWALK CULVERTS PER C.O.A. STD. DWG. 2236 AND REPLACE ASPHALT PAVING PER C.O.A. STD. DWG. 2465.
- CONSTRUCT CONCRETE RUNDOWN WITH BOLLARDS PER DETAIL, SHEET 2.

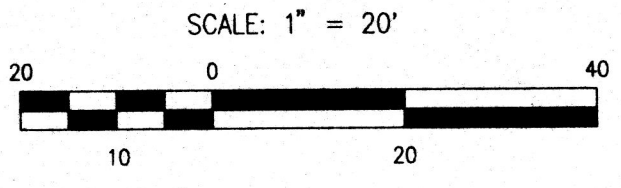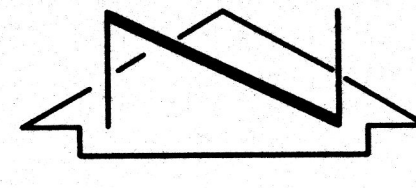

BOUNDARY TABLES

LINE	DIRECTION	DISTANCE
L1	S 00°48'00" W	10.00'
L2	S 17°26'00" W	31.28'
L3	N 89°12'00" W	55.59'

CURVE	RADIUS	LENGTH	CHORD	BEARING	DELTA	TANGENT
C1	25.00'	39.27'	35.36'	S 44°12'00" E	90°00'00"	25.00'

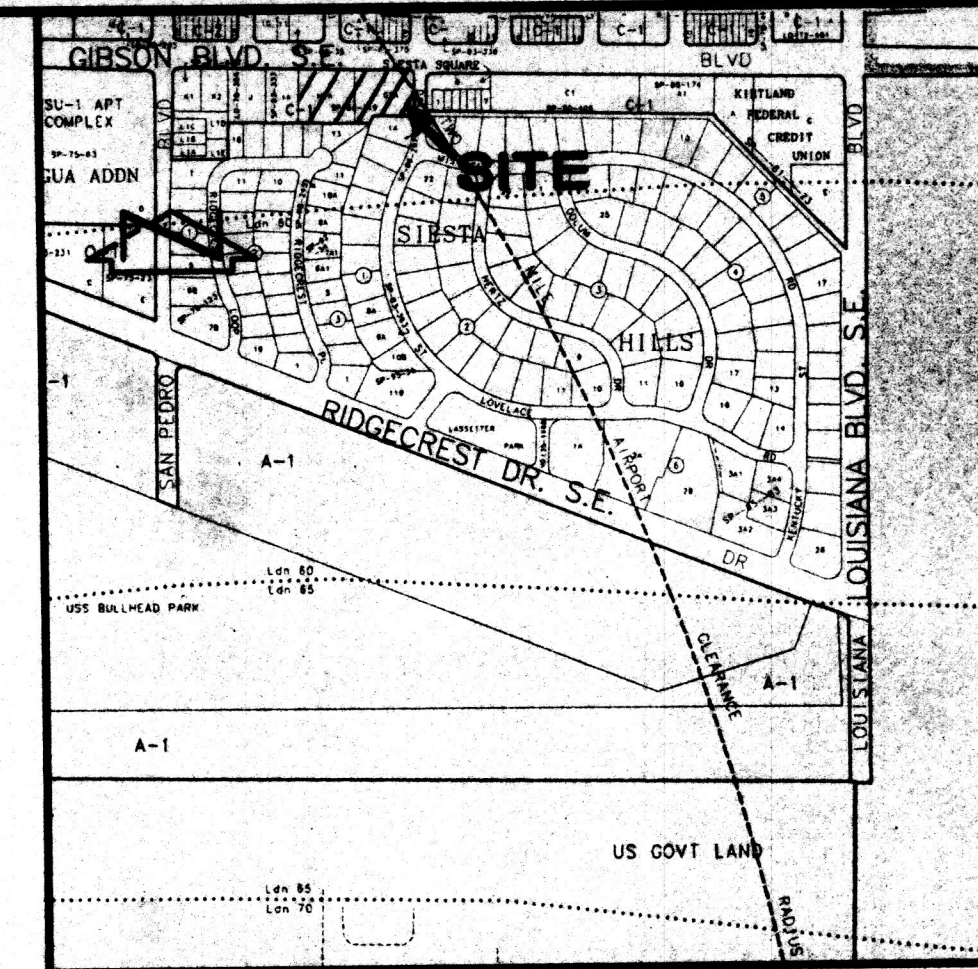

VICINITY MAP

SCALE: 1" = 750'

M-18

PROJECT BENCHMARK

A.C.S. BENCHMARK "9-L18"
A "D" CHISELED ON TOP OF CONCRETE CURB AT ENE CURB RETURN, AT THE INTERSECTION OF GIBSON BLVD. S.E. AND FLORIDA ST. S.E., IN THE NORTHEAST QUADRANT OF THE INTERSECTION.
ELEVATION = 5319.72 FEET (M.S.L.D.)

T.B.M.

A "D" CHISELED IN THE TOP OF CURB AT THE SW CURB RETURN OF THE INTERSECTION OF DAKOTA ST. S.E. AND GIBSON BLVD. S.E. AS SHOWN ON THE DRAWINGS.
ELEVATION = 5314.89 FEET (M.S.L.D.)

PARKING SPACE ANALYSIS:

179 REGULAR SPACES

THIS IS NOT A TOPOGRAPHIC OR A BOUNDARY SURVEY. APPARENT PROPERTY CORNERS ARE SHOWN FOR ORIENTATION ONLY. BOUNDARY DATA AND TOPOGRAPHIC DATA SHOWN HEREON ARE FROM A BOUNDARY AND TOPOGRAPHIC SURVEY OF TRACTS G-2-A AND H-2-A, SIESTA HILLS SUBDIVISION No. 2, ALBUQUERQUE, NEW MEXICO PREPARED BY JEFF MORTENSEN & ASSOCIATES, INC. DATED AUGUST 1997.

NOTE: ALL DIMENSIONS ARE TO FACE OF CURB

LEGEND

T.B.M. ELEV. F.D. R.P. W/ P.O.B. S.F.N.F. I.D. R.O.W. CONC. C.P. RCP T.C. F.L. B.C. B.W. N.G. T.G. E.C. T.A. E.A. B.S.W. S.W. T.O.S. S.A.S. S.D. A. M.H. STD. C&G (TYP.) TEL. O/H ELEC. (3) U/G DIA. W.V. P.P. L.P. T.R.F. CP DRL.	TEMPORARY BENCHMARK ELEVATION FOUND IRON PIPE WITH POINT OF BEGINNING SEARCH FOR NOT FOUND IDENTIFICATION RIGHT-OF-WAY CONCRETE CAST IRON CONCRETE PIPE REINFORCED CONCRETE PIPE TOP OF CURB FLOWLINE BACK OF CURB BOTTOM OF WALL AT GROUND NATURAL GROUND TOP OF GRATE EDGE OF CONCRETE TOP OF ASPHALT EDGE OF ASPHALT BACK OF SIDEWALK SIDEWALK TOP OF CONCRETE SANITARY SEWER STORM DRAIN WATERLINE MANHOLE STANDARD CURB & GUTTER TYPICAL TELEPHONE OVERHEAD ELECTRIC (NO. OF LINES) UNDERGROUND DIAMETER WATER VALVE POWER POLE LIGHT POLE TRAFFIC GATE POST DOUBLE	PROPERTY CORNER CURB SCRATCH 16.1 SPOT ELEVATION TELEPHONE RISER WATER VALVE SANITARY SEWER MANHOLE STORM DRAIN MANHOLE TRAFFIC SIGN GUY ANCHOR POWER POLE LIGHT POST GATE POST STORM INLET SMALL TREE CONFEROUS TREE LARGE SHRUBS DECIDUOUS TREE NEW LIGHT POLE
--	---	--

---	PROPERTY LINE
---	ADJOINER LINE
---	EASEMENT LINE
---	UTILITY LINE
---	FLOWLINE
---	NEW 6" FENCE

EASEMENT KEYED NOTES

- UTILITY EASEMENTS RESERVED BY V-75-10 IN FORMER ALLEYS
- 5' PUBLIC UTILITY EASEMENT GRANTED BY PLAT D1-127
- 7/10' POWER AND TELEPHONE EASEMENT GRANTED BY PLAT D6-192
- 7' PUBLIC UTILITY EASEMENT IDENTIFIED BY PLAT C22-116
- 10' DRAINAGE EASEMENT IDENTIFIED BY PLAT C26-135


SITE PLAN

LOVELACE HOSPITAL STAFF SHUTTLE LOT




JEFF MORTENSEN & ASSOCIATES, INC.
6010-B MIDWAY PARK BLVD. N.E.
ALBUQUERQUE, N.M. 87109
ENGINEERS SURVEYORS (505) 345-4250


DESIGNED BY	J.G.M.	NO.	DATE	BY	REVISIONS	JOB NO.
DRAWN BY	T.N.T.	1	09-10-97	J.G.M.	ADD CURB AT WEST SIDE OF LOT.	970611
APPROVED BY	J.G.M.					DATE
						08-1997
						SHEET 1 OF 4

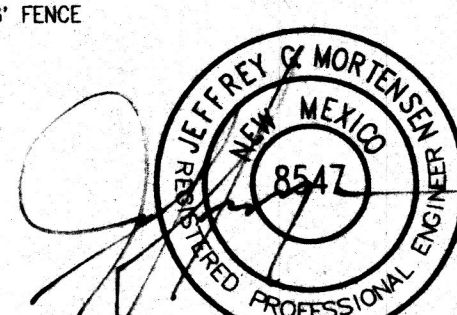


09-10-97 08-28-97

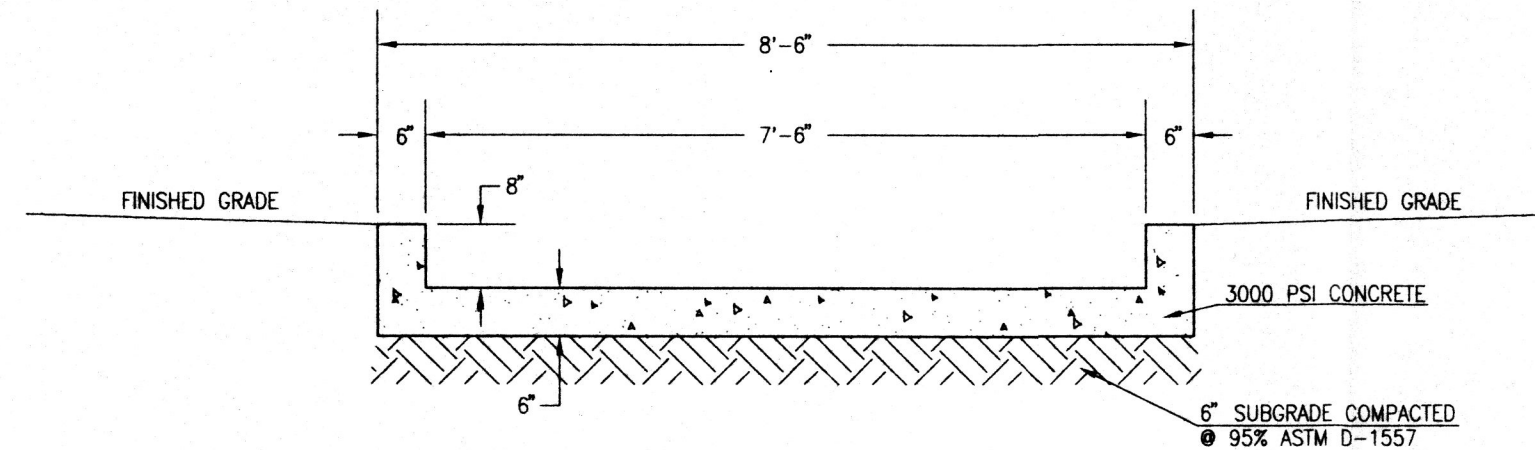


SECTION A-A
SCALE: 1" = 2'-0"

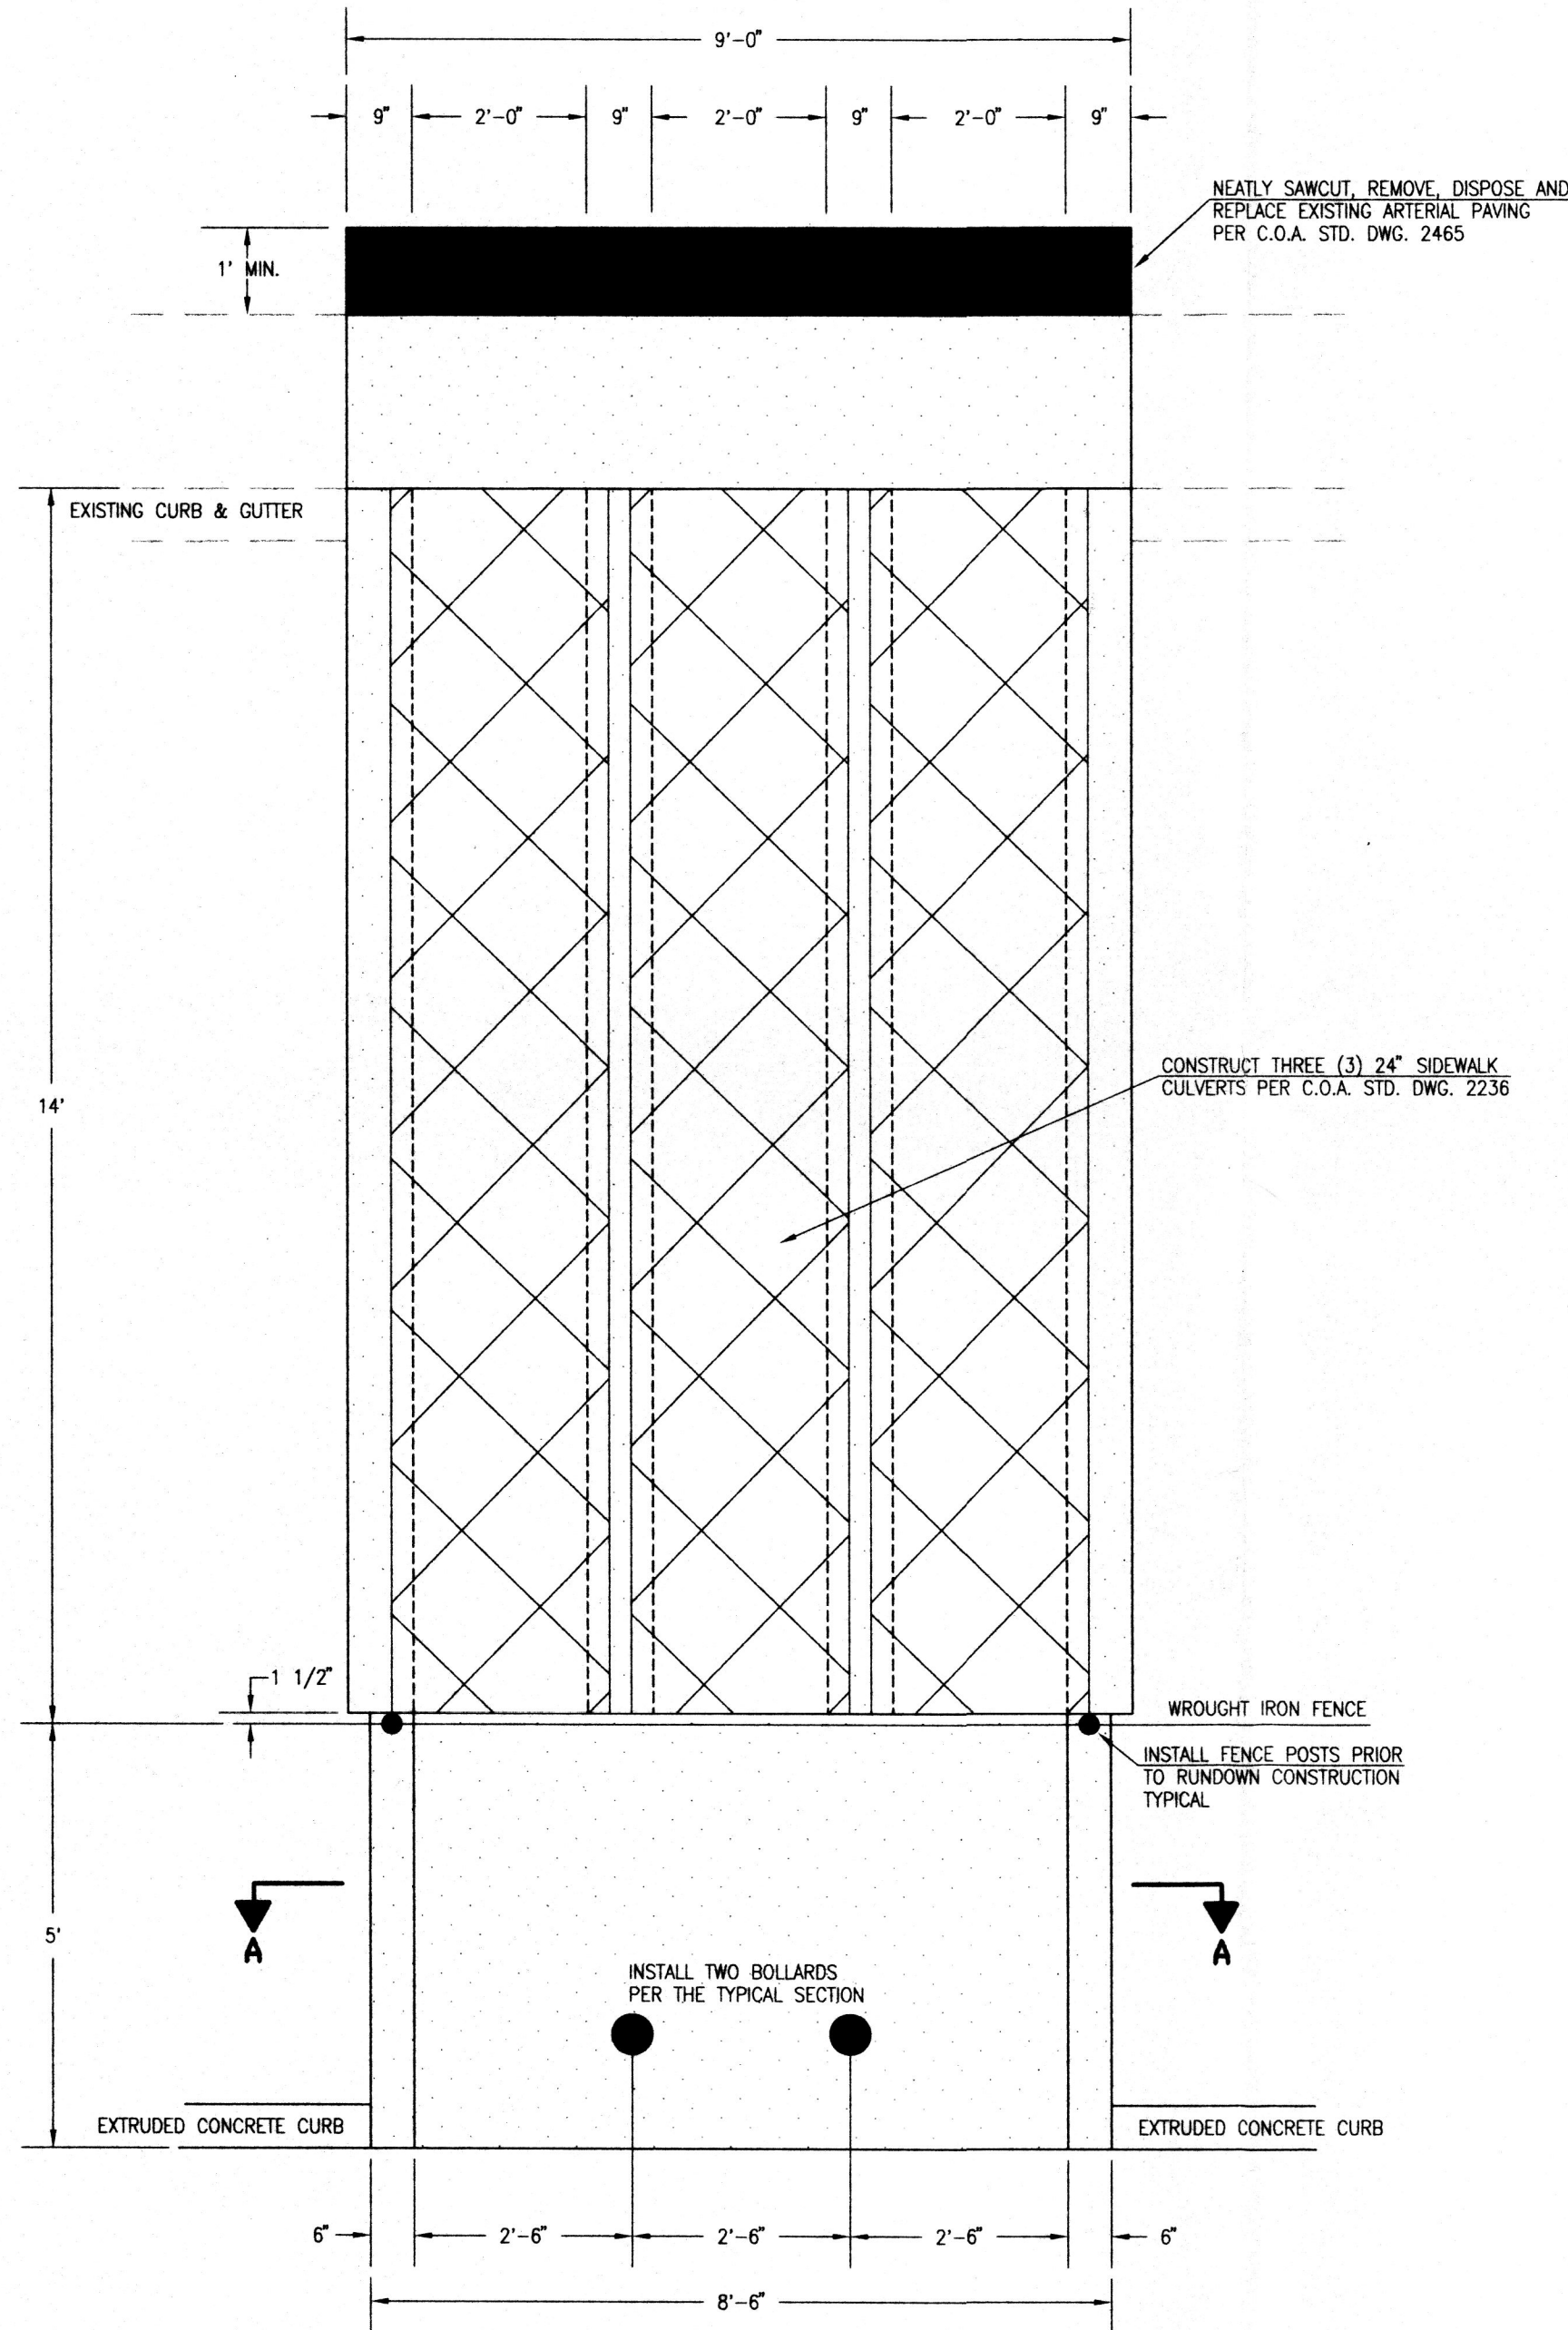


CONCRETE RUNDOWN DETAIL
SCALE: 1" = 2'-0"

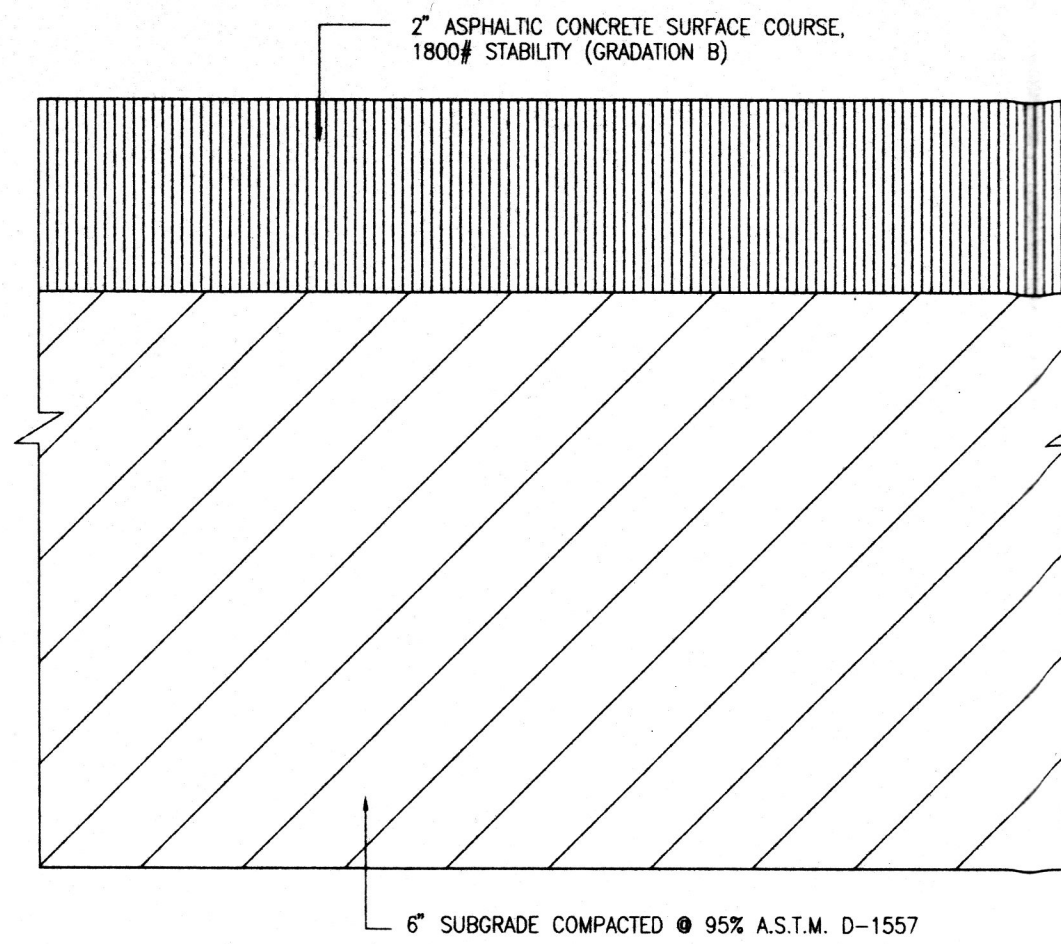


TYPICAL PAVEMENT SECTION
SCALE: 1" = 0'-2"

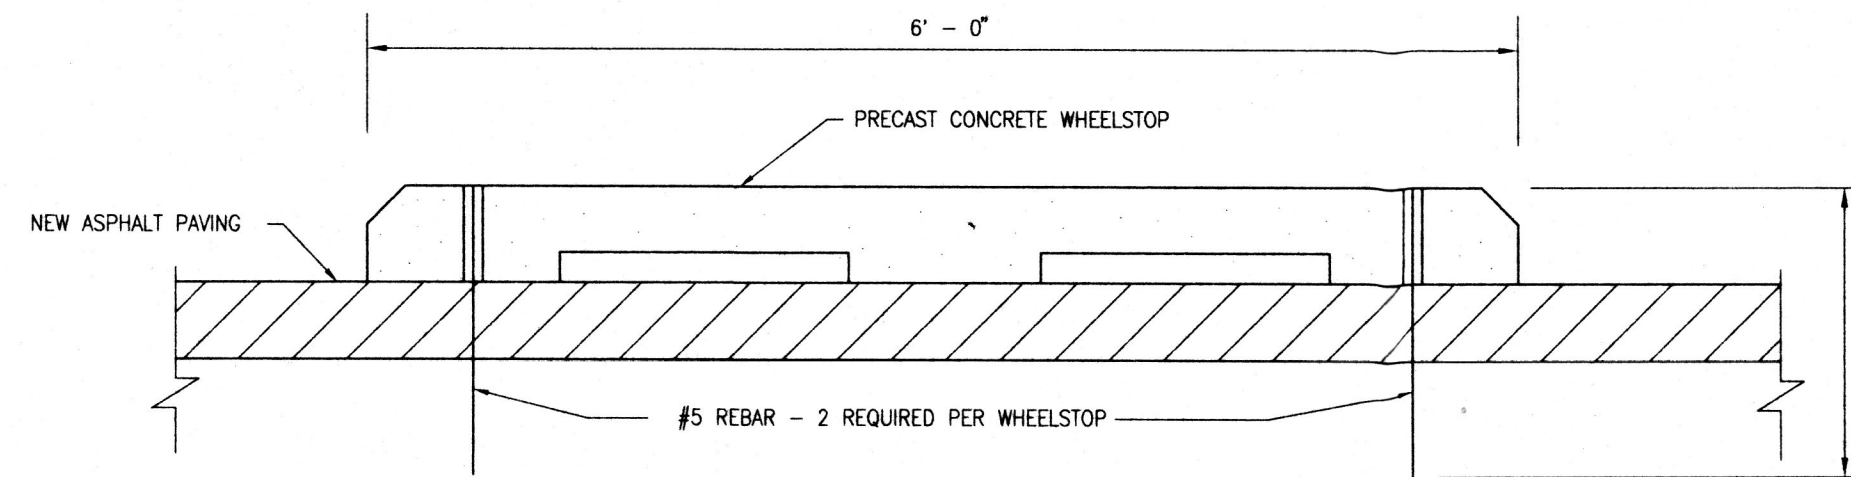

WHEEL STOP SECTION (OPTIONAL)
SCALE: 1" = 10'-0"

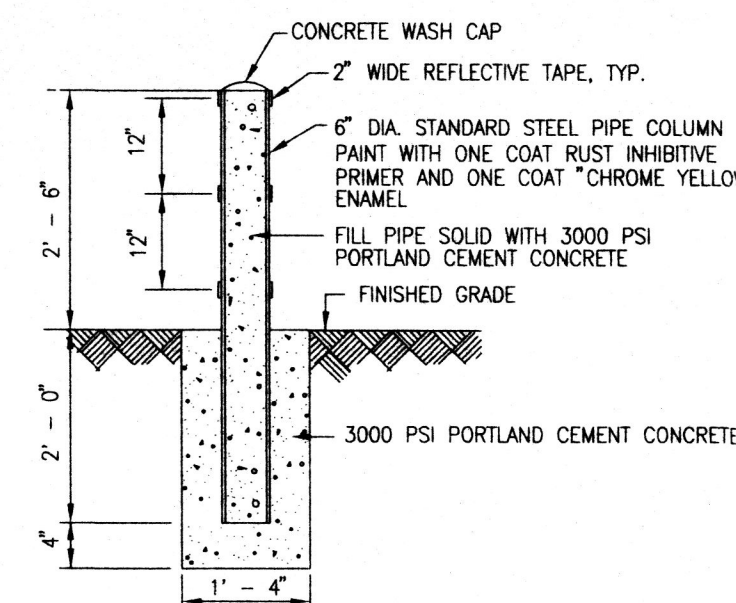

TYPICAL BOLLARD SECTION
SCALE: 1" = 2'-0"

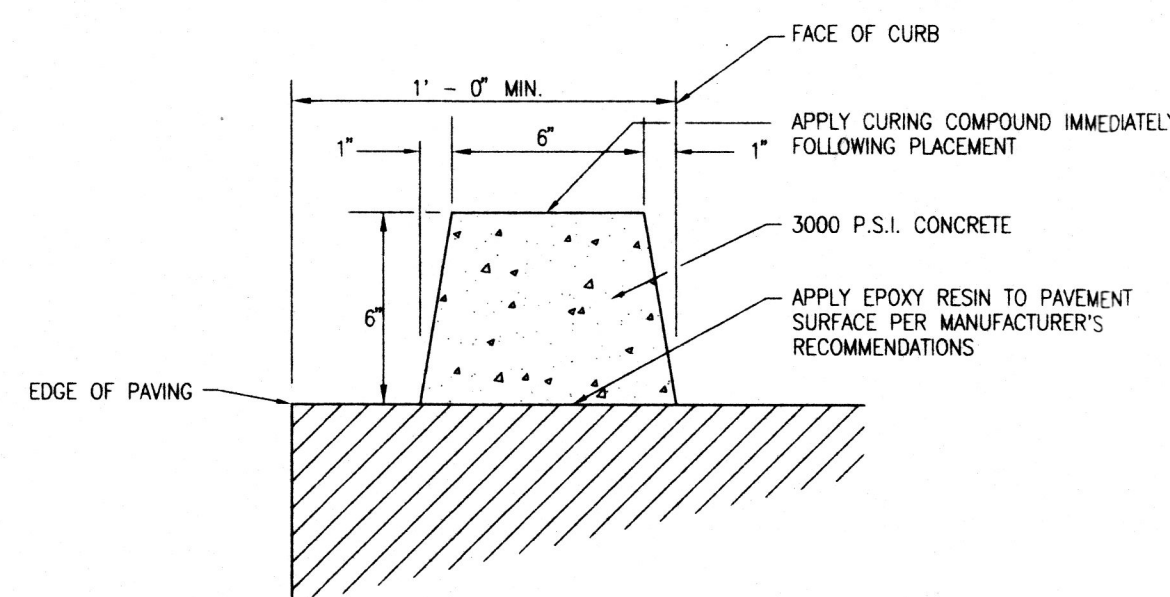

TYPICAL EXTRUDED CONCRETE CURB SECTION
SCALE: 1" = 0'-6"

Drainage Plan
The following items concerning the Lovelace Hospital Staff Shuttle Lot Drainage Plan are contained hereon:


1. Vicinity Map
2. Grading Plan
3. Sections and Details
4. Calculations

As shown by the Vicinity Map, the site is located at the southwest corner of the intersection of Gibson Boulevard S.E. and Dakota Street S.E. At present, the site is undeveloped. The surrounding area is developed commercially to the north and residentially to the south. The site will be developed to serve as a shuttle parking lot for Lovelace Hospital employees.

As shown by Panel 362 of 825 of the National Flood Insurance Program Flood Insurance Rate Maps published by F.E.M.A. for the County of Bernalillo, New Mexico, and Incorporated Areas, dated September 20, 1996, the site does not lie within a designated flood hazard zone, flooding is identified within Gibson Boulevard S.E. at a depth of one foot (Zone AO). This flooding has been alleviated, however, by the construction of the System 206-02A Improvements as delineated on Map L18 of the Albuquerque Master Drainage Study Volume II. More particularly, these improvements are the Highland Phase II Storm Drain Improvements and the Gibson Boulevard Storm Drain. Those improvements are currently in place. The System 206-02A Improvements "will eliminate flooding on Gibson Boulevard below the detention basin and on Eastern Avenue, Ross Avenue, Anderson Avenue, Kathryn Avenue, Southern Avenue, Trumbull Avenue, and Bell Avenue down to San Mateo Boulevard." The detention basin referenced in this quotation is located east of Louisiana Boulevard S.E. Based upon the improvements referenced above, free discharge of runoff from this site is appropriate.

The Grading Plan shows: 1) existing and proposed grades indicated by spot elevations and contours at 10' intervals, 2) the limit and character of the existing improvements, 3) the limit and character of the proposed improvements, and 4) continuity between existing and proposed grades. As shown by this Plan, the proposed improvements consist of the construction of a 77-space parking lot. The parking lot will be constructed with asphalt paving and concrete curbs. At present, the site drains from east to west onto the adjacent private property which lies to the west. The developed drainage pattern will direct the developed runoff toward to the northwest corner of the site where the runoff will exit via sidewalk culverts. From this point, the runoff will flow westerly along the south curb line of Gibson Blvd. S.E. for eventual introduction into storm inlets which discharge into a storm drain collector constructed as part of the AMDS 206-02A System Improvements. A portion of the site will remain "undeveloped" along the south edge of the parking lot. This area will be landscaped. The rainfall that falls upon this area will be allowed to follow its historic drainage pattern. All other runoff generated by the site will be directed to Gibson Boulevard S.E. as described above.

The Calculations which appear hereon analyze both the existing and developed conditions for the 100-year, 6-hour rainfall event. The Procedure for 40-acre and Smaller Basins, as set forth in the Revision of Section 22.2, Hydrology of the Development Process Manual, Volume 2, Design Criteria, dated January, 1993, has been used to quantify the peak rate of discharge and volume of runoff generated. As shown by these calculations, an increase in runoff is anticipated due to the proposed improvements. The entire site has been considered as a single basin with all runoff discharging to Gibson Boulevard S.E. "Credit" has not been taken for that runoff which falls upon the landscape area south of the paved parking lot and which will not physically drain to Gibson Boulevard S.E. The Weir Equation was utilized to calculate the entrance condition for the sidewalk culverts.

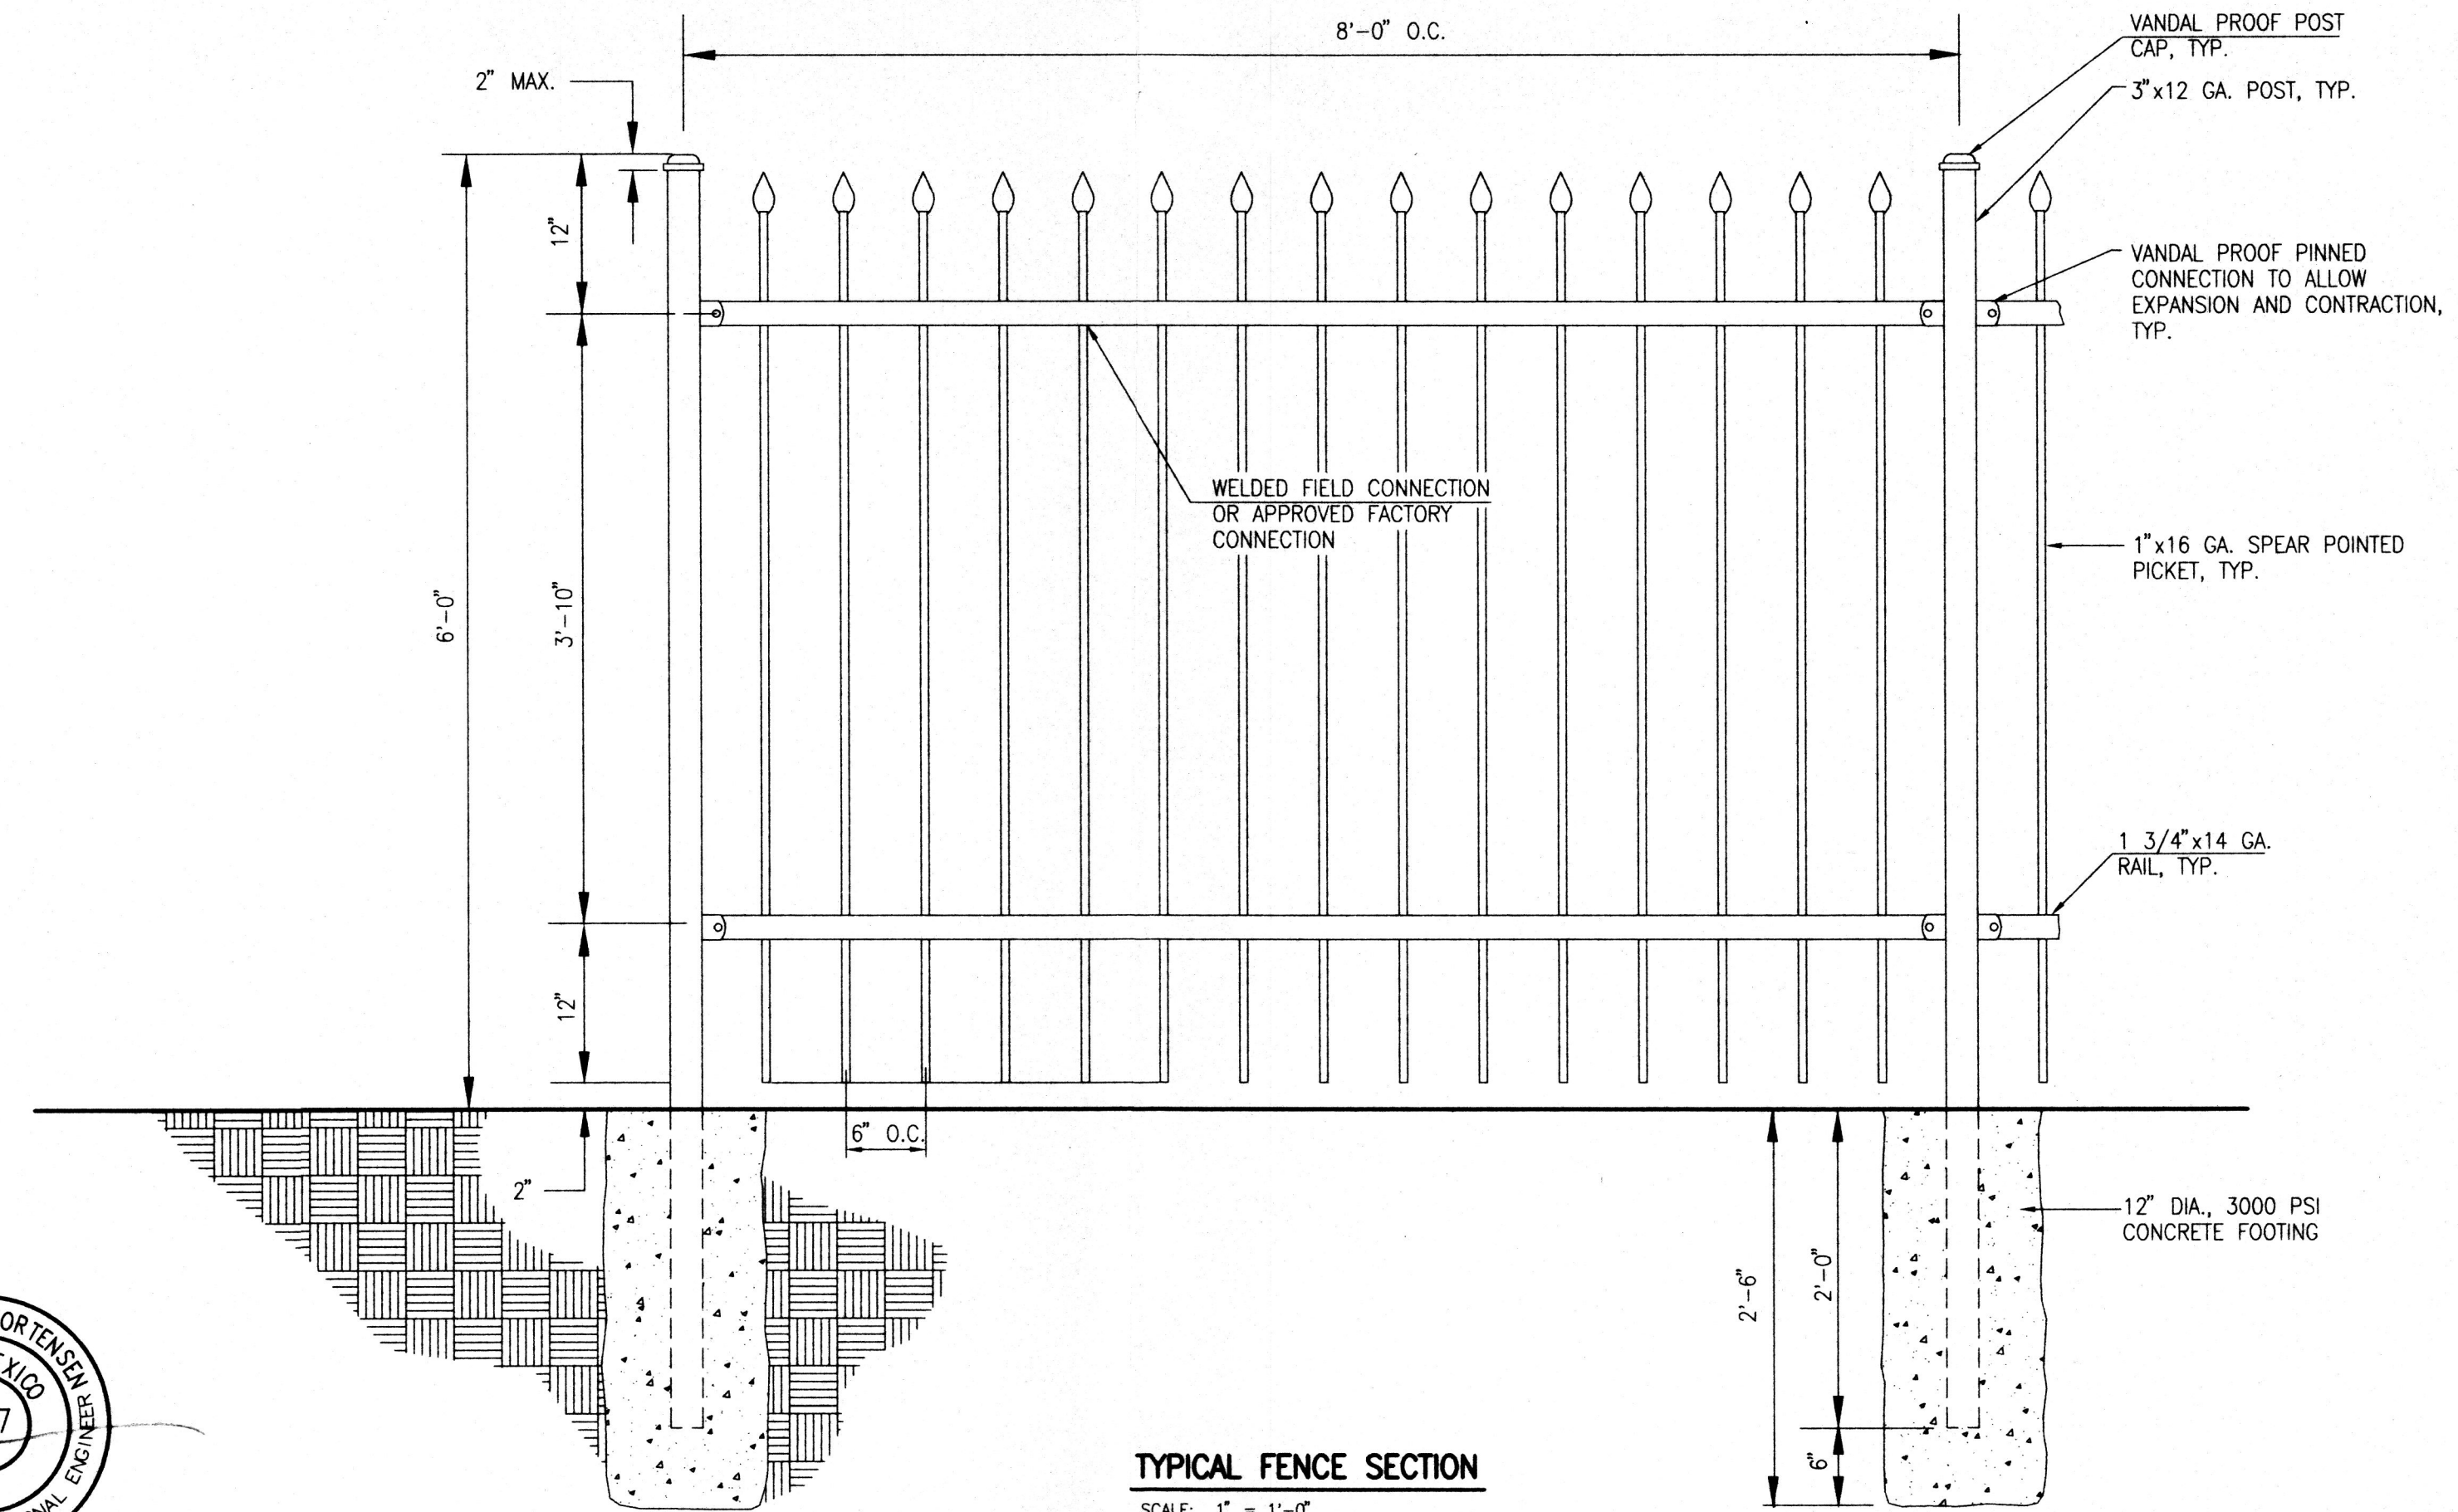

TYPICAL FENCE SECTION
SCALE: 1" = 1'-0"

CALCULATIONS

Site Characteristics
 1. Precipitation Zone = 3
 2. $P_{6,100} = P_{360} = 2.60$ in.
 3. Total Area (A_T) = 89,880 sf/2.06 ac.
 4. Existing Land Treatment
 Treatment Area (sf/ac) %
 C 89,880/2.06 100
 5. Developed Land Treatment
 Treatment Area (sf/ac) %
 B 18,830/0.43 20.9
 C 7,800/0.18 8.7
 D 63,250/1.45 70.4

Existing Condition

1. Volume

$$E_W = (E_A A_A + E_B A_B + E_C A_C + E_D A_D) / A_T$$

$$E_W = (1.29)(2.06) / 2.06 = 1.29 \text{ in.}$$

$$V_{100} = (E_W / 12) A_T$$

$$V_{100} = (1.29 / 12) 2.06 = 0.2215 \text{ ac.ft.; } 9,650 \text{ cf}$$

 2. Peak Discharge

$$Q_p = Q_{PA} A_A + Q_{PB} A_B + Q_{PC} A_C + Q_{PD} A_D$$

$$Q_p = Q_{100} = (3.45)(2.06) = 7.1 \text{ cfs}$$

Developed Condition

1. Volume

$$E_W = (E_A A_A + E_B A_B + E_C A_C + E_D A_D) / A_T$$

$$E_W = [(0.92)(0.43) + (1.29)(0.18) + (2.36)(1.45)] / 2.06 = 1.97 \text{ in.}$$

$$V_{100} = (E_W / 12) A_T$$

$$V_{100} = (1.97 / 12) 2.06 = 0.3382 \text{ ac.ft.; } 14,730 \text{ cf}$$

 2. Peak Discharge

$$Q_p = Q_{PA} A_A + Q_{PB} A_B + Q_{PC} A_C + Q_{PD} A_D$$

$$Q_p = Q_{100} = (2.60)(0.43) + (3.45)(0.18) + (5.02)(1.45) = 9.0 \text{ cfs}$$

Comparison

1. $\Delta V_{100} = 14,730 - 9,650 = 5,080 \text{ cf (increase)}$
 2. $\Delta Q_{100} = 9.0 - 7.1 = 1.9 \text{ cfs (increase)}$

Sidewalk Culvert Entrance Condition

Weir Equation

$$Q = CLH^{3/2}$$


Let: C = 2.70
 L = 2.0 ft (24" Sidewalk Culvert)
 H = 0.67 ft (8" Curb & Gutter)

Therefore: $Q = 3.0 \text{ cfs per } 24" \text{ Sidewalk Culvert}$

Number of Sidewalk Culverts Required = Q_{100} / Q

$$= 9.0 \text{ cfs} / 3.0 \text{ cfs}$$

$$= 3 - 24" \text{ Sidewalk Culverts}$$

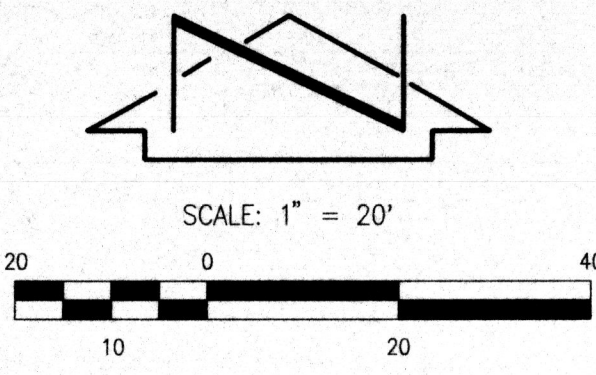

LEGEND

T.B.M.
ELEV.
FD.
P.
W/
P.O.B.
S.F.N.F.
L.D.
R.O.W.
CONC.
C.I.
CP
RCP
TC
FL
BC
BW
NG
TC
TA
BSW
SD
SAS
SD
W
MH
CAG
STD.
TEL.
O/H
ELEC.
U/G
DIA.
WV
PP
LP
TRAF.
GP
DBL

TEMPORARY BENCHMARK
ELEVATION
FOUND
IRON PIPE
WITH
POINT OF BEGINNING
SEARCH FOR NOT FOUND
IDENTIFICATION
RIGHT-OF-WAY
CONCRETE
CAST IRON
CONCRETE PIPE
REINFORCED CONCRETE PIPE
TOP OF CURB
FLOWLINE
BACK OF CURB
BOTTOM OF WALL AT GROUND
NATURAL GROUND
TOP OF GRADE
EDGE OF CONCRETE
TOP OF ASPHALT
BACK OF SIDEWALK
SIDEWALK
TOP OF CONCRETE
SANITARY SEWER
STORM DRAIN
WATERLINE
MANHOLE
STANDARD CURB & GUTTER
TYPICAL
TELEPHONE
OVERHEAD
ELECTRIC (NO. OF LINES)
UNDERGROUND
DRAINAGE
WATER VALVE
POWER POLE
LIGHT POLE
TRAFFIC
GATE POST
DOUBLE

PROPERTY CORNER
CURB SCRATCH
SPOT ELEVATION
TELEPHONE RISER
WATER VALVE
SANITARY SEWER MANHOLE
STORM DRAIN MANHOLE
TRAFFIC SIGN
GUY ANCHOR
POWER POLE
LIGHT POLE
GATE POST
STORM INLET
SMALL TREE
CONIFEROUS TREE
LARGE SHRUBS
NEW LIGHT POLE

PROPERTY LINE
ADJOINER LINE
EASEMENT LINE
COUNTOUT LINE
UTILITY LINE
FLOWLINE
NEW 6" FENCE

BOUNDARY TABLES

LINE	DIRECTION	DISTANCE
L1	S 00°48'00" W	10.00'
L2	S 17°26'00" W	31.28'
L3	N 89°12'00" W	55.59'

CURVE	RADIUS	LENGTH	CHORD	BEARING	DELTA	TANGENT
C1	25.00'	39.27'	35.36'	S 44°12'00" E	90°00'00"	25.00'

GIBSON BOULEVARD S.E.
(100' R.O.W.)

DAKOTA STREET S.E.
(55' R.O.W.)

PROJECT BENCHMARK

A "C" CHISELED ON TOP OF CONCRETE CURB AT ENE CURB RETURN, AT THE INTERSECTION OF GIBSON BLVD. S.E. AND FLORIDA ST. S.E., IN THE NORTHEAST QUADRANT OF THE INTERSECTION. ELEVATION = 5319.72 FEET (M.S.L.D.)

T.B.M.

A "C" CHISELED IN THE TOP OF CURB AT THE SW CURB RETURN OF THE INTERSECTION OF DAKOTA ST. S.E. AND GIBSON BLVD. S.E. AS SHOWN ON THE DRAWING. ELEVATION = 5314.89 FEET (M.S.L.D.)

THIS IS NOT A TOPOGRAPHIC OR A BOUNDARY SURVEY. APPARENT PROPERTY CORNERS ARE SHOWN FOR ORIENTATION ONLY. BOUNDARY DATA AND TOPOGRAPHIC DATA SHOWN HEREON ARE FROM A BOUNDARY AND TOPOGRAPHIC SURVEY OF TRACT G-2-A, SIESTA HILLS SUBDIVISION No. 2, ALBUQUERQUE, NEW MEXICO PREPARED BY JEFF MORTENSEN & ASSOCIATES, INC. DATED JULY 31, 1997.

Construction Notes:

- Two (2) working days prior to any excavation, contractor must contact New Mexico One Call System 260-1990 (Albuquerque Area), 1-800-321-ALERT(2537) (Statewide), for location of existing utilities.
- Prior to construction, the contractor shall excavate and verify the horizontal and vertical location of all potential obstructions. Should a conflict exist, the contractor shall notify the engineer in writing so that the conflict can be resolved with a minimum amount of delay. The Contractor shall be responsible for all interpretations it makes without first contacting the Engineer as required above.
- All work on this project shall be performed in accordance with applicable federal, state and local laws, rules and regulations concerning construction safety and health.
- All construction within public right-of-way shall be performed in accordance with applicable City of Albuquerque Standards and Procedures.
- If any utility lines, pipelines, or underground utility lines are shown on these drawings, they are shown in an approximate manner only, and such lines may exist where none are shown. If any such existing lines are shown, the location is based upon information provided by the owner of said utility, and the information may be incomplete, or may be obsolete by the time construction commences. The engineer has conducted only preliminary investigation of the location, depth, size, or type of existing utility lines, pipelines, or underground utility lines. This investigation is not conclusive, and may not be complete, therefore, makes no representation pertaining thereto, and assumes no responsibility or liability therefor. The contractor shall inform itself of the location of any utility line, pipeline, or underground utility line in or near the area of the work in advance of and during excavation work. The contractor is fully responsible for any and all damage caused by its failure to locate, identify and preserve any and all existing utilities, pipelines, and underground utility lines. In planning and conducting excavation, the contractor shall comply with state statutes, municipal and local ordinances, rules and regulations, if any, pertaining to the location of these lines and facilities.
- An Excavation/Construction Permit will be required before beginning any work within City right-of-way. An approved copy of these plans must be submitted at the time of application for this permit.
- Backfill compaction shall be according to arterial street use.
- Maintenance of these facilities shall be the responsibility of the owner of the property served.
- The design of planters and landscaped areas is not part of this plan. All planters and landscaped areas adjacent to the building(s) shall be provided with positive drainage to avoid any ponding adjacent to the structure. For construction details, refer to landscaping plan.

Erosion Control Measures:

- The contractor shall ensure that no soil erodes from the site into public right-of-way or onto private property.
- The contractor shall promptly clean up any material excavated within the public right-of-way so that the excavated material is not susceptible to being washed down the street.
- The contractor shall secure "Topsoil Disturbance Permit" prior to beginning construction.
- Any areas of excess disturbance (traffic access storage yard, excavated material, etc.) shall be re-seeded according to C.O.A. specification 1012 "Native Grass Seeding". This will be considered incidental to construction, therefore, no separate payment will be made.

EASEMENT KEYED NOTES


- UTILITY EASEMENTS RESERVED BY V-75-10 IN FORMER ALLEYS
- 5' PUBLIC UTILITY EASEMENT GRANTED BY PLAT D1-127
- 7'10" POWER AND TELEPHONE EASEMENT GRANTED BY PLAT D6-192
- 7' PUBLIC UTILITY EASEMENT IDENTIFIED BY PLAT C22-116
- 10' DRAINAGE EASEMENT IDENTIFIED BY PLAT C26-135




JEFF MORTENSEN & ASSOCIATES, INC.
600-B MIDWAY PARK BLVD. N.E.
ALBUQUERQUE, N.M. 87109
ENGINEERS SURVEYORS (505) 345-4250

GRADING AND DRAINAGE PLAN
LOVELACE HOSPITAL STAFF SHUTTLE LOT

APPROVALS	NAME	DATE	NO.	DATE	BY	REVISIONS	JOB NO.
A.C.E./DESIGN	Benny Montoya	9/24/97	1	9/27	G.R.B.	ADD CURBS AT WEST SIDE OF LOT.	970611
INSPECTOR					T.N.T.		DATE 08-1997
A.C.E./FIELD					J.G.M.		SHEET 3 OF 4

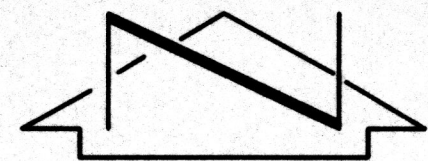


SCALE: 1" = 20'

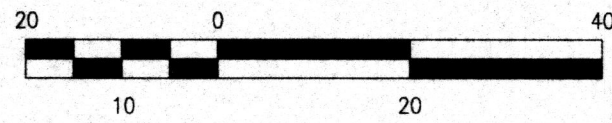

BOUNDARY TABLES

LINE	DIRECTION	DISTANCE
L1	S 00°48'00" W	10.00'
L2	S 17°26'00" W	31.28'
L3	N 89°12'00" W	55.59'

CURVE	RADIUS	LENGTH	CHORD	BEARING	DELTA	TANGENT
C1	25.00'	39.27'	35.36'	S 44°12'00" E	90°00'00"	25.00'

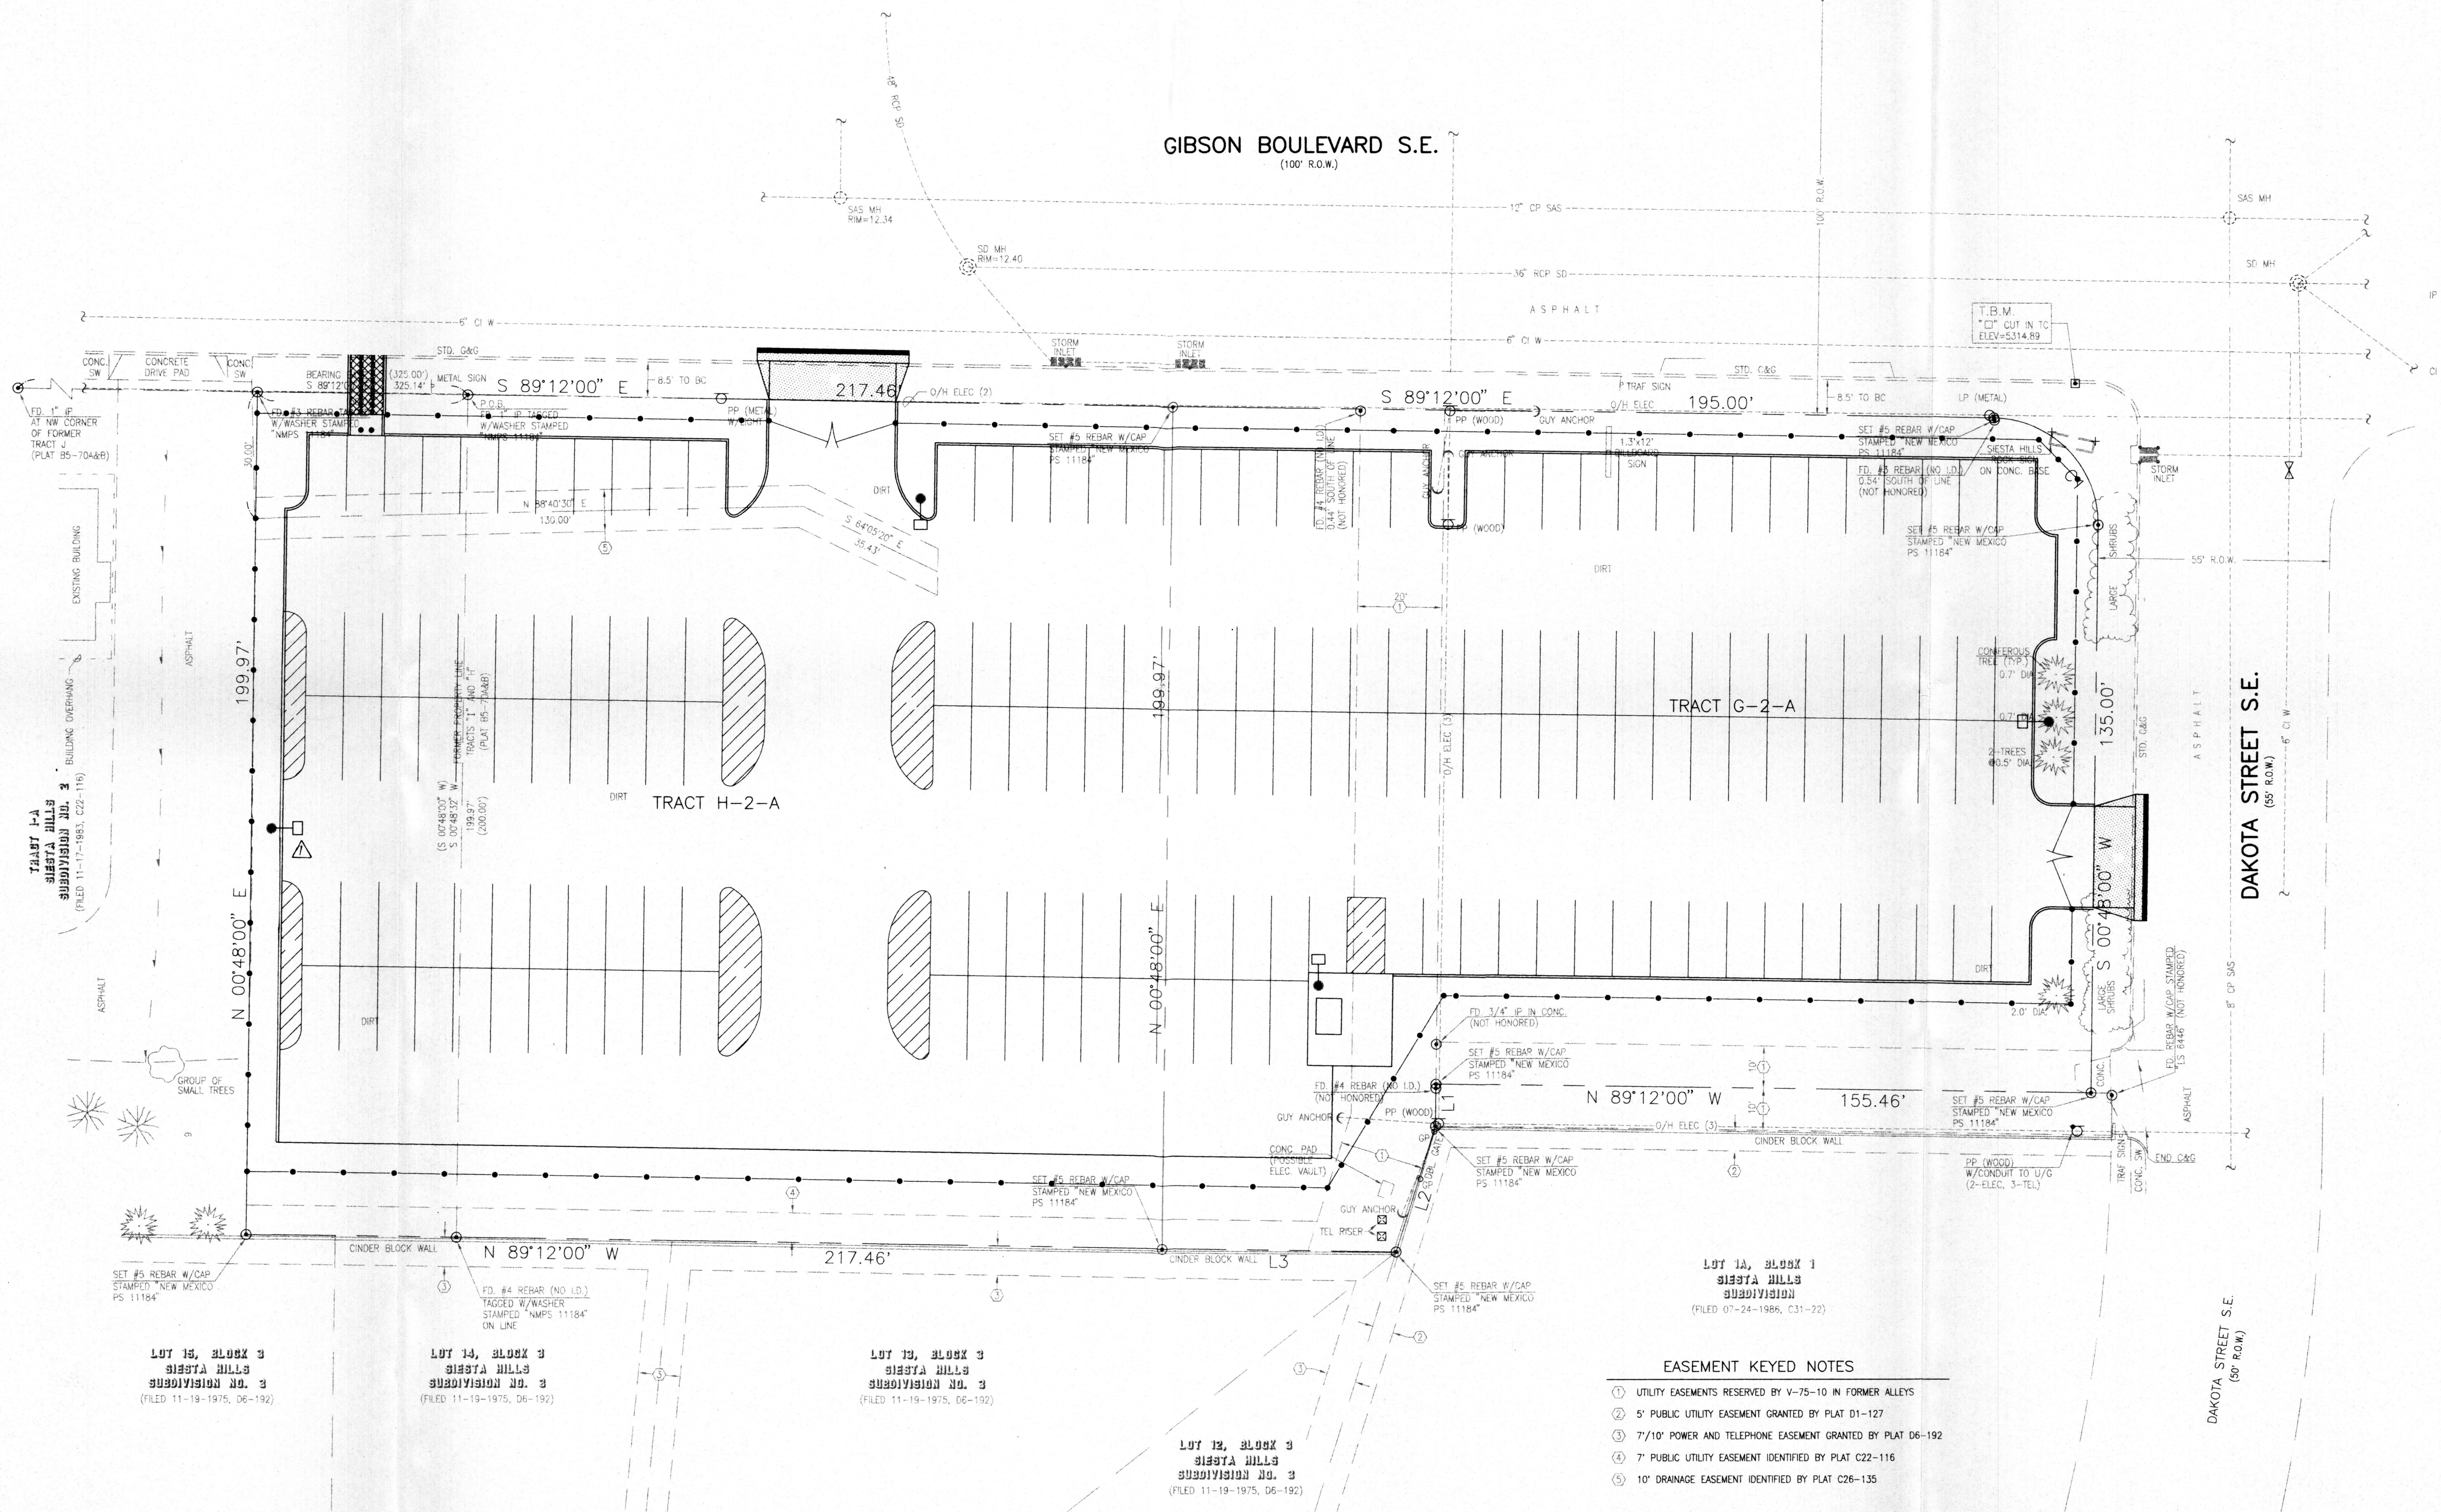

EASEMENT KEYED NOTES

- UTILITY EASEMENTS RESERVED BY V-75-10 IN FORMER ALLEYS
- 5' PUBLIC UTILITY EASEMENT GRANTED BY PLAT D1-127
- 7'/10" POWER AND TELEPHONE EASEMENT GRANTED BY PLAT D6-192
- 7' PUBLIC UTILITY EASEMENT IDENTIFIED BY PLAT C22-116
- 10' DRAINAGE EASEMENT IDENTIFIED BY PLAT C26-135




JEFF MORTENSEN & ASSOCIATES, INC.
4000-B MIDWAY PARK BLVD. N.E.
ALBUQUERQUE, N.M. 87109
ENGINEERS SURVEYORS (505) 345-4250

LANDSCAPING PLAN
LOVELACE HOSPITAL STAFF SHUTTLE LOT

DESIGNED BY
DRAWN BY
APPROVED BY

NO.	DATE	BY	REVISIONS
1	08/01/97	GMB	ADD CURB AT WEST SIDE OF LOT.

JOB NO. 970611
DATE 08-1997
SHEET 4 OF 4

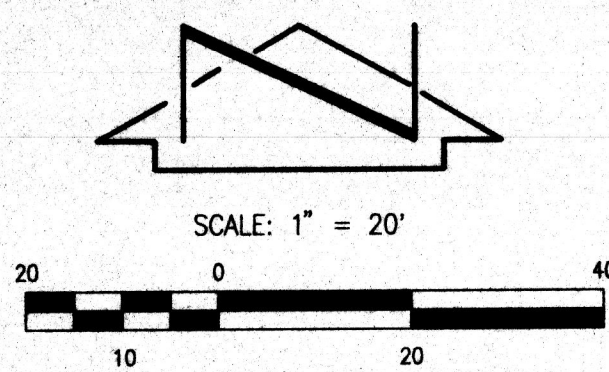

LEGEND

T.B.M.
ELEV.
F.D.
W/
P.O.B.
S.F.N.F.
I.D.
R.O.W.
CONC.
C.P.
RCP
TC
FL
BC
BW
NM
TC
EC
TA
BSW
SW
TCD
SAS
SD
W
MH
STD. C&G
(TYP.)
TEL.
O/H
ELEC. (S)
U/V
DIA.
WV
PP
LP
TRAF.
CP
DBL

TEMPORARY BENCHMARK
ELEVATION
FOUND
IRON PIPE
WITH
POINT OF BEGINNING
SEARCH FOR NOT FOUND
IDENTIFICATION
RIGHT-OF-WAY
CONCRETE
CAST IRON
CONCRETE PIPE
REINFORCED CONCRETE PIPE
TOP OF CURB
FLOWLINE
BACK OF CURB
BOTTOM OF WALL AT GROUND
NATURAL GROUND
TOP OF GRATE
EDGE OF CONCRETE
TOP OF ASPHALT
BACK OF SIDEWALK
SIDEWALK
TOP OF CONCRETE
SANITARY SEWER
STORM DRAIN
WATERLINE
MANHOLE
STANDARD CURB & GUTTER
TYPICAL
TELEPHONE
OVERHEAD
ELECTRIC (NO. OF LINES)
UNDERGROUND
DAMETER
WATER VALVE
POWER POLE
LIGHT POLE
TRAFFIC
GATE POST
DOUBLE

PROPERTY CORNER
CURB SCRATCH
SPOT ELEVATION
TELEPHONE RISER
WATER VALVE
SANITARY SEWER MANHOLE
STORM DRAIN MANHOLE
TRAFFIC SIGN
GLY ANCHOR
POWER POLE
LIGHT POLE
GATE POST
STORM INLET
SMALL TREE
CONIFEROUS TREE
LARGE SHRUBS
NEW LIGHT POLE

PROPERTY LINE
ADJONER LINE
EASEMENT LINE
COUNTOUR LINE
UTILITY LINE
FLOWLINE
NEW 6' FENCE

BOUNDARY TABLES

LINE	DIRECTION	DISTANCE
L1	S 00°48'00" W	10.00'
L2	S 17°26'00" W	31.28'
L3	N 89°12'00" W	55.59'

CURVE	RADIUS	LENGTH	CHORD	BEARING	DELTA	TANGENT
C1	25.00'	39.27'	35.36'	S 44°12'00" E	90°00'00"	25.00'

AS-BUILT LEGEND

TC13.40 TA12.60	AS-BUILT ELEVATION	AS-BUILT CONCRETE IMPROVEMENTS
TA11.30	AS-BUILT = AS-DESIGNED	NOT-BUILT

GIBSON BOULEVARD S.E.
(100' R.O.W.)

DRAINAGE CERTIFICATION

As indicated by the as-built information shown hereon, this project has been graded and drained in substantial compliance with the approved Plan with the noted exceptions which do not void the approved concept:

- A 36" wide private entrance has been constructed by City Work Order (City Project No. 582681) in lieu of a 30' driveway along Gibson Boulevard S.E., and
- A 6' sidewalk has been constructed along the property line of Gibson Boulevard S.E. by City Work Order (City Project No. 582681).

It is based upon this evaluation of as-constructed conditions that final acceptance be approved by City of Albuquerque Public Works Department - Hydrology Section. The as-built information shown hereon has been obtained by me or under my direct supervision, and is true and correct to the best of my knowledge and belief.

Jeffrey G. Mortensen, N.M.
Professional Engineer
04-23-98
Date

PROJECT BENCHMARK

A "C" CHISEL ON TOP OF CONCRETE CURB AT ENE CURB RETURN, AT THE INTERSECTION OF GIBSON BLVD. S.E. AND FLORIDA ST. S.E., IN THE NORTHEAST QUADRANT OF THE INTERSECTION.
ELEVATION = 5319.72 FEET (M.S.L.D.)

T.B.M.

A "C" CHISEL IN THE TOP OF CURB AT THE SW CURB RETURN OF THE INTERSECTION OF DAKOTA ST. S.E. AND GIBSON BLVD. S.E. AS SHOWN ON THE DRAWING.
ELEVATION = 5314.89 FEET (M.S.L.D.)


THIS IS NOT A TOPOGRAPHIC OR A BOUNDARY SURVEY. APPARENT PROPERTY CORNERS ARE SHOWN FOR ORIENTATION ONLY. BOUNDARY DATA AND TOPOGRAPHIC DATA SHOWN HEREON ARE FROM A BOUNDARY AND TOPOGRAPHIC SURVEY OF TRACT G-2-A, SIESTA HILLS SUBDIVISION No. 2, ALBUQUERQUE, NEW MEXICO PREPARED BY JEFF MORTENSEN & ASSOCIATES, INC. DATE JULY 31, 1997.


Construction Notes:

- Two (2) working days prior to any excavation, contractor must contact New Mexico One Call System 260-1990 (Albuquerque Area), 1-800-321-ALERT(2537) (Statewide), for location of existing utilities.
- Prior to construction, the contractor shall excavate and verify the horizontal and vertical location of all potential obstructions. Should a conflict exist, the contractor shall notify the engineer in writing so that the conflict can be resolved with a minimum amount of delay. The Contractor shall be responsible for all interpretations it makes without first contacting the Engineer as required above.
- All work on this project shall be performed in accordance with applicable federal, state and local laws, rules and regulations concerning construction safety and health.
- All construction within public right-of-way shall be performed in accordance with applicable City of Albuquerque Standards and Procedures.
- If any utility lines, pipelines, or underground utility lines are shown on these drawings, they are shown in an approximate manner only, and such lines may exist where none are shown. If any such existing lines are shown, the location is based upon information provided by the owner of said utility, and the information may be incomplete, or may be obsolete by the time construction commences. The engineer has conducted only preliminary investigation of the location, depth, size, or type of existing utility lines, pipelines, or underground utility lines. This investigation is not conclusive, and may not be complete, therefore, makes no representation pertaining thereto, and assumes no responsibility or liability therefor. The contractor shall inform itself of the location of any utility line, pipeline, or underground utility line in or near the area of the work in advance of and during excavation work. The contractor is fully responsible for any and all damage caused by its failure to locate, identify and preserve any and all existing utilities, pipelines, and underground utility lines. In planning and conducting excavation, the contractor shall comply with state statutes, municipal and local ordinances, rules and regulations, if any, pertaining to the location of these lines and facilities.
- An Excavation/Construction Permit will be required before beginning any work within City right-of-way. An approved copy of these plans must be submitted at the time of application for this permit.
- Backfill compaction shall be according to arterial street use.
- Maintenance of these facilities shall be the responsibility of the owner of the property served.
- The design of planters and landscaped areas is not part of this plan. All planters and landscaped areas adjacent to the building(s) shall be provided with positive drainage to avoid any ponding adjacent to the structure. For construction details, refer to landscaping plan.

Erosion Control Measures:

- The contractor shall ensure that no soil erodes from the site into public right-of-way or onto private property.
- The contractor shall promptly clean up any material excavated within the public right-of-way so that the excavated material is not susceptible to being washed down the street.
- The contractor shall secure "Topsoil Disturbance Permit" prior to beginning construction.
- Any areas of excess disturbance (traffic access storage yard, excavated material, etc.) shall be re-seeded according to C.O.A. specification 1012 "Native Grass Seeding". This will be considered incidental to construction, therefore, no separate payment will be made.

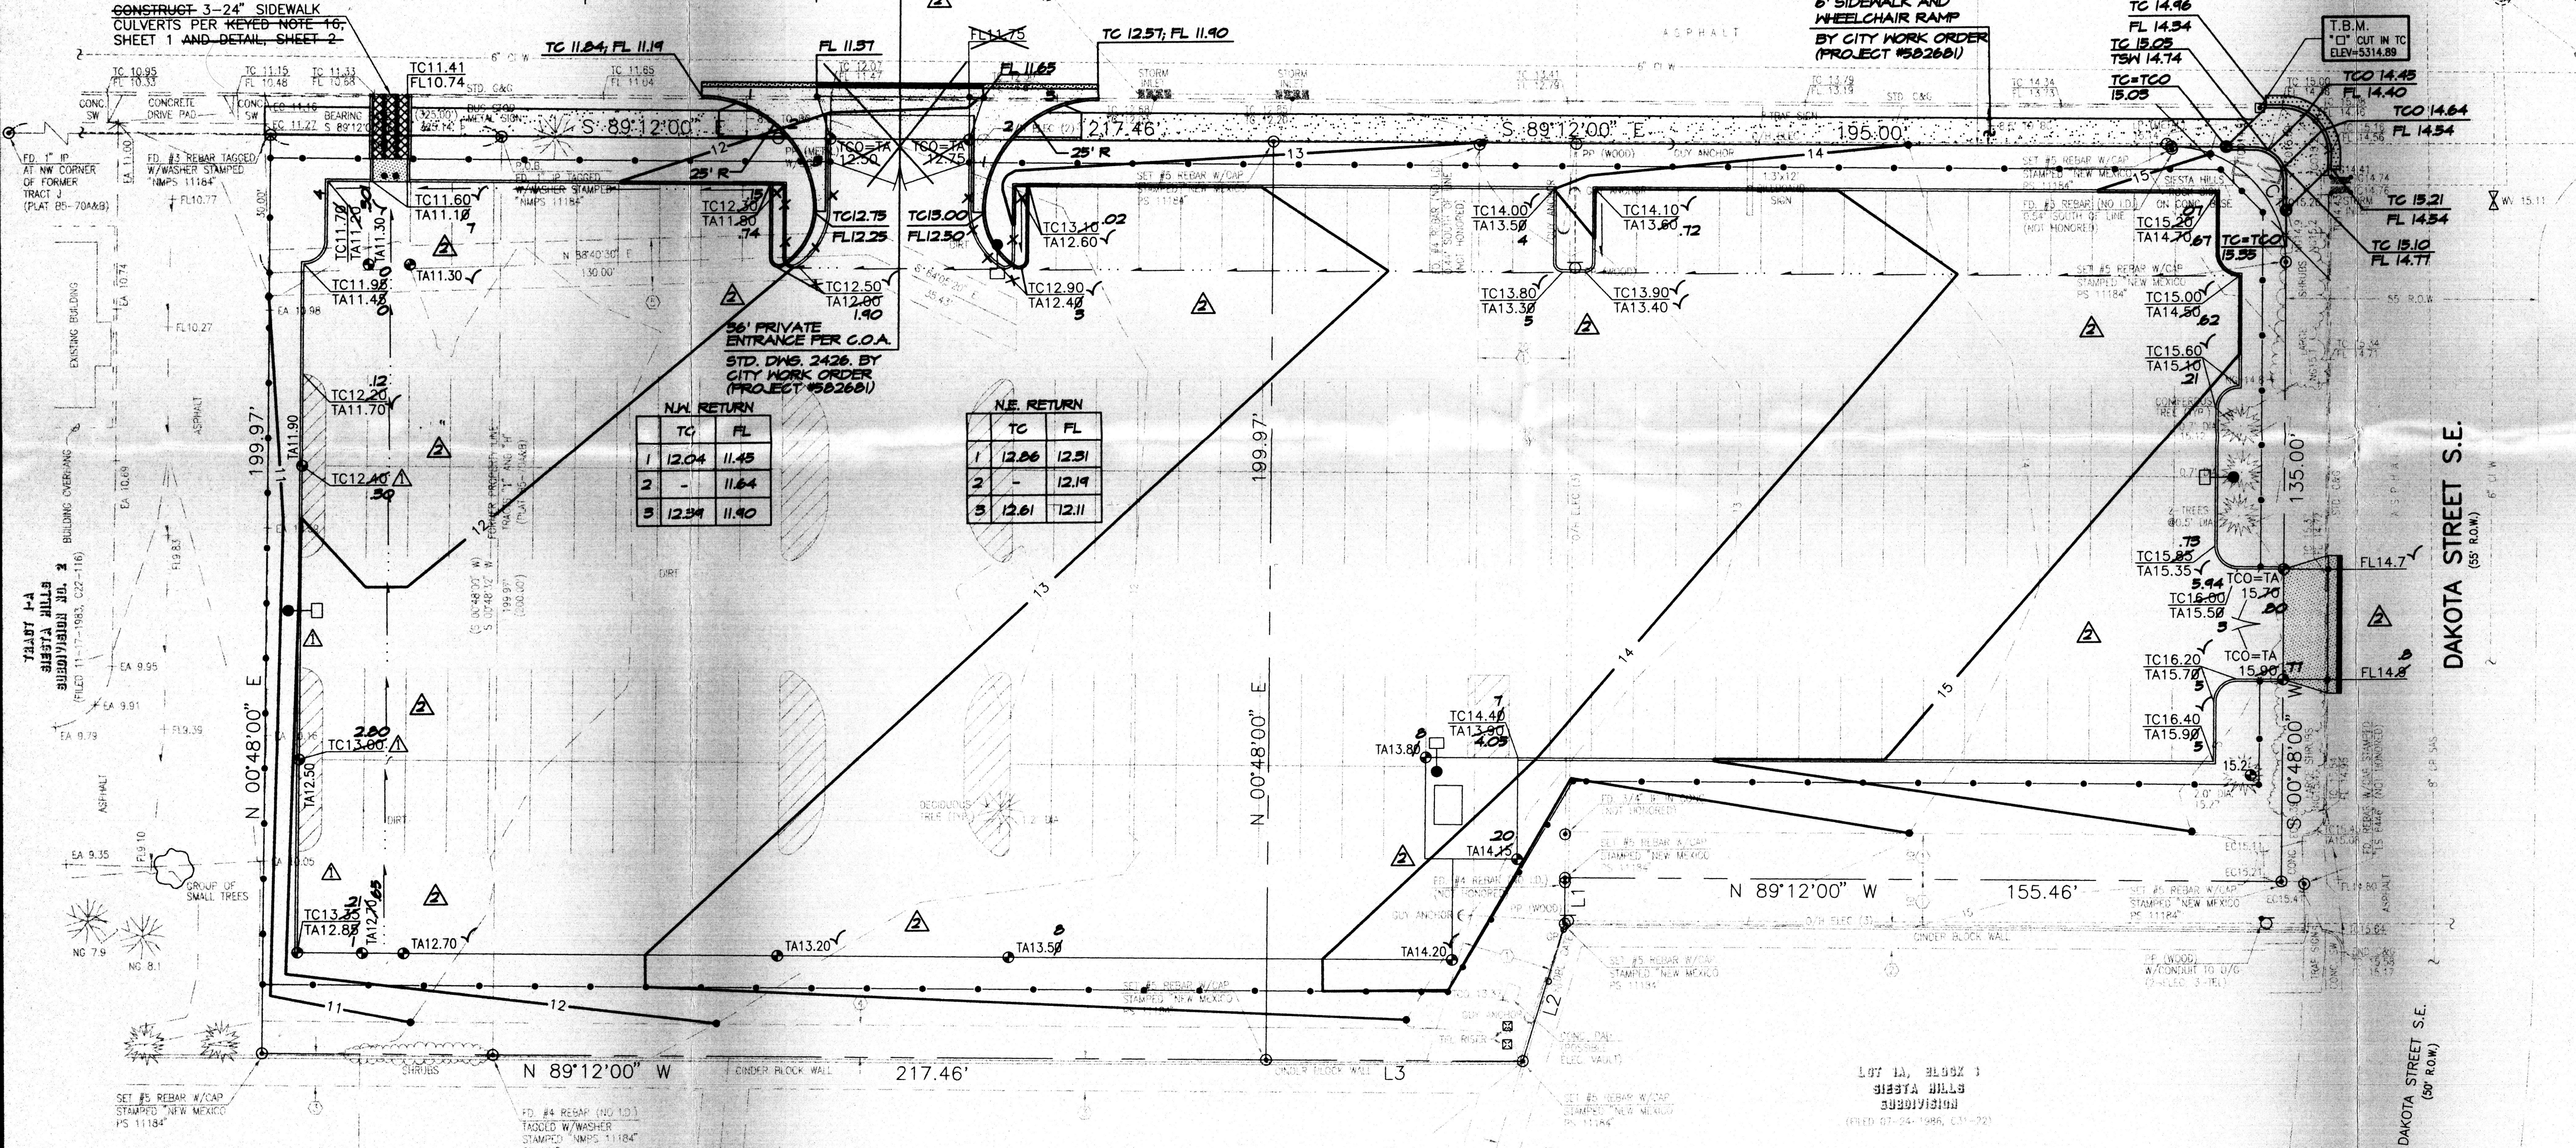

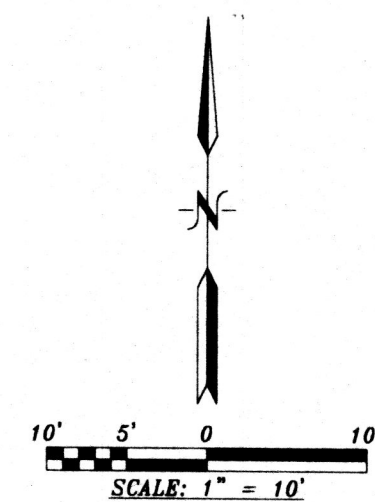


NOTES:


1. EXISTING CURBS AND ASPHALT WILL REMAIN IN PLACE. CONTRACTOR WILL CUT AND REMOVE ASPHALT AS NECESSARY TO BUILD STRUCTURE AND INSTALL UTILITY LINES.
2. CONTRACTOR WILL THEN DO A 1" TO 3" OVERLAY CAP OF ASPHALT TO FINISH PARKING AND DRAINAGE AREAS.
3. ADDITIONAL SOIL COMPACTION, 6" GRAVEL COURSE, AND 3" TO 4" ASPHALT WILL REPLACE AREAS WHERE EXISTING ASPHALT HAS BEEN CUT ADJACENT TO BUILDING AND UTILITY LINES.

LEGEND

- TOA=XXX = TOP OF NEW ASPHALT OVERLAY OR CONCRETE
→ = FLOW DIRECTION
XXX = EXISTING GRADE
= EXISTING CURB
= PARKING BUMPERS (CONCRETE)
• • • = BOLLARDS
= BREAK LINE

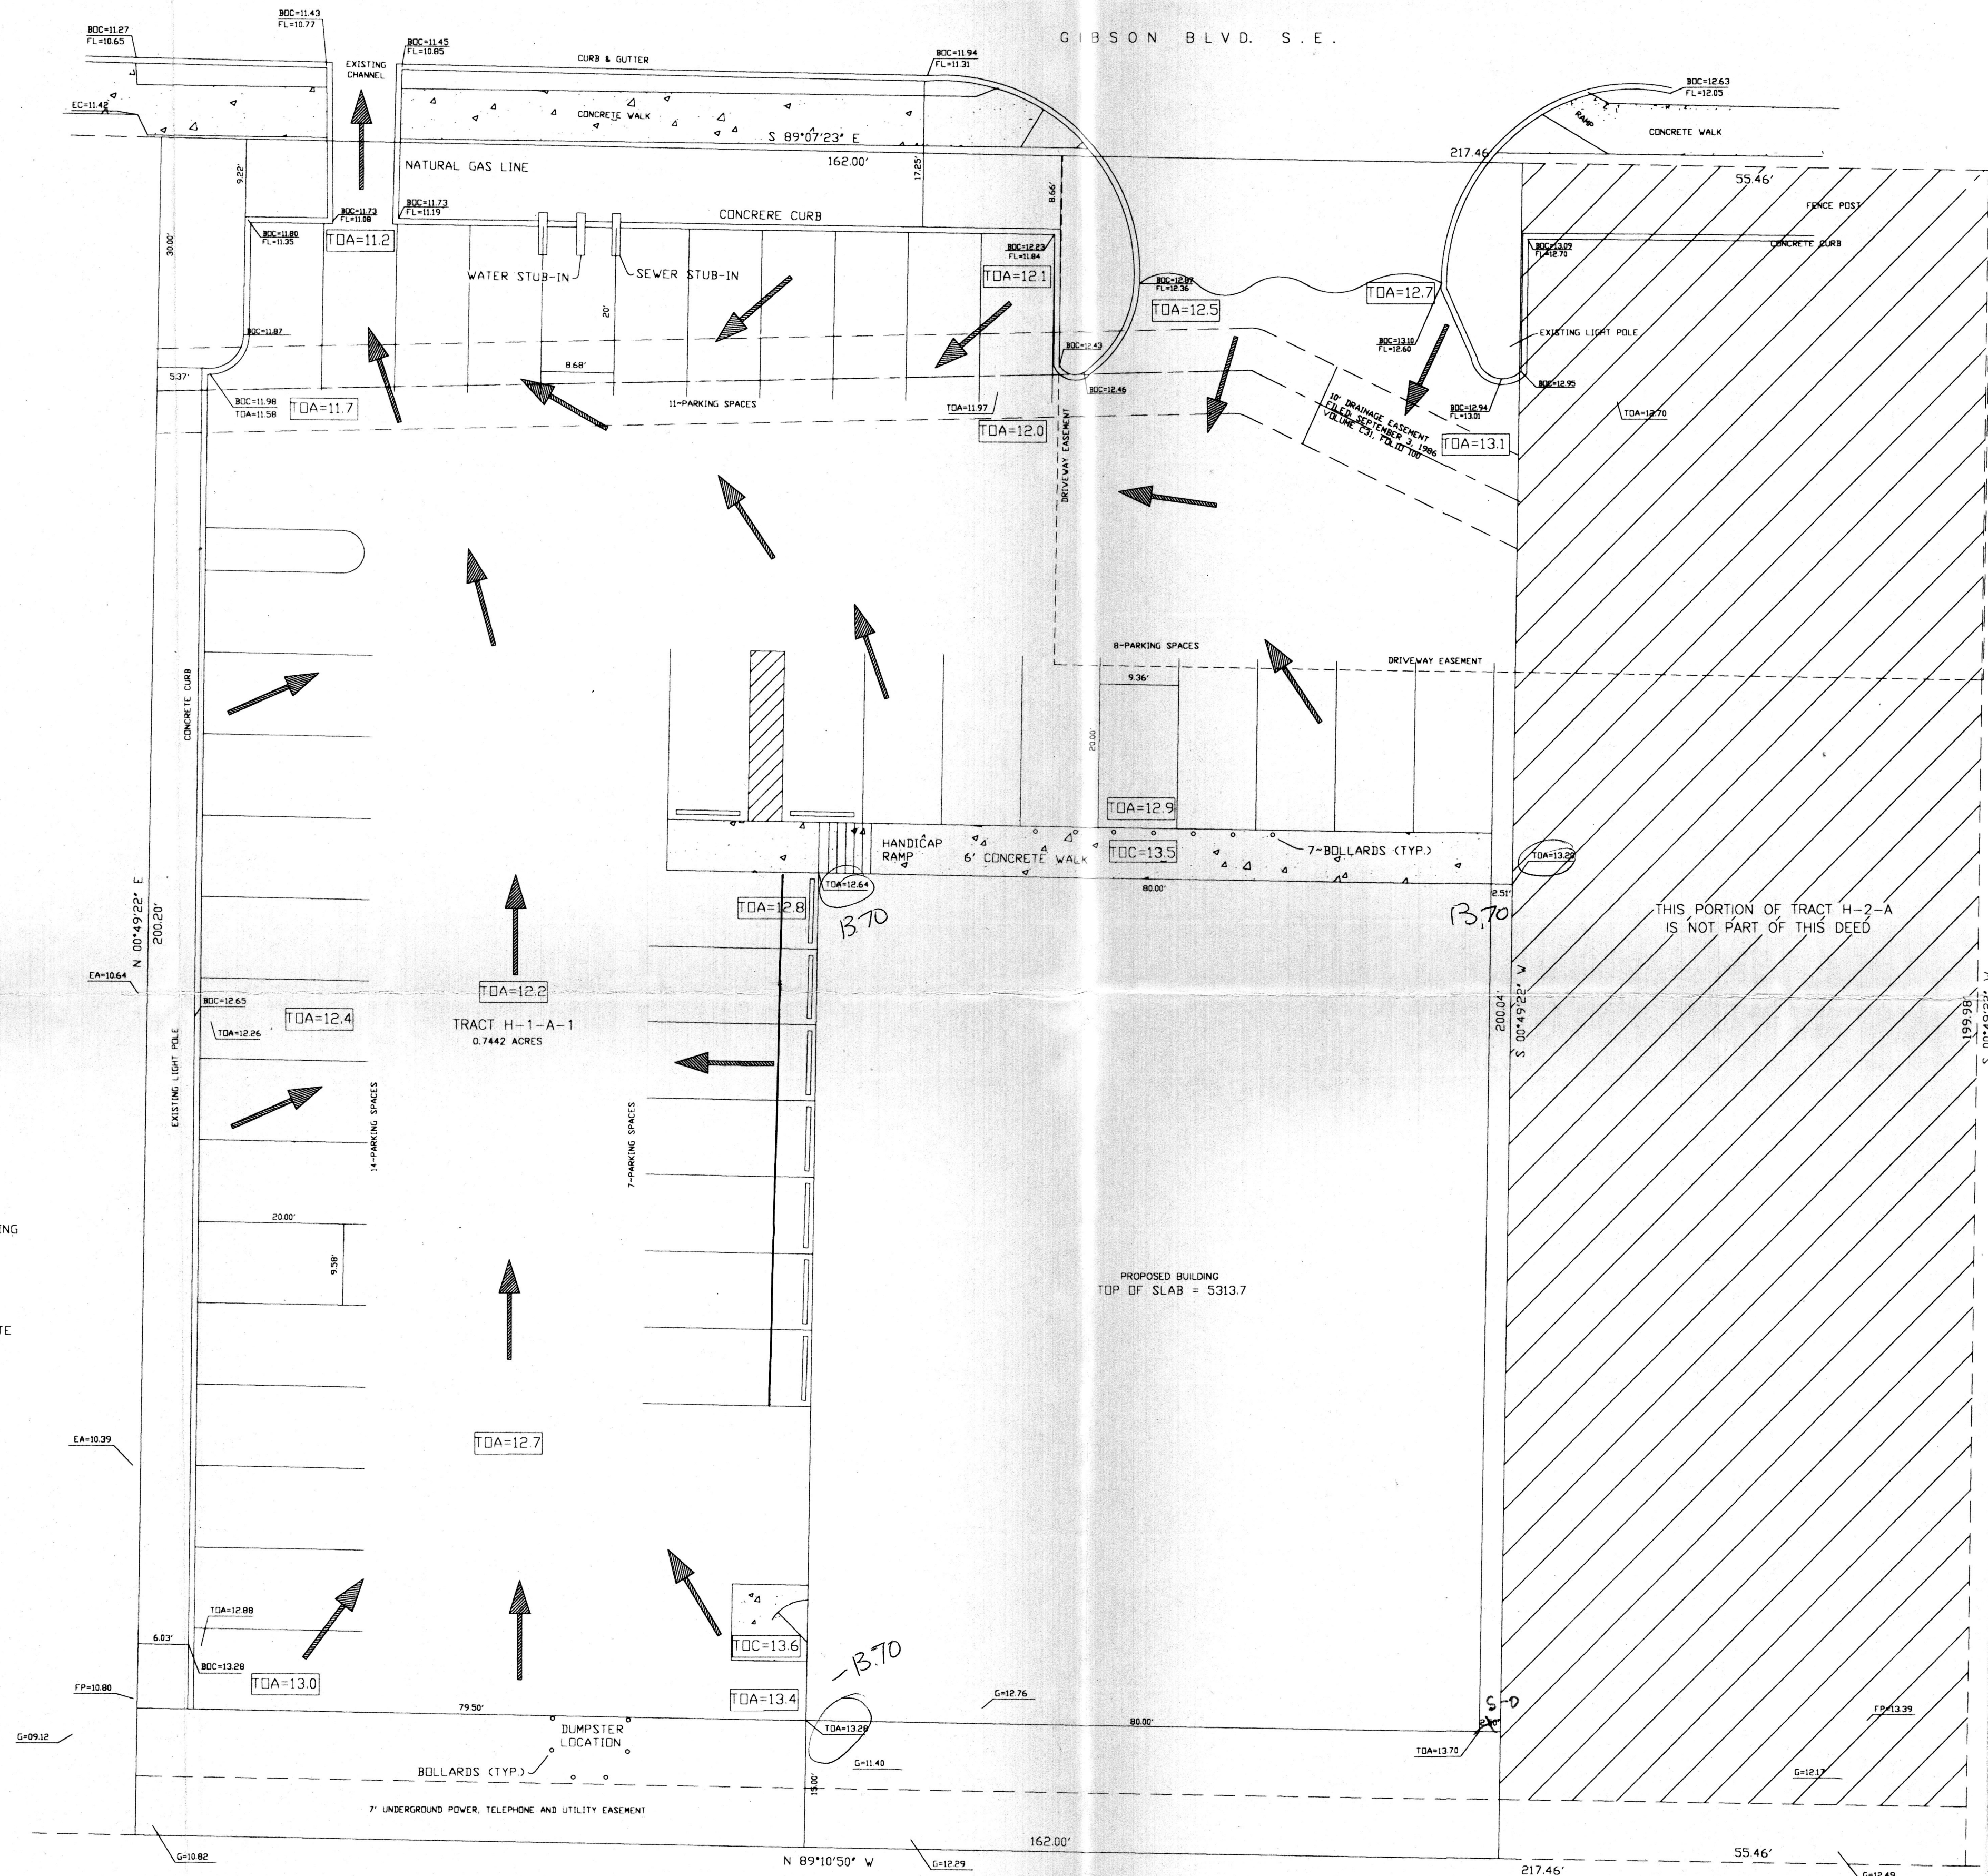

DRAINAGE PLAN
OF
TRACT H-2-A
SIESTA HILLS
SUBDIVISION No. 2
6000 GIBSON S.E.
CITY OF ALBUQUERQUE
BERNALILLO COUNTY, NEW MEXICO

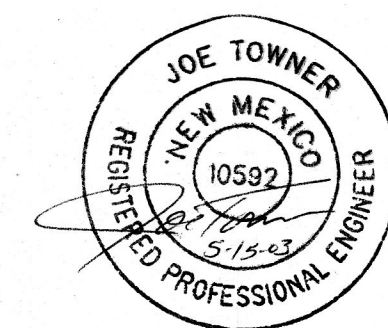

AS BUILT

TES
TOWNER ENGINEERING SERVICES, INC.
8205 SPAIN N.E. SUITE #205
ALBUQUERQUE, NM 87109
PHONE: (505) 828-1930
FAX: (505) 828-1967

SITE INFORMATION
FAMILY DOLLAR STORE
5350 GIBSON SE
ALB, NEW MEXICO 87104


DESIGN TYPE
80'x100' BLDG
MTL PANEL FACIA
SPLIT FACE CMU FRONT
MTL PANEL EXT WALLS


SHEET TITLE:
DRAINAGE PLAN

SHEET NO.

C-2

REV	DESCRIPTION	DATE	BY	CHKD	APVLS
1	ISSUED FOR PERMIT	10/23/02	TLS	JT	JT

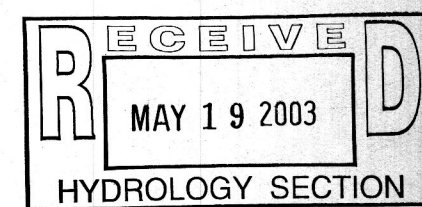

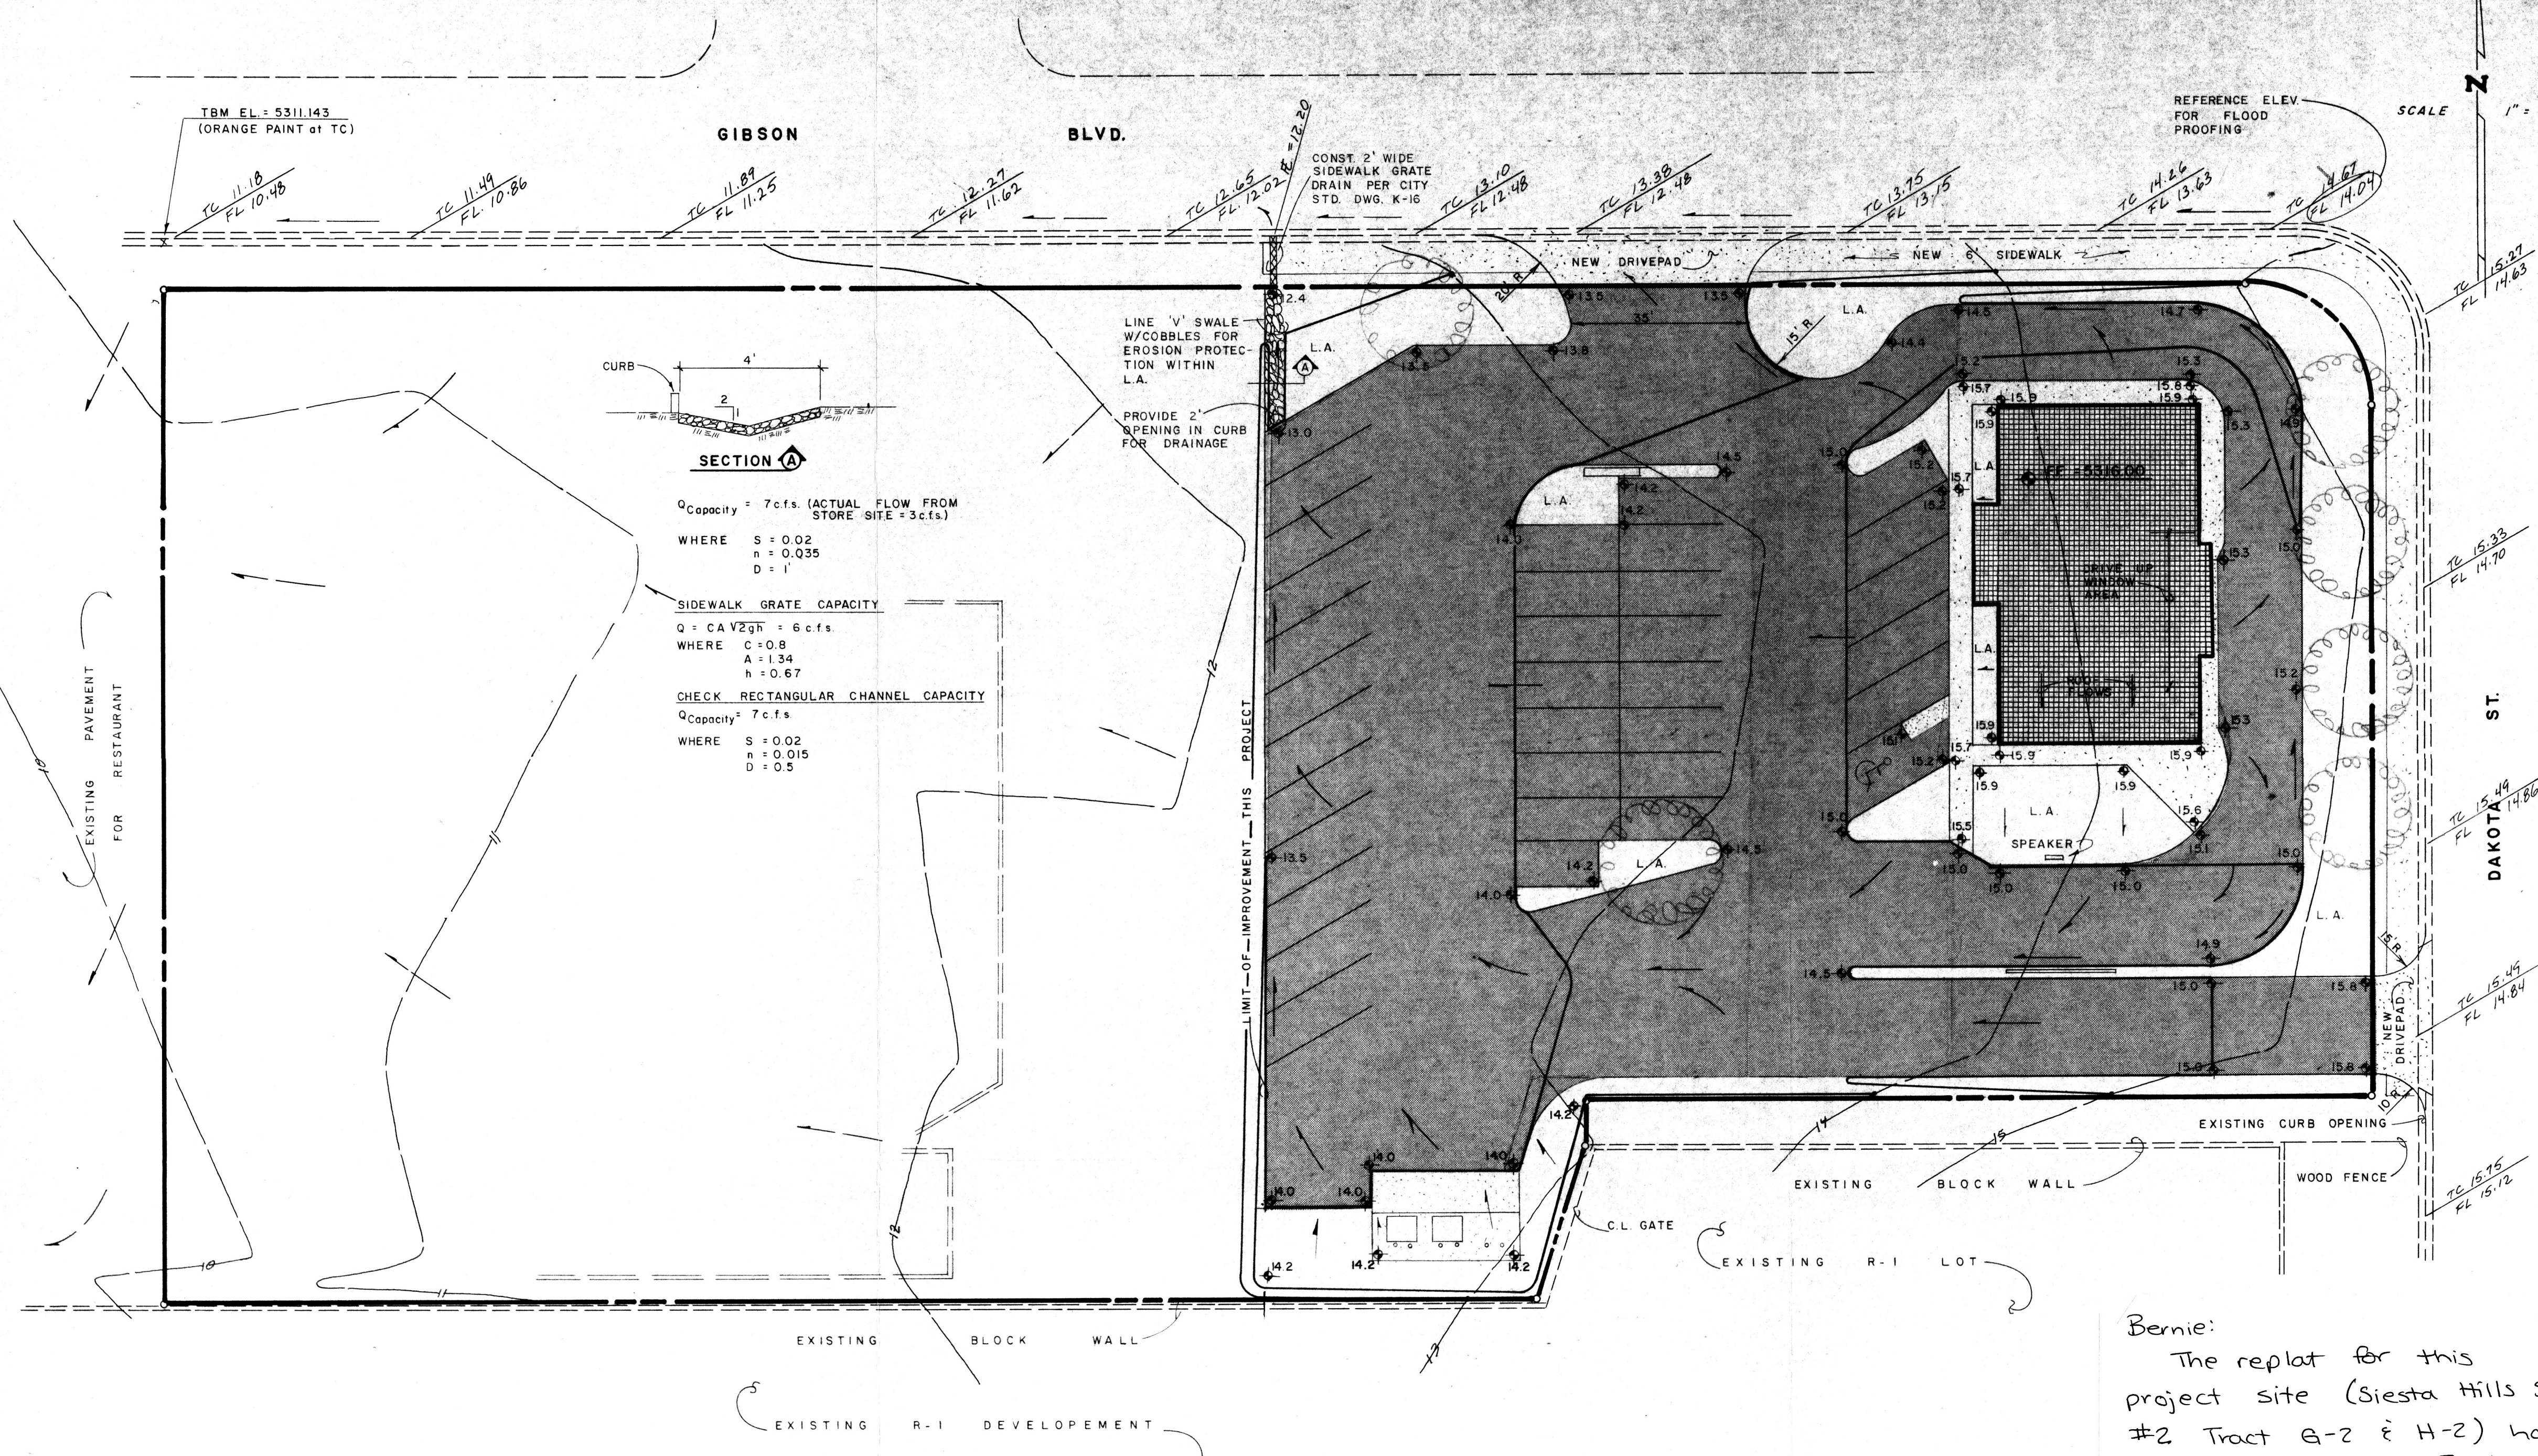

SCOPE:

The proposed improvements, comprised of a Wendy's Restaurant and associated pavement for access and parking, will be located on the east side of the tract of land, all of which is presently owned by Wendy's.

The present site is an undeveloped tract. A portion of the existing landscaping along the east side of the site will remain and become part of the final site development.

The site had been previously divided into Tracts C-1, H-1, in which the Wendy's Restaurant was to occupy the west tract. Due to this relocation to the east tract, the plat will be replatted to move this common boundary. This replat process is presently underway and a copy will be submitted to Hydrology upon completion of the filing.

The intent of this plan is to show:

- Grading relationships between the existing ground elevations and proposed finished elevations in order to facilitate positive drainage to designated discharge points.
- The extent of proposed site improvements, including buildings, walks and pavement.
- The flow rate/volume of rainfall runoff across or around these improvements and methods of handling these flows to meet City requirements for drainage management.
- The relationship of onsite improvements with existing neighboring property to insure an orderly transition between proposed and surrounding grades.

GENERAL NOTES:

LEGAL: Tracts C-1 and H-1, Siesta Hills Subdivision.

SURVEYOR: Topo - John Armstrong. Replat - Ross Elder Surveying Co.

B.M.: Top of sewer manhole rim, M18-101, located near intersection of Ridgecrest and San Pedro, west edge of rim, Elevation = 5,324.07.

T.B.M.: NW corner of site, orange paint on T.C. Elevation = 5,311.14.

SOILS: SCS Soils Map #31, Soil Type 'McB', Hydrologic Group 'B'.

FLOOD HAZARD: Based on existing flood hazard maps, the site is adjacent to flooding which occurs in Gibson Blvd. (ANDS-L-18).

OFF-SITE DRAINAGE: Offsite flows are intercepted by existing street improvements on the east and by an existing R-1 development located along the south boundary.

EROSION CONTROL: The contractor will be responsible for controlling erosion from leaving the site during the construction phase. This can be accomplished by use of a temporary fabric fence or a 1'-high earth berm across the low points to prevent runoff entering into Gibson Blvd.

CALCULATIONS: Calculations are based on the City of Albuquerque D.P.M. Manual, Vol. II for the 100 year-6 hour storm, using the Rational Formula to compare the existing and proposed runoff rates.

RATIONAL METHOD- Q = CIA

Area of site: 81,800 sq. ft. = 1.9 AC. (Both Tracts)
 37,482 sq. ft. = 0.86 AC. (Wendy's Restaurant Tract)

Run-off Coefficient:

Existing site:	Developed Site:
Undeveloped Area = 81,800 ft ²	Roof Area = 2,600 ft ²
	Landscaped Area = 3,400 ft ²
	Paved Area = 31,600 ft ²
$C_u = \frac{81,800(0.40)}{81,800} = 0.40$	$C_u = \frac{44,200(0.40)}{81,800} = 0.22$
	$C_l = \frac{3,400(0.25)}{81,800} = 0.01$
	$C_p = \frac{34,200(0.95)}{81,800} = 0.40$
Composite C = 0.40	Composite C = 0.63

Rainfall Intensity:

$I = P_2 (6.84) \cdot 0.51 = 4.96$ per hour
 where $P_2 = 2.35$ (DPM 22.2 D-1)
 $C = 10$ minutes

Existing Condition:

$Q_{100} = (0.40)(4.96)(1.9) = 4 cfs$

Developed Condition:

$Q_{100} = (0.63)(4.96)(1.9) = 6 cfs$




SUMMARY:

$Q_{100} = (4)-(6) = 2 cfs$ (increase)
 $V_{100} = (6000)-(9000) = 3000 cu. ft.$ (increase)

CONCLUSION:

This site lies adjacent to the main drainage route for flows leaving Kirtland AFB at Louisiana and Gibson. The Kirtland Detention Facility eliminated the Gibson flooding. Additionally, intermediate flows below the Kirtland Facility will be picked up in the near future by the extension of the Highland Detention System. These two factors make it possible for this site to free discharge onto Gibson Blvd.

Bernie:
 The replat for this project site (Siesta Hills Subd #2 Tract G-2 & H-2) has been signed by Fred 8/27/86.

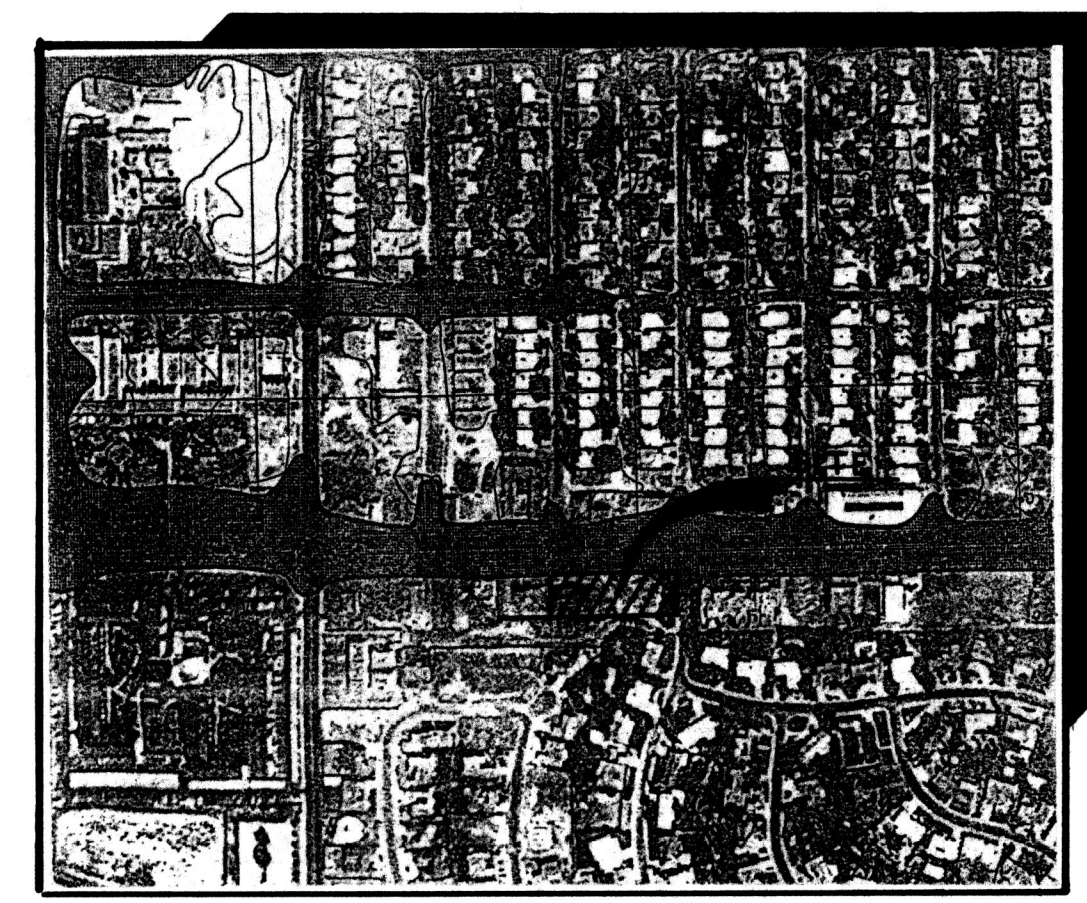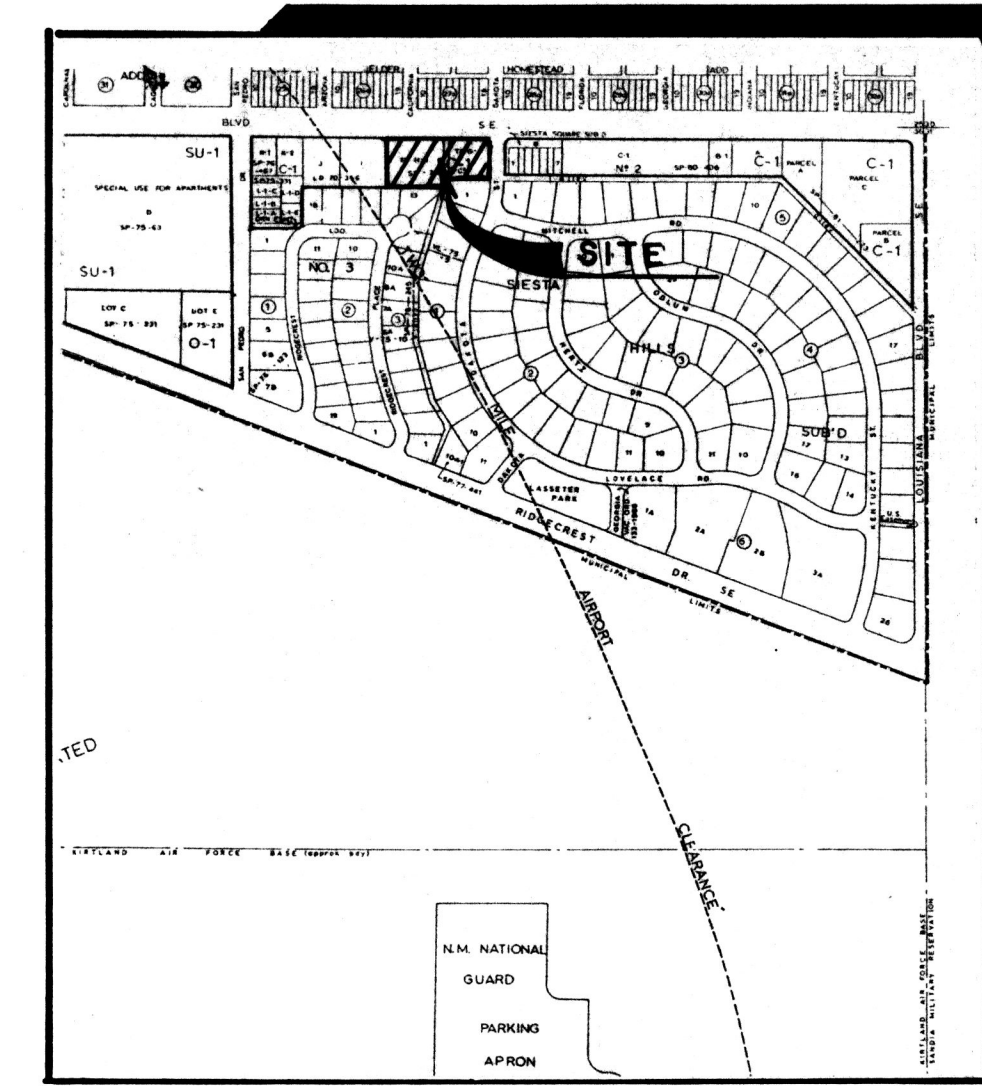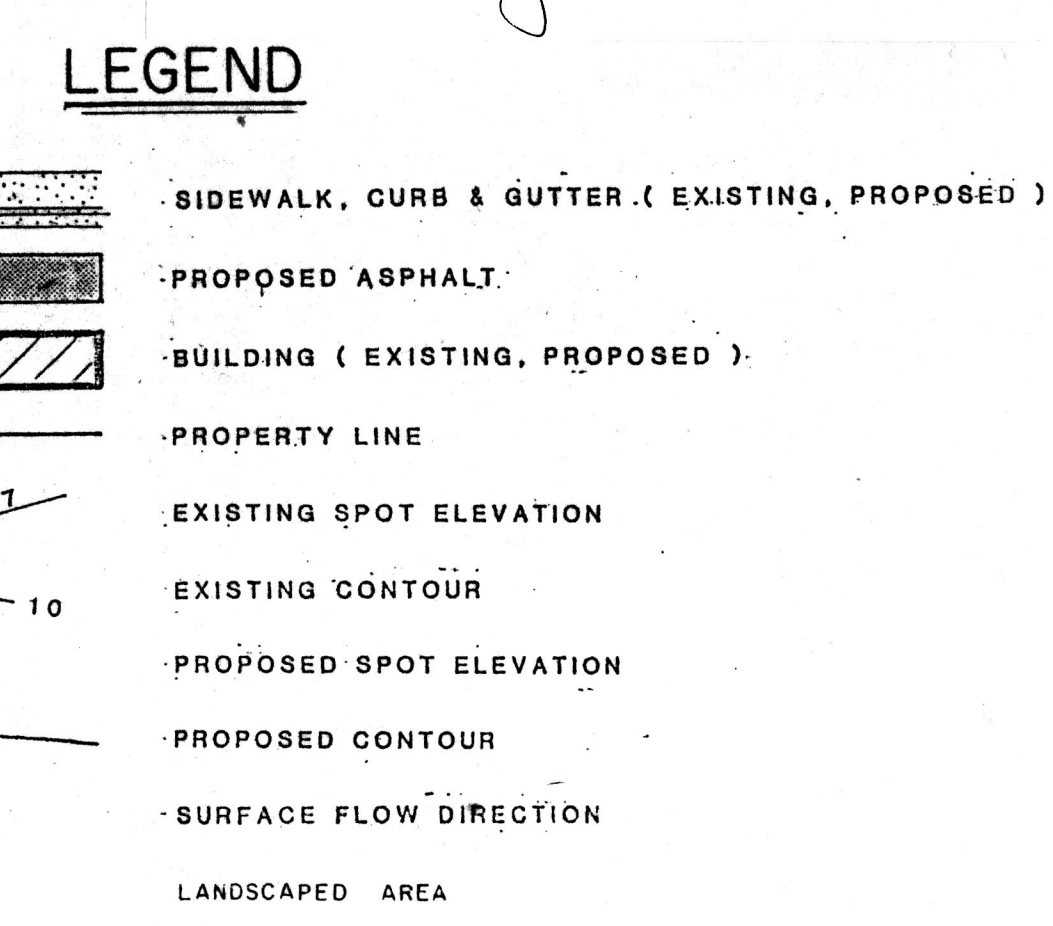

REVISED 7-11-86:

- SWALE SECTION ADDED
- NOTE ADDED FOR GRATE CAPACITY & CHANNEL CAPACITY

Christopher L. Weiss 7-17-86
 CHRISTOPHER L. WEISS DATE

REVISED 8-1-86:

- CHANGED DUMPSTER LOCATION.
- REVISED BUILDING OUTLINE.
- ADDED WHEELCHAIR RAMP.

Christopher L. Weiss 8-1-86
 CHRISTOPHER L. WEISS DATE

WEISS-HINES ENGINEERING INC.

1100 ALVARADO N.E. SUITE B

ALBUQUERQUE, NEW MEXICO 87110

(505) 266-3444

DATE

DESIGNED C.L.W. 6-86

DRAWN M.L.W. 6-86

CHECKED C.W. 6-86

REVISIONS

1

CHANGED DUMPSTER LOCATION.

DRAINAGE / GRADING PLAN

WENDY'S RESTAURANT

GIBSON BOULEVARD S.E.

ENGINEERING


CHARTERED PROFESSIONAL ENGINEER

CRISTOPHER L. WEISS

NEW MEXICO

17127

SHEET 1 OF 1

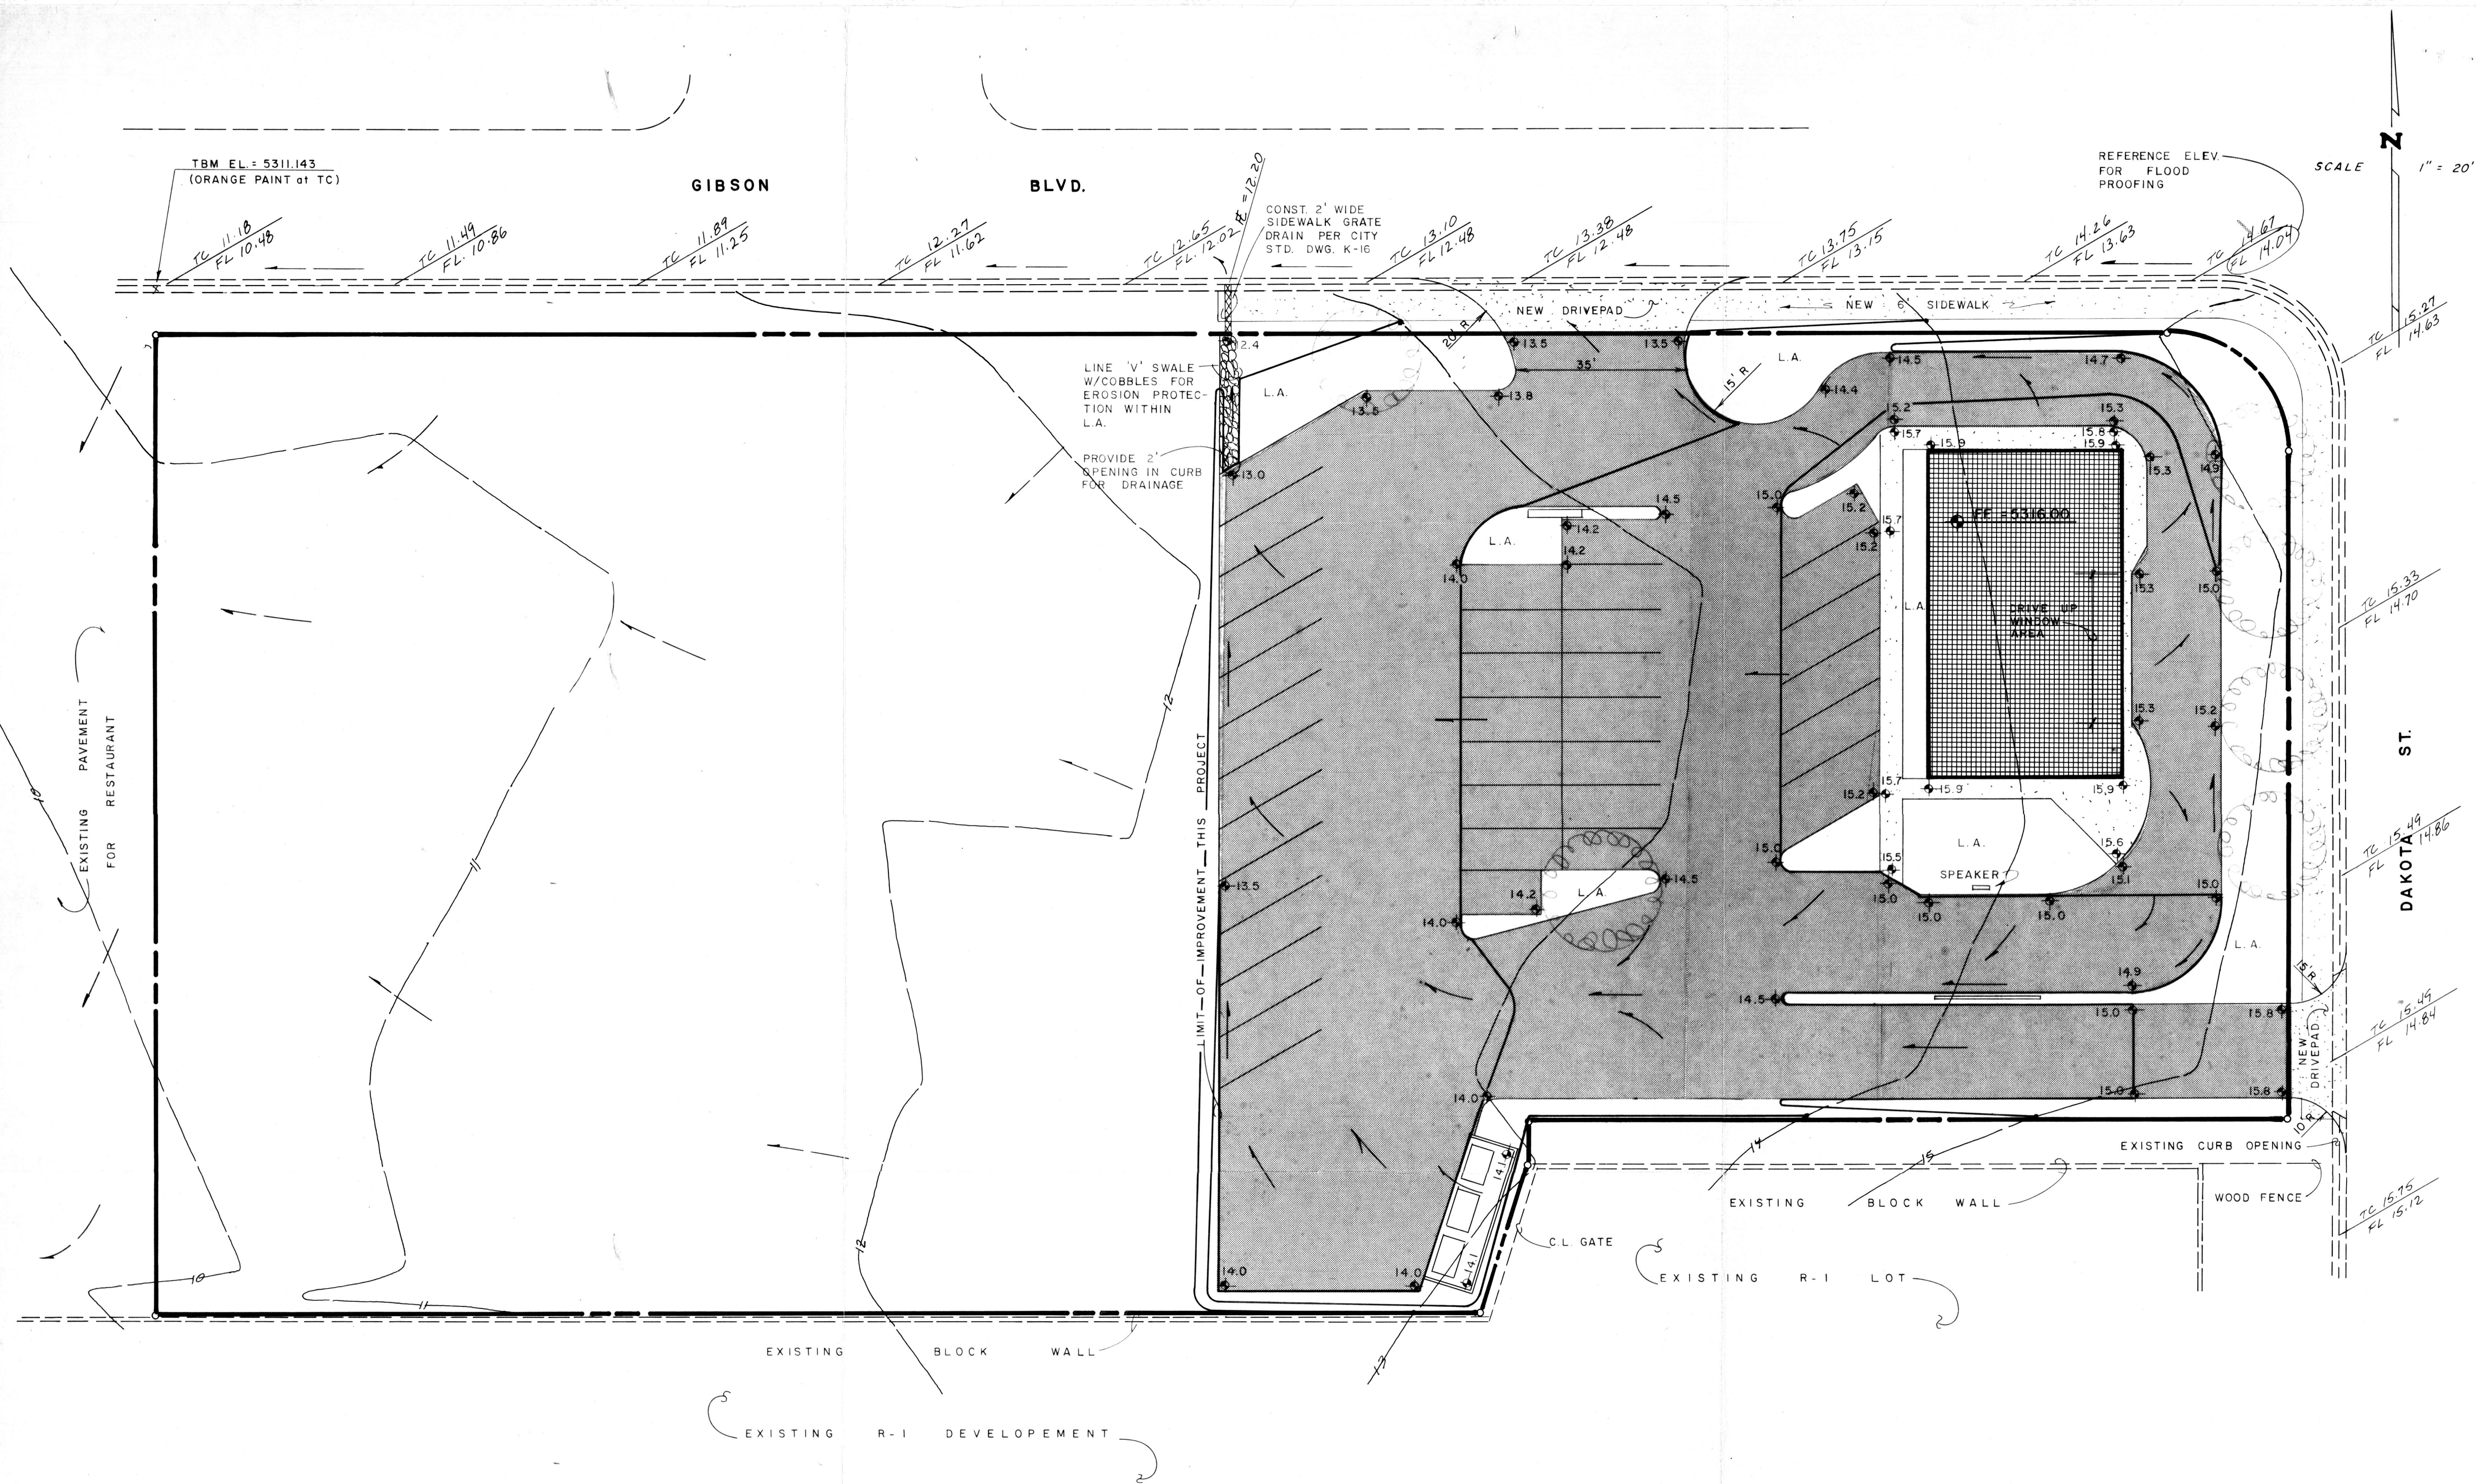

SCOPE:

The proposed improvements are comprised of a Wendy's Restaurant and associated pavement for access and parking, will be located on the east side of the tract of land, all of which is presently owned by Wendy's.

The present site is an undeveloped tract. A portion of the existing landscaping along the east side of the site will remain and become part of the final site development.

The site had been previously divided into Tracts G-1, H-1, in which the Wendy's Restaurant was to occupy the west tract. Due to this relocation to the east tract, the plat will be replatted to move this common boundary. This replat process is presently underway and a copy will be submitted to Hydrology upon completion of the filing.

The intent of this plan is to show:

- Grading relationships between the existing ground elevations and proposed finished elevations in order to facilitate positive drainage to designated discharge points.
- The extent of proposed site improvements, including buildings, walks and pavement.
- The flow rate/volume of rainfall runoff across or around these improvements and methods of handling these flows to meet City requirements for drainage management.
- The relationship of onsite improvements with existing neighboring property to insure an orderly transition between proposed and surrounding grades.

GENERAL NOTES:

LEGAL: Tracts G-1 and H-1, Siesta Hills Subdivision.

SURVEYOR: Topo - John Armstrong. Replat - Ross Elder Surveying Co.

B.M.: Top of sewer manhole rim, M18-101, located near intersection of Ridgecrest and San Pedro, west edge of rim, Elevation = 5,324.07.

T.B.M.: NW corner of site, orange paint on T.C. Elevation = 5,311.14.

SOILS: SCS Soils Map #31, Soil Type 'Web', Hydrologic Group 'B'.

FLOOD HAZARD: Based on existing flood hazard maps, the site is adjacent to flooding which occurs in Gibson Blvd. (AMIS-L-18).

OFF-SITE DRAINAGE: Offsite flows are intercepted by existing street improvements on the east and by an existing R-1 development located along the south boundary.

EROSION CONTROL: The contractor will be responsible for controlling erosion from leaving the site during the construction phase. This can be accomplished by use of a temporary fabric fence or a 2'-high earth berm across the low points to prevent runoff entering into Gibson Blvd.

CALCULATIONS: Calculations are based on the City of Albuquerque D.P.M. Manual, Vol. II for the 100 year-6 hour storm, using the Rational Formula to compare the existing and proposed runoff rates.

RATIONAL METHOD- Q = CIA

Area of site: 81,800 sq.ft. = 1.9 Ac. (Both Tracts)
73,600 sq.ft. = 0.86 Ac. (Wendy's Restaurant Tract)

Run-off Coefficient:

Existing site: Undeveloped Area = 81,800 ft²
Developed Site: Roof Area = 2,600 ft²
Landscaped Area = 3,400 ft²
Paved Area = 31,600 ft²

$C_u = \frac{81,800(0.40)}{81,800} = 0.40$	$C_d = \frac{44,200(0.40)}{81,800} = 0.22$
$C_l = \frac{3,400(0.25)}{81,800} = 0.01$	$C_p = \frac{34,200(0.95)}{81,800} = 0.40$
Composite C = 0.40	
Composite C = 0.63	

Rainfall Intensity:

$I = P_6 (6.84) I^{-0.51} = 4.96$ per hour
where $P_6 = 2.35$ (DPM 22.2 D-1)
 $C = 10$ minutes

Existing Condition:

$Q_{100} = (0.40)(4.96)(1.9) = 4$ cfs
 $V_{100} = (4)(50)(60 \text{ sec/min})/2 = 6000$ cu. ft.

Developed Condition:


$Q_{100} = (0.63)(4.96)(1.9) = 6$ cfs
 $V_{100} = (6)(50)(60)/2 = 9000$ cu. ft.

SUMMARY:


$C_{100} = (4)-(6) = 2$ cfs (increase)
 $V_{100} = (6000)-(9000) = 3000$ cu. ft. (increase)

CONCLUSION:

This site lies adjacent to the main drainage route for flows leaving Kirtland AFB at Louisiana and Gibson. The Kirtland Detention Facility eliminated the Gibson flooding. Additionally, intermediate flows below the Kirtland Facility will be picked up in the near future by the extension of the Highland Detention System. These two factors make it possible for this site to free discharge onto Gibson Blvd.

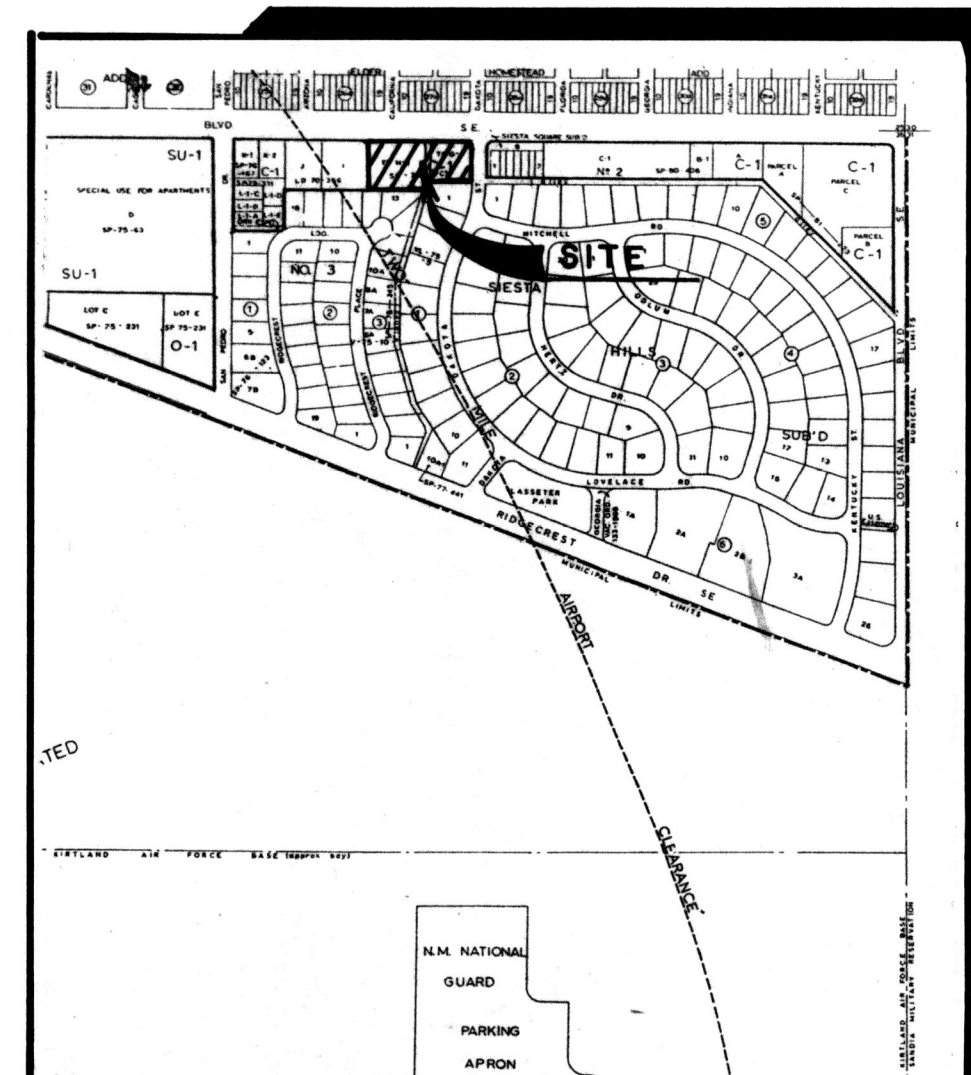

VICINITY MAP M-18

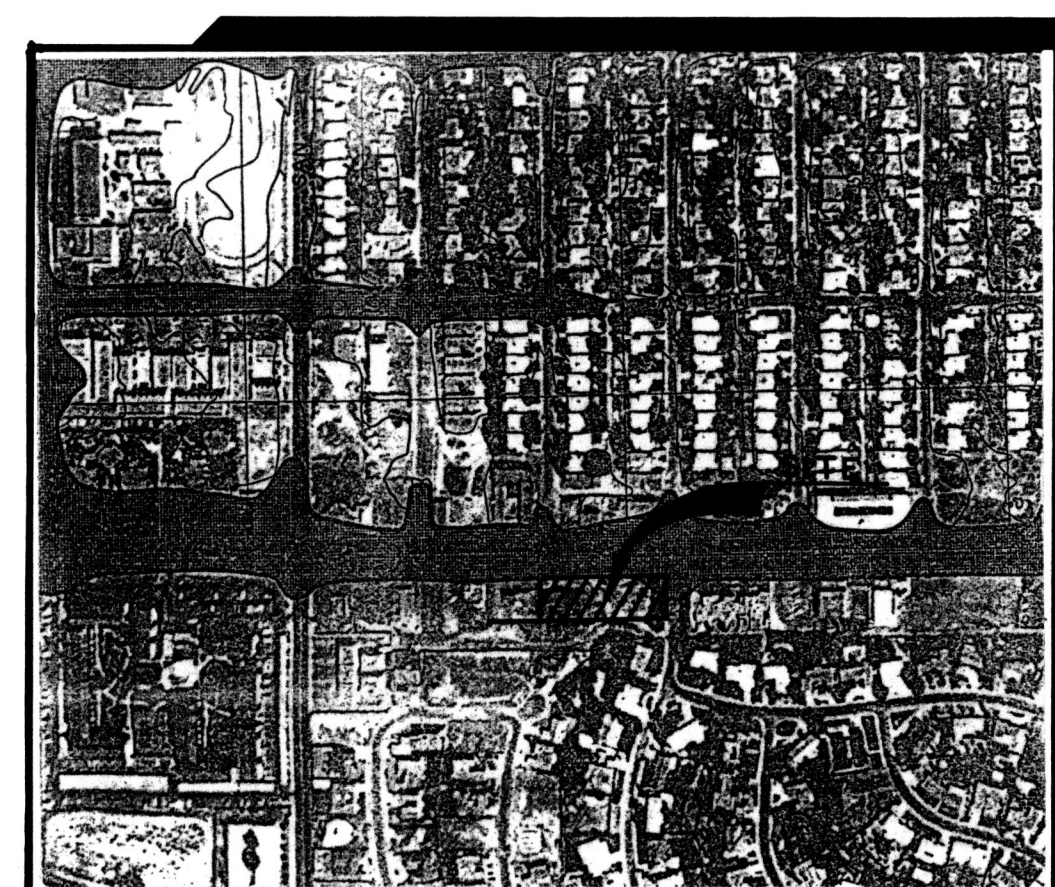

FLOOD HAZARD MAP

LEGEND

- SIDEWALK, CURB & GUTTER (EXISTING, PROPOSED)
- PROPOSED ASPHALT
- BUILDING (EXISTING, PROPOSED)
- PROPERTY LINE
- EXISTING SPOT ELEVATION
- EXISTING CONTOUR
- PROPOSED SPOT ELEVATION
- PROPOSED CONTOUR
- SURFACE FLOW DIRECTION
- LANDSCAPED AREA

RECEIVED
JUN 26 1986
HYDROLOGY SECTION

DRAINAGE / GRADING PLAN
WENDY'S RESTAURANT
GIBSON BOULEVARD S.E.


H
ENGINEERING

PROFESSIONAL ENGINEER
STATE OF NEW MEXICO
No. 10000
JUN 26 1986

SHEET 1 OF 1

WEISS-HINES ENGINEERING, INC.
1100 ALVARADO N.E. SUITE B
ALBUQUERQUE, NEW MEXICO 87110
(505) 266-3444

DATE: 6-86
DESIGNED: CJO
DRAWN: M/L
CHECKED: CJO

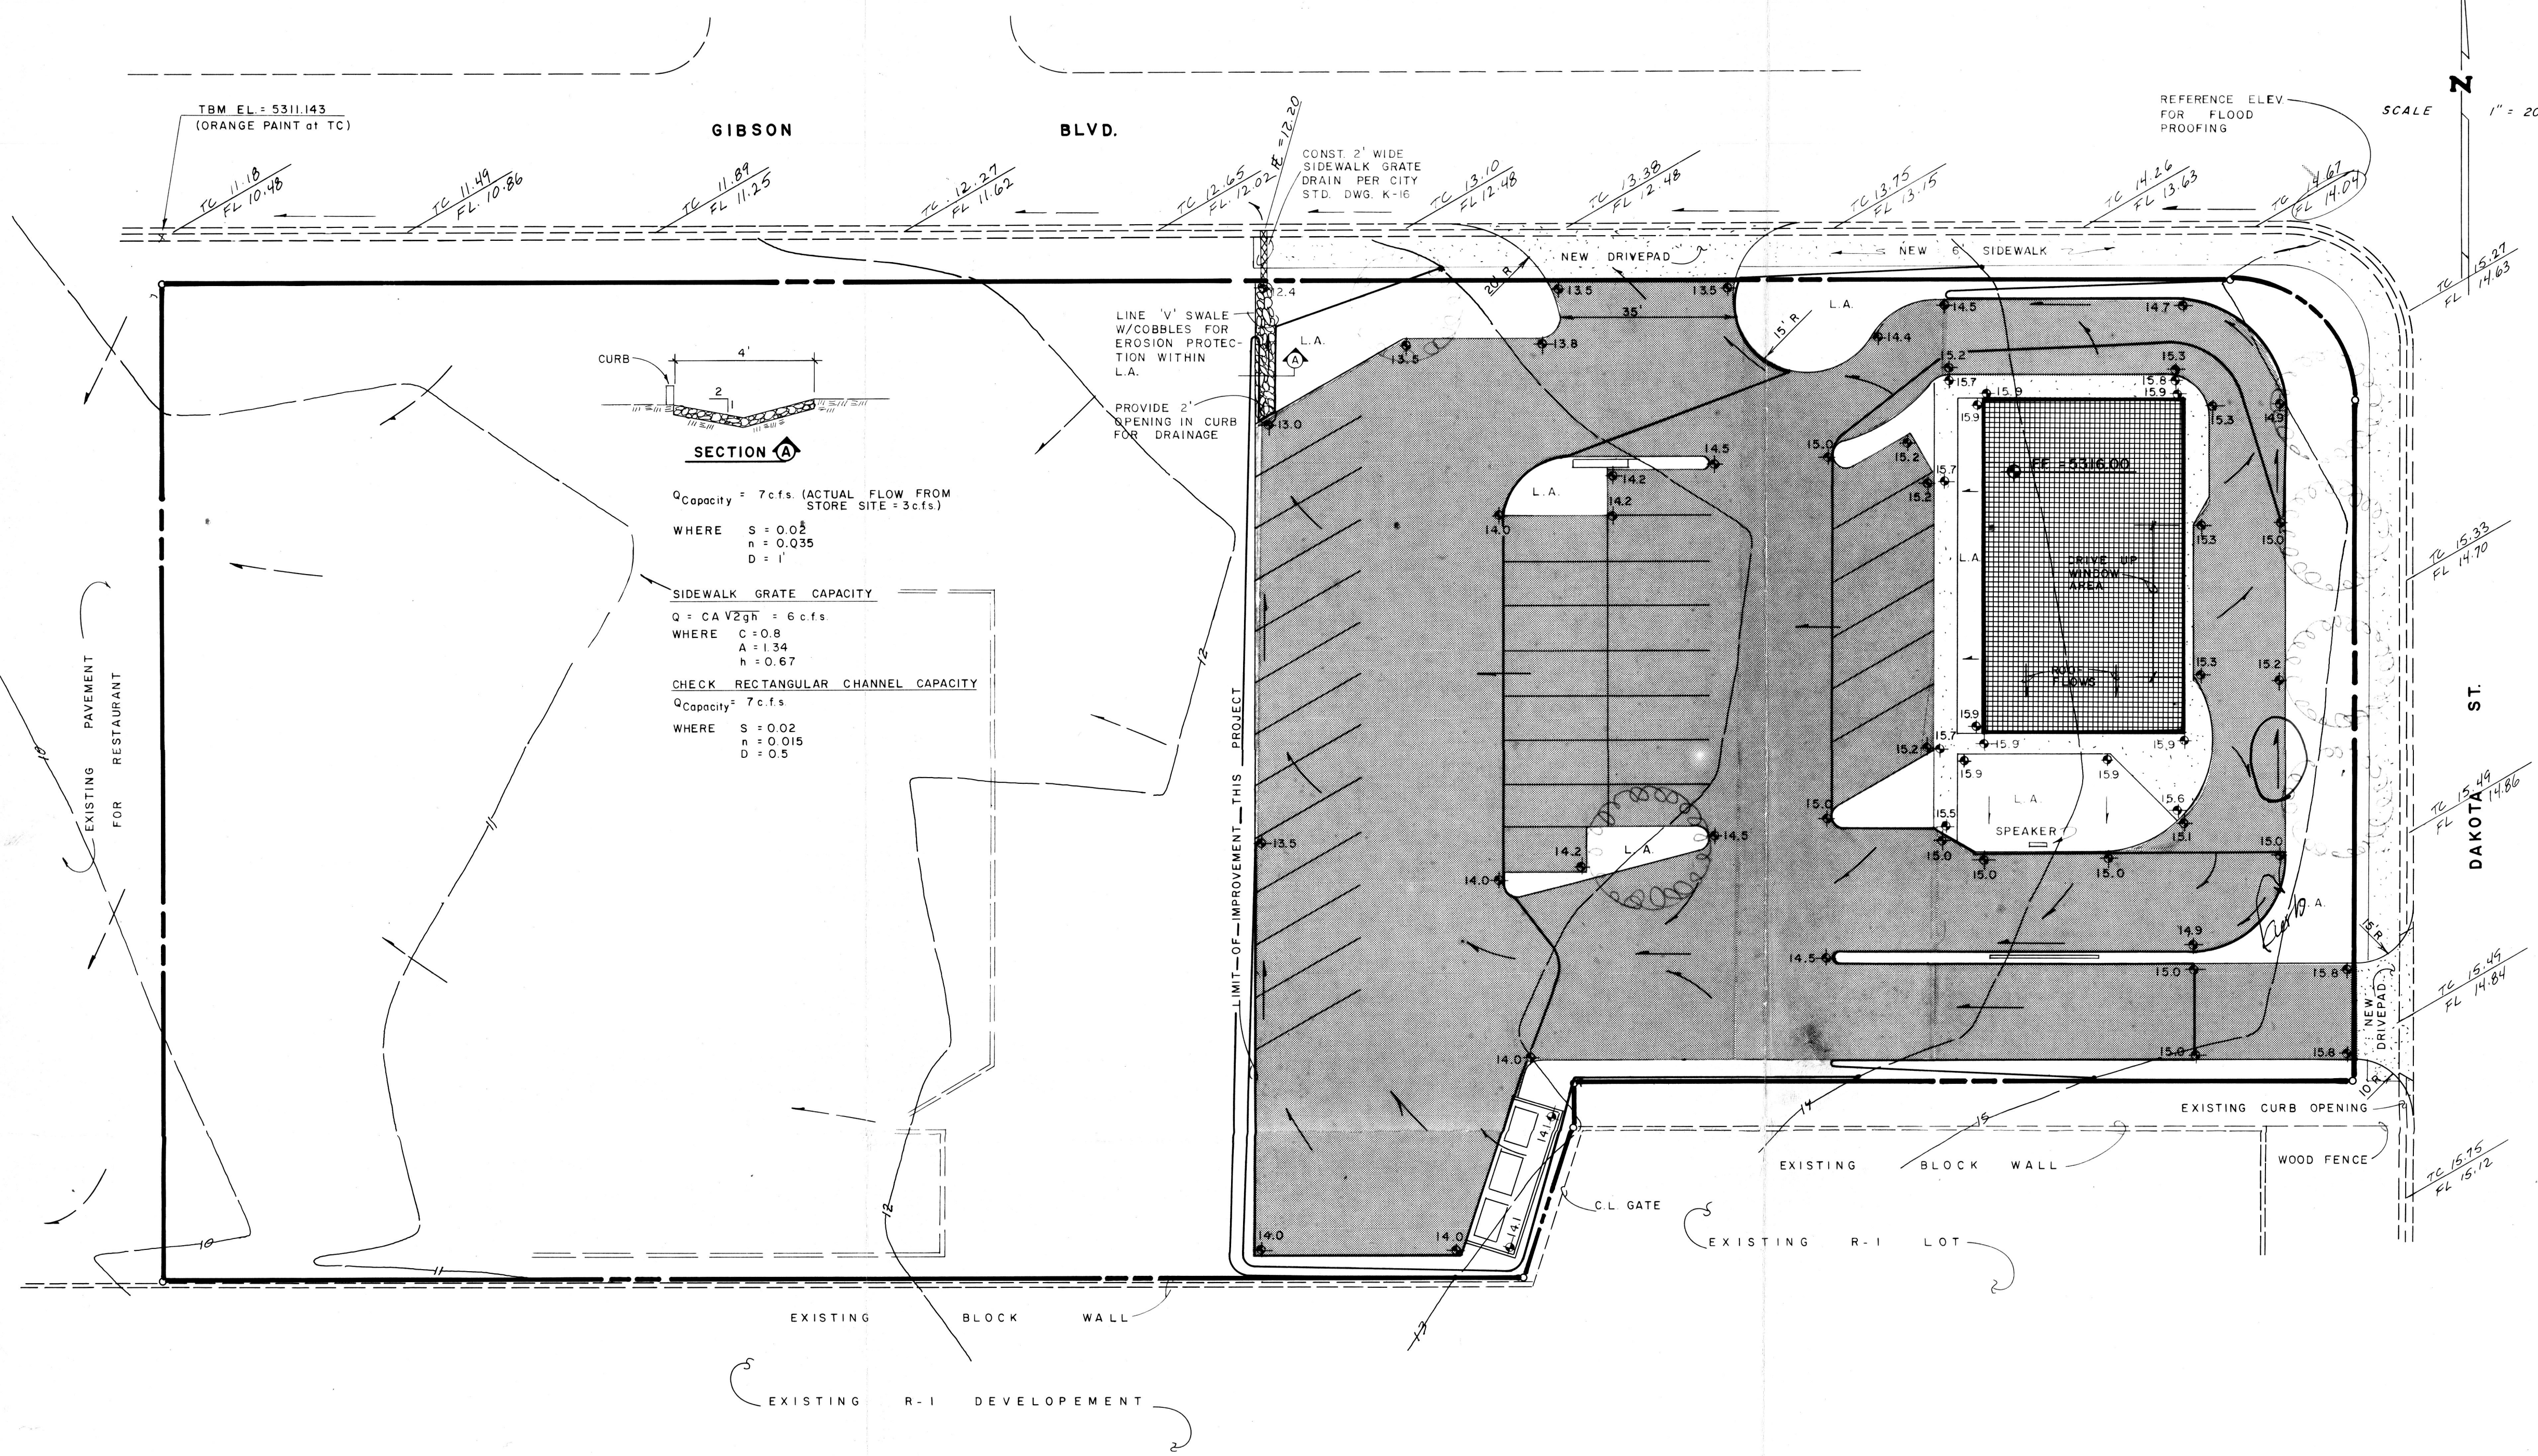

SCOPE:

The proposed improvements, comprised of a Wendy's Restaurant and associated pavement for access and parking, will be located on the east side of the tract of land, all of which is presently owned by Wendy's.

The present site is an undeveloped tract. A portion of the existing landscaping along the east side of the site will remain and become part of the final site development.

The site had been previously divided into Tracts G-1, H-1, in which the Wendy's Restaurant was to occupy the west tract. Due to this relocation to the east tract, the plat will be replatted to move this common boundary. This replat process is presently underway and a copy will be submitted to Hydrology upon completion of the filing.

The intent of this plan is to show:

- Grading relationships between the existing ground elevations and proposed finished elevations in order to facilitate positive drainage to designated discharge points.
- The extent of proposed site improvements, including buildings, walks and pavement.
- The flow rate/volume of rainfall runoff across or around these improvements and methods of handling these flows to meet City requirements for drainage management.
- The relationship of onsite improvements with existing neighboring property to insure an orderly transition between proposed and surrounding grades.

GENERAL NOTES:

LEGAL: Tracts C-1 and H-1, Siesta Hills Subdivision.

SURVEYOR: Topo - John Armstrong. Replat - Ross Elder Surveying Co.

B.M.1: Top of sewer manhole rim, M18-101, located near intersection of Ridgecrest and San Pedro, west edge of rim, Elevation = 5,324.07.

T.B.M.1: NW corner of site, orange point on T.C. Elevation = 5,311.14.

SOILS: SCS Soils Map #31, Soil Type 'WcB', Hydrologic Group 'B'.

FLOOD HAZARD: Based on existing flood hazard maps, the site is adjacent to flooding which occurs in Gibson Blvd. (AMDS-L-18).

OFF-SITE DRAINAGE: Offsite flows are intercepted by existing street improvements on the east and by an existing R-1 development located along the south boundary.

EROSION CONTROL: The contractor will be responsible for controlling erosion from leaving the site during the construction phase. This can be accomplished by use of a temporary fabric fence or a 1'-high earth berm across the low points to prevent runoff entering into Gibson Blvd.

CALCULATIONS: Calculations are based on the City of Albuquerque D.P.M. Manual, Vol. II for the 100 year-6 hour storm, using the Rational Formula to compare the existing and proposed runoff rates.

RATIONAL METHOD- Q = CIA

Area of site: 81,800 sq.ft. = 1.9 Ac. (Both Tracts)
 37,462 sq.ft. = 0.86 AC. (Wendy's Restaurant Tract)

Run-off Coefficient:

Existing site:	Developed Site:
Undeveloped Area = 81,800 ft ²	Roof Area = 2,600 ft ²
	Landscaped Area = 3,400 ft ²
	Paved Area = 31,600 ft ²
$C_u = \frac{81,800(0.40)}{81,800} = 0.40$	$C_u = \frac{44,200(0.40)}{81,800} = 0.22$
	$C_l = \frac{3,400(0.25)}{81,800} = 0.01$
	$C_p = \frac{34,200(0.95)}{81,800} = 0.40$
Composite C = 0.40	Composite C = 0.63

Rainfall Intensity:

$I = P_6 (6.84) T^{-0.51} = 4.96"$ per hour
 where $P_6 = 2.35" (\text{DPM } 22.2 \text{ D-1})$
 $T = 10 \text{ minutes}$

Existing Condition:

$Q_{100} = (0.40)(4.96)(1.9) = 4 \text{ cfs}$

$V_{100} = (4)(50T)(60 \text{ sec/min})/2 = 6000 \text{ cu. ft.}$

Developed Condition:

$Q_{100} = (0.63)(4.96)(1.9) = 6 \text{ cfs}$




$V_{100} = (6)(50)(60)/2 = 9000 \text{ cu. ft.}$

SUMMARY:

$Q_{100} = (4)-(6) = 2 \text{ cfs (increase)}$
 $V_{100} = (6000)-(9000) = 3000 \text{ cu. ft. (increase)}$

CONCLUSION:

This site lies adjacent to the main drainage route for flows leaving Kirtland AFB at Louisiana and Gibson. The Kirtland Detention Facility eliminated the Gibson flooding. Additionally, intermediate flows below the Kirtland Facility will be picked up in the near future by the extension of the Highland Detention System. These two factors make it possible for this site to free discharge onto Gibson Blvd.

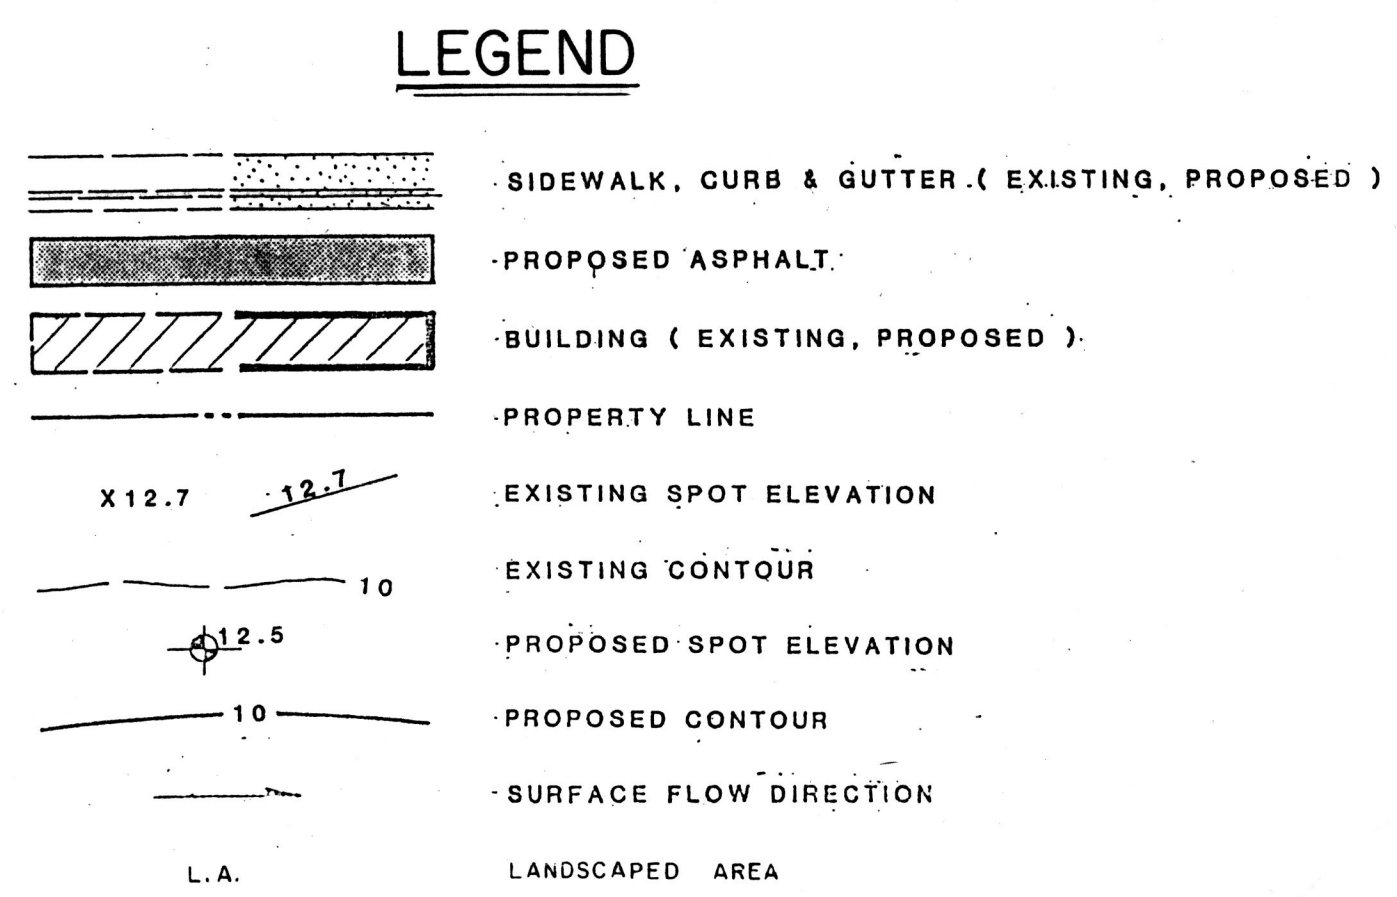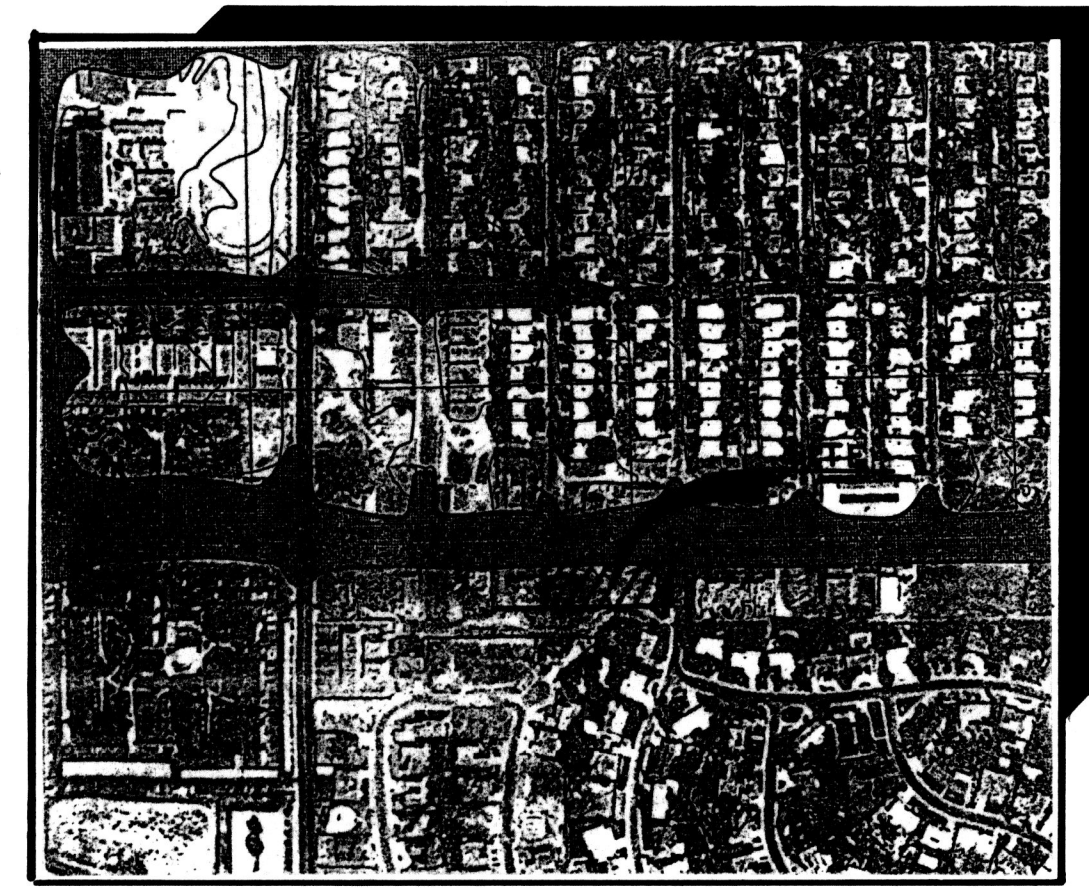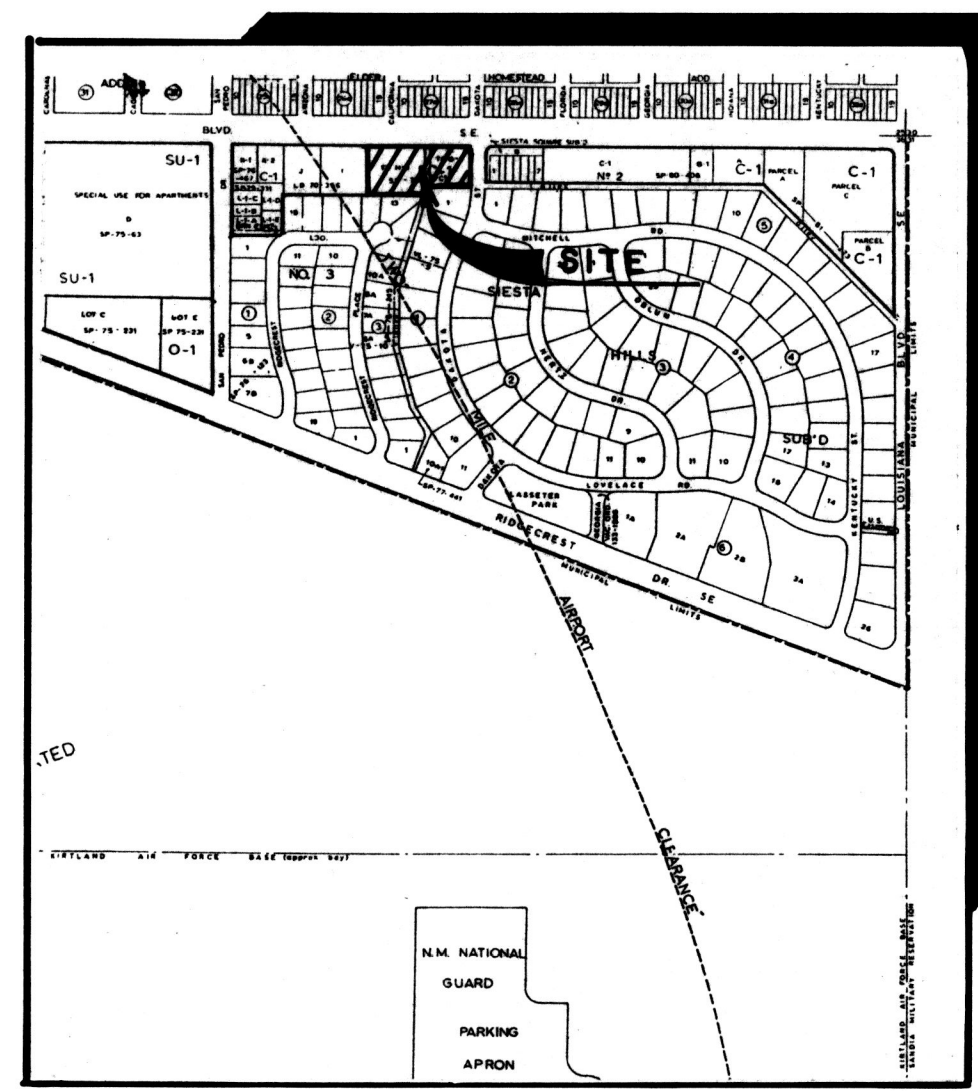

REVISED 7-11-86:

- SWALE SECTION ADDED
- NOTE ADDED FOR GRATE CAPACITY & CHANNEL CAPACITY

Christopher L. Weiss 7-17-86
 CHRISTOPHER L. WEISS DATE

WEISS-HINES ENGINEERING INC.

1100 ALVARADO N.E. SUITE B
ALBUQUERQUE, NEW MEXICO 87110
(505) 266-3444

REVISIONS

DATE

DESIGNED CJC

DRAWN MJC

CHECKED CW

7-11-86

7-17-86

DRAINAGE / GRADING PLAN

WENDY'S RESTAURANT


GIBSON BOULEVARD S.E.

ENGINEERING

CHRISTOPHER L. WEISS

PROFESSIONAL ENGINEER

SHEET 1 OF 1

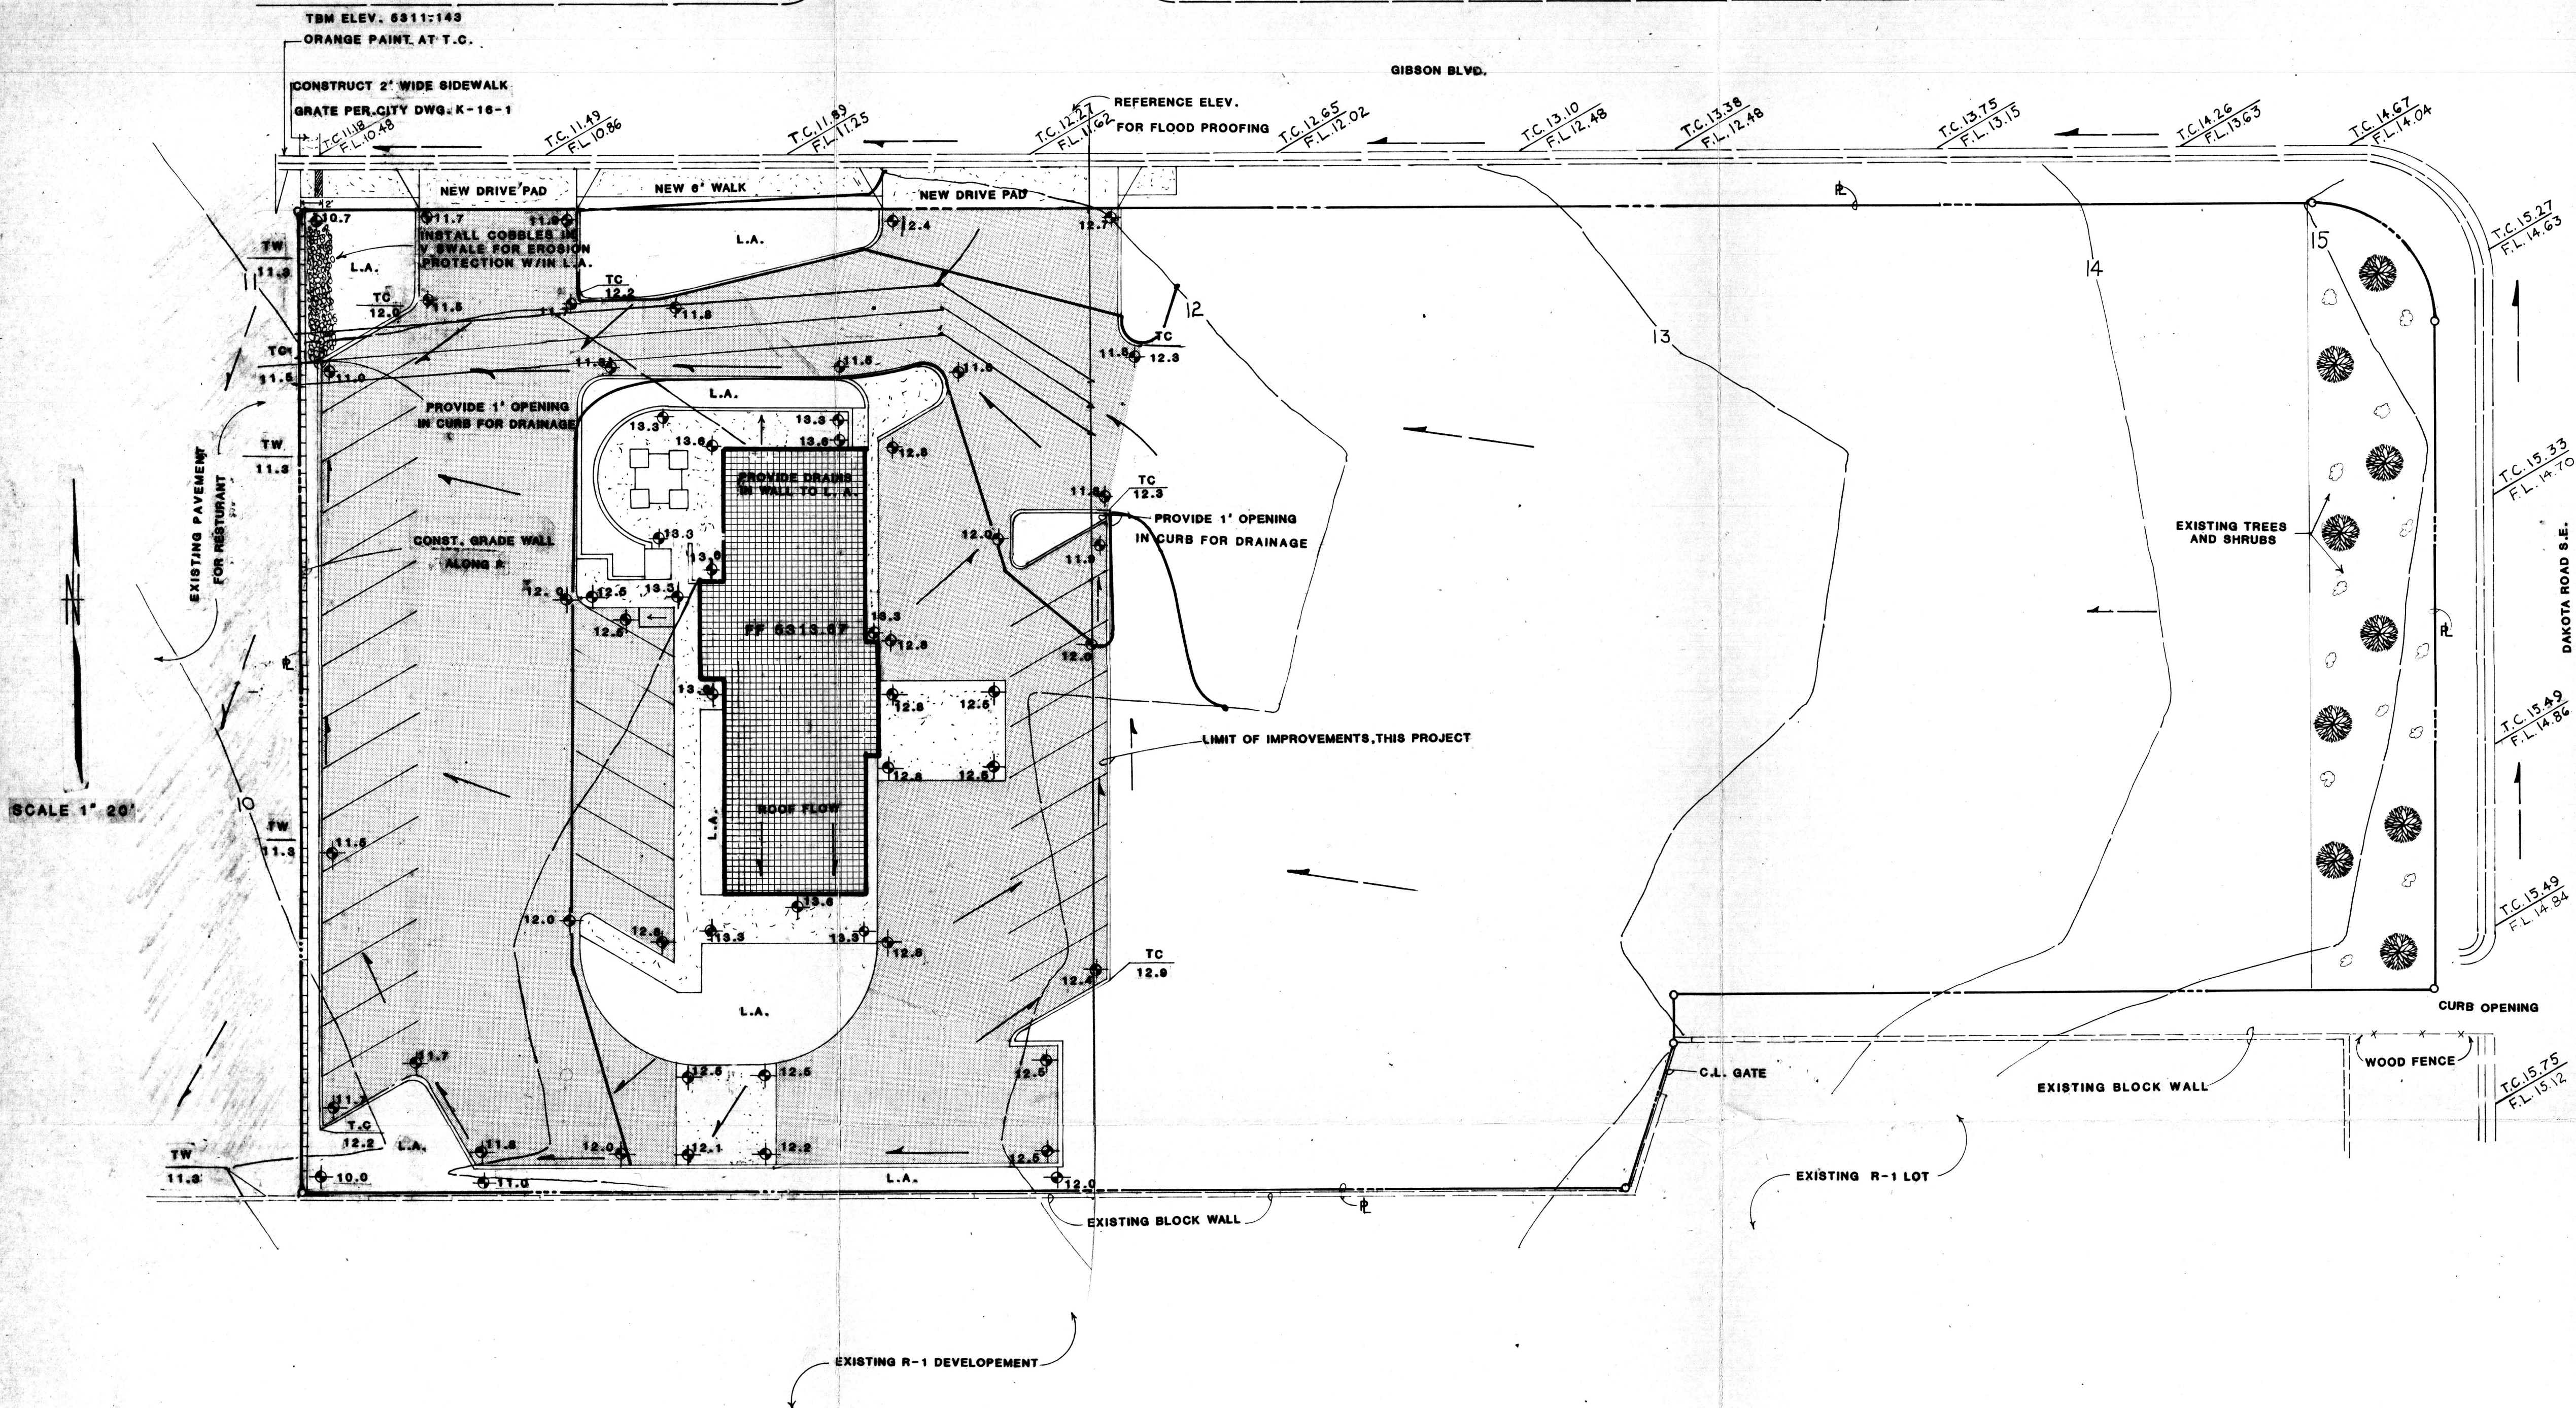


SCALE 1" = 20'

LEGEND

- SIDEWALK, CURB & GUTTER (EXISTING, PROPOSED)
- PROPOSED ASPHALT
- BUILDING (EXISTING, PROPOSED)
- PROPERTY LINE
- EXISTING SPOT ELEVATION
- EXISTING CONTOUR
- PROPOSED SPOT ELEVATION
- PROPOSED CONTOUR
- SURFACE FLOW DIRECTION
- LANDSCAPED AREA

VICINITY MAP M-18

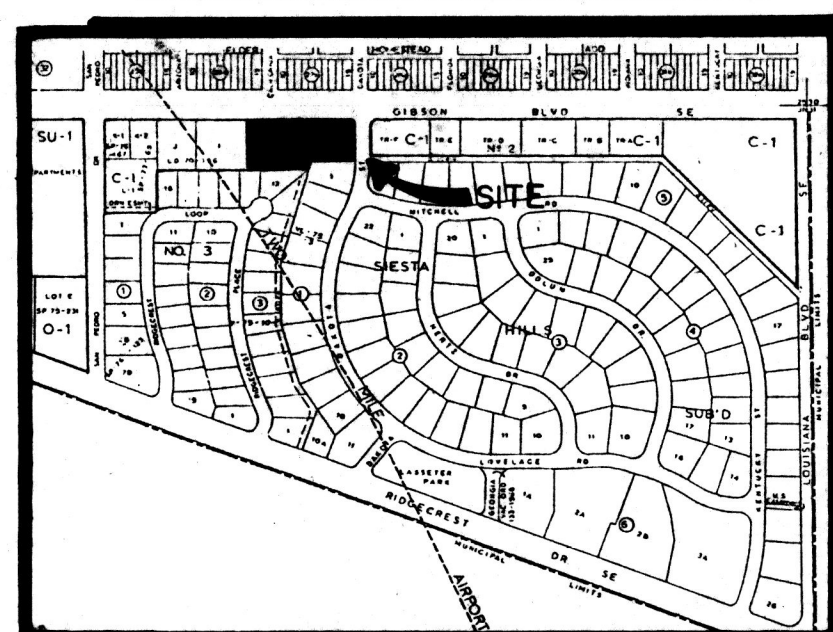

SCOPE:

The proposed improvements, is comprised of a Wendys Restaurant, associated pavement for access, walks and curbs. The proposed improvements are located on the west side of the tract of land, all of which is owned by Wendys.

The present site is undeveloped and with the exception of the proposed improvements, there are no plans for developing the remainder of the site at this time.

The intent of this plan is to show:

- Grading relationships between the existing ground elevations and proposed finished elevations in order to facilitate positive drainage to designated discharge points.
- The extent of proposed site improvements, including buildings, walks and pavement.
- The flow rate/volume of rainfall runoff across or around these improvements and methods of handling these flows to meet City requirements for drainage management.
- The relationship of onsite improvements with existing neighboring property to insure an orderly transition between proposed and surrounding grades.

GENERAL NOTES:

- LEGAL:**
Tracts C-1 & H-1, Siesta Hills Subdivision.
- SURVEYOR:**
John Armstrong, 3816 Edith Blvd. N.E., Albuquerque, New Mexico.
- B.M.:**
Top of sewer manhole rim, M18-101, located near intersection of Ridgecrest and San Pedro, west edge of rim, Elevation 5324.07.
- T.B.M.:**
NW corner of site, orange paint on T.C. Elevation 5311.14.
- SOILS:**
SCS Soils Map #31, Soil Type WeB, Hydrologic Group "B".
- FLOOD HAZARD:**
Site is affected by flooding which occurs in Gibson Blvd. (AMDS L-18).
- OFF-SITE DRAINAGE:**
Site is isolated from offsite drainage on the east and south by existing street improvements and an existing R-1 development.
- EROSION CONTROL:**
Contractor should construct a temporary fabric fence or 2' high earth berm across low point of site after preliminary grading has been completed to prevent sediment laden runoff from entering Gibson Blvd.
- CALCULATIONS:**
Based on a pre-design meeting with City of Albuquerque Hydrology, on 11-16-84, the following criteria was established.

- Discharge to be determined by analysis of downstream capacity.
- Flood proofing required.

Calculations are based on the City of Albuquerque D.P.M. Manual, Vol. II for the 100 year-6 hour storm, using the Rational Formula to compare the existing and proposed runoff rates.

RATIONAL METHOD- Q = CIA

Area of site: 81,800 sq.ft. = 1.9 Ac.

Run-off Coefficient:

Existing Site:	Developed Site:
A imp. = 0 Ac	A imp. = 0.7 Ac
X imp. = 0 %	X imp. = 37 %
"C" = 0.34 (DPM 22.2 C-1)	"C" = 0.51 (DPM 22.2 C-1)

Rainfall Intensity:

$I = P_6 (6.84) T_c^{0.084} = 4.96"$ per hour
where $P_6 = 2.35"$ (DPM 22.2 D-1)
 $T_c = 10$ minutes

Existing Condition:

Q100 = (0.34)(4.96)(1.9) = 3 cfs

V100 = (3)(5 Tc)(60 sec/in)/2 = 4500 cu. ft.

Developed Condition:

Q100 = (0.51)(4.96)(1.9) = 5 cfs

V100 = (5)(50)(60)/2 = 7500 cu. ft.



SUMMARY:

$\Delta Q100 = (3)-(5) = 2$ cfs (increase)
 $\Delta V100 = (4500)-(7500) = 3000$ cu. ft. (increase)

DOWNSTREAM CAPACITY:

Site lies in the path of the flows presently discharging from Kirkland AFB at Louisiana Blvd. and Gibson. The Kirkland Detention Facility, which is presently under construction, will eliminate the Gibson flooding. Additionally, the flows from the site will be picked up in the near future by the extension of the Highland Detention drainage system. These two factors make it possible for this site to free discharge to Gibson Blvd.

DRAINAGE / GRADING PLAN WENDYS RESTAURANT GIBSON BOULEVARD S.E.

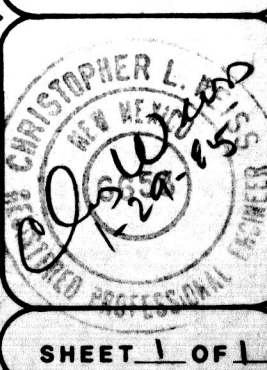
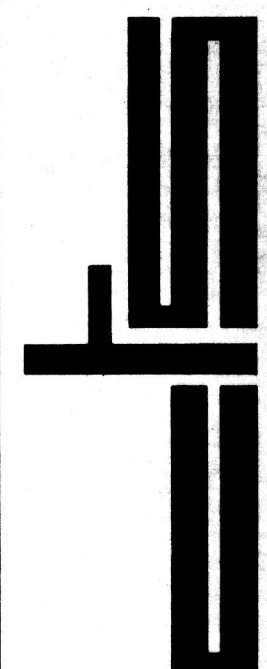


SHEET 1 OF 1

CTS INC.
ENGINEERING
1100 ALVARADO N.E. SUITE A
ALBUQUERQUE, NEW MEXICO 87110
(505) 266-3444

REVISIONS	DATE
DESIGNED C.L.	1-25
DRAWN M.W.	1-25
CHECKED C.L.	1-25

SITE PLAN
OF
TRACT H-2-A
SIESTA HILLS
SUBDIVISION No. 2
5450 6000 GIBSON S.E.
CITY OF ALBUQUERQUE
BERNALILLO COUNTY, NEW MEXICO

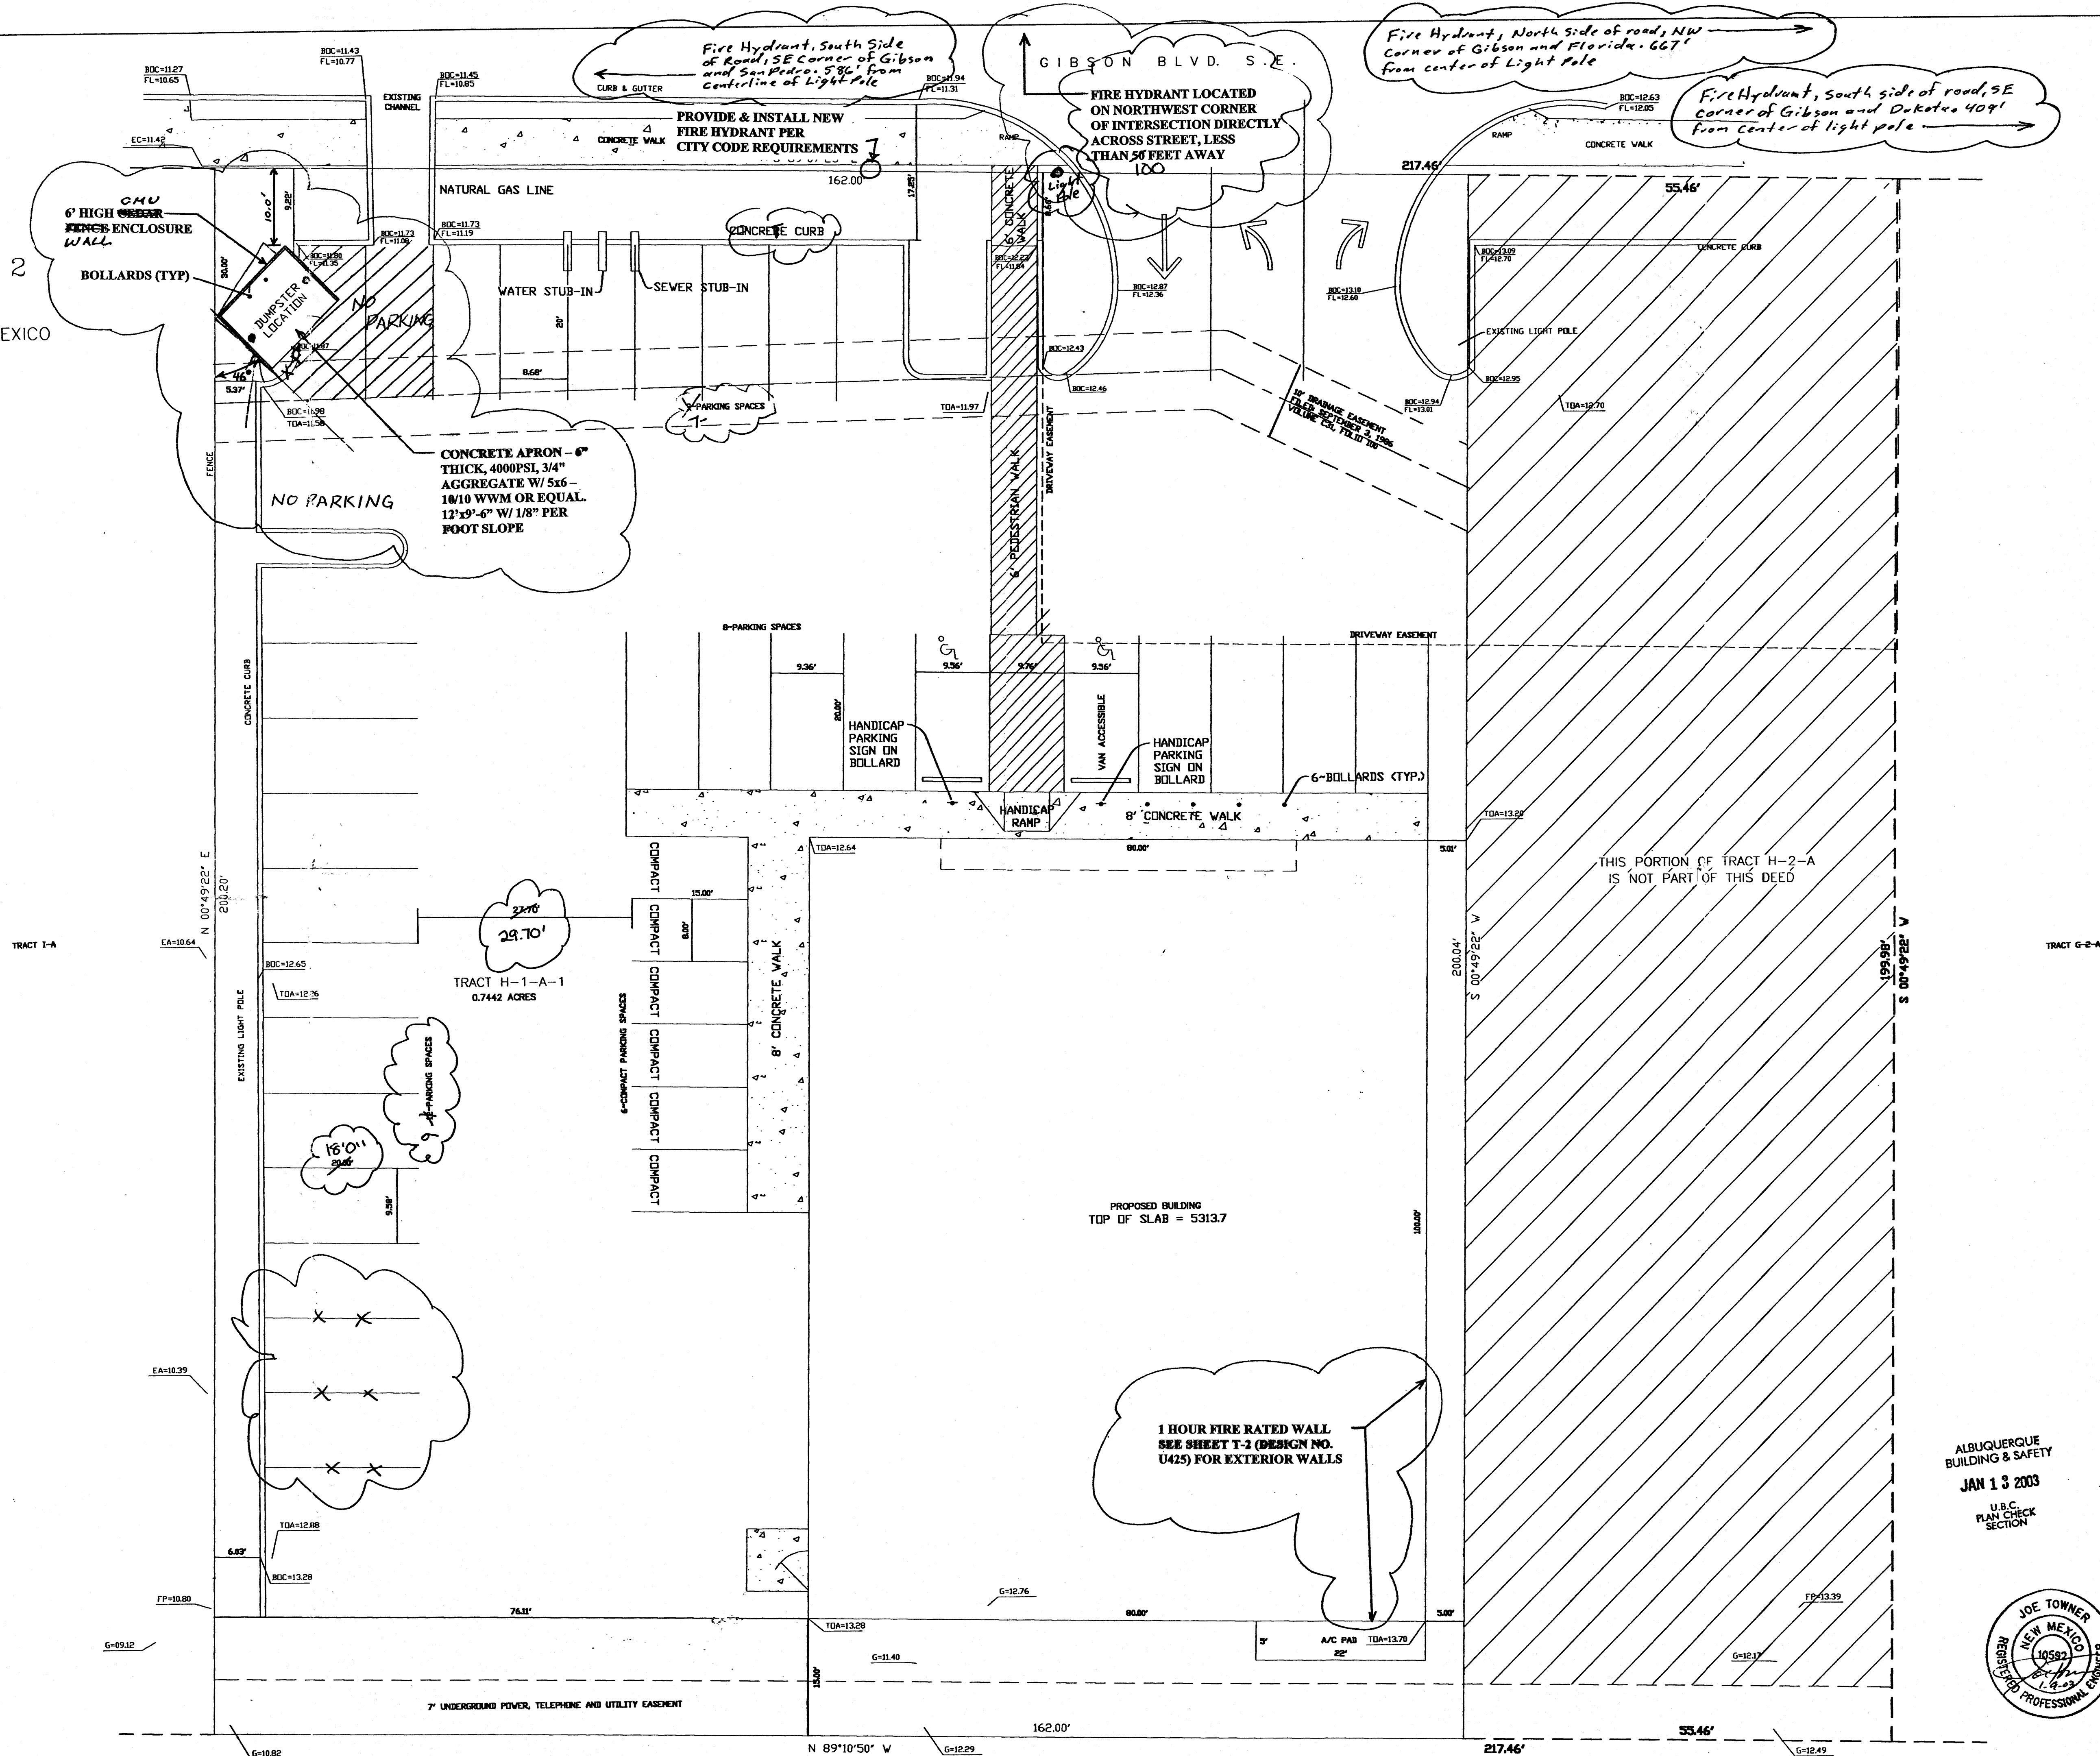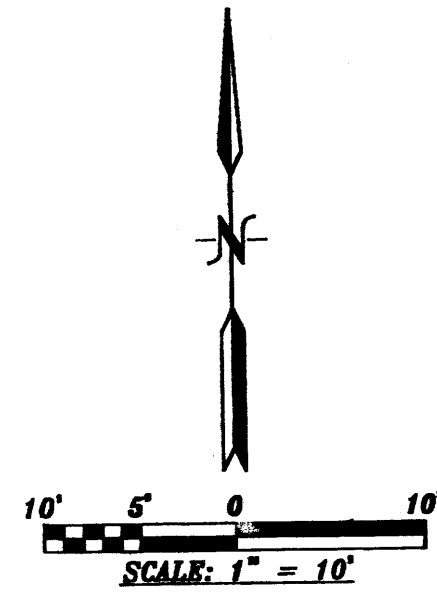

ALBUQUERQUE
BUILDING & SAFETY
JAN 13 2003
U.B.C.
PLAN CHECK
SECTION



TES
TOWNER ENGINEERING SERVICES, INC.
8205 SPAIN N.E. SUITE #205
ALBUQUERQUE, NM 87109
PHONE: (505) 828-1930
FAX: (505) 828-1967


SITE INFORMATION
FAMILY DOLLAR STORE
5450 GIBSON SE
ALB. NEW MEXICO 87104

SHEET TITLE:
CIVIL SITE PLAN

SHEET NO.
C-1

REV	DESCRIPTION	DATE	BY	CHKD	APVLS
3	RE-ISSUED FOR PERMIT	01/09/03	POS	JT	JT
2	RE-ISSUED FOR PERMIT	12/03/02	TLS	JT	JT
1	ISSUED FOR PERMIT	10/23/02	TLS	JT	JT


DRAINAGE PLAN
OF
TRACT H-2-A
SIESTA HILLS
SUBDIVISION No. 2
6000 GIBSON S.E.
CITY OF ALBUQUERQUE
BERNALILLO COUNTY, NEW MEXICO

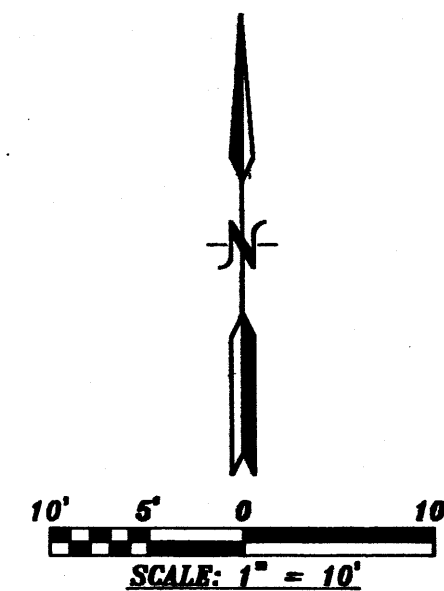

- NOTES:
1. EXISTING CURBS AND ASPHALT WILL REMAIN IN PLACE. CONTRACTOR WILL CUT AND REMOVE ASPHALT AS NECESSARY TO BUILD STRUCTURE AND INSTALL UTILITY LINES.
 2. CONTRACTOR WILL THEN DO A 1" TO 3" OVERLAY CAP OF ASPHALT TO FINISH PARKING AND DRAINAGE AREAS.
 3. ADDITIONAL SOIL COMPACTION, 6" GRAVEL COURSE, AND 3" TO 4" ASPHALT WILL REPLACE AREAS WHERE EXISTING ASPHALT HAS BEEN CUT ADJACENT TO BUILDING AND UTILITY LINES.

LEGEND

- TOA=XXX = TOP OF NEW ASPHALT OVERLAY OR CONCRETE
 = FLOW DIRECTION
 = EXISTING GRADE
 = EXISTING CURB
 = PARKING BUMPERS (CONCRETE)
 = BOLLARDS
 = BREAK LINE

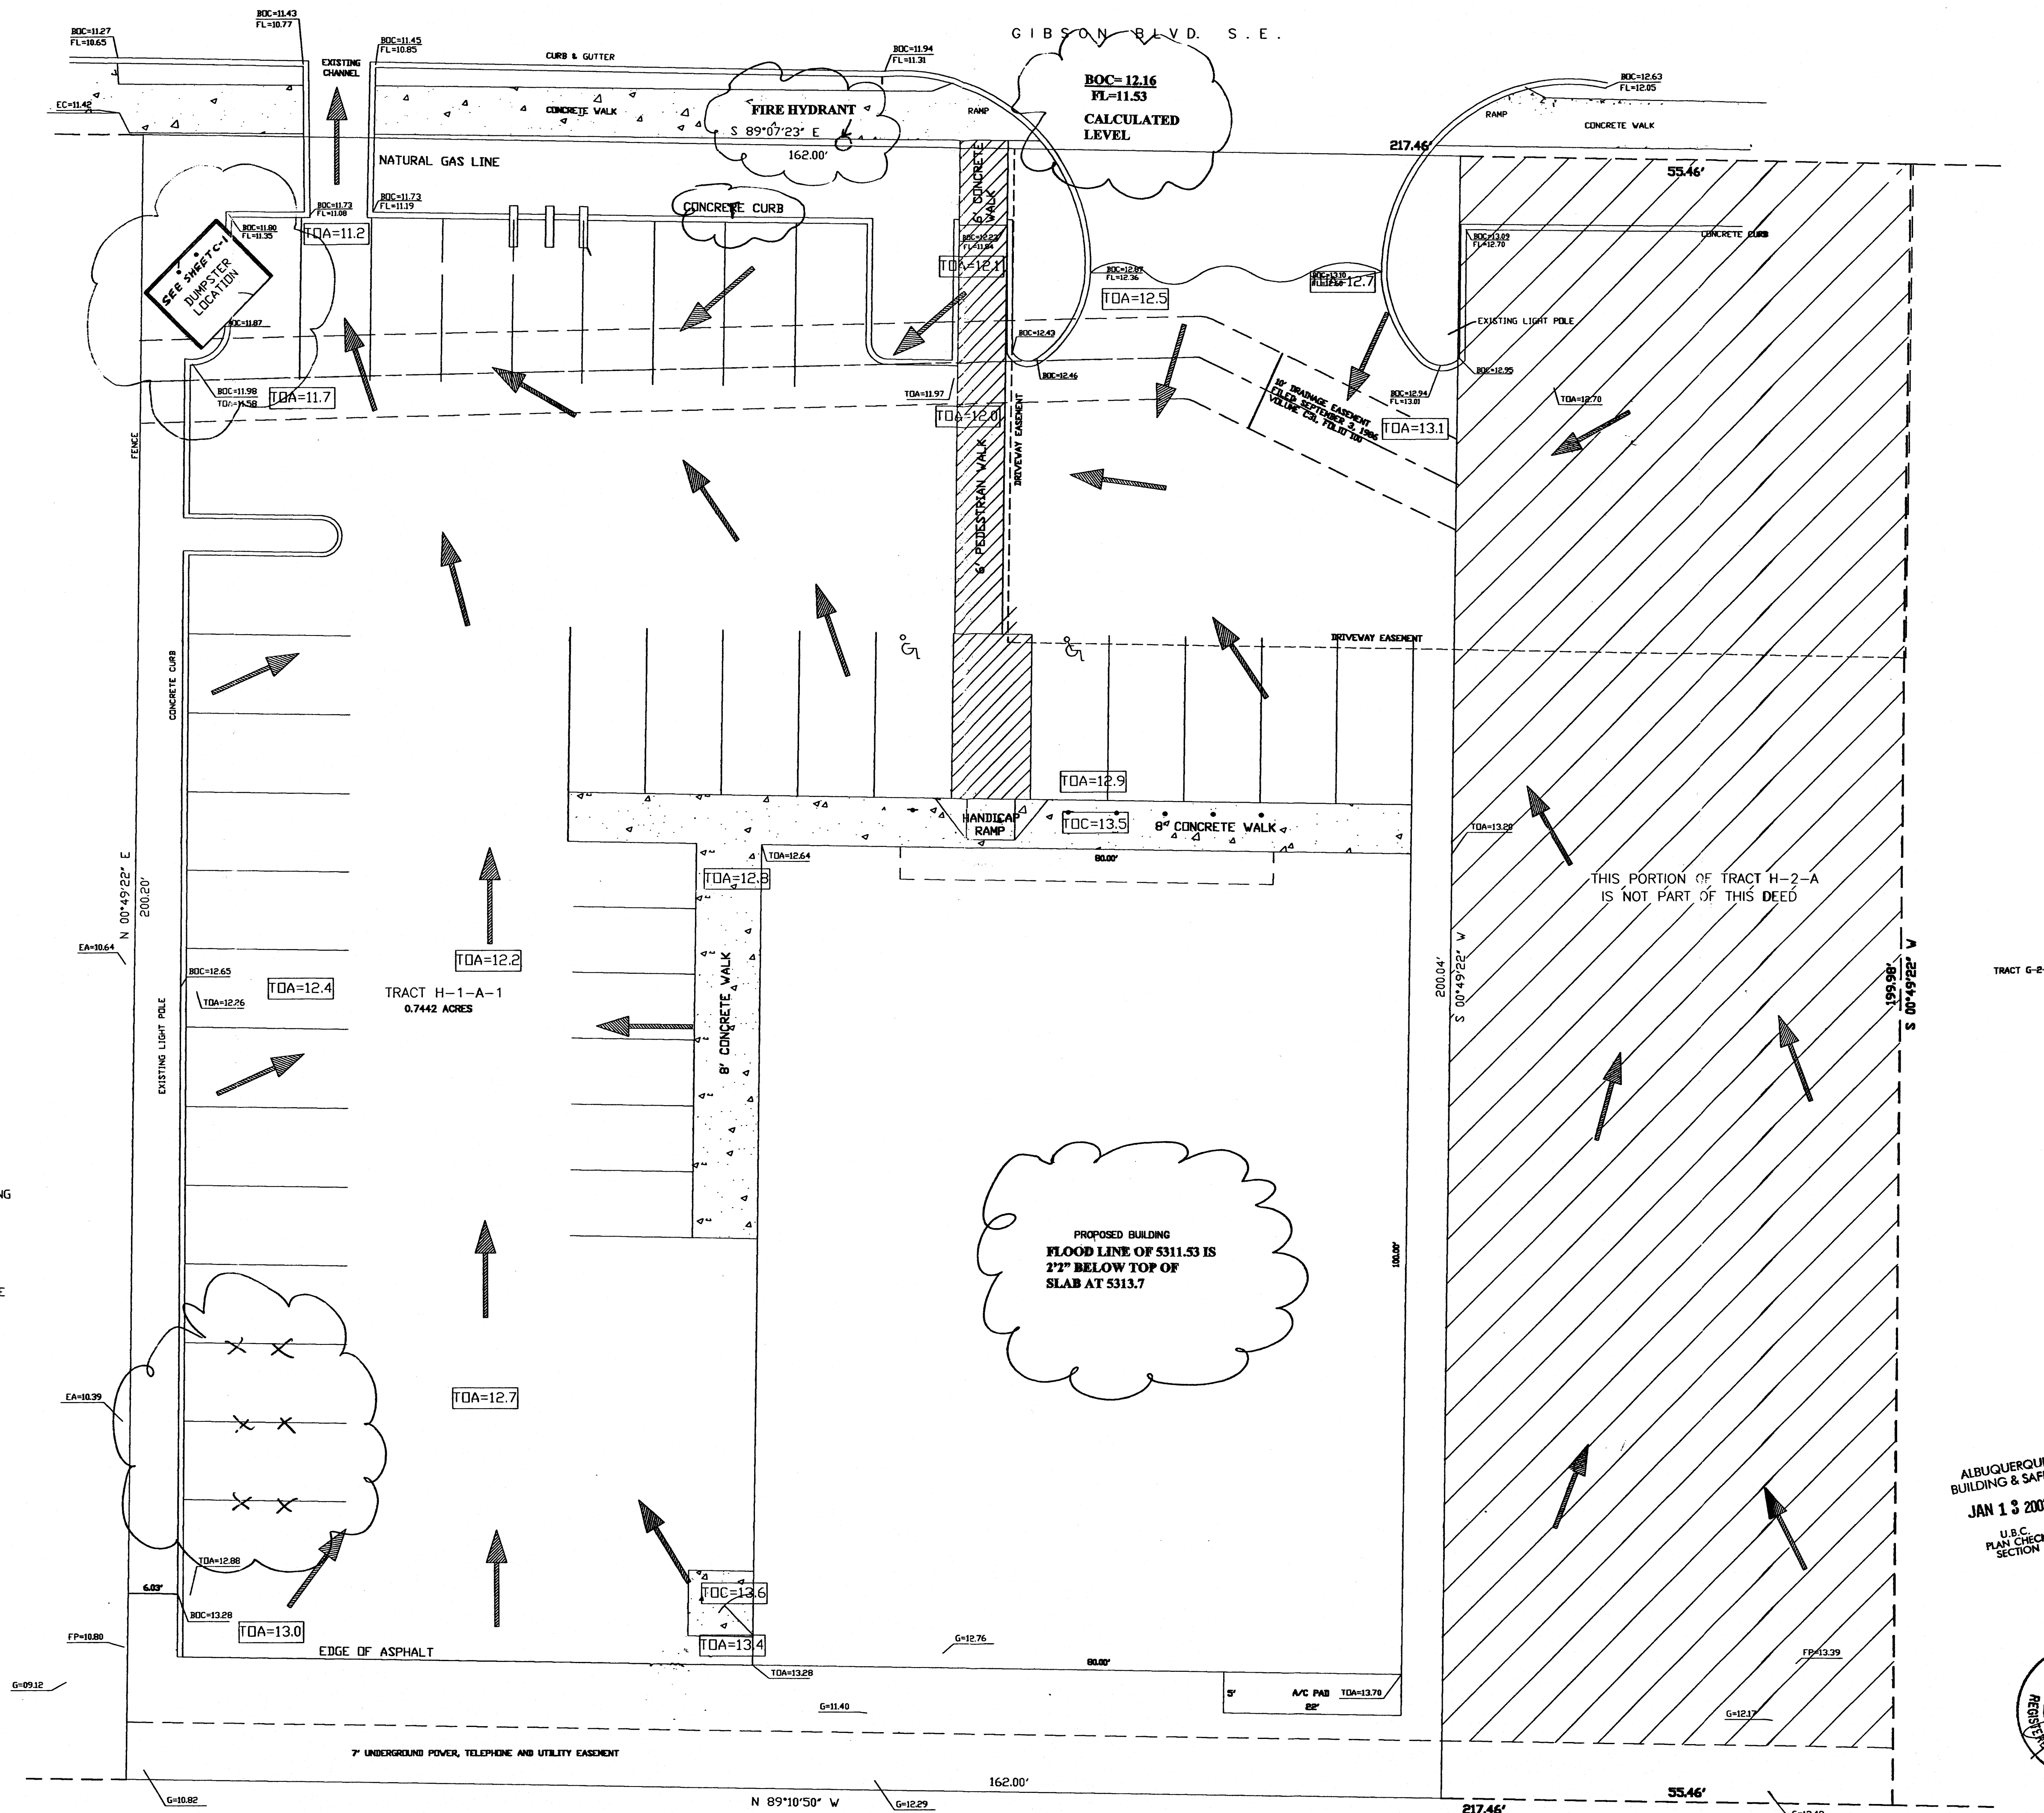

ALBUQUERQUE
BUILDING & SAFETY
JAN 13 2003
U.B.C.
PLAN CHECK
SECTION



TES
TOWER ENGINEERING SERVICES, INC.
8205 SPAIN N.E. SUITE #205
ALBUQUERQUE, NM 87109
PHONE: (505) 828-1930
FAX: (505) 828-1967

DESIGN TYPE
80'x100' BLDG
MTL PANEL FACIA
SPLIT FACE CMU FRONT
MTL PANEL EXT WALLS



SITE INFORMATION
FAMILY DOLLAR STORE
2700 GIBSON SE
ALB, NEW MEXICO 87104

SHEET TITLE:
DRAINAGE PLAN
SHEET NO.

C-2

REV	DESCRIPTION	DATE	BY	CHKD	APVLS
3	RE-ISSUED FOR PERMIT	01/09/03	PDS	JT	JT
2	RE-ISSUED FOR PERMIT	12/03/02	TLS	JT	JT
1	ISSUED FOR PERMIT	10/23/02	TLS	JT	JT

SITE PLAN
OF
TRACT H-2-A
SIESTA HILLS
SUBDIVISION No. 2
6000 GIBSON S.E.
CITY OF ALBUQUERQUE
BERNALILLO COUNTY, NEW MEXICO

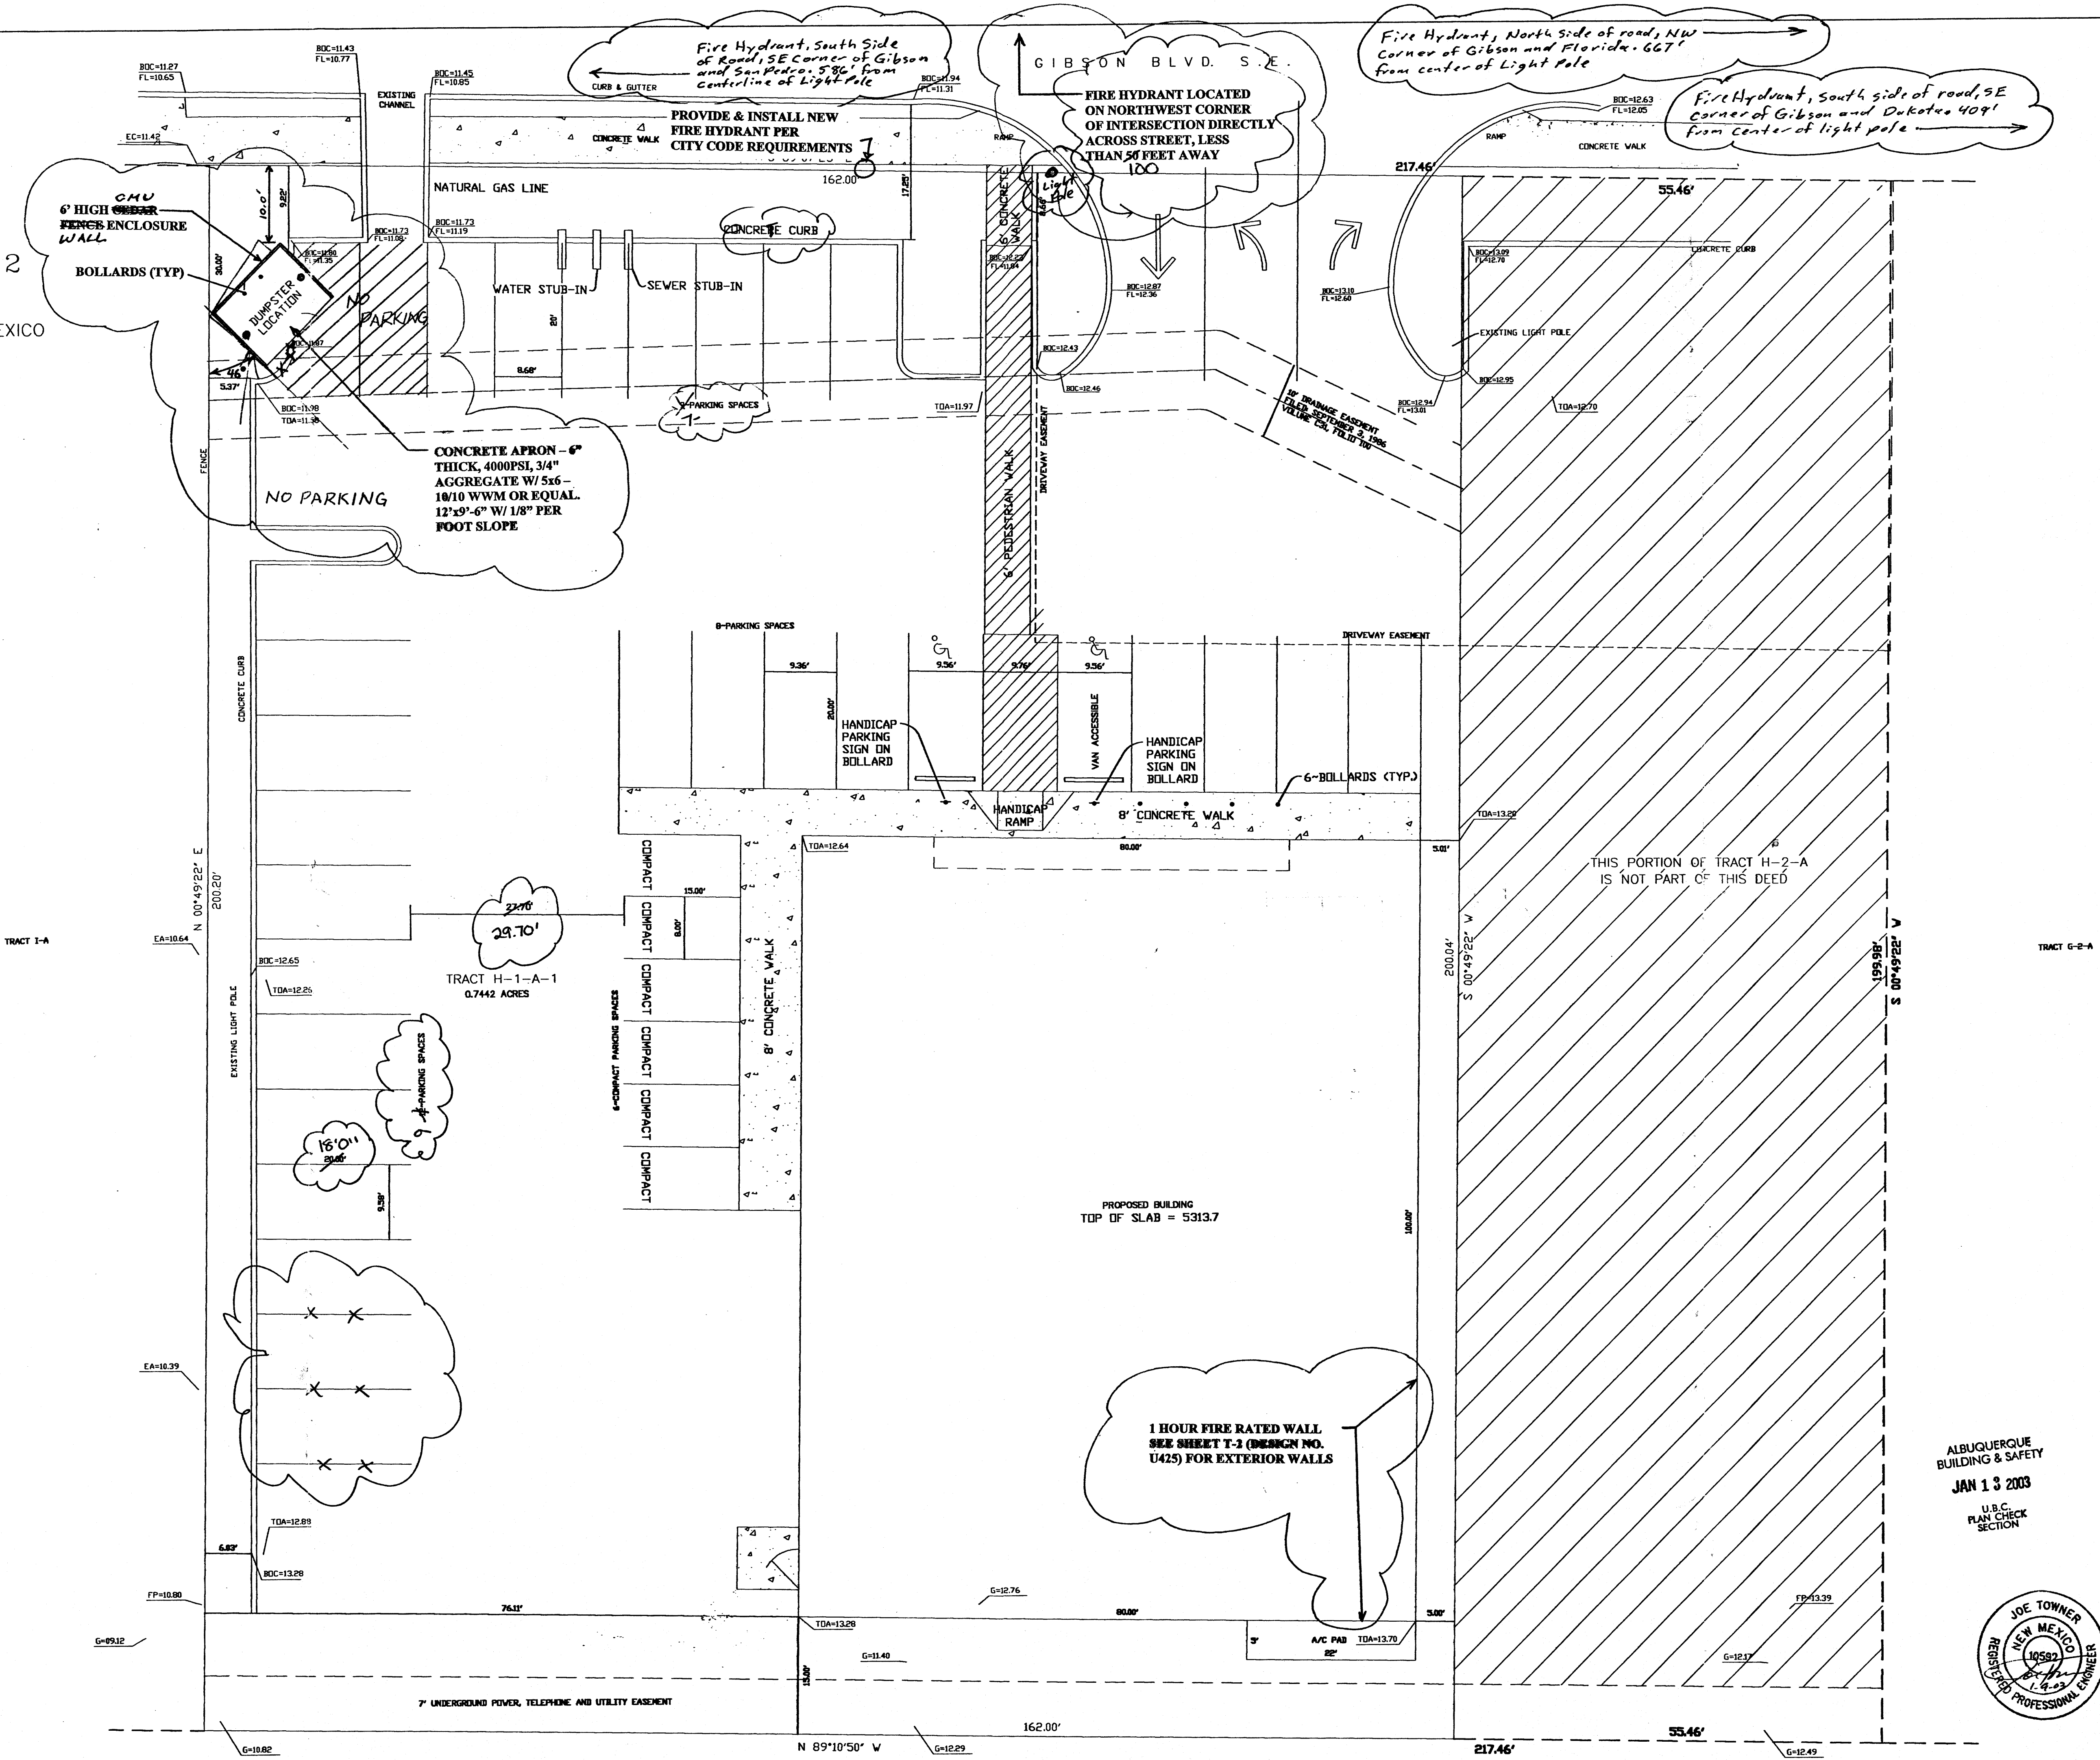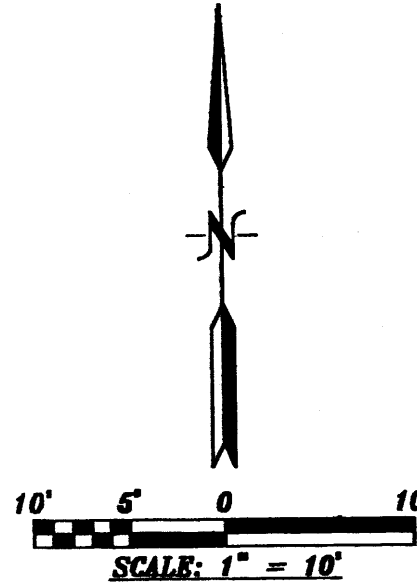

TES
TOWNER ENGINEERING SERVICES, INC.
8205 SPAIN N.E. SUITE #205
ALBUQUERQUE, NM 87109
PHONE: (505) 828-1930
FAX: (505) 828-1967

DESIGN TYPE
80'x100' BLDG
MTL PANEL FACIA
SPLIT FACE CMU FRONT
MTL PANEL EXT WALLS


SITE INFORMATION
FAMILY DOLLAR STORE
6000 GIBSON SE
ALB. NEW MEXICO 87104

SHEET TITLE:
CIVIL SITE PLAN

SHEET NO.
C-1


ALBUQUERQUE
BUILDING & SAFETY
JAN 13 2003

U.S.C.
PLAN CHECK
SECTION

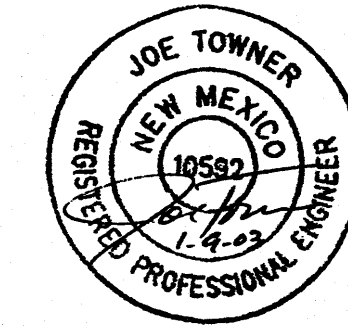


REV	DESCRIPTION	DATE	BY	CHKD	APVLS
3	RE-ISSUED FOR PERMIT	01/09/03	POS	JT	JT
2	RE-ISSUED FOR PERMIT	12/03/02	TLS	JT	JT
1	ISSUED FOR PERMIT	10/23/02	TLS	JT	JT


TRAFFIC PLAN
OF
TRACT H-2-A
SIESTA HILLS
SUBDIVISION No. 2
5950 6000 GIBSON S.E.
CITY OF ALBUQUERQUE
BERNALILLO COUNTY, NEW MEXICO

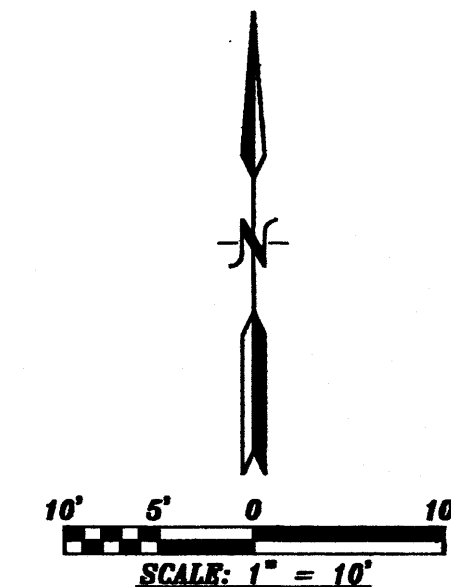


- NOTES:
1. PARKING REQUIRED = 27 SPACES
 2. PARKING FURNISHED = 32 SPACES
 3. EXISTING FENCE WILL BE REMOVED PRIOR TO FINAL INSPECTION OF BUILDING CONSTRUCTION
 4. PARKING BUMPERS =

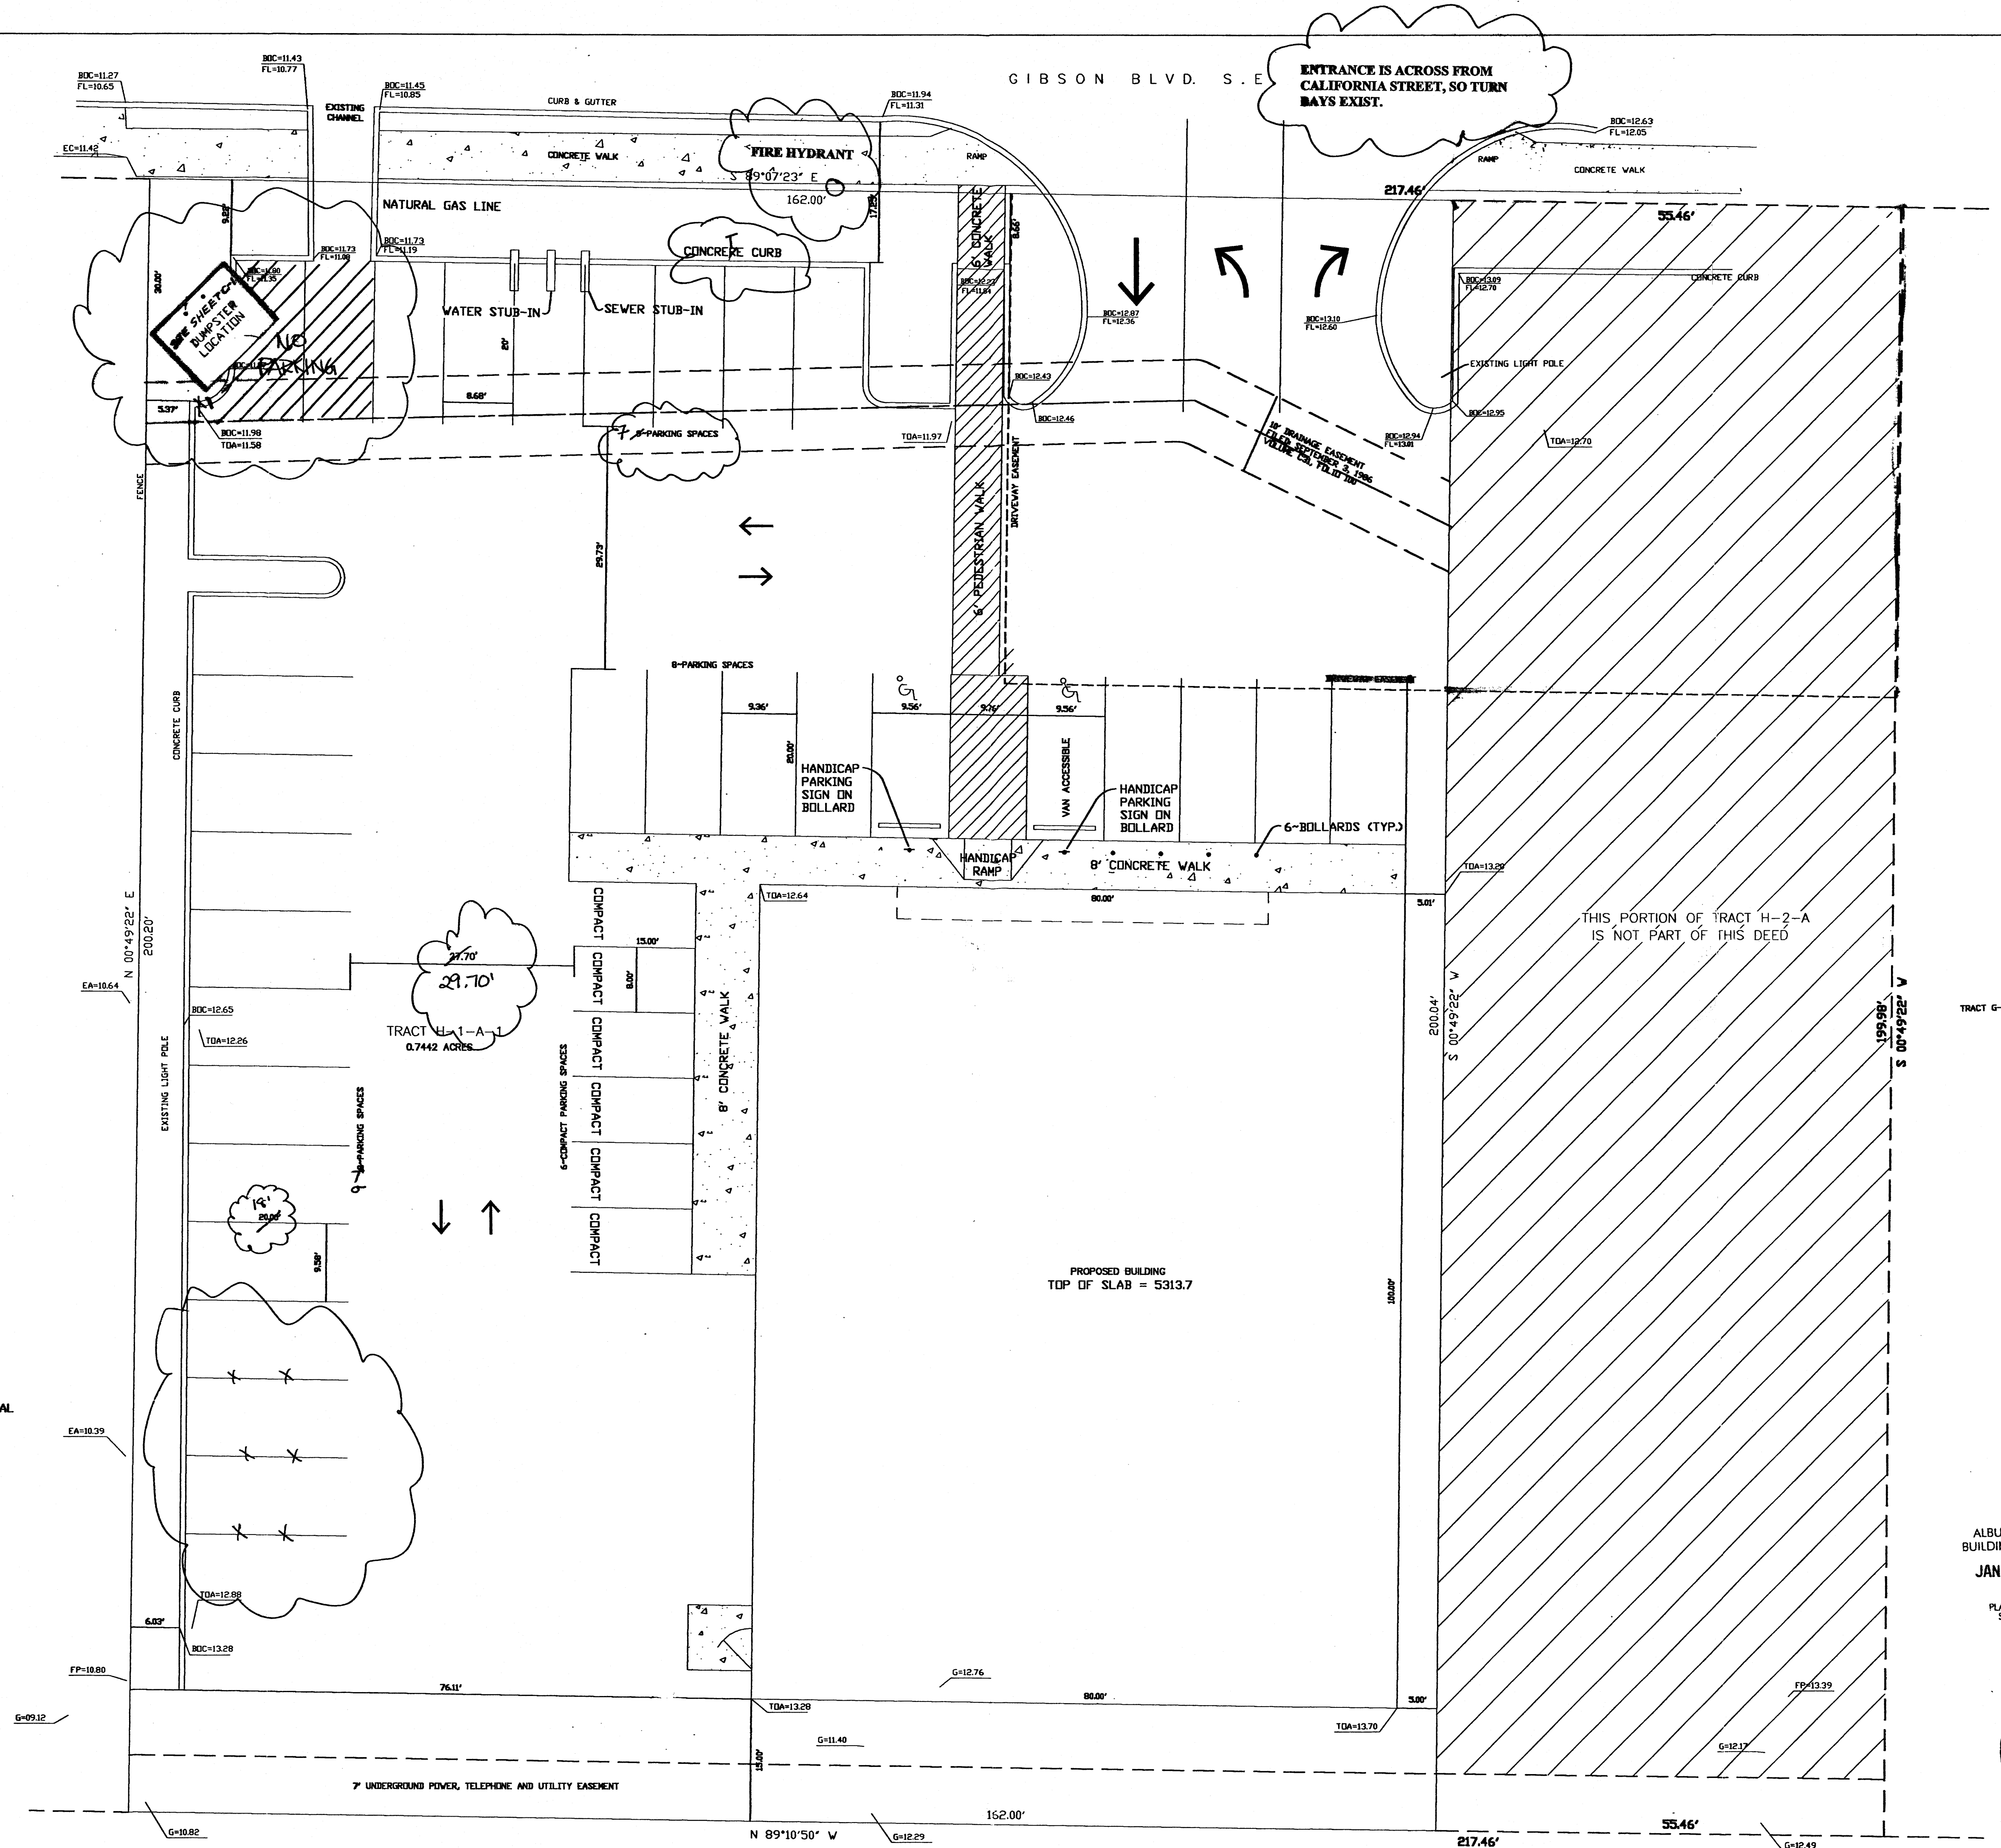

ALBUQUERQUE
BUILDING & SAFETY
JAN 13 2003
U.B.C.
PLAN CHECK
SECTION

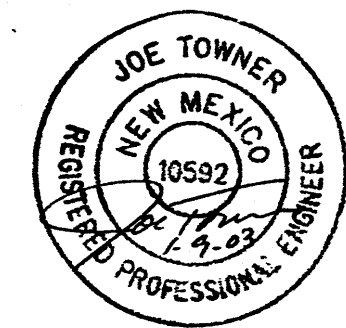

TES TOWER ENGINEERING SERVICES, INC. 8205 SPAIN N.E. SUITE #205 ALBUQUERQUE, NM 87109 PHONE: (505) 828-1930 FAX: (505) 828-1967	DESIGN TYPE 80'x100' BLDG MTL PANEL FACIA SPLIT FACE CMU FRONT MTL PANEL EXT WALLS	SITE INFORMATION FAMILY DOLLAR STORE 5950 GIBSON SE ALB, NEW MEXICO 87104	SHEET TITLE: TRAFFIC PLAN SHEET NO. C-4
REV 3 RE-ISSUED FOR PERMIT 01/09/03 DATE BY CHKD APVLS			

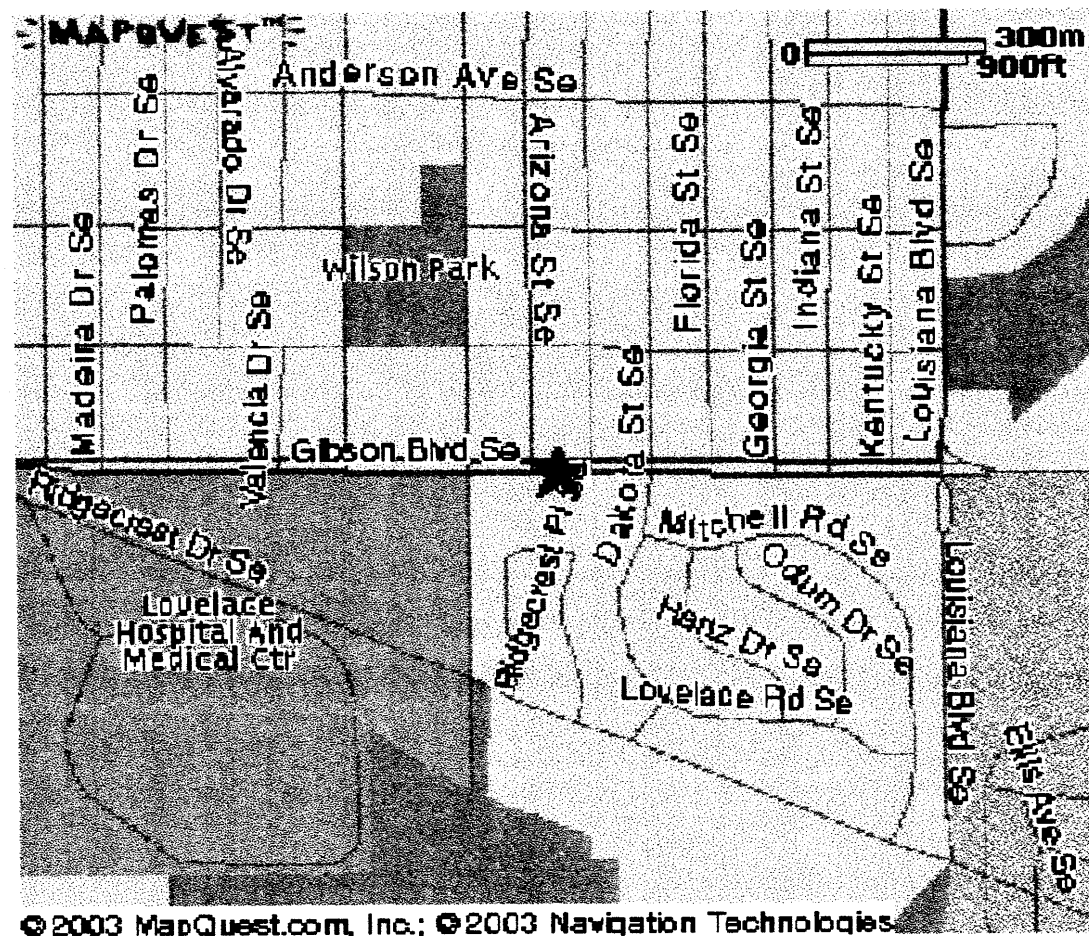

© 2003 MapQuest.com, Inc.; © 2003 Navigation Technologies

PROJECT INFORMATION:





PROJECT LOCATION:
5950 GIBSON SE
ALBUQUERQUE, NM 87104

LEGAL DESCRIPTION:
PORTION OF TRACT 80, H-2-A-1
SIESTA HILLS SUBDIVISION #2
BERNALILLO COUNTY, NM
ZONING MAP M-18

PROJECT DESCRIPTION:
FREE STANDING FAMILY DOLLAR RETAIL STORE

BUILDING DATA:
BUILDING AREA (SQ. FT.): 8000 GROSS
BUILDING HEIGHT: 1 STORY
ALLOWABLE AREA (SQ. FT.): 9000 GROSS TABLE 503 M & S-1

SITE PLAN OF
TRACT H-2-A
SIESTA HILLS
SUBDIVISION No. 2
5950 GIBSON S.E.
CITY OF ALBUQUERQUE
BERNALILLO COUNTY, NEW MEXICO

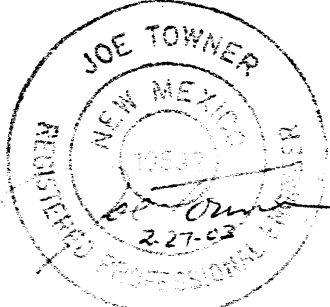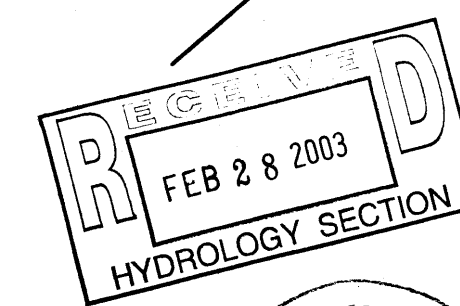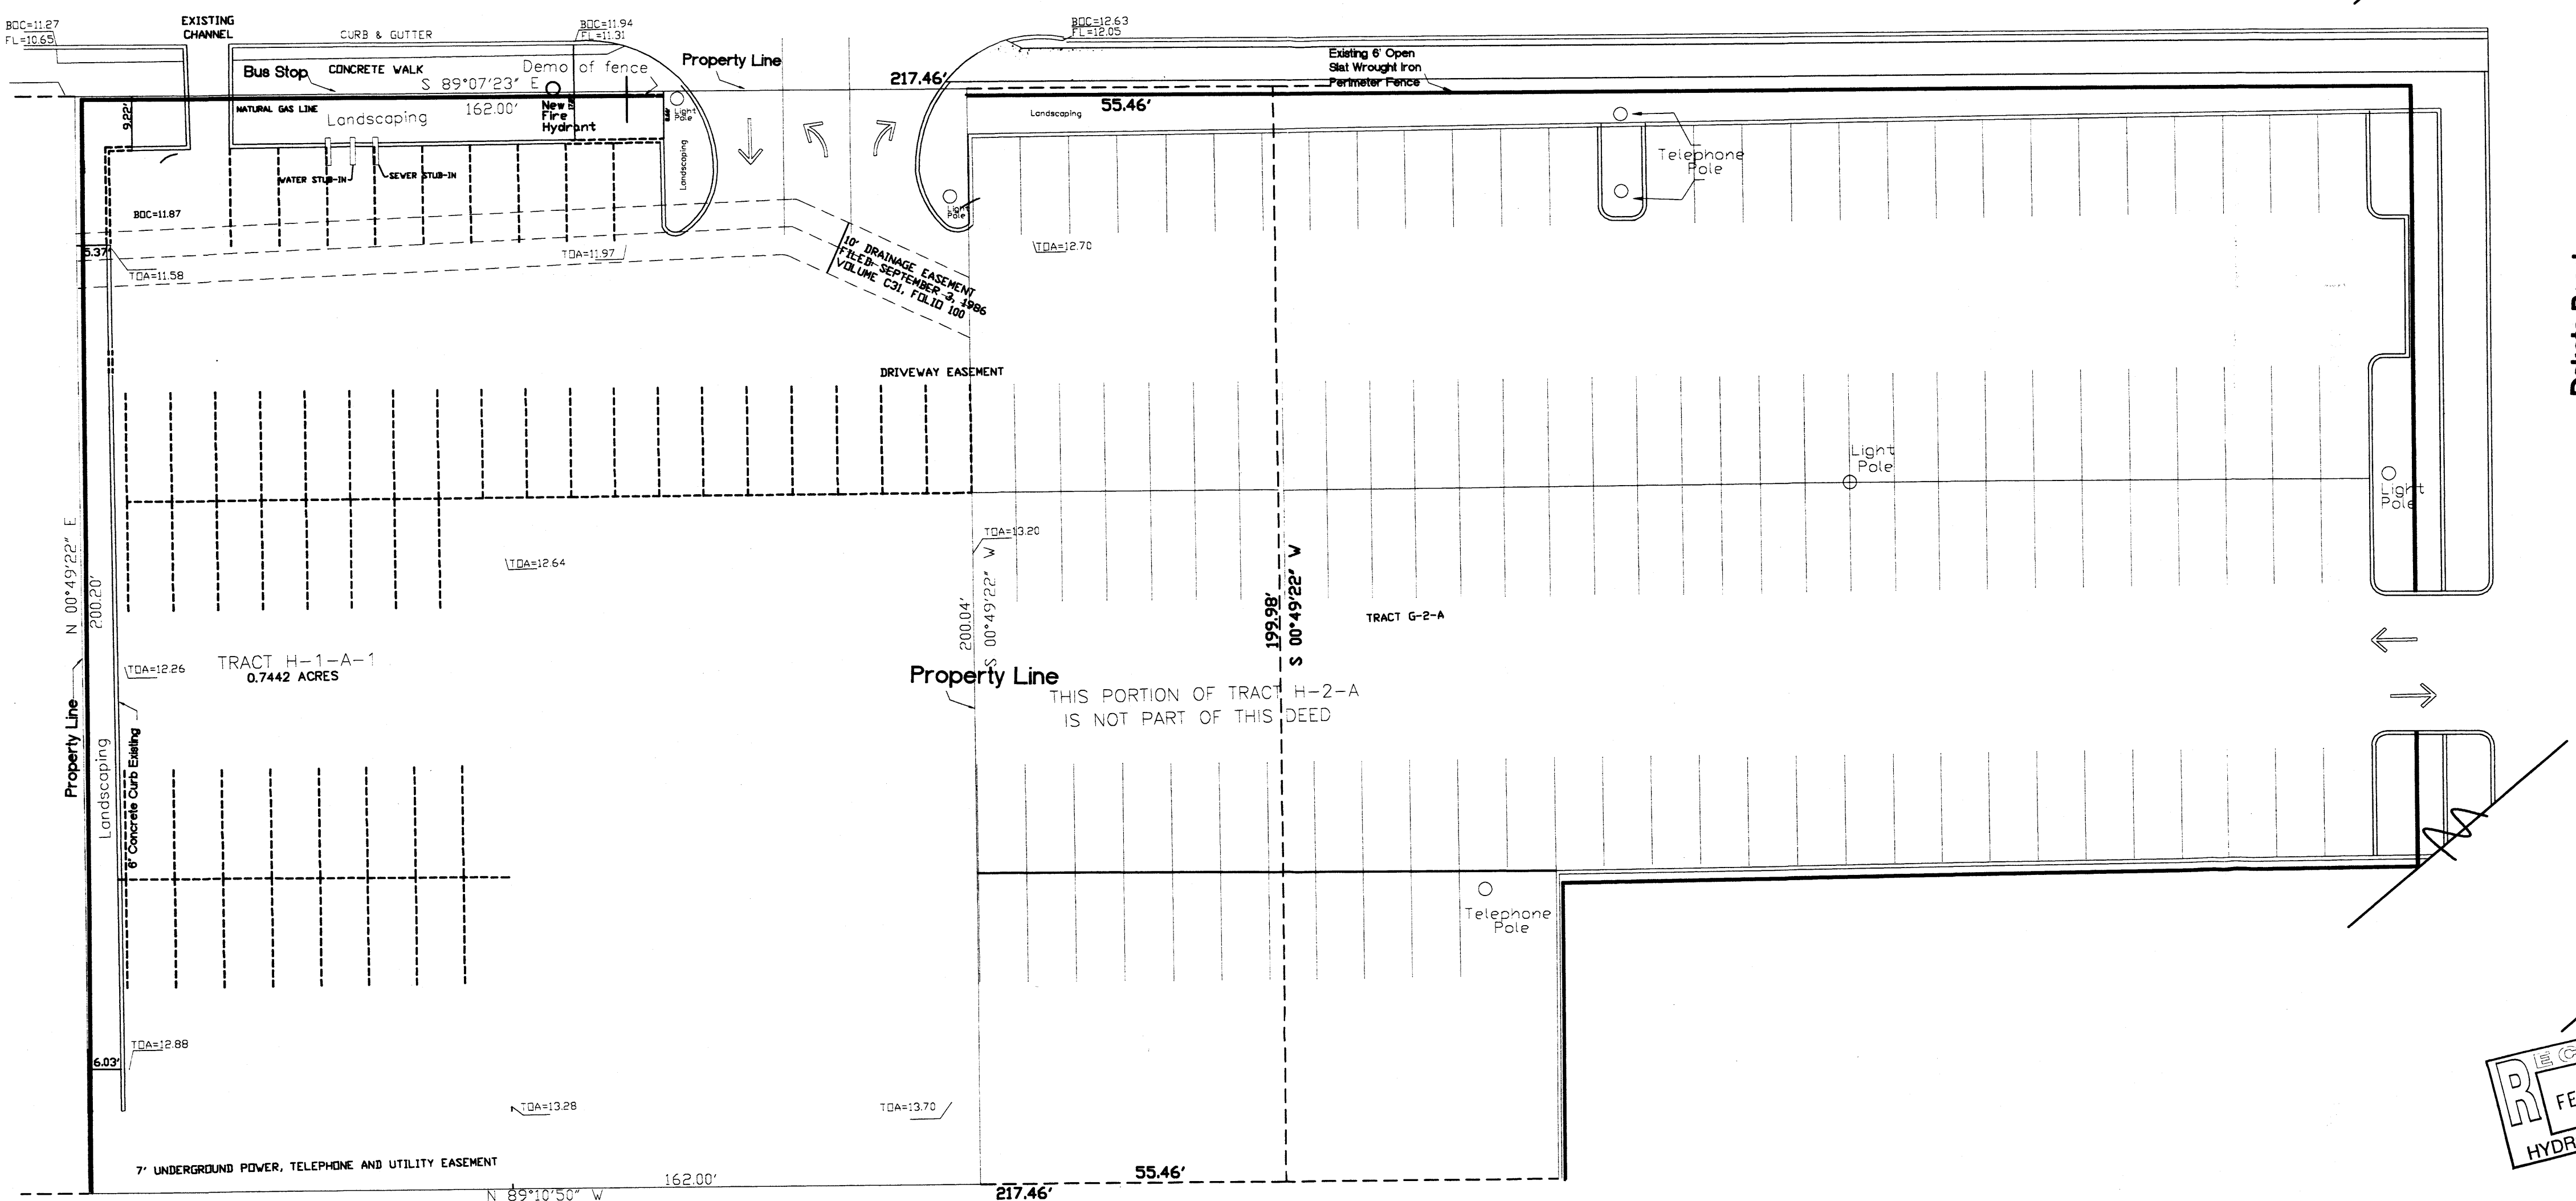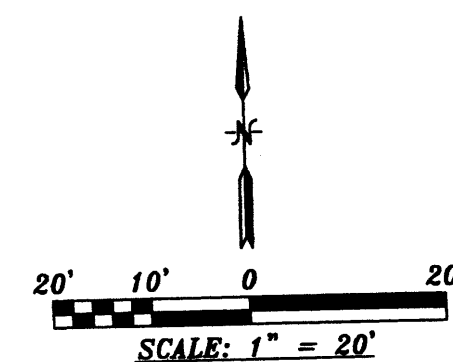

TRAFFIC CIRCULATION LAYOUT
APPROVED
Signed: [Signature] Date: 2-28-03

TES
TOWNER ENGINEERING SERVICES, INC.
8205 SPAIN N.E. SUITE #205
ALBUQUERQUE, NM 87109
PHONE: (505) 828-1930
FAX: (505) 828-1967


DESIGN TYPE
80'x100' BLDG
MTL PANEL FACIA
SPLIT FACE CMU FRONT
MTL PANEL EXT WALLS

SITE INFORMATION
FAMILY DOLLAR STORE
6000 GIBSON SE
ALB, NEW MEXICO 87104

SHEET TITLE:
EXISTING CIVIL SITE PLAN

SHEET NO.


C-4A

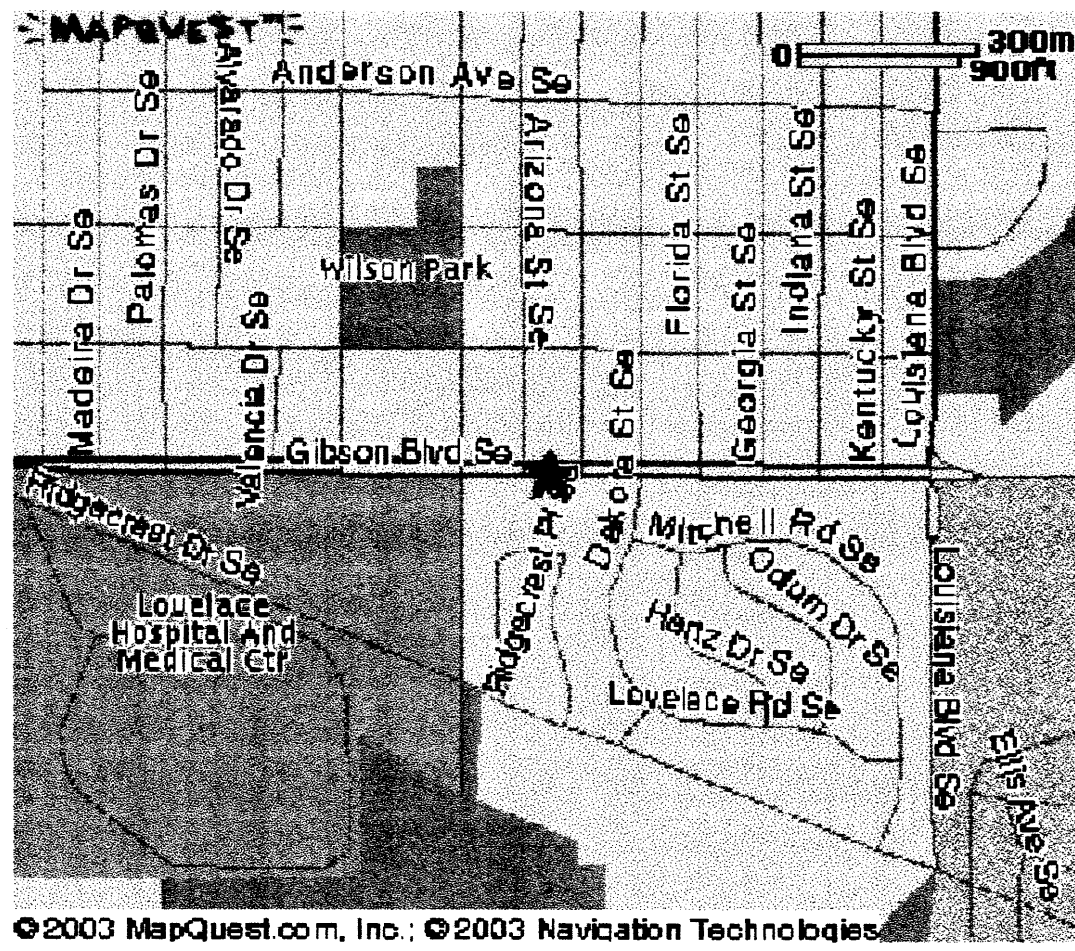


© 2003 MapQuest.com, Inc.; © 2003 Navigation Technologies

PROJECT INFORMATION :			
PROJECT LOCATION:			
5950 GIBSON, SE			
ALBUQUERQUE, NM 87104			
LEGAL DESCRIPTION:			
PORTION OF TRACT 90, H-2-A-1			
SIESTA HILLS SUBDIVISION #2			
BERNALILLO COUNTY, NM			
ZONING MAP M-18			
PROJECT DESCRIPTION:			
FREE STANDING FAMILY DOLLAR RETAIL STORE			
BUILDING DATA:			
BUILDING AREA (SQ. FT.):	8000 GROSS		
BUILDING HEIGHT:	1 STORY		
ALLOWABLE AREA (SQ. FT.):	9000 GROSS	TABLE 503	M & S-1

SITE PLAN
OF
TRACT H-2-A
SIESTA HILLS
SUBDIVISION No. 2
5950 GIBSON S.E.
CITY OF ALBUQUERQUE
BERNALILLO COUNTY, NEW MEXICO

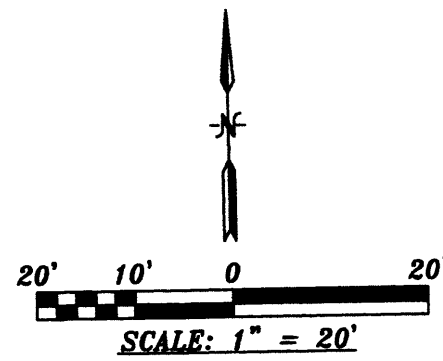

- NOTES
1. PARKING REQUIRED - 27 SPACES
 2. PARKING FURNISHED - 32 SPACES
 3. EXISTING FENCE WILL BE REMOVED PRIOR TO FINAL INSPECTION OF BUILDING CONSTRUCTION
 4. PARKING BUMPERS -

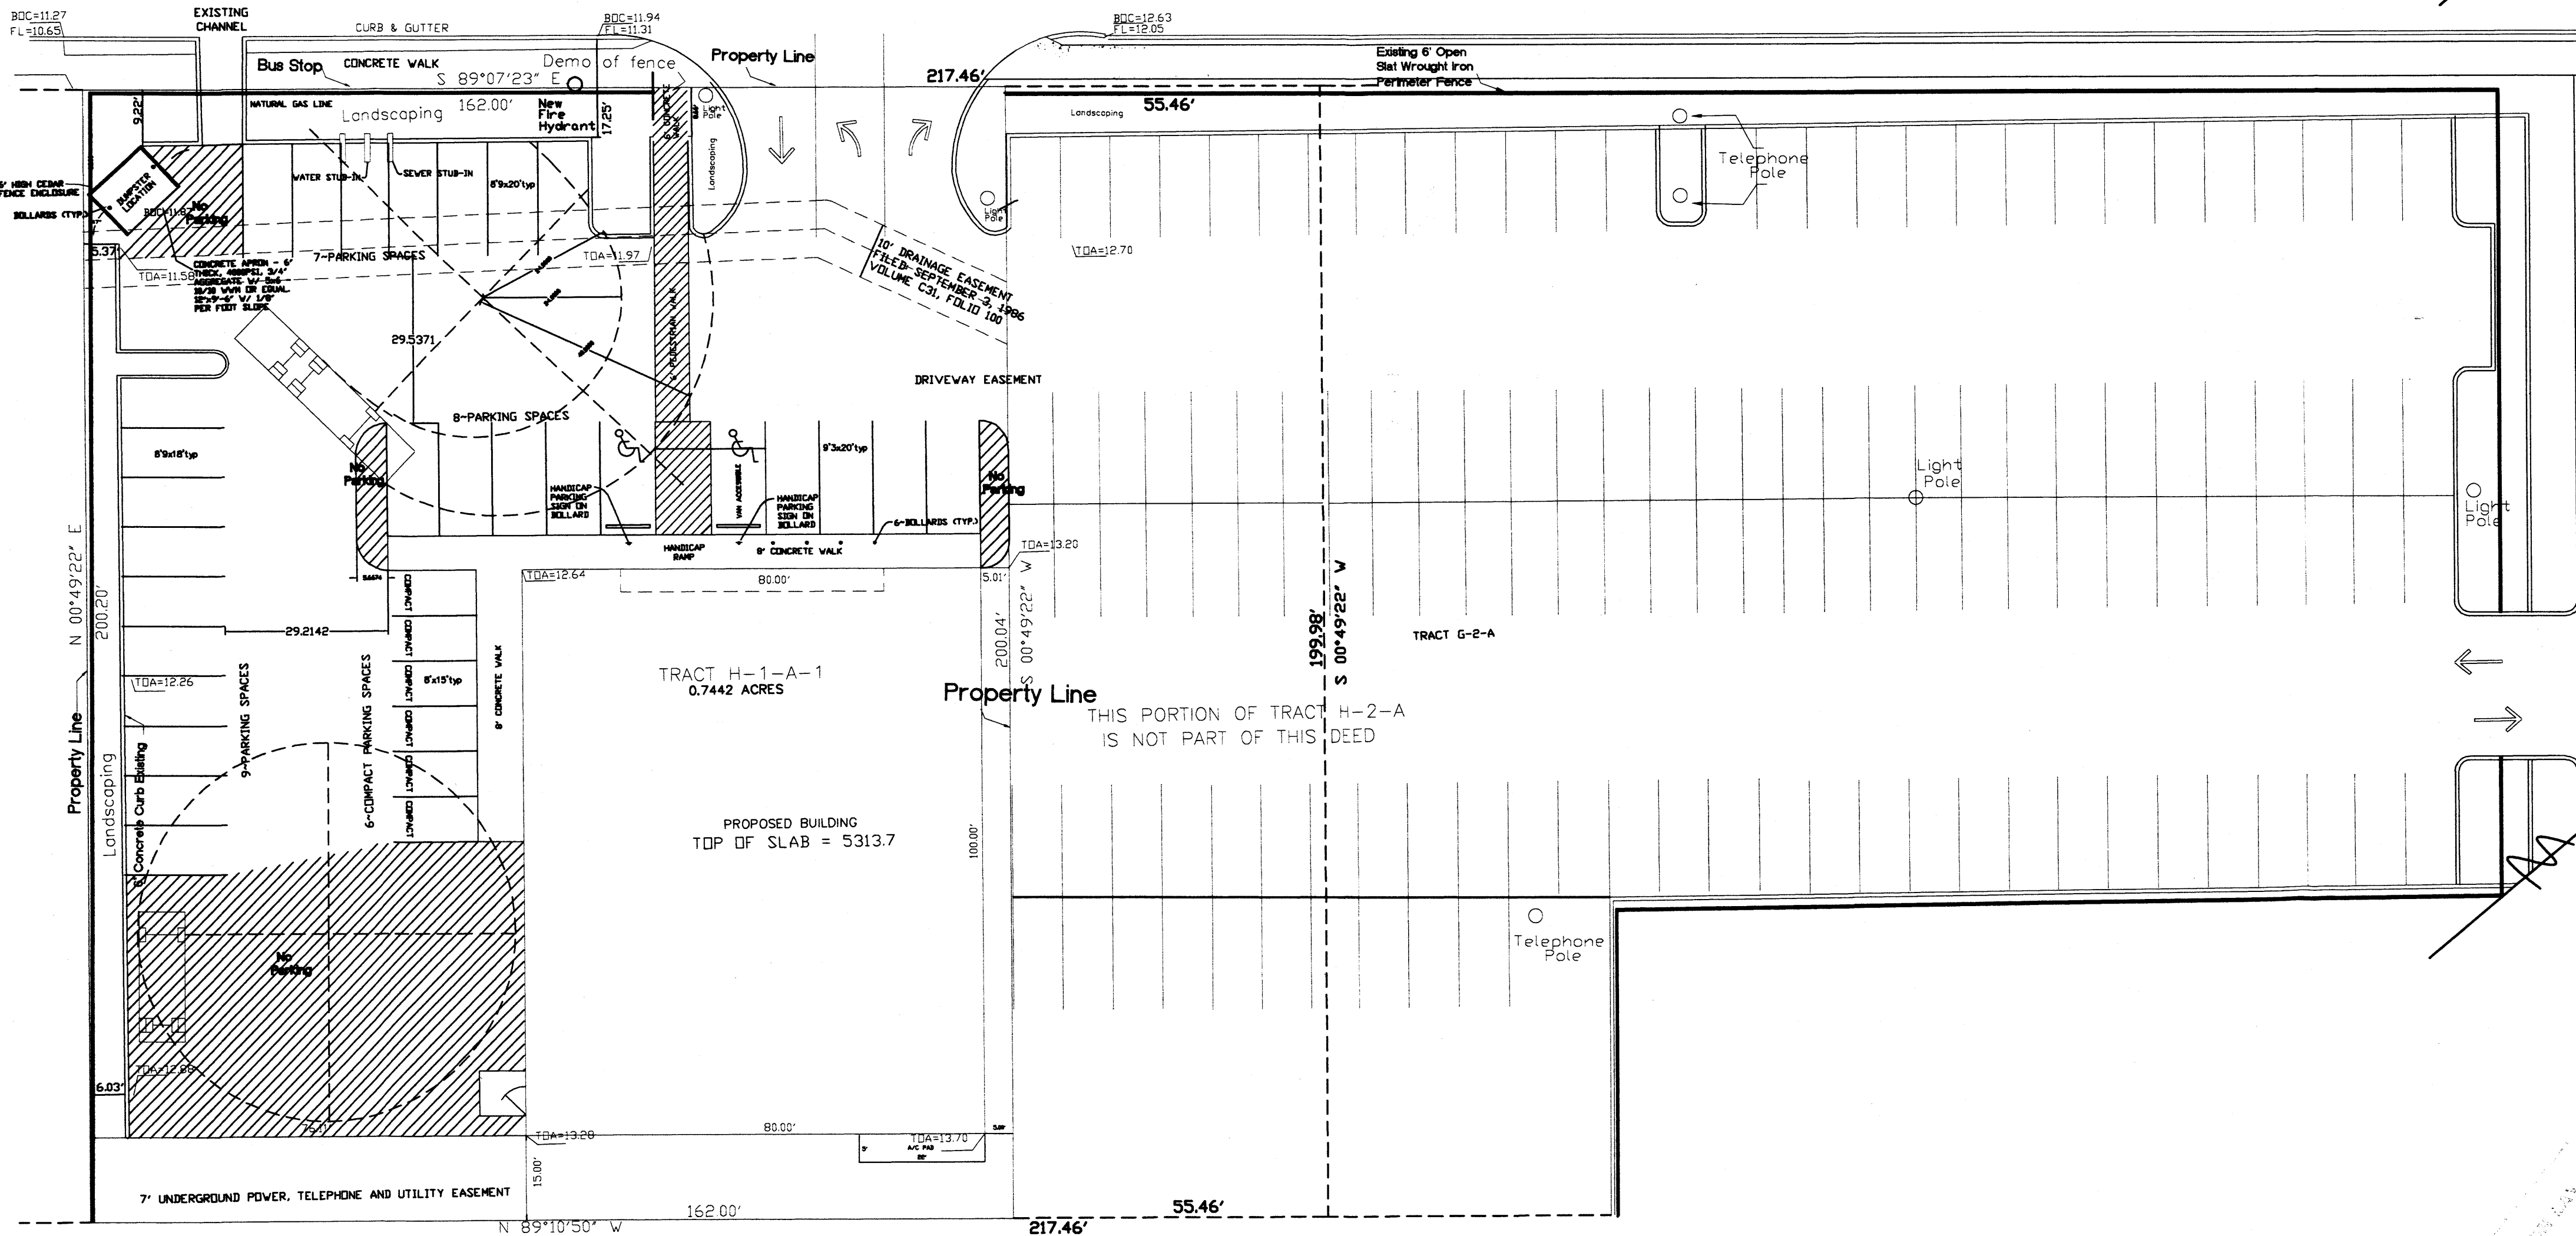

Dakota Road

California Road

Gibson Blvd

TRAFFIC ENGINEERING SERVICES, INC.

APPROVED

7-27-03

Signed

NEW MEXICO

REGISTERED PROFESSIONAL ENGINEER

2-27-93

JOE TOWNER

HYDROLOGY SECTION

FEB 28 2003


TES
TOWNER ENGINEERING SERVICES, INC.
8205 SPAIN N.E. SUITE #205
ALBUQUERQUE, NM 87109
PHONE: (505) 828-1930
FAX: (505) 828-1967

DESIGN TYPE	SITE INFORMATION	SHEET TITLE:	SHEET NO.
80'x100' BLDG MTL PANEL FACIA SPLIT FACE CMU FRONT MTL PANEL EXT WALLS	FAMILY DOLLAR STORE 6000 GIBSON SE ALB, NEW MEXICO 87104	EXISTING CIVIL SITE PLAN REVISED	C-4B

REV	DESCRIPTION	DATE	BY	CHKD	APVLS
4	RE-ISSUED FOR PERMIT	02/27/03	KSD		
3	RE-ISSUED FOR PERMIT	01/09/03	PDS		
2	RE-ISSUED FOR PERMIT	12/03/02	TLS		
1	ISSUED FOR PERMIT	10/23/02	JT		

- 1: EXISTING CURBS AND ASPHALT WILL REMAIN IN PLACE. CONTRACTOR WILL CUT AND REMOVE ASPHALT AS NECESSARY TO BUILD STRUCTURE AND INSTALL UTILITY LINES.
- 2: CONTRACTOR WILL THEN DO A 1" TO 3" OVERLAY CAP OF ASPHALT TO FINISH PARKING AND DRAINAGE AREAS.
- 3: ADDITIONAL SOIL COMPACTION, 6" GRAVEL COURSE, AND 2" TO 4" ASPHALT WILL REPLACE AREAS WHERE EXISTING ASPHALT HAS BEEN CUT ADJACENT TO BUILDING AND UTILITY LINES.

	= TOP OF NEW ASPHALT OVERLAY OR CONCRETE
	= FLOW DIRECTION
	= EXISTING GRADE
	= EXISTING CURB
	= PARKING BUMPERS (CONCRETE)
	= BOLLARDS
	= BREAK LINE

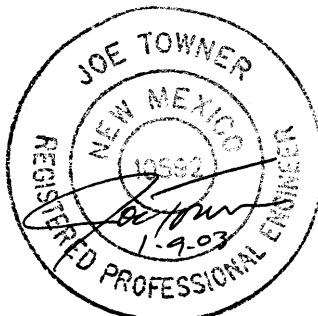


TES
TOWNER ENGINEERING SERVICES, INC.
8205 SPAIN N.E. SUITE #205
ALBUQUERQUE, NM 87109
PHONE: (505) 828-1930
FAX: (505) 828-1967

SHEET TITLE:
DRAINAGE PLAN

SHEET NO.
C-2

DRAINAGE PLAN
OF
TRACT H-2-A
SIESTA HILLS
SUBDIVISION No. 2
6000 GIBSON S.E.
CITY OF ALBUQUERQUE
BERNALILLO COUNTY, NEW MEXICO

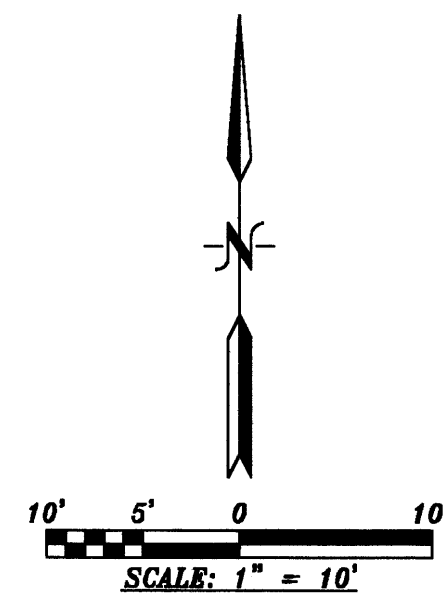


NOTES:

- 1: EXISTING CURBS AND ASPHALT WILL REMAIN IN PLACE. CONTRACTOR WILL CUT AND REMOVE ASPHALT AS NECESSARY TO BUILD STRUCTURE AND INSTALL UTILITY LINES.
- 2: CONTRACTOR WILL THEN DO A 1" TO 3" OVERLAY CAP OF ASPHALT TO FINISH PARKING AND DRAINAGE AREAS.
- 3: ADDITIONAL SOIL COMPACTION, 6" GRAVEL COURSE, AND 3" TO 4" ASPHALT WILL REPLACE AREAS WHERE EXISTING ASPHALT HAS BEEN CUT ADJACENT TO BUILDING AND UTILITY LINES.

LEGEND

- TDA=XX.X = TOP OF NEW ASPHALT OVERLAY OR CONCRETE
- = FLOW DIRECTION
- xxxx = EXISTING GRADE
- = EXISTING CURB
- = PARKING BUMPERS (CONCRETE)
- • • = BOLLARDS
- ~ = BREAK LINE

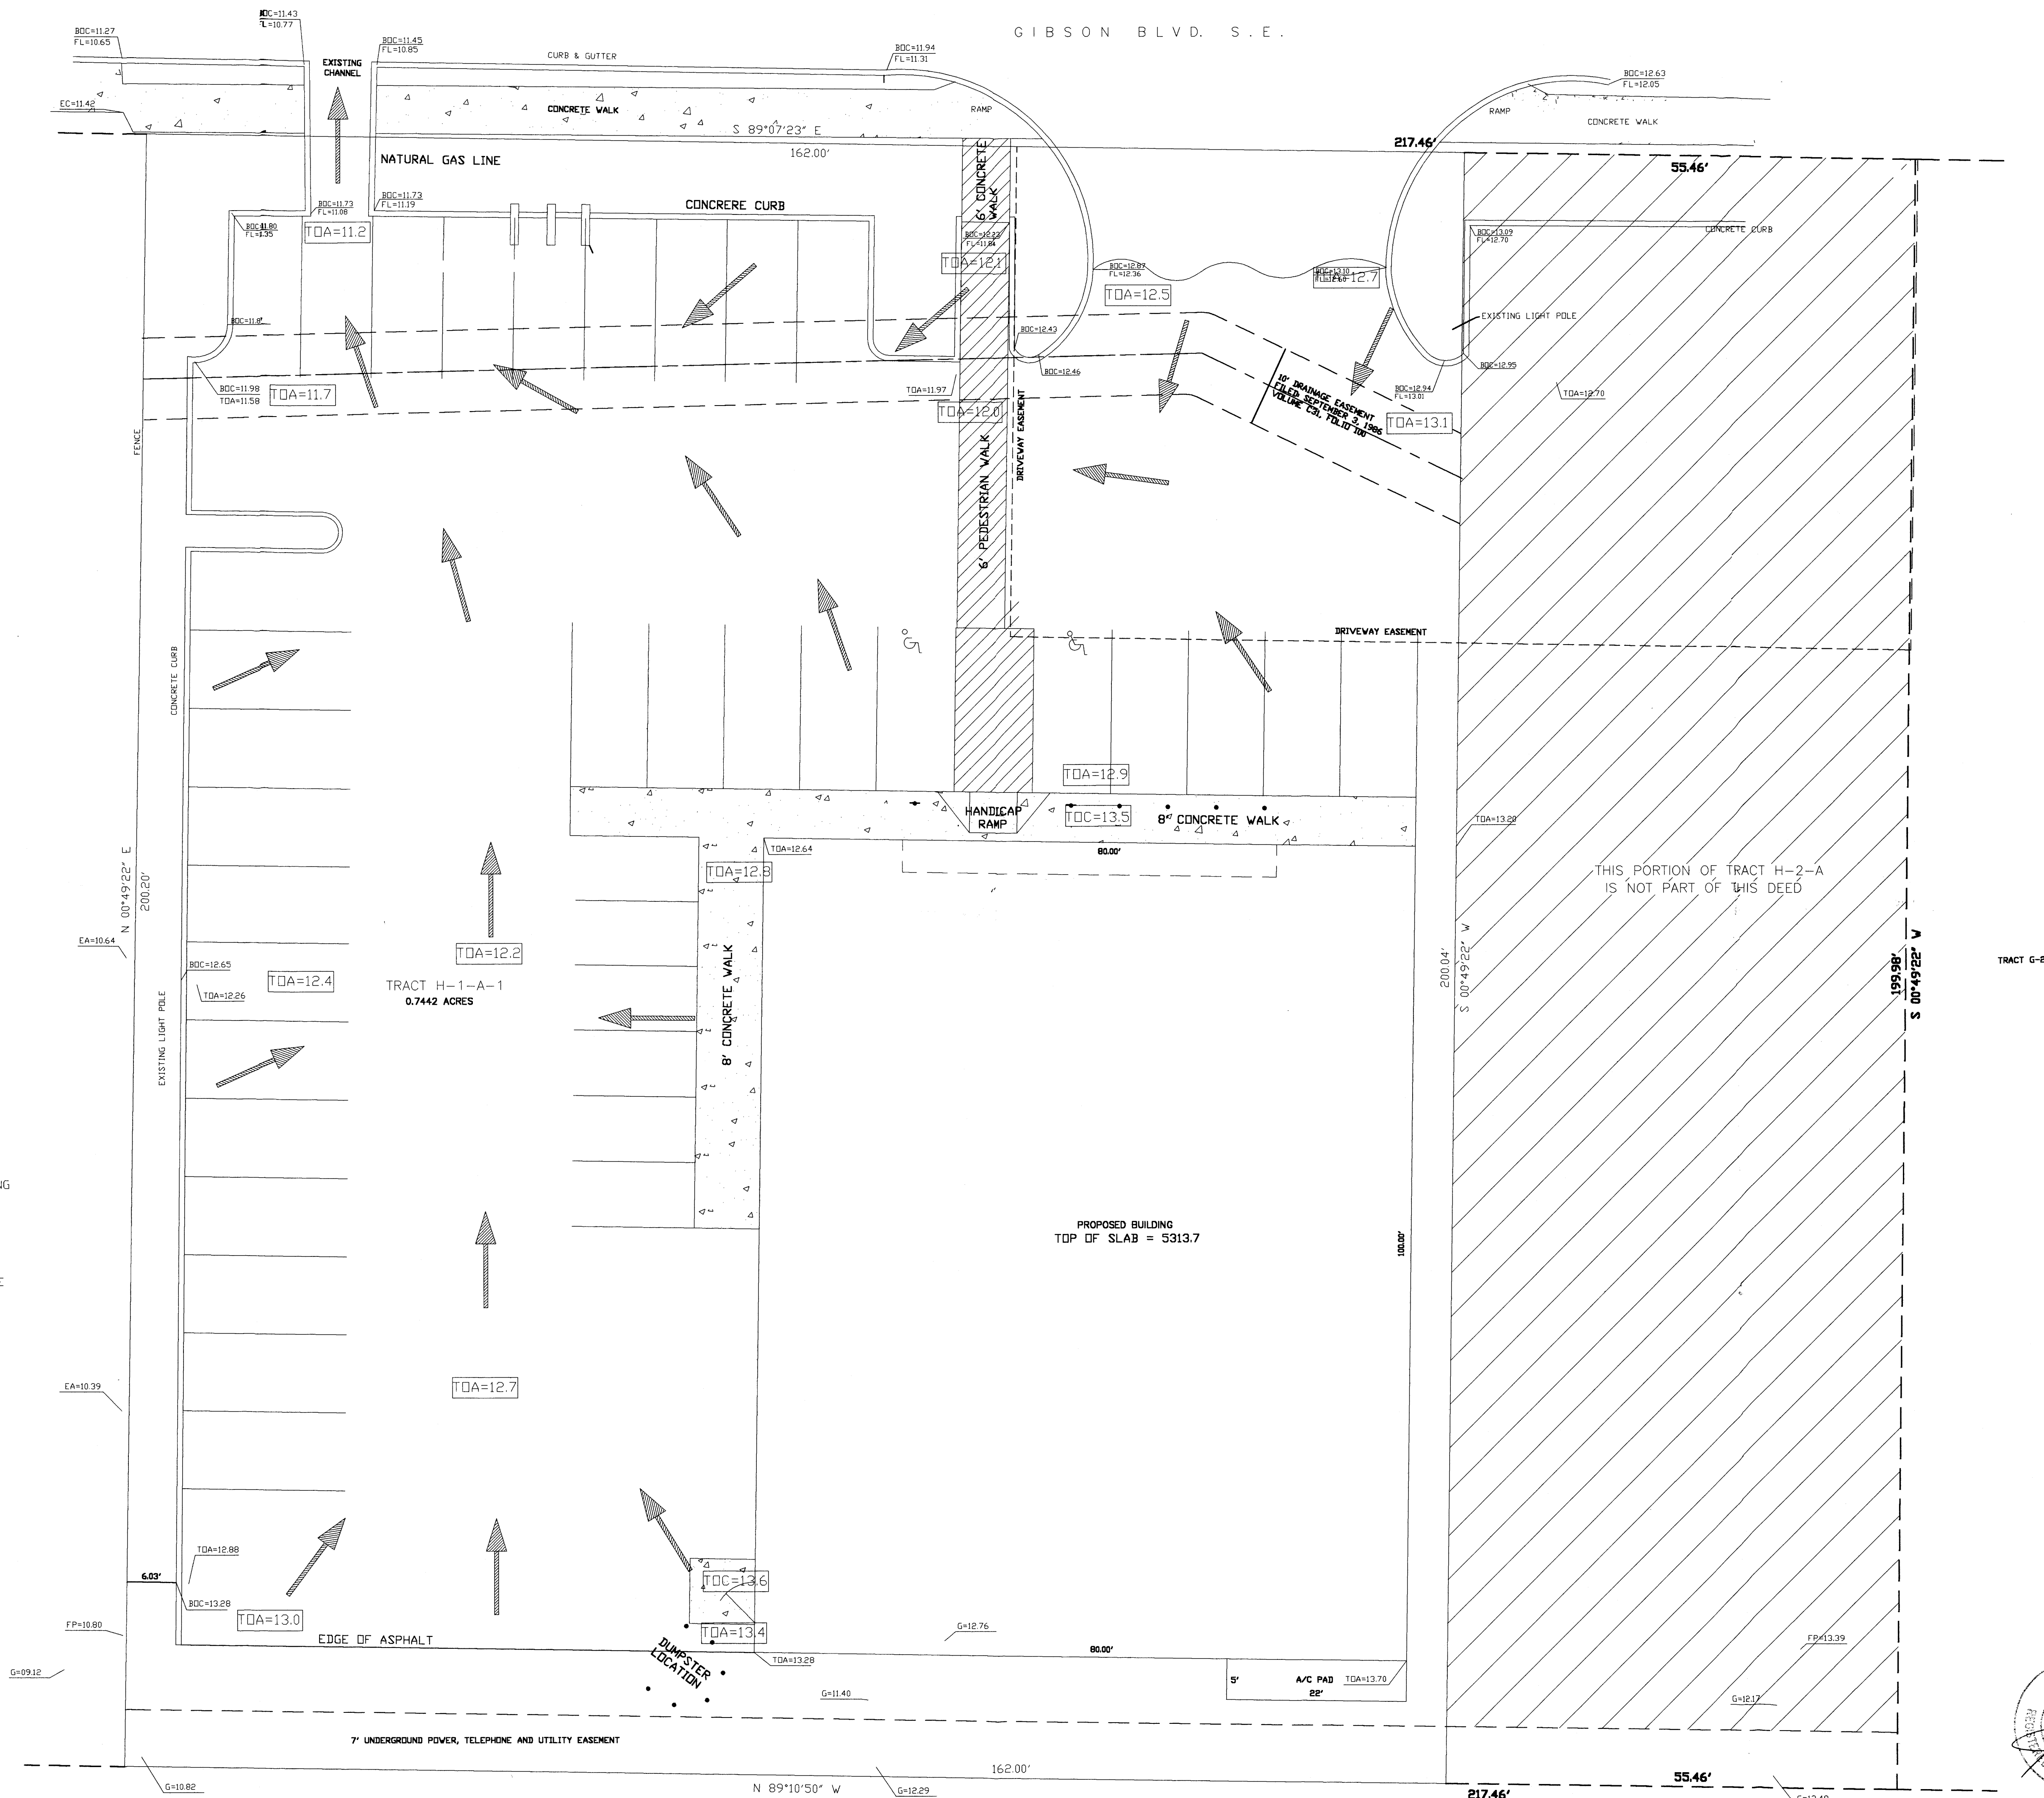

TES
TOWNER ENGINEERING SERVICES, INC.
8205 SPAIN N.E. SUITE #205
ALBUQUERQUE, NM 87109
PHONE: (505) 828-1930
FAX: (505) 828-1967


DESIGN TYPE
80'x100' BLDG
MTL PANEL FACIA
SPLIT FACE CMU FRONT
MTL PANEL EXT WALLS

SITE INFORMATION
FAMILY DOLLAR STORE
6000 GIBSON SE
ALB, NEW MEXICO 87104

SHEET TITLE:
DRAINAGE PLAN


SHEET NO.

C-2

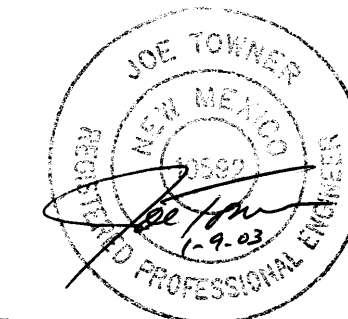



REV	DESCRIPTION	DATE	BY	CHKD	APVLS
3	RE-ISSUED FOR PERMIT	01/09/03	PDS	JT	JT
2	RE-ISSUED FOR PERMIT	12/03/02	TLS	JT	JT
1	ISSUED FOR PERMIT	10/23/02	TLS	JT	JT

TRAFFIC PLAN
OF
TRACT H-2-A
SIESTA HILLS
SUBDIVISION No. 2
6000 GIBSON S.E.
CITY OF ALBUQUERQUE
BERNALILLO COUNTY, NEW MEXICO

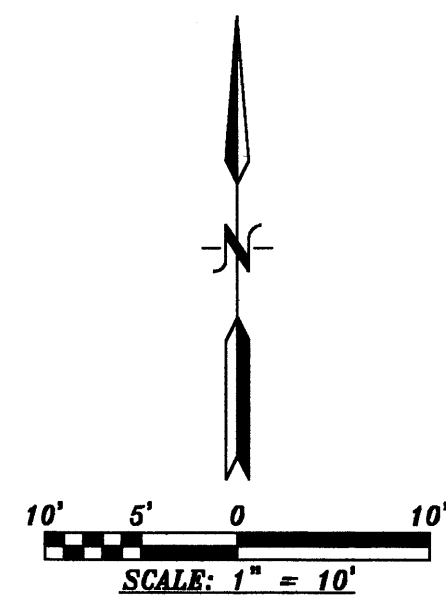

NOTES:

- 1: PARKING REQUIRED = 27 SPACES
- 2: PARKING FURNISHED = 37 SPACES
- 3: EXISTING FENCE WILL BE REMOVED PRIOR TO FINAL INSPECTION OF BUILDING CONSTRUCTION
- 4: PARKING BUMPERS =

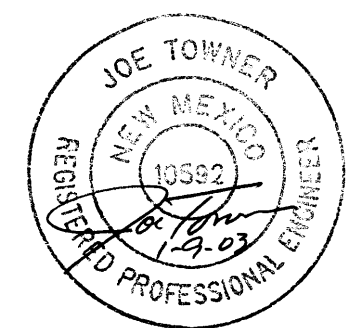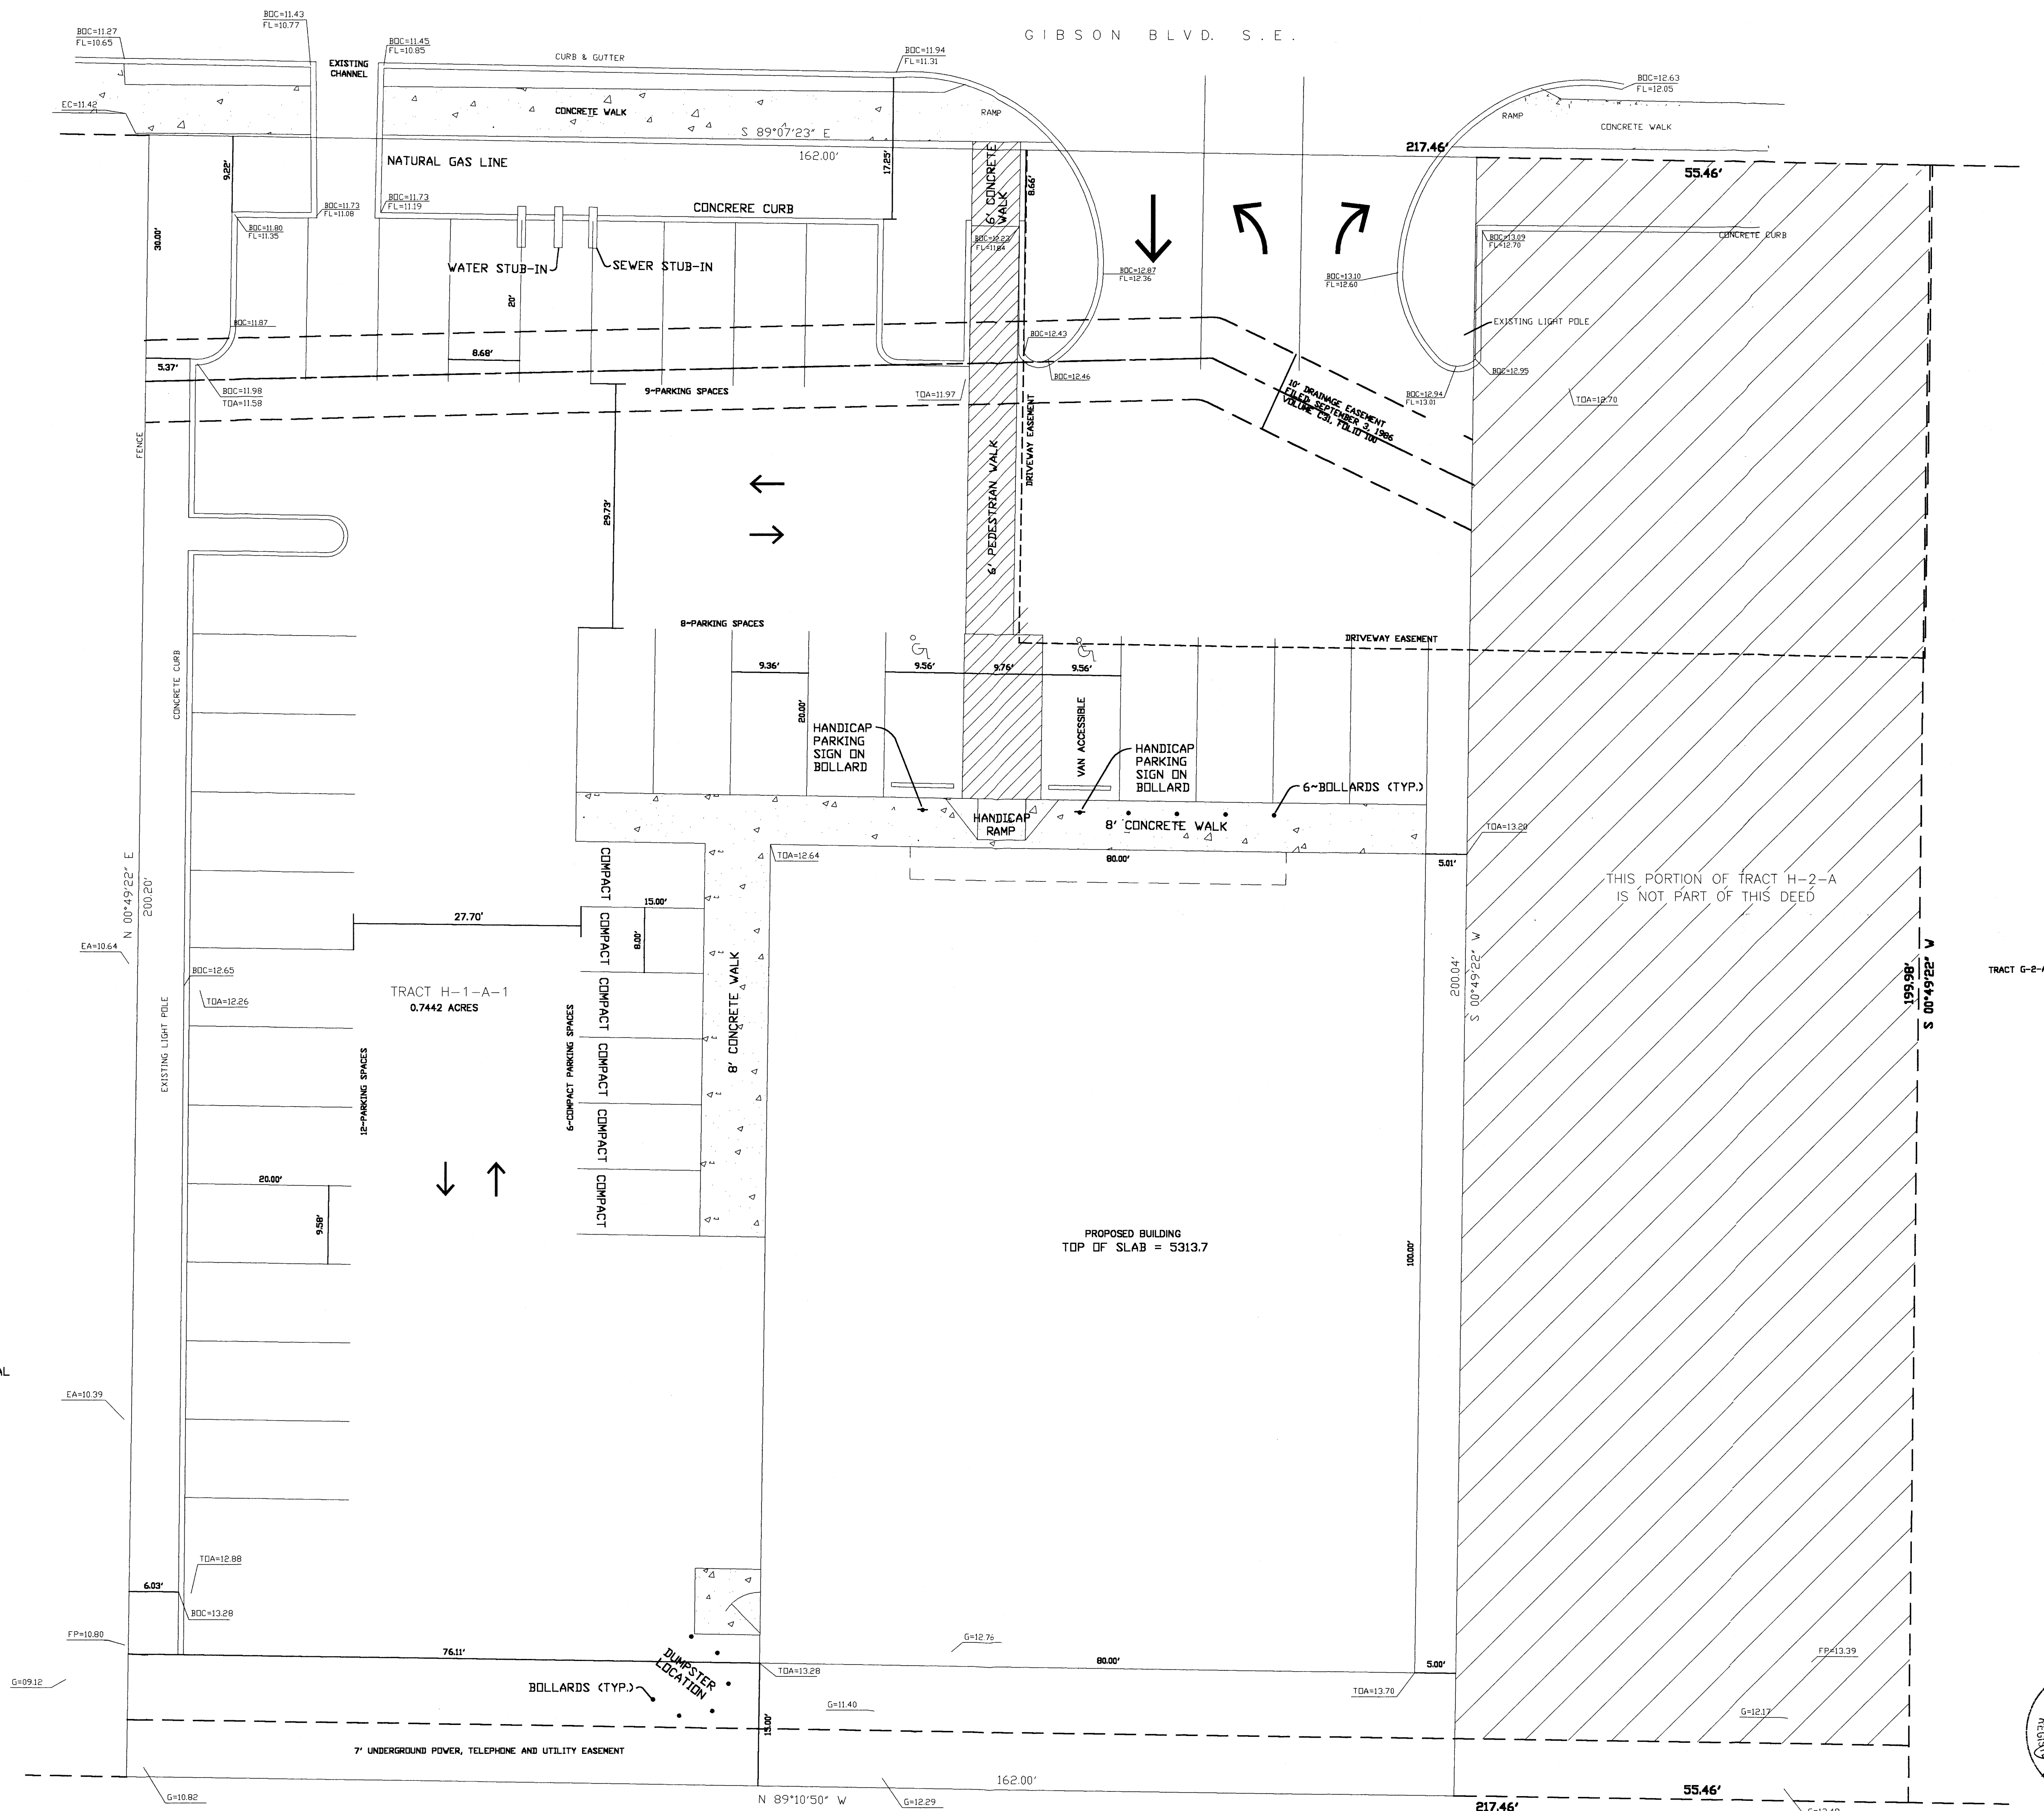

TES
TOWNER ENGINEERING SERVICES, INC.
8205 SPAIN N.E. SUITE #205
ALBUQUERQUE, NM 87109
PHONE: (505) 828-1930
FAX: (505) 828-1967

DESIGN TYPE
80'x100' BLDG
MTL PANEL FACIA
SPLIT FACE CMU FRONT
MTL PANEL EXT WALLS

SITE INFORMATION
FAMILY DOLLAR STORE
6000 GIBSON SE
ALB, NEW MEXICO 87104


SHEET TITLE:
TRAFFIC PLAN

SHEET NO.


C-4

REV	DESCRIPTION	DATE	BY	CHKD	APVLS
3	RE-ISSUED FOR PERMIT	01/09/03	PDS	JT	JT

TRAFFIC PLAN
OF
TRACT H-2-A
SIESTA HILLS
SUBDIVISION No. 2
6000 GIBSON S.E.
CITY OF ALBUQUERQUE
BERNALILLO COUNTY, NEW MEXICO

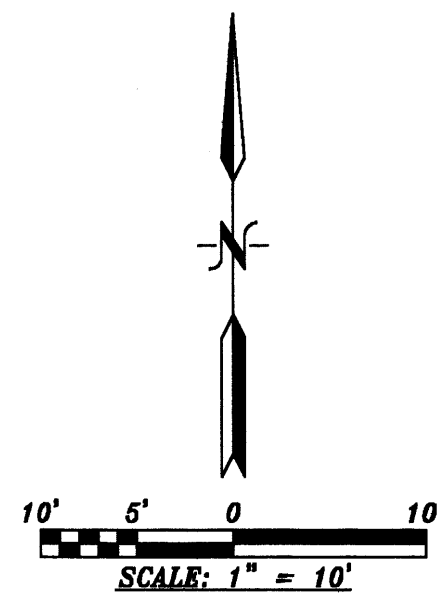

- NOTES:
- 1) PARKING REQUIRED = 27 SPACES
 - 2) PARKING FURNISHED = 37 SPACES
 - 3) EXISTING FENCE WILL BE REMOVED PRIOR TO FINAL INSPECTION OF BUILDING CONSTRUCTION
 - 4) PARKING BUMPERS =

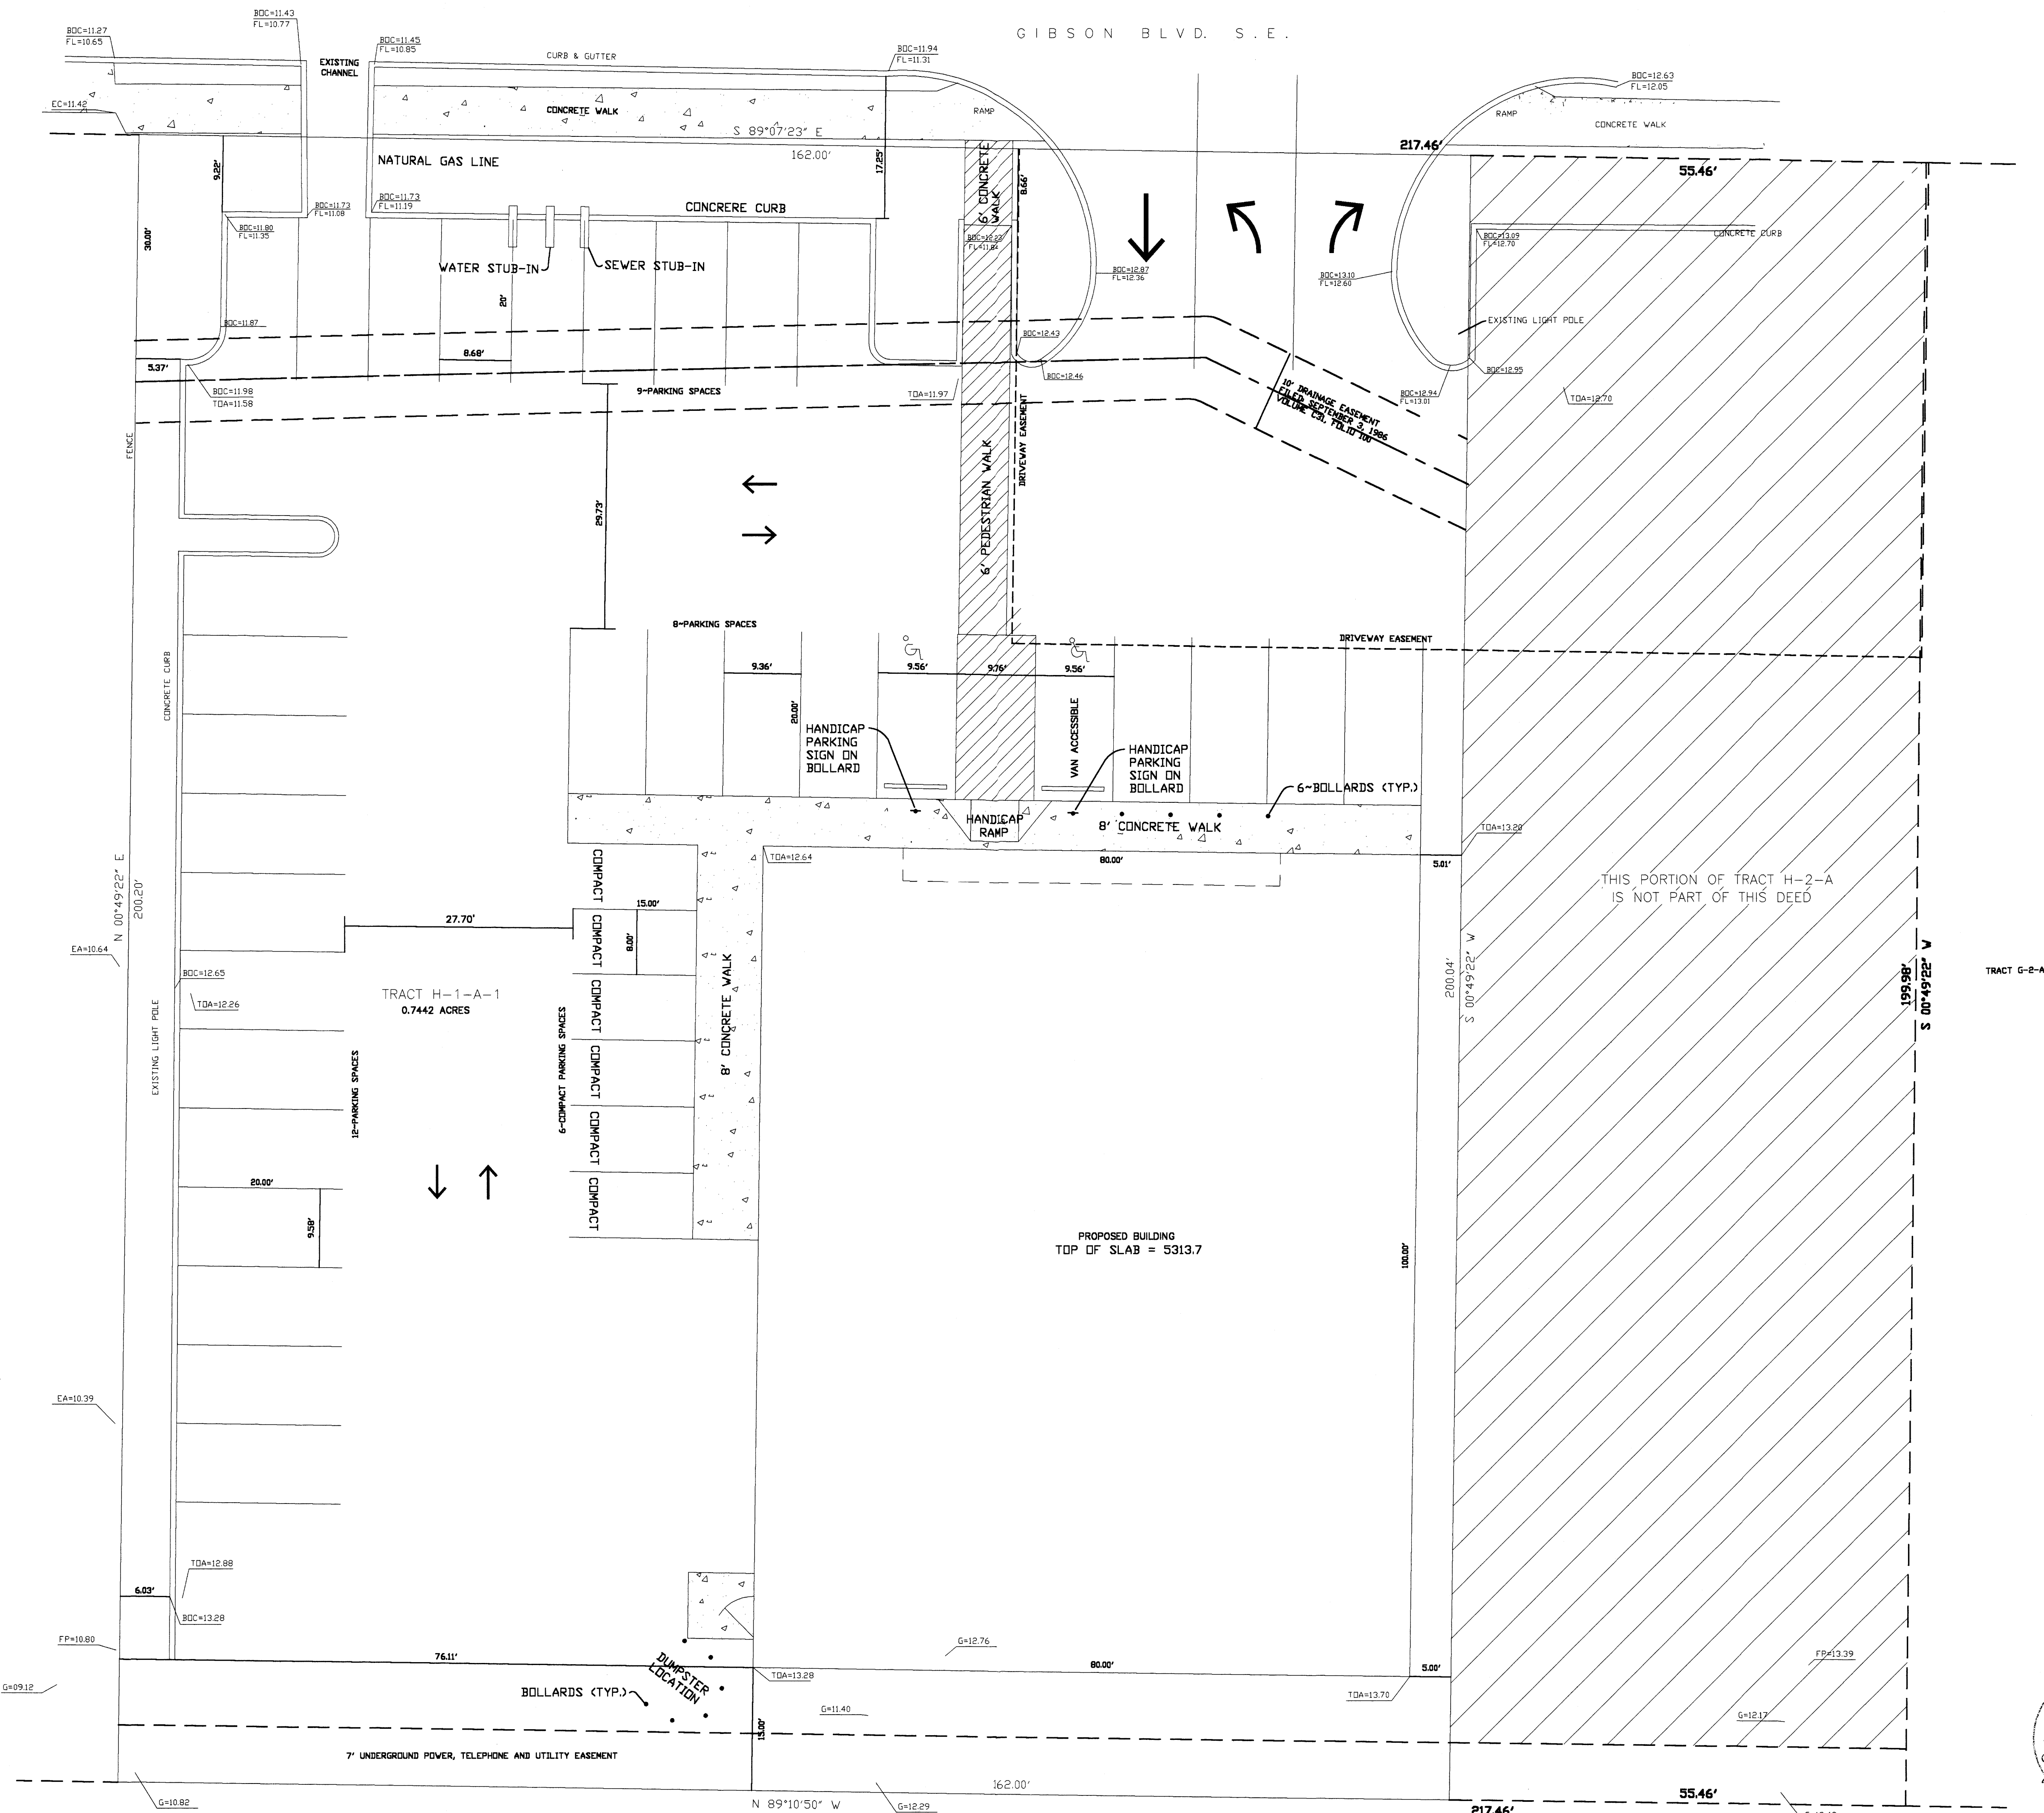

TES
TOWER ENGINEERING SERVICES, INC.
8205 SPAIN N.E. SUITE #205
ALBUQUERQUE, NM 87109
PHONE: (505) 828-1930
FAX: (505) 828-1967


DESIGN TYPE
80'x100' BLDG
MTL PANEL FACIA
SPLIT FACE CMU FRONT
MTL PANEL EXT WALLS

SITE INFORMATION
FAMILY DOLLAR STORE
6000 GIBSON SE
ALB, NEW MEXICO 87104

SHEET TITLE:
TRAFFIC PLAN

SHEET NO.



C-4

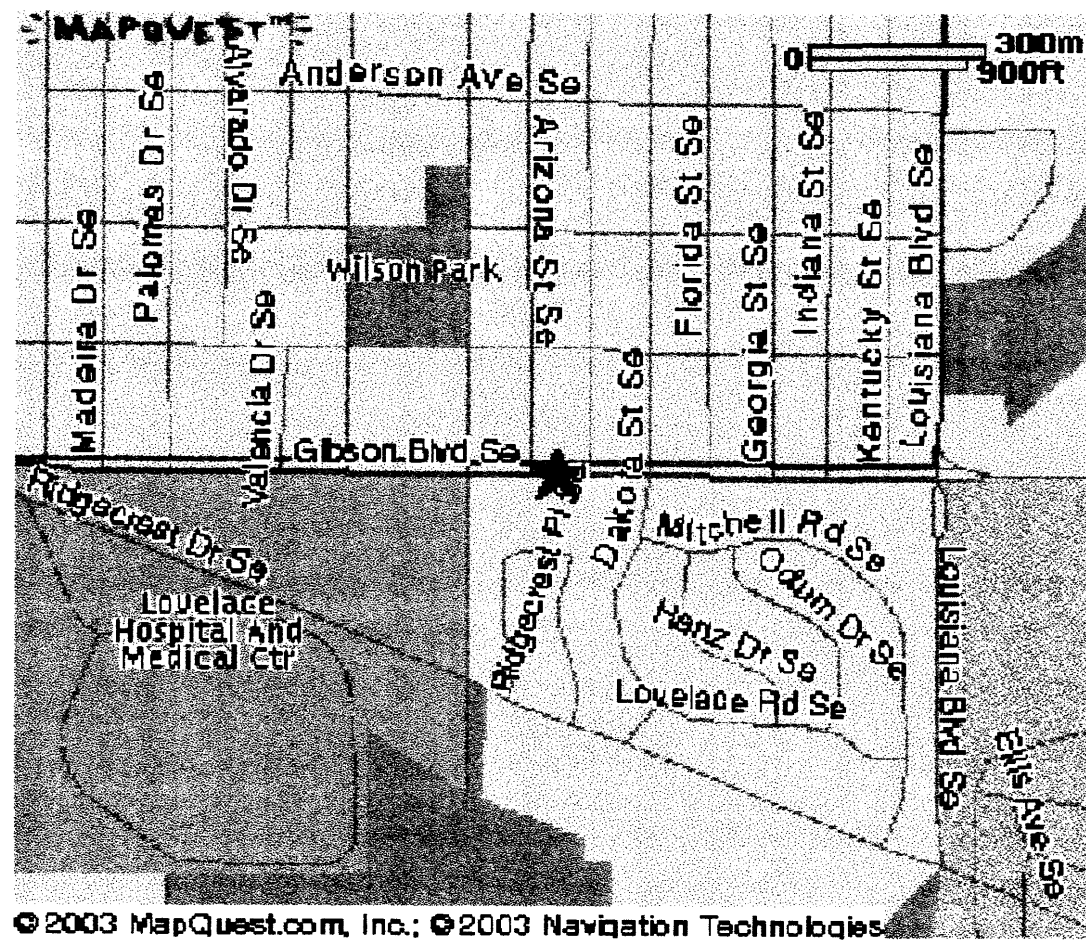

© 2003 MapQuest.com, Inc.; © 2003 Navigation Technologies

PROJECT INFORMATION :			
PROJECT LOCATION: 5950 GIBSON SE ALBUQUERQUE, NM 87104			
LEGAL DESCRIPTION: PORTION OF TRACT 90, H-2-A-1 SIESTA HILLS SUBDIVISION #2 BERNALILLO COUNTY, NM ZONING MAP M-18			
PROJECT DESCRIPTION: FREE STANDING FAMILY DOLLAR RETAIL STORE			
BUILDING DATA: BUILDING AREA (SQ. FT.): 8000 GROSS BUILDING HEIGHT: 1 STORY ALLOWABLE AREA (SQ.FT.): 9000 GROSS TABLE 503 M & S-1			

SITE PLAN
OF
TRACT H-2-A
SIESTA HILLS
SUBDIVISION No. 2
5950 GIBSON S.E.
CITY OF ALBUQUERQUE
BERNALILLO COUNTY, NEW MEXICO

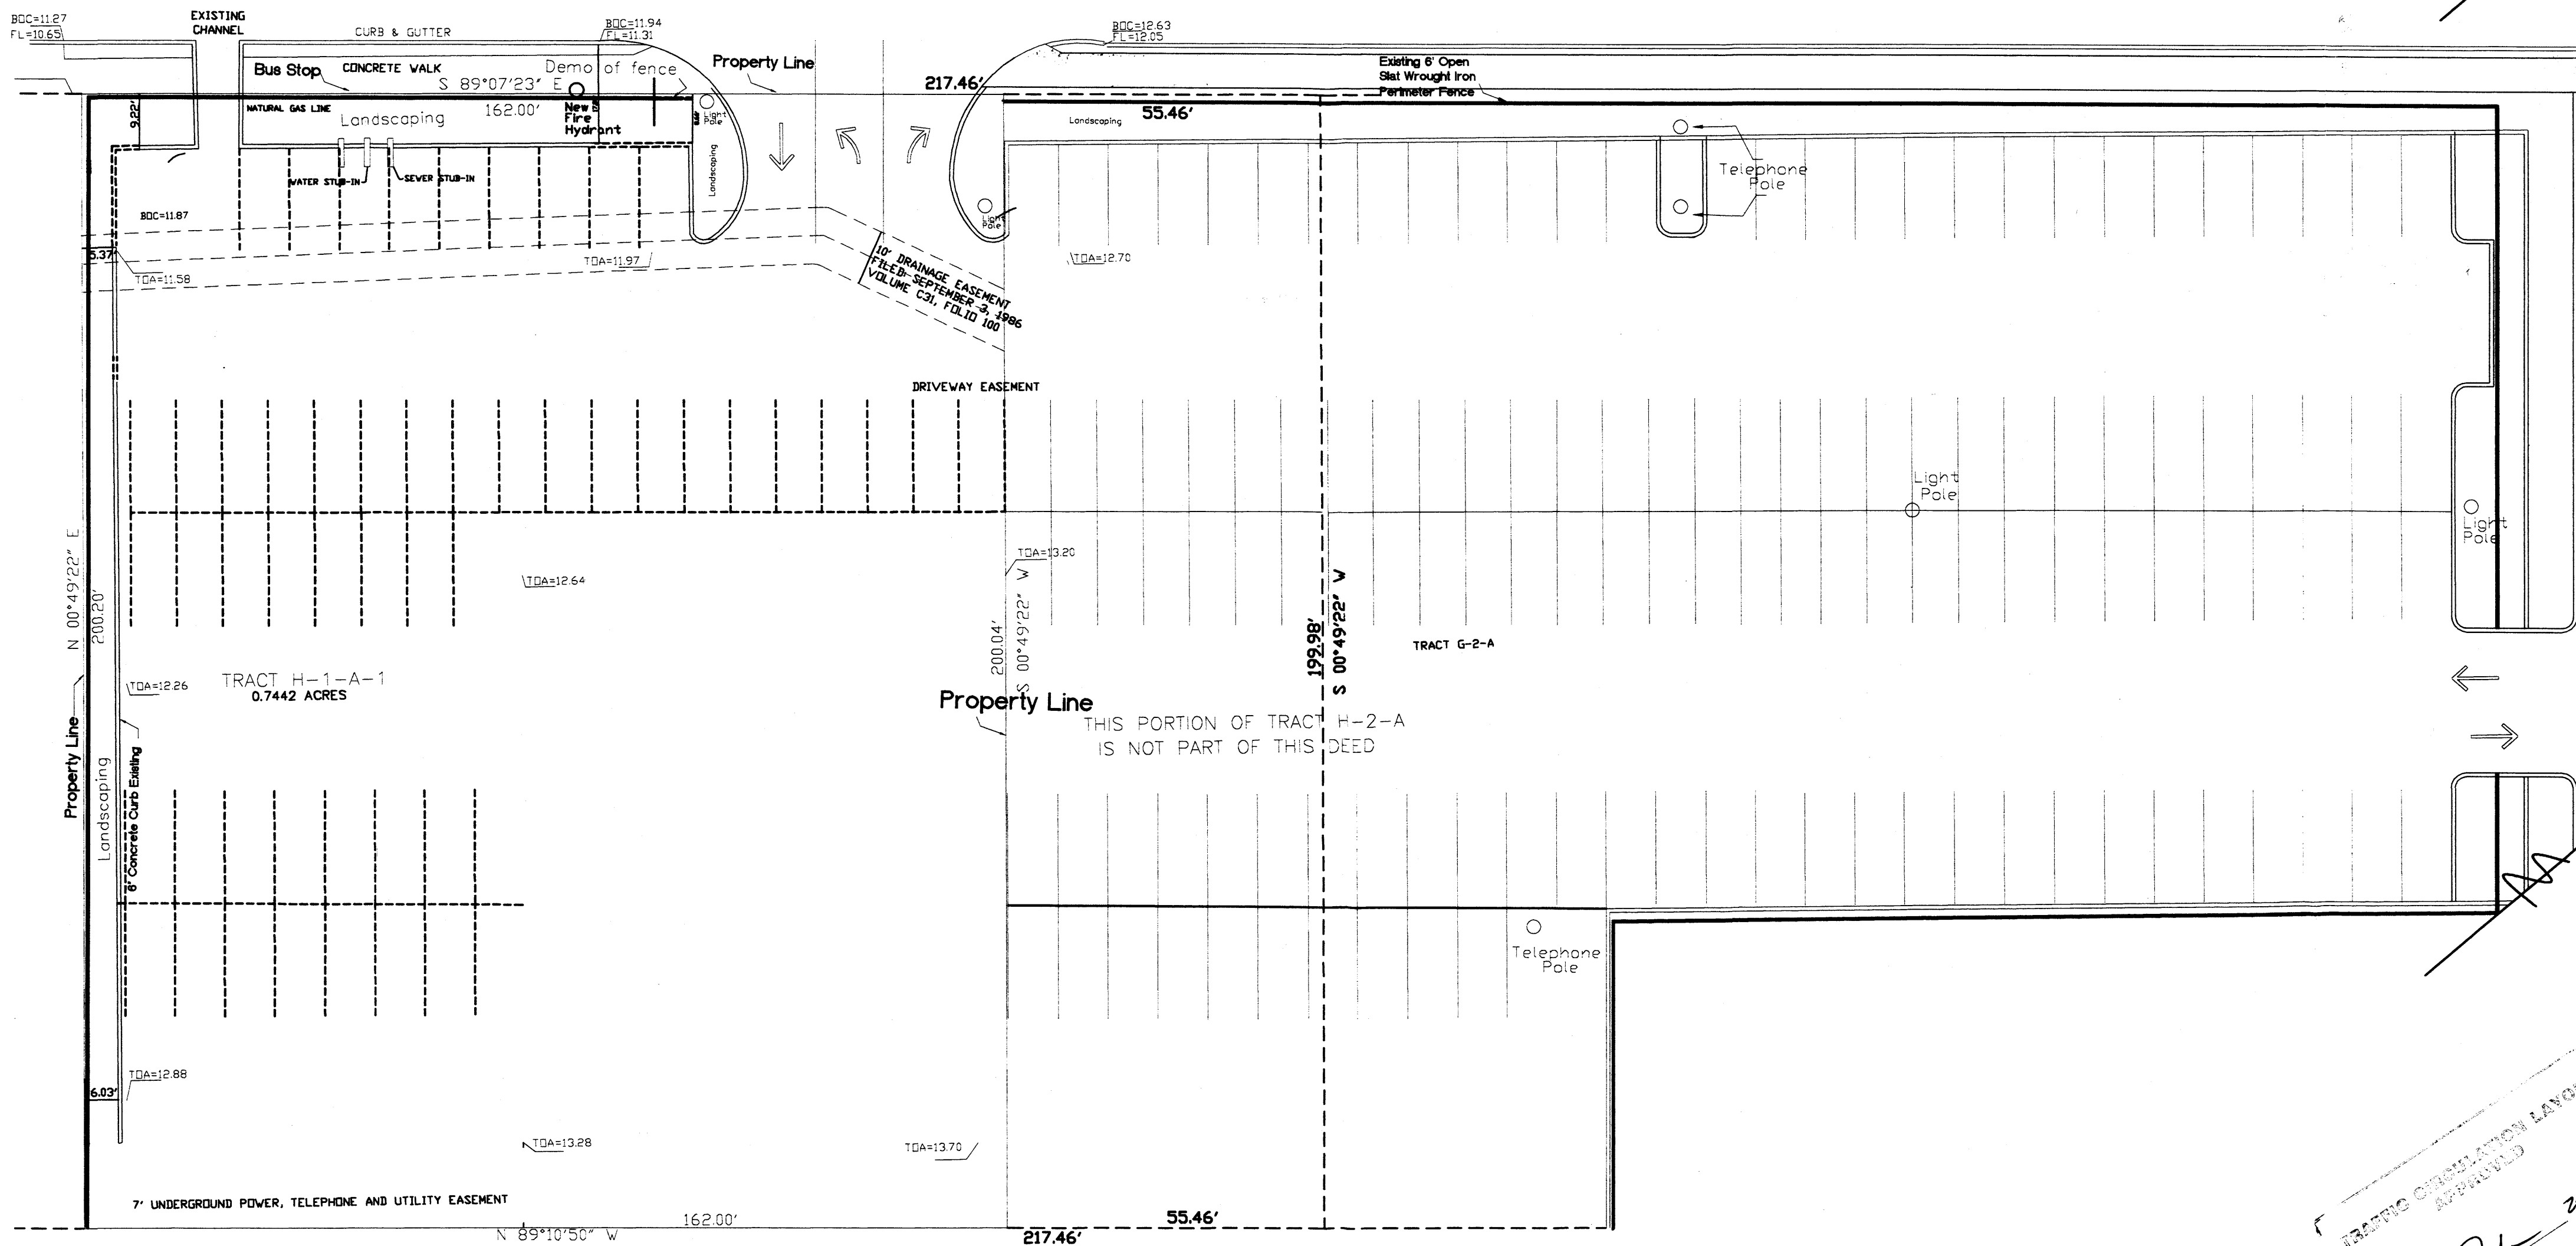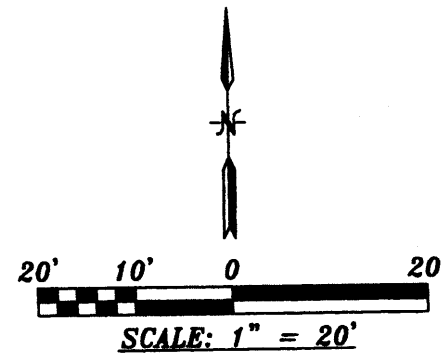

2-28-03
DATE
HYDROLOGY SECTION
FEB 23 2003
JOE TOWNER
REGISTERED PROFESSIONAL ENGINEER
NEW MEXICO
10592
2-27-02

TES
TOWNER ENGINEERING SERVICES, INC.
8205 SPAIN N.E. SUITE #205
ALBUQUERQUE, NM 87109
PHONE: (505) 828-1930
FAX: (505) 828-1967

DESIGN TYPE
80'x100' BLDG
MTL PANEL FACIA
SPLIT FACE CMU FRONT
MTL PANEL EXT WALLS


SITE INFORMATION
FAMILY DOLLAR STORE
5950 GIBSON SE
ALB, NEW MEXICO 87104

SHEET TITLE:
EXISTING CIVIL SITE PLAN

SHEET NO.

C-4A

RECEIVED
MAY 19 2003
HYDROLOGY SECTION

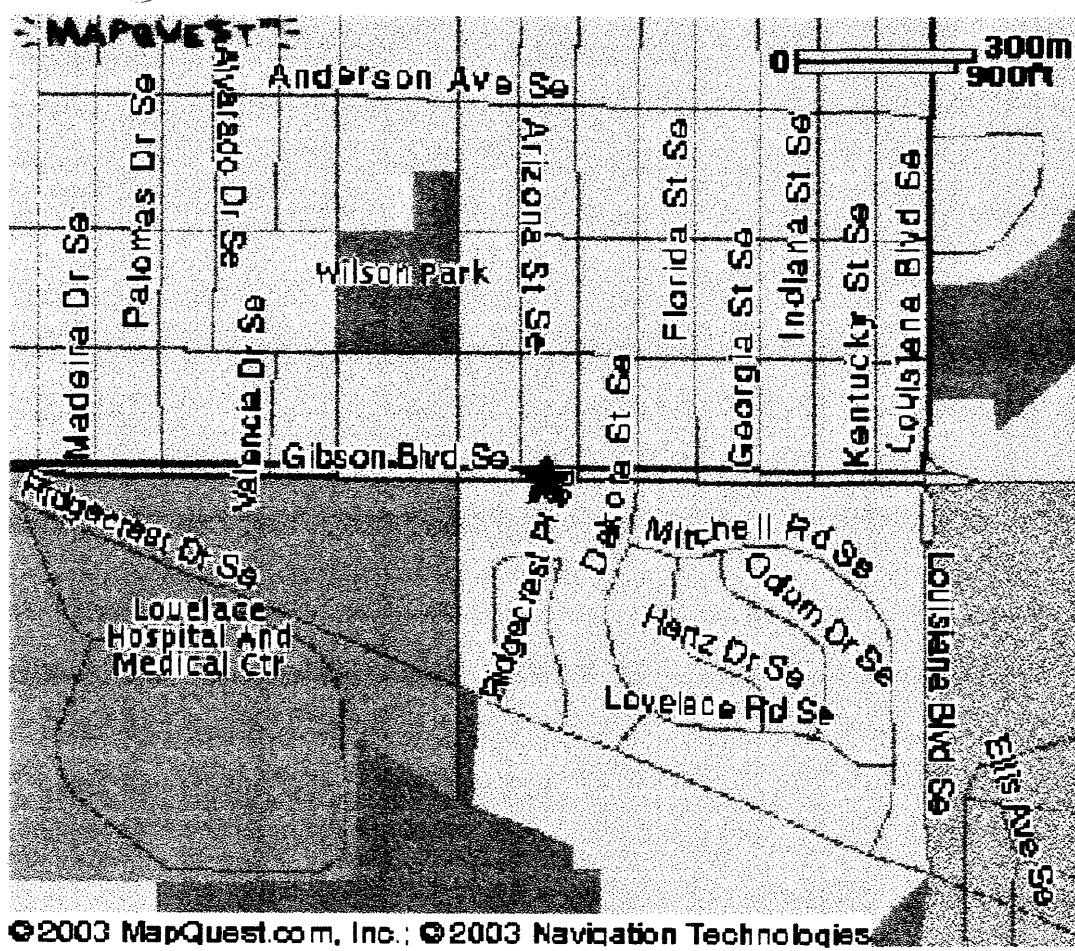

©2003 MapQuest.com, Inc. ©2003 Navigation Technologies

PROJECT INFORMATION :			
PROJECT LOCATION: 5950 GIBSON SE ALBUQUERQUE, NM 87104			
LEGAL DESCRIPTION: PORTION OF TRACT 90, H-2-A-1 SIESTA HILLS SUBDIVISION #2 BERNALILLO COUNTY, NM ZONING MAP M-18			
PROJECT DESCRIPTION: FREE STANDING FAMILY DOLLAR RETAIL STORE			
BUILDING DATA: BUILDING AREA (SQ. FT.): 8000 GROSS BUILDING HEIGHT: 1 STORY ALLOWABLE AREA (SQ. FT.): 9000 GROSS TABLE 503 M & S-1			

REV	DESCRIPTION	DATE	BY	CHKD	APVLS
4	RE-ISSUED FOR PERMIT	02/27/03	KSD		
3	RE-ISSUED FOR PERMIT	01/09/03	PDS	JT	JT
2	RE-ISSUED FOR PERMIT	12/03/02	TLS	JT	JT
1	ISSUED FOR PERMIT	10/23/02	TLS	JT	JT

TES
TOWNER ENGINEERING SERVICES, INC.
8205 SPAIN N.E. SUITE #205
ALBUQUERQUE, NM 87109
PHONE: (505) 828-1930
FAX: (505) 828-1967


DESIGN TYPE
80'x100' BLDG
MTL PANEL FACIA
SPLIT FACE CMU FRONT
MTL PANEL EXT WALLS

SITE INFORMATION
FAMILY DOLLAR STORE
5950 GIBSON SE
ALB, NEW MEXICO 87104

SHEET NO.
EXISTING CIVIL SITE PLAN
REVISED

SHEET NO.
C-4B

SITE PLAN
OF
TRACT H-2-A
SIESTA HILLS
SUBDIVISION No. 2
5950 GIBSON S.E.
CITY OF ALBUQUERQUE
BERNALILLO COUNTY, NEW MEXICO

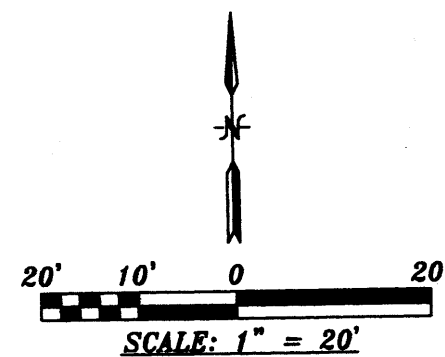

- NOTES**
1. PARKING REQUIRED - 27 SPACES
 2. PARKING FURNISHED - 32 SPACES
 3. EXISTING FENCE WILL BE REMOVED PRIOR TO FINAL INSPECTION OF BUILDING CONSTRUCTION
 4. PARKING BUMPERS -

