

GRADING NOTES

- [illegible]


RAINAGE MANAGEMENT PLAN

INTRODUCTION

The purpose of this submittal is to present a Drainage Management Plan for a proposed additional storage building at the Emcorecore industrial property. The project will include a 12,793 gross square foot warehouse that was planned under a previous drainage management submittal titled Emcore II, by Brashear and Lorenz (stamped 11-17-00). The referenced document is M-21 (05F) in the Hydrologic Emcorec

[illegible]

A SIDEWALK SECTION
N.T.S.

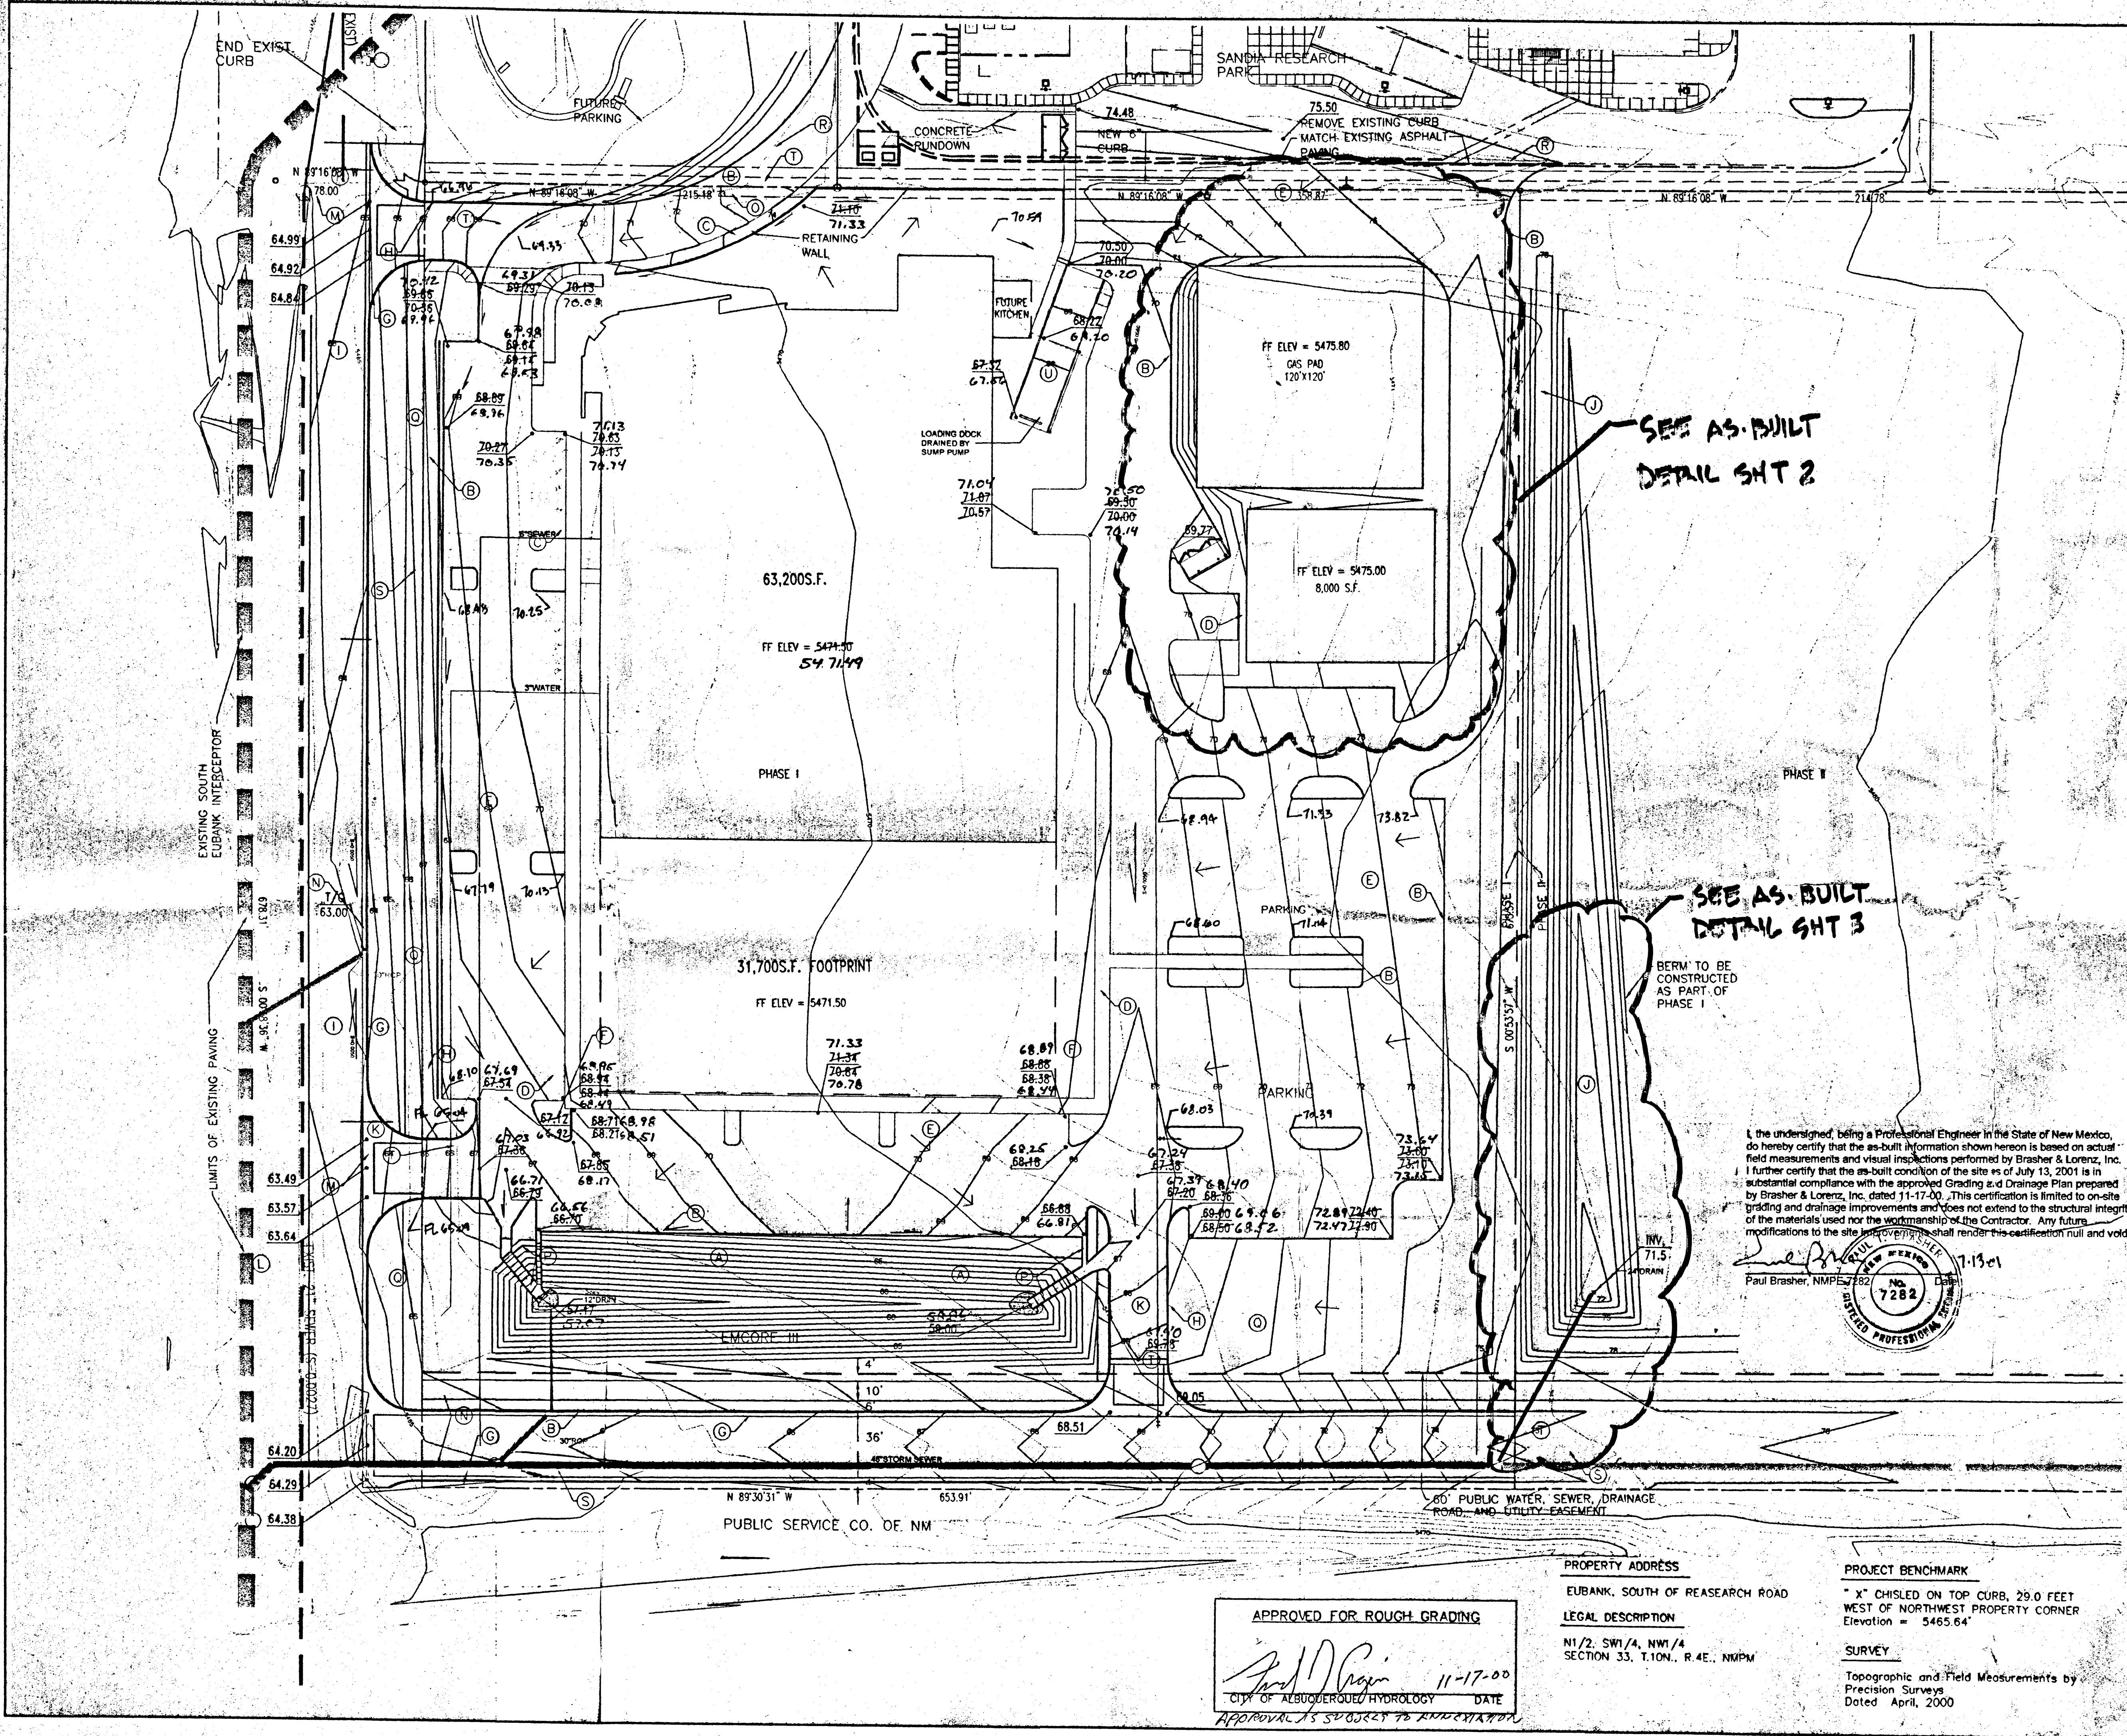


Drainage Plan Notes:

1. BLI recommends that the Owner obtain a Geotechnical Evaluation of the on-site soils prior to foundation / structural design.
2. This Plan recommends drainage away from all structures to prohibit ponding of runoff which may cause structural settlement. Future alteration of grades adjacent to the proposed structures is not recommended.
3. Irrigation within 10 feet of any proposed structure is not recommended. Introduction of irrigation water into subsurface soils adjacent to the structure could cause settlement.
4. This Plan is prepared to establish on-site drainage and grading criteria only. BLI assumes no responsibility for subsurface analysis, foundation / structural design, or utility design.
5. Local codes may require all footings to be placed in natural undisturbed soil. If the Contractor plans to place footings on engineered fill, a certification by a registered Professional Engineer will be required. If the contractor wishes BLI to prepare the Certification, we must be notified PRIOR to placement of the fill.
6. BLI recommends that the Owner obtain the services of a Geotechnical Engineer to test and inspect all earthwork aspects of the project.
7. The property boundary shown on this Plan is given for information only to describe the project limits. Property boundary information shown hereon does not constitute a boundary survey. A boundary survey performed by a licensed New Mexico Registered Professional Surveyor is recommended prior to construction.

TEMPORARY EROSION CONTROL PLAN

1. The intent of the Temporary Erosion Control Plan is to limit the discharge of sediment into the public street and / or storm drainage system and to protect adjacent properties from flooding and sedimentation.
2. The contractor shall submit a Temporary Erosion Control Plan and obtain a Topsoil Disturbance Permit from Environmental Health prior to performing any earthwork-related excess runoff during construction.
3. After the initial site clearing, the temporary erosion control facilities should be constructed per the Plan to direct excess runoff and sediment the outfall locations.
4. The Temporary Erosion Control Plan consists of the placement of swales earthen erosion control berms or silt fencing along the downstream project boundaries that will direct runoff and sediment to the proposed detention ponds located at the west end of Phase II and the south end of Phase I.
5. It is the Contractor's responsibility to properly maintain all temporary erosion control facilities during the construction phase of the project.

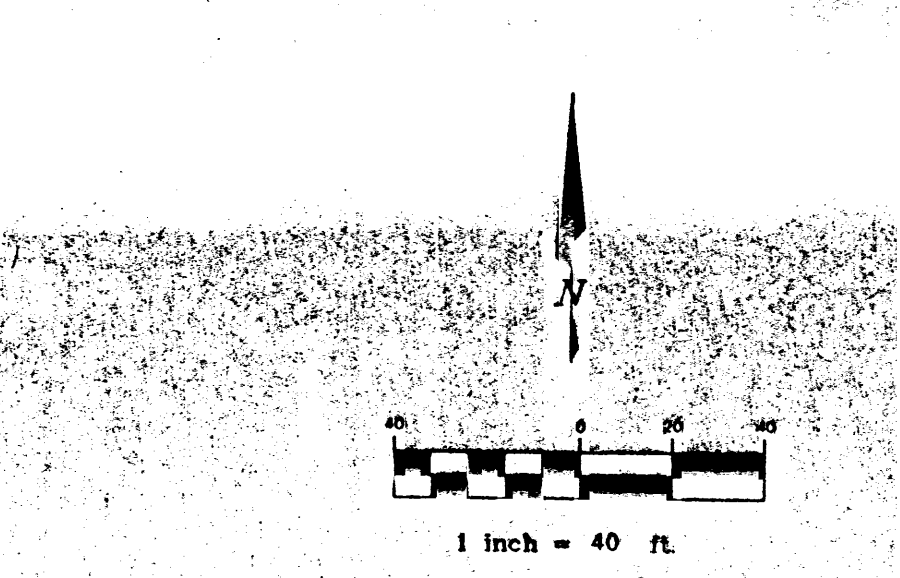

- KEYED NOTES:
- A DETENTION POND (PRIVATE)
 - B 6" CONCRETE HEADER CURB
 - C 6" CONCRETE SIDEWALK
 - D 8" CONCRETE SIDEWALK
 - E ASPHALT PAVING
 - F HANDICAP RAMP
 - G FUTURE STD. CURB AND GUTTER
 - H TRANSITION FROM 6" TO 6" CURB
 - I FUTURE EUBANK PAVING
 - J BERM
 - K 30' WIDTH ENTRANCE
 - L EXISTING TEMPORARY EUBANK PAVING (30' WIDTH)
 - M TEMPORARY ACCESS TO EXISTING PAVING
 - N CONSTRUCT NEW DROP INLET
 - O RETAINING WALL
 - P CONCRETE RUNDOWN
 - Q LANDSCAPED AREA
 - R FUTURE PAVED ACCESS TO ADJACENT PROPERTY
 - S 10' ASPHALT PATH
 - T OUTSIDE LIMIT OF PHASE I CONSTRUCTION
 - U LOADING DOCK RAMP

LEGEND		REVISIONS:	
02.5 X	EXISTING CONTOUR ELEVATION	CHECKED BY:	PTB
01	EXISTING SPOT ELEVATION	DRAWN BY:	LAN
01.5	PROPOSED CONTOUR ELEVATION	JOB NO:	00530
01.5	PROPOSED SPOT ELEVATION	FILE NO:	EUBANK.DWG
←	PROPERTY LINE	SHEET NO:	1 OF 1
→	DIRECTION OF FLOW		
—	DRAINAGE SWALE		
—	DRAINAGE BASIN DIVIDE		
⊙	HEC 2 SECTION		
~~~~~	WATER BLOCK		

I, the undersigned, being a Professional Engineer in the State of New Mexico, do hereby certify that the as-built information shown hereon is based on actual field measurements and visual inspections performed by Brasher & Lorenz, Inc. I further certify that the as-built condition of the site as of July 13, 2001 is in substantial compliance with the approved Grading and Drainage Plan prepared by Brasher & Lorenz, Inc. dated 11-17-00. This certification is limited to on-site grading and drainage improvements and does not extend to the structural integrity of the materials used nor the workmanship of the Contractor. Any future modifications to the site and/or plans shall render this certification null and void.

Paul Brasher, NMPE 7282

APPROVED FOR ROUGH GRADING

*Paul Brasher* 11-17-00

CITY OF ALBUQUERQUE HYDROLOGY DATE

APPROVAL IS SUBJECT TO REVISION

PROPERTY ADDRESS

EUBANK, SOUTH OF RESEARCH ROAD

LEGAL DESCRIPTION

N1/2, SW1/4, NW1/4 SECTION 33, T.10N., R.4E., NWPM

PROJECT BENCHMARK

"X" CHISEL ON TOP CURB, 29.0 FEET WEST OF NORTHWEST PROPERTY CORNER

Elevation = 5465.64'

SURVEY

Topographic and Field Measurements by Precision Surveys

Dated April, 2000

RECEIVED

NOV 17 2000

HYDROLOGY SECTION

BRASHER & LORENZ

CONSULTING ENGINEERS

2201 San Pedro NE Building 1 Suite 220

Albuquerque, New Mexico 87110

PH: 505-888-6088 FAX: 505-888-6188

EMCORE III

ALBUQUERQUE, NEW MEXICO

GRADING AND DRAINAGE PLAN





RECEIVED

NOV 17 2000

HYDROLOGY SECTION

REVISIONS:

CHECKED BY:	PTB
DRAWN BY:	LAN
JOB NO:	00530
FILE NO:	EUBANK.DWG
SHEET NO:	1 OF 1

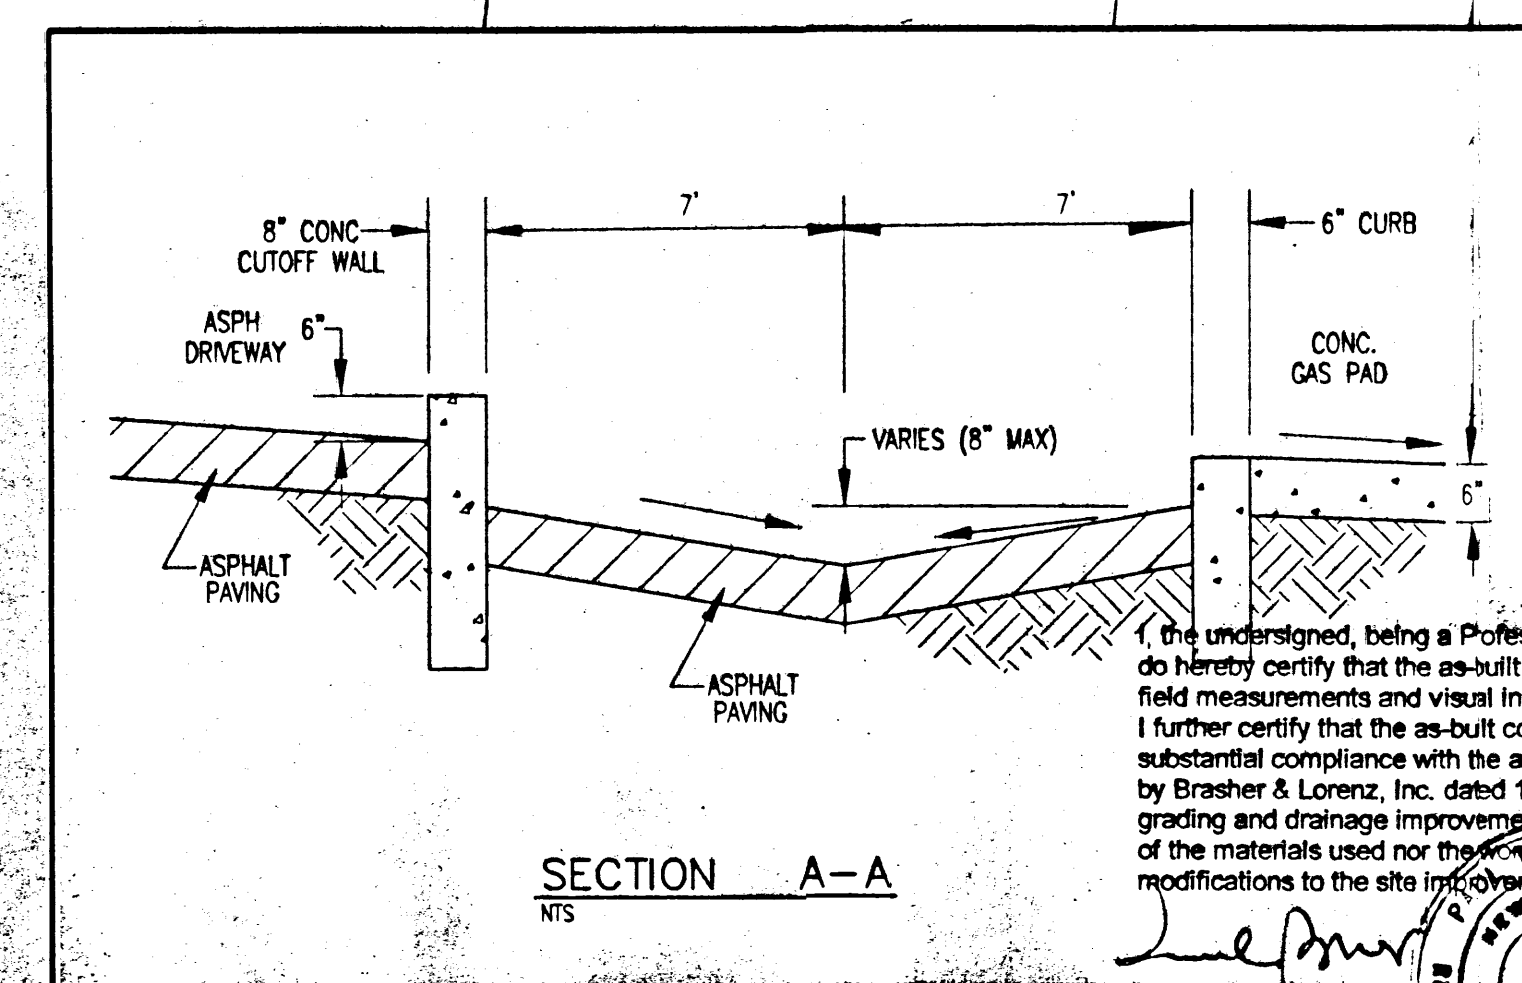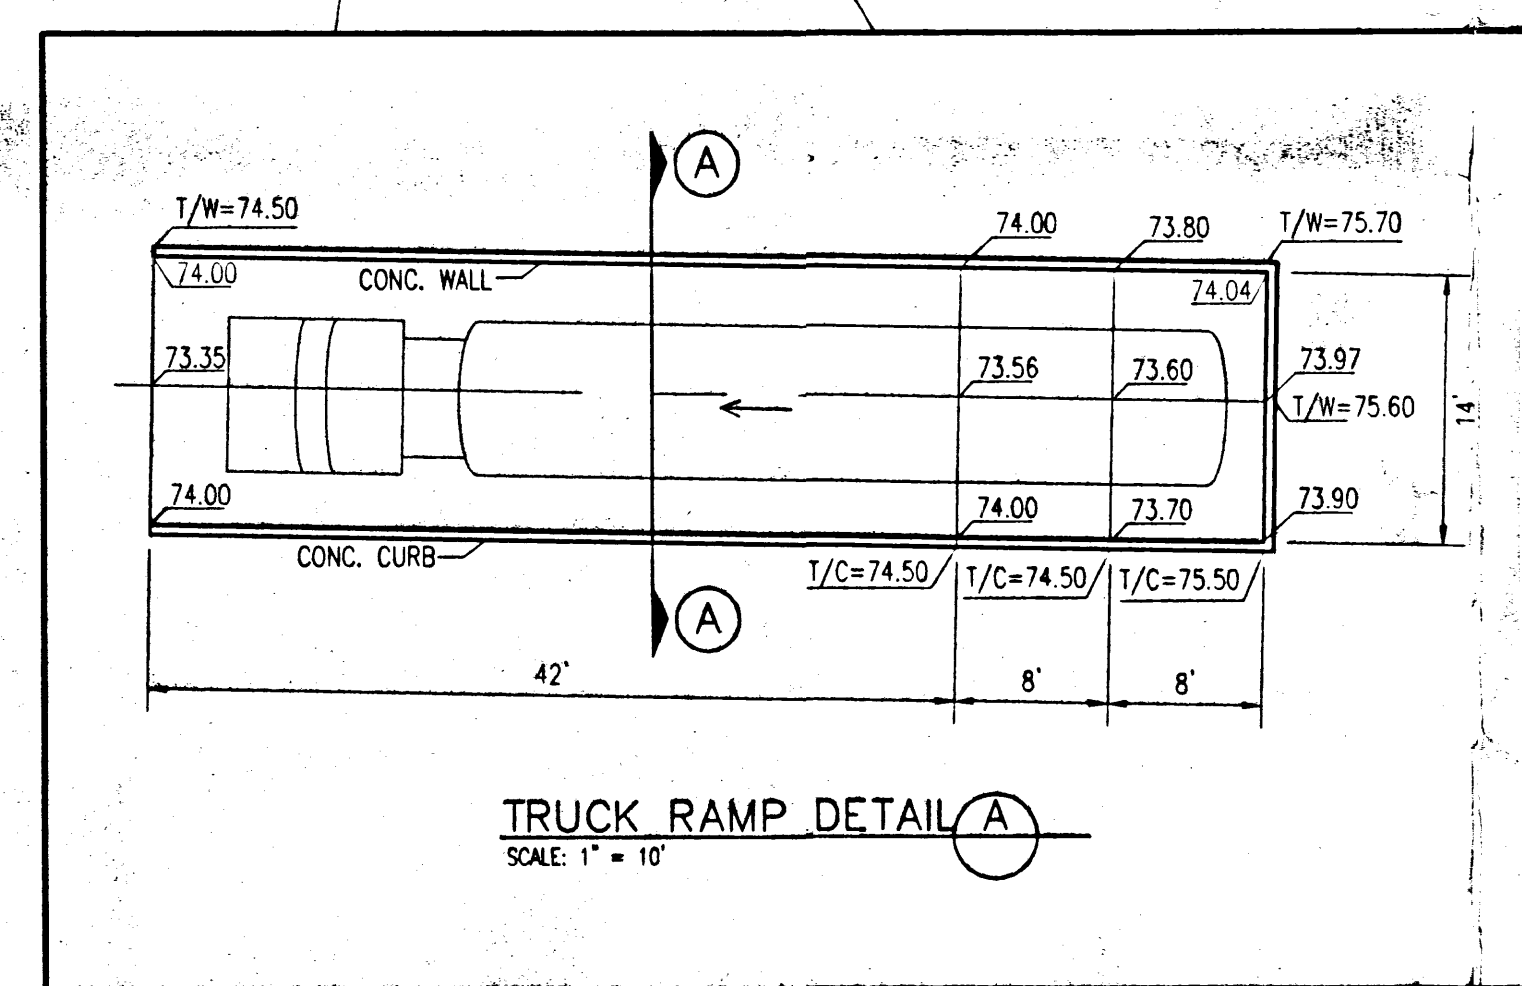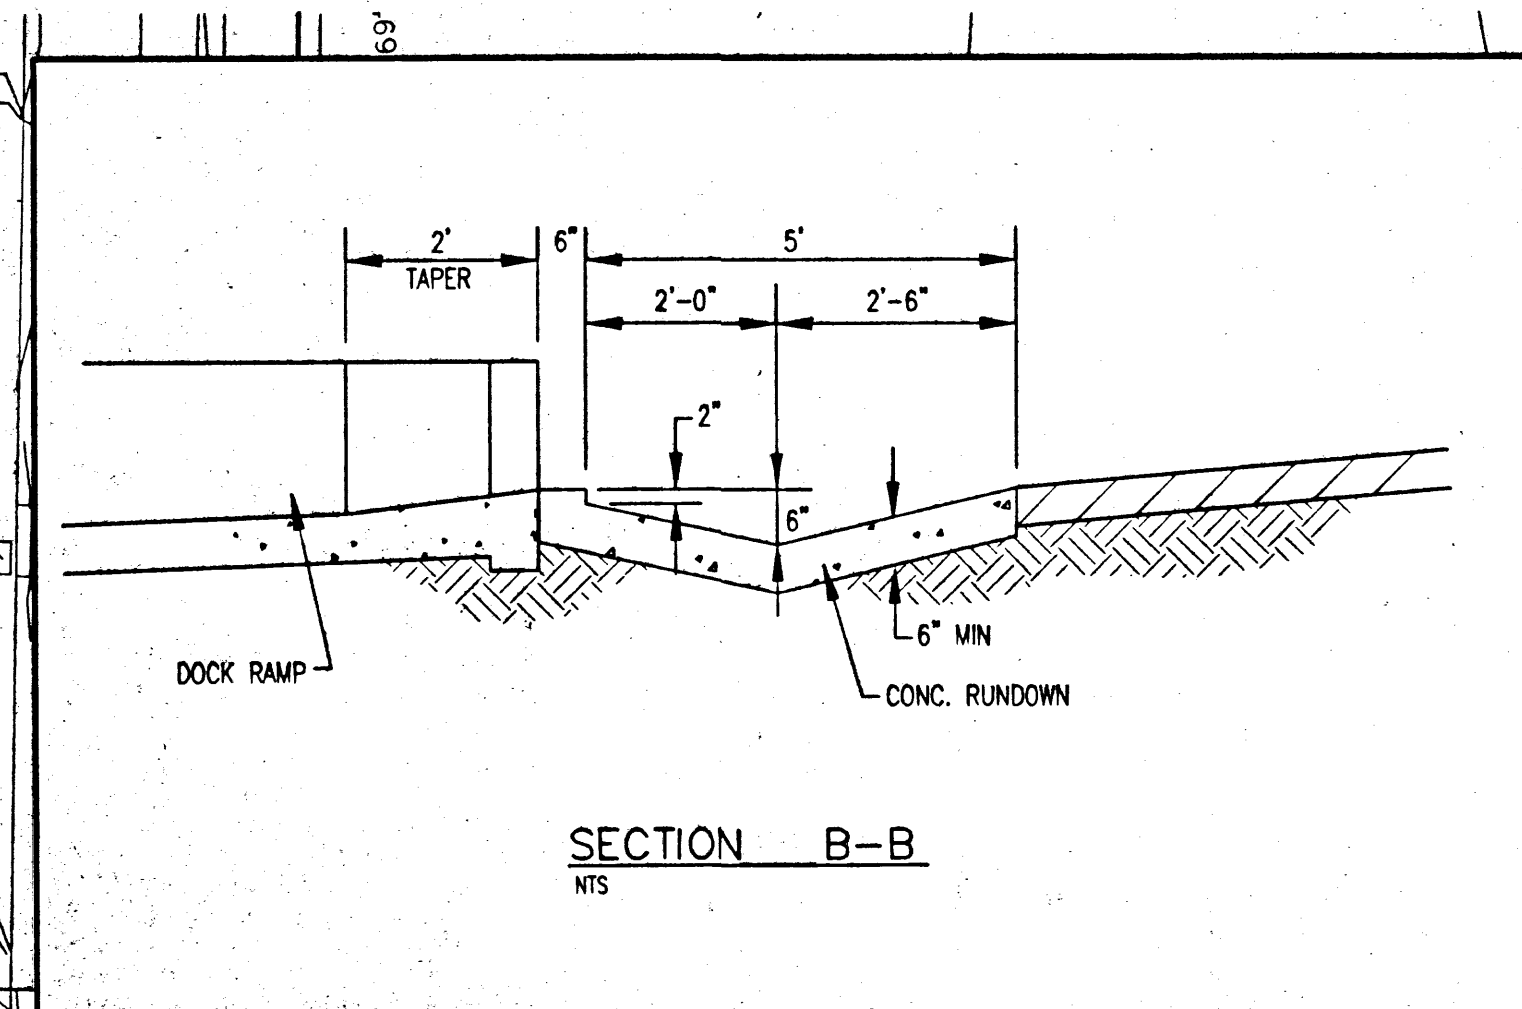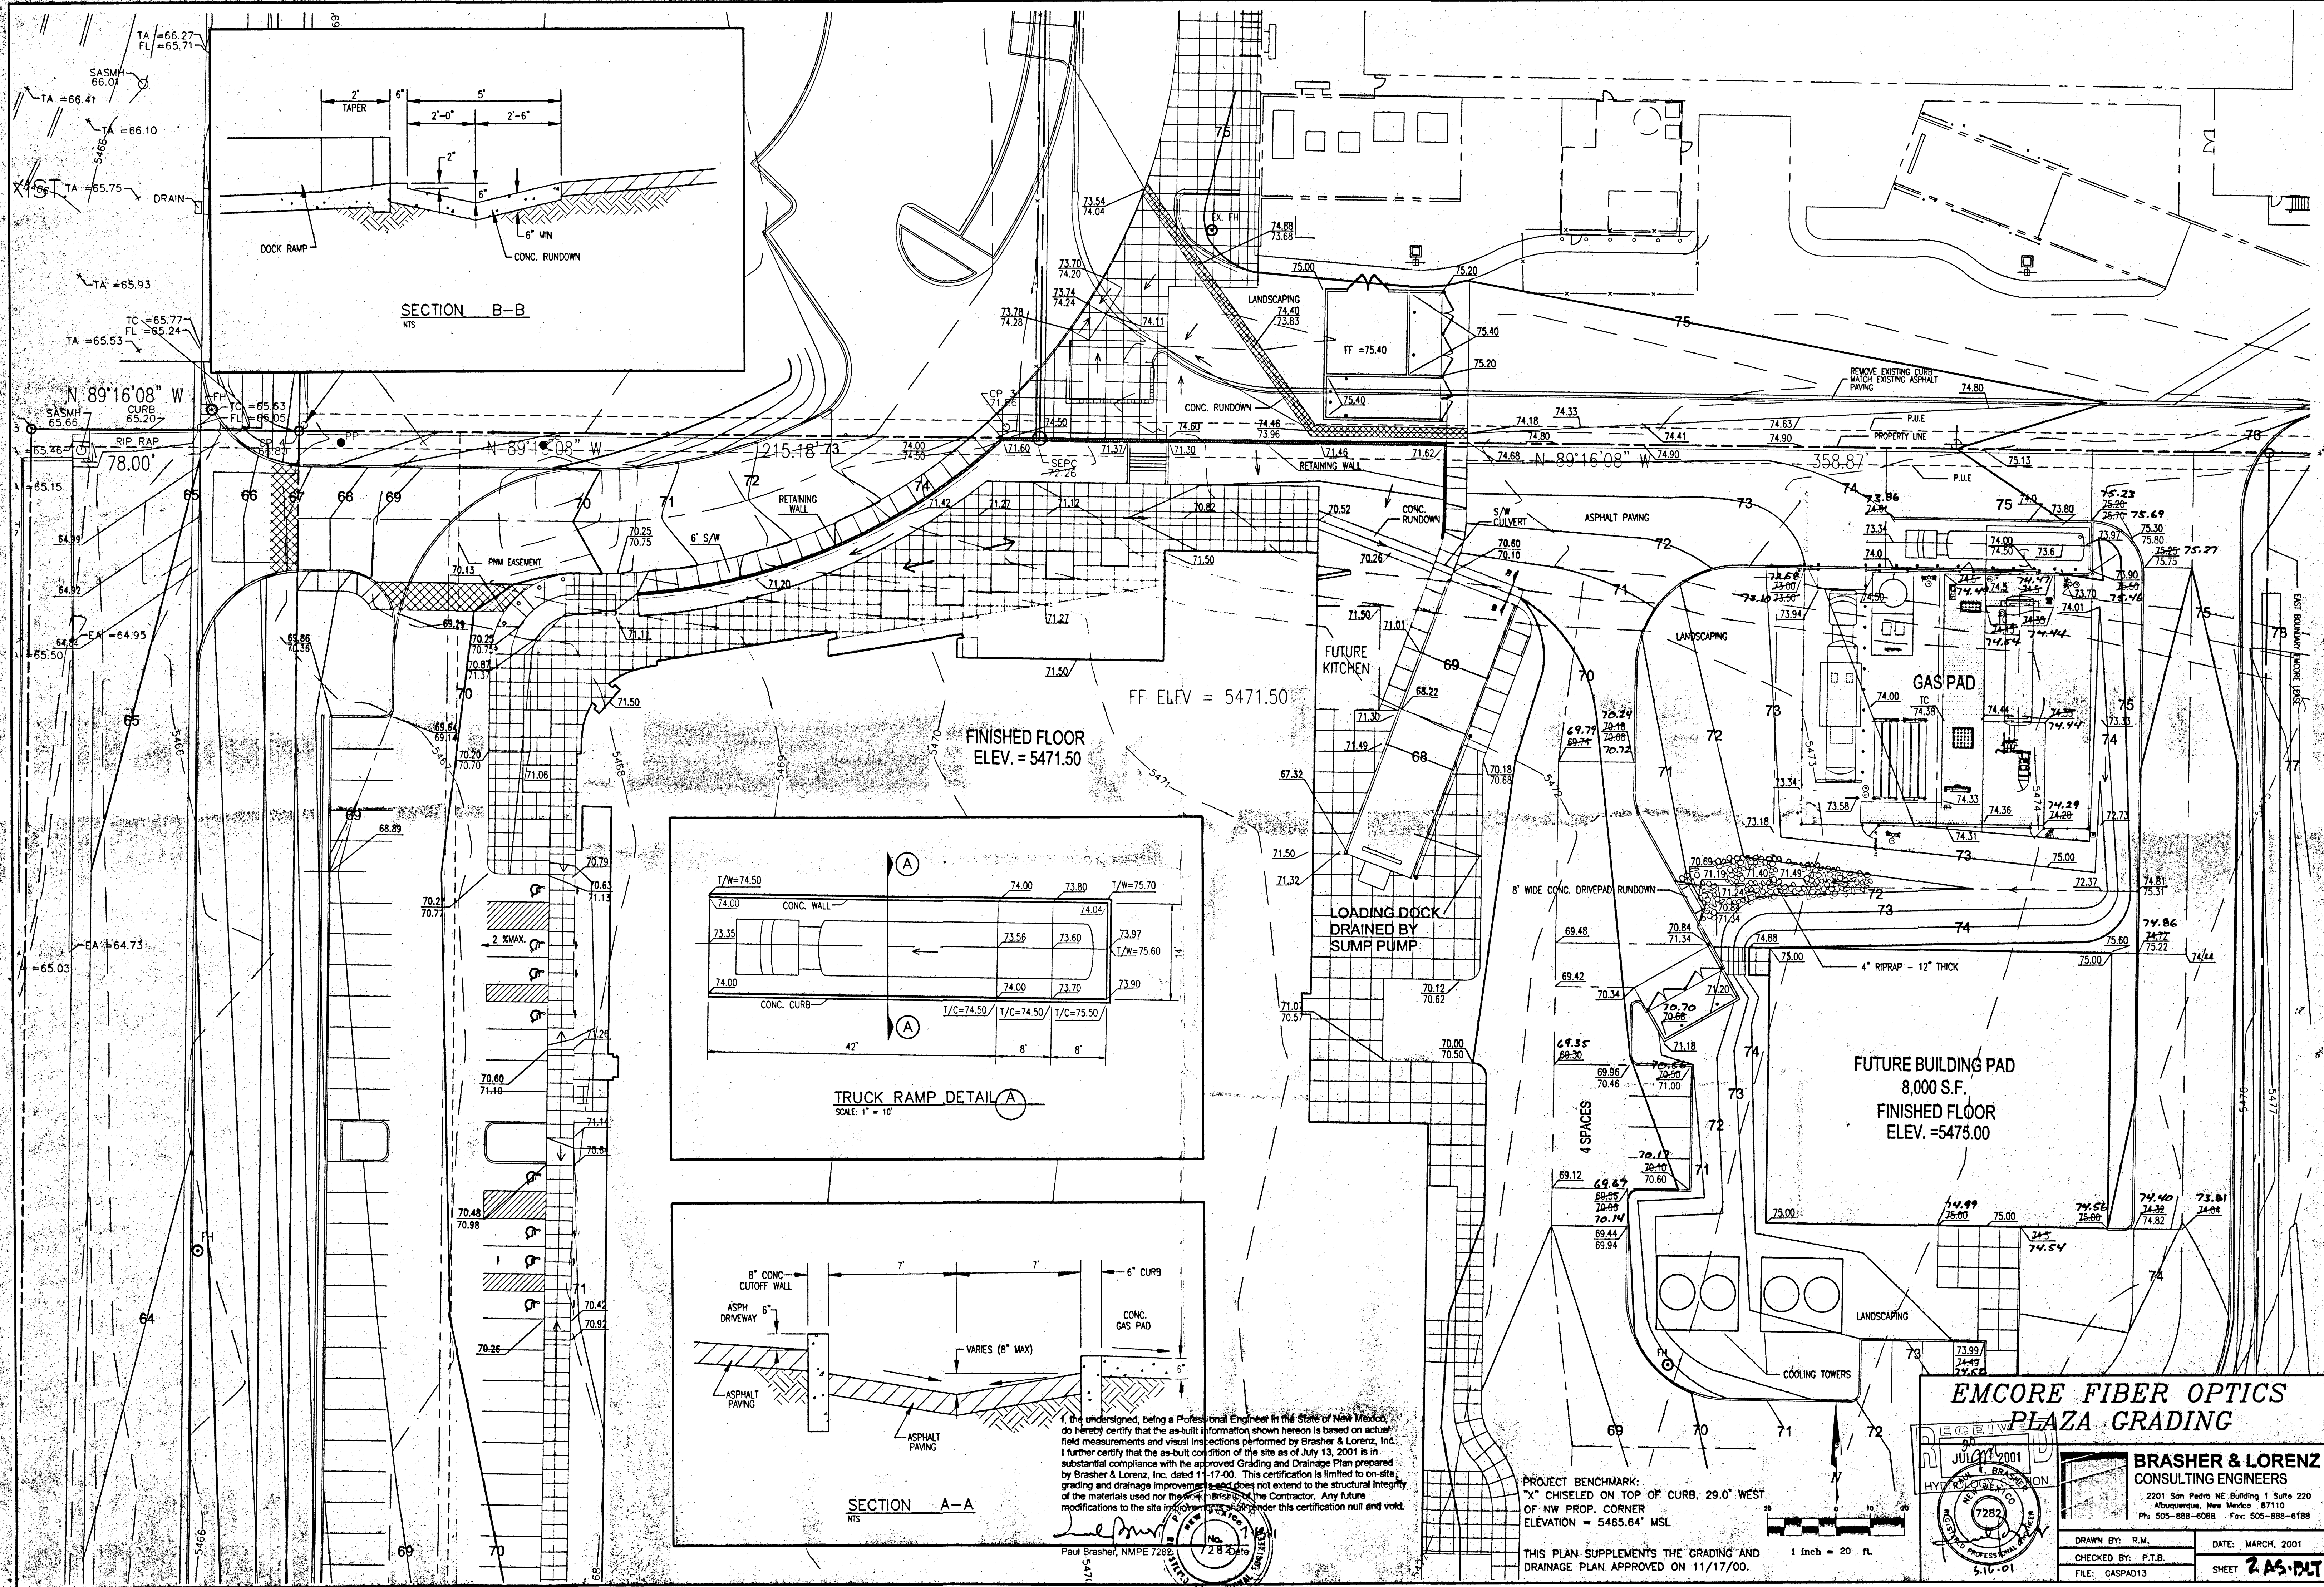

I, the undersigned, being a Professional Engineer in the State of New Mexico, do hereby certify that the as-built information shown hereon is based on actual field measurements and visual inspections performed by Brasher & Lorenz, Inc. I further certify that the as-built condition of the site as of July 13, 2001 is in substantial compliance with the approved Grading and Drainage Plan prepared by Brasher & Lorenz, Inc. dated 11-17-00. This certification is limited to on-site grading and drainage improvements and does not extend to the structural integrity of the materials used nor the workmanship of the Contractor. Any future modifications to the site improvements shall render this certification null and void.

Paul Brasher, NMPE 7282  
7282  
PROFESSIONAL ENGINEER


PROJECT BENCHMARK:  
"X" CHISELED ON TOP OF CURB, 29.0' WEST  
OF NW PROP. CORNER  
ELEVATION = 5465.64' MSL

THIS PLAN SUPPLEMENTS THE GRADING AND DRAINAGE PLAN APPROVED ON 11/17/00.

**EMCORE FIBER OPTICS  
PLAZA GRADING**


**BRASHER & LORENZ  
CONSULTING ENGINEERS**  
2201 San Pedro NE Building 1 Suite 220  
Albuquerque, New Mexico 87110  
Ph: 505-888-6088 Fax: 505-888-6188

DRAWN BY: R.M.	DATE: MARCH, 2001
CHECKED BY: P.T.B.	
FILE: GASPAD13	SHEET <b>2 AS-BLT</b>

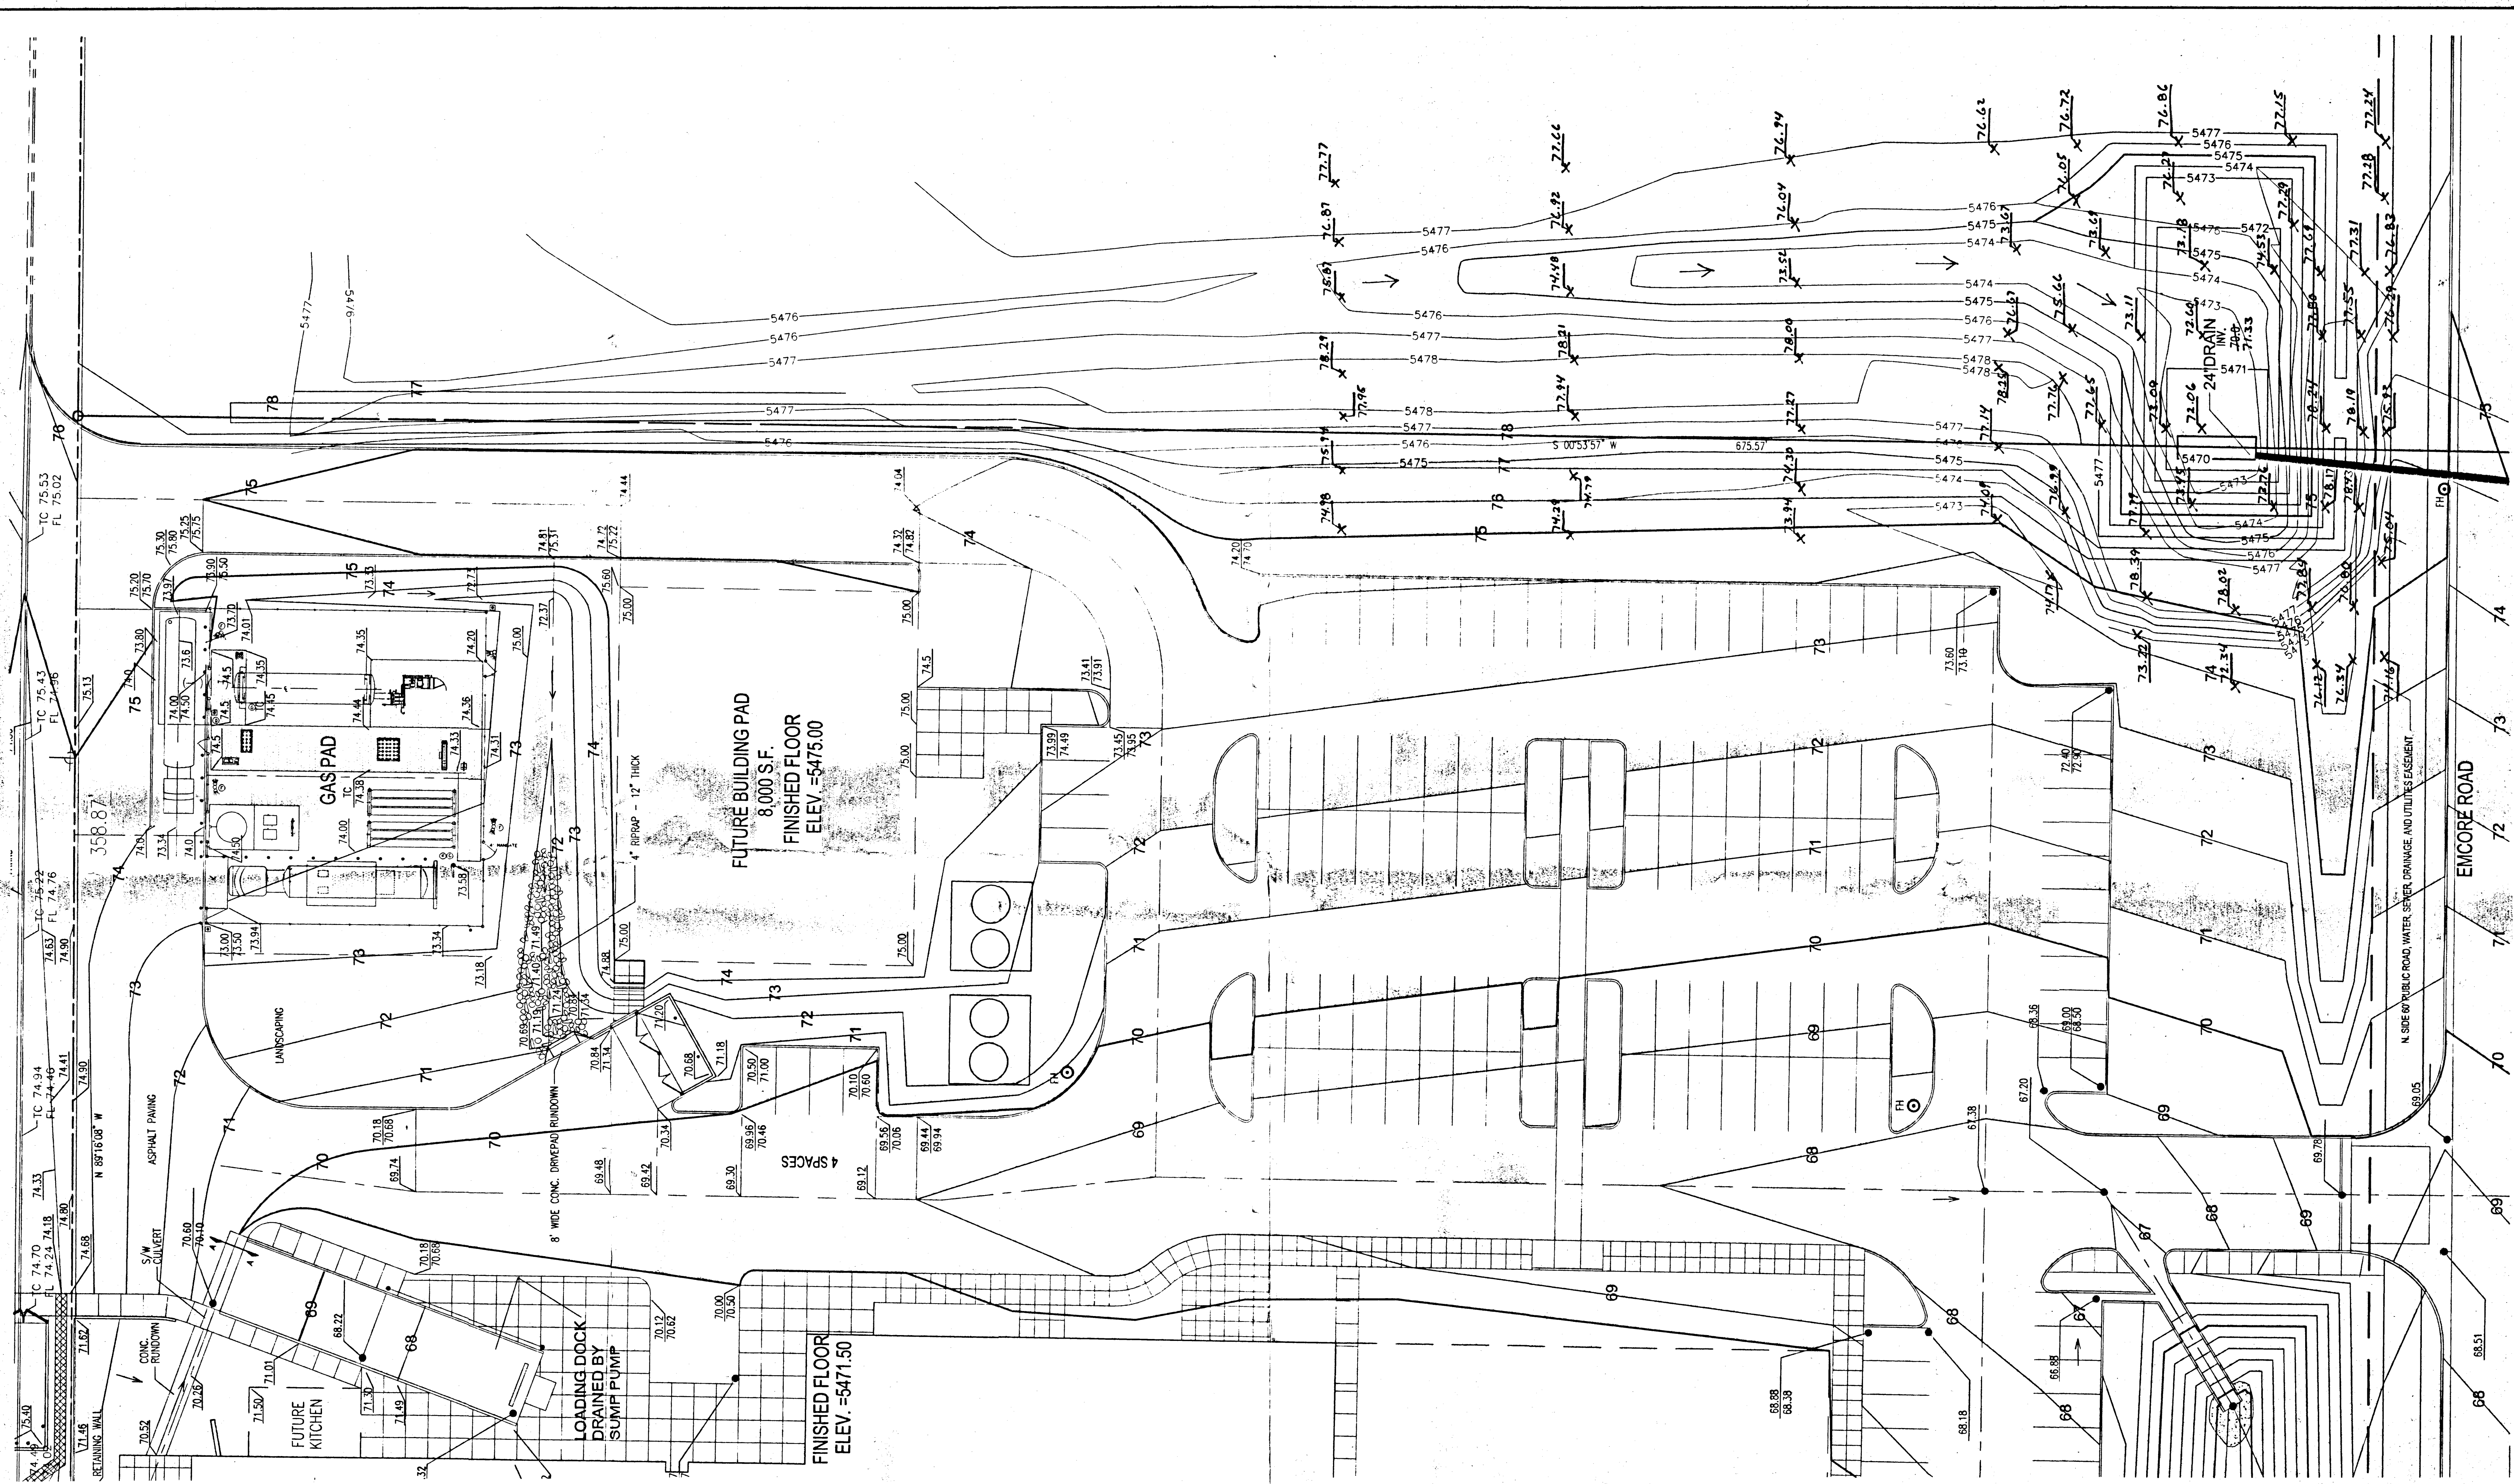

I, the undersigned, being a Professional Engineer in the State of New Mexico, do hereby certify that the as-built information shown hereon is based on actual field measurements and visual inspections performed by Brasher & Lorenz, Inc. I further certify that the as-built condition of the site as of July 13, 2001 is in substantial compliance with the approved Grading and Drainage Plan prepared by Brasher & Lorenz, Inc. dated 11-17-00. This certification is limited to on-site grading and drainage improvements and does not extend to the structural integrity of the materials used for the workmanship of the Contractor. Any future modifications to the site improvements shall be the responsibility of the Contractor.


*Paul Brasher*  
 Paul Brasher, NMPE 7282

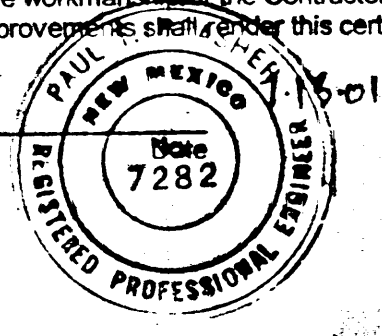

THIS PLAN SUPPLEMENTS THE GRADING AND DRAINAGE PLAN APPROVED ON 11/17/00

**PROJECT BENCHMARK**

"X" CHISEL ON TOP CURB, 29.0 FEET WEST OF NORTHWEST PROPERTY CORNER ELEVATION = 5465.64 FEET

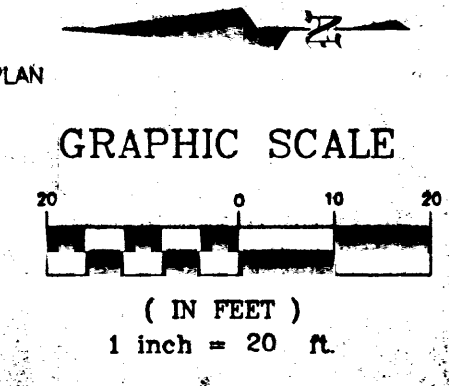

**EMCORE**  
 FIBER OPTICS  
 GRADING PLAN

HYDROLOGY SECTION

**BRASHER & LORENZ**  
 CONSULTING ENGINEERS


2201 San Pedro NE Building 1 Suite 220  
 Albuquerque, New Mexico 87110  
 PH: 505-888-6088 Fax: 505-888-6188

DRAWN BY: R.M.  
 CHECKED BY: P.T.B.  
 FILE: GASPAD11

DATE: MARCH, 2001  
 SHEET: 5 OF 10

RECEIVED  
NOV 17 2000  
HYDROLOGY SECTION

**BRASHER & LORENZ**  
CONSULTING ENGINEERS  
2201 San Pedro NE Building 1 Suite 220  
Albuquerque, New Mexico 87110  
Ph: 505-888-5088 Fax: 505-888-6188

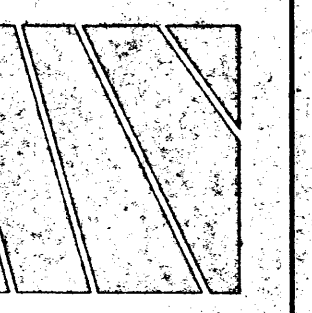


EMCORE III  
ALBUQUERQUE, NEW MEXICO

GRADING AND DRAINAGE  
PLAN

REVISIONS:	CHECKED BY: PTB
	DRAWN BY: LAN
	JOB NO: 00530
	FILE NO: EUBANK.DWG
	SHEET NO: 1 OF 1


- Drainage Plan Notes:
1. BLI recommends that the Owner obtain a Geotechnical Evaluation of the on-site soils for foundation / structural design.
  2. This Plan recommends positive drainage away from all structures to prohibit ponding of runoff which may cause structural settlement. Future alteration of grades adjacent to the proposed structures is not recommended.
  3. Irrigation within 10 feet of any proposed structure is not recommended. Introduction of irrigation water into subsurface soils adjacent to the structure could cause settlement.
  4. This Plan is prepared to establish on-site drainage and grading criteria only. BLI assumes no responsibility for subsurface analysis, foundation / structural design, or utility design.
  5. Local codes may require all footings to be placed in natural undisturbed soil. If the Contractor plans to place footings on engineered fill, a certification by a registered Professional Engineer will be required. If the contractor wishes BLI to prepare the Certification, we must be notified PRIOR to placement of the fill.
  6. BLI recommends that the Owner obtain the services of a Geotechnical Engineer to test and inspect all earthwork aspects of the project.
  7. The property boundary shown on this Plan is given for information only to describe the project limits. Property boundary information shown herein does not constitute a boundary survey. A boundary survey performed by a licensed New Mexico Registered Professional Surveyor is recommended prior to construction.

- TEMPORARY EROSION CONTROL PLAN
1. The intent of the Temporary Erosion Control Plan is to limit the discharge of sediment into the public street and / or storm drainage system and to protect adjacent properties from flooding and sedimentation.
  2. The contractor shall submit a Temporary Erosion Control Plan and obtain a Tapered Disturbance Permit from Environmental Health prior to performing any earthwork-related excess runoff during construction.
  3. After the initial site clearing, the temporary erosion control facilities should be constructed per the Plan to direct excess runoff and sediment the outfall locations.
  4. The Temporary Erosion Control Plan consists of the placement of swales earthen erosion control berms or silt fencing along the downstream project boundaries that will direct runoff and sediment to the proposed detention ponds located at the west end of Phase II and the south end of Phase I.
  5. It is the Contractor's responsibility to properly maintain all temporary erosion control facilities during the construction phase of the project.

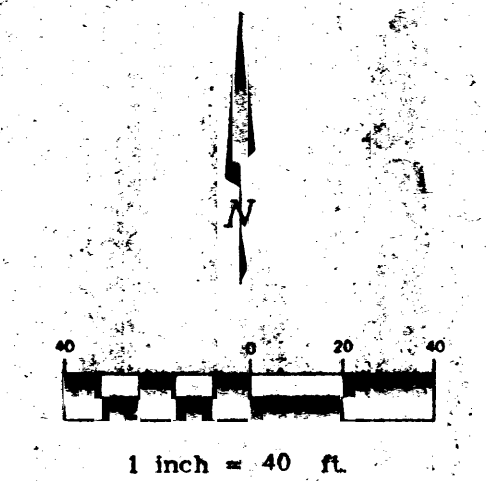

- KEYED NOTES:
- A DETENTION POND (PRIVATE)
  - B 6" CONCRETE HEADER CURB
  - C 6" CONCRETE SIDEWALK
  - D 8" CONCRETE SIDEWALK
  - E ASPHALT PAVING
  - F HANDICAP RAMP
  - G FUTURE STD. CURB AND GUTTER
  - H TRANSITION FROM 8" TO 6" CURB
  - I FUTURE EUBANK PAVING
  - J BERM
  - K 30' WIDTH ENTRANCE
  - L EXISTING TEMPORARY EUBANK PAVING (10' WIDTH)
  - M TEMPORARY ACCESS TO EXISTING PAVING
  - N CONSTRUCT NEW DROP INLET
  - O RETAINING WALL
  - P CONCRETE RUNDOWN
  - Q LANDSCAPED AREA
  - R FUTURE PAVED ACCESS TO ADJACENT PROPERTY
  - S 10" ASPHALT PATH
  - T OUTSIDE LIMIT OF PHASE I CONSTRUCTION
  - U LOADING DOCK RAMP

- LEGEND
- 60C1 --- EXISTING CONTOUR ELEVATION
  - 02.5 x --- EXISTING SPOT ELEVATION
  - 01 --- PROPOSED CONTOUR ELEVATION
  - PROPERTY LINE
  - 01.5 --- PROPOSED SPOT ELEVATION
  - DIRECTION OF FLOW
  - DRAINAGE SWALE
  - DRAINAGE BASIN DIVIDE
  - HEC 2 SECTION I.D.
  - WATER BLOCK

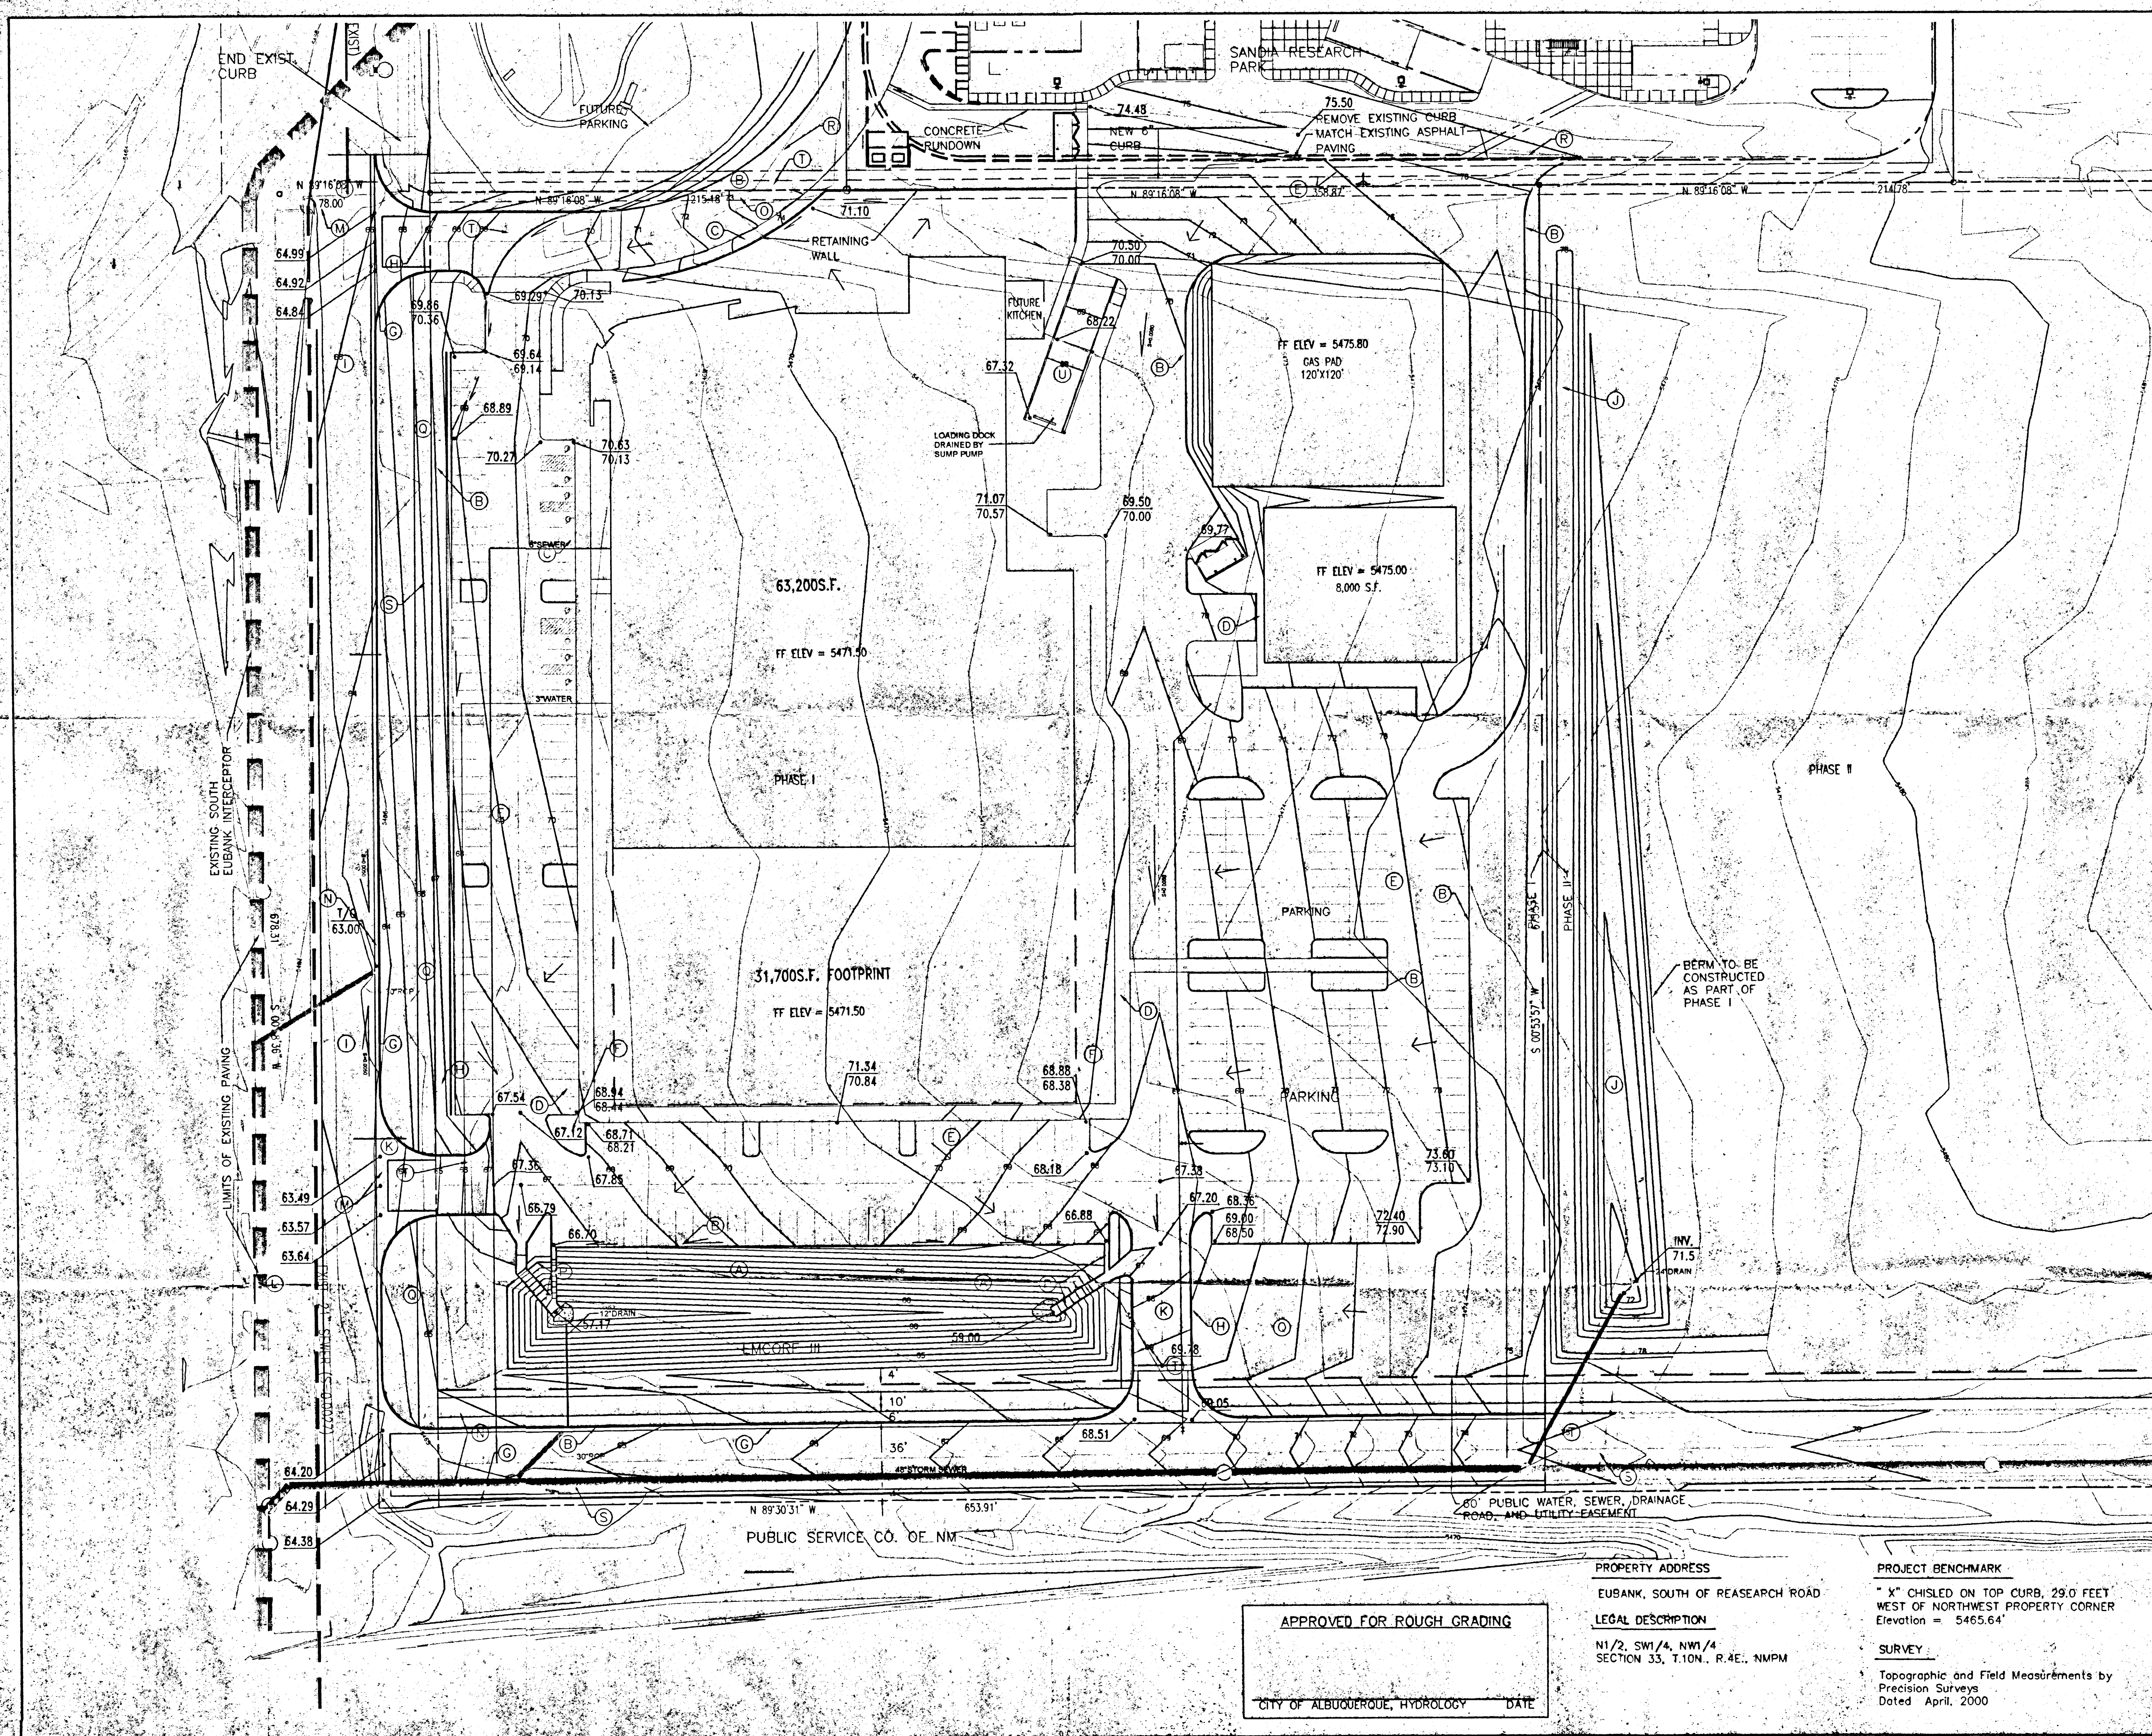

PROPERTY ADDRESS  
EUBANK, SOUTH OF RESEARCH ROAD

LEGAL DESCRIPTION  
N1/2, SW1/4, NW1/4  
SECTION 33, T.10N., R.4E., NMPM

PROJECT BENCHMARK  
"X" CHISLED ON TOP CURB, 29.0 FEET  
WEST OF NORTHWEST PROPERTY CORNER  
Elevation = 5465.64'


SURVEY  
Topographic and Field Measurements by  
Precision Surveys  
Dated April, 2000

APPROVED FOR ROUGH GRADING


CITY OF ALBUQUERQUE, HYDROLOGY DATE

# DRAINAGE PLAN NOTES


1. BLI recommends that the Owner obtain a Geotechnical Evaluation of the on-site soils prior to foundation/structural design.
2. This Plan recommends positive drainage away from all structures to prohibit ponding of runoff which may cause structural settlement. Future alteration of grades adjacent to the proposed structures is not recommended.
3. Irrigation within 10 feet of any proposed structure is not recommended. Introduction of irrigation water into subsurface soils adjacent to the structure could cause settlement.
4. This Plan is prepared to establish on-site drainage and grading criteria only. BLI assumes no responsibility for subsurface analysis, foundation/structural design, or utility design.
5. Local codes may require all footings to be placed in natural undisturbed soil. If the Contractor plans to place footings on engineered fill, a certification by a registered Professional Engineer will be required. If the contractor wishes BLI to prepare the Certification, we must be notified PRIOR to placement of the fill.
6. BLI recommends that the Owner obtain the services of a Geotechnical Engineer to test and inspect all earthwork aspects of the project.
7. The property boundary shown on this Plan is given for information only to describe the project limits. Property boundary information shown hereon does not constitute a boundary survey. A boundary survey performed by a licensed New Mexico Registered Professional Surveyor is recommended prior to construction.

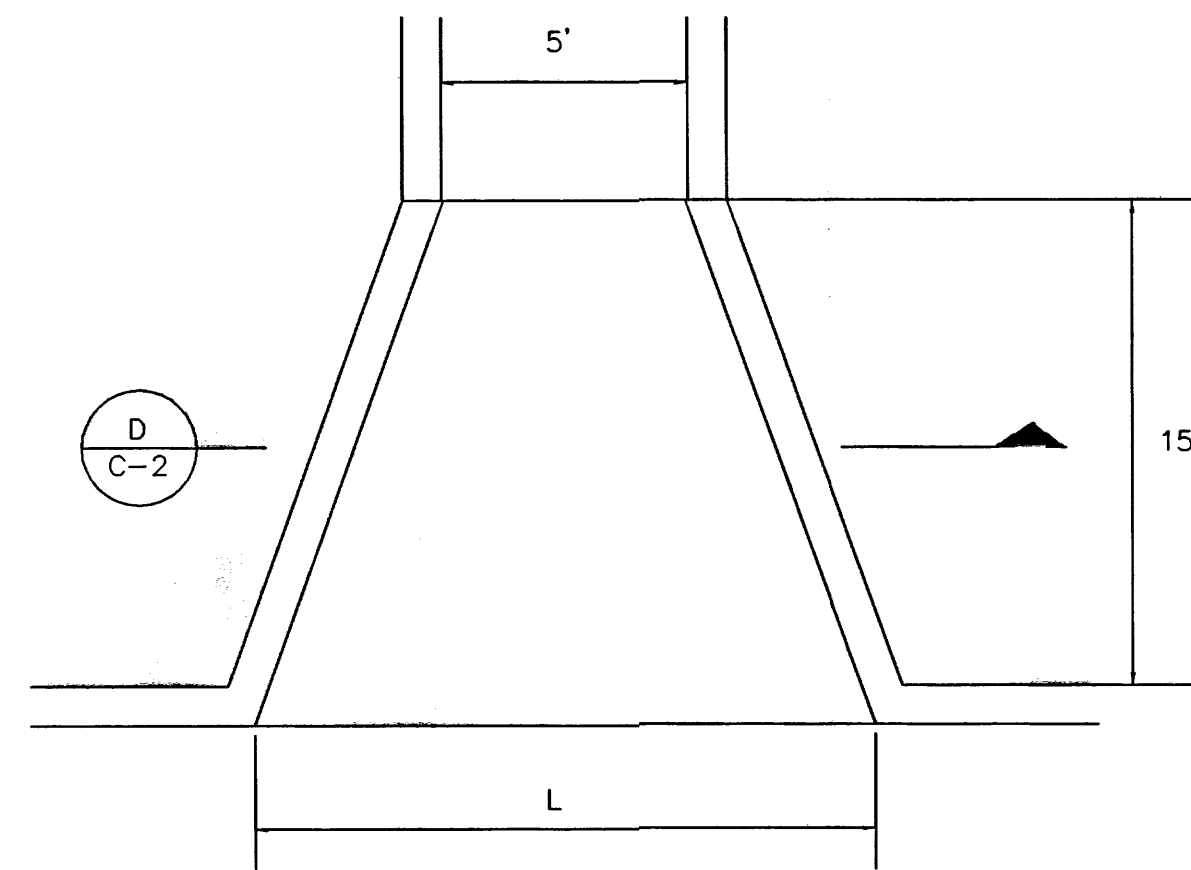


RUNDOWN INLET DETAIL  
NTS E C-2

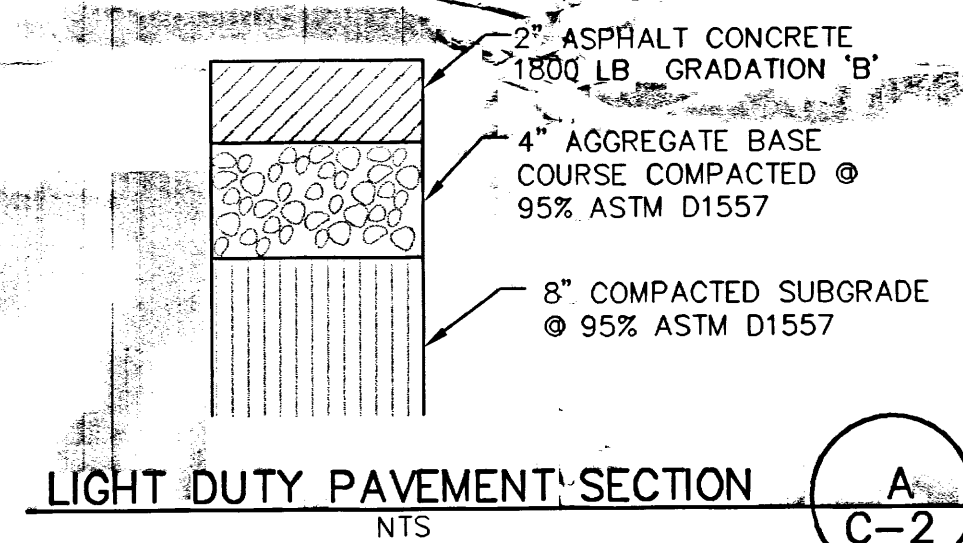


LIGHT DUTY PAVEMENT SECTION  
NTS A C-2

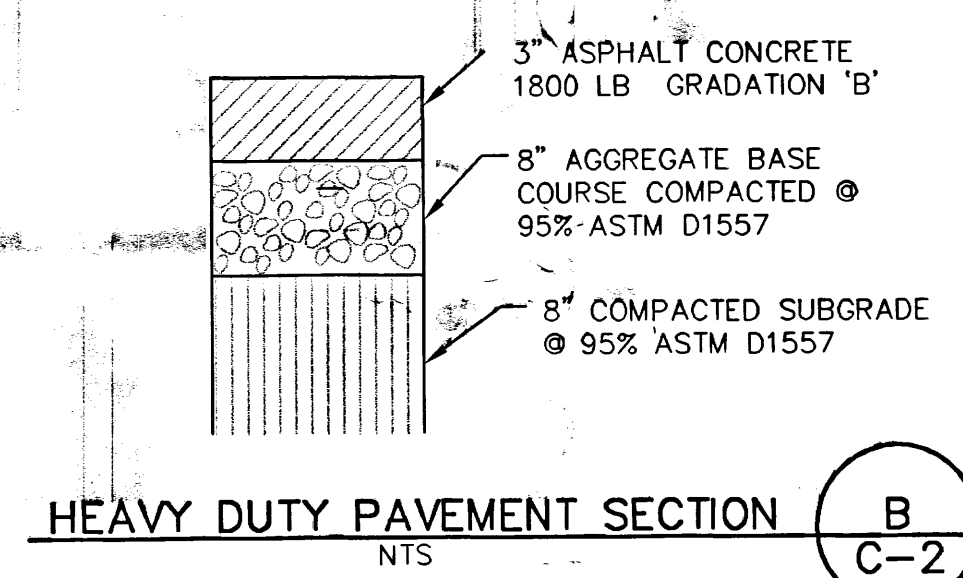


HEAVY DUTY PAVEMENT SECTION  
NTS B C-2

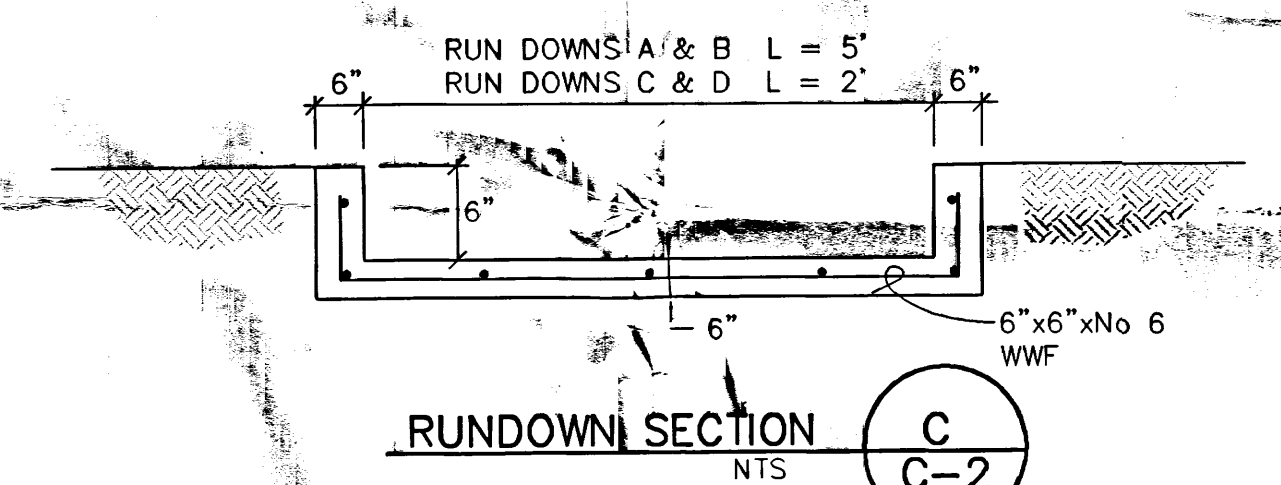


RUNDOWN SECTION  
NTS C C-2

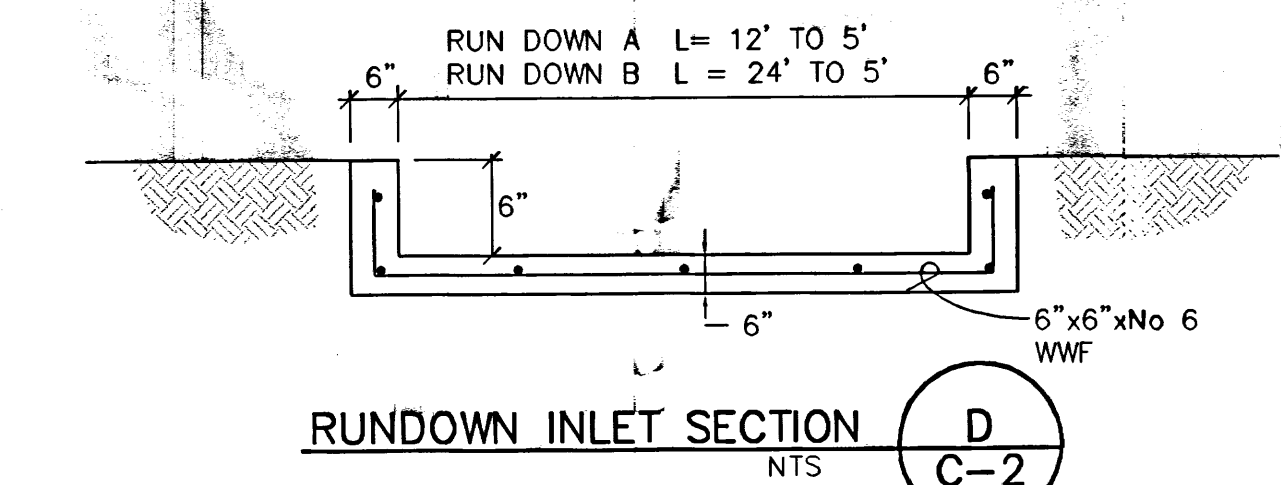


RUNDOWN INLET SECTION  
NTS D C-2

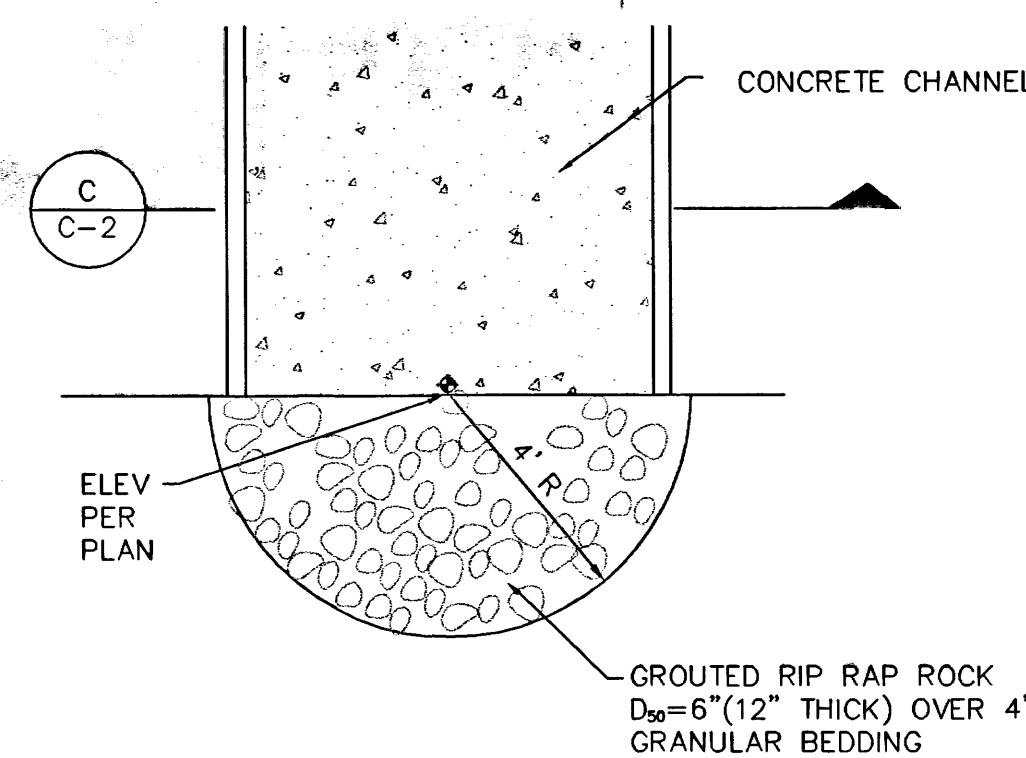


EROSION CONTROL PAD  
NTS F C-2

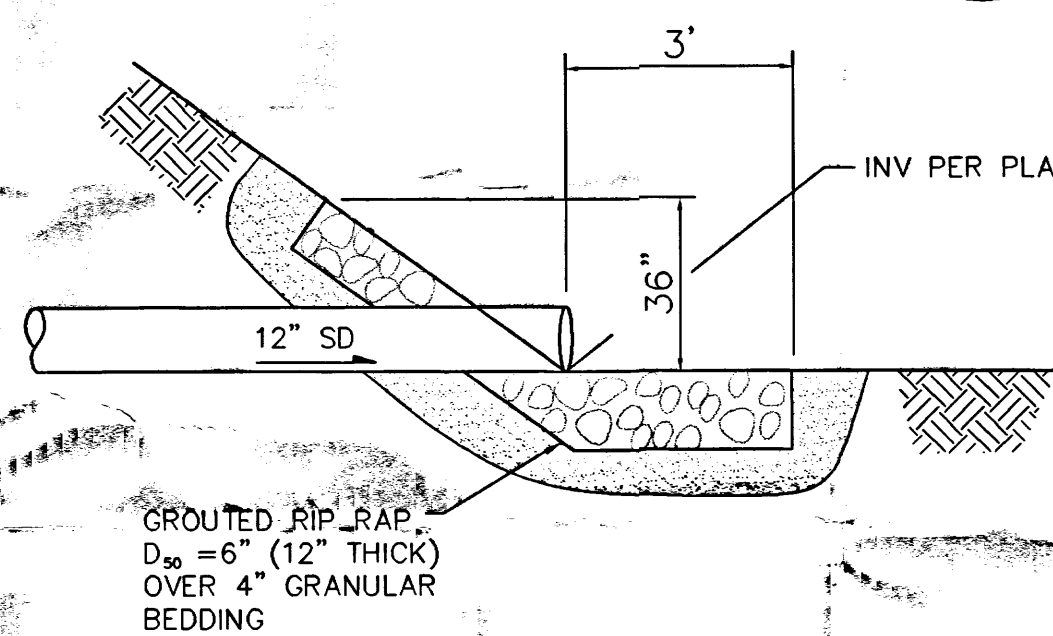


EROSION CONTROL PAD SECTION @ POND OUTLET  
NTS G C-2

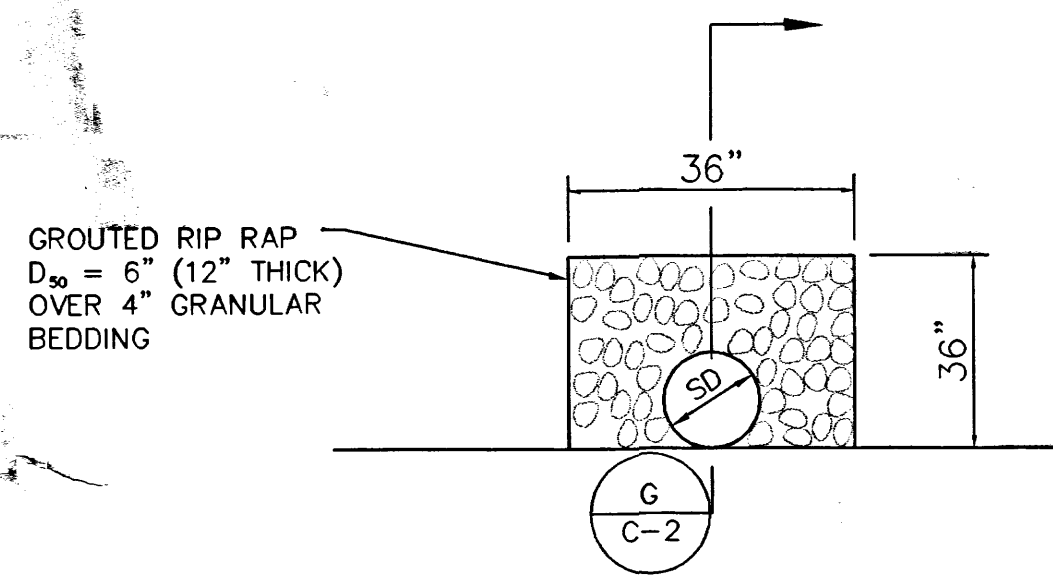


EROSION CONTROL PAD  
NTS H C-2

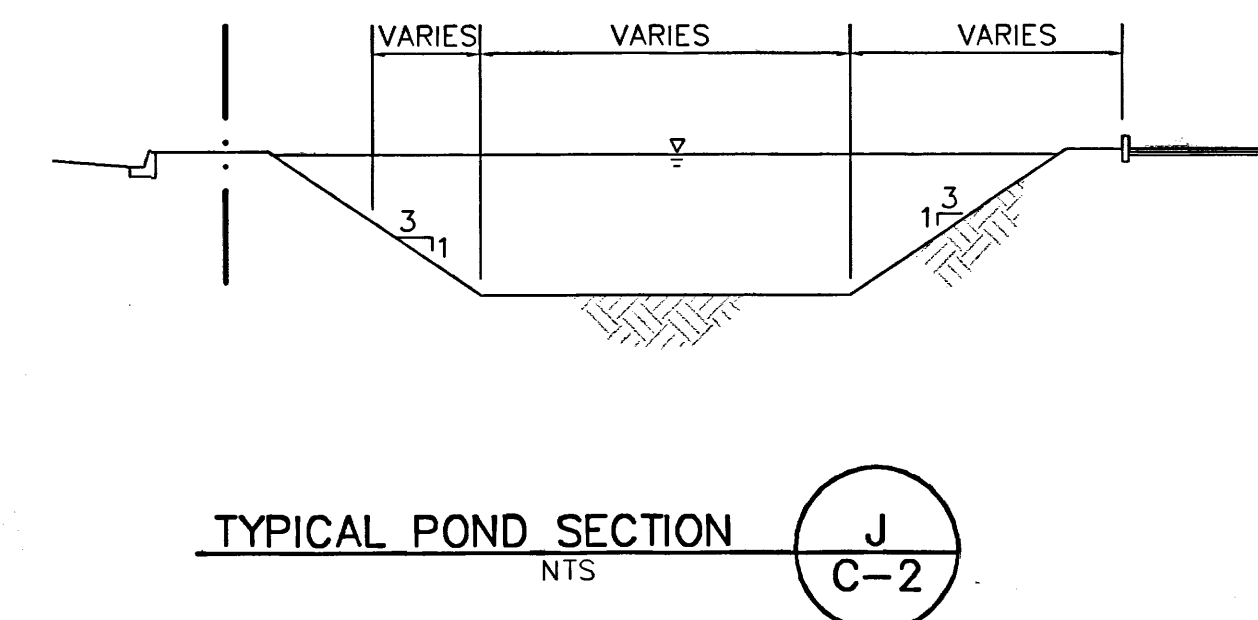


TYPICAL POND SECTION  
NTS J C-2

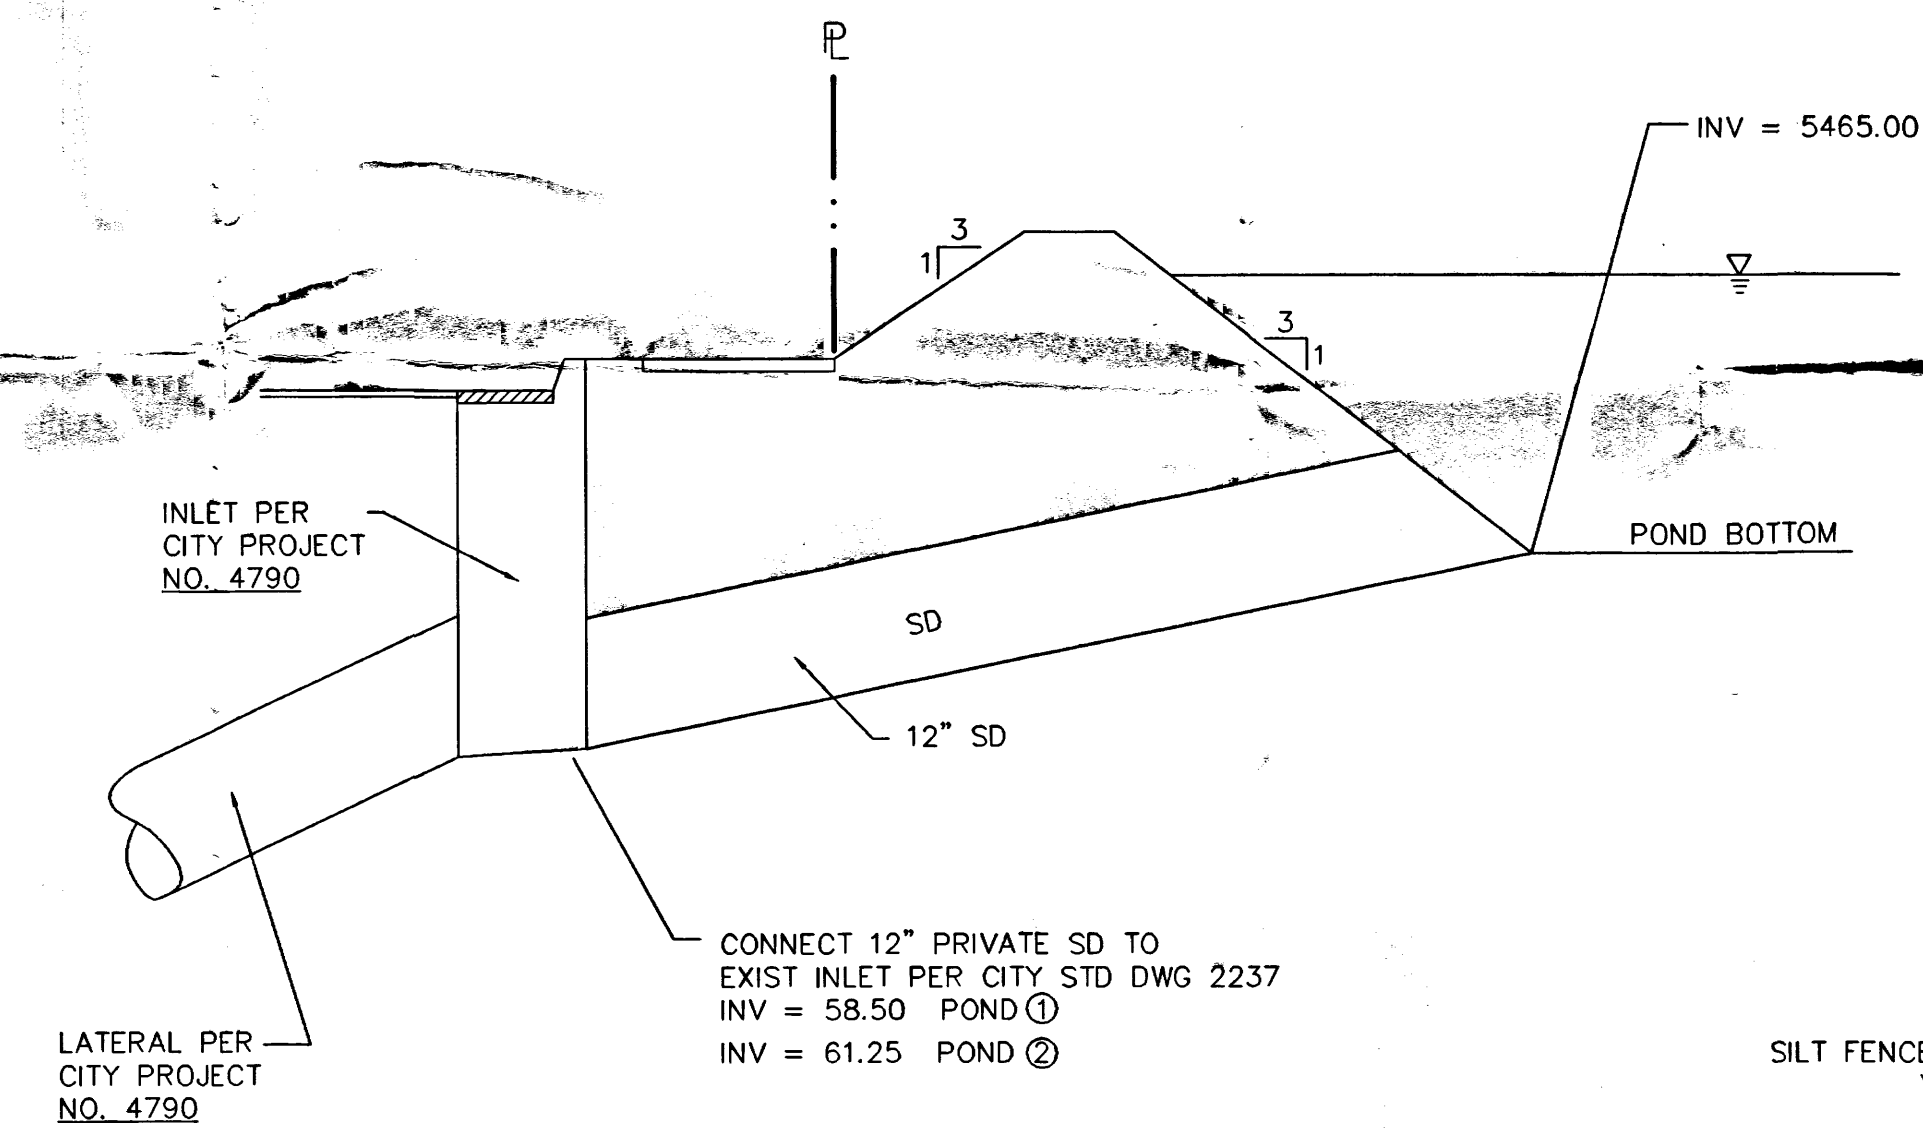


POND OUTLET DETAIL  
NTS K C-2

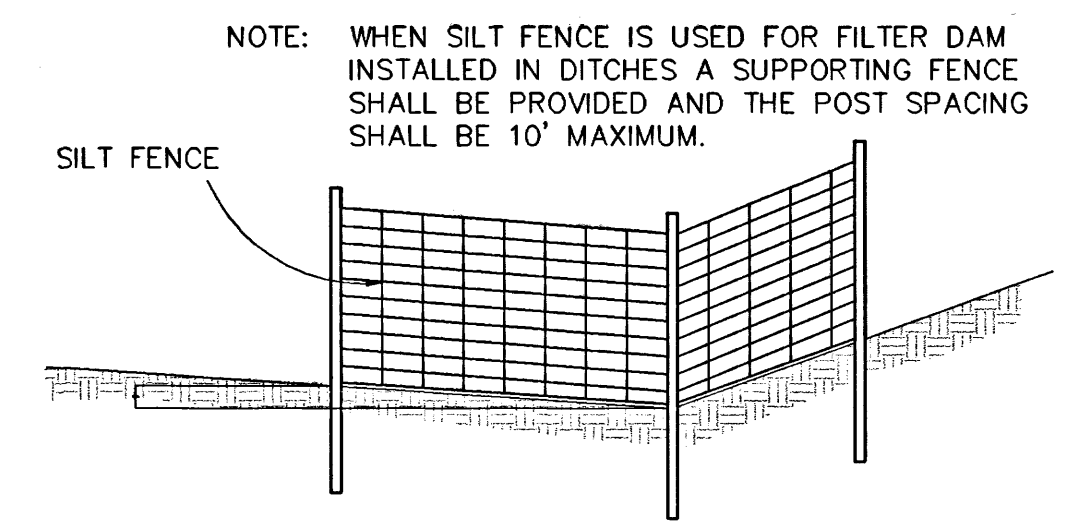

ELEVATION - FILTER DAM  
(SILT FENCE OPTION) M C-2

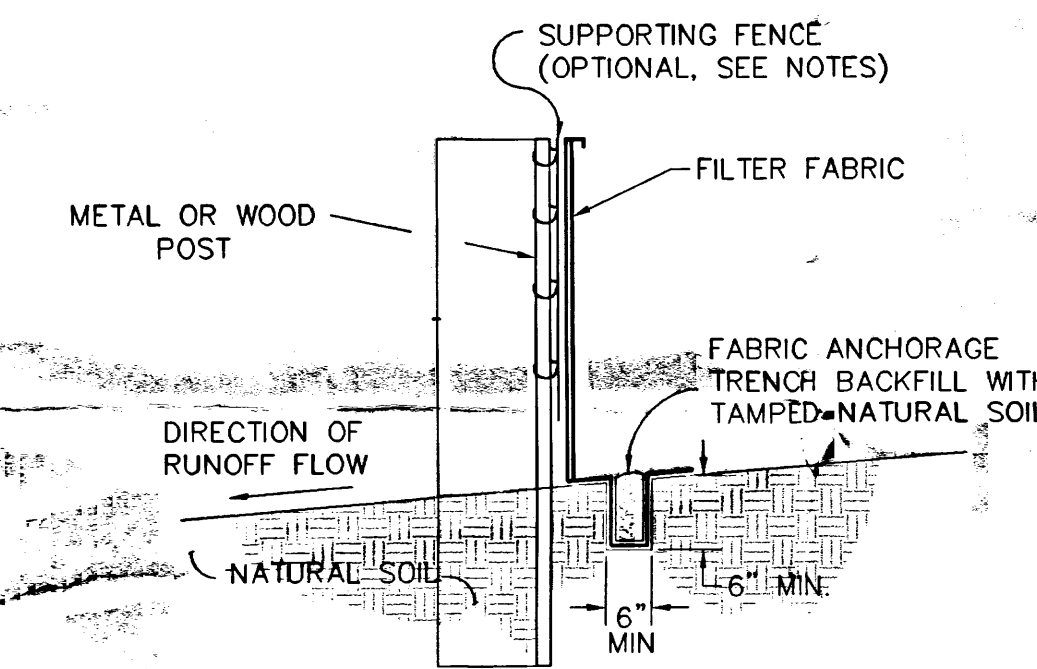

ELEVATION - FILTER DAM  
(SILT FENCE OPTION) L C-2

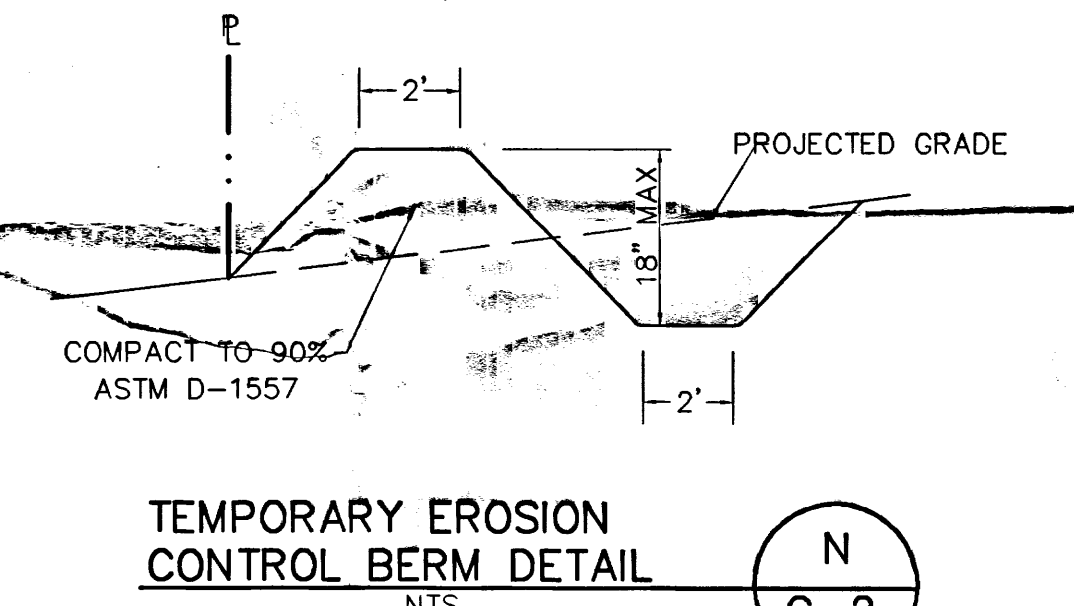

TEMPORARY EROSION  
CONTROL BERM DETAIL N C-2

**Dekker/Perich/Sabatini**  
architecture • interiors • planning • engineering  
6801 Jefferson NE, Suite 100 Albuquerque, NM 87109  
505 761-9700 fax 761-4222 99001 07.01.99

<b>EMCORE III</b> GRADING & DRAINAGE PLAN DETAILS	
	<b>BRASHER &amp; LORENZ</b> CONSULTING ENGINEERS 2201 San Pedro NE Building 1 Suite 220 Albuquerque, New Mexico 87110 Ph: 505-889-6088 Fax: 505-889-6188
	DRAWN BY: M.D.B.II
	CHECKED BY: D.A.L.
	FILE: 00530-DD.DWG
DATE: SEPTEMBER, 2000 SHEET - OF -	