


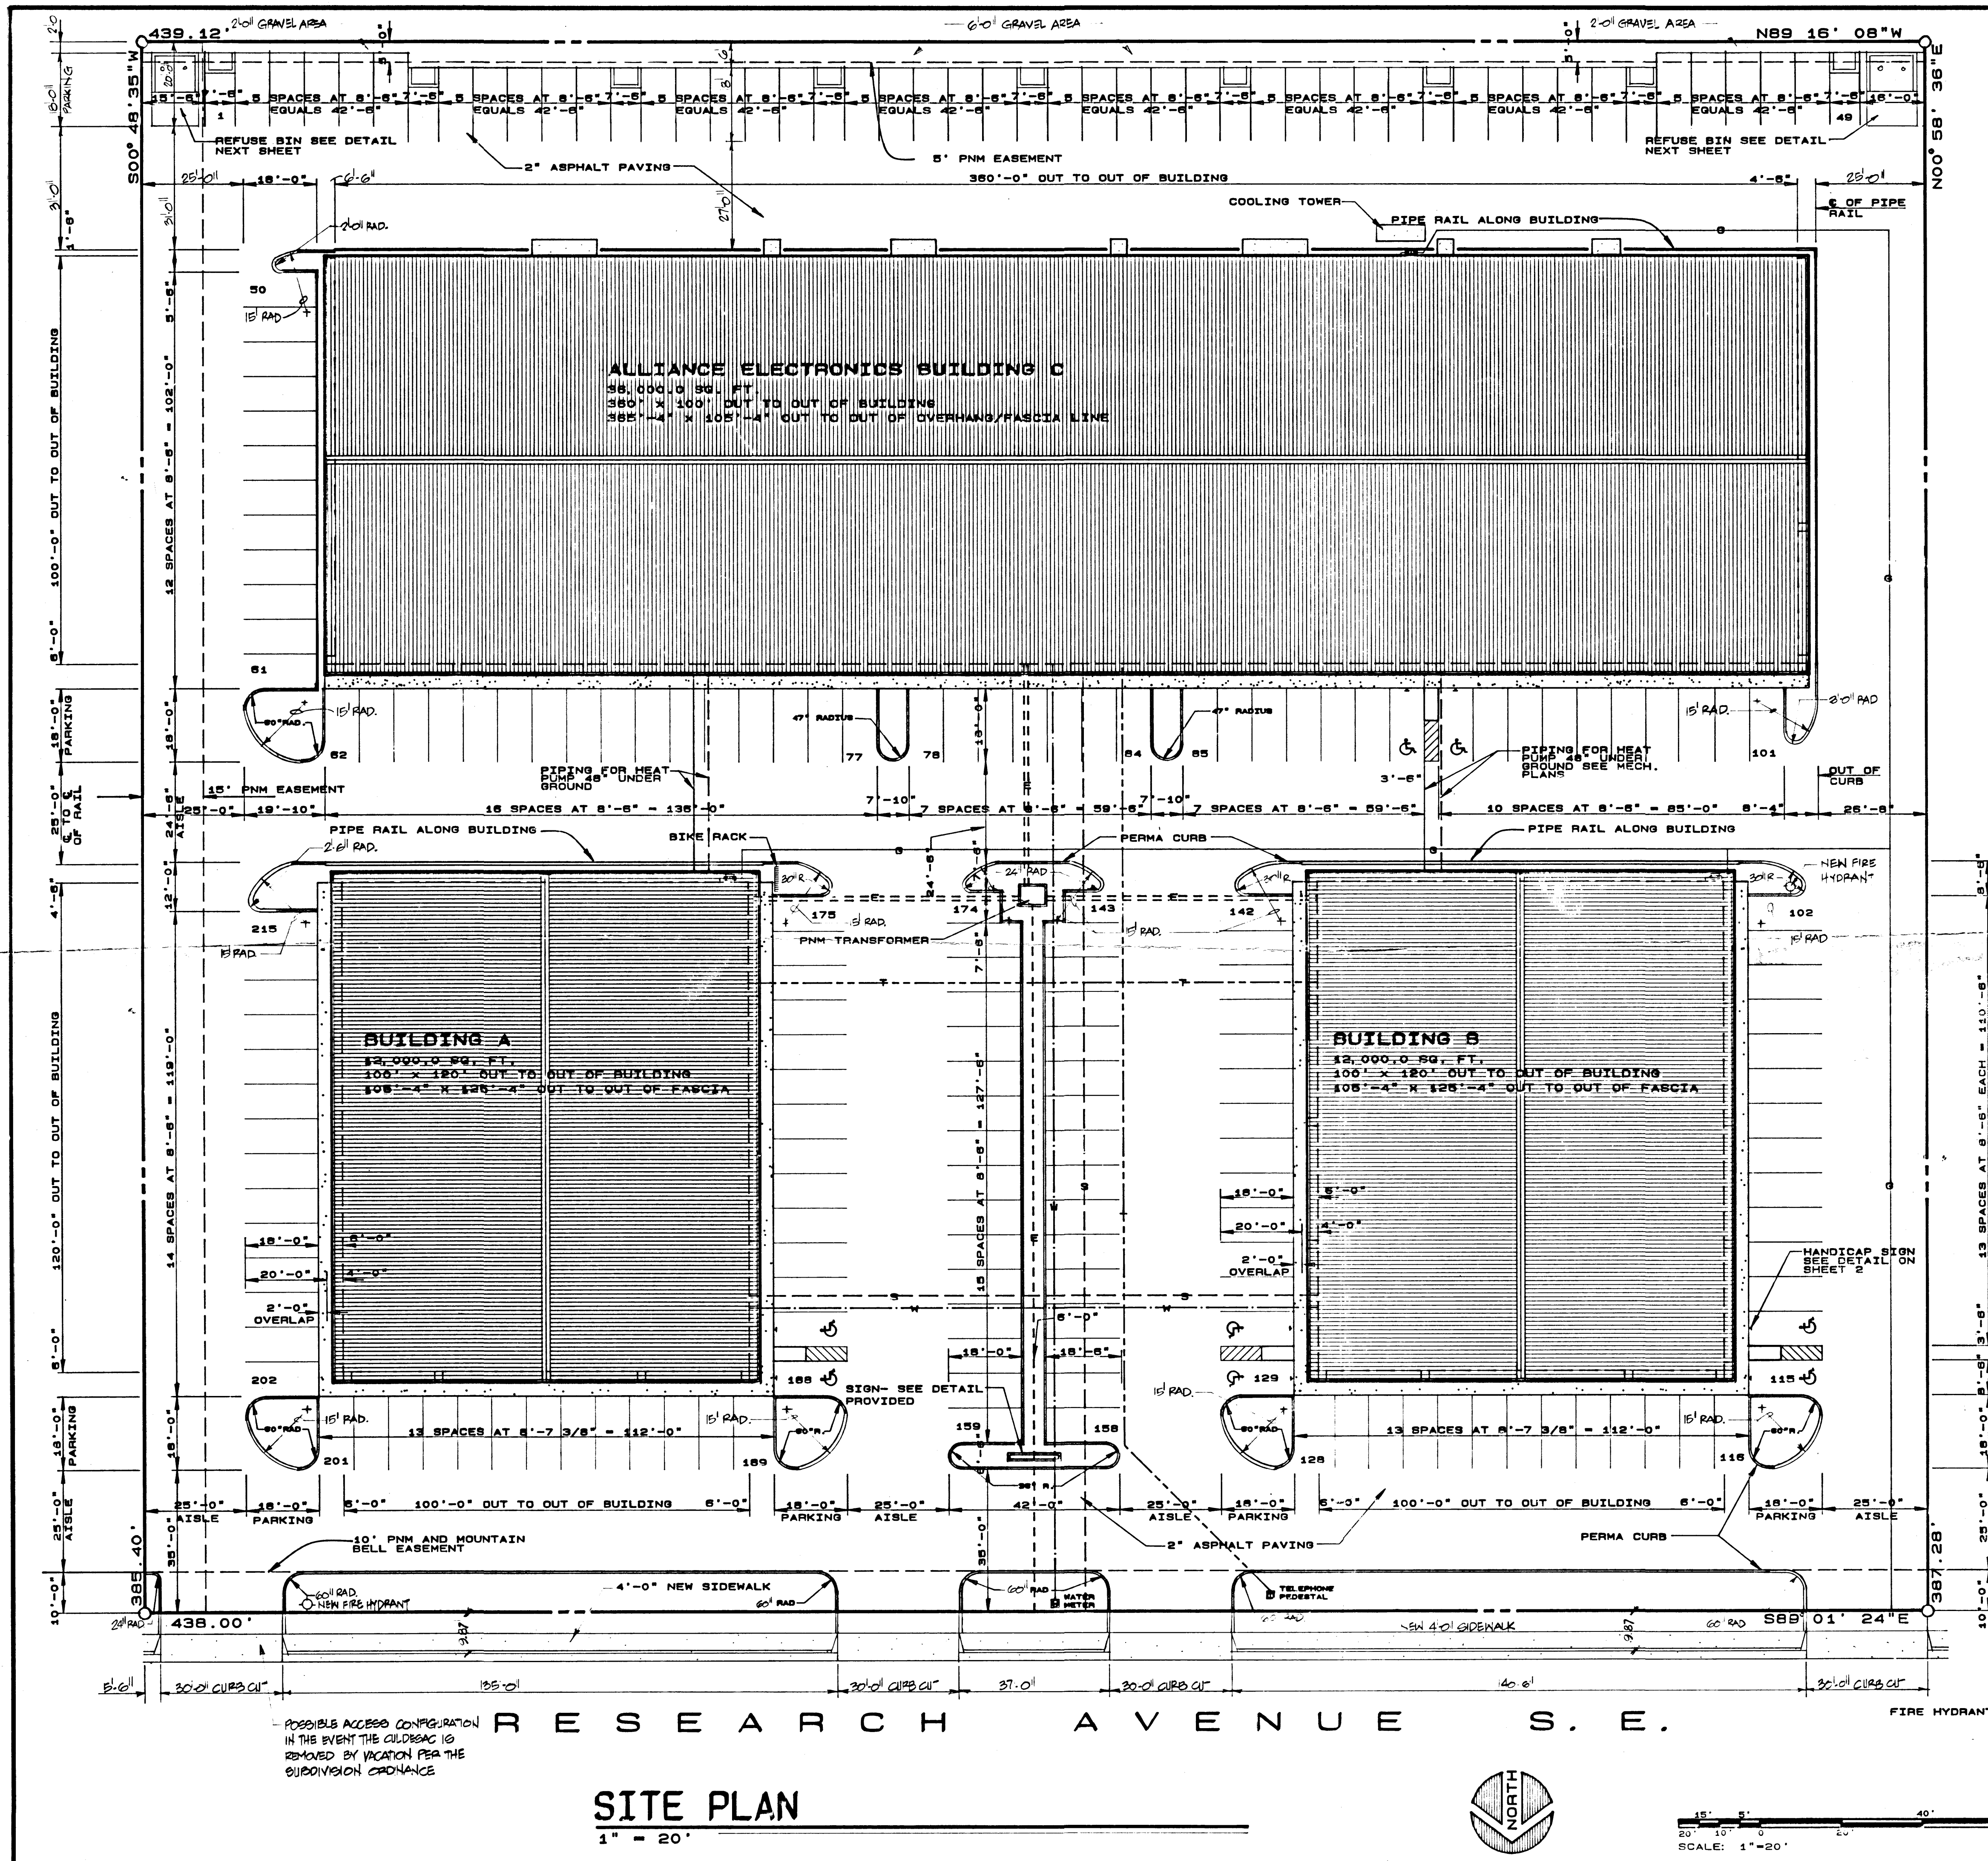


# INDEX TO SHEETS

| SHT. NO. | DESCRIPTION                 |
|----------|-----------------------------|
| 1        | SITE PLAN, INDEX TO SHEETS  |
| 2        | SITE DETAILS, PERMIT DATA   |
| 3        | LANDSCAPE PLAN              |
| 4        | DRAINAGE PLAN               |
| 5        | FOUNDATION PLAN             |
| 6        | FOUNDATION PLAN             |
| 7        | FOUNDATION DETAILS, NOTES   |
| 8        | STRUCTURAL LAYOUT           |
| 9        | 3/32" FLOOR PLAN            |
| 10       | 1/8" FLOOR PLAN             |
| 11       | 1/8" FLOOR PLAN             |
| 12       | SCHEDULES, MISC. ELEVATIONS |
| 13       | ELEVATIONS                  |
| 14       | SECTIONS                    |
| 15       | PLUMBING PLAN               |
| 16       | PLUMBING PLAN               |
| 17       | MECHANICAL PLAN-PIPING      |
| 18       | MECHANICAL PLAN-PIPING      |
| 19       | MECHANICAL PLAN-HVAC        |
| 20       | MECHANICAL PLAN-HVAC        |
| 21       | ELECTRICAL PLAN             |
| 22       | ELECTRICAL PLAN             |
| 23       | LIGHTING PLAN               |
| 24       | LIGHTING PLAN               |
| 25       | FOUNDATION PLAN BLDG. A & B |
| 26       | FLOOR PLAN BLDG. A & B      |
| 27       | ELEVATIONS BLDG. A & B      |
| 28       | UTILITY PLAN BLDG. A        |
| 29       | HVAC PLAN BLDG. A           |
| 30       | UTILITY PLAN BLDG. B        |
| 31       | HVAC PLAN BLDG. B           |

SIGNATURE BLOCK Z-80-96-2  
 DEVELOPMENT REVIEW BOARD

I CERTIFY THAT THIS AREA IS ZONED SU-1 AND THIS PLAN IS CONSISTENT WITH THE SPECIFIC DEVELOPMENT PLAN APPROVED BY THE ENVIRONMENTAL PLANNING COMMISSION ON SEPTEMBER 18, 1986.  
 DRB-89-505

*Paul Cloud* 11/3/88  
 CITY PLANNER  
*Paul J. Aguirre* 10/31/88  
 CITY ENGINEER  
*Paul W. Hansen* 10/7/88  
 TRAFFIC ENGINEER  
*William J. White* 10-4-88  
 WATER RESOURCES ENGINEER  
*John M. Stone* 10-4-88  
 PARKS AND RECREATION

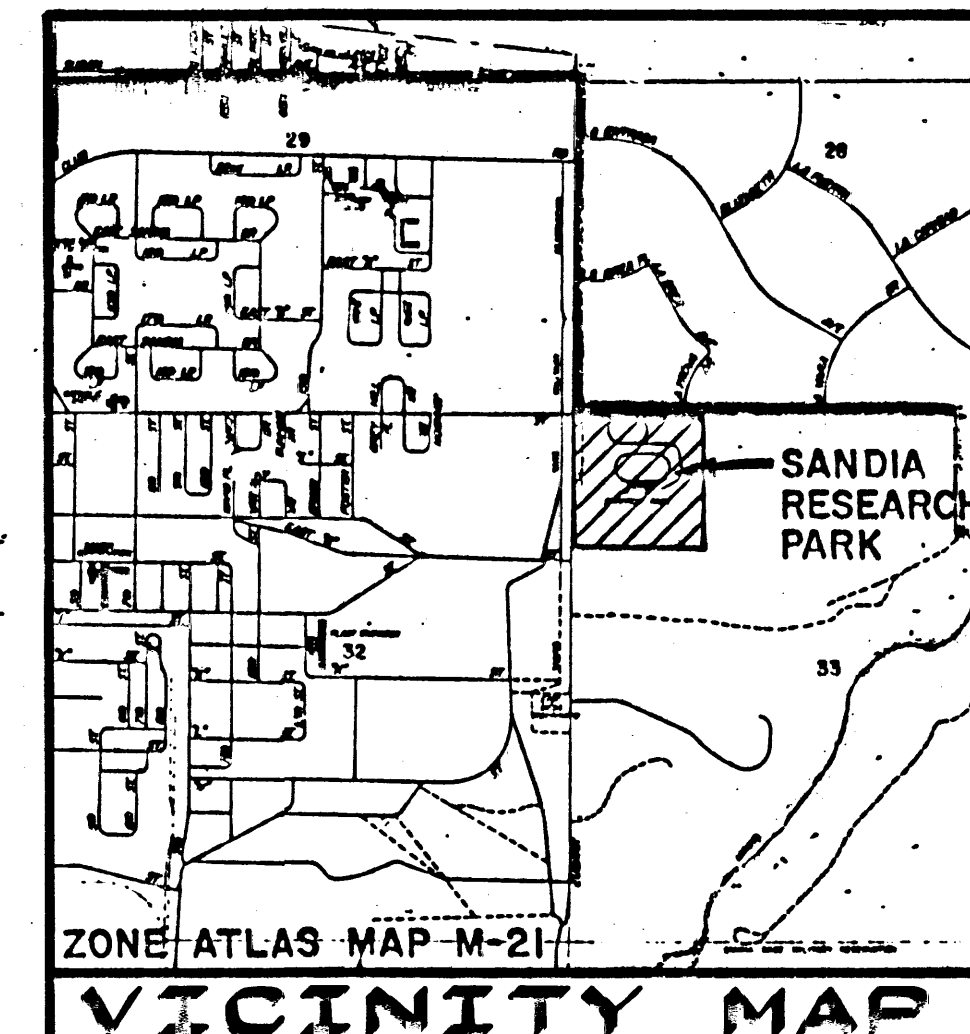

**DURA BILT**  
 PRODUCTS, INC.  
 4808 JEFFERSON N.E.  
 ALBUQUERQUE N.M. 87109  
 (505) 883-9100

**DESIGN/BUILDERS**  
 LICENSE NO. 3044

JOB NO.: 88-129  
 DATE: 6/28/88  
 CONTRACT DATE:  
 DRAWN BY: BWD  
 REVISIONS:


**SANDIA RESEARCH PARK**  
**ALLIANCE ELECTRONICS**  
 10, 510 RESEARCH AVENUE S. E.  
 ALBUQUERQUE, NEW MEXICO 87123

*William J. White*


**SITE PLAN,**  
**INDEX TO SHEETS**  
 SHEET NO.  
**1**  
 JOB NO: 88-129 OF 6

I, PHILIP W. CLARK, REGISTERED PROFESSIONAL ENGINEER, IN THE STATE OF NEW MEXICO, DO HEREBY CERTIFY THAT THE INFORMATION SHOWN IS IN SUBSTANTIAL COMPLIANCE WITH THE APPROVED DRAINAGE REPORT/PLAN.

JUNE 26, 1989.

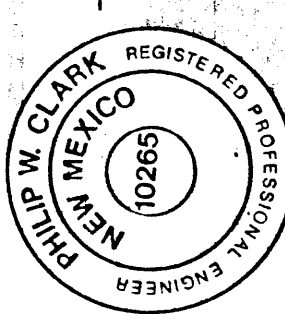

○ = FIELD AS-BUILT ELEV.

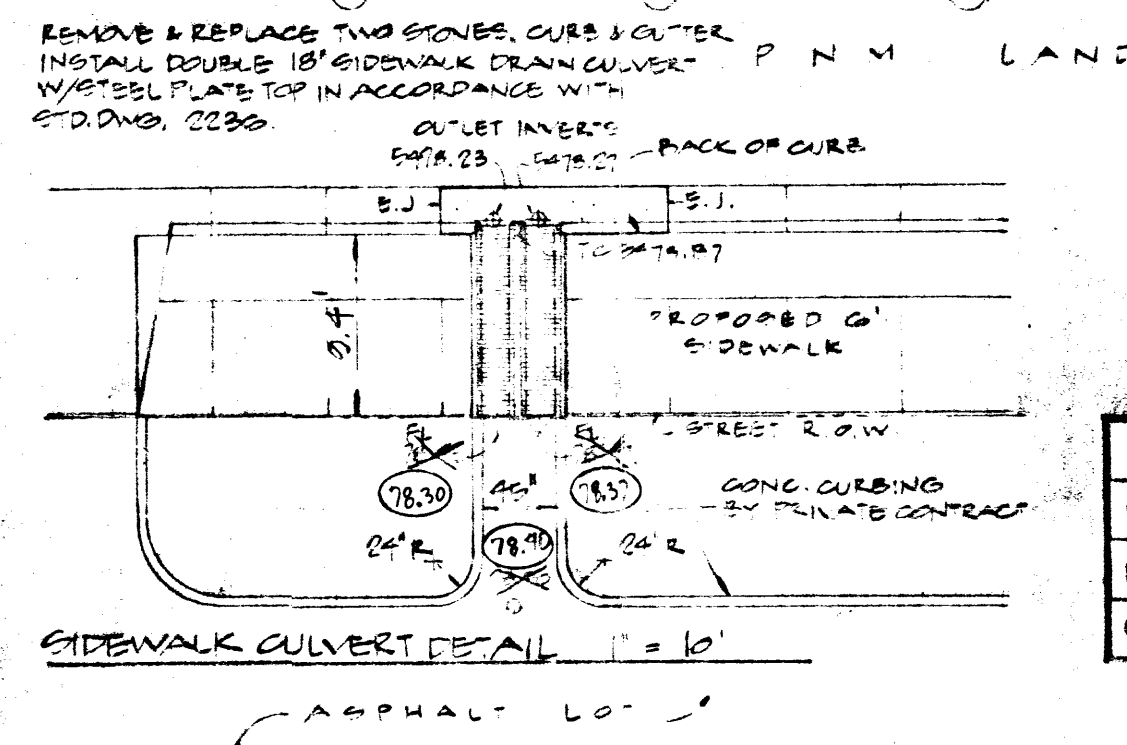

| APPROVALS        | NAME | DATE |
|------------------|------|------|
| HYDROLOGY/DESIGN |      |      |
| INSPECTOR/DESIGN |      |      |
| CONST/ACPT.      |      |      |

**NOTICE TO CONTRACTOR**

- An excavation/construction permit will be required before beginning any work within City right-of-way. An approved copy of these plans must be submitted at the time of application for this permit.
- All work detailed on these plans to be performed, except as otherwise stated or provided hereon, shall be constructed in accordance with "STANDARD SPECIFICATIONS FOR PUBLIC WORKS CONSTRUCTION 1984".
- Two working days prior to any excavation, contractor must contact Line Locating Services, 765-1234, for location of any existing utilities.
- Prior to construction, the contractor shall excavate and verify the horizontal and vertical locations of all obstructions. Should a conflict exist, the contractor shall notify the engineer so that the conflict can be resolved with a minimum of delay.
- Backfill and compaction shall be according to RESIDENTIAL street use.
- Maintenance of this facility shall be the responsibility of the owner served.

**REQUIRED DETENTION**

$$T_d = \frac{2.0 \times 10^{-5} \times C}{10.44 \text{ CFS}} = 3.144 \text{ SECONDS}$$

**VOLUME RELEASED FOR DURATION**

$$= (10.44 \text{ CFS} \times 10.89 \text{ CFS}) \times \frac{3.144 \times 10.3 \text{ FEET}}{2} \times 10.89 \text{ CFS}$$

$$= 22,999 \text{ CFS}$$

$$22,999 \text{ CFS} - 22,999 \text{ CFS} = 2019 \text{ CFS}$$

**TOTAL VOLUME DETAINED @ ELEV 8279.25 = 2019 CFS**

**OVERFLOW RELEASED TO RESEARCH AVENUE THROUGH WEST DRIVEWAY**

**BENCH MARK**

1. USO SQUARE [ ] CHISELED ON TOP OF CONCRETE BASE OF METALLIC PAVEMENT Pylon ELEV 8469.39

2. ON TOP OF CURB, 9.0 FEET WEST OF WEST PROPERTY CORNER ELEV 8469.02

**LEGEND**

CONTOUR INTERVAL: ONE FOOT, 1.0'

(S) EXISTING CONTOUR

— PROPOSED CONTOUR

+82.00 EXISTING ELEVATION

+82.00 PROPOSED ELEVATION


— RETAINING WALL

— FLOW LINE

MINIMUM EXISTING DETENTION BASIN DURING 100-YR RAINFALL

PROPOSED ELEVATIONS AND CONTOUR AS SHOWN ARE TO FINISHED SURFACE. CONTRACTOR SHALL DETERMINE APPROPRIATE ELEVATIONS.

CONTRACTOR IS RESPONSIBLE FOR ABATEMENT OF SEDIMENT RELEASED ONTO ADJOINING PRIVATE PROPERTIES AND PUBLIC STREETS DURING CONSTRUCTION.

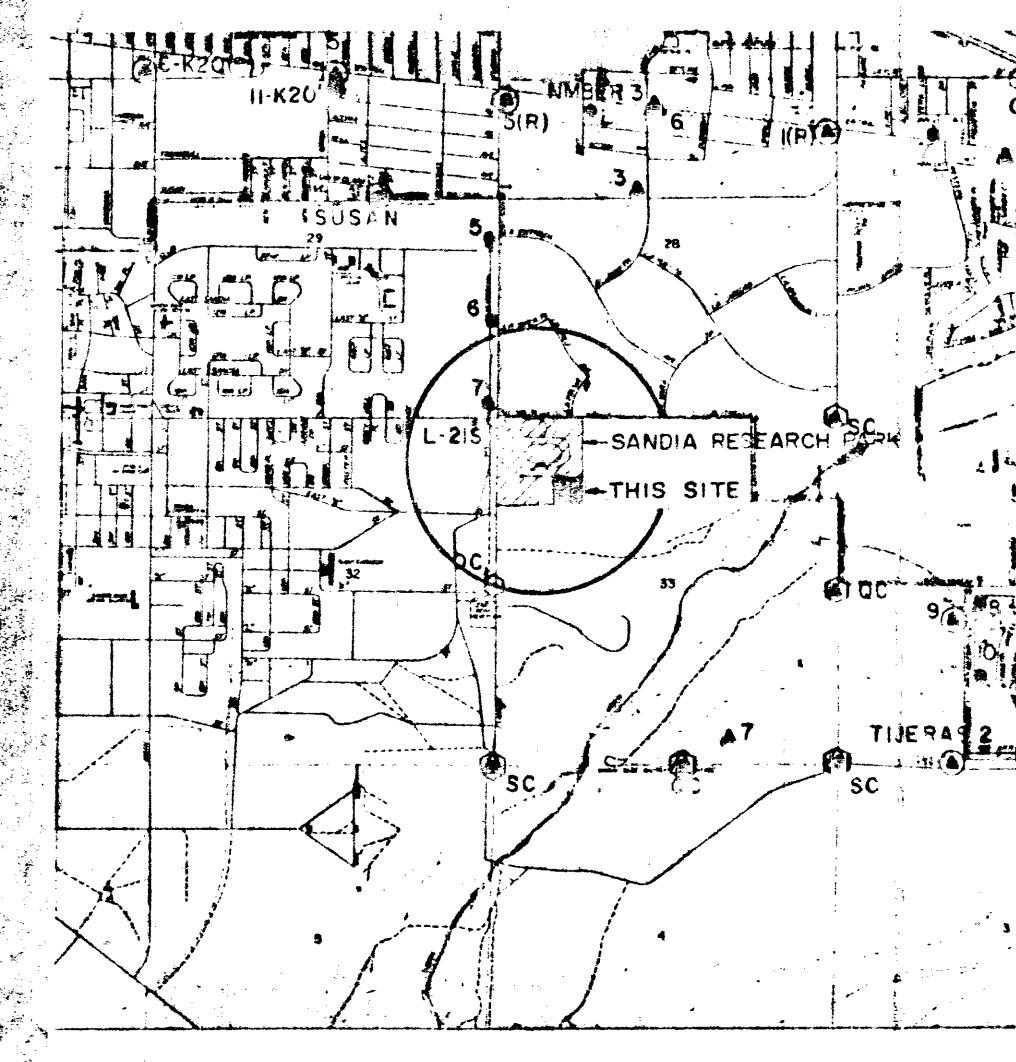

VICINITY MAP

**DATA**

AREA OF SITE: 3.89 ACRES (168,440 SQ. FT.)

SLOPE AS GRADED: 1.6%

TIME OF CONCENTRATION: 10 MINUTES

100-YR, 24 HOUR RAINFALL: 2.8 INCHES

INTENSITY (0.6 IN X 2.5 IN) = 4.86 IN/HR

**EXISTING CONDITIONS**

ENTIRE SITE HAS BEEN GRADED IN GENERAL CONFORMANCE WITH GRADING & DRAINAGE PLAN FOR SANDIA RESEARCH PARK. SLOPE IS CONSTANT FROM SOUTHEAST TO NORTHWEST. NO STIPULATED IMPROVEMENTS, PAVING OR LANDSCAPING EXIST. VEGETATION IS LIMITED TO SPARSE NATIVE GROWTH.

$C = 40$

$Q_{100} = .40 \times 4.86 \text{ IN/HR} \times 3.89 \text{ AC} = 7.55 \text{ CFS PEAK}$

$Q_{10} = .057 \times Q_{100} = 4.37 \text{ CFS}$

**PROPOSED DEVELOPMENT**

THREE SINGLE-STORY COMMERCIAL BUILDINGS, ASPHALT DRIVE AND PARKING, CONCRETE WALKS, LANDSCAPING AREAS.

ROOF AREA: 90%  $C = .95$

PAVEMENT: 90%  $C = .90$

LANDSCAPING: 75%  $C = .05$

$C_{100} = (.90 \times .95) + (.90 \times .90) + (.05 \times .05) = .87$

$Q_{100} = .87 \times 4.86 \text{ IN/HR} \times 3.89 \text{ AC} = 16.44 \text{ CFS PEAK}$

$Q_{10} = .057 \times Q_{100} = 10.30 \text{ CFS}$

**UPSTREAM CONTRIBUTORY AREAS**

VINE LAND OF PUBLIC SERVICE COMPANY ADJOINING ON SOUTH SIDE TWO AND ONE-HALF FEET (2') LOWER. FLOW FROM LAND ADJOINING TO EAST ARE INTENDED, ACCORDING TO APPROVED GRADING & DRAINAGE PLAN (PERMIT 1988) TO BE INTERCEPTED BY A SWALE GRADED ALONG EAST PROPERTY LINE ON ADJOINING LAND. FLOW WOULD BE DIRECTED TO IMPROVE "ELEV" "RESIDENT" DISTURBANCE OF SOIL ASSOCIATED WITH CONSTRUCTION OF RETAINMENT TURN AROUND HAS BLOCKED THIS ROUTE. CHANNEL SHOULD BE RE-CREATED.

**DRAINAGE ROUTING**

CATCHMENT FOR THIS DEVELOPMENT IS LOCATED AT THE SE CORNER OF INTERSECTION OF RESEARCH AVENUE AND EUPHRAZ BOULEVARD, SE. APPROVED REPORT ALLOWS A DIRECT DISCHARGE OF 3.42 CFS PER ACRE. 3.89 AC X 3.42 CFS = 13.30 CFS ALLOWABLE.

**DIRECT RUNOFF VOLUME**

COMPOSITE SCS CURVE NUMBER (SCS 10% IMPERVIOUS)  $(.05 \times .95) + (.075 \times .91 \text{ SOIL GROUP 'B'}) = .93$

DIRECT RUNOFF: 1.83 IN

$3.89 \text{ AC} \times 1.83 \text{ IN} = 60.40 \text{ FT} = 68,500 \text{ CU FT}$

RELEASE TO STREET WILL BE VIA 2.18' SIDEWALK CULVERTS.

SECTION, 1E X 5' = 75 SQ FT

ELEVATION = 8200 FT/FT

$n = .012$

$V = \frac{1.486}{.012} \times \left( \frac{68,500}{60.40} \right)^{.58} \times 0.000 = 7.02 \text{ FT/SEC}$

$Q_d = 7.02 \text{ FT/SEC} \times 75 \text{ SQ FT} = 526.5 \text{ CFS}$

**DESCRIPTION OF PROPERTY**

LOT - 3

BLOCK - 4

SANDIA RESEARCH PARK

ALBUQUERQUE, NEW MEXICO

RESEARCH AVENUE, 88

ALLIANCE ELECTRONICS

PREPARED FOR

DURA-BILT PRODUCTS

06/28/89

**HALL ENGINEERING COMPANY INC.**

ENGINEERING • SURVEYING • PLANNING • CONSTRUCTION

6940 2ND ST., N.W., SUITE 306 • ALBUQUERQUE, NEW MEXICO 87107

PHONE: (505) 345-1064