

# CITY OF ALBUQUERQUE



Timothy M. Keller, Mayor

January 11, 2018

Shawn Biazar  
SBS Construction and Engineering, LLC  
10209 Snowflake Ct. NW  
Albuquerque, NM, 87114

**RE: Navin Properties LLC  
1400 Britt SE  
Request for Permanent C.O. – Accepted  
Engineer's Certification Date: 01/05/18  
Engineer's Stamp Date: 3/12/17  
Hydrology File: M21D005D**

PO Box 1293

Dear Mr. Biazar:

Albuquerque

Based on the Certification received 01/09/18 and site visit on 01/10/18, the site is acceptable for a Permanent Certificate of Occupancy by Hydrology for 1400 Britt SE.

If you have any questions, please contact me at 924-3995 or [rbrissette@cabq.gov](mailto:rbrissette@cabq.gov).

NM 87103

Sincerely,

[www.cabq.gov](http://www.cabq.gov)

*Renée C. Brissette*

Renée C. Brissette, P.E. CFM  
Senior Engineer, Hydrology  
Planning Department

**Location**  
LOT 4, BLOCK 3, SANDIA RESEARCH PARK is located at 1400 Britt St., SE, containing 1.0169 acre. See attached portion of Vicinity Map M-21-Z for exact location.

**Purpose**  
The purpose of this drainage report is to present a grading and drainage solution for new building and improvements with this tract of land.

**Existing Drainage Conditions**  
This site falls within Master Drainage Plan for the Sandi Research Park, Area D-1 (M-21/D5) prepared by Andrews, Ashbury, & Roberts, Inc. Area D-1, discharging directly into streets at various locations which eventually drains directly into existing pond this development. No offsite flows enters this site. the runoff to the east drains east. Small portion of the site to the east drains east. The runoff to the north and to the south drain west to Britt Street.

**Proposed Conditions and On-Site Drainage Management Plan**  
Since the Master Plan (File M-21/D5) is designed for complete discharge, we are proposing to pond the 90th Percentile/First Flush requirement which is 0.34 inches times the impervious area. Total retention volume provided within pond A and B (2,922.52 cf) exceeds the ponding volume requirement for First Flush (814.31 cf). Pond A overflows into parking lot and then to Pond B. From there the runoff drains to Britt Street via Sidewalk culvert.

**Calculations**  
City of Albuquerque, Development Process Manual, Section 22.2, Hydrology Section, was used for runoff calculations. See this plan for AHYMO input and Summary output files.

* ZONE 3	
*****	
* 100-YEAR, 6-HR STORM (UNDER EXISTING CONDITIONS)	
*****	
START RAINFALL	TIME=0.0
	TYPE=1 RAIN QUARTER=0.0 IN
	RAIN ONE=2.14 IN RAIN SIX=2.60 IN
	RAIN DAY=3.10 IN DT=0.03333 HR
* COMPUTE NM HYD	
	ID=1 HYD NO=100.0 AREA=0.001589 SQ MI
	PER A=100.00 PER B=0.00 PER C=0.00 PER D=0.00
	TP=0.1333 HR MASS RAINFALL=1
*****	
* 10-YEAR, 6-HR STORM (UNDER EXISTING CONDITIONS)	
*****	
START RAINFALL	TIME=0.0
	TYPE=1 RAIN QUARTER=0.0 IN
	RAIN ONE=1.43 IN RAIN SIX=1.73 IN
	RAIN DAY=2.07 IN DT=0.03333 HR
* COMPUTE NM HYD	
	ID=1 HYD NO=110.0 AREA=0.001589 SQ MI
	PER A=100.00 PER B=0.00 PER C=0.00 PER D=0.00
	TP=0.1333 HR MASS RAINFALL=1
*****	
* 100-YEAR, 6-HR STORM (UNDER PROPOSED CONDITIONS)	
*****	
START RAINFALL	TIME=0.0
	TYPE=1 RAIN QUARTER=0.0 IN
	RAIN ONE=2.14 IN RAIN SIX=2.60 IN
	RAIN DAY=3.10 IN DT=0.03333 HR
* COMPUTE NM HYD	
	ID=1 HYD NO=100.1 AREA=0.001589 SQ MI
	PER A=0.00 PER B=25.00 PER C=10.00 PER D=65.00
	TP=0.1333 HR MASS RAINFALL=1
*****	
* 10-YEAR, 6-HR STORM (UNDER PROPOSED CONDITIONS)	
*****	
START RAINFALL	TIME=0.0
	TYPE=1 RAIN QUARTER=0.0 IN
	RAIN ONE=1.43 IN RAIN SIX=1.73 IN
	RAIN DAY=2.07 IN DT=0.03333 HR
* COMPUTE NM HYD	
	ID=1 HYD NO=110.1 AREA=0.001589 SQ MI
	PER A=0.00 PER B=25.00 PER C=10.00 PER D=65.00
	TP=0.1333 HR MASS RAINFALL=1
*****	
FINISH	

AHYMO PROGRAM SUMMARY TABLE (AHYMO\_97) -  
INPUT FILE = BRITT.TXT

VERSION: 1997.02d

RUN DATE (MON/DAY/YR) =03/12/2017  
USER NO.= AHYMO-I-9702c01000R31-AH

COMMAND	HYDROGRAPH IDENTIFICATION	FROM ID NO.	TO ID NO.	AREA (SQ MI)	PEAK DISCHARGE (CFS)	RUNOFF VOLUME (AC-FT)	RUNOFF (INCHES)	TIME TO PEAK (HOURS)	CFS PER ACRE	PAGE = 1
START RAINFALL	TYPE= 1									
COMPUTE NM HYD	100.00	-	1	.00159	1.91	.056	.65514	1.533	1.880	PER IMP= .00
START RAINFALL	TYPE= 1									
COMPUTE NM HYD	110.00	-	1	.00159	.57	.016	.18834	1.533	.563	PER IMP= .00
START RAINFALL	TYPE= 1									
COMPUTE NM HYD	100.10	-	1	.00159	4.34	.160	1.88584	1.500	4.270	PER IMP= 65.00
START RAINFALL	TYPE= 1									
COMPUTE NM HYD	110.10	-	1	.00159	2.70	.095	1.11772	1.500	2.653	PER IMP= 65.00
FINISH										

POND VOLUME REQUIRED

TOTAL PONDING VOLUME REQUIRED (90TH PERCENTILE/FIRST FLUSH) = 0.34 INCHES x IMPERVIOUS AREA = (0.34/12 x 28,708.75) = 813.41 CF



POND CALCULATION

TOTAL POND AREA PROVIDED =  
PONDING CALCULATIONS:

POND A: AREA @ TOP = 3,578.92, AREA @ BOTTOM = 1,496.69  
POND VOLUME = (3,578.92+1,496.69)/2\*1.00 = 2,537.81 CF

POND B: AREA @ TOP = 778.27, AREA @ BOTTOM = 247.62  
POND VOLUME = (778.27+247.62)/2\*0.75 = 384.71 CF

TOTAL POND VOLUME PROVIDED = 2,537.81 + 384.71 = 2,922.52 CF

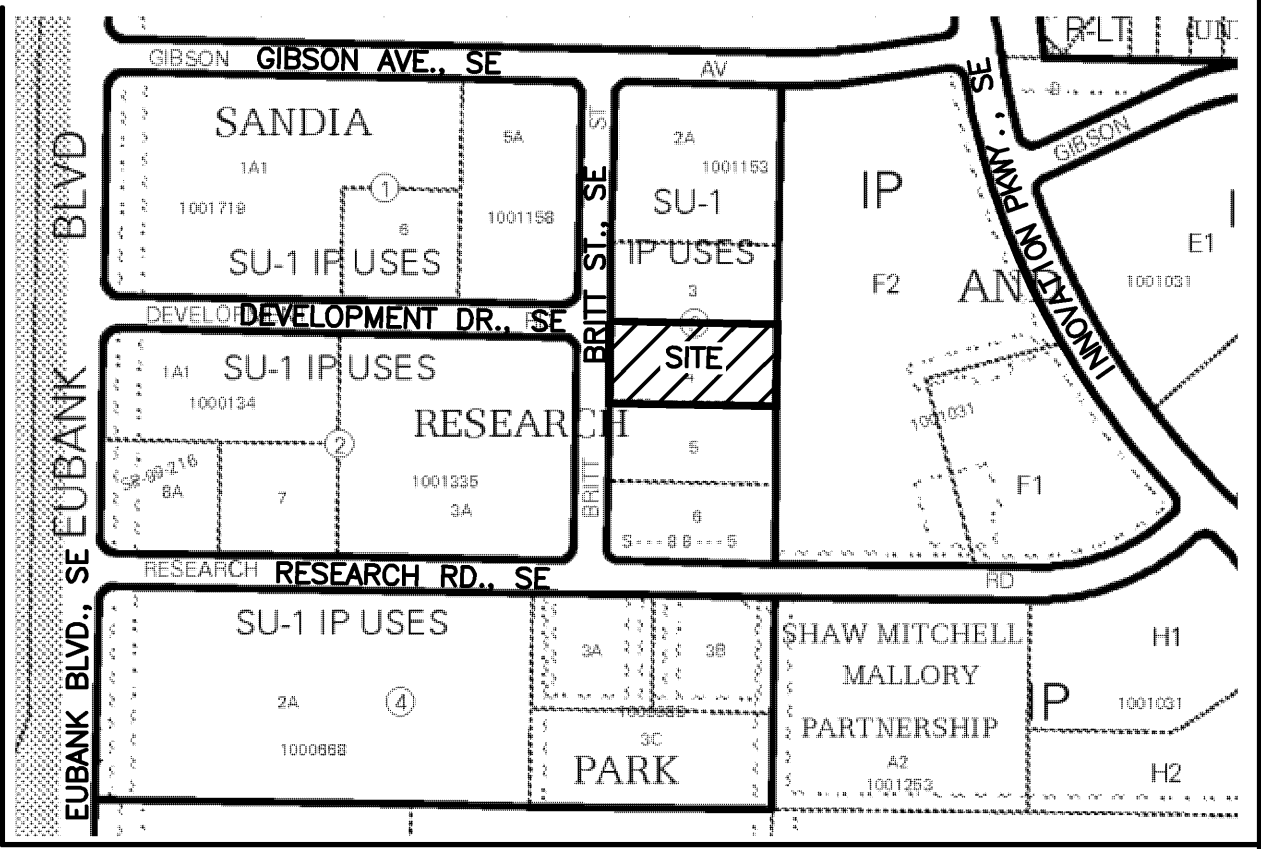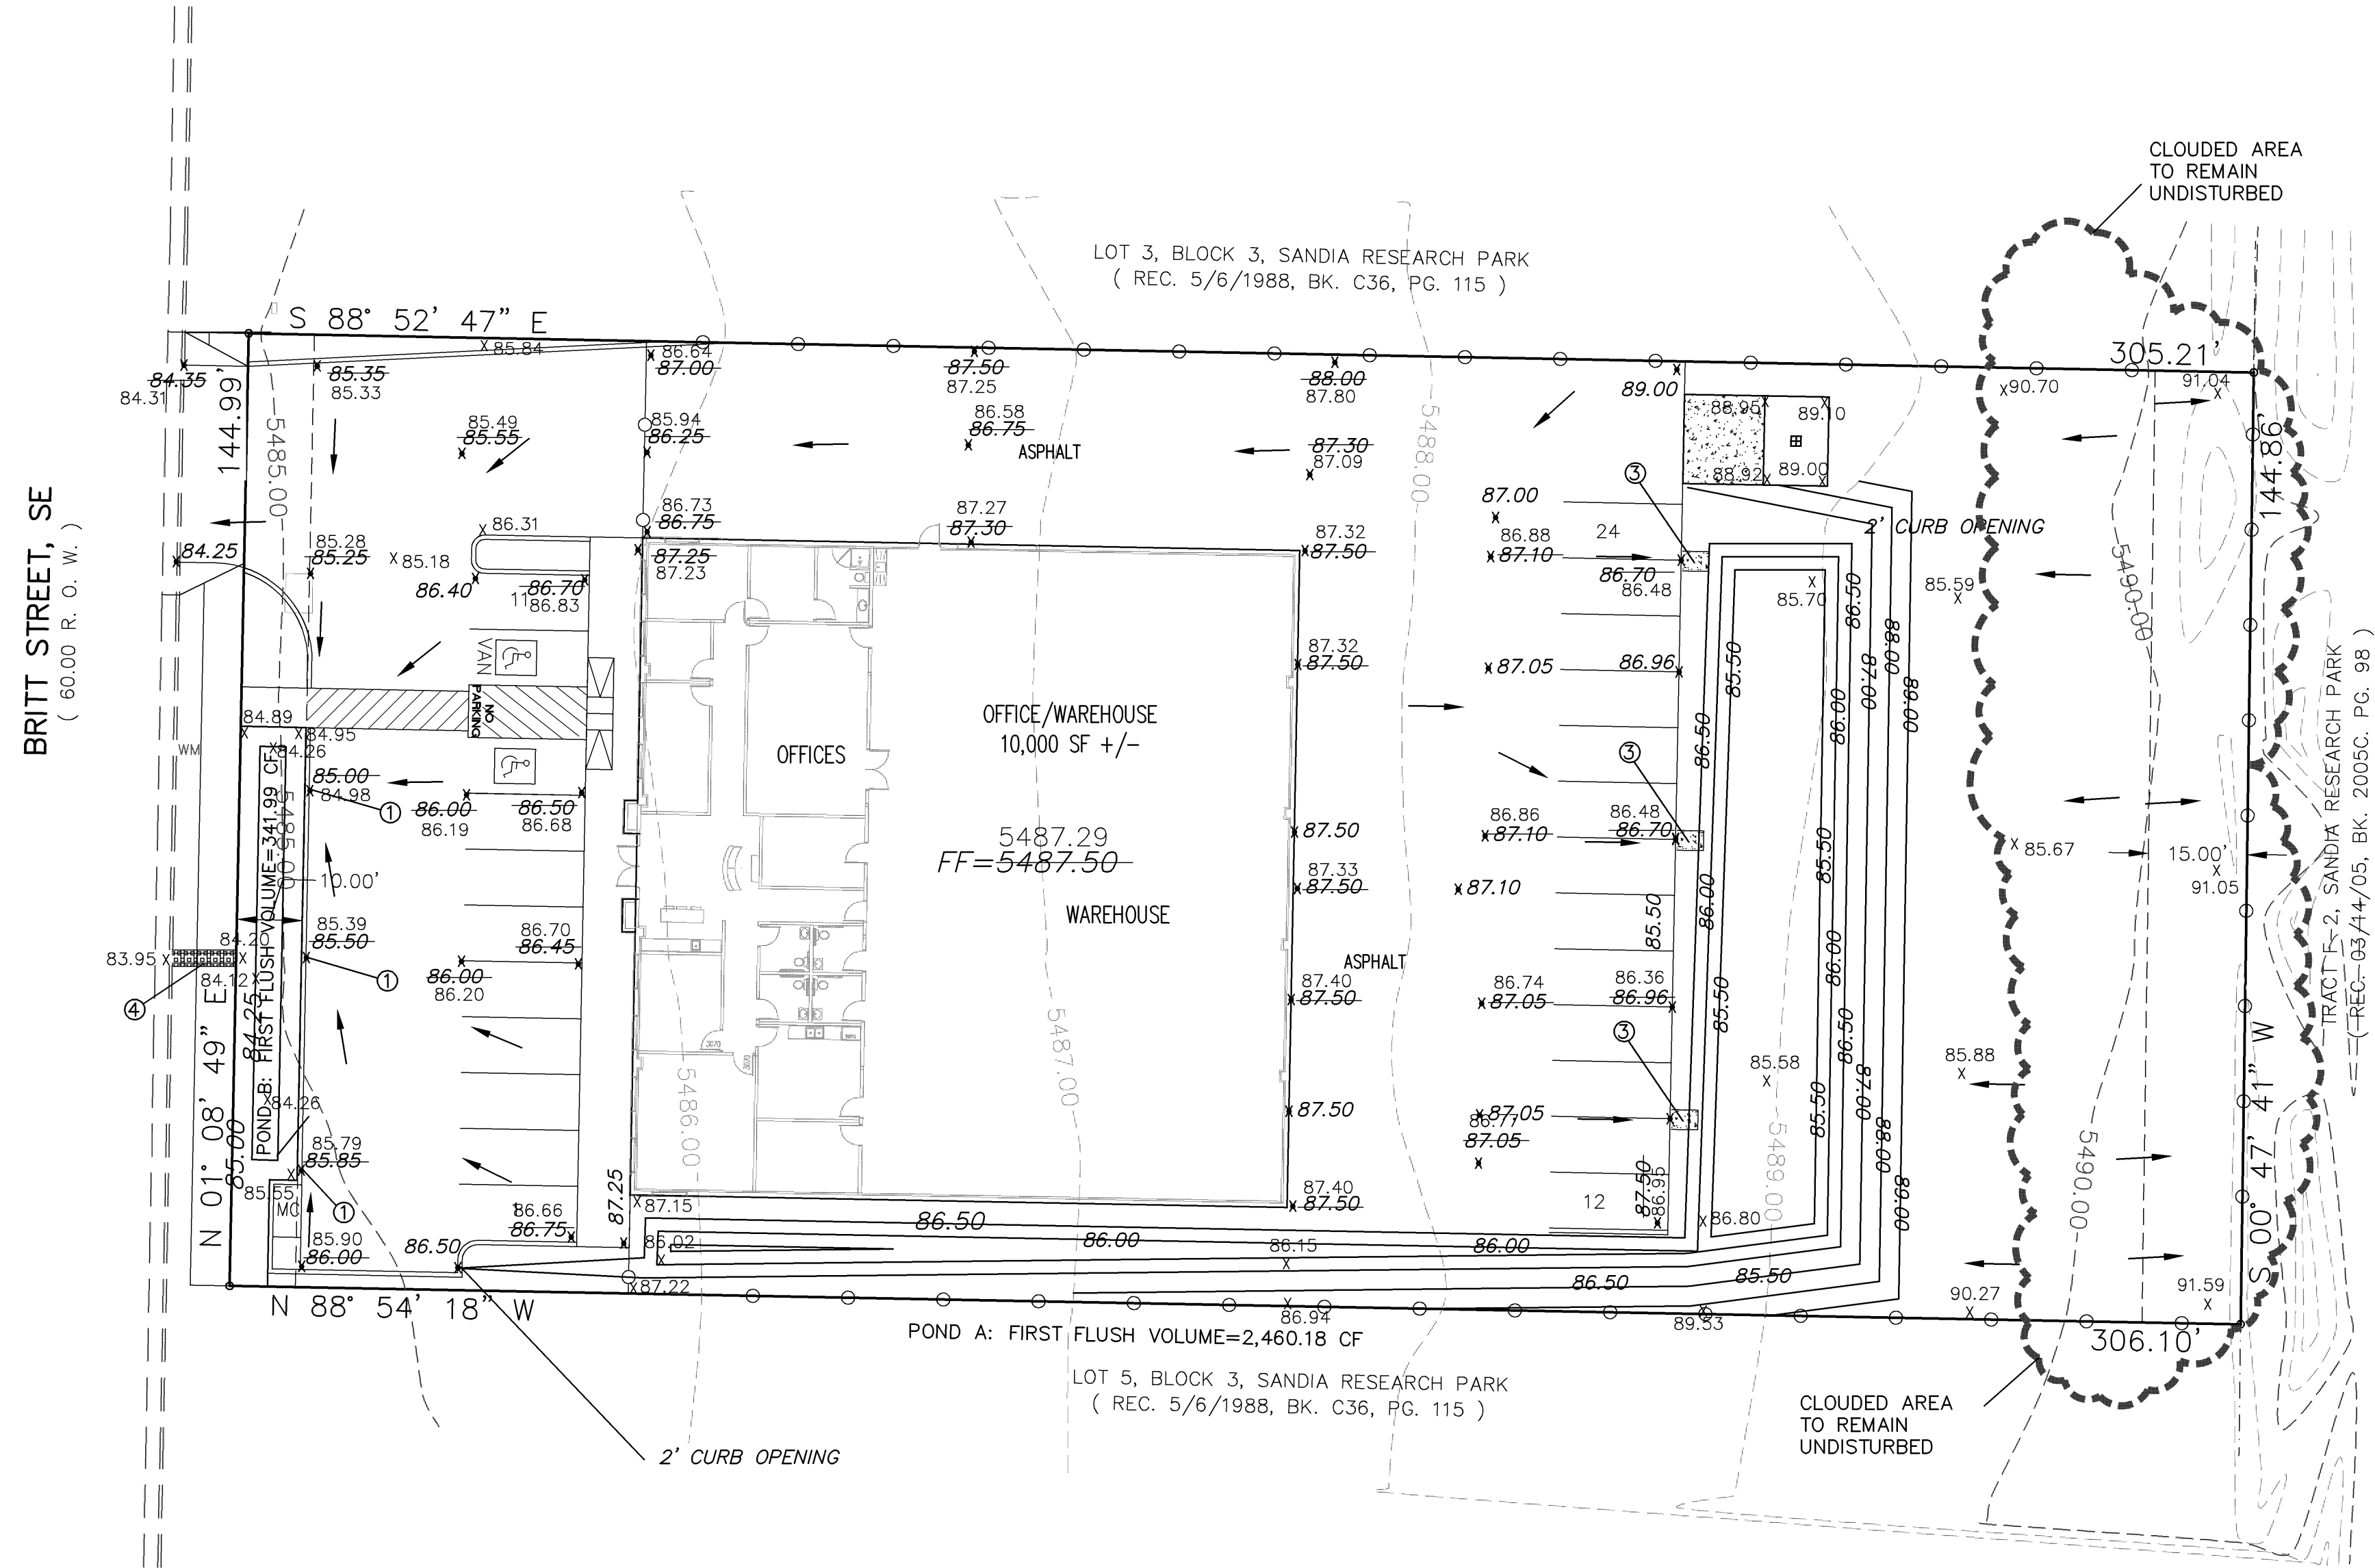

VICINITY MAP:

M-21-Z

LEGAL DESCRIPTION:

LOT 4, BLOCK 3, SANDIA RESEARCH PARK  
CONTAINING 1.0169 ACRE  
ZONING: SU-1 FOR IP USES  
ADDRESS: 1400 BRITT ST., SE

GENERAL NOTES:

- 1: CONTOUR INTERVAL IS HALF (1.00) FOOT.
- 2: ELEVATIONS ARE BASED ON CITY OF ALBUQUERQUE CONTROL STATION LSS\_302, HAVING AN ELEVATION OF 5444.138 FEET ABOVE SEA LEVEL.
- 3: UTILITIES SHOWN HEREON ARE IN THEIR APPROXIMATE LOCATION BASED ONLY ON ABOVE GROUND EVIDENCE FOUND IN THE FIELD AND AS-BUILT INFORMATION PROVIDED BY THE CLIENT. UTILITIES SHOWN HEREON, WHETHER INDICATED AS ABANDONED OR NOT, SHALL BE VERIFIED BY OTHERS FOR EXACT LOCATION AND/ OR DEPTH PRIOR TO EXCAVATION OR DESIGN CONSIDERATIONS.
- 4: THIS IS NOT A BOUNDARY SURVEY, BEARINGS ARE ASSUMED, DISTANCES AND FOUND PROPERTY CORNERS ARE FOR INFORMATIONAL PURPOSES ONLY.
- 5: SLOPES ARE AT 3:1 MAXIMUM.

LEGEND

- 5030--- EXISTING CONTOUR (MAJOR)
- 5029--- EXISTING CONTOUR (MINOR)
- BOUNDARY LINE
- x 28.50 PROPOSED SPOT ELEVATION
- x 5029.16 EXISTING GRADE
- x 5075.65 EXISTING FLOWLINE ELEVATION
- PROPOSED RETAINING WALL
- BC=89.08 BOTTOM OF CHANEL

TC=28.50  
TA=28.00

- HP HIGH POINT
- 87.40 AS-BUILT GRADES
- x 90.27 AS-BUILT SPOT ELEVATIONS

DRAINAGE CERTIFICATION

I, REZA AFAGHPOUR, NMPE 11814, OF SBS CONSTRUCTION AND ENGINEERING, LLC, HEREBY CERTIFY THAT THIS PROJECT HAS BEEN GRADED AND WILL DRAIN IN SUBSTANTIAL COMPLIANCE WITH AND IN ACCORDANCE WITH THE DESIGN INTENT OF THE APPROVED PLAN DATED 03-12-2017. THE RECORD INFORMATION EDITED ONTO THE ORIGINAL DESIGN DOCUMENT HAS BEEN OBTAINED BY NMPS 9801 (LEONARD MARTINEZ), OF SBS CONSTRUCTION AND ENGINEERING, LLC. I FURTHER CERTIFY THAT I HAVE PERSONALLY VISITED THE PROJECT SITE ON AND HAVE DETERMINED BY VISUAL INSPECTION THAT THE SURVEY DATA PROVIDED IS REPRESENTATIVE OF ACTUAL SITE CONDITIONS AND IS TRUE AND CORRECT TO THE BEST OF MY KNOWLEDGE AND BELIEF. THIS CERTIFICATION IS SUBMITTED IN SUPPORT OF A REQUEST FOR FINAL CERTIFICATE OF OCCUPANCY.


THE RECORD INFORMATION PRESENTED HEREON IS NOT NECESSARILY COMPLETE AND INTENDED ONLY TO VERIFY SUBSTANTIAL COMPLIANCE OF THE GRADING AND DRAINAGE ASPECTS OF THIS PROJECT. THOSE RELYING ON THIS RECORD DOCUMENT ARE ADVISED TO OBTAIN INDEPENDENT VERIFICATION OF ITS ACCURACY BEFORE USING IT FOR ANY OTHER PURPOSE.

REZA AFAGHPOUR, NMPE 11814  
REGISTERED PROFESSIONAL ENGINEER  
DATE 01-05-2018

NOTES:

1. PROVIDE 12" CURB OPENING
2. PROPOSED 2-4" STORM DRAIN PIPE
3. 3' WIDE CONCRETE RUNDOWN
4. 2. 24" SIDEWALK CULVERT PER CITY STD DWG 2236 (TACK WELD PLATE AT THE BOLT).

GRAPHIC SCALE

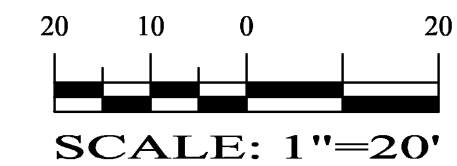

REZA AFAGHPOUR  
P.E. #11814

SBS CONSTRUCTION AND ENGINEERING, LLC

10209 SNOWFLAKE CT., NW  
ALBUQUERQUE, NEW MEXICO 87114  
(505)899-3570

NAVIN PROPERTIES, LLC  
1400 BRITT ST., SE  
CONCEPTUAL GRADING PLAN

DRAWING:	DRAWN BY:	DATE:	SHEET #
201632-GD.DWG	SH-B	3/12/2017	3 OF 4