

Conceptual Primary Entry


75' X 75' Landscape Easement for Primary Entry Monument & Landscaping

25' Landscape Easement along Innovation Parkway - typ.


Willow Wood

Conceptual Pocket Park


25' Landscape Easement

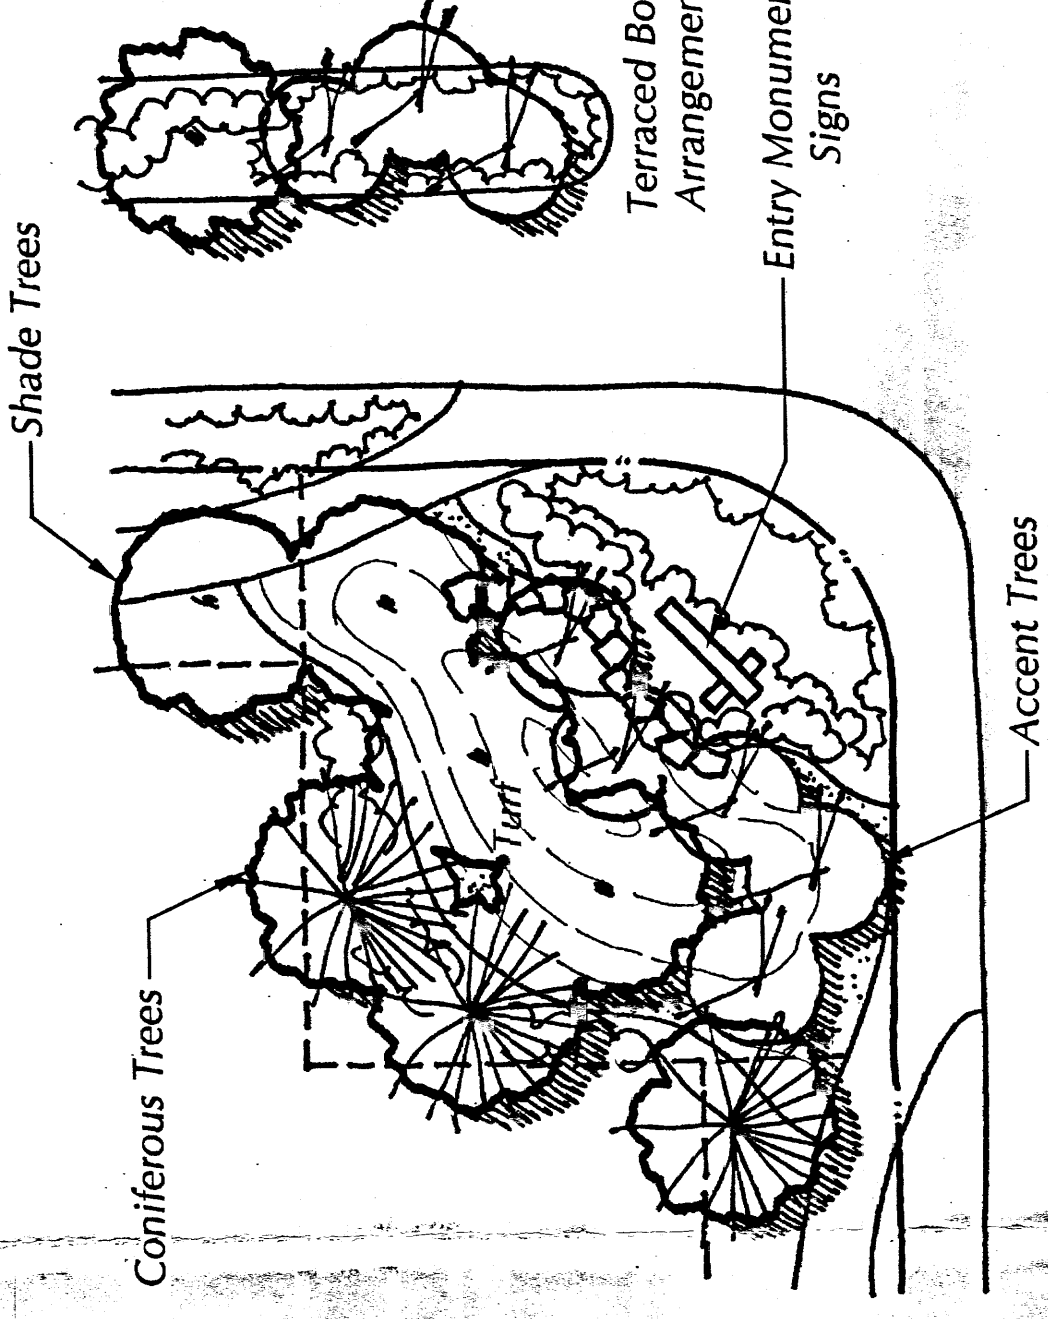



Conceptual Primary Entry

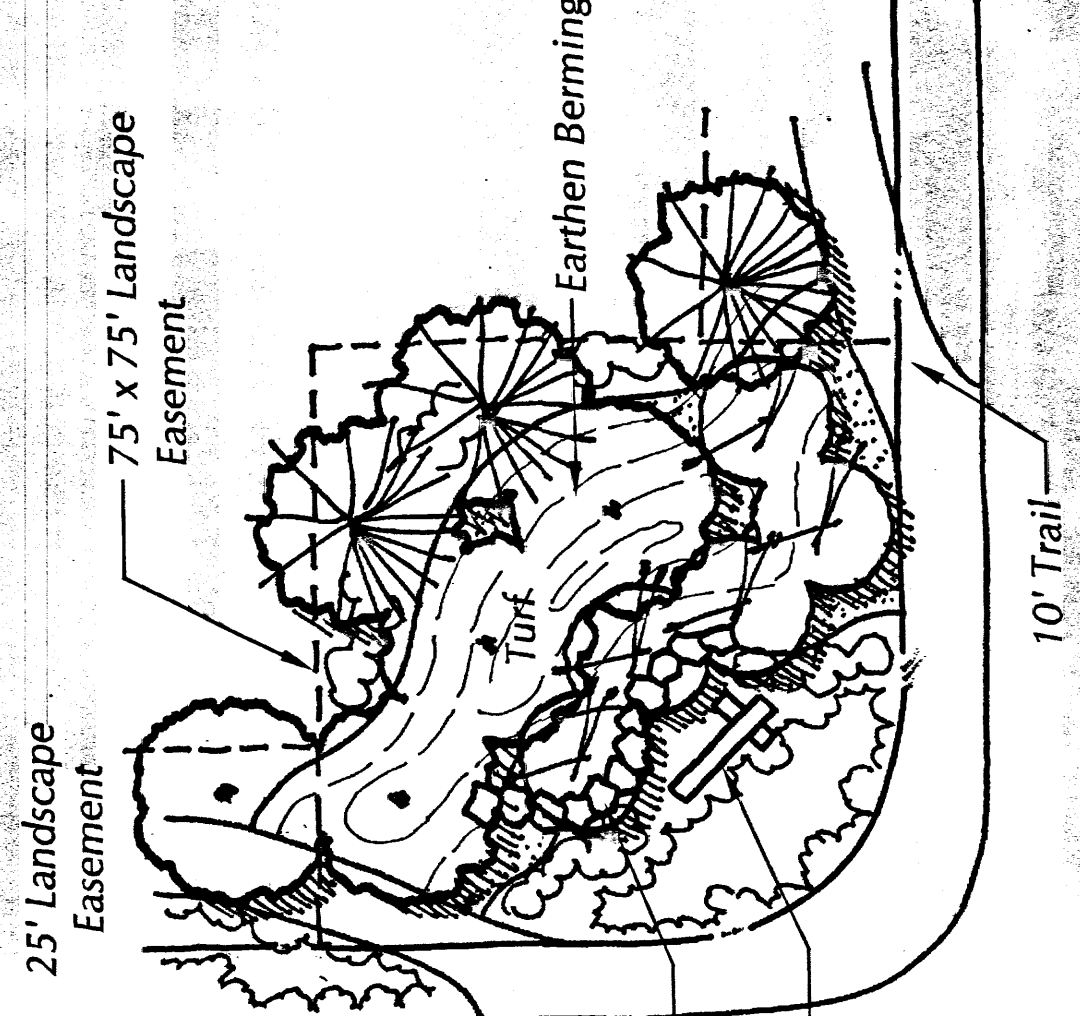

Conceptual Pocket Park

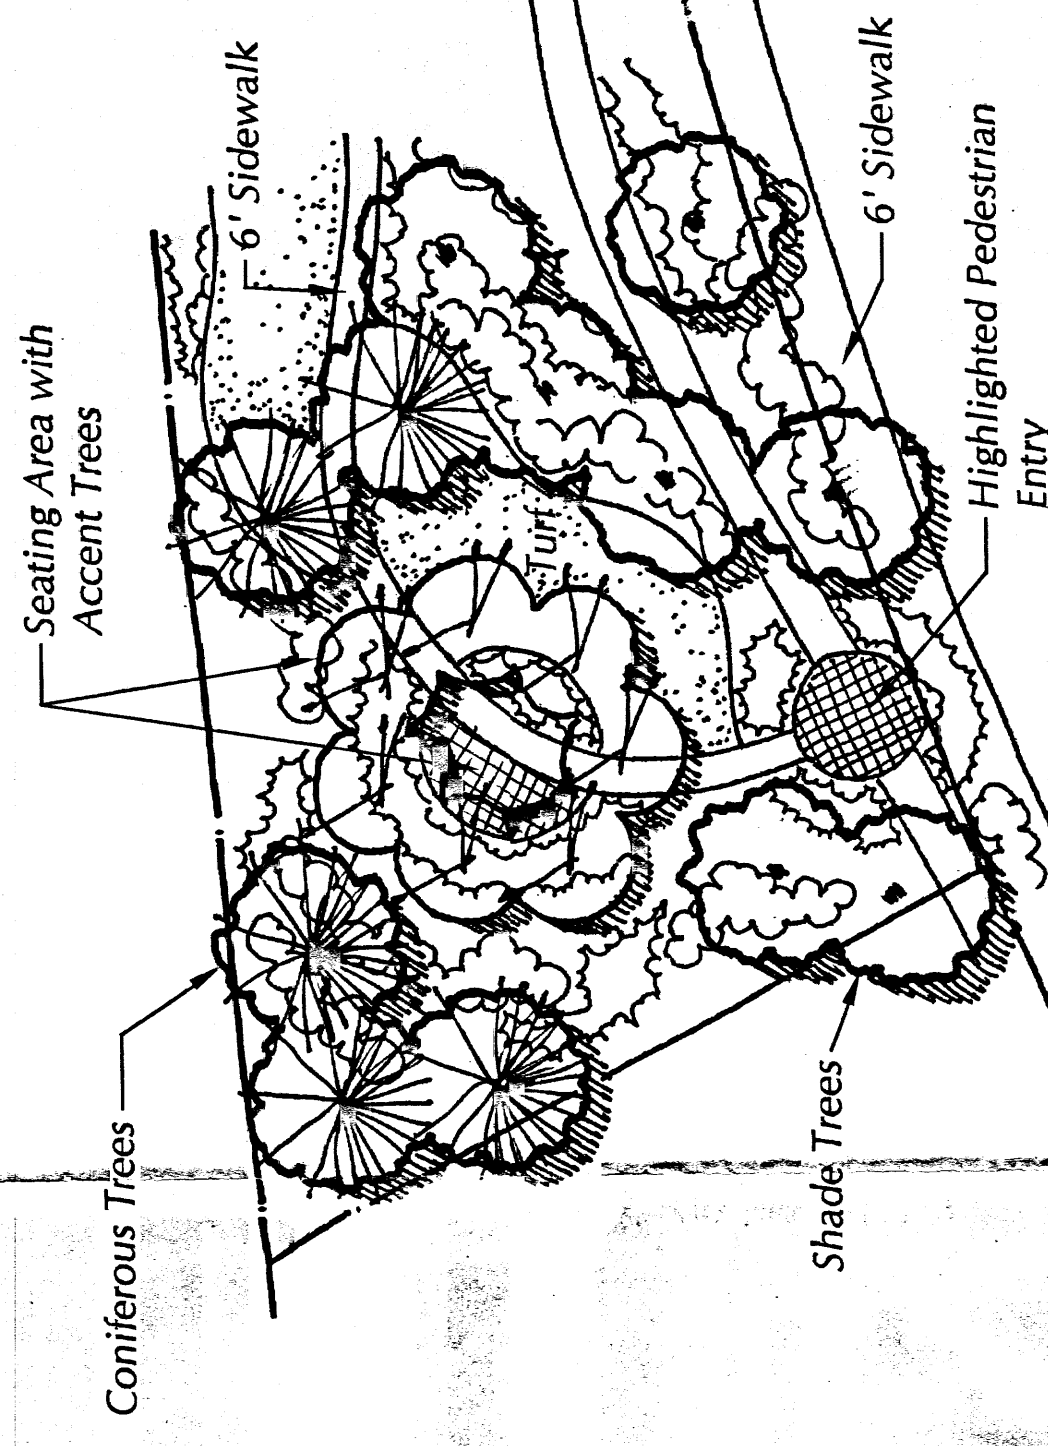

South Pointe Mobile Home Park

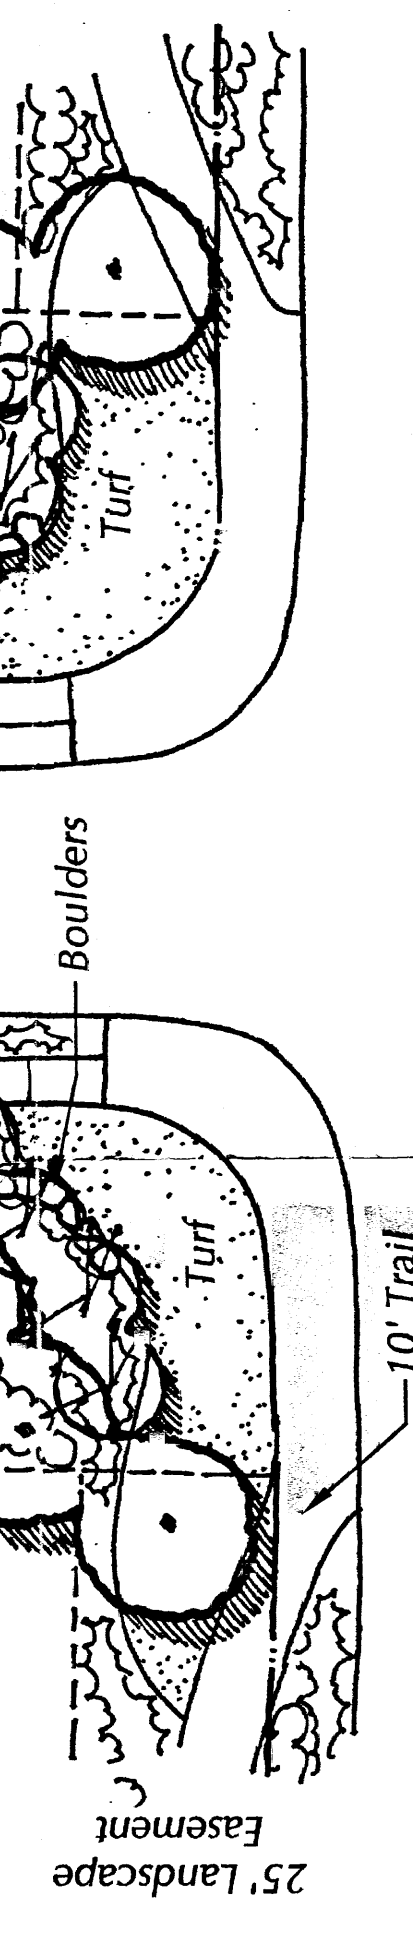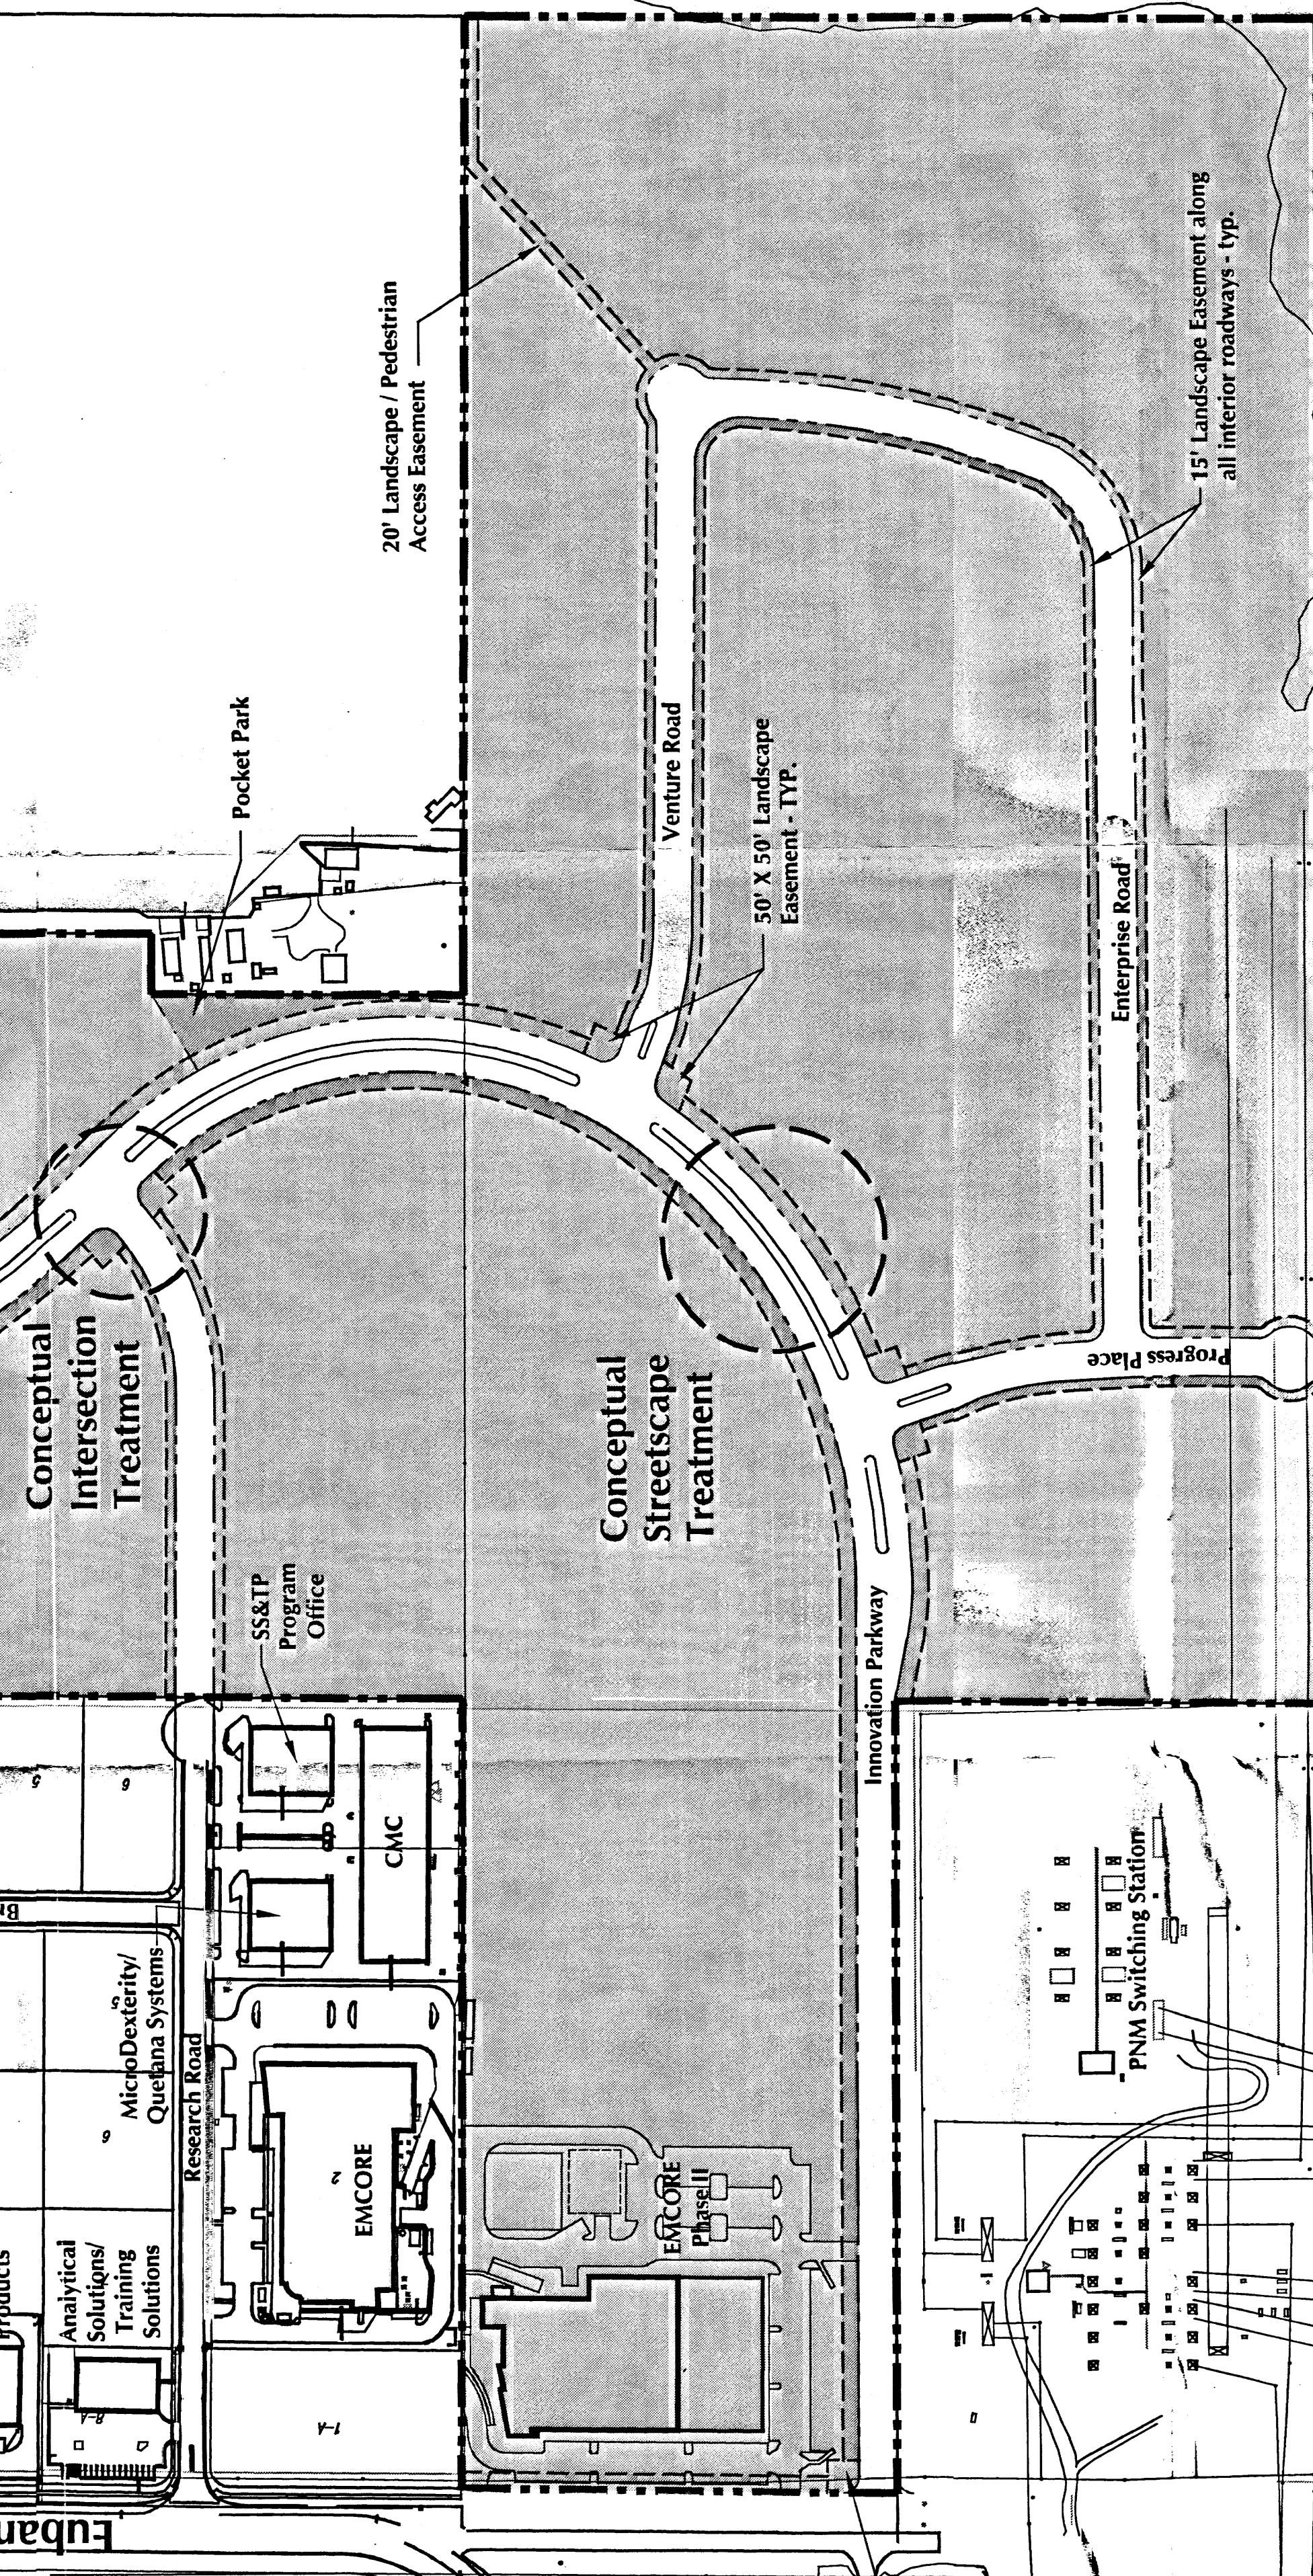

Conceptual Intersection Treatment

Landscape Master Plan



Sandia Science and Technology Park

Prepared For:


Science and Technology Park Development Corporation
Albuquerque, New Mexico 87120

Prepared By:


CONSENSUS PLANNING, INC.
9040 Lomas Blvd. NE
Albuquerque, NM 87110
(505) 764-9801 Fax 842-5495
e-mail: op@consensusplanning.com

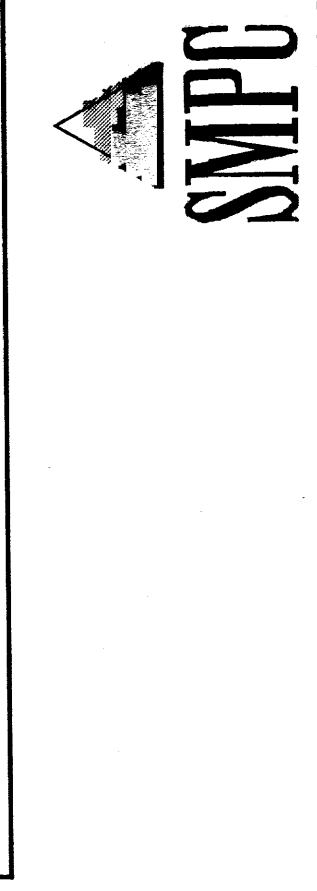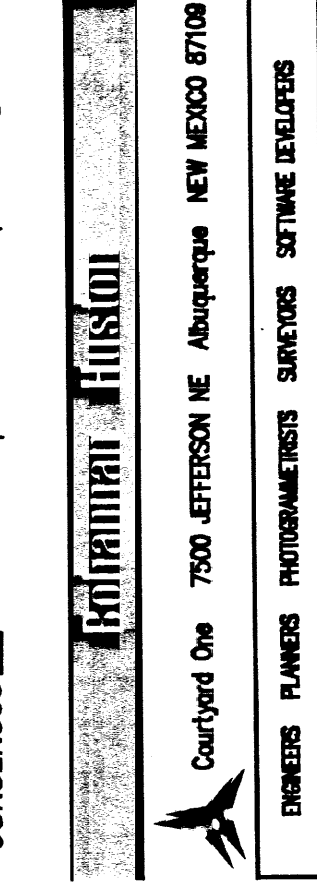

Scale 1" = 200'

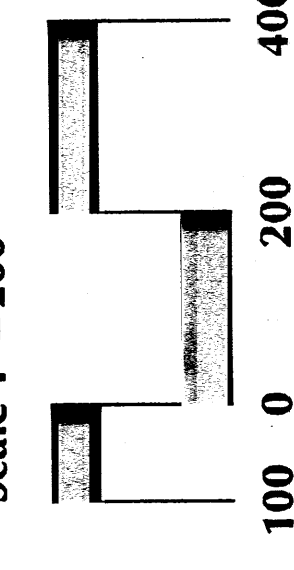

Conceptual Streetscape Treatment

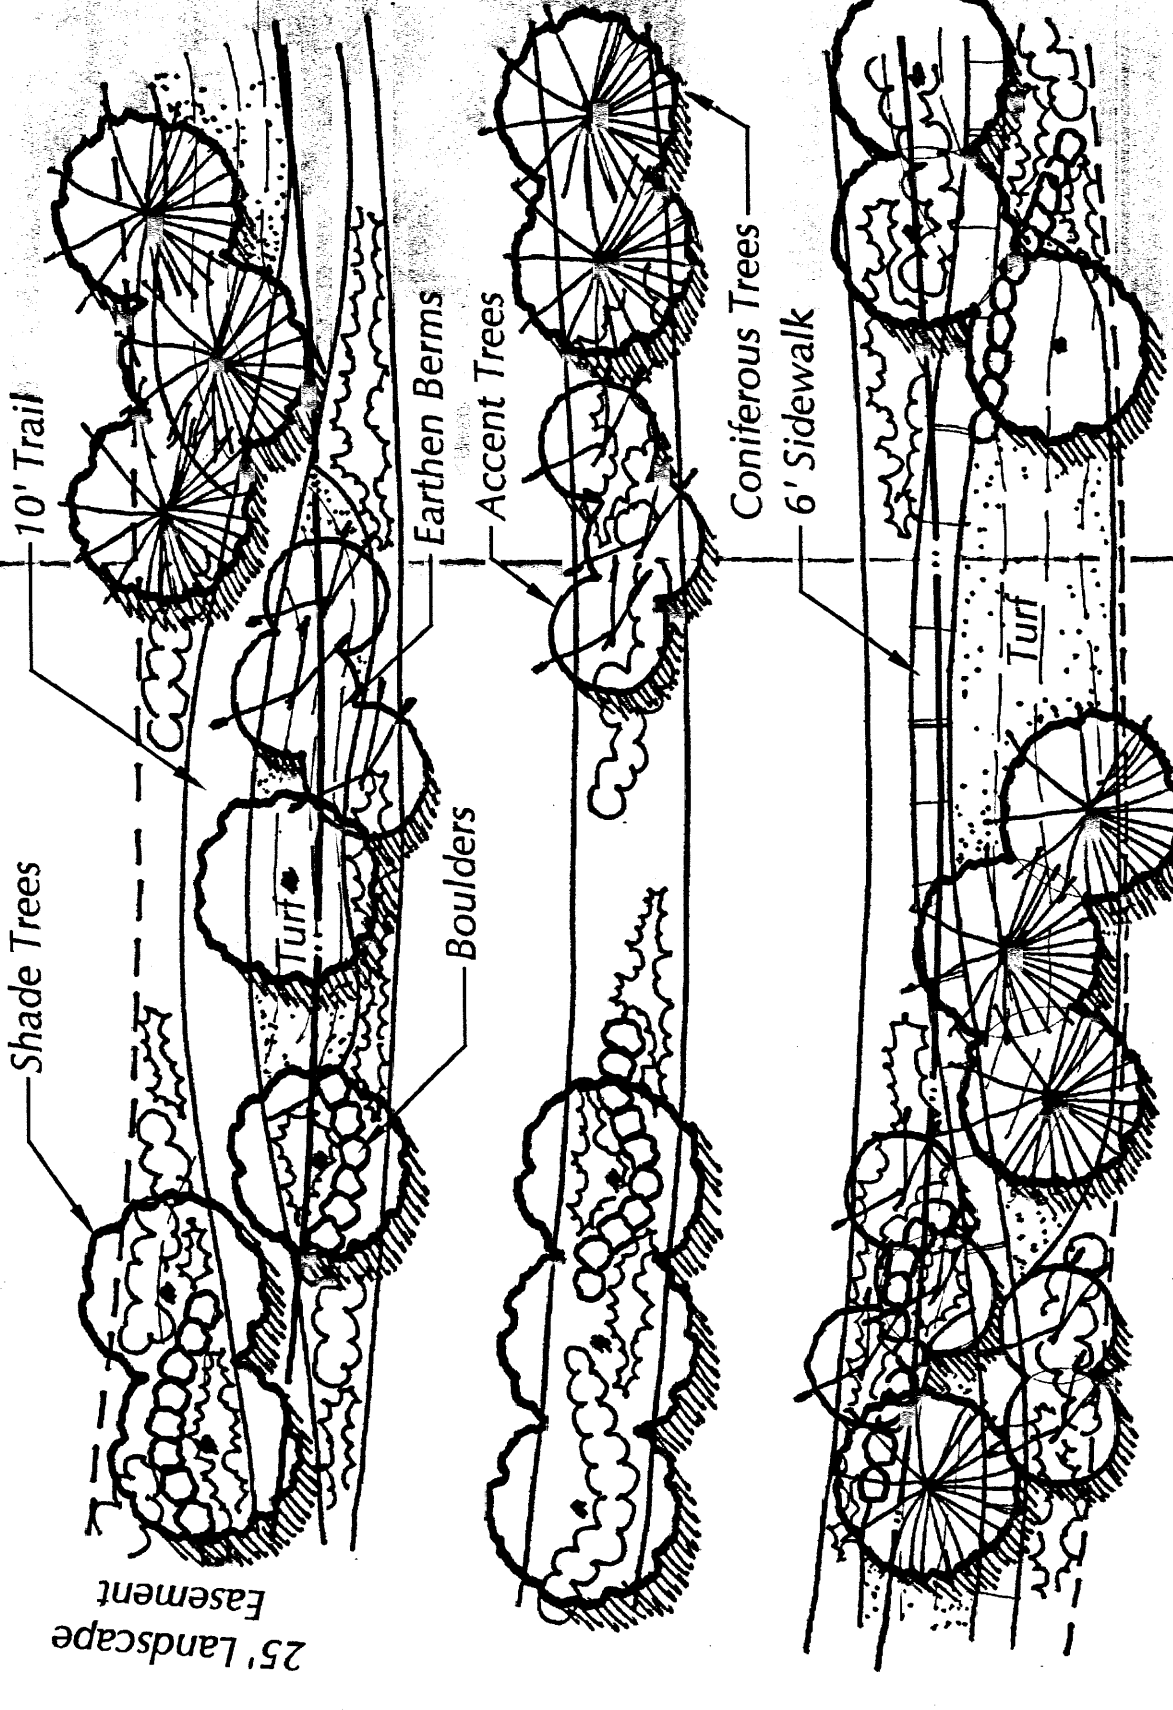

January 25, 2001

- 1) Lot lines are shown for illustrative purposes only. Final platting of this Master Plan will occur in a phased manner as specific development proposals are presented.
- 2) Development of property within the Old South Eubank Landfill will only occur upon completion of mitigation measures.
- 3) Road extension subject to provision of adequate right-of-way and/or access easement, or as aligned in another location.
- 4) Eubank Boulevard will be extended to the southernmost access road (wherever final alignment of Progress Place is platted).



Sandia Science and Technology Park

Prepared By:


PLANNING
CONSENSUS PLANNING, INC.
Planning / Landscape Architecture
924 Park Avenue SW
Albuquerque, NM 87102
(505) 764-9801 Fax 842-5495
e-mail: cp@consensusplanning.com

Colman-Houston
 Courtyard One 7500 JEFFERSON NE Albuquerque NEW MEXICO 87109
 ENGINEERS PLANNERS PHOTOGRAMMETRISTS SURVEYORS SOFTWARE DEVELOPERS



Figure 1 consists of two schematic diagrams of the experimental setup. The top diagram is a top-down view of a rectangular arena. It features a central platform (a small square) and a black start box (a larger square) located at one end. The arena is divided into several sections by walls. The bottom diagram is a side view of the arena, showing a coordinate system with a scale from 0 to 400 cm. A North arrow is indicated at the top right of the diagram.

January 25, 2001

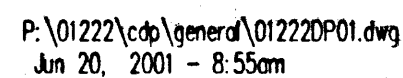

ZONE ATLAS NO. M-21
SP. NO. 12-14-412

1st of New Mexico
County of Bernalillo
Instrument was filed for record
AUG 24 1982
SEC. 32
of clock, m. Recorded in Vol.
Records of said County Folio
Clerk & Recorder
Deputy Clerk

SCALE: 1"=400'

BASE
FORCE
AIR
(SANDIA)
KIRTLAND

TRACT 4

TRACT 3

TRACT 6

MANZANO MESA
(Filed 8/17/60)

82 44125

SUMMARY PLAT
FOR ANNEXATION TO THE
CITY OF ALBUQUERQUE OF
NW 1/4 NE 1/4, S 1/2 NE 1/4, NW 1/4 & NW 1/4 SW 1/4
OF SECTION 33
T.10N., R.4 E., N.M.P.M.

BERNALILLO COUNTY, NEW MEXICO
SEPT. 1981

DESCRIPTION

That Certain Parcel of Land Situate Within Section 33, T.10N., R.4E., N.M.P.M., Bernalillo County, New Mexico, Comprised Of The NW 1/4 NE 1/4, The NW 1/4 SW 1/4, SW 1/4 Of Said Section 33 And Being More Particularly Described As Follows: Beginning At The Southeast Corner Of The SW 1/4 NE 1/4 Of The Said Section 33, Whence The East Quarter Section Corner Of The Said Section 33 (Marked By A Bureau Of Land Management - BLM - Brass Cap Set In Concrete) Bears S 89° 44' 34" E, 1301.08 Feet; Thence N 89° 44' 34" W, 1301.08 Feet Along The South Line Of The Said NW 1/2 NE 1/4 Of Section 33 To The Center Section Corner Of Said Section 33; Thence N 89° 44' 34" W, 1309.78 Feet Along The South Line Of The Said NW 1/4 Of Section 33 To The Northeast Corner Of The NW 1/4 SW 1/4 Of The Said Section 33; Thence S 00° 47' 51" W, 1362.08 Feet Along The East Line Of The Said NW 1/4 SW 1/4 To The Southeast Corner Of The Said NW 1/4 SW 1/4; Thence N 89° 27' 30" W, 1313.30 Feet Along The South Line Of The Said NW 1/4 SW 1/4 To The Southwest Corner Of The Said NW 1/4 SW 1/4; Thence N 00° 56' 53" E, 1355.60 Feet Along The West Section Line Of The Said Section 33, Said Section Line Being The Same As The Centerline Of Eubank Boulevard, S.E., To The West Quarter Section Corner Of The Said Section 33; Thence N 00° 58' 36" E, 2711.86 Feet Continuing Along The Said West Section Line Of Section 33 And Centerline Of Eubank Boulevard, S.E., To The Northwest Corner Of The Said Section 33; Thence S 88° 48' 24" E, 2604.08 Feet Along The North Section Line Of The Said Section 33; To The North Quarter Section Corner Of The Said Section 33; Thence S 88° 47' 46" E, 1302.30 Feet Continuing Along The Said North Section Line To The Northeast Corner Of The W 1/2 NE 1/4 Of The Said Section 33; Thence S 00° 40' 26" W, 2647.65 Feet Along The East Line Of The Said W 1/2 NE 1/4 Of Section 33 To The Point Of Beginning Of The Parcel Herein Described. The Above Delineated Parcel Of Land Contains 281.66398 Acres, More Or Less.

The Undersigned Agree That When Right of Way Or Easements Required For Streets, Drainage Or Utilities Are Defined, Such Right of Way Or Easements Will Be Dedicated Or Granted Without Cost To The City Of Albuquerque.

D.A. McCall - President Futures, Inc.

W.M. Fitzpatrick - Desert Oceans Corporation

Raymond W. Shaw - Chairman of the Board,
Reco Corporation

Commissioner of Public Land
State of New Mexico

FREE CONSENT

We the under signed, Owners of the lands shown on this plat, do hereby consent to the purpose for creating this plat, such purpose being for Annexation to the City of Albuquerque, and is our free act and will.

D.A. McCall
D.A. McCall - President Futures, Inc.

Raymond W. Shaw - Chairman of the Board,
Reco Corporation

Doug Hendren, Right-of-Way Agent
Public Service Company of New Mexico

Charles W. White
Board of Education

Commissioner of Public Land
State of New Mexico

W.M. Fitzpatrick - Desert Oceans Corporation

ACKNOWLEDGEMENT

STATE OF NEW MEXICO

COUNTY OF BERNALILLO

The foregoing instrument was acknowledged before me this 10th day of June, 1982.

My Commission Expires: June 01, 1986

Notary Public

SURVEYOR'S CERTIFICATION

This is to certify that this plat was prepared from field notes of an actual survey under my direct supervision, to the best of my knowledge and belief is true and correct, meets the minimum requirements for monumentation and surveys of the Albuquerque Subdivision Ordinance, and shows all easements of record.

James W. Gross, S.P.L. & L.S. No. 4100
9/10/81



FREE CONSENT & DEDICATION

The Undersigned Owner of the Land shown on this Plat do hereby Dedicate the Easements & Right of Ways hereon, Said Easements & Right of Ways being the 40' Drainage Easement running parallel to the West Line of Section 33 and the 75' Right of Way for Eubank Blvd. running parallel to the West Line of Section 33.

D.A. McCall
D.A. McCall - President Futures, Inc.

Commissioner of Public Land,
State of New Mexico

ACKNOWLEDGEMENT

STATE OF NEW MEXICO

COUNTY OF BERNALILLO

The foregoing Instrument was Acknowledged before me this 20th day of August, 1982.

My Commission Expires: June 01, 1986

Notary Public

FREE CONSENT & DEDICATION

Dedication to the Albuquerque Metropolitan Arroyo Flood Control Authority, its successors and assigns, of the lands, right-of-way, and easements designed hereon is with the full and free consent and in accordance with the desire of the undersigned owner. The Dedication is for drainage and flood control, and the construction, operation, and maintenance of related facilities. Any portion of any lands, right-of-way, or easement dedicated or granted herein shall revert to the owner, his successors and assigns as and to the extent said portion is declared unnecessary for flood and drainage by the Board of Directors of the Albuquerque Metropolitan Arroyo Flood Control Authority. Said Easement is located on the SW 1/4 of the NE 1/4 of Section 33 as shown on the Plat.

Commissioner of Public Land
State of New Mexico

ACKNOWLEDGEMENT

STATE OF NEW MEXICO

COUNTY OF BERNALILLO

The foregoing Instrument was Acknowledged before me this ___ day of ___ 1982.

My Commission Expires: ___

Notary Public

NOTES:


- Bearings are State Plane.
- Distances are ground.
- Unless otherwise noted, Corners set with rebar with Alum. Cap marked: N.M.L.S. NO. 4100.




DENNEY-GROSS & ASSOC., INC.
ENGINEERS SURVEYORS PLANNERS
2400 COMANCHE RD. NE., ALBUQ. 1 M. 87107
(505) 864-0696

APPROVALS

O. Val Valdez 8/24/82
PROPERTY MANAGER
Paul Brunker 8/24/82
WATER RESOURCES
Dan Salas 8/17/82
AMAFCA
Charles M. Estabrook 8/24/82
Planning Director
Martin Valdez 8/24/82
PARKS & RECREATION
SP-82-2P

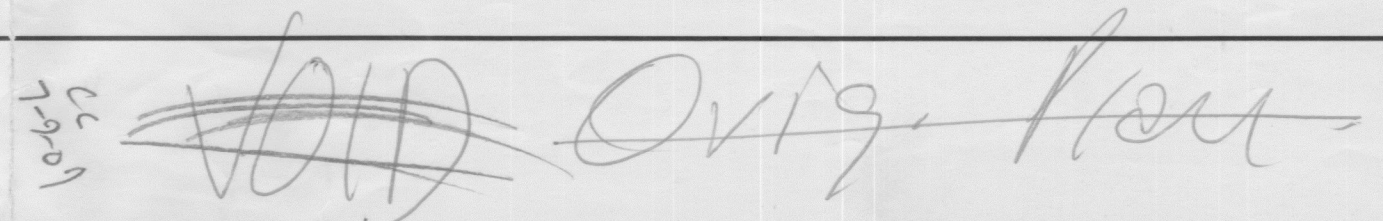

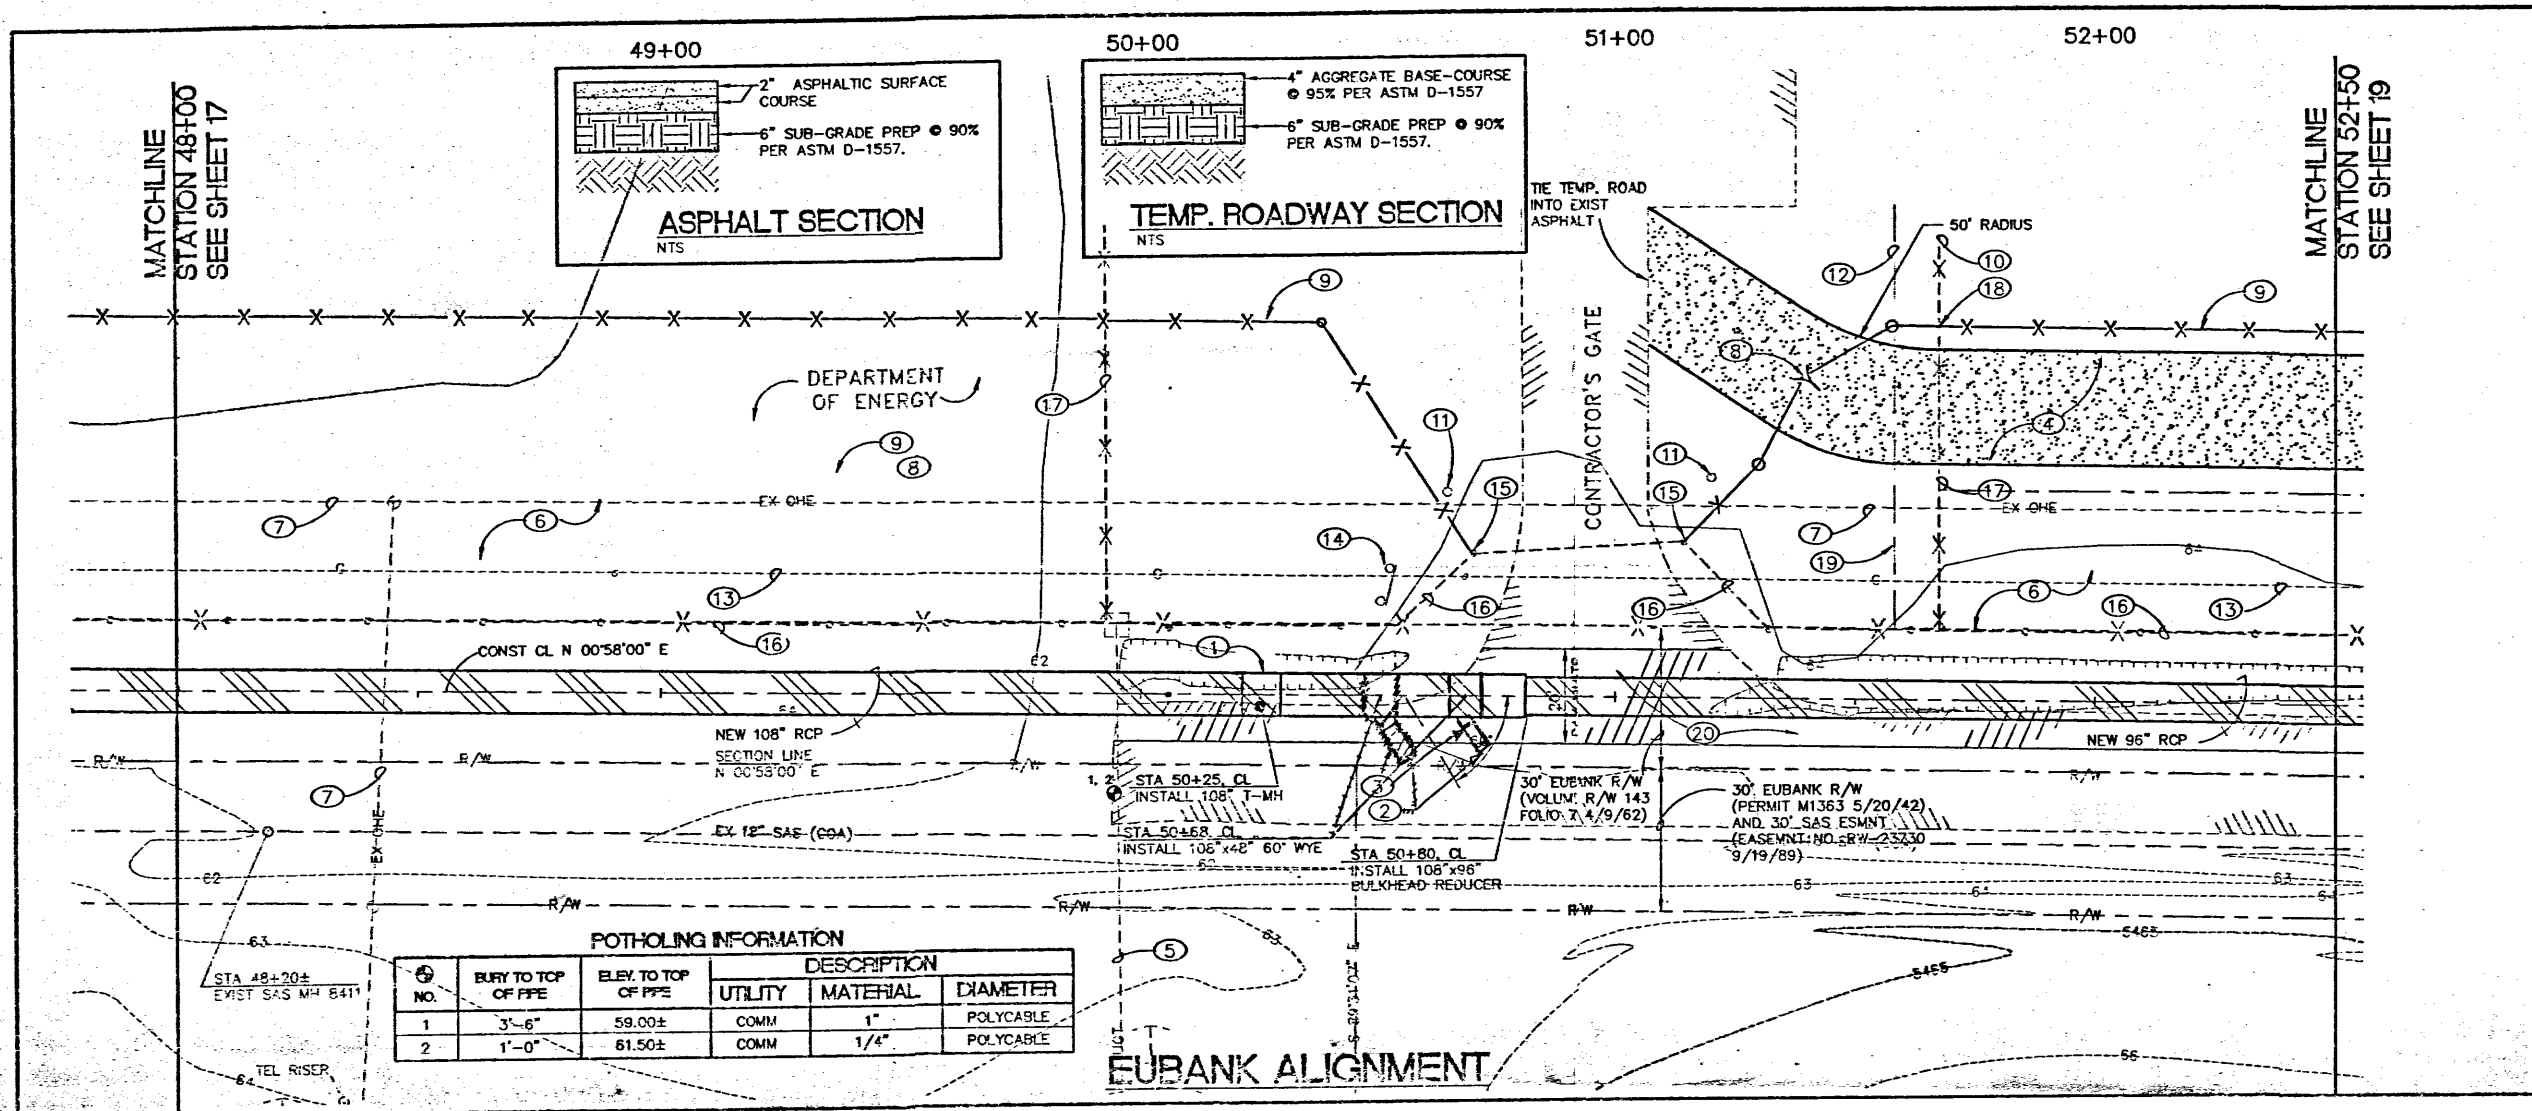

KEYED NOTES:

- INSTALL NEW T-MH. SEE DETAIL A/45. USE BOLTED MANHOLE COVER AT THIS LOCATION.
- INSTALL 48" PRE-CAST RCP PLUG.
- 8-LF 48" RCP (IV) @ 0.010 FT/FT.
- CONSTRUCT 24' WIDE TEMPORARY ACCESS ROAD. SEE TEMPORARY ROAD SECTION THIS SHEET. LEAVE TEMPORARY ROAD IN PLACE AFTER CONSTRUCTION IS COMPLETED.
- EXISTING 1" AND 1/4" UNDERGROUND COMMUNICATIONS CABLES. CONTRACTOR TO SUPPORT CABLES DURING INSTALLATION OF STORM DRAIN. COORDINATE WITH US WEST.
- CONTOURS WEST OF SECTION LINE ARE AT 2-FOOT INTERVALS AND WERE SURVEYED BY KOOGLER-POOLE ENGINEERING. CONTOURS EAST OF SECTION LINE ARE AT 1-FOOT INTERVALS AND WERE SURVEYED BY SURVEYING CONTROL, INC.
- EXISTING OVERHEAD ELECTRIC
- CONTRACTOR SHALL PROVIDE TO SNL CONTRACTOR'S AND SNL PERSONNEL ACCESS TO THE SNL CONTRACTOR'S GATE AT ALL TIMES. ACCESS WIDTH SHALL BE 40'.
- INSTALL PERIMETER FENCE FOR INSTALLATION OF NEW STORM DRAIN. CONTRACTOR SHALL COORDINATE THIS ACTIVITY WITH KAFB SECURITY PERSONNEL. CONTRACTOR SHALL NOT REMOVE EXISTING PERIMETER FENCE UNTIL CONSTRUCTION OF NEW PERIMETER FENCE IS APPROVED BY COA AND KAFB SECURITY. SEE SHEET 36 FOR DETAIL. REMOVE & DISPOSE OF TEMP PERIMETER FENCE AFTER NEW PERIMETER FENCE IS INSTALLED & APPROVED.
- NOT USED
- EXISTING WOOD LIGHT POLE. TO REMAIN
- EXISTING 8' LONG PCC PARKING BUMPERS. SHALL BE REMOVED & REPLACED AFTER CONSTRUCTION
- EXISTING PHM HIGH PRESSURE 8" STEEL GAS LINE. APPROXIMATE BURY 5'.
- EXISTING SANDIA NATIONAL LABS SIGN. SHALL REMAIN.
- BEGIN INSTALLATION OF PERIMETER FENCE.
- REMOVE & DISPOSE OF EXIST. PERIMETER FENCE AFTER INSTALLATION OF TEMP PERIMETER FENCE. INSTALL NEW PERIMETER FENCE AFTER CONSTRUCTION OF NEW SD IS COMPLETE.
- REMOVE & STORE EXIST. 3-STRAND BARBED WIRE FENCE & POSTS. RE-INSTALL FENCE AFTER CONSTRUCTION IS COMPLETED.
- CONNECT EXIST 3-STRAND BARBED WIRE TO NEW PERIMETER FENCE.
- REMOVE & STORE (6) PARKING BUMPERS. RE-INSTALL AFTER CONSTRUCTION IS COMPLETED.
- REMOVE & DISPOSE OF EXIST ASPHALT PAVEMENT. CONSTRUCT NEW ASPHALT PAVING AFTER SD INSTALLATION IS COMPLETE. SEE ASPHALT SECTION THIS SHEET.

RECORD DRAWING

Job # 195106
 Smith Engineering Company
 A Full Service Engineering Company
 4000 West Broadway, Suite 100, Albuquerque, NM 87102



CITY OF ALBUQUERQUE
 PUBLIC WORKS DEPARTMENT
 ENGINEERING DEVELOPMENT GROUP

TITLE: SOUTH EUBANK STORM DRAIN PHASE 1
 UTILITY P & P: EUBANK ALIGNMENT: STA 48+00 TO 52+50

DESIGNED BY: TWD
 DRAWN BY: SEC
 CHECKED BY: PJC

DATE: 5/98
 DATE: 5/98
 DATE: 5/98

City Project No. 4790.91
 Zone Map No. M-21 L-21
 Sheet 18 of 56

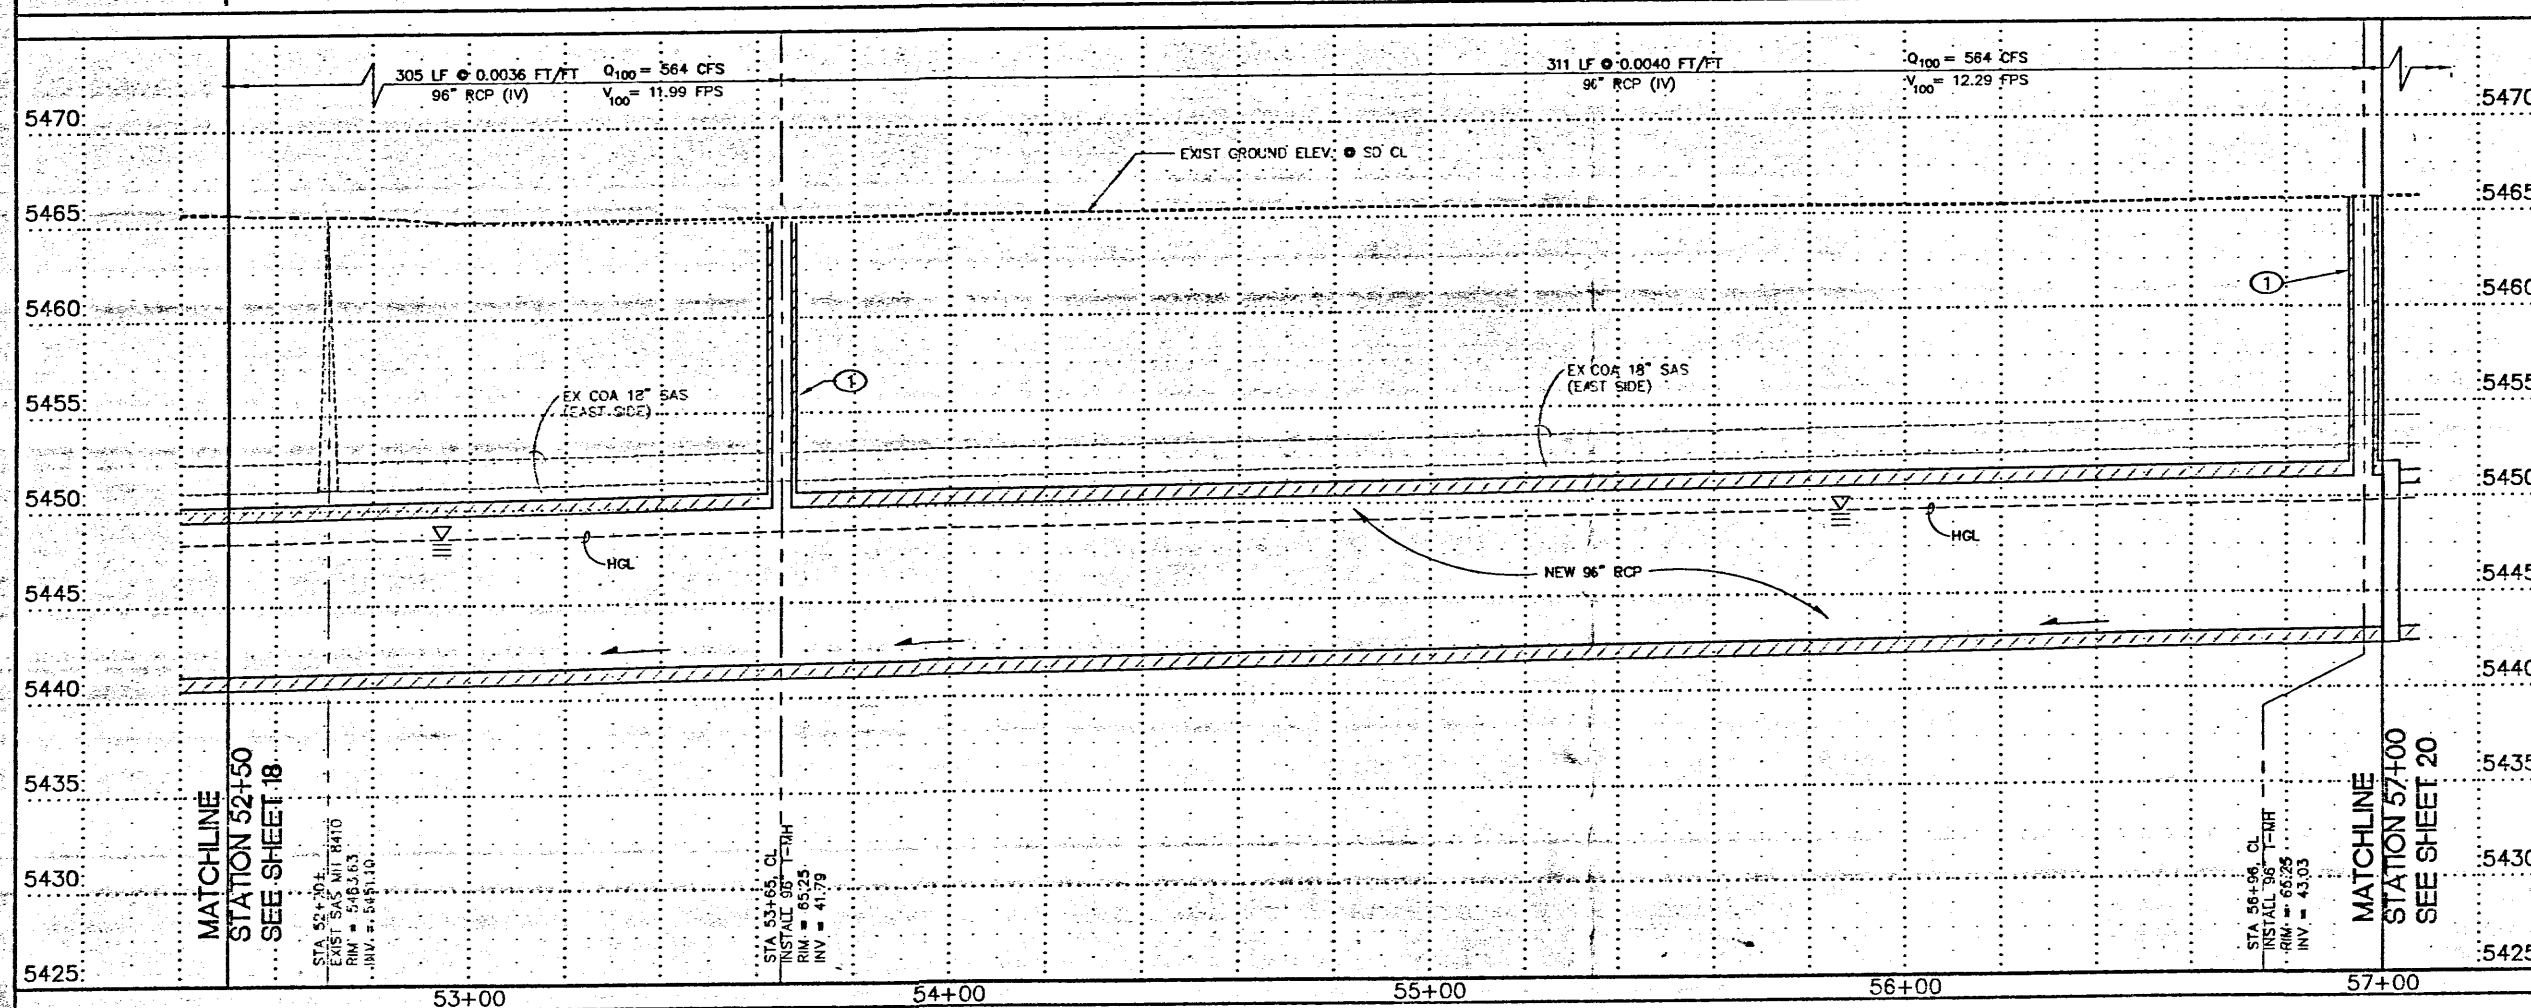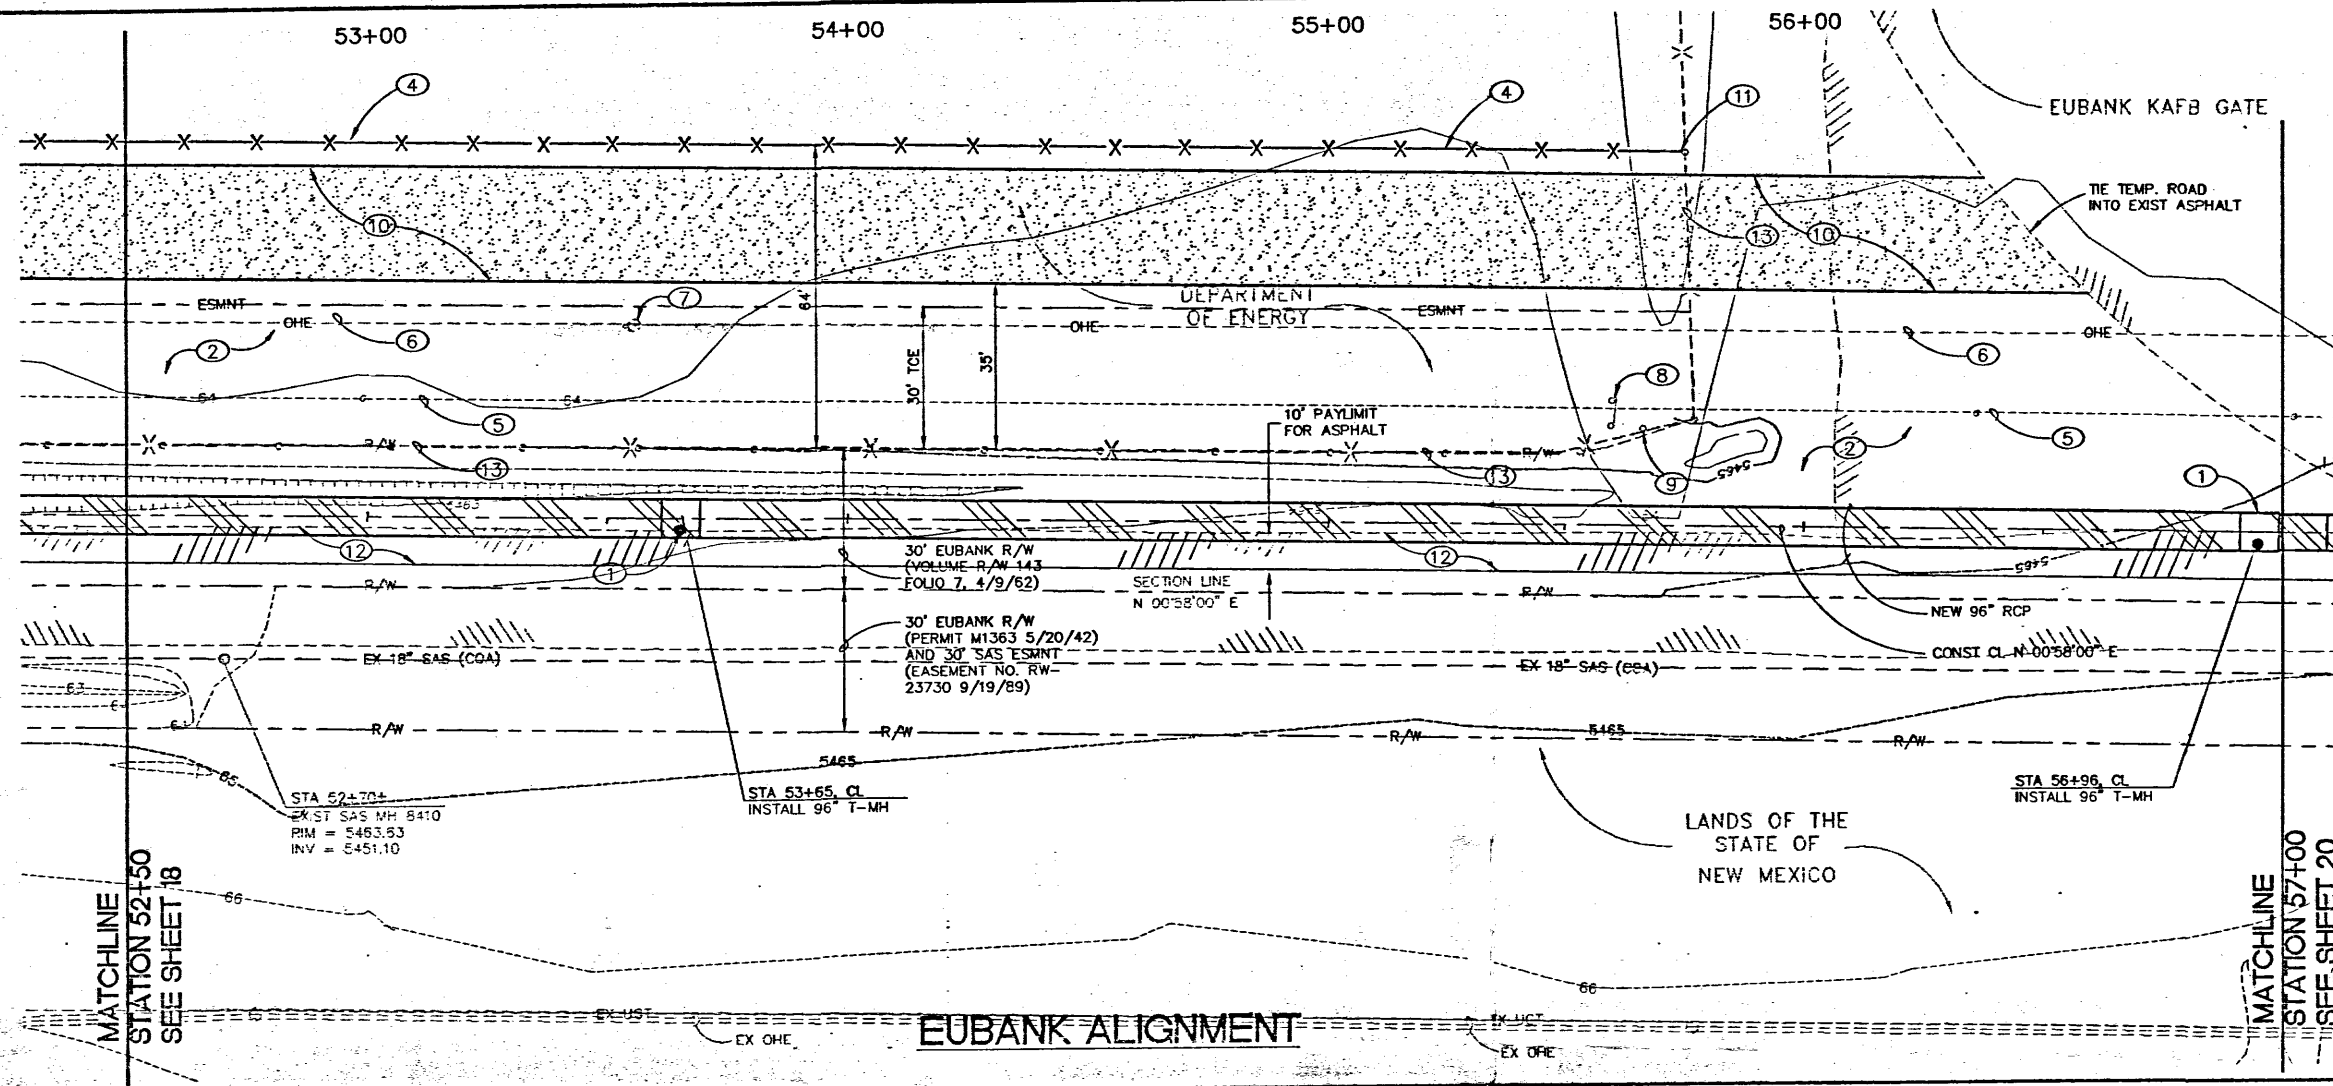

KEYED NOTES:

- INSTALL NEW T-MH. SEE DETAIL A/45. USE BOLTED MANHOLE COVER AT THIS LOCATION.
- CONTOURS WEST OF SECTION LINE ARE AT 2-FOOT INTERVALS AND WERE SURVEYED BY KOOGLER-POOLE ENGINEERING. CONTOURS EAST OF SECTION LINE ARE AT 1-FOOT INTERVALS AND WERE SURVEYED BY SURVEYING CONTROL, INC.
- NOT USED
- INSTALL PERIMETER FENCE FOR INSTALLATION OF NEW STORM DRAIN. CONTRACTOR SHALL COORDINATE THIS ACTIVITY WITH KAFB SECURITY PERSONNEL. CONTRACTOR SHALL NOT REMOVE EXISTING PERIMETER FENCE UNTIL CONSTRUCTION OF NEW PERIMETER FENCE IS APPROVED BY COA AND KAFB SECURITY. SEE SHEET 38 FOR DETAIL.
- EXISTING PNM HIGH PRESSURE 8\"/>



AS BUILT INFORMATION	
CONTRACTOR	DATE
WORKED BY	DATE
REVIEWED BY	DATE
APPROVED BY	DATE
VERIFIED BY	DATE
DOCUMENTED BY	DATE
MICRO-FILM INFORMATION	
RECORDED BY	DATE
NO.	

BENCH MARKS	
C.O.A. BENCHMARK	DATE
FROM THE INTERSECTION OF EUBANK AND THE FUTURE	
INTERSECTION GO DIRECTLY EAST 292'	
ELEVATION = 5471.78'	
GROUND COORDINATES:	
NORTHING = 1,481,746.33	
EASTING = 418,123.51	
GRID COORDINATES:	
NORTHING = 1,481,220.09	
EASTING = 417,975.01	
GROUND TO GRID FACTOR: 0.99964485	

SURVEY INFORMATION	
NO.	DATE
11599	STEPHEN JAMES
	TOLER, FROM
	SURVEYING CONTROL
	INC.


ENGINEER'S SEAL	
REGISTERED PROFESSIONAL ENGINEER	DATE
NO.	DATE

DESIGN REVISIONS	
NO.	DATE
1	5/98
2	5/98
3	5/98
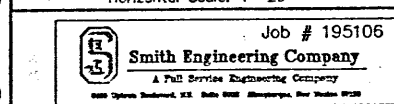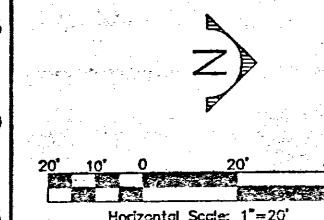

CITY OF ALBUQUERQUE PUBLIC WORKS DEPARTMENT ENGINEERING DEVELOPMENT GROUP	
TITLE: SOUTH EUBANK STORM DRAIN PHASE 1 UTILITY P & P: EUBANK ALIGNMENT: STA 52+50 TO 57+00	
Design Review Committee	City Engineer Approval
DESIGN REVIEW COMMITTEE	CITY ENGINEER
City Project No. 4790.91	Zone Map No. M-21 L-21
Sheet 29	of 56

RECORD DRAWING

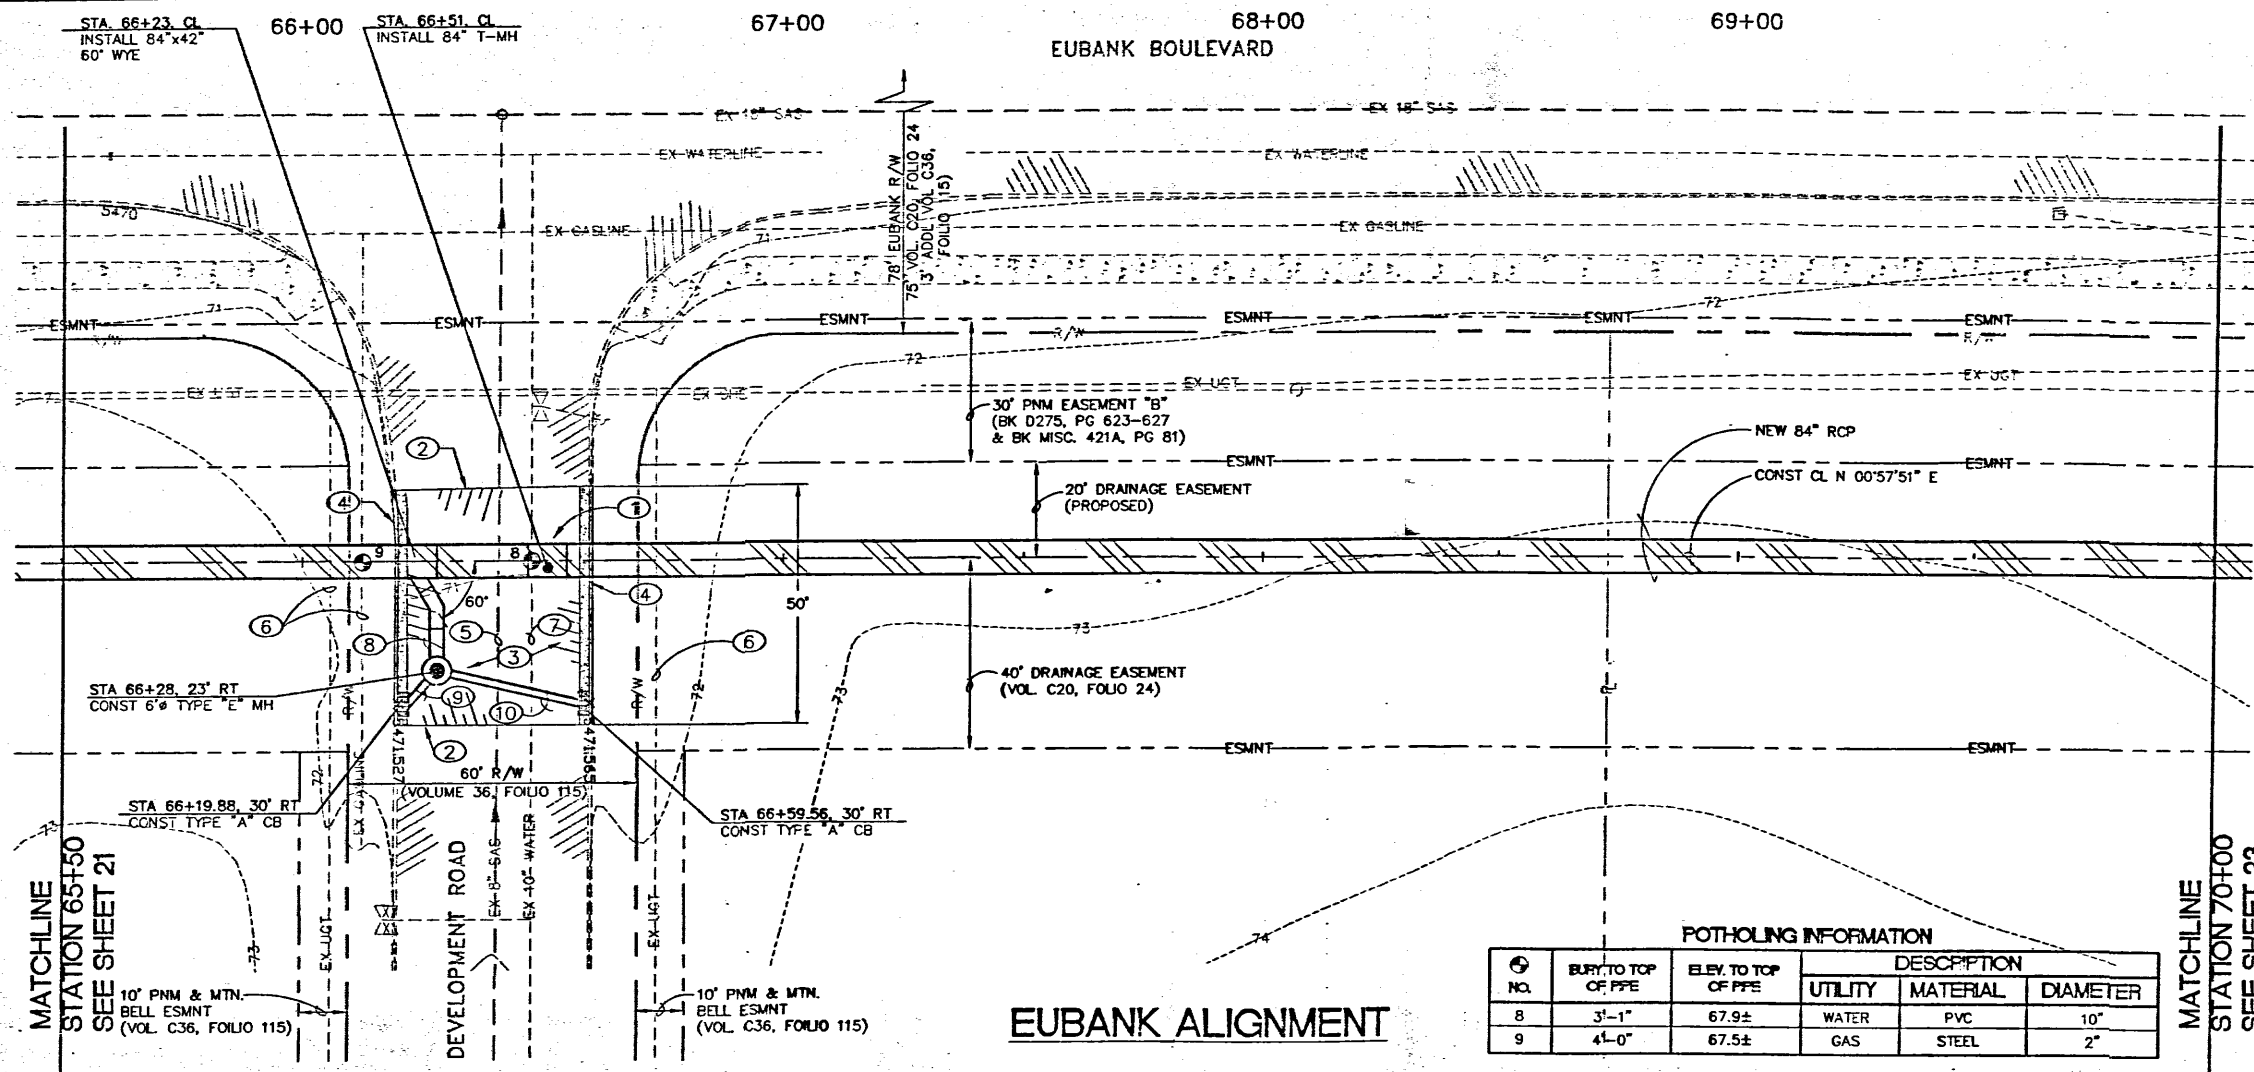

POTHOLING INFORMATION

NO.	DEPTH TO TOP OF PPE	ELEV. TO TOP OF PPE	DESCRIPTION		
			UTILITY	MATERIAL	DIAMETER
8	3'-1"	67.9±	WATER	PVC	10"
9	4'-0"	67.5±	GAS	STEEL	2"

KEYED NOTES:

1. INSTALL NEW T-MH. SEE DETAIL A/45.
2. MATCH EDGE OF EXISTING PAVEMENT.
3. REMOVE AND REPLACE 200-SY OF ASPHALT PAVING, MATCH EXISTING GRADES. MAINTAIN 2% CROWN IN PATCH SECTION. SEE PATCH DETAIL SHEET 20.
4. REMOVE AND REPLACE 100-LF STD CURB-AND-GUTTER (50-LF EACH SIDE) PER COA STD DWG 2415. MATCH EXISTING FLOWLINE AND TOP OF CURB ELEVATIONS.
5. SUPPORT EXISTING 8" SAS FOR STORM DRAIN INSTALLATION.
6. PROVIDE SUPPORT OF EXISTING GAS AND COMMUNICATION LINES FOR STORM DRAIN INSTALLATION. COORDINATE WITH AFFECTED UTILITY COMPANIES.
7. SUPPORT EXISTING 10" WATER AS REQUIRED FOR INSTALLATION OF NEW STORM DRAIN.
8. SEE SHEET 38 FOR PROFILE OF SEGMENT "A" ON DEVELOPMENT ROAD.
9. SEE SHEET 38 FOR PROFILE OF SEGMENT "B" ON DEVELOPMENT ROAD.
10. SEE SHEET 38 FOR PROFILE OF SEGMENT "C" ON DEVELOPMENT ROAD.

RECORD DRAWINGS

ENGINEER'S SEAL

REVISIONS


Smith Engineering Company
Job # 195106
A Full Service Engineering Company
2000 Wayne Boulevard, S.E. Suite 2000, Marietta, GA 30067

**CITY OF ALEXANDRIA
PUBLIC WORKS DEPARTMENT
ENGINEERING DEVELOPMENT GROUP**

**TITLE: SOUTH EUBANK STORM DRAIN PHASE 1
UTILITY P & P: EUBANK ALIGNMENT: STA 65+50 TO 70+00**

DESIGN REVIEW COMMITTEE	CITY ENGINEER APPROVAL	DATE	BY
APR 26 2000	APR 26 2000	5/98	5/98
DESIGN REVIEW COMMITTEE	CITY ENGINEER	DATE	BY
		5/98	5/98


City Project No. **4790.91** Zone Map No. **M-21 L-21** Sheet **22** of **56**

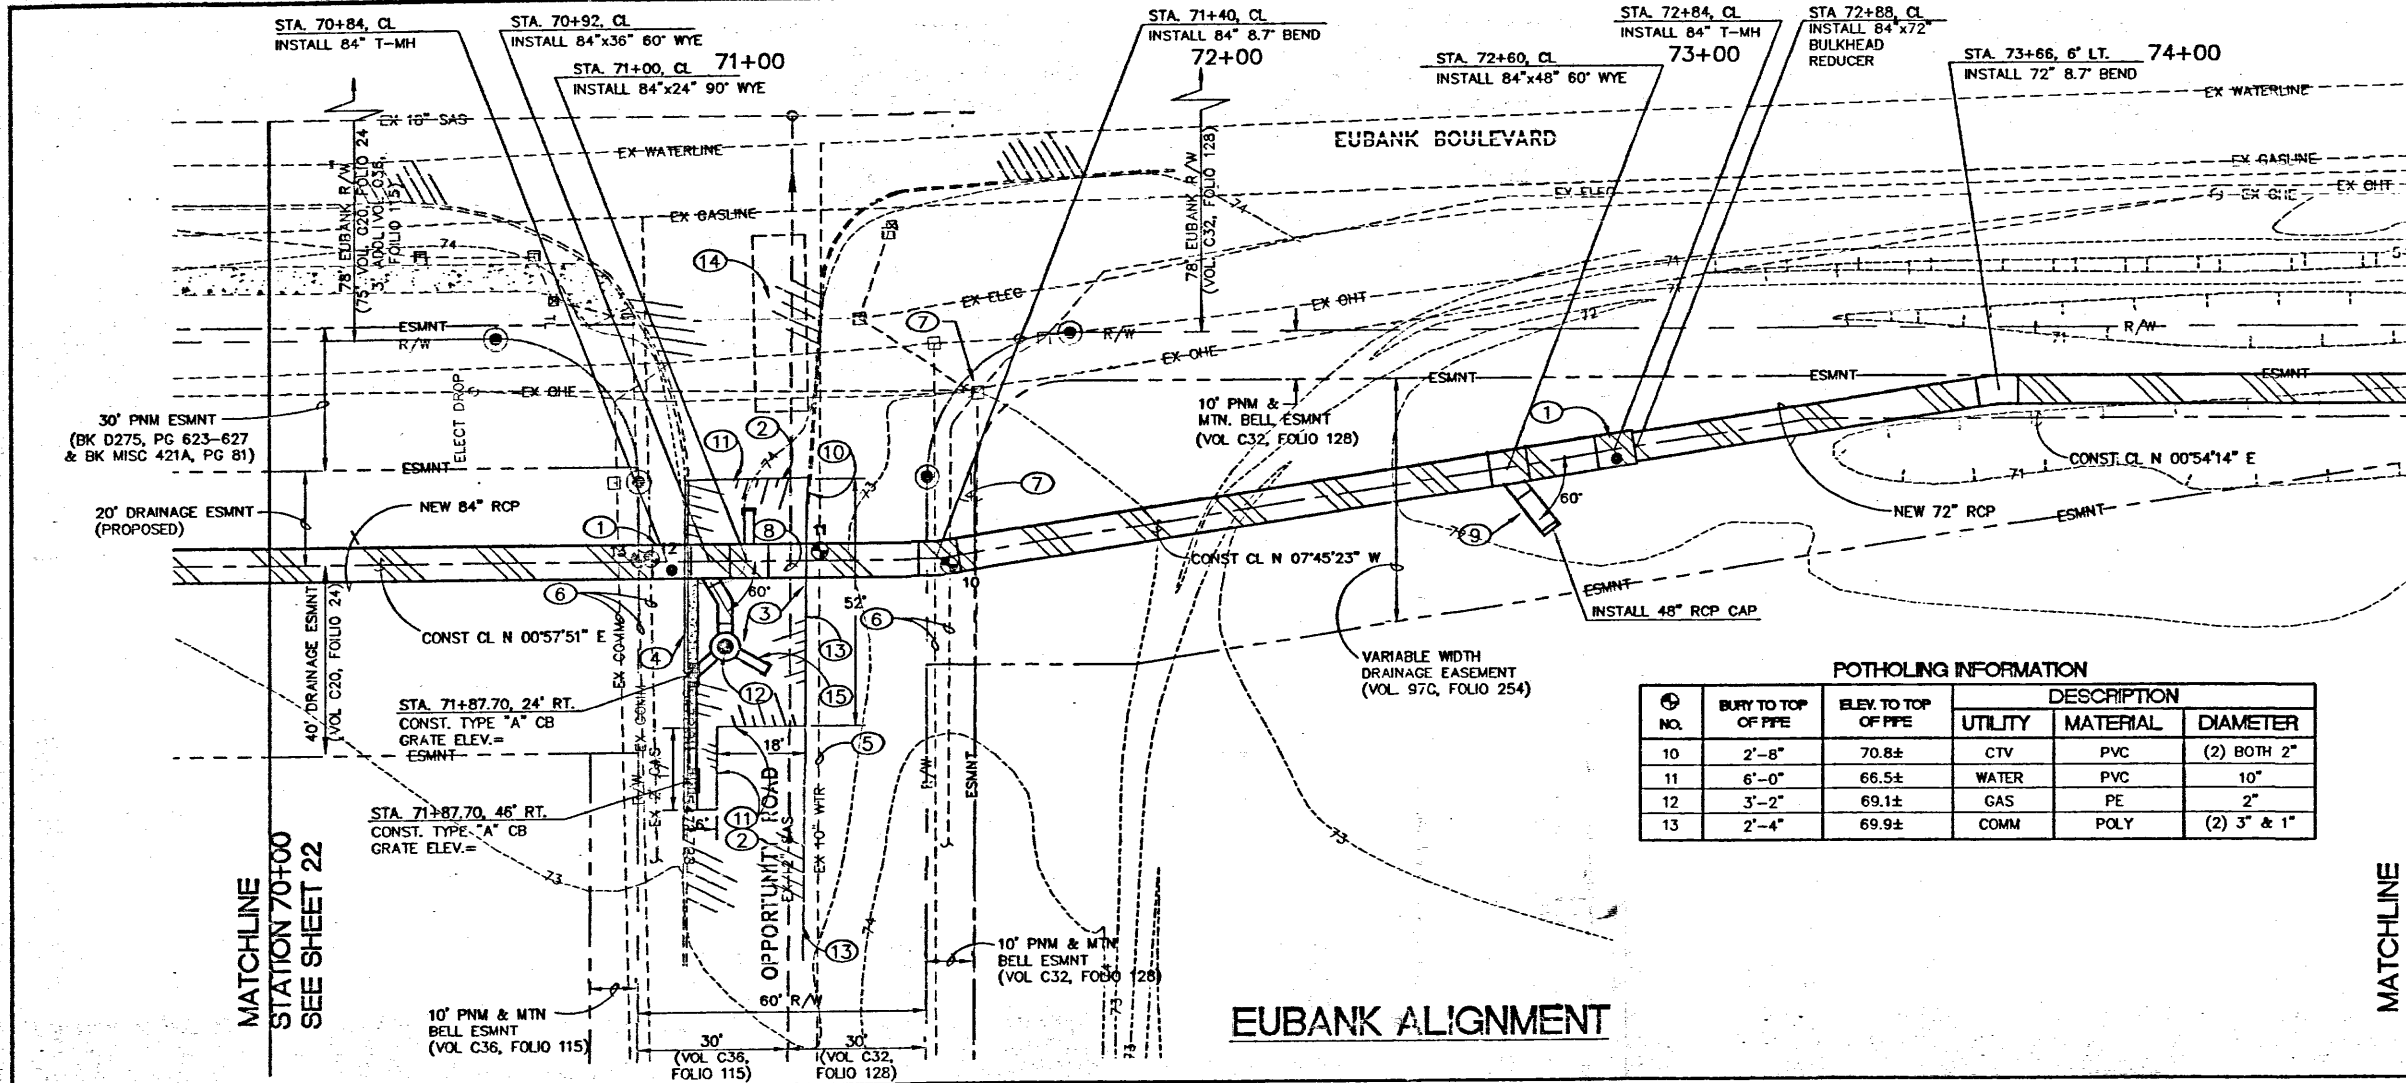

POTHOLING INFORMATION					
NO.	BURY TO TOP OF PIPE	ELEV. TO TOP OF PIPE	DESCRIPTION		
			UTILITY	MATERIAL	DIAMETER
10	2'-8"	70.8±	CTV	PVC	(2) BOTH 2"
11	6'-0"	66.5±	WATER	PVC	10"
12	3'-2"	69.1±	GAS	PE	2"
13	2'-4"	69.9±	COMM	POLY	(2) 3" & 1"

KEYED NOTES:

1. INSTALL NEW T-MH. SEE DETAIL A/45.
2. MATCH EXISTING EDGE OF PAVEMENT.
3. REMOVE AND REPLACE 150-SY ASPHALT PAVEMENT. MATCH EXISTING GRADES. MAINTAIN 2% CROSS SLOPE IN PATCH SECTION. CONSTRUCT NEW ASPHALT SECTION PER DETAIL SHEET 20.
4. CONSTRUCT 50-LF STANDARD CURB-AND-GUTTER PER COA STD DWG 2415.
5. PROVIDE SUPPORT FOR EXISTING 10" WATERLINE FOR INSTALLATION OF NEW STORM DRAIN.
6. PROVIDE SUPPORT FOR EXISTING GAS AND COMMUNICATION LINES. COORDINATE WITH AFFECTED UTILITY COMPANIES.
7. COORDINATE WITH PNM TO SUPPORT EXISTING POWER POLE AND TO TEMPORARILY RELOCATE DOWN WIRES FOR INSTALLATION OF STORM DRAIN. REINSTALL NEW DOWN WIRES AFTER CONSTRUCTION IS COMPLETE.
8. PROVIDE SUPPORT FOR EXISTING 12" SAS FOR INSTALLATION OF NEW STORM DRAIN.
9. INSTALL 8-LF OF 48" RCP SD (IV) @ 0.010 FT/FT. INV @ TERMINATION = 56.27.
10. REMOVE 5-LF OF AC-CURB. DO NOT REPLACE.
11. LIMITS OF PAVEMENT FOR ASPHALT REMOVAL.
12. SEE SHEET 38 FOR PROFILE OF 36" RCP AND CATCH BASINS.
13. EXISTING EDGE OF PAVEMENT.
14. EXISTING LOOP DETECTOR TO REMAIN.
15. INSTALL 8-LF OF 24" RCP SD (IV) @ 0.010 FT/FT. INV @ TERMINATION = 56.20. INSTALL 24" PRE-CAST RCP CAP @ END OF PIPE.
16. INSTALL 8 LF OF 24" RCP STORM DRAIN (IV) @ 0.010 FT/FT. INVERT @ TERMINATION = 56.20. INSTALL 24" CAP AND GASKET AT END OF PIPE.

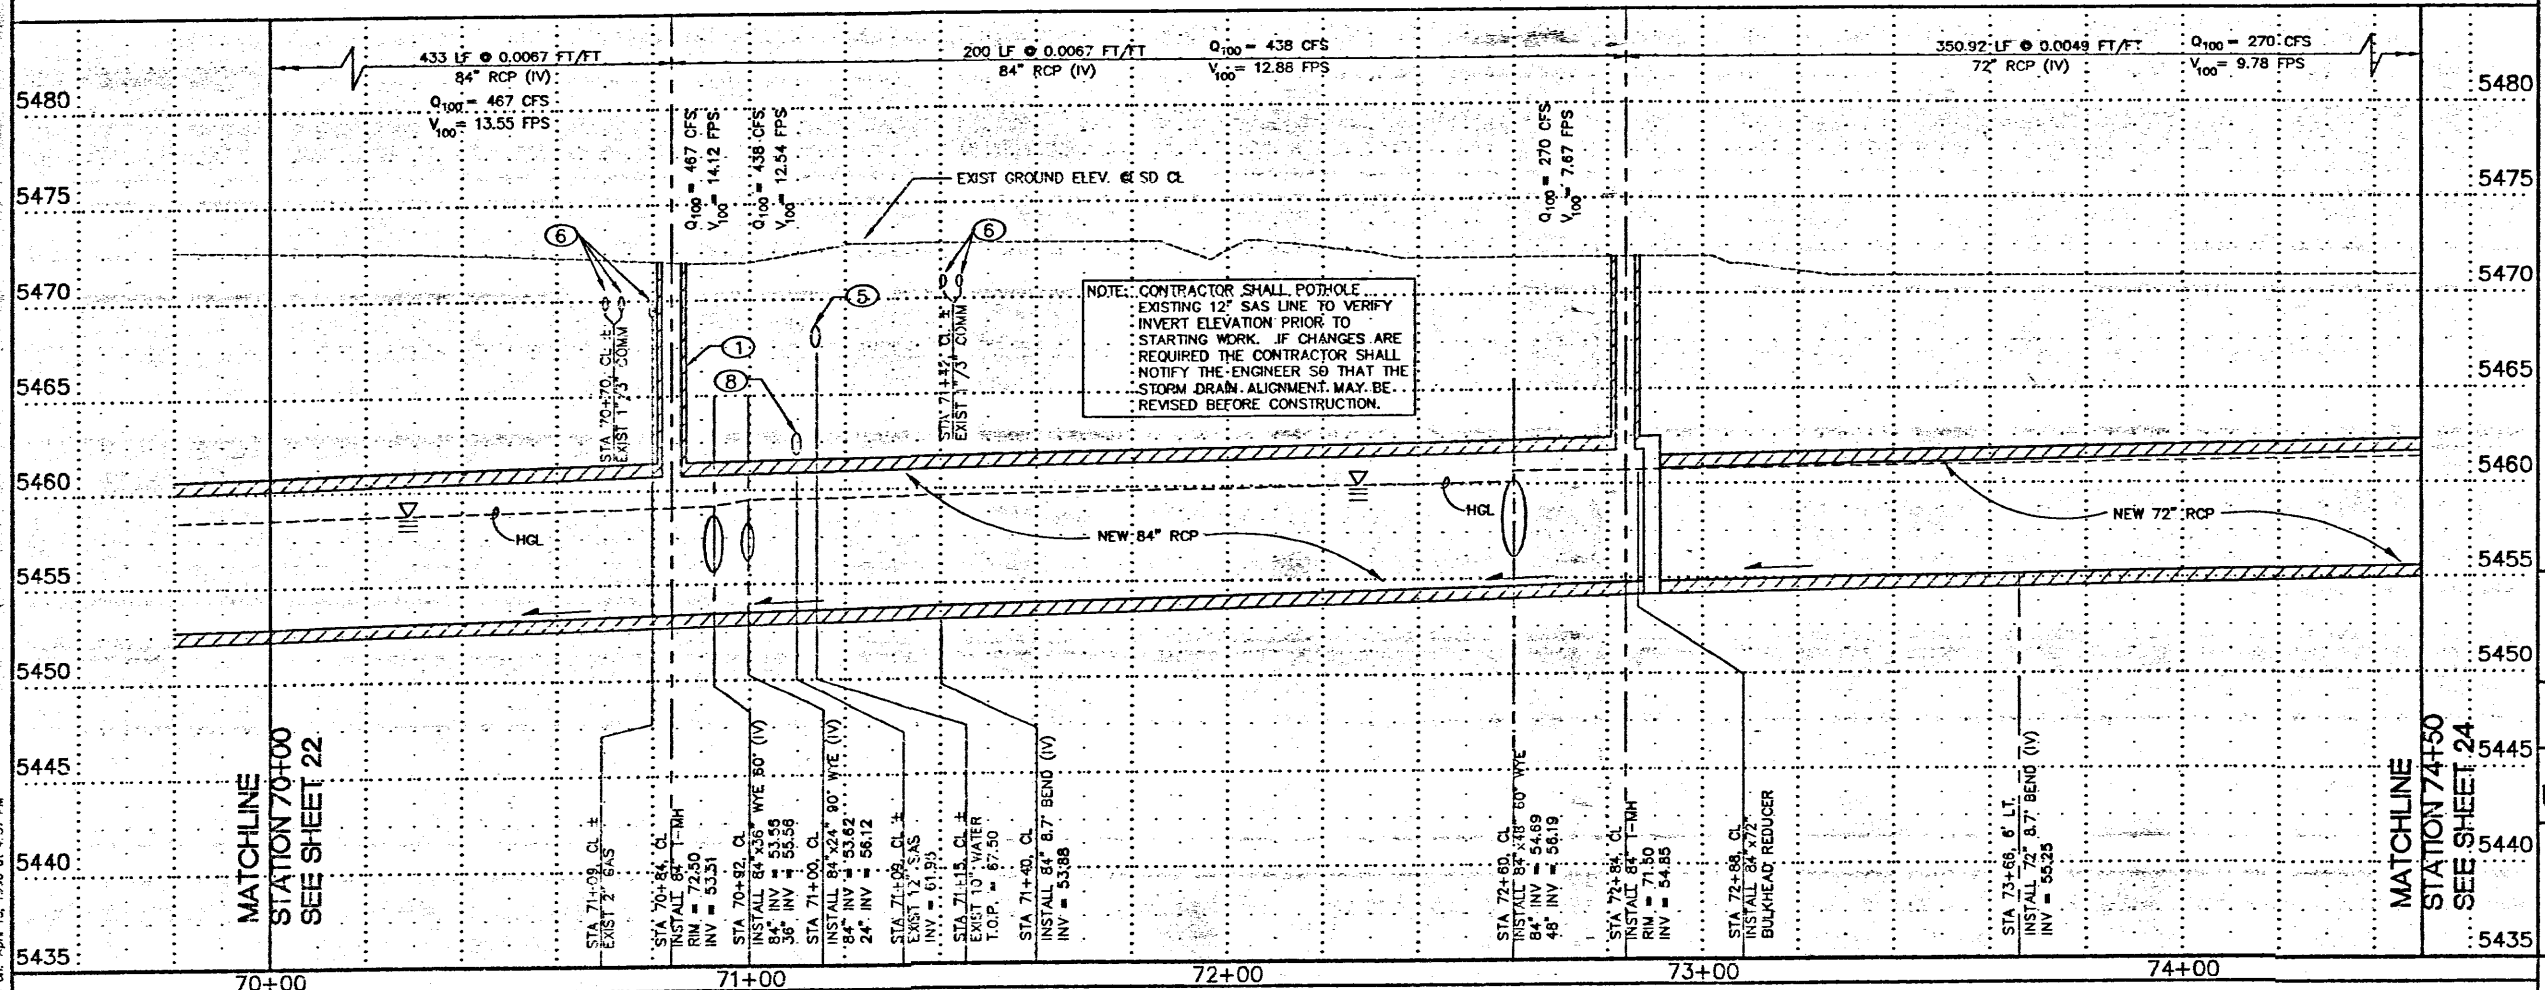

RECORD DRAWING

ENGINEER'S SEAL

NO. DATE

REVISIONS

DESIGN

DESIGNED BY: TWO DATE: 5/98

DRAWN BY: SEC DATE: 5/98

CHECKED BY: PJC DATE: 5/98

Job # 195106

Smith Engineering Company

A Full Service Engineering Company

City of Albuquerque

PUBLIC WORKS DEPARTMENT

ENGINEERING DEVELOPMENT GROUP

TITLE: SOUTH EUBANK STORM DRAIN PHASE 1

UTILITY P & P: EUBANK ALIGNMENT: STA 70+00 TO 74+50

Design Review Committee



City Engineer Approval

City Project No. 4790.91

Zone Map No. M-21 L-21

Sheet 23 of 56


\\s0106r\station\1024mp.dwg Fri Sep 03 10:06:21 1999 Michael J. Riordan

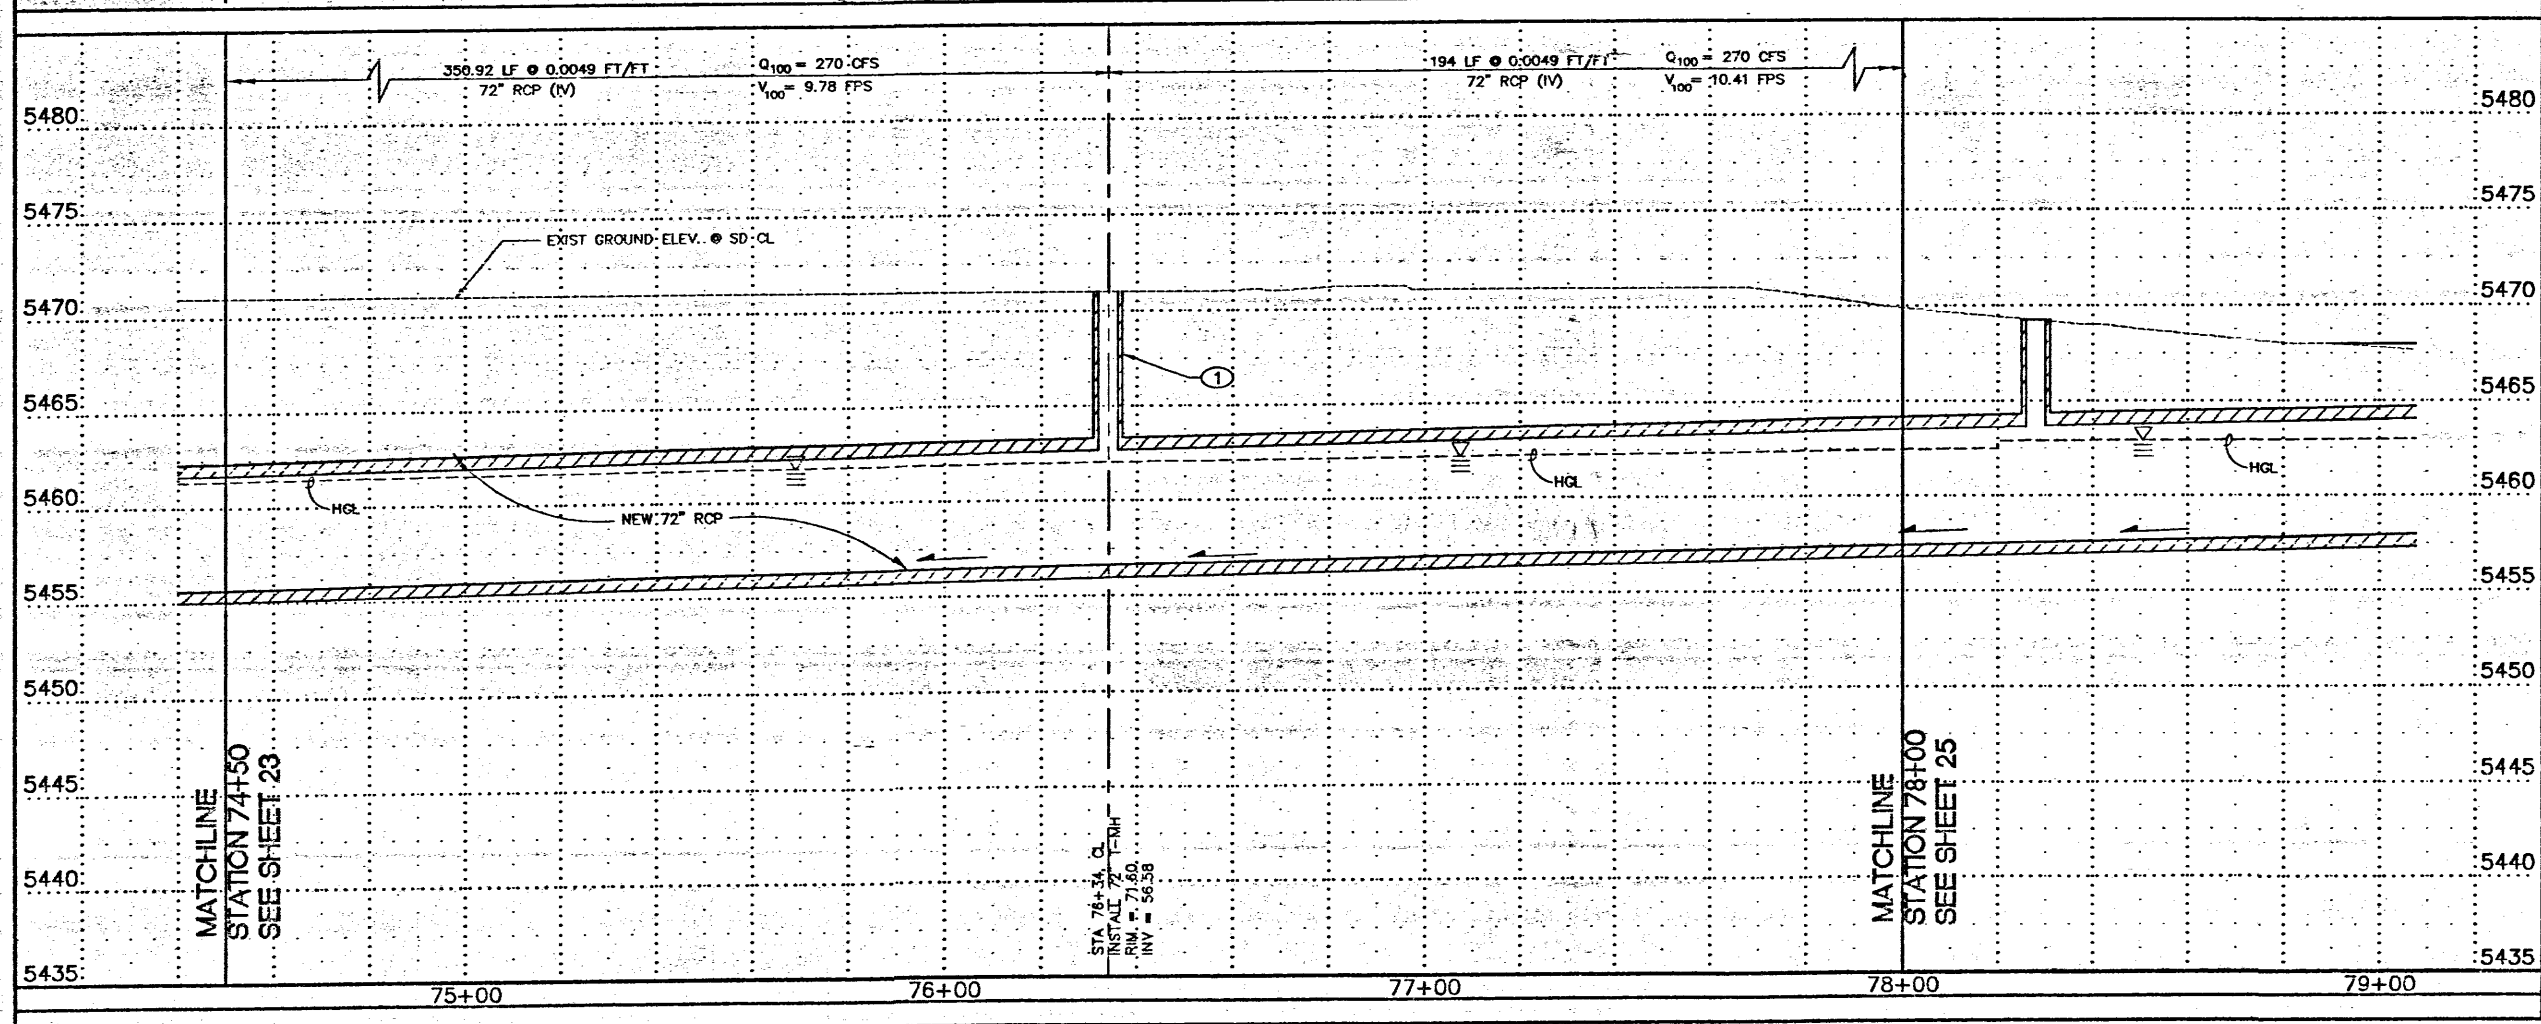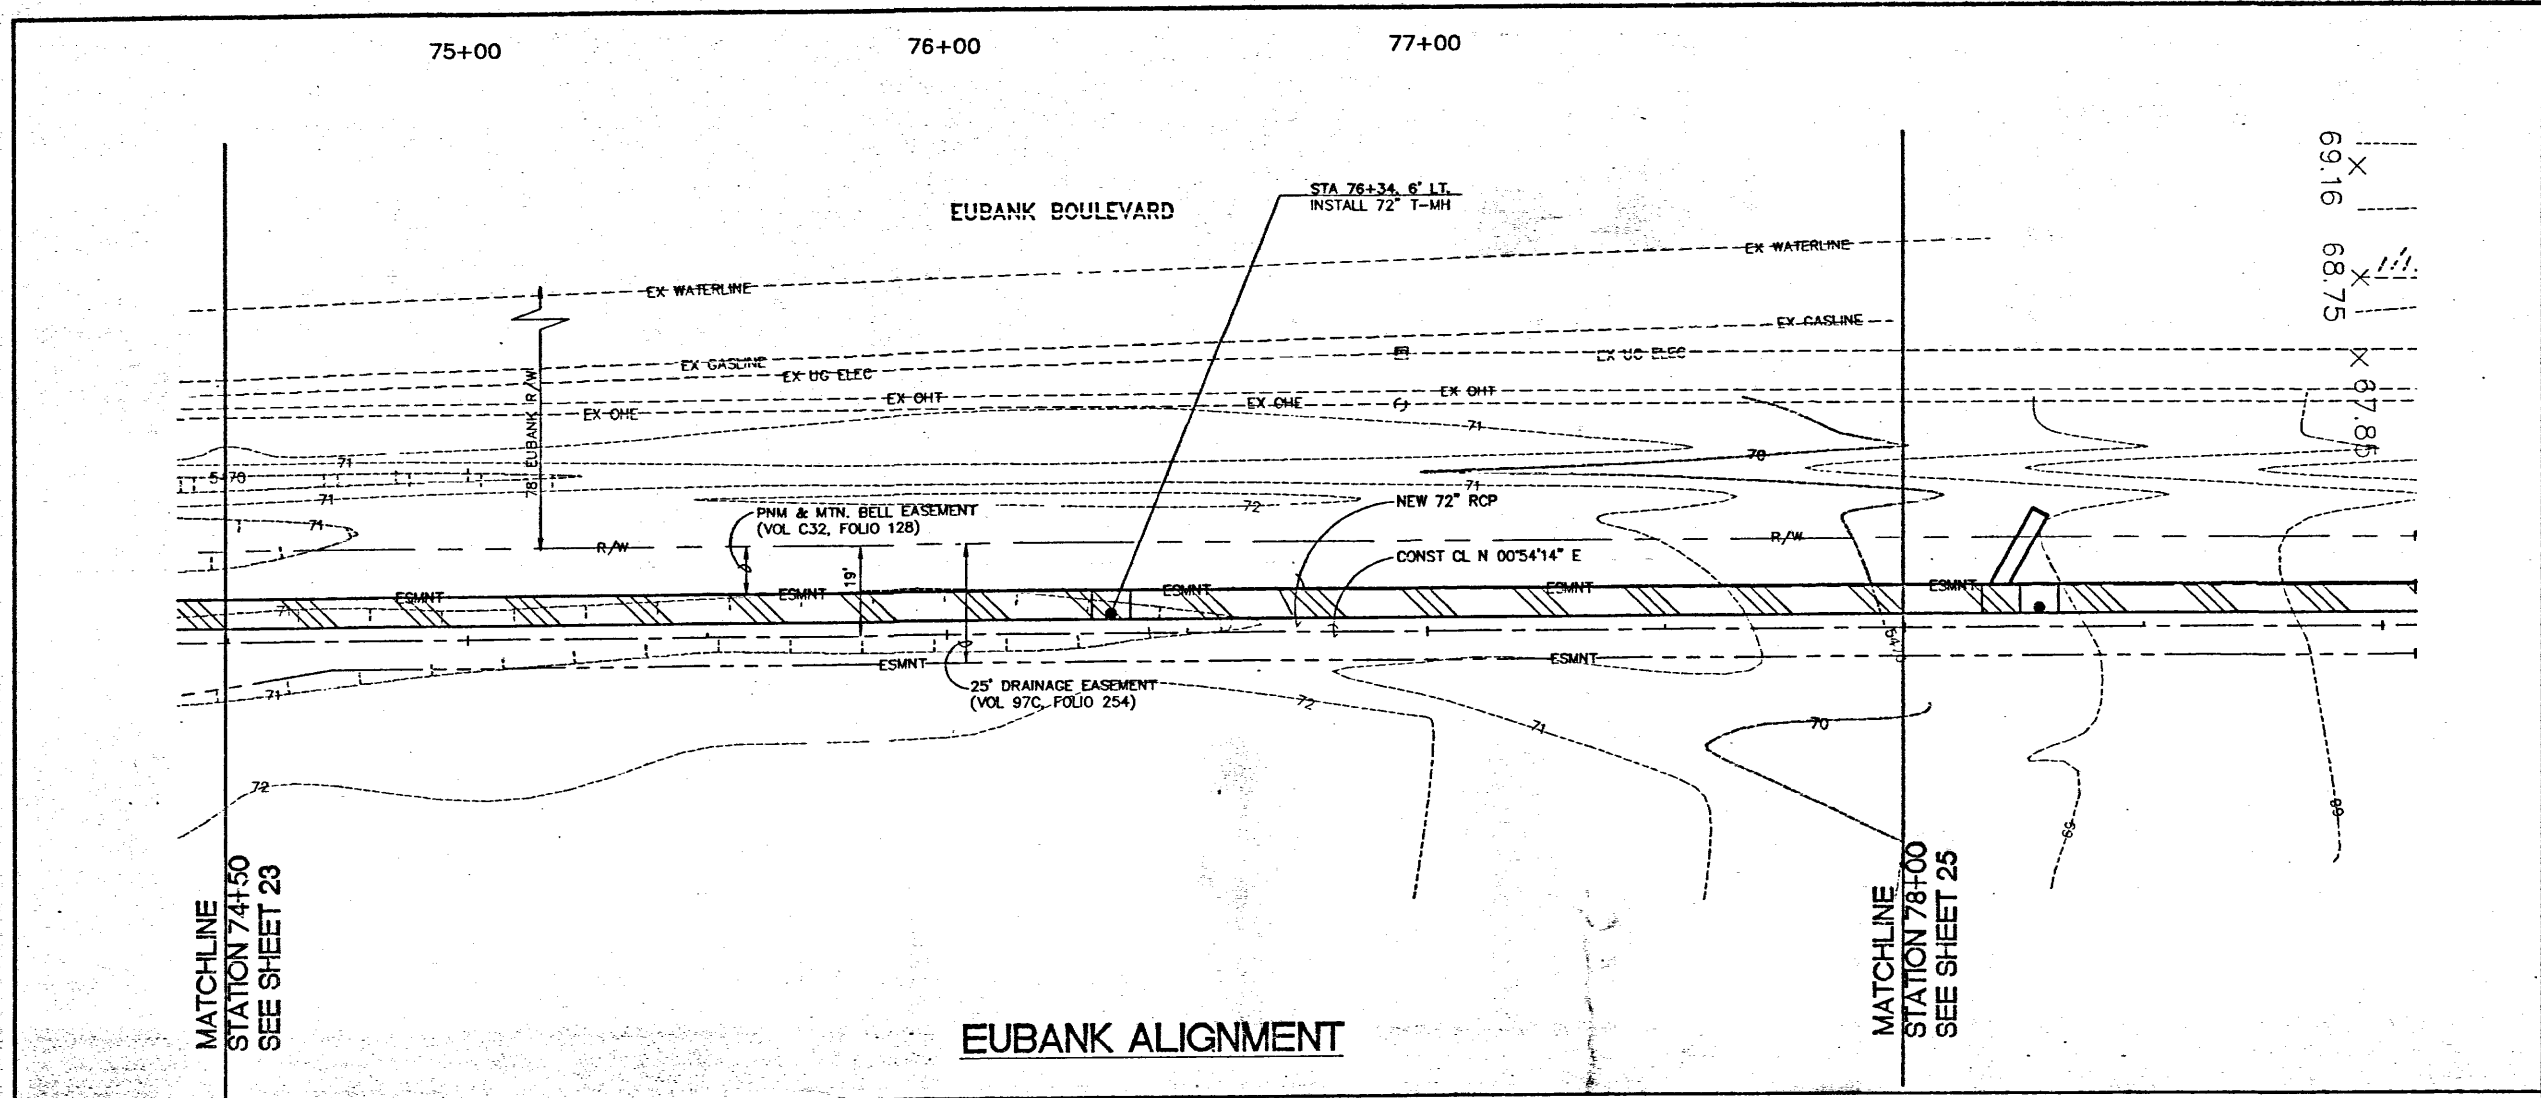

KEYED NOTES:

1. INSTALL NEW T-MH. SEE DETAIL A/45.

RECORD DRAWINGS

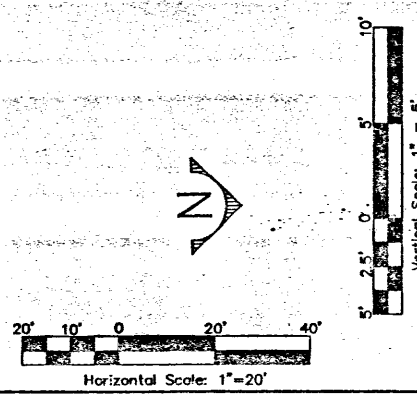

CITY OF ALBUQUERQUE
PUBLIC WORKS DEPARTMENT
ENGINEERING DEVELOPMENT GROUP

TITLE: SOUTH EUBANK STORM DRAIN PHASE 1
UTILITY P & P: EUBANK ALIGNMENT: STA 74+50 TO 78+00

Design Review Committee	City Engineer Approval

NO.	DATE	REVISIONS	BY

DESIGNED BY	TWO	DATE	5/98
DRAWN BY	SEC	DATE	5/98
CHECKED BY	PUC	DATE	5/98

City Project No. 4790.91

Zone Map No. M-21 L-21

Sheet 24 of 56

AS BUILT INFORMATION		BENCH MARKS		SURVEY INFORMATION		ENGINEER'S SEAL	
CONTRACTOR	DATE	C.O.A. BENCHMARK	DATE	NO.	BY	DATE	FIELD NOTES
BY	DATE	FROM THE INTERSECTION OF EUBANK AND THE FUTURE	DATE	11599	STEPHEN JAMES	11/5/99	INTERSECTION GO DIRECTLY EAST 292'
ACCEPTANCE BY	DATE	INTERSECTION ELEVATION	DATE		TOLER, FROM		ELEVATION = 5471.78'
FIELD DRAWING BY	DATE	GROUND COORDINATES	DATE		SURVEYING CONTROL		GROUND COORDINATES: NORTHING = 1,481,746.33
CORRECTED BY	DATE	EASTING = 418,123.51	DATE		INC.		EASTING = 418,123.51
RECORDED BY	DATE	GRID COORDINATES	DATE				GRID COORDINATES: NORTHING = 1,481,220.09
NO.		EASTING = 417,975.01	DATE				EASTING = 417,975.01
		GROUND TO GRID FACTOR: 0.99964485					

THOMAS J. CONLEY
REGISTERED PROFESSIONAL ENGINEER
No. 11599
State of New Mexico

5/98

M21/0007A

FIVE

Sandia Science
+ Tech Park