


MATCHLINE - SEE PLATE 4

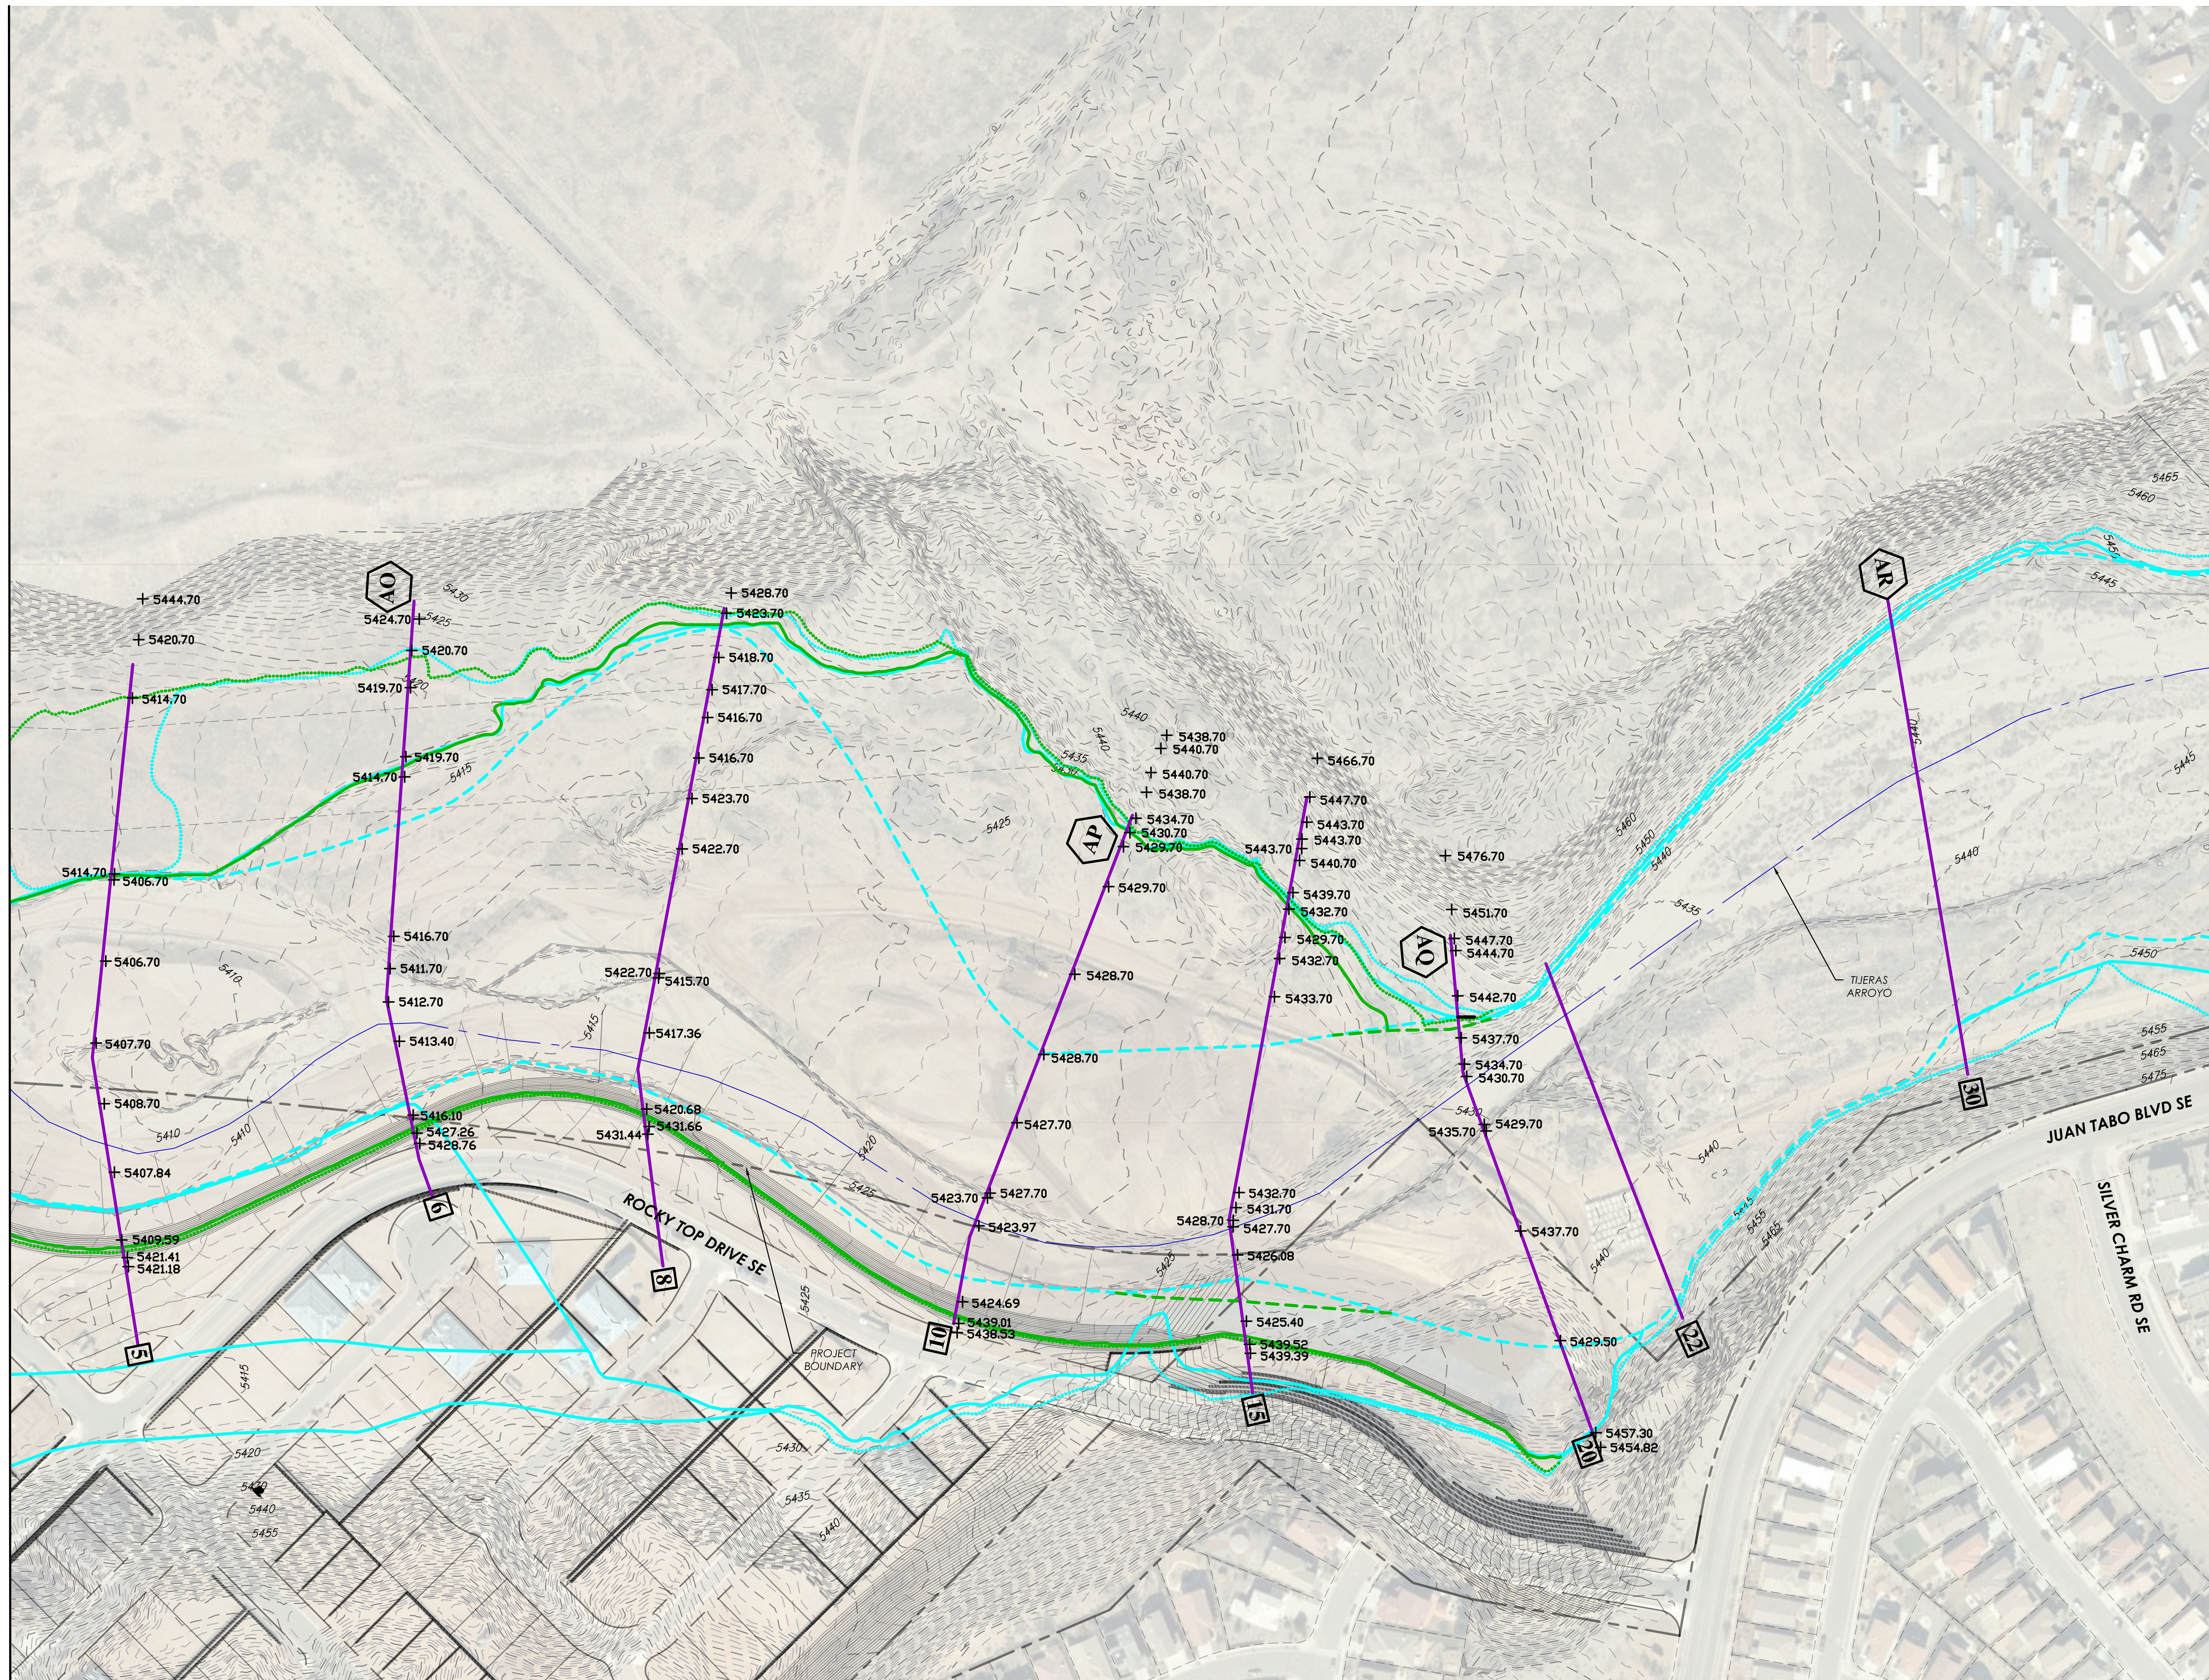

MATCHLINE - SEE PLATE 6

LEGEND

- STREAM CENTERLINE
- CROSS SECTION
- 50 CROSS SECTION NUMBER
- 655 --- EXISTING CONTOUR
- EFFECTIVE 100-YR FLOODPLAIN
- EFFECTIVE 100-YR FLOODWAY
- EFFECTIVE 500-YR FLOODPLAIN
- AS-BUILT 100-YR FLOODPLAIN
- AS-BUILT 500-YR FLOODPLAIN
- AS-BUILT SURVEY ELEVATION
- x 5400
- AM EFFECTIVE FEMA CROSS SECTION



PREPARED BY:

dmg MARK GOODWIN & ASSOCIATES, P.A.
CONSULTING ENGINEERS
P.O. BOX 90608
ALBUQUERQUE, NEW MEXICO 87199
(505)828-2200, FAX (505)797-9539

**CORRECTED EFFECTIVE
CONDITIONS
TOPOGRAPHIC WORKMAP
OF
TIJERAS ARROYO
FOR
JUAN TABO HILLS WEST
CITY OF ALBUQUERQUE,
NEW MEXICO**
Date: June 2022