

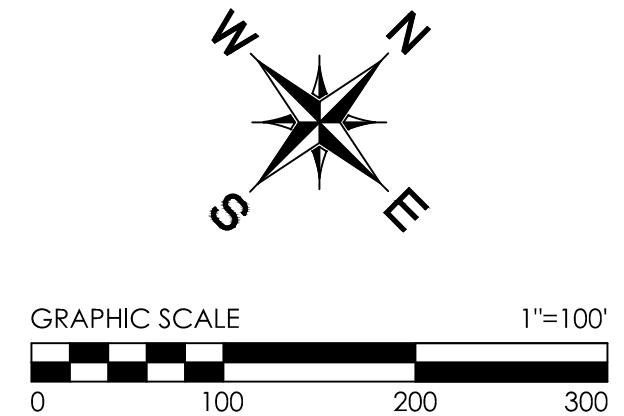


MATCHLINE - SEE PLATE 5

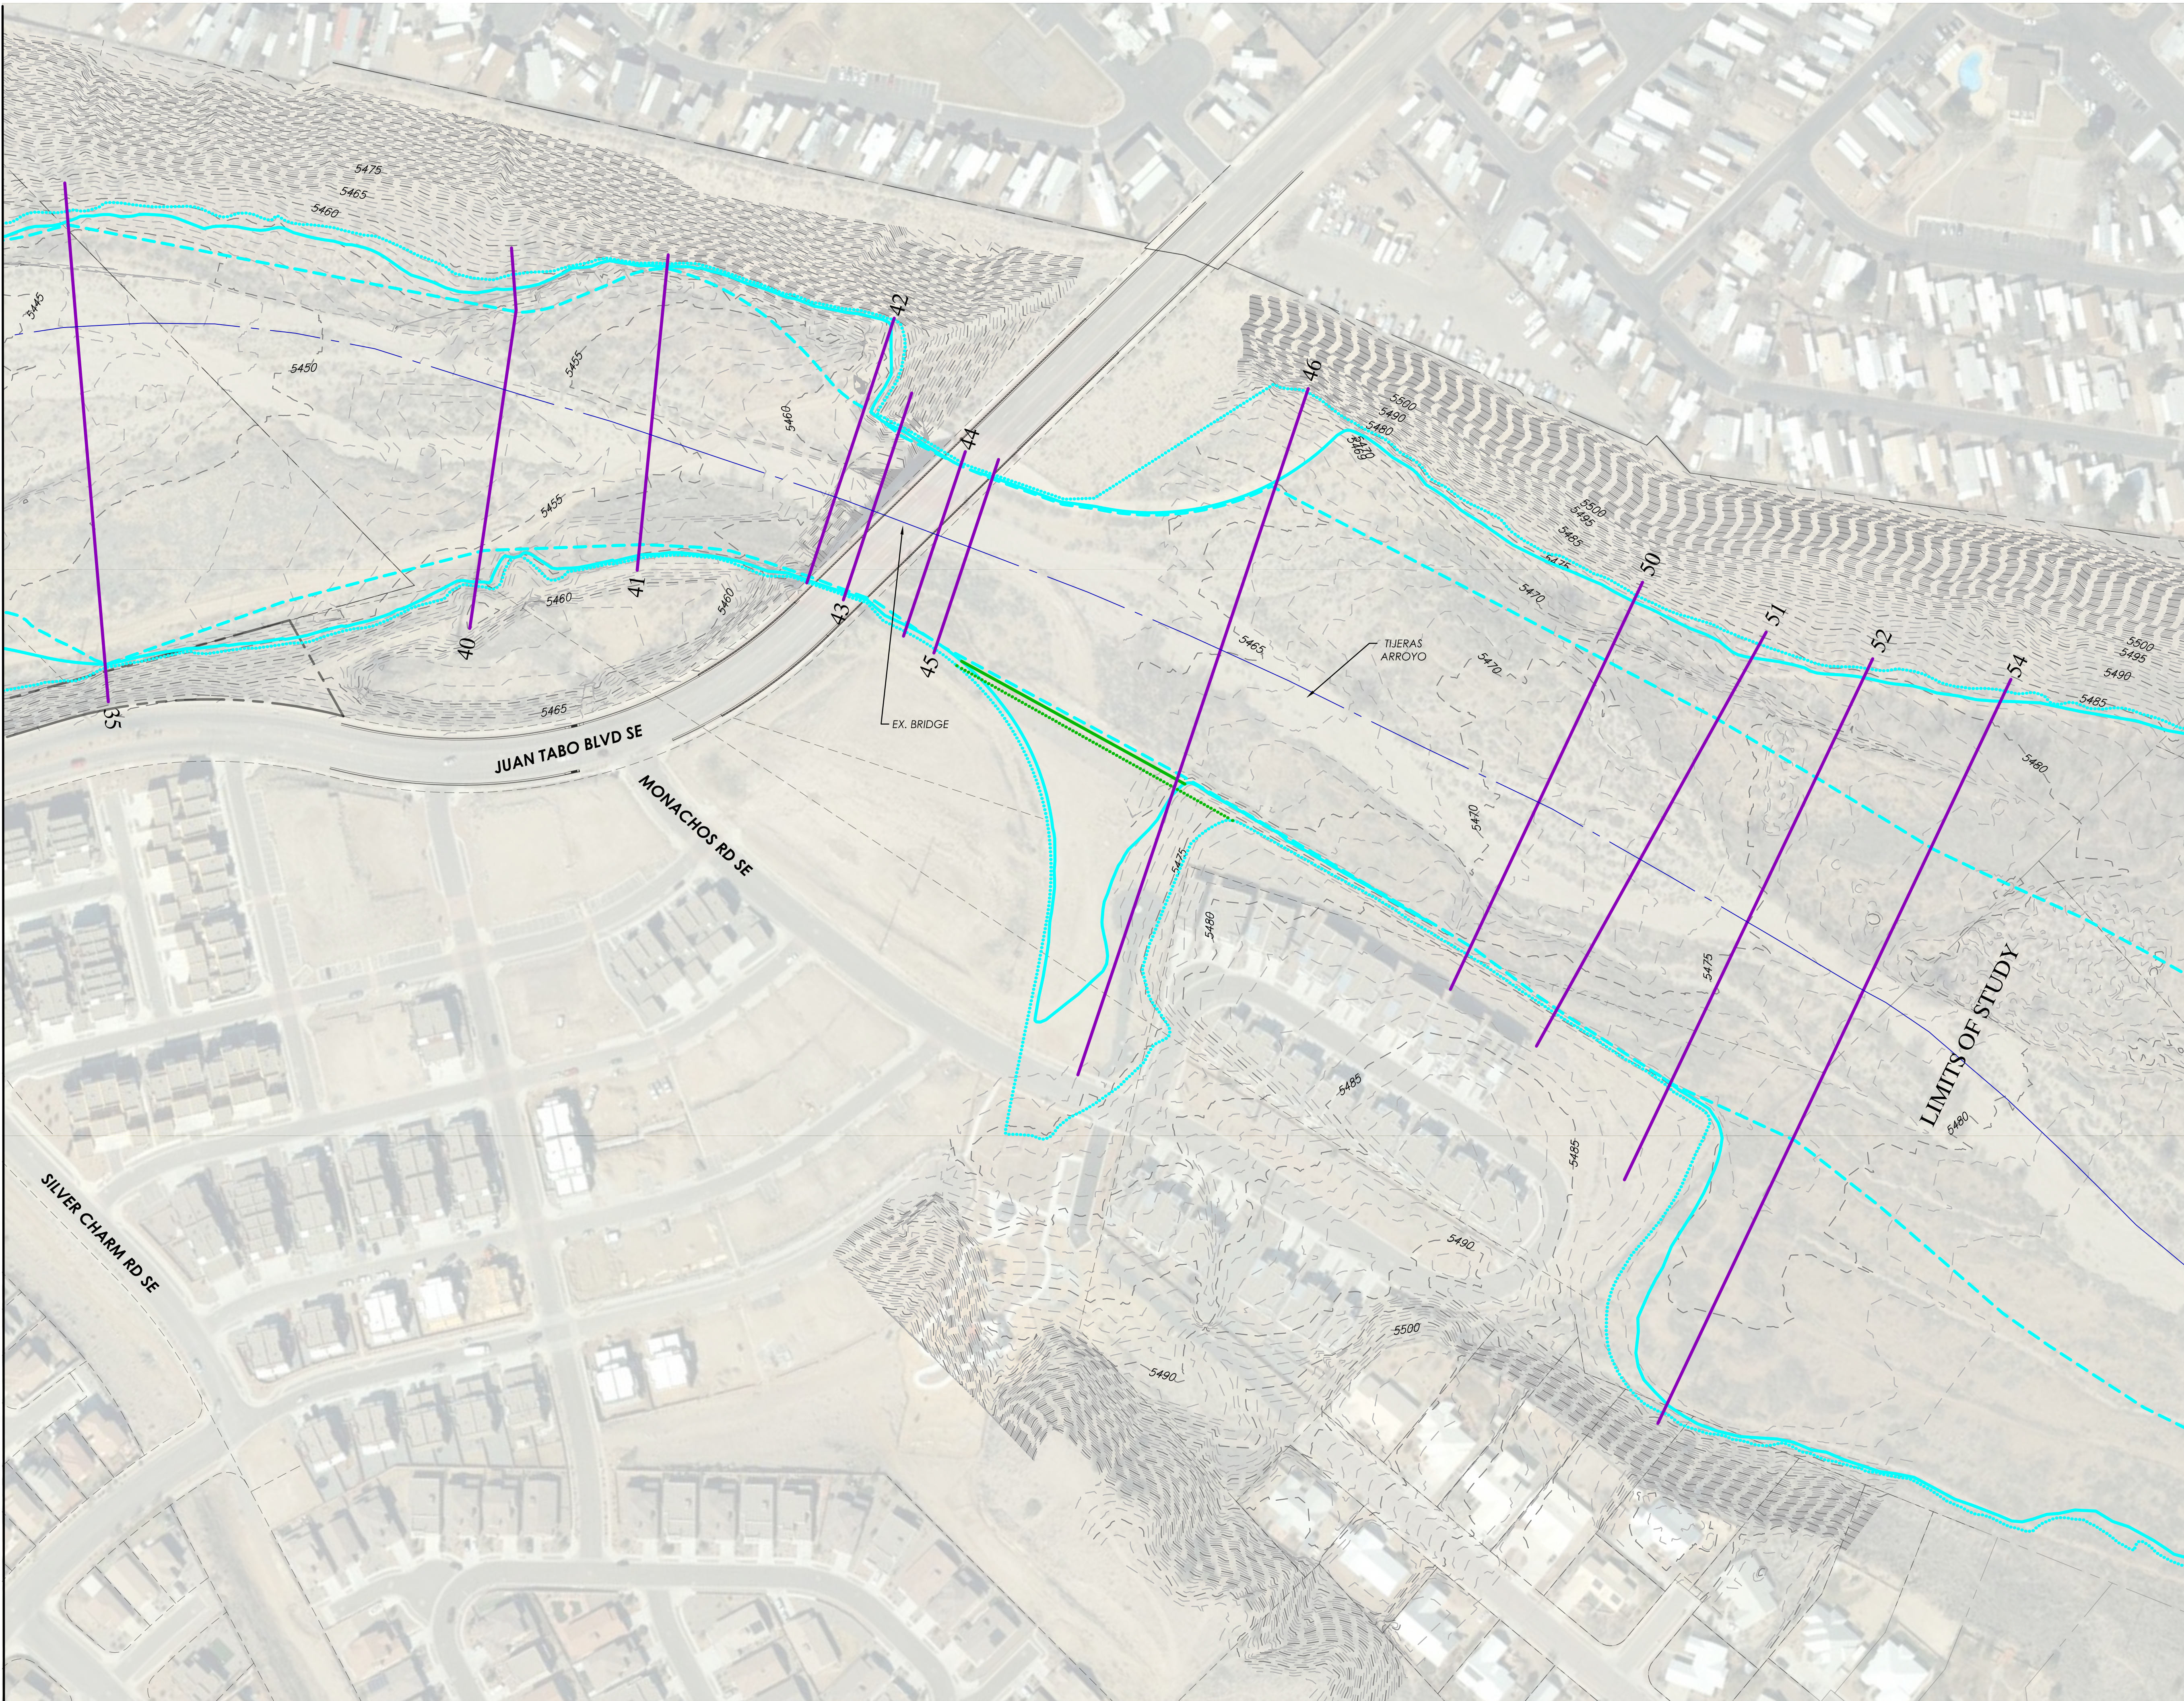

LEGEND	
	STREAM CENTERLINE
	CROSS SECTION
50	CROSS SECTION NUMBER
	EXISTING CONTOUR
	EFFECTIVE 100-YR FLOODPLAIN
	EFFECTIVE 100-YR FLOODWAY
	EFFECTIVE 500-YR FLOODPLAIN
	AS-BUILT 100-YR FLOODPLAIN
	AS-BUILT 500-YR FLOODPLAIN
	AS-BUILT 100-YR FLOODWAY

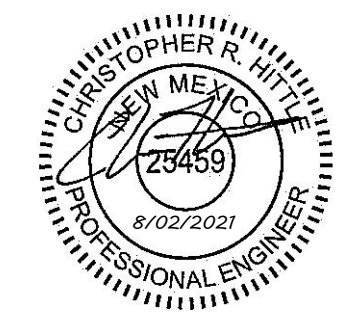

PREPARED BY:
 MARK GOODWIN & ASSOCIATES, P.A.
CONSULTING ENGINEERS
P.O. BOX 30606
ALBUQUERQUE, NEW MEXICO 87199
(505)828-2200, FAX (505)797-9539

**AS-BUILT CONDITIONS
TOPOGRAPHIC WORKMAP
OF
TIJERAS ARROYO
FOR
JUAN TABO HILLS WEST
CITY OF ALBUQUERQUE,
NEW MEXICO**
Date: August 2021