


GENERAL NOTES

- A. COORDINATE WORK WITH SITE PLAN AND LANDSCAPE PLAN.
- B. ALL TRASH, DEBRIS, & SURFACE VEGETATION SHALL BE CLEARED AND LEGALLY DISPOSED OF OFFSITE.
- C. FINAL GRADES SHOWN REPRESENT TOP OF FINISH MATERIAL (I.E. TOP OF CONCRETE, TOP OF PLAYGROUND MATERIAL, TOP OF LANDSCAPING MATERIAL, ETC.). CONTRACTOR SHALL GRADE, COMPACT SUBGRADE AND DETERMINE EARTHWORK ESTIMATES BASED ON ELEVATIONS SHOWN MINUS FINISH MATERIAL THICKNESSES. SEE ARCHITECTURAL FOR ADDITIONAL INFORMATION.
- D. UNIFORMLY GRADE AREAS WITHIN LIMITS OF GRADING AS SHOWN ON PLAN. COMPACT WITH UNIFORM SLOPES BETWEEN POINTS WHERE ELEVATIONS ARE INDICATED.
- E. MAXIMUM SLOPES WITHIN GRAVEL AREAS SHALL BE 6:1.
- F. EXISTING UTILITY LINES ARE SHOWN IN AN APPROXIMATE MANNER ONLY AND MAY BE INCOMPLETE OR OBSOLETE. SUCH LINES MAY OR MAY NOT EXIST WHERE SHOWN OR NOT SHOWN. CONTRACTOR SHALL CONTACT NM-811 FOR UTILITY LINE SPOTS TWO WORKING DAYS PRIOR TO CONDUCTING SITE FIELD WORK. CONTRACTOR SHALL FIELD VERIFY AND LOCATE ALL UTILITIES PRIOR TO COMMENCEMENT OF ANY CONSTRUCTION. CONTRACTOR IS FULLY RESPONSIBLE FOR ANY AND ALL DAMAGE CAUSED BY ITS FAILURE TO LOCATE, IDENTIFY AND PRESERVE ANY AND ALL EXISTING UTILITIES, PIPELINES, AND UNDERGROUND UTILITY LINES.
- G. THE ENVIRONMENTAL PROTECTION AGENCY AND THE CITY OF ALBUQUERQUE REQUIRE A STORM WATER POLLUTION PREVENTION PLAN (SWPPP) FOR PROJECTS WHERE CONSTRUCTION ACTIVITIES (INCLUDING OTHER LAND-DISTURBING ACTIVITIES) DISTURB ONE ACRE OR MORE (BY OTHERS). A SWPPP MUST BE OBTAINED BY THE CONTRACTOR AND INCLUDED WITH THE CONTRACTOR'S SUBMITTAL FOR A ROUGH GRADING, GRADING, PAVING OR BUILDING PERMIT. THE SWPPP MUST BE IN PDF OR MS WORD FORMAT ON A CD.
- H. ADJUST RIMS OF EXISTING UTILITY FEATURES AS NECESSARY TO MATCH NEW GRADES, TYPICAL.
- I. WHERE NEW GRADES ARE SHOWN AS 'MATCH' OR '±', TRANSITIONS SHALL BE SMOOTH AND LEVEL.
- J. ENGINEER RECOMMENDS THAT OWNER MAINTAIN EROSION PROTECTION ELEMENTS. ENGINEER RECOMMENDS THAT OWNER INSPECT SITE YEARLY AND AFTER EACH RAINFALL TO IDENTIFY NEW AREAS OF EROSION AND INSTALL ADDITIONAL EROSION PROTECTION AS NEEDED BASED ON ACTUAL OCCURRENCES.
- K. ALL EROSION PROTECTION SHALL BE FRACTURED-FACE ROCK (F.F. ROCK)=6" AVG. DIA. ANGULAR FACED ROCK (COLOR TO BE SELECTED BY LANDSCAPE ARCHITECT) PLACED OVER GEOTEX 50 NON-WOVEN GEOTEXTILE FABRIC (O.E.)

VICINITY MAP

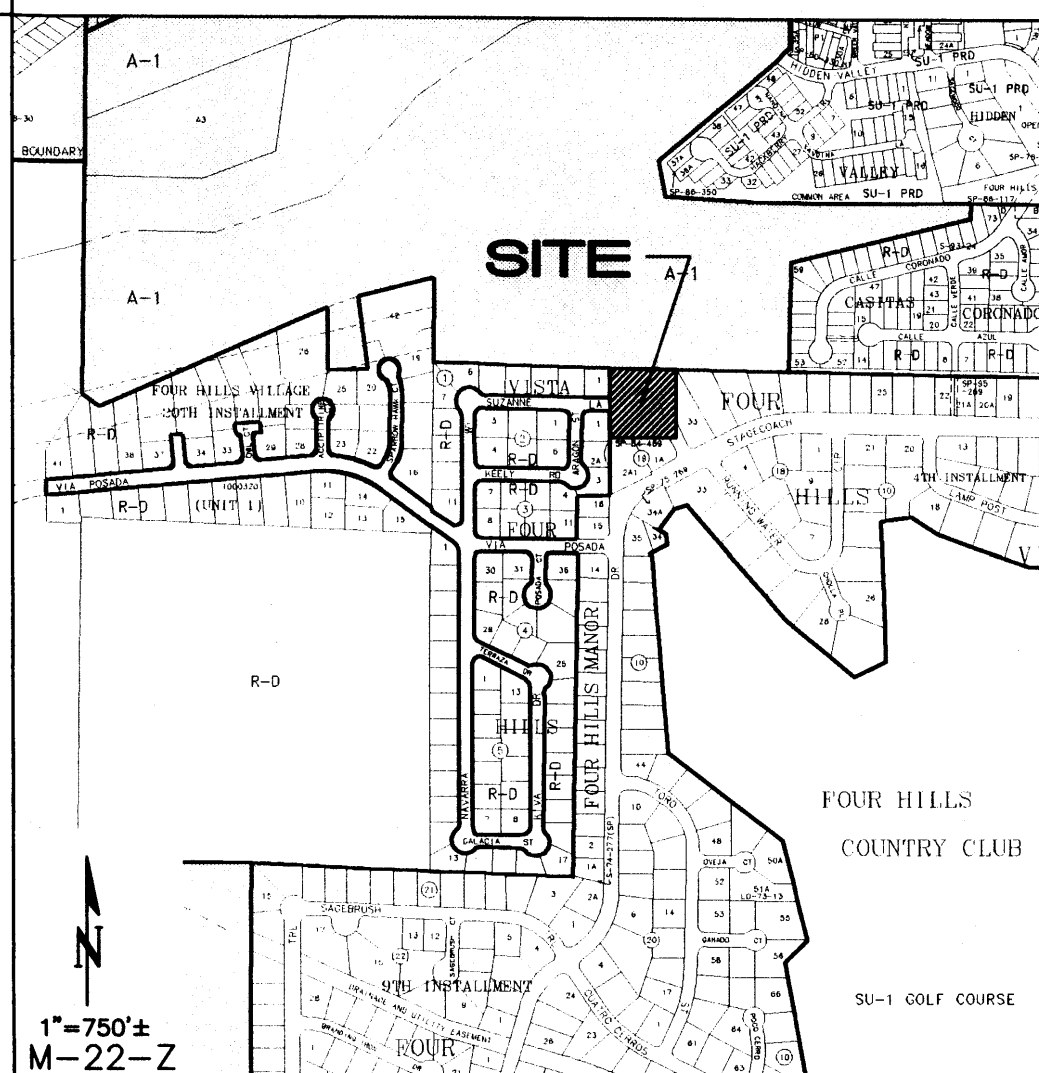

PROJECT DATA

LEGAL DESCRIPTION: FOUR HILLS WELL SITE, BERNALILLO
COUNTY, NEW MEXICO.

SITE AREA: 1.5 ACRES


FLOOD ZONE: PER BERNALILLO, NM COUNTY F.I.R.M. MAP NUMBER 35001C0367H DATED AUGUST 16, 2012, THE SITE IS LOCATED IN FLOOD ZONE 'X' (UNSHADED) DEFINED AS FLOOD INSURANCE RATE ZONES USED FOR AREAS OUTSIDE THE 0.2-PERCENT-ANNUAL-CHANCE FLOODPLAIN.

ENGINEER: ÅSA M. NILSSON-WEBER
ISAACSON & ARFMAN, P.A.
128 MONROE ST NE, ABQ. NM 87108
PHONE: (505) 268-8828


SURVEYOR: ROBERT LOCKMAN
BOHANNAN HUSTON, INC.
7500 JEFFERSON ST NE, ABQ. NM 87109
PHONE: (505.) 823-1000

BENCHMARK: COA STATION 5_M22. SEE PLAN

LEGEND

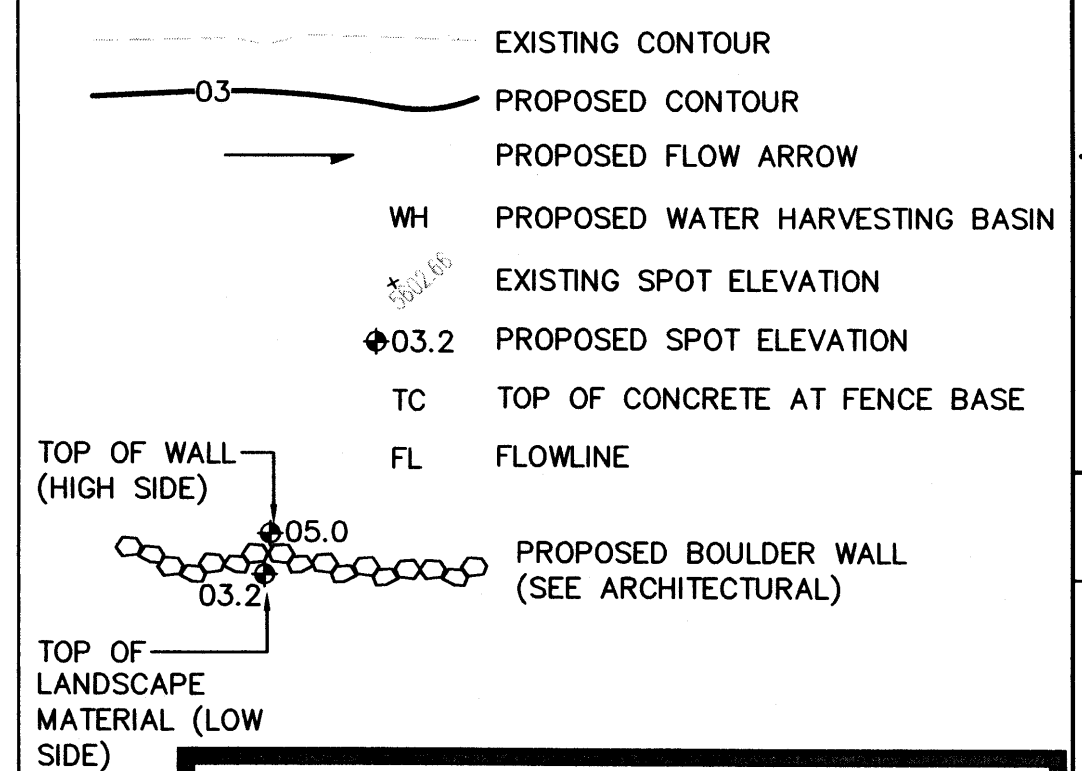

 ISAACSON & ARFMAN, P.A.
Consulting Engineering Associates
128 Monroe Street N.E.
Albuquerque, New Mexico 87108
Ph. 505-268-8828 www.iaacivol.com
1962 CG-101.dwg Aug 13, 2013



**MORROW REARDON
WILKINSON MILLER, LTD.,
LANDSCAPE ARCHITECTS**

210 La Veta NE, Albuquerque, NM 87108
505.268.2266 FAX 505.265.9637
mrw@mrw.com

CITY OF ALBUQUERQUE
STRATEGIC PLANNING AND DESIGN
PARKS AND RECREATION DEPARTMENT


FOUR HILLS VILLAGE PARK GRADING AND DRAINAGE PLAN

Design Review Committee	City Engineer Approval	Last Design Update	Mo./Day/Yr.	Mo./Day/Yr.
City Project No. 503891	Zone Map No. M-22	Sheet 6A	Of 15	

FOUR HILLS VILLAGE PARK

PROJECT# 503891

RECORD DRAWINGS
DATE:

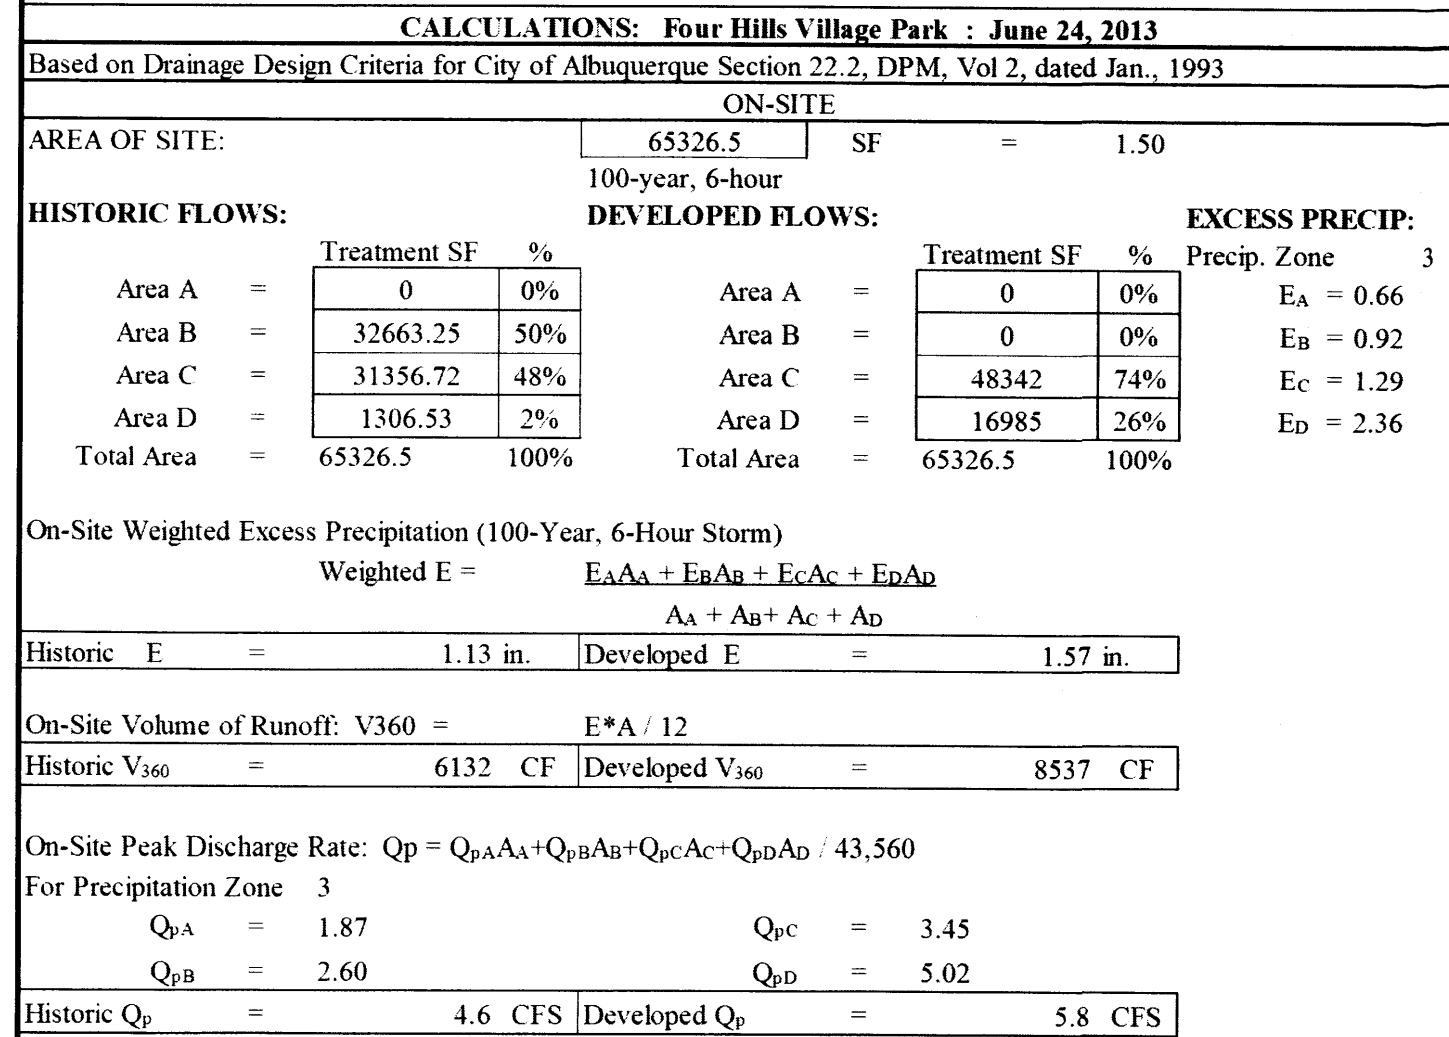

CALCULATIONS

THE PROJECT LIMITS REPRESENT 1.5 ACRES OF PARTIALLY DEVELOPED PROPERTY. THE PROPOSED DEVELOPMENT OF THE PROPERTY INTO A PUBLIC PARK WILL INCREASE THE STORMWATER BY 1.2 CFS (2405 CF VOLUME) DURING THE 100-YEAR, 6-HOUR STORM.

THIS INCREASE WILL BE CAPTURED WITHIN DEPRESSED WATER HARVESTING AREAS INCORPORATED INTO THE LANDSCAPING THROUGHOUT THE PARK. IN ADDITION, THE MAIN PLAY AREAS WILL SELF POND WITHIN THE WOOD MULCH TO PERCOLATE INTO THE GROUND. FLOW IN EXCESS OF THE WATER HARVESTING AND SELF-PONDING AREAS WILL CONTINUE TO PASS TO THE NORTH TO FOLLOW HISTORIC FLOWPATHS.

ON-SITE RETENTION:

THE TWO MAIN PLAY AREAS HATCHED AT LEFT TOTAL 5053 SF. THESE WILL BE GRADED AND FILLED WITH 12" DEEP WOOD FIBER PLAYGROUND MULCH.

USING A 25% VOID FACTOR, THESE TWO DEPRESSED AREAS WILL
STORE APPROX. 1000 CF OF STORMWATER.

THE REMAINDER OF THE WOOD FIBER AREAS (15,000 SF±) WILL BE CONSTRUCTED WITH A 6" DEPTH.

USING A 25% VOID FACTOR, THESE DEPRESSED AREAS CAN STORE UP TO 1,875 CF OF STORMWATER.

IN ADDITION, THERE ARE A NUMBER OF DEPRESSED LANDSCAPED AREAS AROUND THE PERIMETER OF THE PARK. EACH IS APPROXIMATELY 12" DEEP.

TOTAL VOLUME AVAILABLE FOR ON-SITE RETENTION EXCEEDS THE EXPECTED INCREASED VOLUME DUE TO CONSTRUCTION (2,405 CF PER CALCULATIONS).

BASED ON THE BERNALILLO COUNTY SOIL MAPS, THE PROPERTY CONSISTS OF 100% Te (TESAJU-MILLETT STONY SANDY LOAMS), CLASSIFIED AS HYDROLOGIC SOIL GROUP 'B' DEFINED AS HAVING MODERATE INFILTRATION (MODERATELY WELL DRAINED OR WELL DRAINED SOILS) WHEN THOROUGHLY WET. PERMEABILITY OF 6.0 TO 20.0 INCHES PER HOUR.



1. 3000 PSI CONCRETE.
2. EDGES NOT SPECIFICALLY DIMENSIONED SHALL BE EDGED WITH A 3/8" EDGING TOOL.
3. CONSTRUCTION CONTROL JOINTS AT 6' O.C. MAX.
4. 1/2" EXPANSION JOINTS 24' O.C.

SCALE: N.T.S.



1. VARY ANGULAR FACE ROCK SIZE BETWEEN 4" AND 8" DIA. (AVG.=6")
2. PLACE GEOTEX 501 NON-WOVEN GEOTEXTILE (O.E.) BENEATH ALL EROSION PROTECTION

SCALE: N.T.S.



1. EDGES NOT SPECIFICALLY DIMENSIONED SHALL BE SHAPED WITH A 3/8" EDGING TOOL.

SCALE: N.T.S.



FOUR HILLS VILLAGE PARK



**MORROW REARDON
WILKINSON MILLER, LTD.,
LANDSCAPE ARCHITECTS**

210 La Veta NE, Albuquerque, NM 87108
505.268.2288 FAX 505.265.9637
mrmw.com



CITY OF ALBUQUERQUE
STRATEGIC PLANNING AND DESIGN
PARKS AND RECREATION DEPARTMENT

FOUR HILLS VILLAGE PARK GRADING AND DRAINAGE DETAILS

Design Review Committee	City Engineer Approval	Last Design Update	Mo./Day/Yr.	Mo./Day/Yr.
City Project No. 503891		Zone Map No. M-22	Sheet 6B	Of 15

RECORD DRAWINGS
DATE:

BENCHMARK
S.M22
E. 1476295.600
N. 1564235.798
Z. 5596.97



3'X32'X1'DEEP
F.F. ROCK PAD

EIGHT 6" CURB SLOTS @ 4' O.C.
SEE DRAINAGE DETAIL SHEET.
FLOWLINE = 97.0 TYP.

3'X32'X1'DEEP
F.F. ROCK PAD

EIGHT 6" CURB SLOTS @ 4' O.C.
SEE DRAINAGE DETAIL SHEET.
FLOWLINE = 01.5 TYP.

0 10 20 40 60
SCALE 1"=20'

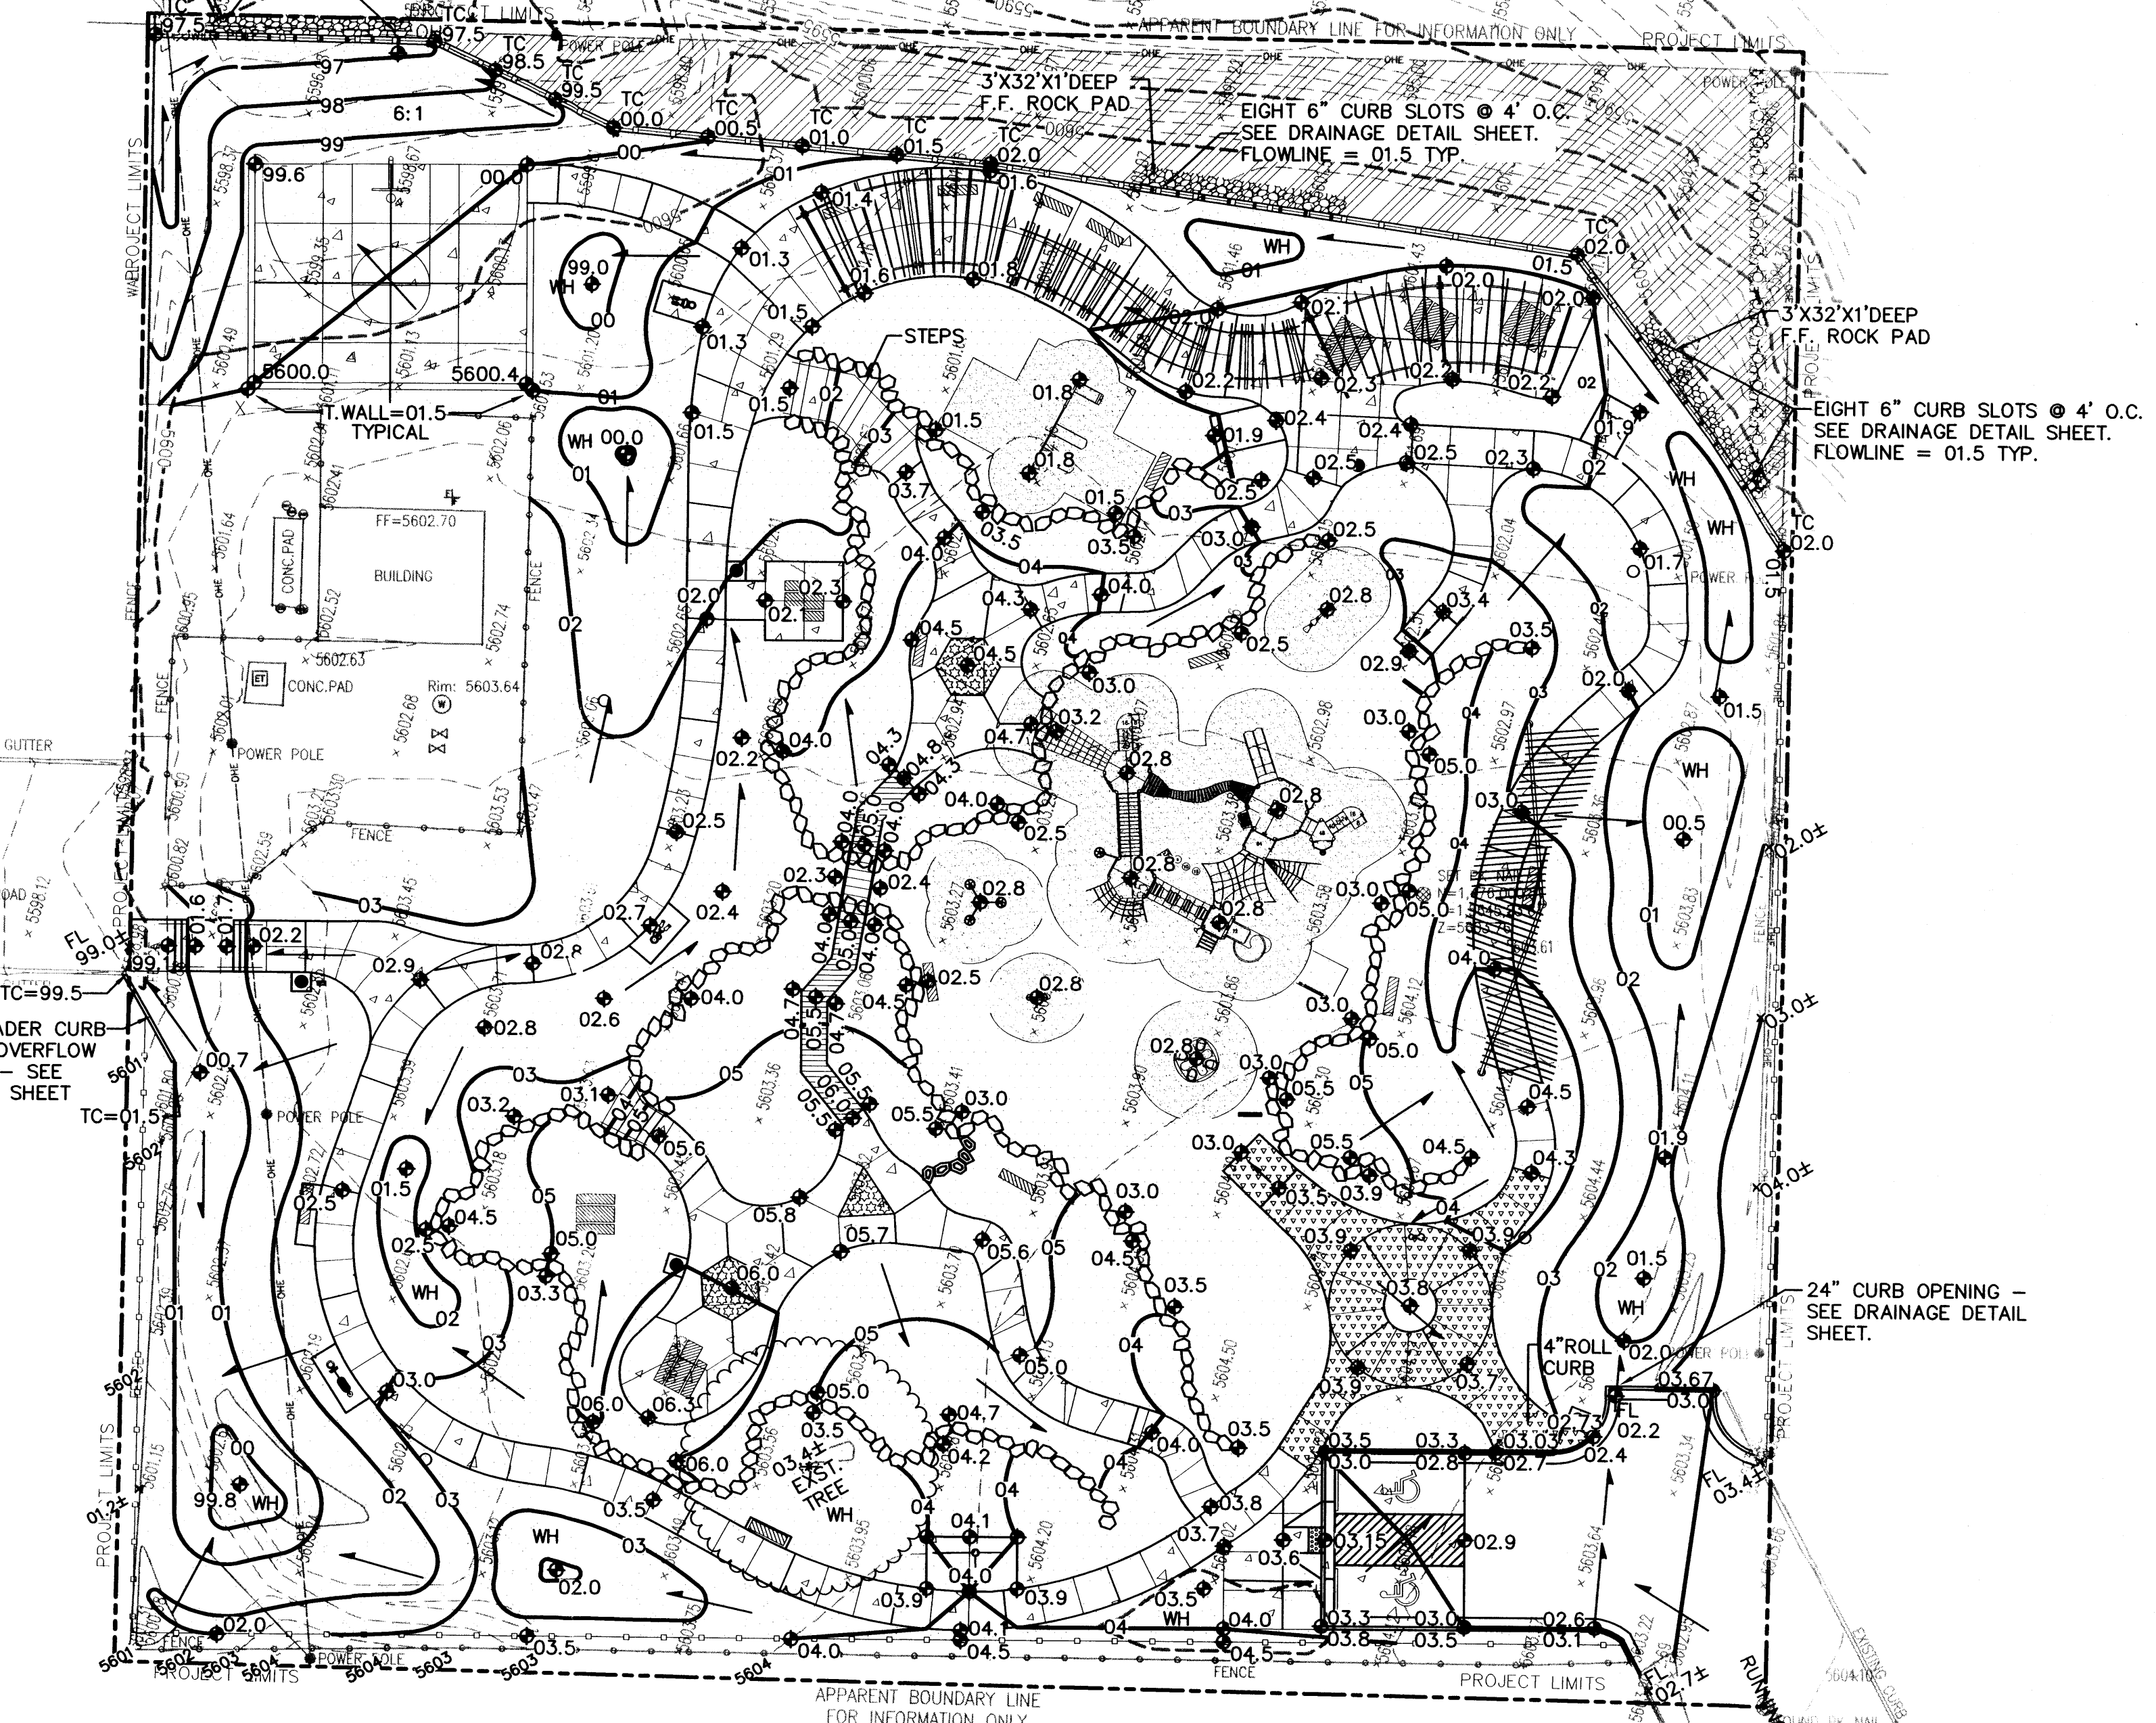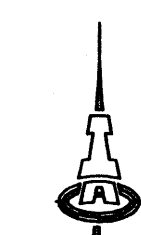


15.5 LF HEADER CURB
TO DIRECT OVERFLOW
TO STREET - SEE
DETAIL THIS SHEET

24" CURB OPENING -
SEE DRAINAGE DETAIL
SHEET.

GENERAL NOTES

- A. COORDINATE WORK WITH SITE PLAN AND LANDSCAPE PLAN.
- B. ALL TRASH, DEBRIS, & SURFACE VEGETATION SHALL BE CLEARED AND LEGALLY DISPOSED OF OFFSITE.
- C. FINAL GRADES SHOWN REPRESENT TOP OF FINISH MATERIAL (I.E. TOP OF CONCRETE, TOP OF PLAYGROUND MATERIAL, TOP OF LANDSCAPING MATERIAL, ETC.). CONTRACTOR SHALL GRADE, COMPACT SUBGRADE AND DETERMINE EARTHWORK ESTIMATES BASED ON ELEVATIONS SHOWN MINUS FINISH MATERIAL THICKNESSES. SEE ARCHITECTURAL FOR ADDITIONAL INFORMATION.
- D. UNIFORMLY GRADE AREAS WITHIN LIMITS OF GRADING AS SHOWN ON PLAN. COMPACT WITH UNIFORM SLOPES BETWEEN POINTS WHERE ELEVATIONS ARE INDICATED.
- E. MAXIMUM SLOPES WITHIN GRAVEL AREAS SHALL BE 6:1.
- F. EXISTING UTILITY LINES ARE SHOWN IN AN APPROXIMATE MANNER ONLY AND MAY BE INCOMPLETE OR OBSOLETE. SUCH LINES MAY OR MAY NOT EXIST WHERE SHOWN OR NOT SHOWN. CONTRACTOR SHALL CONTACT NM-811 FOR UTILITY LINE SPOTS TWO WORKING DAYS PRIOR TO CONDUCTING SITE FIELD WORK. CONTRACTOR SHALL FIELD VERIFY AND LOCATE ALL UTILITIES PRIOR TO COMMENCEMENT OF ANY CONSTRUCTION. CONTRACTOR IS FULLY RESPONSIBLE FOR ANY AND ALL DAMAGE CAUSED BY ITS FAILURE TO LOCATE, IDENTIFY AND PRESERVE ANY AND ALL EXISTING UTILITIES, PIPELINES, AND UNDERGROUND UTILITY LINES.
- G. THE ENVIRONMENTAL PROTECTION AGENCY AND THE CITY OF ALBUQUERQUE REQUIRE A STORM WATER POLLUTION PREVENTION PLAN (SWPPP) FOR PROJECTS WHERE CONSTRUCTION ACTIVITIES (INCLUDING OTHER LAND-DISTURBING ACTIVITIES) DISTURB ONE ACRE OR MORE (BY OTHERS). A SWPPP MUST BE OBTAINED BY THE CONTRACTOR AND INCLUDED WITH THE CONTRACTOR'S SUBMITTAL FOR A ROUGH GRADING, GRADING, PAVING OR BUILDING PERMIT. THE SWPPP MUST BE IN PDF OR MS WORD FORMAT ON A CD.
- H. ADJUST RIMS OF EXISTING UTILITY FEATURES AS NECESSARY TO MATCH NEW GRADES, TYPICAL.
- I. WHERE NEW GRADES ARE SHOWN AS 'MATCH' OR '±', TRANSITIONS SHALL BE SMOOTH AND LEVEL.
- J. ENGINEER RECOMMENDS THAT OWNER MAINTAIN EROSION PROTECTION ELEMENTS. ENGINEER RECOMMENDS THAT OWNER INSPECT SITE YEARLY AND AFTER EACH RAINFALL TO IDENTIFY NEW AREAS OF EROSION AND INSTALL ADDITIONAL EROSION PROTECTION AS NEEDED BASED ON ACTUAL OCCURRENCES.
- K. ALL EROSION PROTECTION SHALL BE FRACTURED-FACE ROCK (F.F. ROCK)=6" AVG. DIA. ANGULAR FACED ROCK (COLOR TO BE SELECTED BY LANDSCAPE ARCHITECT) PLACED OVER GEOTEX 50 NON-WOVEN GEOTEXTILE FABRIC (O.E.)

VICINITY MAP

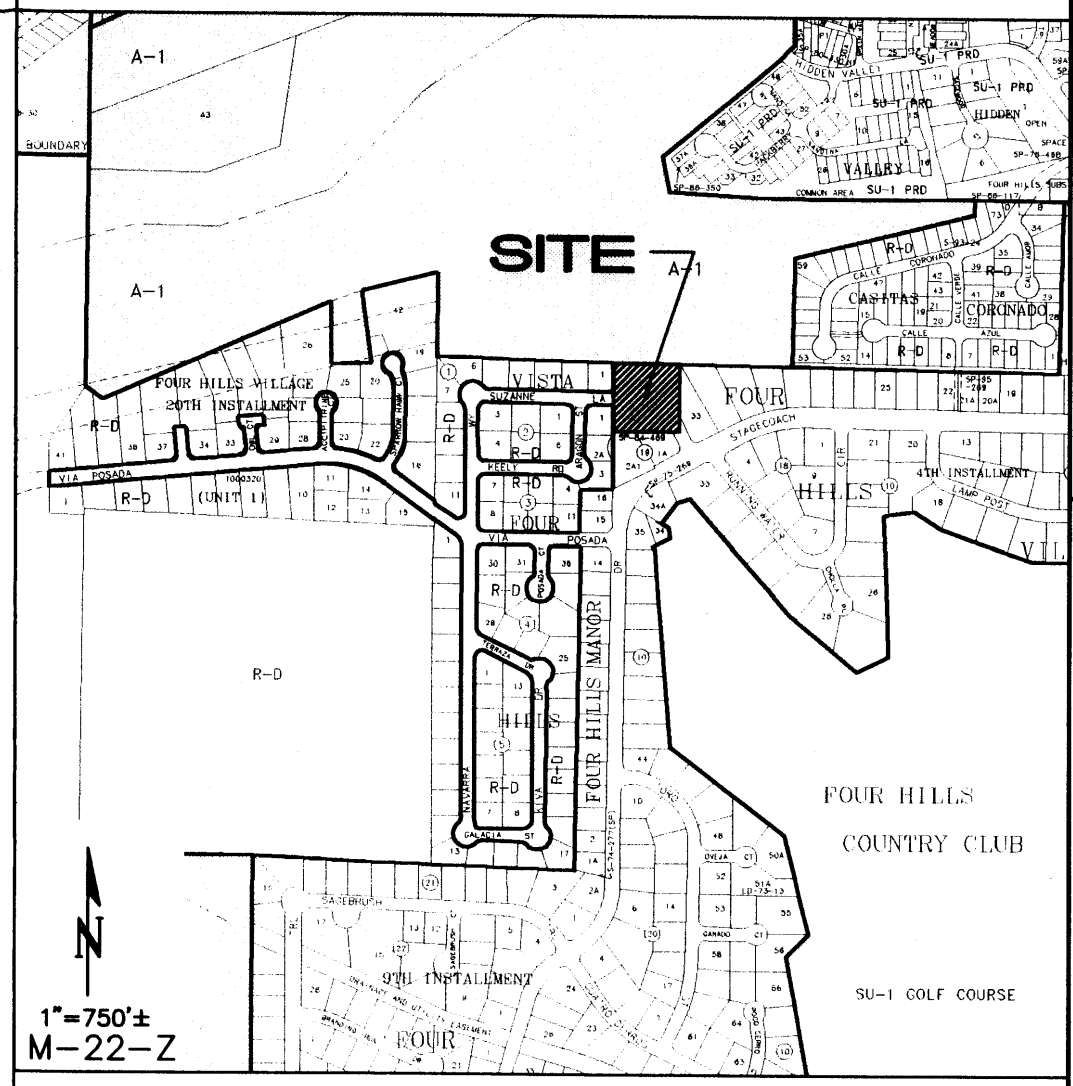

PROJECT DATA

LEGAL DESCRIPTION: FOUR HILLS WELL SITE, BERNALILLO COUNTY, NEW MEXICO.

SITE AREA: 1.5 ACRES

FLOOD ZONE: PER BERNALILLO, NM COUNTY F.I.R.M. MAP NUMBER 35001C0367H DATED AUGUST 16, 2012, THE SITE IS LOCATED IN FLOOD ZONE 'X' (UNSHADED) DEFINED AS FLOOD INSURANCE RATE ZONES USED FOR AREAS OUTSIDE THE 0.2-PERCENT-ANNUAL-CHANCE FLOODPLAIN.

ENGINEER: ASA M. NILSSON-WEBER
ISAACSON & ARFMAN, P.A.
128 MONROE ST NE, ABO. NM 87108
PHONE: (505) 268-8828

SURVEYOR: ROBERT LOCKMAN
BOHANNAN HUSTON, INC.
7500 JEFFERSON ST NE, ABO. NM 87109
PHONE: (505.) 823-1000

BENCHMARK: COA STATION 5_M22. SEE PLAN

LEGEND

- EXISTING CONTOUR
- PROPOSED CONTOUR
- PROPOSED FLOW ARROW
- WH PROPOSED WATER HARVESTING BASIN
- EXISTING SPOT ELEVATION
- PROPOSED SPOT ELEVATION
- TC TOP OF CONCRETE AT FENCE BASE
- FL FLOWLINE
- TOP OF WALL (HIGH SIDE)
- TOP OF LANDSCAPE MATERIAL (LOW SIDE)
- PROPOSED BOULDER WALL (SEE ARCHITECTURAL)

ISAACSON & ARFMAN, P.A.
Consulting Engineering Associates
128 Monroe Street N.E.
Albuquerque, New Mexico 87108
Ph. 505-268-8828 www.iacivil.com
1962 CG-101.dwg Aug 13, 2013

**MORROW REARDON
WILKINSON MILLER, LTD.,
LANDSCAPE ARCHITECTS**
210 La Veta NE, Albuquerque, NM 87108
505.348.2200 FAX 505.265.9637
mrw@mrwm.com


CITY OF ALBUQUERQUE
STRATEGIC PLANNING AND DESIGN
PARKS AND RECREATION DEPARTMENT

FOUR HILLS VILLAGE PARK GRADING AND DRAINAGE PLAN

Design Review Committee	City Engineer Approval	Mo./Day/Yr.	Mo./Day/Yr.
City Project No.	Zone Map No.	Sheet	Of
503891	M-22	6A	15


AS-BUILT INFORMATION			
CONTRACTOR	DATE	INSPECTOR'S	DATE
STAMPED BY	DATE	FIELD	DATE
VERIFICATION BY	DATE	CORRECTED BY	DATE
MICRO-FILM INFORMATION			
NO.	DATE	NO.	DATE

SURVEY INFORMATION		FIELD NOTES	
NO.	DATE	BY	DATE

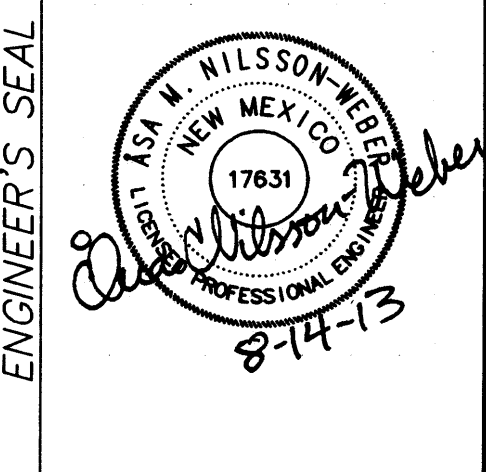

REVISIONS		REMARKS	
NO.	DATE	BY	DATE

FOUR HILLS VILLAGE PARK
PROJECT# 503891
RECORD DRAWINGS
DATE:

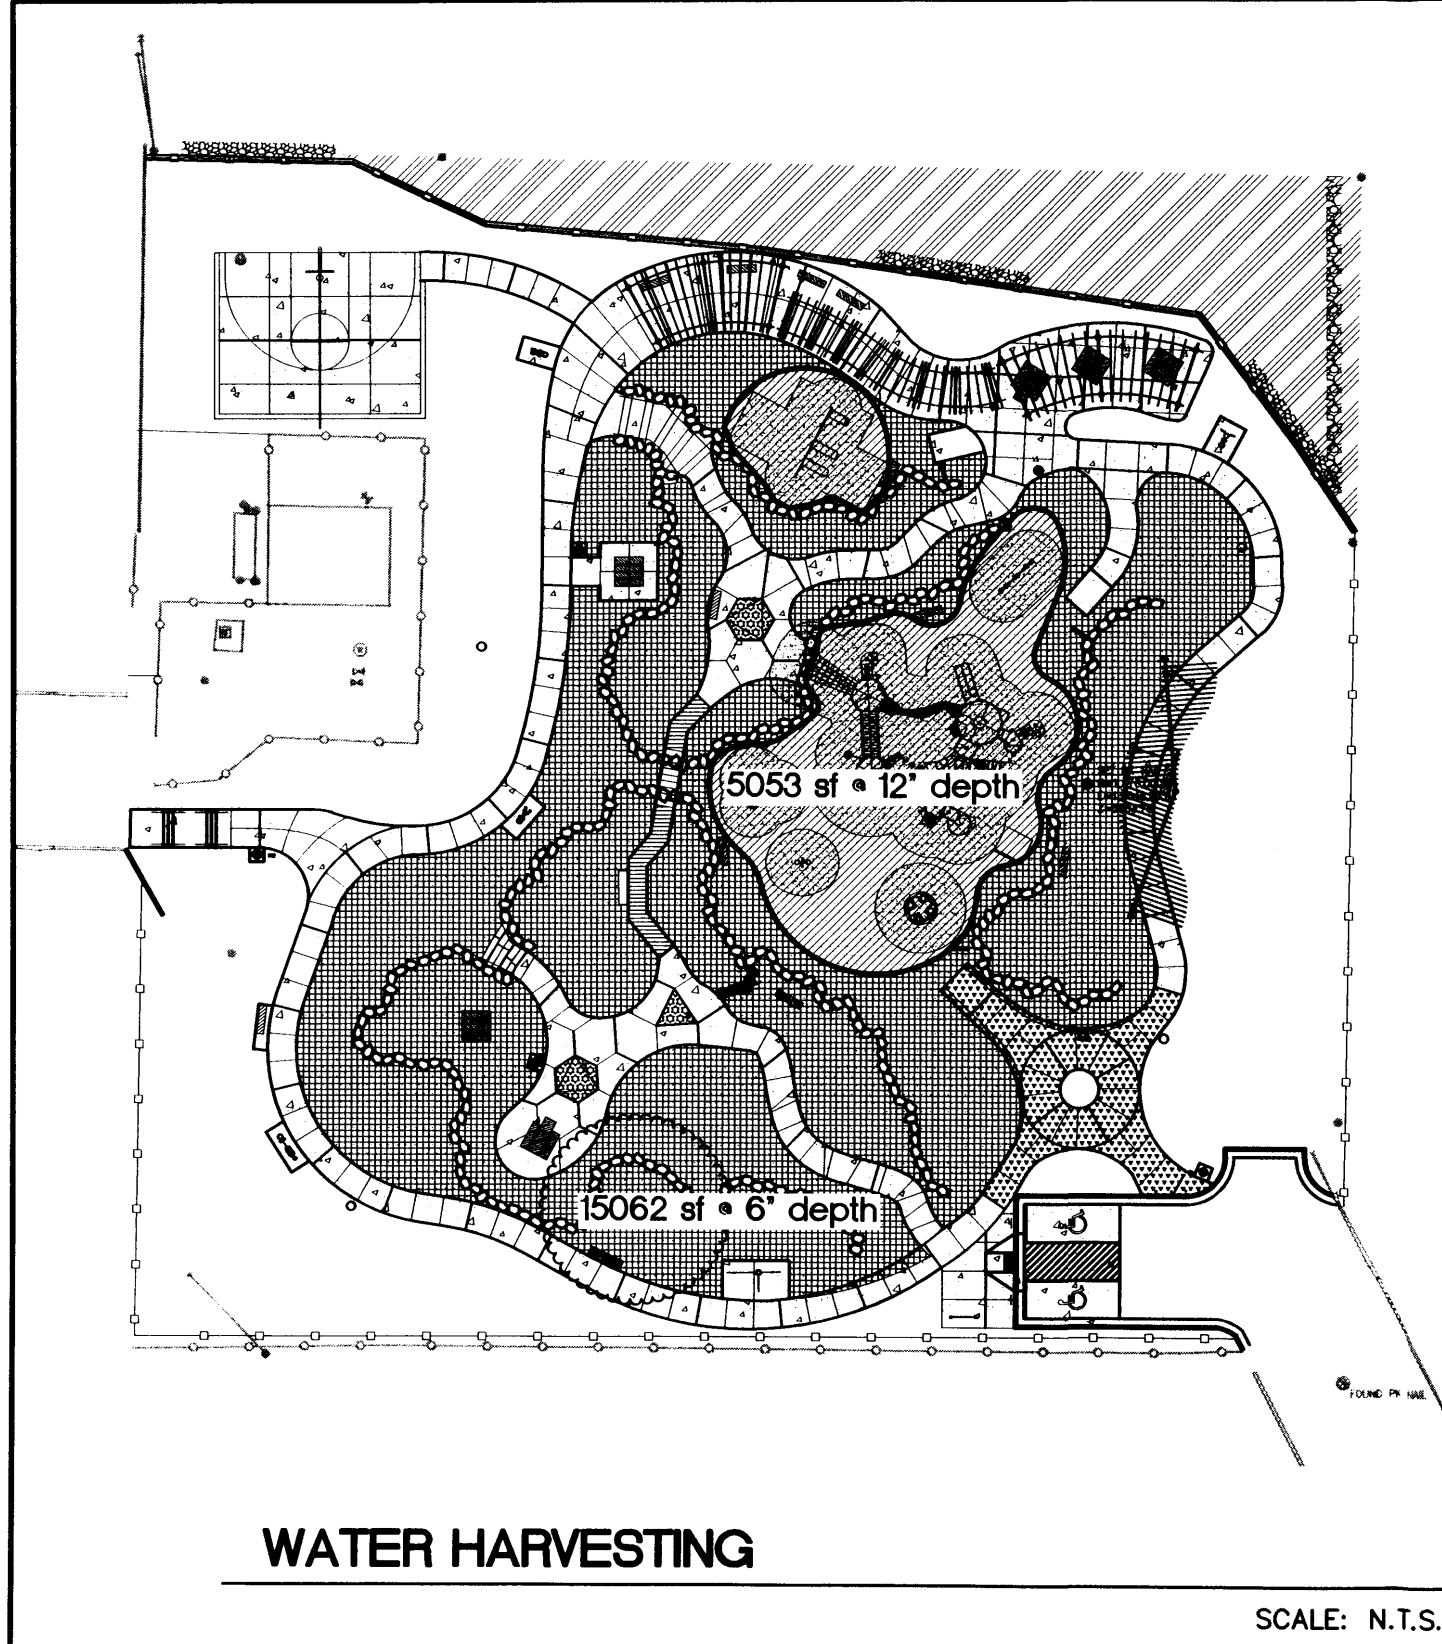

WATER HARVESTING

SCALE: N.T.S.

CALCULATIONS: Four Hills Village Park : June 24, 2013									
Based on Drainage Design Criteria for City of Albuquerque Section 22.2, DPM, Vol 2, dated Jan., 1993									
ON-SITE									
AREA OF SITE:		65326.5		SF		=		1.50	
100-year, 6-hour									
HISTORIC FLOWS:				DEVELOPED FLOWS:				EXCESS PRECIP:	
Treatment SF		%		Treatment SF		%		Precip. Zone	
Area A	=	0	0%	Area A	=	0	0%	E _A	= 0.66
Area B	=	32663.25	50%	Area B	=	0	0%	E _B	= 0.92
Area C	=	31356.72	48%	Area C	=	48342	74%	E _C	= 1.29
Area D	=	1306.53	2%	Area D	=	16985	26%	E _D	= 2.36
Total Area	=	65326.5	100%	Total Area	=	65326.5	100%		
On-Site Weighted Excess Precipitation (100-Year, 6-Hour Storm)									
Weighted E =		$E_A A_A + E_B A_B + E_C A_C + E_D A_D$							
		$A_A + A_B + A_C + A_D$							
Historic E	=	1.13 in.		Developed E		=		1.57 in.	
On-Site Volume of Runoff: V ₃₆₀ = E * A * 12									
Historic V ₃₆₀	=	6132 CF		Developed V ₃₆₀		=		8537 CF	
On-Site Peak Discharge Rate: Q _p = Q _{pA} A _A + Q _{pB} A _B + Q _{pC} A _C + Q _{pD} A _D / 43,560									
For Precipitation Zone 3									
Q _{pA}	=	1.87		Q _{pC}	=	3.45			
Q _{pB}	=	2.60		Q _{pD}	=	5.02			
Historic Q _p	=	4.6 CFS		Developed Q _p	=	5.8 CFS			

CALCULATIONS

DRAINAGE CONCEPT

THE PROJECT LIMITS REPRESENT 1.5 ACRES OF PARTIALLY DEVELOPED PROPERTY. THE PROPOSED DEVELOPMENT OF THE PROPERTY INTO A PUBLIC PARK WILL INCREASE THE STORMWATER BY 1.2 CFS (2405 CF VOLUME) DURING THE 100-YEAR, 6-HOUR STORM.

THIS INCREASE WILL BE CAPTURED WITHIN DEPRESSED WATER HARVESTING AREAS INCORPORATED INTO THE LANDSCAPING THROUGHOUT THE PARK. IN ADDITION, THE MAIN PLAY AREAS WILL SELF POND WITHIN THE WOOD MULCH TO PERCOLATE INTO THE GROUND. FLOW IN EXCESS OF THE WATER HARVESTING AND SELF-PONDING AREAS WILL CONTINUE TO PASS TO THE NORTH TO FOLLOW HISTORIC FLOWPATHS.

ON-SITE RETENTION:

THE TWO MAIN PLAY AREAS HATCHED AT LEFT TOTAL 5053 SF. THESE WILL BE GRADED AND FILLED WITH 12" DEEP WOOD FIBER PLAYGROUND MULCH.

USING A 25% VOID FACTOR, THESE TWO DEPRESSED AREAS WILL STORE APPROX. 1000 CF OF STORMWATER.


THE REMAINDER OF THE WOOD FIBER AREAS (15,000 SF±) WILL BE CONSTRUCTED WITH A 6" DEPTH.

USING A 25% VOID FACTOR, THESE DEPRESSED AREAS CAN STORE UP TO 1,875 CF OF STORMWATER.

IN ADDITION, THERE ARE A NUMBER OF DEPRESSED LANDSCAPED AREAS AROUND THE PERIMETER OF THE PARK. EACH IS APPROXIMATELY 12" DEEP.

TOTAL VOLUME AVAILABLE FOR ON-SITE RETENTION EXCEEDS THE EXPECTED INCREASED VOLUME DUE TO CONSTRUCTION (2,405 CF PER CALCULATIONS).

BASED ON THE BERNALILLO COUNTY SOIL MAPS, THE PROPERTY CONSISTS OF 100% Te (TESAJU-MILLET STONY SANDY LOAMS), CLASSIFIED AS HYDROLOGIC SOIL GROUP 'B' DEFINED AS HAVING MODERATE INFILTRATION (MODERATELY WELL DRAINED OR WELL DRAINED SOILS) WHEN THOROUGHLY WET. PERMEABILITY OF 6.0 TO 20.0 INCHES PER HOUR.

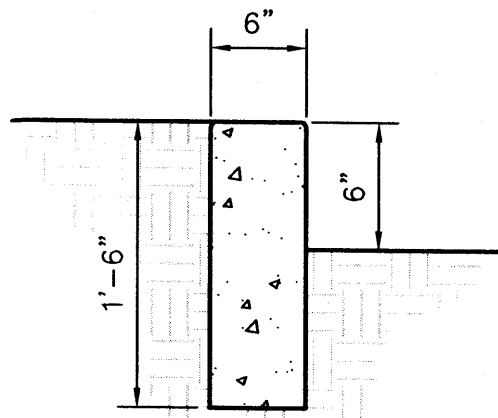


GENERAL NOTES

- 3000 PSI CONCRETE.
- EDGES NOT SPECIFICALLY DIMENSIONED SHALL BE EDGED WITH A 3/8" EDGING TOOL.
- CONSTRUCTION CONTROL JOINTS AT 6' O.C. MAX.
- 1/2" EXPANSION JOINTS 24' O.C.

HEADER CURB

SCALE: N.T.S.

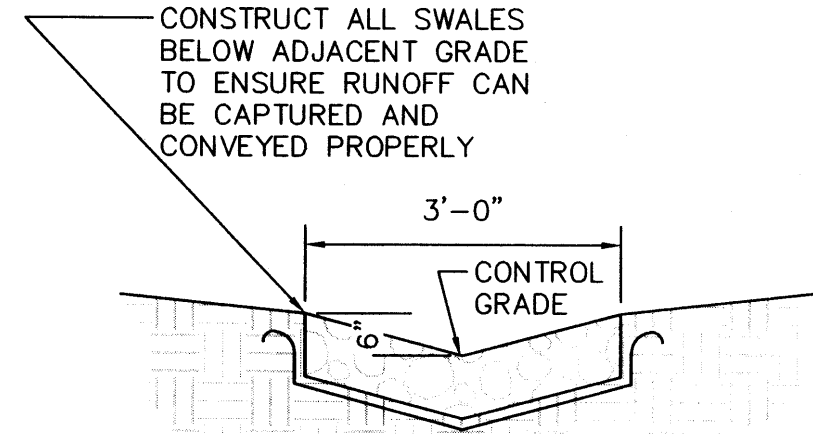


GENERAL NOTES

- VARY ANGULAR FACE ROCK SIZE BETWEEN 4" AND 8" DIA. (AVG.=6")
- PLACE GEOTEX 501 NON-WOVEN GEOTEXTILE (O.E.) BENEATH ALL EROSION PROTECTION

ROCK SWALE

SCALE: N.T.S.

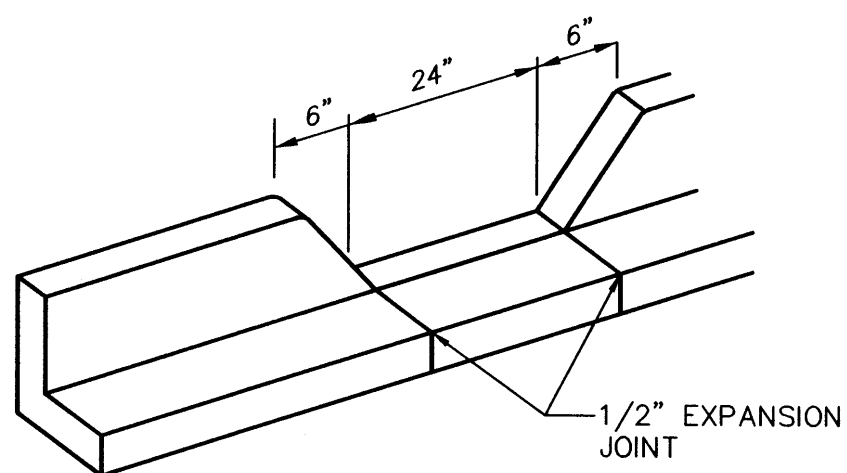


GENERAL NOTES

- EDGES NOT SPECIFICALLY DIMENSIONED SHALL BE SHAPED WITH A 3/8" EDGING TOOL.

CURB OPENING

SCALE: N.T.S.

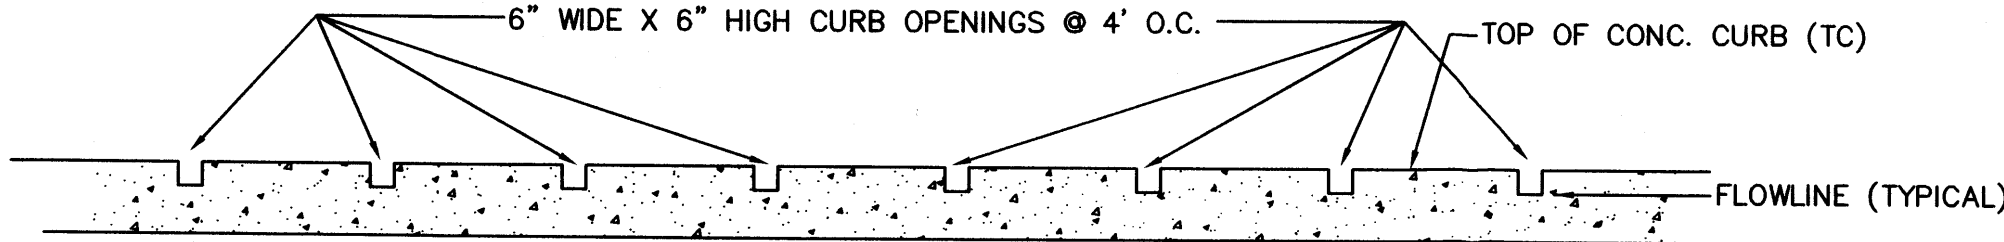

CURB SLOTS

SCALE: N.T.S.

ISAACSON & ARFMAN, P.A.
Consulting Engineering Associates
128 Monroe Street N.E.
Albuquerque, New Mexico 87108
Ph. 505-268-8828 www.iacivil.com
1962 CG-101.dwg Aug 13, 2013

**MORROW REARDON
WILKINSON MILLER, LTD.,
LANDSCAPE ARCHITECTS**
210 La Veta NE, Albuquerque, NM 87108
505.268.2266 FAX 505.265.9637
mrw@mrwm.com




CITY OF ALBUQUERQUE
STRATEGIC PLANNING AND DESIGN
PARKS AND RECREATION DEPARTMENT

FOUR HILLS VILLAGE PARK
GRADING AND DRAINAGE DETAILS

Design Review Committee	City Engineer Approval	Last Design Update	Mo./Day/Yr.	Mo./Day/Yr.
City Project No.	Zone Map No.	Sheet	Of	
503891	M-22	6B	15	

AS-BUILT INFORMATION			
CONTRACTOR		WORK STATED BY	DATE
INSPECTOR'S ACCEPTANCE BY		DATE	
FIELD VERIFICATION BY		DATE	
DRAWINGS CORRECTED BY		DATE	
MICRO-FILM INFORMATION			
RECORDED BY		DATE	
NO.			

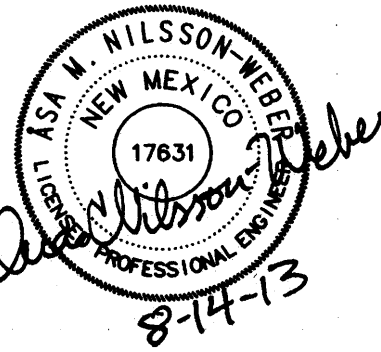


FOUR HILLS VILLAGE PARK

PROJECT# 503891

RECORD DRAWINGS
DATE:

BENCHMARK

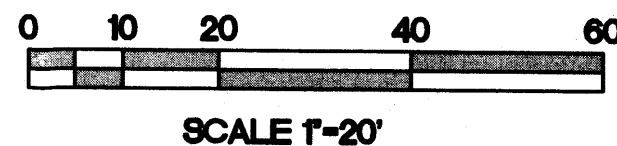

VICINITY MAP

-

PROJECT DATA

LEGAL DESCRIPTION: FOUR HILLS WELL SITE, BERNALILLO
COUNTY, NEW MEXICO.

SITE AREA: 1.5 ACRES

FLOOD ZONE: PER BERNALILLO, NM COUNTY F.I.R.M. MAP NUMBER 35001C0367H DATED AUGUST 16, 2012, THE SITE IS LOCATED IN FLOOD ZONE 'X' (UNSHADED) DEFINED AS FLOOD INSURANCE RATE ZONES USED FOR AREAS OUTSIDE THE 0.2-PERCENT-ANNUAL-CHANCE FLOODPLAIN.


ENGINEER: ÅSA M. NILSSON-WEBER
ISAACSON & ARFMAN, P.A.
128 MONROE ST NE, ABQ. NM 87108
PHONE: (505) 268-8828

SURVEYOR: ROBERT LOCKMAN
BOHANNAN HUSTON, INC.
7500 JEFFERSON ST NE, ABQ. NM 87109
PHONE: (505.) 823-1000

BENCHMARK: COA STATION 5_M22. SEE PLAN

LEGEND

-
- EXISTING CONTOUR
- PROPOSED CONTOUR
- PROPOSED FLOW ARROW
- WH PROPOSED WATER HARVESTING BASIN
- EXISTING SPOT ELEVATION
- 03.2 PROPOSED SPOT ELEVATION
- TC TOP OF CONCRETE AT FENCE BASE
- TOP OF WALL (HIGH SIDE)
- 05.0
- 03.2
- PROPOSED BOULDER WALL (SEE ARCHITECTURAL)
- TOP OF LANDSCAPE MATERIAL (LOW SIDE)
- RECEIVED JUN 28 2013

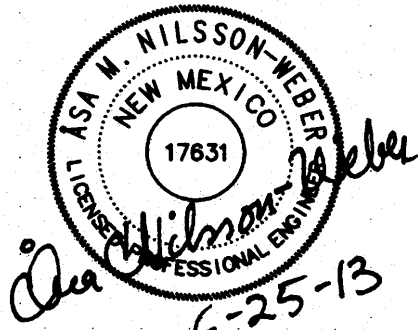

CALCULATIONS

CALCULATIONS: Four Hills Village Park : June 24, 2013

Based on Drainage Design Criteria for City of Albuquerque Section 22.2, DPM, Vol 2, dated Jan., 1993

ON-SITE

AREA OF SITE:

65326.5

SF

=

1.50

Ac.

100-year, 6-hour

DEVELOPED FLOWS:

EXCESS PRECIP:

	Treatment SF	%		Treatment SF	%	Precip. Zone	
Area A	=	0	0%	Area A	=	0	EA = 0.66
Area B	=	32663.25	50%	Area B	=	0	EB = 0.92
Area C	=	31356.72	48%	Area C	=	48342	EC = 1.29
Area D	=	1306.53	2%	Area D	=	16985	ED = 2.36
Total Area	=	65326.5	100%	Total Area	=	65326.5	100%

On-Site Weighted Excess Precipitation (100-Year, 6-Hour Storm)

$$\text{Weighted E} = \frac{E_A A_A + E_B A_B + E_C A_C + E_D A_D}{A_A + A_B + A_C + A_D}$$

Historic E	=	1.13 in.	Developed E	=	1.57 in.
------------	---	----------	-------------	---	----------

On-Site Volume of Runoff: $V_{360} = E \cdot A / 12$

Historic V_{360}	=	6132 CF	Developed V_{360}	=	8537 CF
--------------------	---	---------	---------------------	---	---------

On-Site Peak Discharge Rate: $Q_p = Q_{pA}A_A + Q_{pB}A_B + Q_{pC}A_C + Q_{pD}A_D / 43,560$

$Q_{pA} = 1.87$ $Q_{pB} = 2.60$	$Q_{pC} = 3.45$ $Q_{pD} = 5.02$
Historic $Q_p = 4.6$ CFS	Developed $Q_p = 5.8$ CFS

GENERAL NOTES

1. 3000 PSI CONCRETE.
2. EDGES NOT SPECIFICALLY DIMENSIONED SHALL BE EDGED WITH A 3/8" EDGING TOOL.
3. CONSTRUCTION CONTROL JOINTS AT 6' O.C. MAX.
4. 1/2" EXPANSION JOINTS 24' O.C.

HEADER CURB

SCALE: N.T.S.

GENERAL NOTES

1. VARY ANGULAR FACE ROCK SIZE BETWEEN 4" AND 8" DIA. (AVG.=6")
2. PLACE GEOTEX 501 NON-WOVEN GEOTEXTILE (O.E.) BENEATH ALL EROSION PROTECTION

ROCK SWALE

SCALE: N.T.S.

GENERAL NOTES

1. EDGES NOT SPECIFICALLY DIMENSIONED SHALL BE SHAPED WITH A 3/8" EDGING TOOL.

CURB OPENING

SCALE: N.T.S.

FOUR HILLS VILLAGE PARK

PROJECT# 503891

RECORD DRAWINGS
DATE: