


## STATEMENT OF PROBLEM

The existing cattle guard inlet designed to protect Juan Tabo Hills Unit 1 and Unit 2 from offsite flows from Four Hills is failing. The stormwater is overflowing the inlet and eroding the downstream conditions. In the current condition, the inlet is "on grade." After applying the grate inlet interception efficiency and 15% clogging factor, the inlet is only able to capture 110.5 cfs. Analysis of the offsite flows into this grate was calculated using AHYMO. The resulting flows for the 100 year storm was determined to be 140cfs (see Basin Hydrology). Therefore, 29.5 cfs is overflowing the inlet and eroding the emergency access road and the HOA open space area.

## BASIN BOUNDARIES

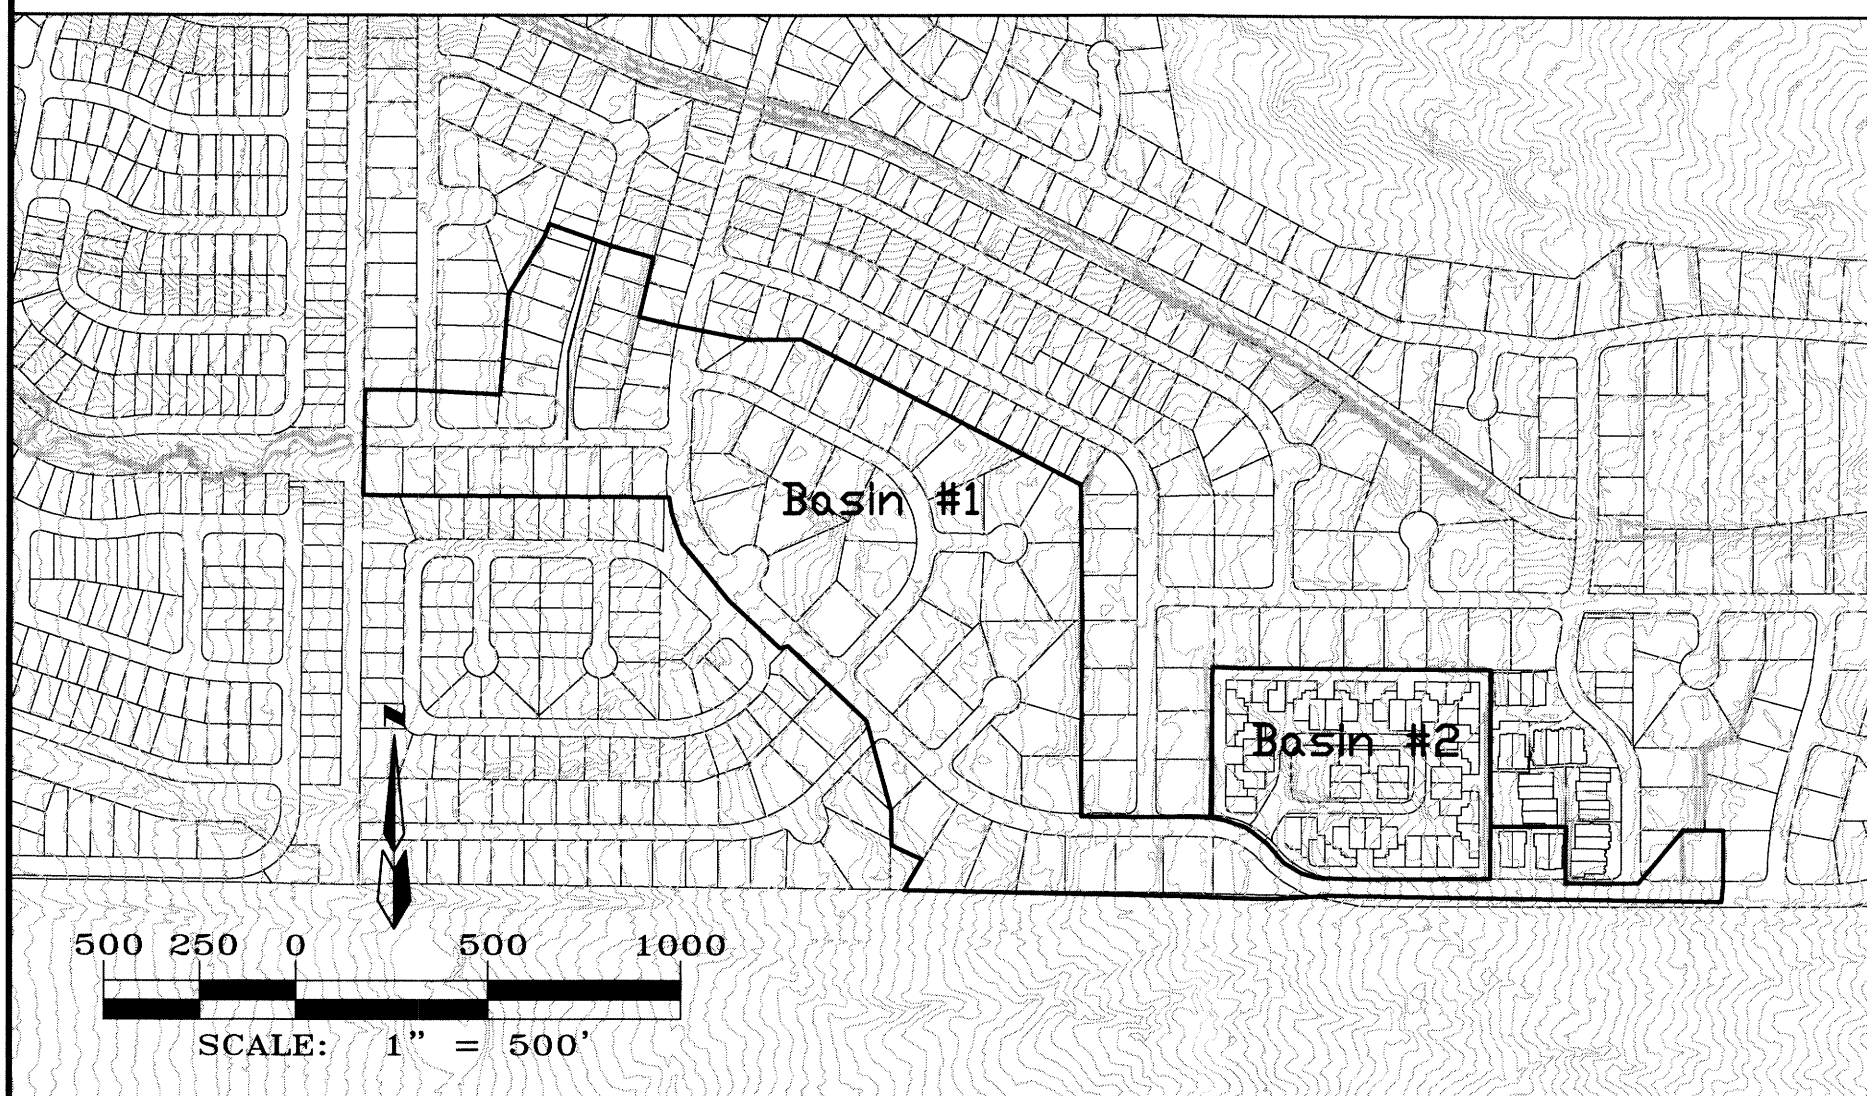

\*\* CONTOURS IN BASIN BOUNDARY MAP 2' INTERVALS

## BASIN HYDROLOGY

RATON AVE. RUNOFF  
100 YEAR 6 HOUR STORM EVENT  
FILE: RATON AVE.DAT  
LAST REVISED: 3-12-14  
NMAA ATLAS 2, VOL IV ZONE-V 11  
TIME=0.0 HR PUNCH CODE=0 PRINT LINES=6  
NEW MEXICO  
TYPE=1 RAIN QUARTER=0.0  
RAIN ONE-100 IN RAIN 320=0.47 IN  
RAIN DAY=1.06 IN DT=0.01 HRS

RATON AVE. DRAINAGE BASIN  
BASIN 1  
AREA 36.6 ACRES  
COMPUTE LT TP

COMPUTE NM HYD  
PRINT HYD  
BASIN 2 (VILLA SERANA CONDOMINIUMS)  
AREA 8.5 ACRES  
COMPUTE LT TP

COMPUTE NM HYD  
PRINT HYD  
ADD HYD  
PRINT HYD  
FINISH

COMPUTE NM HYD  
PRINT HYD  
ADD HYD  
PRINT HYD  
FINISH

## HYDRAULICS

The solution is to create a "sump" condition for the inlet by providing a waterblock in the downstream location. The height of the waterblock was determined by the following three conditions:  
1. Cattle Guard acting as a weir  
2. Cattle Guard acting as a sag inlet  
3. Inlet controlled culvert

## CATTLE GUARD ACTING AS WEIR:


$Q = C_w P d^{1.5}$   
 $140cfs = 3.33 (32') d^{1.5}$   
 $d = 1.2'$   
Grate Inlet Elevation = 89.19  
 $HWEL = 89.19' + 1.2' = 90.39'$

## CATTLE GUARD ACTING AS A SUMP INLET (ORIFICE INTO GRATE):

$Q = C_o A_g \sqrt{2gh}$   
 $A_g = \text{clear opening} = 66.72sf$ . After applying a 50% clogging factor,  $A_g = 33.64sf$   
 $140cfs = 0.67(33.64)\sqrt{2(32.16)d}$   
 $d = 0.6'$   
Grate Inlet Elevation = 89.19  
 $HWEL = 89.19' + 0.6' = 89.69'$

## INLET CONTROLLED CULVERT

Using an Inlet Controlled Nomograph

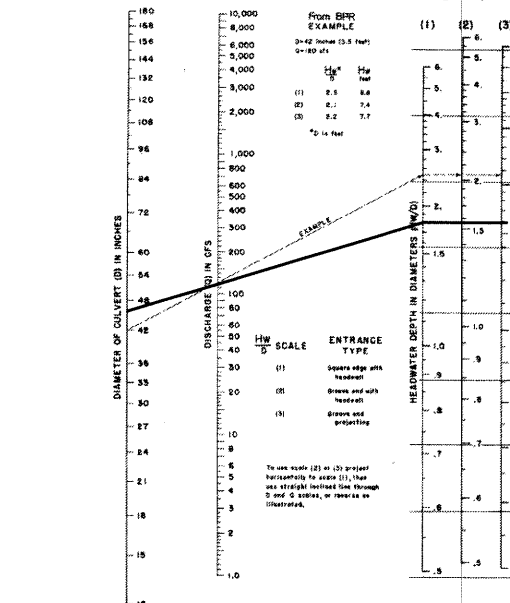

$H_w/D = 1.95$  for square edge  
Storm Drain Inlet Elevation = 81.09  
 $HWEL = (1.95)(4' \text{ dia}) + 81.09' = 88.9'$

## DRAINAGE CERTIFICATION

I, MARK GOODWIN, PE, NMPE 8948, OF THE FIRM MARK GOODWIN & ASSOCIATES, P.A. HEREBY CERTIFY THAT THIS PROJECT HAS BEEN GRADED AND WILL DRAIN IN SUBSTANTIAL COMPLIANCE WITH AND IN ACCORDANCE WITH THE DESIGN INTENT OF THE APPROVED PLAN DATED MAY 20, 2014. THE RECORD INFORMATION EDITED INTO THE ORIGINAL DESIGN DOCUMENT HAS BEEN OBTAINED BY TIM ALDRICH, NMPS 7719, OF THE FIRM ALS, INC. I FURTHER CERTIFY THAT I HAVE PERSONALLY VISITED THE PROJECT SITE ON 7/18/14, AND HAVE DETERMINED BY VISUAL INSPECTION THAT THE SURVEY DATA PROVIDED IS REPRESENTATIVE OF ACTUAL SITE CONDITIONS AND IS TRUE AND CORRECT TO THE BEST OF MY KNOWLEDGE AND BELIEF. THIS CERTIFICATION IS SUBMITTED IN SUPPORT OF A REQUEST FOR GRADING CERTIFICATION APPROVAL.

THE RECORD INFORMATION PRESENTED HEREON IS NOT NECESSARILY COMPLETE AND INTENDED ONLY TO VERIFY SUBSTANTIAL COMPLIANCE OF THE GRADING AND DRAINAGE ASPECTS OF THIS PROJECT. THOSE RELYING ON THIS RECORD DOCUMENT ARE ADVISED THAT THE ENGINEER'S INDEPENDENT VERIFICATION OF THE ACCURACY BEFORE USING IT FOR ANY OTHER PURPOSES.

Mark Goodwin 7/18/14  
MARK GOODWIN NMPE 8948 DATE





## EARTHWORK

Area of Grading and Land Disturbance is 0.13 acres  
Total Volume of fill required is 313cy

## CONCLUSIONS AND RECOMMENDATIONS

The offsite flows can be contained by changing the inlet to a sump condition by adding a waterblock downstream. Per the hydraulic calculations, the maximum HWEL is at 5290.39. By constructing a waterblock at Elevation 5291 per the plans, the offsite flows from Four Hills can be adequately contained until captured by the existing Cattle Guard inlet.


Because the site is less than 1 acre in size, this site is exempt from a NPDES permit.

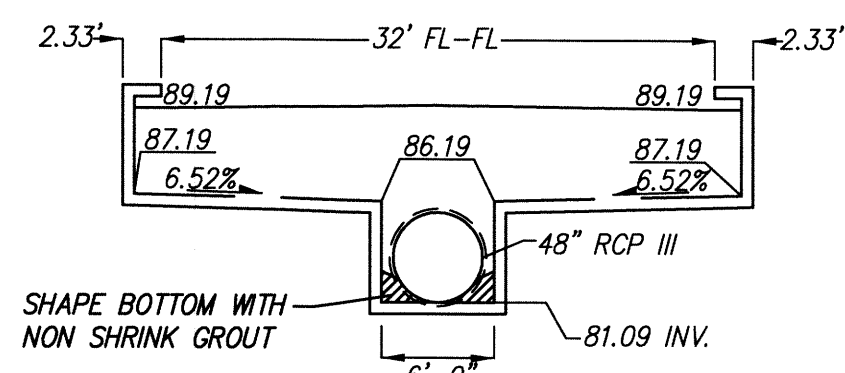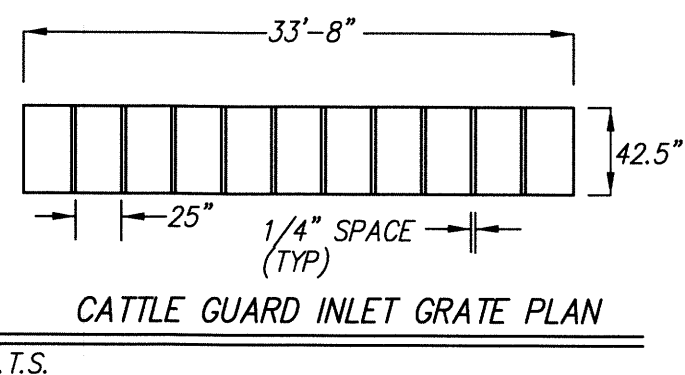

CATTLE GUARD INLET (NORTH SIDE)  
N.T.S. PER COA DWG 2271, 2272 & 2220



## LEGEND

- 5210 EXISTING CONTOUR (MAJOR)
- EXISTING CONTOUR (MINOR)
- 75 NEW CONTOUR
- STORM GRATE
- 2" ASPHALT As-Built
- 6" AGGREGATE BASE COURSE - As-Built
- NATIVE SEED AND MULCH

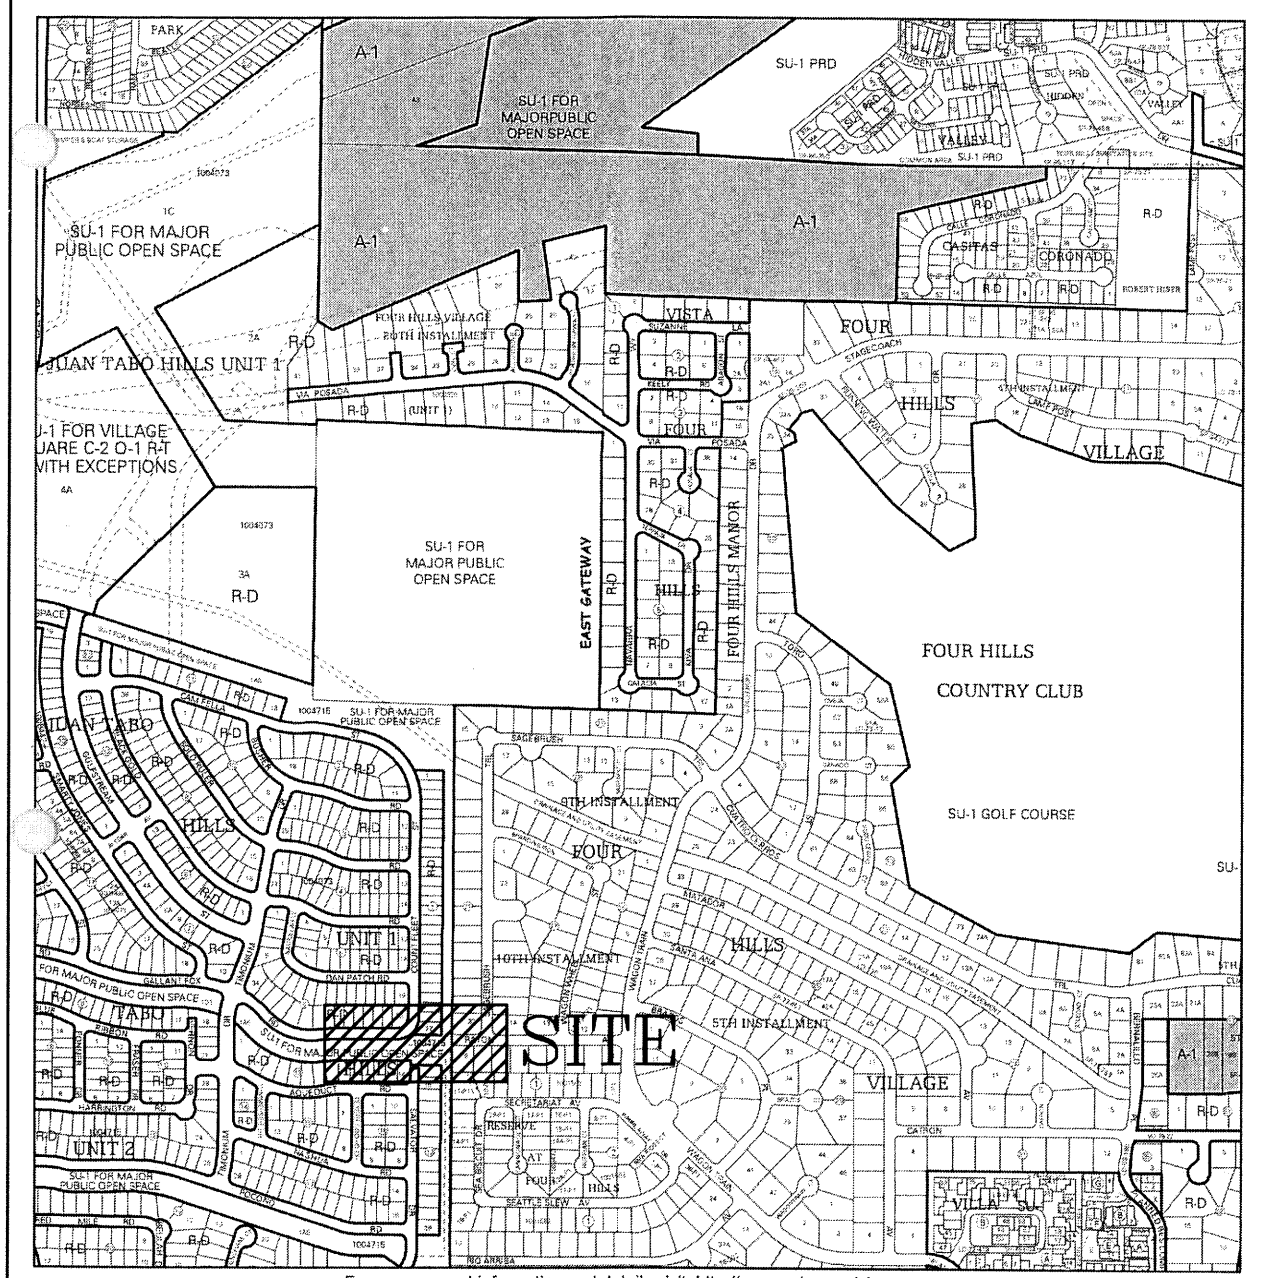

VICINITY MAP ZONE MAP: M-21/M-22

Juan Tabo Hills Subdivision  
Unit 2 and Unit 1  
West End of Raton Avenue

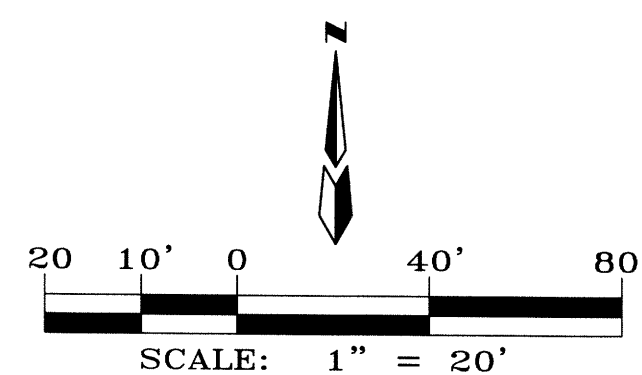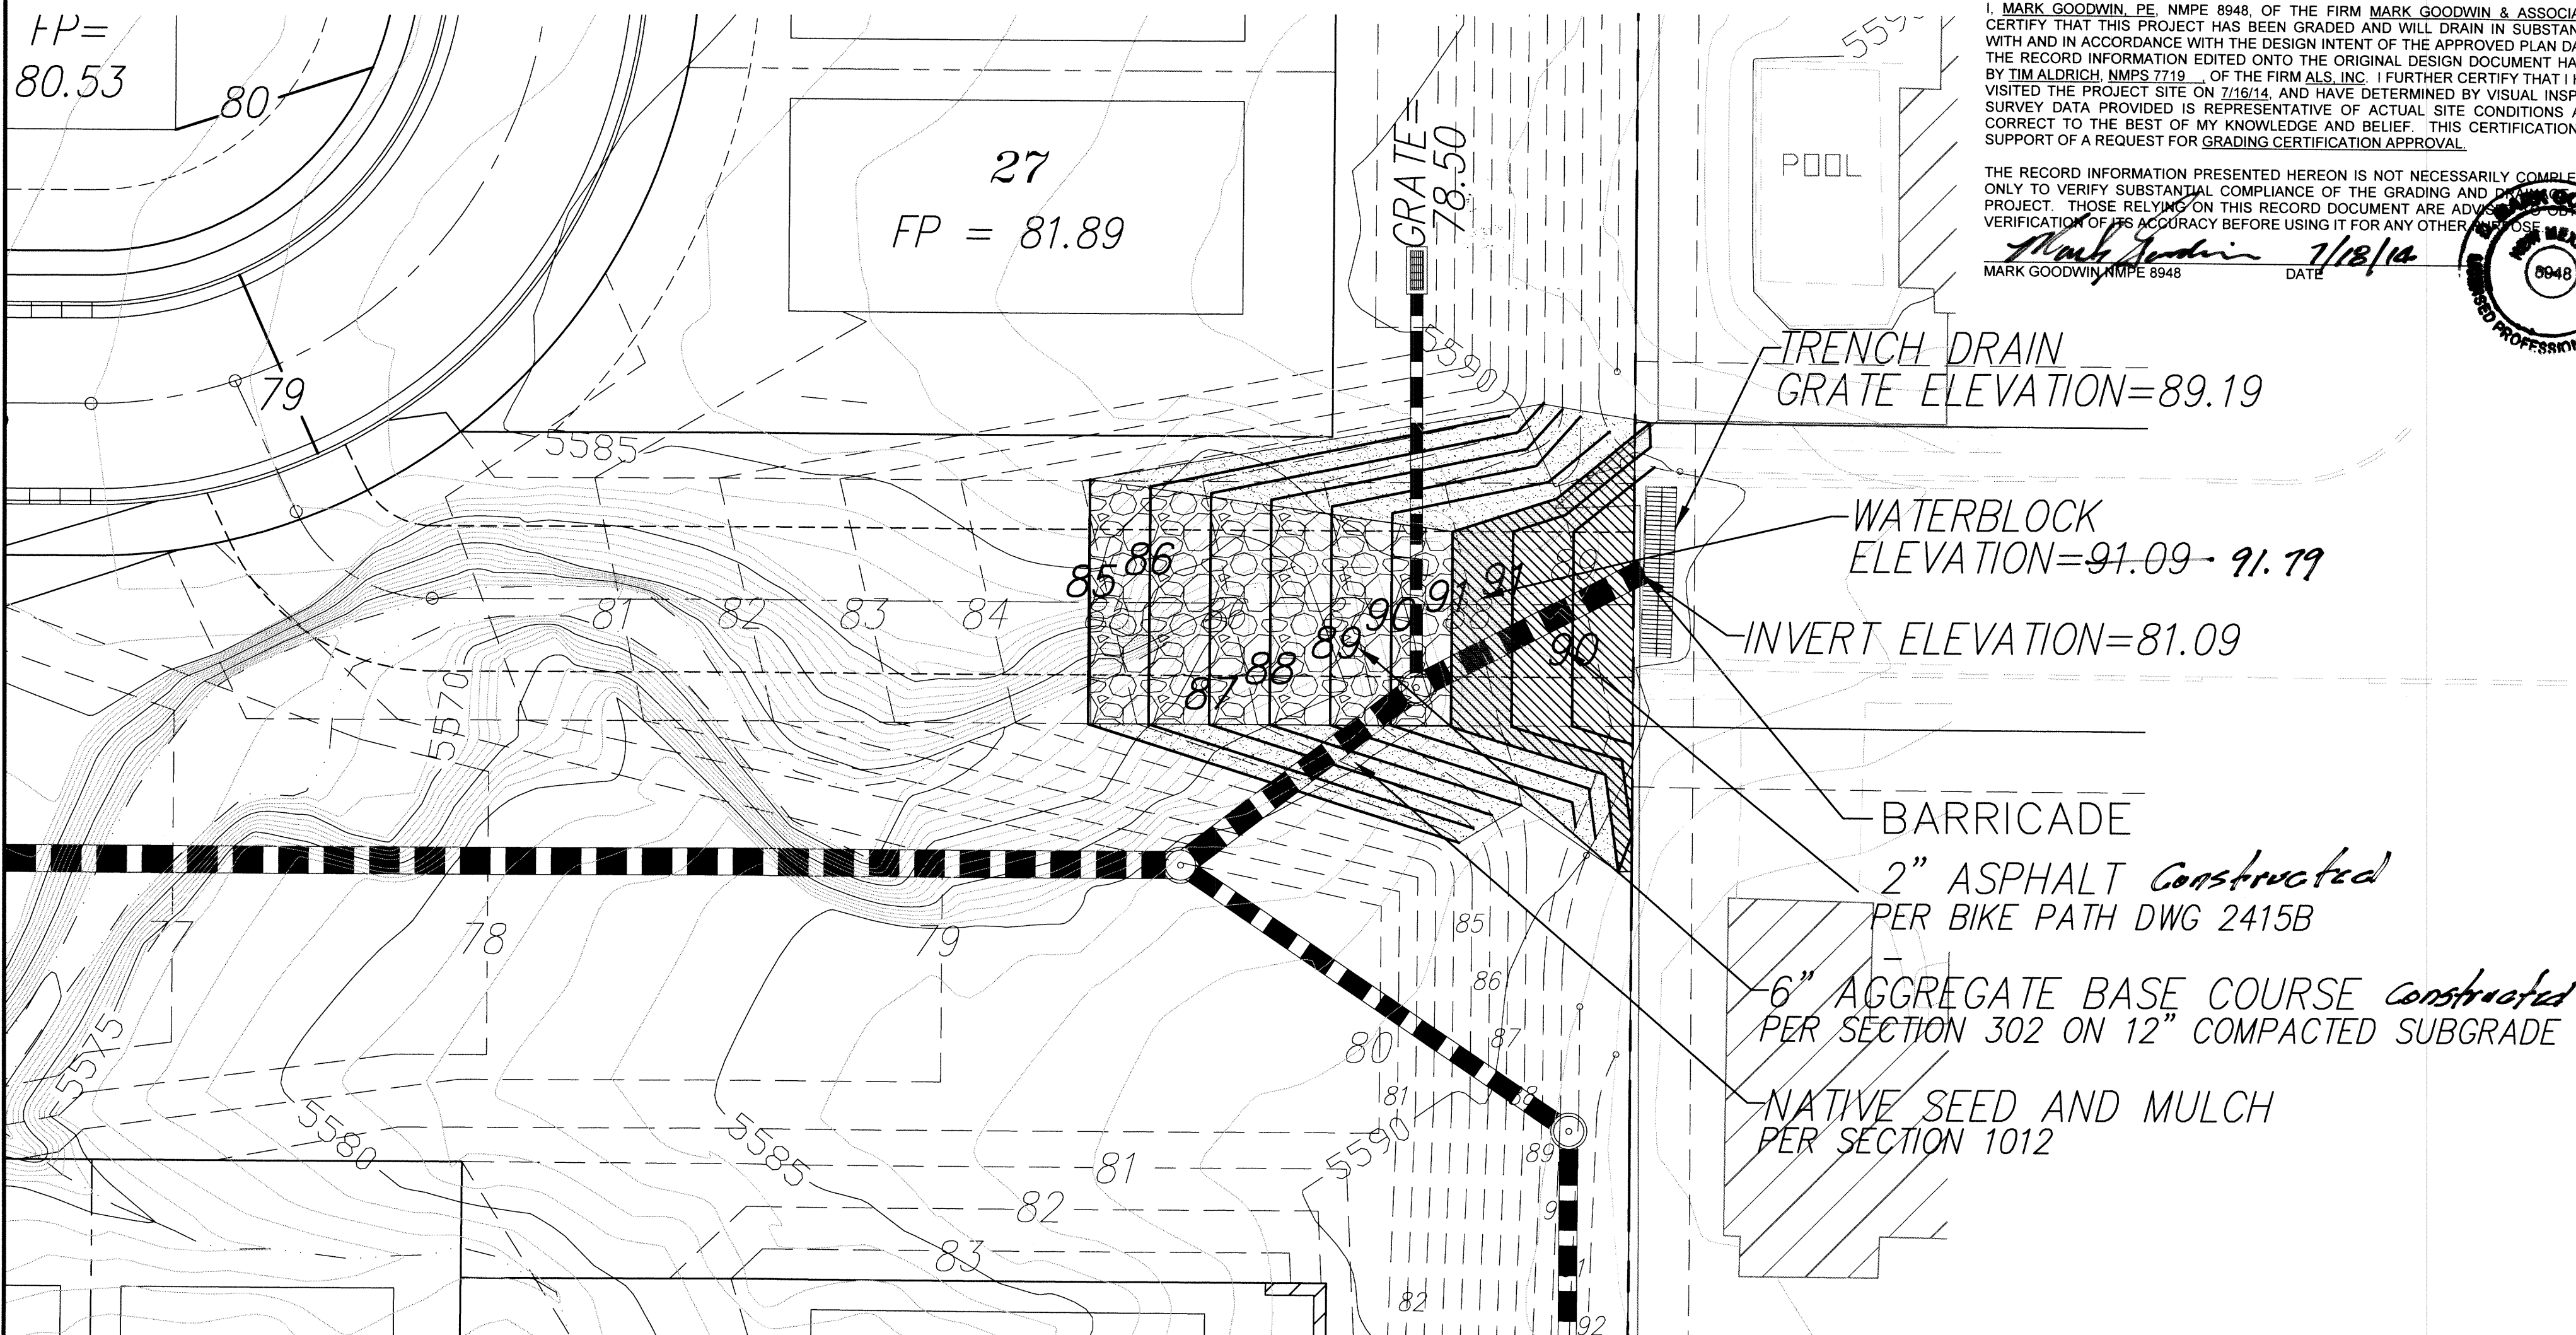

dmg MARK GOODWIN & ASSOCIATES, P.A.  
CONSULTING ENGINEERS  
P.O. BOX 90606  
ALBUQUERQUE, NEW MEXICO 87199  
(505) 828-2200, FAX (505) 797-9539



CITY OF ALBUQUERQUE  
PUBLIC WORKS DEPARTMENT

TITLE: JUAN TABO HILLS SUBDIVISION UNIT 1  
RATON AVENUE GRADING & DRAINAGE PLAN

DESIGN REVIEW COMMITTEE	CITY ENGINEER APPROVAL	DATE	MO./DAY/YR.	MO./DAY/YR.

CITY PROJECT NO. XX ZONE MAP NO. M-21/22 SHEET 1 OF 1