

ASBUILT SURVEY
LOT 1, TRACT 1
FOUR HILLS VILLAGE
INSTALLMENT 11-A
CITY OF ALBUQUERQUE
BERNALILLO COUNTY, NEW MEXICO
AUGUST, 2014


TOP OF POND ACTUAL DIMENSIONS ARE 65' X 30' X 2.5' = 872 CU FT > 870 CU FT

POND GRADED DEEPER 8/21/2014, NOT REFLECTED HERE. PHOTOS EMAILED TO CITY.
REVIEWMENT SHALL INSTALLED WITH FULL BUILDOUT OF LANDSCAPING BY LANDSCAPE CONTRACTOR.
IT MUST BE INSTALLED TO MEET FULL COMPLIANCE WITH ORIGINAL DESIGN INTENT.

WALL NOT CONSTRUCTED. EROSION
PROTECTION ACHIEVED USING
SLOPE BLANKETS. THIS IS A
TEMPORARY MEASURE THAT ACHIEVES
DESIGN INTENT. MUST BE MAINTAINED.

BEAM NOT
CONSTRUCTED
AS PLANNED
MUST BE INSTALLED
FOR FULL COMPLIANCE
WITH DESIGN INTENT.

WATER BLOCK
INSTALLED BY DRIVE PAD
AFTER THIS
SURVEY. RATES EMAILED
BY CONTRACTOR.

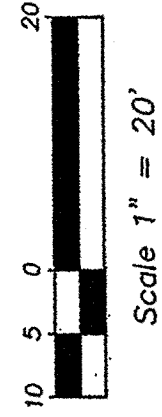


DRAINAGE CERTIFICATION WITH SURVEY WORK BY PROFESSIONAL
SURVEYOR

I, RUSS P. HUGG, NMP# 9750, OF THE FIRM
MEASURED & CALCULATED. HEREBY CERTIFY THAT THIS PROJECT HAS BEEN
GRADED AND WILL DRAIN IN SUBSTANTIAL COMPLIANCE WITH AND IN
ADVANCE WITH THE DESIGN INTENT OF THE APPROVED PLAN DATED
11/11/10. THE DESIGN INTENT HAS BEEN OBTAINED BY THE ORIGINAL
DESIGN DOCUMENT HAS BEEN OBTAINED BY THE ORIGINAL
NMP# 9750 OF THE FIRM SURV-TEK. I FURTHER CERTIFY THAT
I HAVE PERSONALLY VISITED THE PROJECT SITE ON 8/21/14
AND HAVE DETERMINED BY VISUAL INSPECTION THAT THE SURVEY DATA
PROVIDED IS REPRESENTATIVE OF ACTUAL SITE CONDITIONS AND IS
TRUE AND CORRECT TO THE BEST OF MY KNOWLEDGE AND BELIEF. THIS
CERTIFICATION IS SUBMITTED IN SUPPORT OF A REQUEST FOR
APPROVAL AS SUBMITTED.

(Describe any exceptions and/or modifications here in a separate paragraph.)
(Describe any deficiencies and/or corrections required here in a separate paragraph.)
SEE NOTES ON THIS SHEET.
THE RECORD INFORMATION PRESENTED HEREON IS NOT NECESSARILY
COMPLETE AND INTENDED ONLY TO VERIFY SUBSTANTIAL COMPLIANCE
OF THE GRADING AND DRAINAGE ASPECTS OF THIS PROJECT. THOSE
RELYING ON THE RECORD DOCUMENT ARE ADVISED TO OBTAIN
INDEPENDENT VERIFICATION OF ITS ACCURACY BEFORE USING IT FOR
ANY OTHER PURPOSE.

ENGINEER'S STAMP

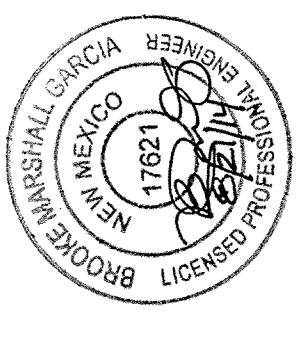


Signature of Engineer

8/21/14
Date

SURVEYORS CERTIFICATION

I, Russ P. Hugg, New Mexico Professional Surveyor Number
9750, hereby certify that the as-built information shown
hereon is the result of an actual field survey performed by
me or under my direct supervision and that the same is
true and correct to the best of my knowledge and belief.

Russ P. Hugg
NMP# No. 9750
8.21.14

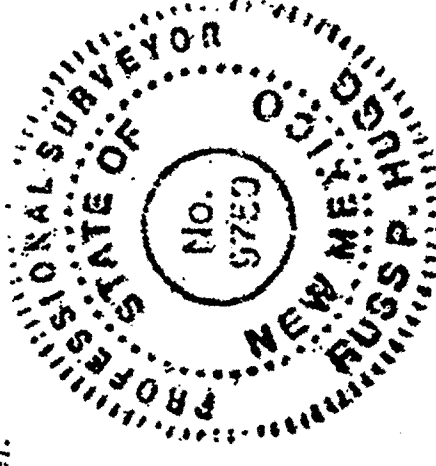

SURV-TEK, INC.

Consulting Surveyors
8801 Valley View Drive N.W. Albuquerque, New Mexico 87114
Phone: 505-897-3598
Fax: 505-897-3577

130475 topo