



NOTES

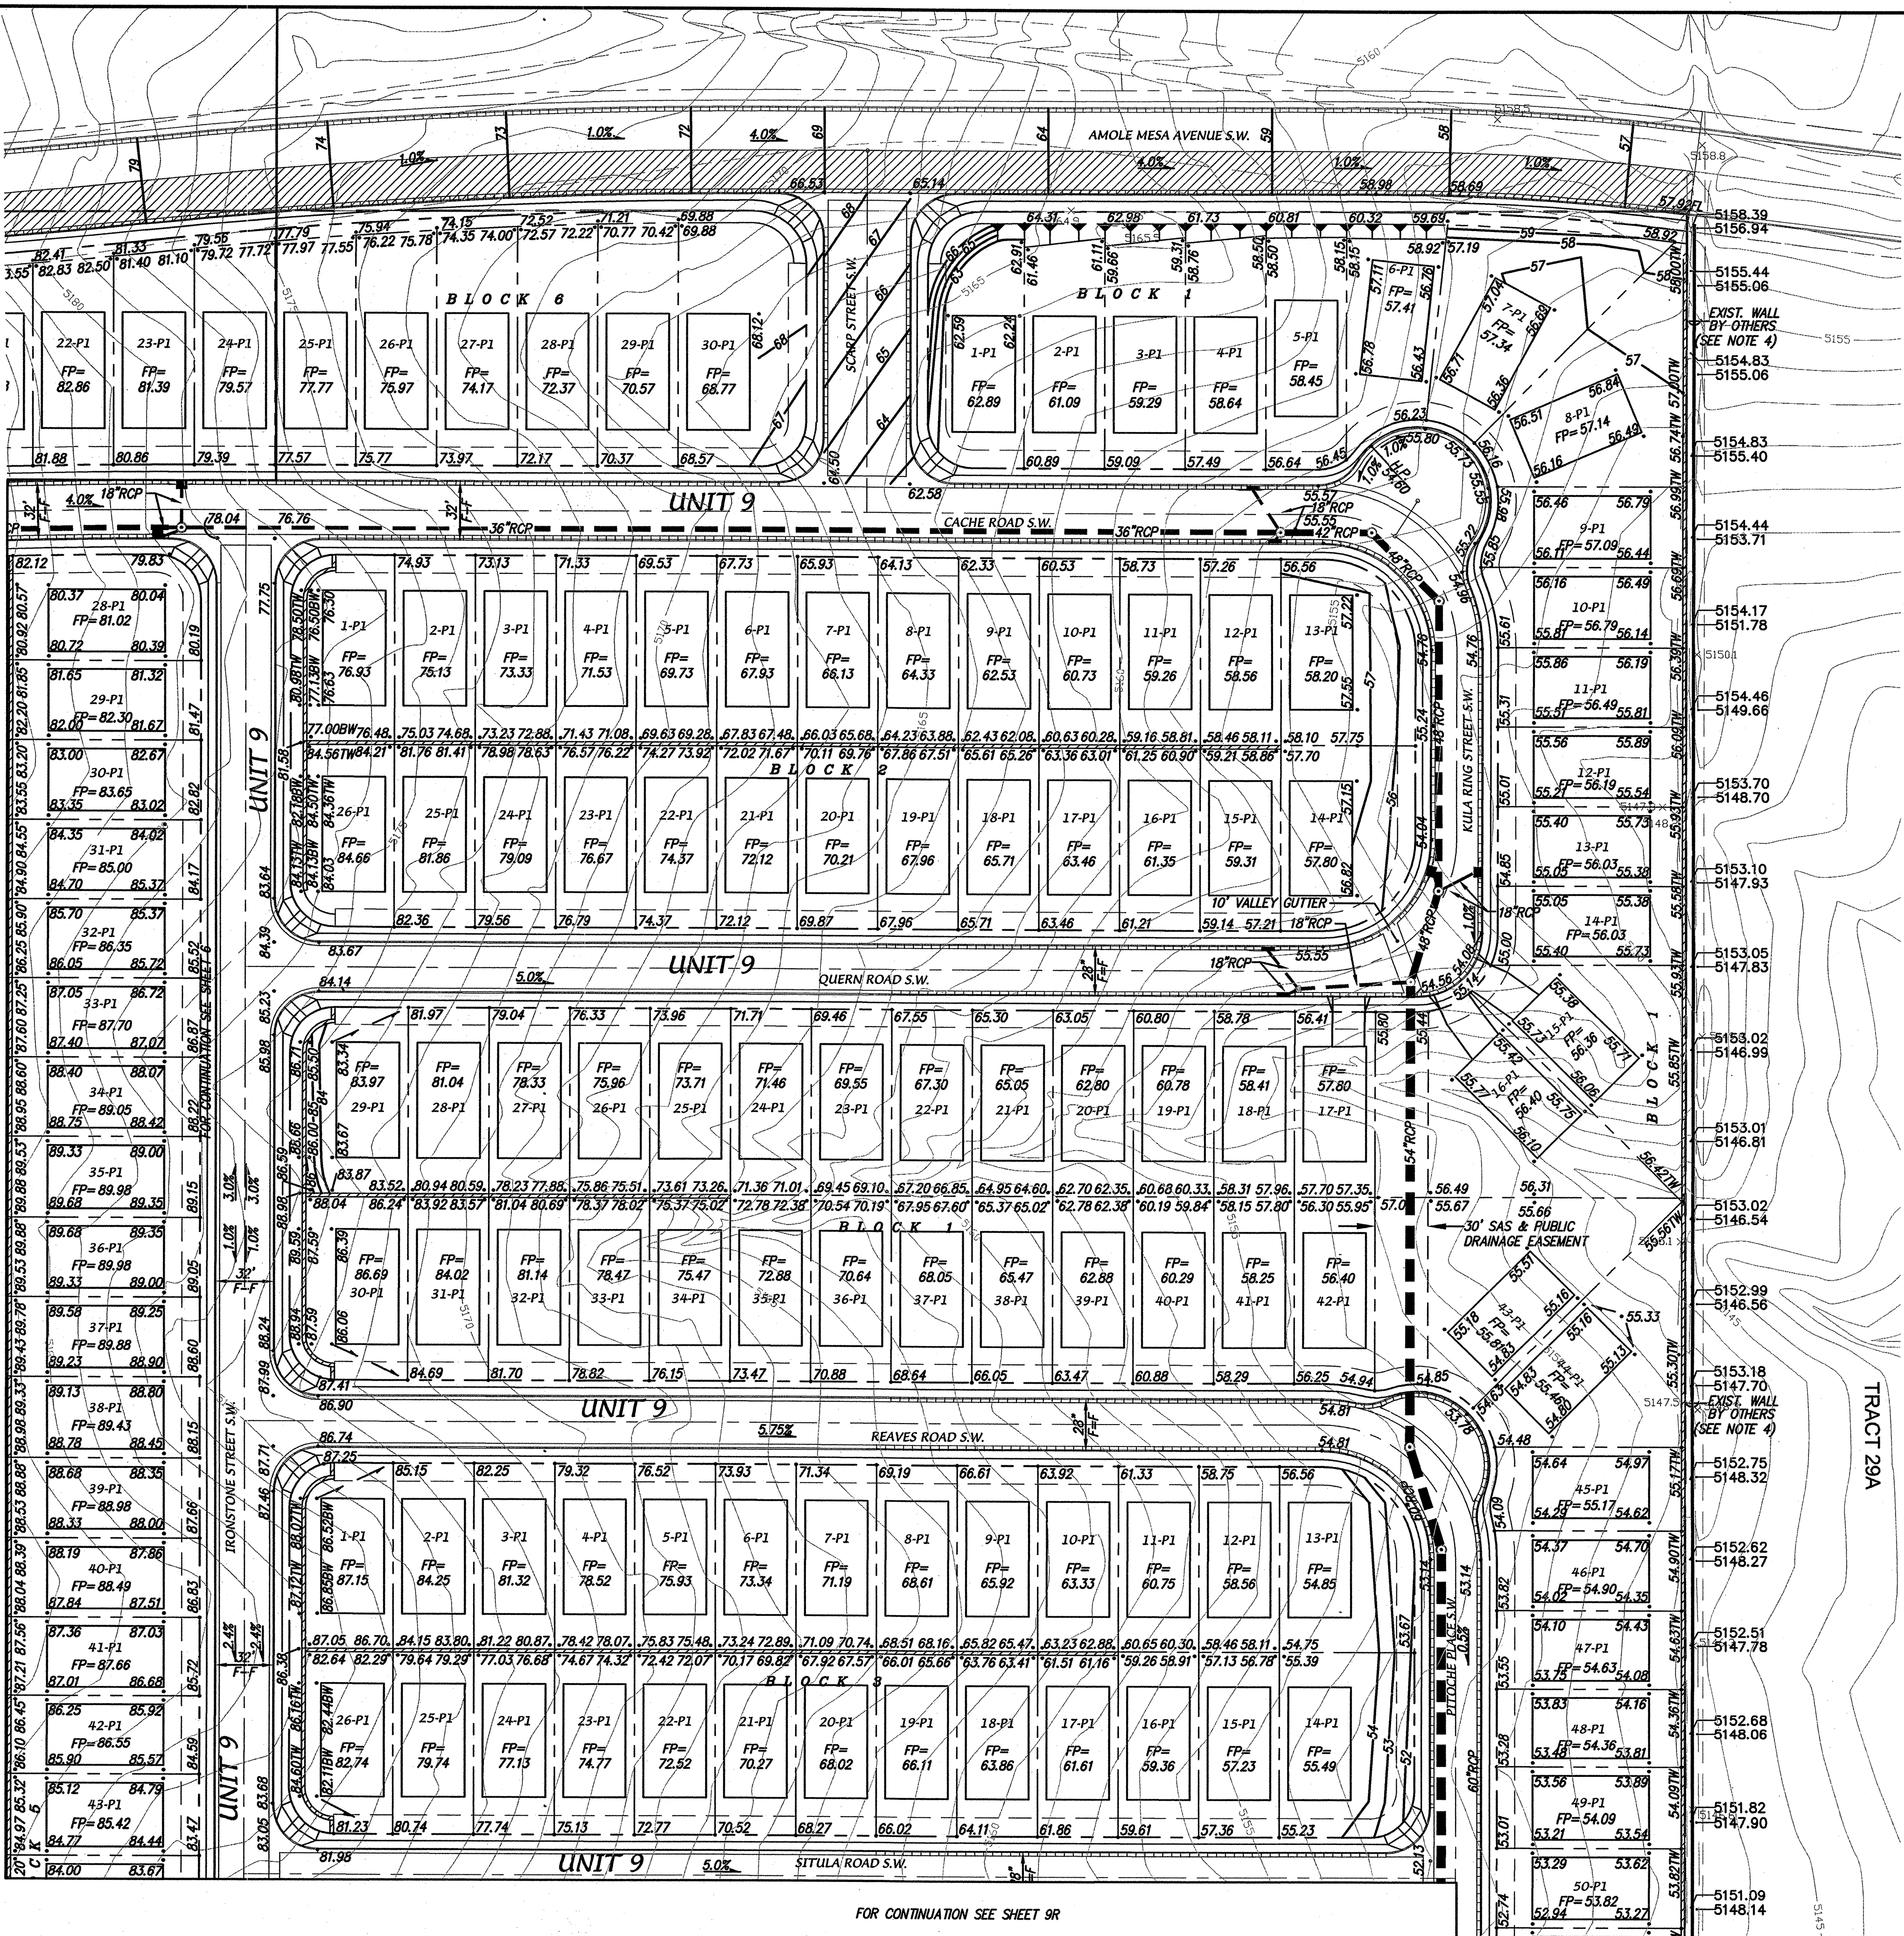

NOTE 1 & 2 PERTAIN TO SHEET 9R ONLY.

NOTE 3: UNIT 9 GRADING PLAN REVISED TO ACCOMMODATE MINIMUM COVER OVER STORM DRAIN AND DRC TRANSPORTATION COMMENTS.

NOTE 4: FIELD VERIFY THE LOCATION OF THE EXISTING RETAINING WALL NEAR EAST PROPERTY LINE BEFORE CONSTRUCTING NEW RETAINING WALL ON PROPERTY LINE.

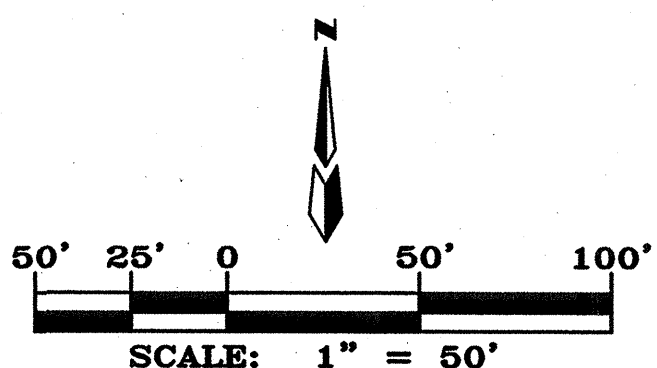

dmg MARK GOODWIN & ASSOCIATES, P.A.
CONSULTING ENGINEERS
P.O. BOX 90606
ALBUQUERQUE, NEW MEXICO 87199
(505) 828-2200, FAX (505) 797-9539

CITY OF ALBUQUERQUE PUBLIC WORKS DEPARTMENT		RECEIVED SEP 10 2007	
TITLE: ANDERSON HEIGHTS UNIT 9 GRADING AND DRAINAGE PLAN			
DESIGN REVIEW COMMITTEE	CITY ENGINEER APPROVAL	MO./DAY/YR.	MO./DAY/YR.
CITY PROJECT NO. 753981		ZONE MAP NO. N-8/P-8	SHEET OF 7R 83

ENGINEER'S SEAL		BENCH MARKS		AS BUILT INFORMATION	
DATE: 02/04 BY: DMG		STATION 3+100 IS LOCATED 5.9 MI. SW OF DOWNTOWN ALBUQUERQUE TO REACH STATION FROM INT. OF COORS AND DENNIS CHAVEZ BLVD. (FORMERLY RIO GRAY), GO S. ON COORS BLVD. 0.62 MI. TO THE STATION WHICH IS ON AN EARTHEN BERM 162.2' WEST OF THE CENTERLINE OF COORS BLVD. THE STATION IS A STANDARD ACS 3 1/4" ALUMINUM CAP RIVETED TO A PPE 0.25' ABOVE THE GROUND AND IS STAMPED "3+100, 1998". ELEV=4935.735 (S.D. 29) X=360733.56, Y=162437.48 (NAD 27)		CONTRACTOR: ALBUQUERQUE INSPECTOR'S: DENNIS CHAVEZ BLVD. DATE: 02/04 BY: DMG MICRO-FILM INFORMATION RECORDED BY: NO.	

REMARKS		BY	
NO. DATE		NO. DATE	
DESIGNED BY: G/K		DATE: 02/04	
DRAWN BY: M/JR		DATE: 02/04	
CHECKED BY: DMG		DATE: 02/04	

