

# CITY OF ALBUQUERQUE

*Planning Department*  
Alan Varela, Director



*Mayor Timothy M. Keller*

October 23, 2025

Genevieve Donart, P.E.  
Isaacson & Arfman, Inc.  
128 Monroe St. NE  
Albuquerque, NM 87108

**RE: Aspire Subdivision – Unit 4 – Lots 1-17 and 111-117**  
**Request for Pad Certification – Accepted**  
**Engineer's Certification Date: 10/07/2025**  
**Engineer's Stamp Date: 03/08/22**  
**Hydrology File: N08D006F4**

Dear Ms. Donart:

PO Box 1293

Based upon the information provided in your Certification received 10/22/2025 and site visit on 10/23/2025, the above referenced Certification is acceptable for Building Pad Certification for the **Aspire Subdivision Unit 4 – Lots 1-17 and 111-117**. Please attach a copy of this approval letter and approved Grading & Drainage Plan with each lot's Building Permit submittal.

Albuquerque

If you have any questions, please contact me at 505-924-3314 or [amontoya@cabq.gov](mailto:amontoya@cabq.gov).

NM 87103

Sincerely,

[www.cabq.gov](http://www.cabq.gov)


Anthony Montoya, Jr., P.E., C.F.M.  
Senior Engineer, Hydrology  
Planning Department, Development Review Services




**BUILDING PAD GRADING CERTIFICATION  
WITH SURVEY WORK BY PROFESSIONAL  
SURVEYOR**

I, GENEVIEVE L. DONART, NMPE 15088, OF THE FIRM ISAACSON & ARFMAN, INC., HEREBY CERTIFY THAT BUILDING PAD ELEVATIONS FOR LOTS 1-17 AND 111-117 OF UNIT 4, AS OBTAINED AND DOCUMENTED BY KIM C. STELZER NMPS, 7482, OF THE FIRM HUITT-ZOLLARS, INC. HAS BEEN GRADED IN SUBSTANTIAL COMPLIANCE WITH THE DESIGN INTENT OF THE APPROVED PLAN DATED 03/08/2022. THE CERTIFICATION DOCUMENT PROVIDED BY THE SURVEYOR IS REPRESENTATIVE OF ACTUAL SITE CONDITIONS AND IS TRUE AND CORRECT TO THE BEST OF MY KNOWLEDGE AND BELIEF. THIS CERTIFICATION IS SUBMITTED IN SUPPORT OF A REQUEST FOR PAD CERTIFICATION AND BUILDING PERMIT APPROVAL.

Genevieve L. Donart  
Date 10/07/2025  
NMPE #15088

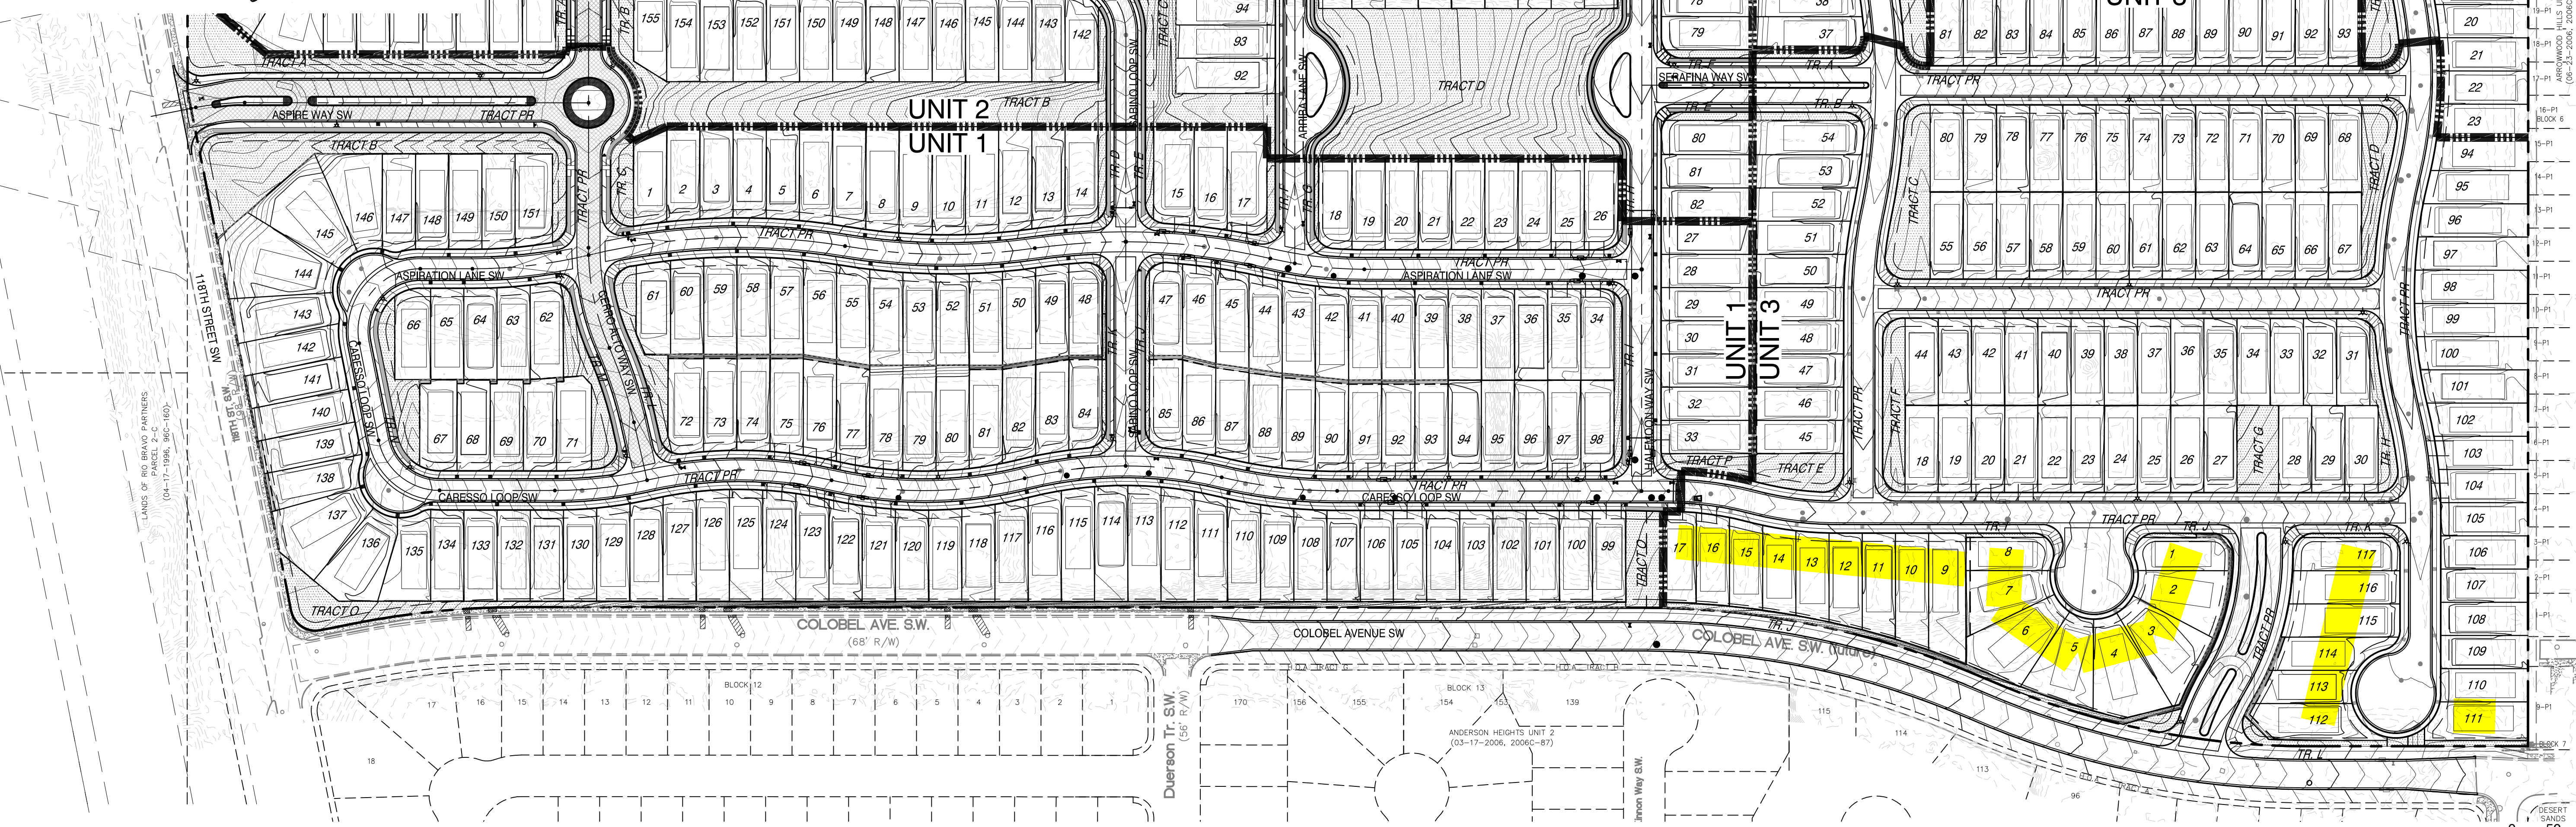

**SITE KEY**

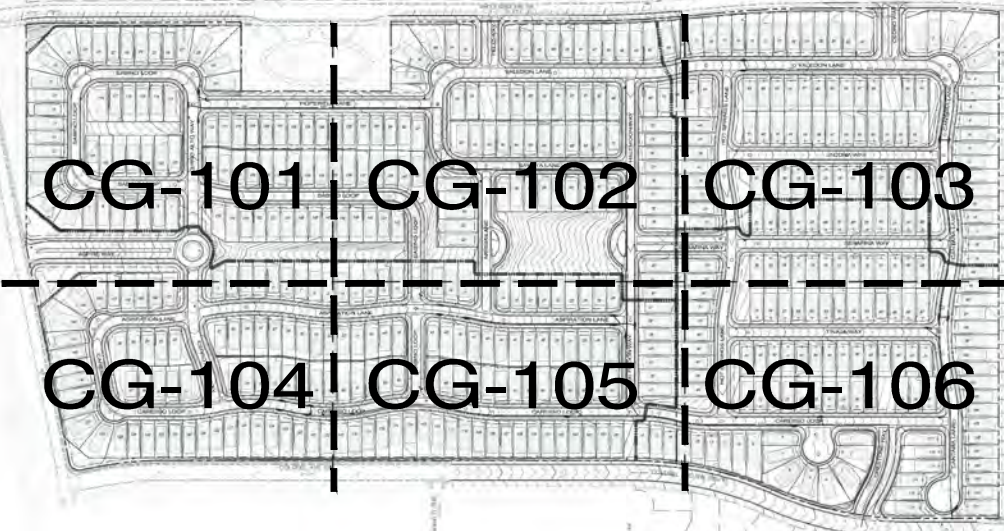

**GENERAL NOTES**

- ELEVATIONS AND IN ACCORDANCE WITH THE DETAILS SHOWN ON THIS PLAN.
- ALL SITE PREPARATION, GRADING OPERATIONS, FOUNDATION CONSTRUCTION, AND PAVEMENT INSTALLATION WORK SHALL BE CONSTRUCTED IN ACCORDANCE WITH THE GEOTECHNICAL REPORT, WHICH WILL BE PROVIDED BY THE OWNER. ALL OTHER WORK SHALL, UNLESS OTHERWISE NOTED IN THE PLANS, BE CONSTRUCTED IN ACCORDANCE WITH THE CITY OF ALBUQUERQUE STANDARD SPECIFICATIONS FOR PUBLIC WORKS CONSTRUCTION.
- PROPOSED SPOT AND CONTOUR ELEVATIONS SHOWN REPRESENT TOP OF FINISH MATERIAL (I.E. TOP OF CONCRETE, TOP OF CONCRETE BUILDING PAD, TOP OF PAVEMENT MATERIAL, TOP OF LANDSCAPING MATERIAL, ETC.). CONTRACTOR SHALL GRADE, COMPACT SUBGRADE AND DETERMINE EARTHWORK ESTIMATES BASED ON ELEVATIONS SHOWN MINUS FINISH MATERIAL THICKNESSES.
- IF FIELD GRADE ADJUSTMENTS ARE REQUIRED, THE CONTRACTOR SHALL NOTIFY THE ENGINEER.
- THE ENVIRONMENTAL PROTECTION AGENCY (EPA) AND THE CITY OF ALBUQUERQUE REQUIRE A STORM WATER POLLUTION PREVENTION PLAN (SWPPP), AN NPDES PERMIT FOR PROJECTS WHERE CONSTRUCTION ACTIVITIES MEET THE EPA THRESHOLD. (SWPPP, NPDES PERMIT BY OTHERS.) CONTRACTOR SHALL COORDINATE WITH OWNER TO DETERMINE WHO WILL PREPARE SWPPP AND INSPECT REQUIRED ELEMENTS.
- ALL NEW PAVEMENT SURFACES SHALL BE CONSTRUCTED WITH POSITIVE SLOPE AWAY FROM BUILDINGS AND POSITIVE SLOPE TOWARD EXISTING AND/OR PROPOSED DRAINAGE PATHS. PAVING AND ROADWAY GRADES SHALL BE  $\pm 0.1'$  FROM PLAN ELEVATIONS. BUILDING PAD ELEVATION SHALL BE  $\pm 0.05'$  FROM PLAN ELEVATION.
- WHERE GRADES BETWEEN NEW AND EXISTING ARE SHOWN AS 'MATCH' OR '±', TRANSITIONS SHALL BE SMOOTH.
- PAD ELEVATIONS SHALL BE WITHIN 0.1±.
- POND DESIGN PARAMETERS AND STORMWATER CONTROL MEASURES SHOWN ON THIS PLAN (TOP OF POND, BOTTOM OF POND, SIZE OF ORIFICE, AREA OF POND, ETC.) TO BE STRICTLY ADHERED TO FOR CERTIFICATION PURPOSES. SEE DETAIL SHEET FOR ADDITIONAL INFORMATION.
- POST-CONSTRUCTION MAINTENANCE FOR PRIVATE STORMWATER FACILITIES WILL BE THE RESPONSIBILITY OF THE FACILITIES OWNER. ENGINEER RECOMMENDS THAT OWNER INSPECT SITE YEARLY AND AFTER EACH RAINFALL TO IDENTIFY NEW AREAS OF EROSION AND INSTALL ADDITIONAL EROSION PROTECTION AS NEEDED BASED ON ACTUAL OCCURRENCES.
- EXISTING UTILITY LINES ARE SHOWN IN AN APPROXIMATE MANNER ONLY AND MAY BE INCOMPLETE OR OBSOLETE. SUCH LINES MAY OR MAY NOT EXIST WHERE SHOWN OR NOT SHOWN. CONTRACTOR SHALL CONTACT NM-811 FOR UTILITY LINE SPOTS FIVE WORKING DAYS PRIOR TO CONDUCTING SITE FIELD WORK. CONTRACTOR SHALL FIELD VERIFY AND LOCATE ALL UTILITIES PRIOR TO COMMENCEMENT OF ANY CONSTRUCTION. CONTRACTOR IS FULLY RESPONSIBLE FOR ANY AND ALL DAMAGE CAUSED BY ITS FAILURE TO LOCATE, IDENTIFY AND PRESERVE ANY AND ALL EXISTING UTILITIES, PIPELINES, AND UNDERGROUND UTILITY LINES. THE CONTRACTOR SHALL BE RESPONSIBLE FOR COORDINATION OF NECESSARY DRY UTILITY ADJUSTMENTS.
- FOR ENGINEER'S CERTIFICATION OF SUBSTANTIAL COMPLIANCE (FOR CERTIFICATE OF OCCUPANCY) CONTRACTOR SHALL PROVIDE AN AUTOCAD FORMAT AS-BUILT SURVEY PREPARED BY A LICENSED SURVEYOR WHICH INCLUDES:
  - AS-BUILT SPOT ELEVATIONS AT EACH DESIGN SPOT ELEVATION SHOWN ON THE APPROVED PLAN;
  - TOP AND BOTTOM ELEVATIONS AS REQUIRED TO DEFINE THE PERIMETER OF PONDS (TO BE USED BY ENGINEER TO CALCULATE AS-BUILT VOLUME PROVIDED);
  - ALL CONSTRUCTION, INCLUDING DRAIN INLETS, PIPES AND PONDS SHOWN ON THIS PLAN MUST BE CONSTRUCTED IN SUBSTANTIAL COMPLIANCE WITH THE APPROVED PLAN IN ORDER TO RECEIVE ENGINEER'S CERTIFICATION.
- UPON WRITTEN REQUEST, THE ELECTRONIC FILE OF THE GRADING AND DRAINAGE WILL BE PROVIDED TO THE CONTRACTOR FOR VERTICAL CONTROL.
- SITE CONSTRUCTION LAYOUT / STAKING SHALL BE COORDINATED WITH THE OWNER.

**VICINITY MAP**



**Isaacson & Arfman, Inc.**  
Civil Engineering Consultants  
128 Monroe Street NE  
Albuquerque, NM 87108  
505-268-8828 | www.iacivil.com

**ASPIRE SUBDIVISION  
UNITS 1-4  
SUCCESS LAND HOLDINGS, LLC**

**OVERALL GRADING & DRAINAGE PLAN**

| Date:   | No. Revision:                                | Date:   | Job No. |
|---------|----------------------------------------------|---------|---------|
| 08/2020 | 1 REVISED LOT GRADES                         | 12/2020 | 2290    |
|         | 2 REVISED RING WALL, PAD, AND COLOBEL GRADES | 03/2022 |         |
|         | ADDED 2-FOOT RANDBY ON LOT 18, UNIT 2        |         |         |
|         | CHANGED TO MOUNTABLE CURB LOTS 18-20         |         |         |

Drawn By: thor  
Ckd By: ANW

CG-100  
SH. OF



June 5, 2024

Ms. Rene Brissette, PE  
City of Albuquerque  
Development and Building Services  
600 2nd St. NW, Suite 201  
Albuquerque, NM 87102

**RE: ASPIRE UNITS 3 & 4 MODIFIED LOTS FOR PAD CERTIFICATION  
(NO8D006F4&5)**

Dear Ms. Brissette,


We would like to modify our request for pad certification to certify the following lots at this time, and to certify the remainder once all of the retaining walls are complete:

- Unit 3 Lots 1-83
- Unit 4 Lots 18-110

Because the submittal fee was paid for the full 200 lots within Units 3 & 4 and there are only 176 in this modified request, we would like the fee to be waived when we submit for the remaining 24 lots.

Please call/email me with any questions or comments.

Sincerely,  
ISAACSON & ARFMAN, INC.

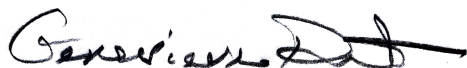


Genevieve Donart, PE




**BUILDING PAD GRADING CERTIFICATION  
WITH SURVEY WORK BY PROFESSIONAL  
SURVEYOR**

I, GENEVIEVE L. DONART, NMPE 15088, OF THE FIRM ISAACSON & ARFMAN, INC., HEREBY CERTIFY THAT BUILDING PAD ELEVATIONS FOR LOTS 1-17 AND 111-117 OF UNIT 4, AS OBTAINED AND DOCUMENTED BY KIM C. STELZER NMPS, 7482, OF THE FIRM HUITT-ZOLLARS, INC. HAS BEEN GRADED IN SUBSTANTIAL COMPLIANCE WITH THE DESIGN INTENT OF THE APPROVED PLAN DATED 03/08/2022. THE CERTIFICATION DOCUMENT PROVIDED BY THE SURVEYOR IS REPRESENTATIVE OF ACTUAL SITE CONDITIONS AND IS TRUE AND CORRECT TO THE BEST OF MY KNOWLEDGE AND BELIEF. THIS CERTIFICATION IS SUBMITTED IN SUPPORT OF A REQUEST FOR PAD CERTIFICATION AND BUILDING PERMIT APPROVAL.

Genevieve L. Donart  
Date 10/07/2025  
NMPE #15088

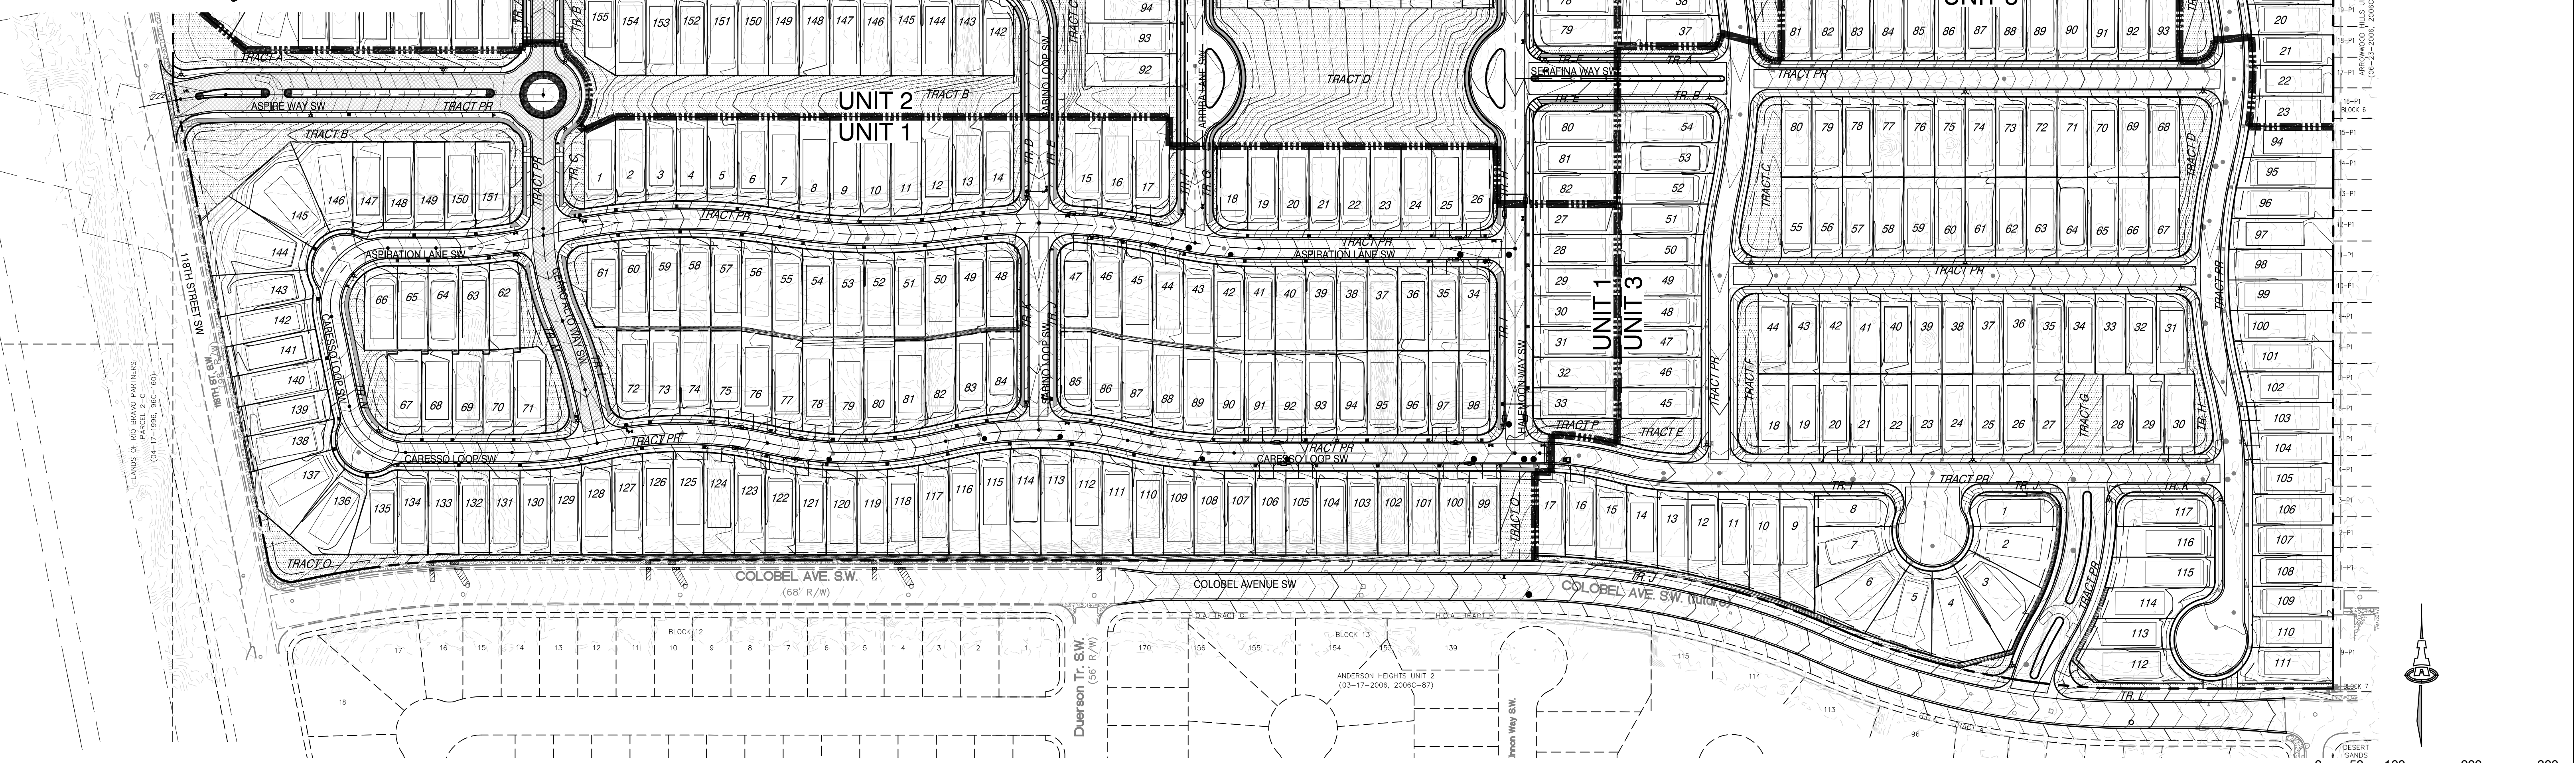

**SITE KEY**

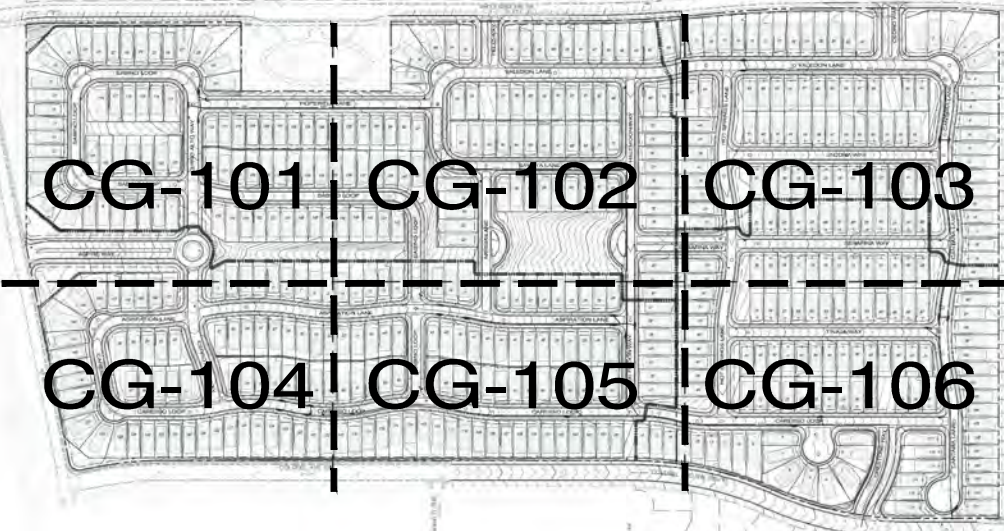

**GENERAL NOTES**

- GRADING SHALL BE PERFORMED AT THE ELEVATIONS AND IN ACCORDANCE WITH THE DETAILS SHOWN ON THIS PLAN.
- ALL SITE PREPARATION, GRADING OPERATIONS, FOUNDATION CONSTRUCTION, AND PAVEMENT INSTALLATION WORK SHALL BE CONSTRUCTED IN ACCORDANCE WITH THE GEOTECHNICAL REPORT, WHICH WILL BE PROVIDED BY THE OWNER. ALL OTHER WORK SHALL, UNLESS OTHERWISE NOTED IN THE PLANS, BE CONSTRUCTED IN ACCORDANCE WITH THE CITY OF ALBUQUERQUE STANDARD SPECIFICATIONS FOR PUBLIC WORKS CONSTRUCTION.
- PROPOSED SPOT AND CONTOUR ELEVATIONS SHOWN REPRESENT TOP OF FINISH MATERIAL (I.E. TOP OF CONCRETE, TOP OF CONCRETE BUILDING PAD, TOP OF PAVEMENT MATERIAL, TOP OF LANDSCAPING MATERIAL, ETC.). CONTRACTOR SHALL GRADE, COMPACT SUBGRADE AND DETERMINE EARTHWORK ESTIMATES BASED ON ELEVATIONS SHOWN MINUS FINISH MATERIAL THICKNESSES.
- IF FIELD GRADE ADJUSTMENTS ARE REQUIRED, THE CONTRACTOR SHALL NOTIFY THE ENGINEER.
- THE ENVIRONMENTAL PROTECTION AGENCY (EPA) AND THE CITY OF ALBUQUERQUE REQUIRE A STORM WATER POLLUTION PREVENTION PLAN (SWPPP), AN NPDES PERMIT FOR PROJECTS WHERE CONSTRUCTION ACTIVITIES MEET THE EPA THRESHOLD. (SWPPP, NPDES PERMIT BY OTHERS.) CONTRACTOR SHALL COORDINATE WITH OWNER TO DETERMINE WHO WILL PREPARE SWPPP AND INSPECT REQUIRED ELEMENTS.
- ALL NEW PAVEMENT SURFACES SHALL BE CONSTRUCTED WITH POSITIVE SLOPE AWAY FROM BUILDINGS AND POSITIVE SLOPE TOWARD EXISTING AND/OR PROPOSED DRAINAGE PATHS. PAVING AND ROADWAY GRADES SHALL BE  $\pm 0.1'$  FROM PLAN ELEVATIONS. BUILDING PAD ELEVATION SHALL BE  $\pm 0.05'$  FROM PLAN ELEVATION.
- WHERE GRADES BETWEEN NEW AND EXISTING ARE SHOWN AS 'MATCH' OR '±', TRANSITIONS SHALL BE SMOOTH.
- PAD ELEVATIONS SHALL BE WITHIN 0.1±.
- POND DESIGN PARAMETERS AND STORMWATER CONTROL MEASURES SHOWN ON THIS PLAN (TOP OF POND, BOTTOM OF POND, SIZE OF ORIFICE, AREA OF POND, ETC.) TO BE STRICTLY ADHERED TO FOR CERTIFICATION PURPOSES. SEE DETAIL SHEET FOR ADDITIONAL INFORMATION.
- POST-CONSTRUCTION MAINTENANCE FOR PRIVATE STORMWATER FACILITIES WILL BE THE RESPONSIBILITY OF THE FACILITIES OWNER. ENGINEER RECOMMENDS THAT OWNER INSPECT SITE YEARLY AND AFTER EACH RAINFALL TO IDENTIFY NEW AREAS OF EROSION AND INSTALL ADDITIONAL EROSION PROTECTION AS NEEDED BASED ON ACTUAL OCCURRENCES.
- EXISTING UTILITY LINES ARE SHOWN IN AN APPROXIMATE MANNER ONLY AND MAY BE INCOMPLETE OR OBSOLETE. SUCH LINES MAY OR MAY NOT EXIST WHERE SHOWN OR NOT SHOWN. CONTRACTOR SHALL CONTACT NM-811 FOR UTILITY LINE SPOTS FIVE WORKING DAYS PRIOR TO CONDUCTING SITE FIELD WORK. CONTRACTOR SHALL FIELD VERIFY AND LOCATE ALL UTILITIES PRIOR TO COMMENCEMENT OF ANY CONSTRUCTION. CONTRACTOR IS FULLY RESPONSIBLE FOR ANY AND ALL DAMAGE CAUSED BY ITS FAILURE TO LOCATE, IDENTIFY AND PRESERVE ANY AND ALL EXISTING UTILITIES, PIPELINES, AND UNDERGROUND UTILITY LINES. THE CONTRACTOR SHALL BE RESPONSIBLE FOR COORDINATION OF NECESSARY DRY UTILITY ADJUSTMENTS.
- FOR ENGINEER'S CERTIFICATION OF SUBSTANTIAL COMPLIANCE (FOR CERTIFICATE OF OCCUPANCY) CONTRACTOR SHALL PROVIDE AN AUTOCAD FORMAT AS-BUILT SURVEY PREPARED BY A LICENSED SURVEYOR WHICH INCLUDES:
  - AS-BUILT SPOT ELEVATIONS AT EACH DESIGN SPOT ELEVATION SHOWN ON THE APPROVED PLAN;
  - TOP AND BOTTOM ELEVATIONS AS REQUIRED TO DEFINE THE PERIMETER OF PONDS (TO BE USED BY ENGINEER TO CALCULATE AS-BUILT VOLUME PROVIDED);
  - ALL CONSTRUCTION, INCLUDING DRAIN INLETS, PIPES AND PONDS SHOWN ON THIS PLAN MUST BE CONSTRUCTED IN SUBSTANTIAL COMPLIANCE WITH THE APPROVED PLAN IN ORDER TO RECEIVE ENGINEER'S CERTIFICATION.
- UPON WRITTEN REQUEST, THE ELECTRONIC FILE OF THE GRADING AND DRAINAGE WILL BE PROVIDED TO THE CONTRACTOR FOR VERTICAL CONTROL.
- SITE CONSTRUCTION LAYOUT / STAKING SHALL BE COORDINATED WITH THE OWNER.

**VICINITY MAP**



**Isaacson & Arfman, Inc.**  
Civil Engineering Consultants  
128 Monroe Street NE  
Albuquerque, NM 87108  
505-268-8828 | www.iacivil.com

**ASPIRE SUBDIVISION  
UNITS 1-4  
SUCCESS LAND HOLDINGS, LLC**

**OVERALL GRADING & DRAINAGE PLAN**

| Date:     | No. Revision:                          | Date:   | Job No. |
|-----------|----------------------------------------|---------|---------|
| 08/2020   | 1 REVISED LOT GRADES                   | 12/2020 | 2290    |
|           | 2 REVISED R/W, PAD, AND COLOBEL GRADES | 03/2022 |         |
| Drawn By: | thor                                   |         | CG-100  |
| Ckd By:   | ANW                                    |         | SH. OF  |

THIS DESIGN, CALCULATIONS, AND CONCEPTS ARE OWNED BY AND REMAIN THE PROPERTY OF ISAACSON & ARFMAN, INC. AND NO PART THEREOF SHALL BE UTILIZED BY ANY PERSON, FIRM OR CORPORATION FOR ANY PURPOSE WHATSOEVER EXCEPT WITH THE WRITTEN PERMISSION OF ISAACSON & ARFMAN, INC. ©





City of Albuquerque  
Planning Department  
Development Review  
**HYDROLOGY SECTION**  
**APPROVED**  
DATE: 03/18/22  
BY: *Renee C. Bruneau*  
HydroTrans # N08D006F

THE APPROVAL OF THIS PLANNING SHALL NOT BE  
CONSIDERED AN ENDORSEMENT OF THE PROJECT OR  
GUARANTEE OF THE ACCURACY OF THE INFORMATION  
CONTAINED HEREIN. THE CITY OF ALBUQUERQUE SHALL NOT BE  
RESPONSIBLE FOR ANY ERRORS OR OMISSIONS IN THE  
SPECIFICATIONS OR CONSTRUCTION OF ANY APPROVED PLANS  
OR FOR ANY DAMAGE, INJURY OR LOSS OF ANY KIND  
RESULTING FROM THE USE OF ANY SUCH APPROVED PLANS.

LEGEND

- EXISTING CONTOUR
- EXISTING SPOT ELEVATION
- PROPOSED CONTOUR
- PROPOSED SPOT ELEVATION
- PAD GRADE ELEVATION
- FLOW ARROW
- STORM DRAIN
- STORM INLET
- RETAINING WALL
- DRIVEWAY LOCATION DESIGNATED TO AVOID CONFLICT WITH STORM INLETS

SITE KEY

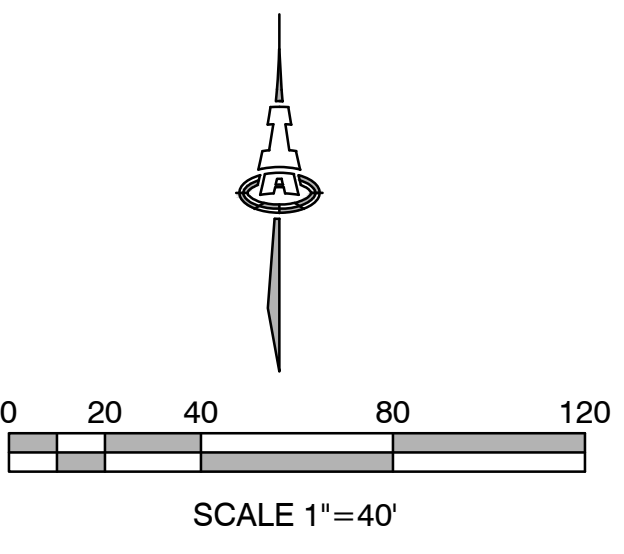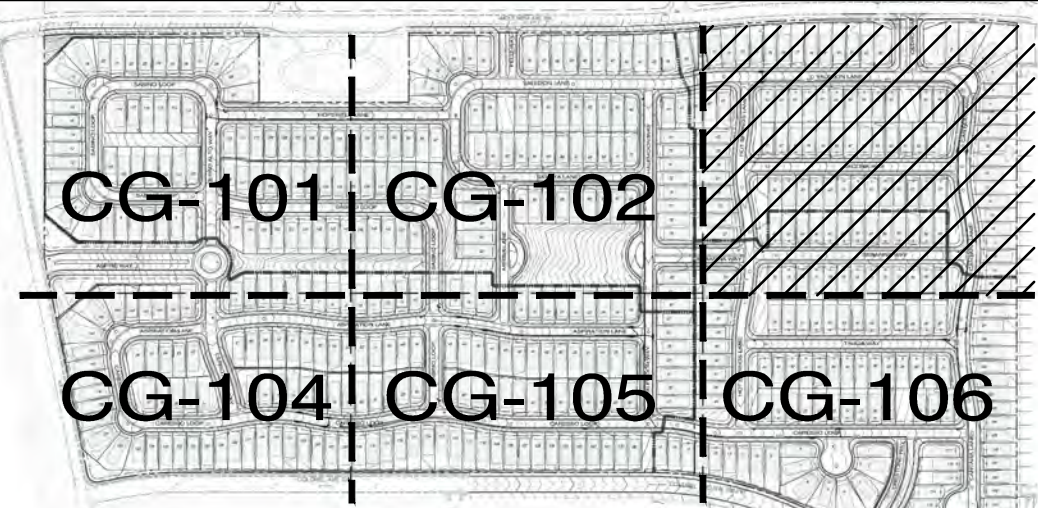

**Isaacson & Arfman, Inc.**  
Civil Engineering Consultants  
128 Monroe Street NE  
Albuquerque, NM 87108  
505-268-8828 | www.iacivil.com

*Professional Engineer*  
NEW MEXICO  
17631  
08/21/20  
12/15/20 Renew  
03/08/22 Renew

| ASPIRE SUBDIVISION         |      |                                             |          |         |
|----------------------------|------|---------------------------------------------|----------|---------|
| UNITS 1-4                  |      |                                             |          |         |
| SUCCESS LAND HOLDINGS, LLC |      |                                             |          |         |
| GRADING & DRAINAGE PLAN 3  |      |                                             |          |         |
| Date:                      | No.  | Revision:                                   | Date:    | Job No. |
| 08/20/20                   | 1    | REVISED LOT GRADES                          | 12/20/20 | 2290    |
| Drawn By:                  | 2    | REVISED RING WALL, PAD, AND COLOREL GRADES: | 03/2022  | CG-103  |
|                            | thor | ADDED 2-FOOT ROUNDOFF ON LOT 18, UNIT 2;    |          |         |
| Ckd By:                    |      | CHANGED TO MOUNTABLE CURB LOTS 18-20.       |          |         |
|                            | ANW  |                                             |          | SH. OF  |

SEE SHEET CG-102

SEE SHEET CG-106

**SURVEYOR'S CERTIFICATION**  
I, KIM C. STELZER, NEW MEXICO PROFESSIONAL SURVEYOR NUMBER 7482, HEREBY CERTIFY THAT THE AS-BUILT INFORMATION SHOWN HEREON IS THE RESULT OF ACTUAL GROUND SURVEY BY ME OR UNDER MY DIRECT SUPERVISION; THAT THIS AS-BUILT SURVEY WAS PERFORMED IN THE MONTH OF JULY; THAT IT MEETS ALL REQUIREMENTS LISTED UNDER THE STANDARD DRAWINGS AND STANDARD SPECIFICATIONS FOR SURVEYING ISSUED BY THE ENGINEER OF RECORD; AND THAT IT IS TRUE AND CORRECT TO THE BEST OF MY KNOWLEDGE AND BELIEF.

*K C Stelzer*  
KIM C. STELZER  
NMPS NO. 7482

7-22-2024  
DATE

W:\PROJECTS\2020\2020-2290\DWG\2290-PLAN-2290-03-10-104.dwg, 3/8/2022, 10:52 AM







1. DRAINAGE EMERGENCY OVERFLOW AT PEDESTRIAN GATE.

## LEGEND

- ## SITE KEY

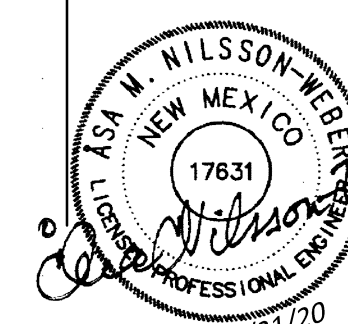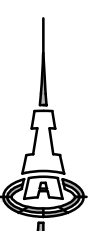

128 Monroe Street NE  
Albuquerque, NM 87108  
5-268-8828 | [www.iacivil.com](http://www.iacivil.com)






This design, calculations, and concepts are owned by and remain the property of Isaacson & Arfman, Inc. and no part thereof shall be utilized by any person, firm or corporation for any purpose whatsoever except with the written permission of Isaacson & Arfman, Inc. ©

SUCCESS LAND HOLDINGS, LLC



## GRADING &amp; DRAINAGE PLAN 6

|                   |     |                                                                                                                                  |         |         |
|-------------------|-----|----------------------------------------------------------------------------------------------------------------------------------|---------|---------|
| Date:             | No. | Revision:                                                                                                                        | Date:   | Job No. |
| 08/2020           | 1   | REVISED LOT GRADES                                                                                                               | 12/2020 | 2290    |
| Drawn By:<br>thor | 2   | REVISED RYING WALL, PAD, AND COLOREL GRADES<br>ADDED 2-FOOT ROUNDOWN ON LOT 18, UNIT 2;<br>CHANGED TO MOUNTABLE CURB LOTS 18-20. | 03/2022 | CG-106  |
|                   |     |                                                                                                                                  |         |         |
| Ckd By:<br>ANW    |     |                                                                                                                                  |         | SH. OF  |




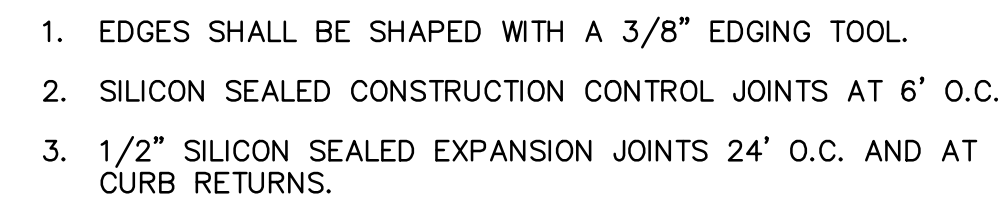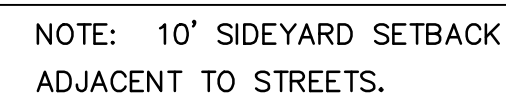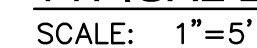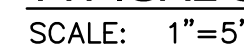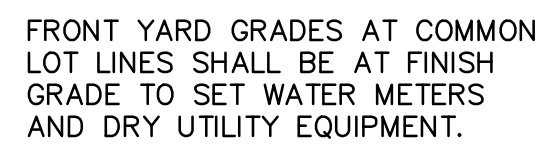

SCALE: N.T.S.

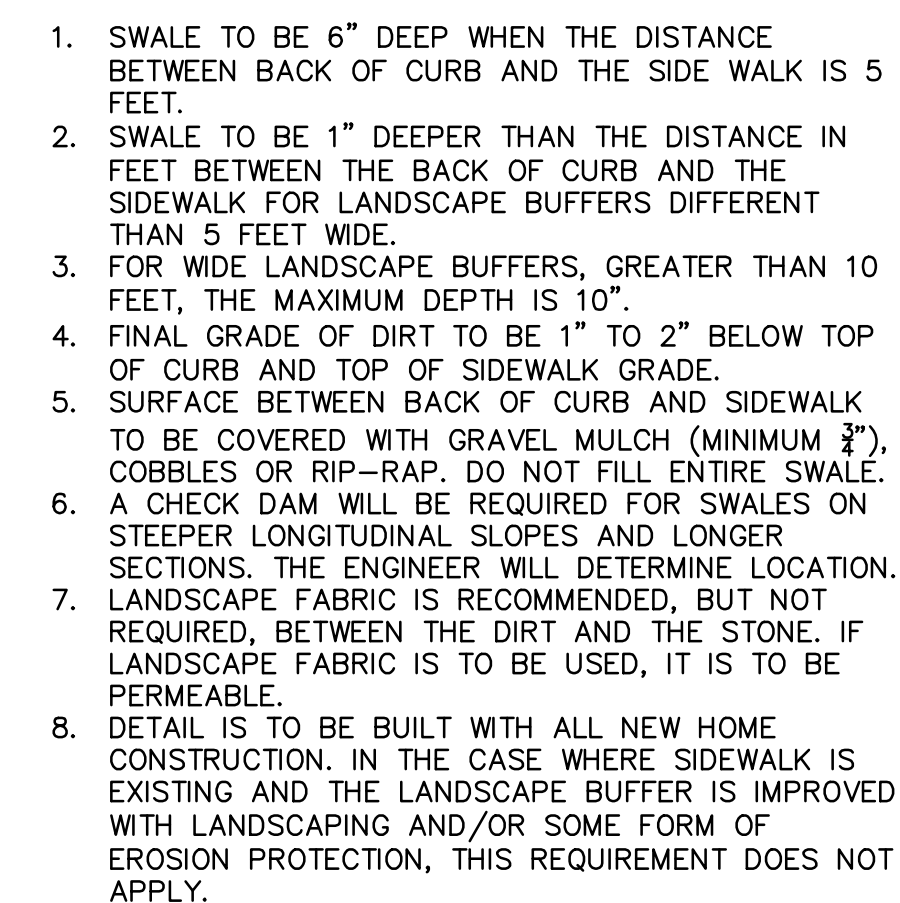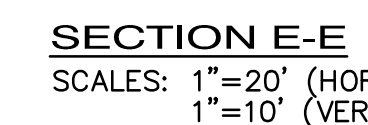

REVISION TO CITY STANDARD DRAWINGS  
2405A & 2405B

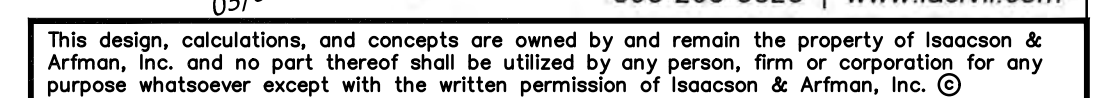


---

SUCCESS LAND HOLDINGS, LLC

## GRADING & DRAINAGE DETAILS

|           |     |                                             |         |         |
|-----------|-----|---------------------------------------------|---------|---------|
| Date:     | No. | Revision:                                   | Date:   | Job No. |
| 08/2020   | 1   | REWSED LOT GRADES                           | 12/2020 | 2290    |
| Drawn By: | 2   | REVISED RING WALL, PAD, AND COLOREL GRADES. | 03/2022 | CG-501  |
| thor      |     | ADDED 2-FOOT RUNDOWN ON LOT 18, UNIT 2.     |         |         |
|           |     | CHANGED TO MOUNTABLE CURB LOTS 18-20.       |         |         |
| Ckd By:   |     |                                             |         | SH. OF  |
| ANW       |     |                                             |         |         |



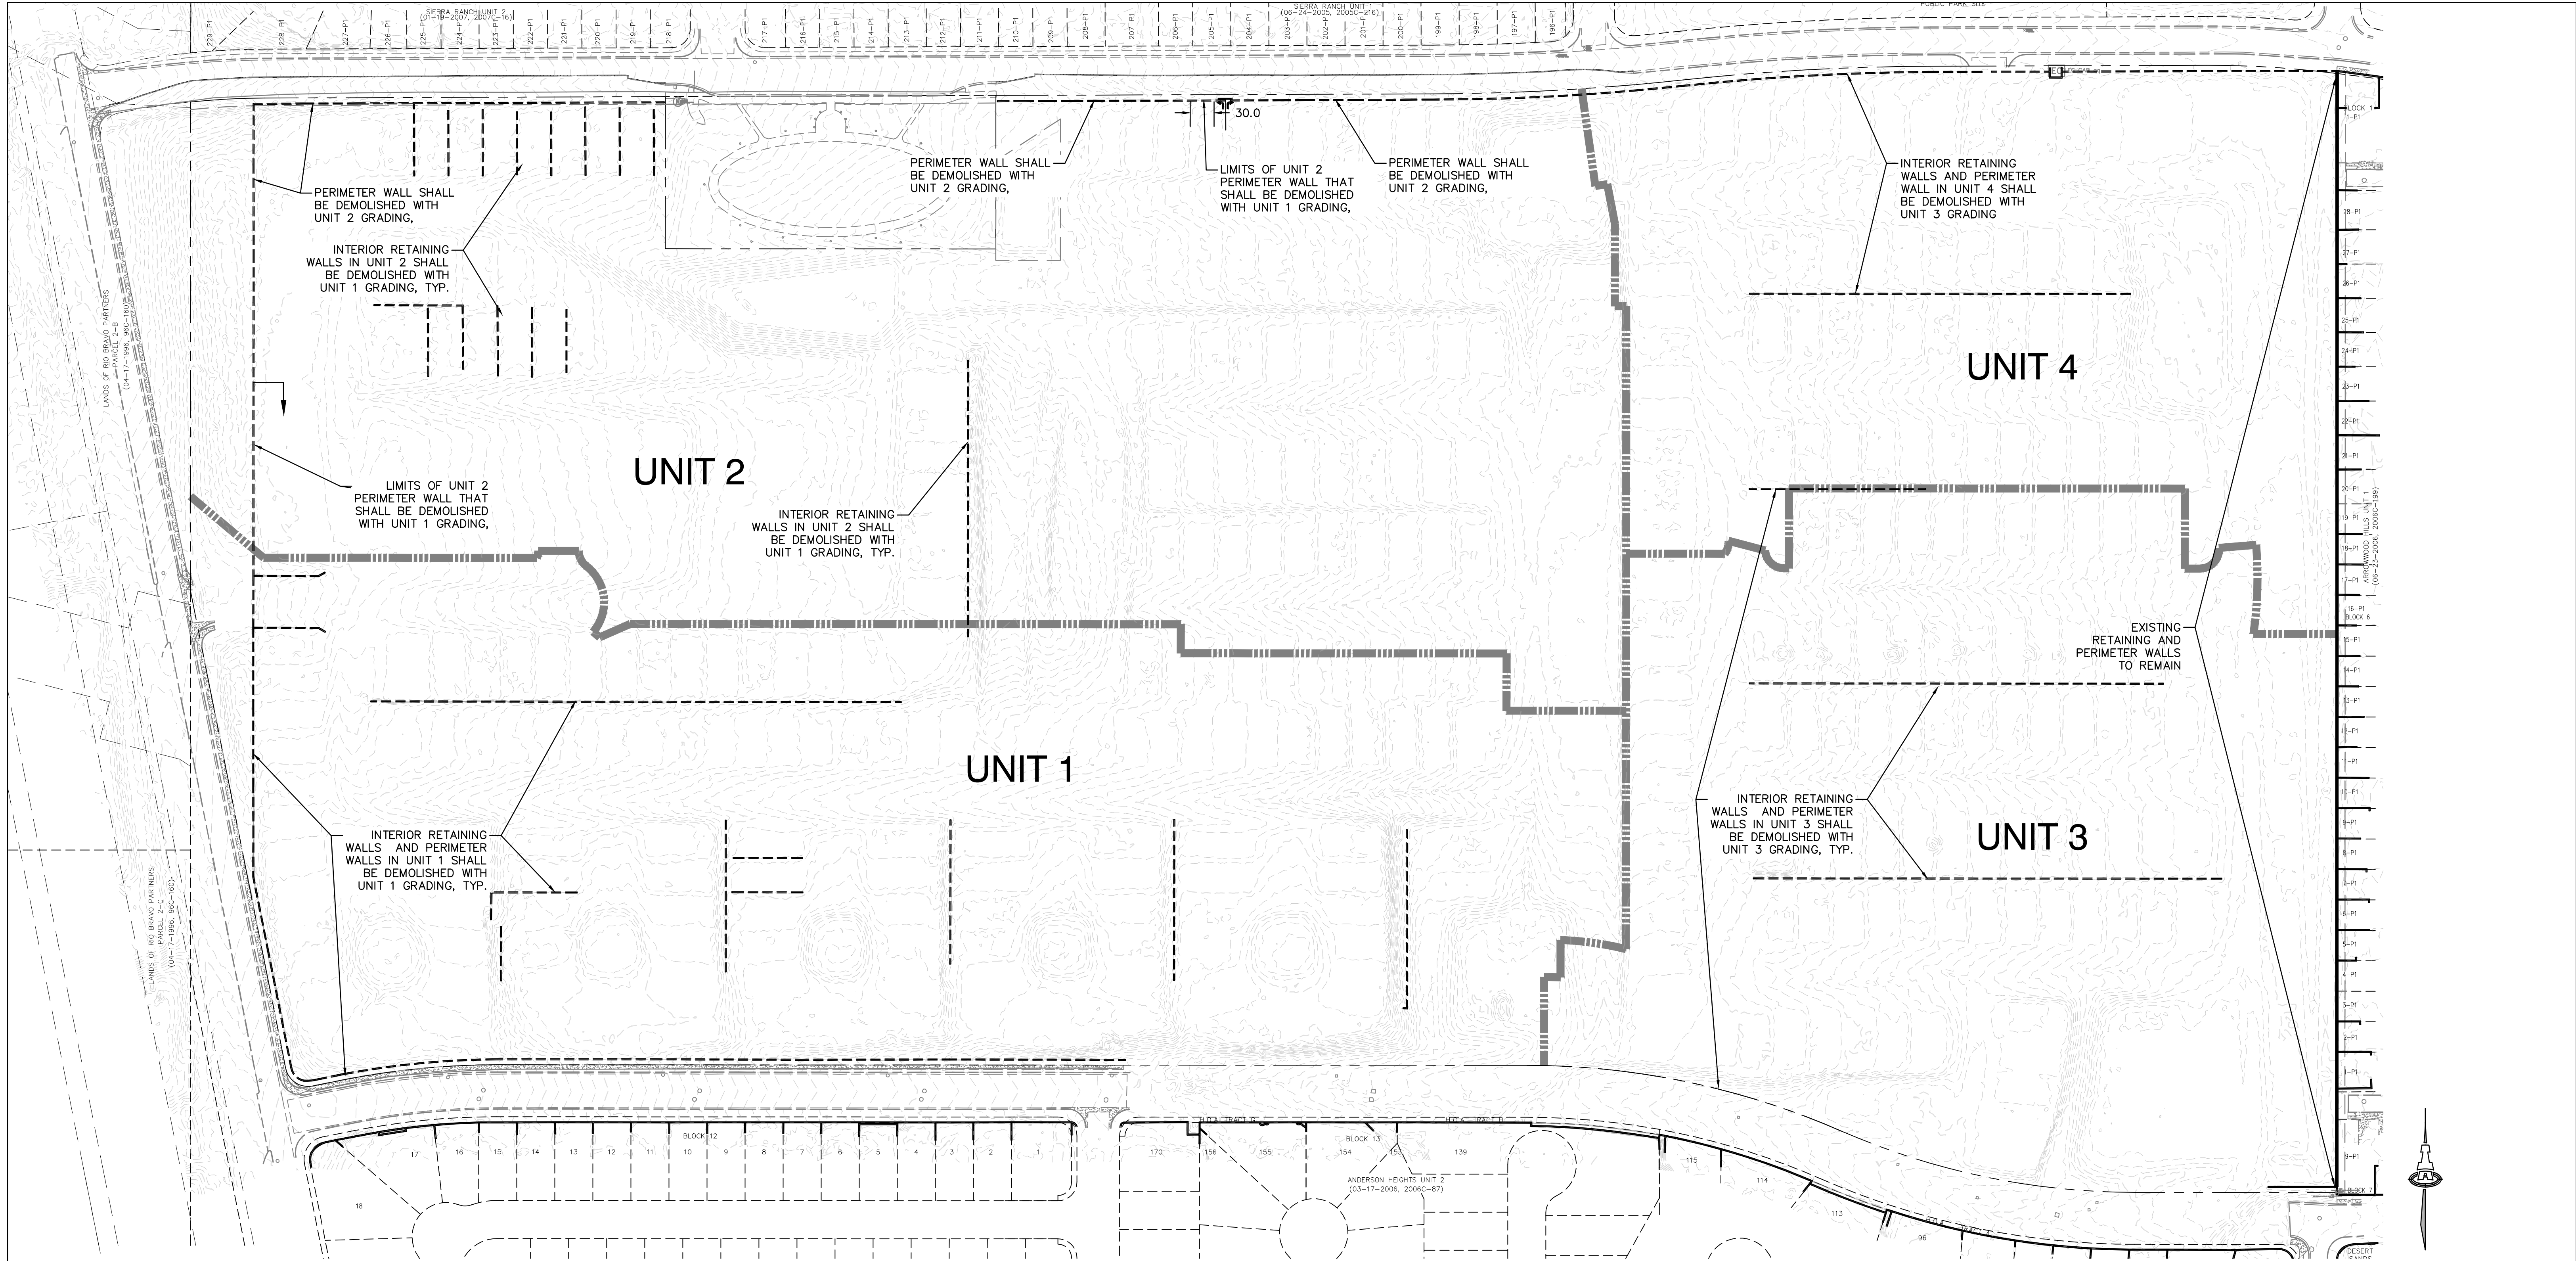

### WALL DEMOLITION NOTES

1. ALL WALLS SHALL BE DEMOLISHED EXCEPT AS NOTED ON PLAN.
2. PATCH & REPAIR EXISTING ADJOINING WALLS TO REMAIN.
3. THE CONTRACTOR SHALL VERIFY ALL CONDITIONS WITHIN THE CONTRACT LIMITS AND NOTIFY THE ENGINEER IN WRITING OF ANY DEVIATION FROM CONTRACT DOCUMENTS NECESSITATED BY FIELD CONDITIONS OR ITEMS NOT COVERED.
4. ALL DEMOLITION SHALL BE PERFORMED IN A SAFE AND ACCEPTABLE MANNER TO ALL AUTHORITIES HAVING JURISDICTION AND THE OWNER.
5. THOROUGHLY CLEAN ADJACENT AREAS OF DEBRIS CAUSED BY DEMOLITION WORK.
6. PRIOR TO ANY DEMOLITION, THE CONTRACTOR SHALL COORDINATE BRACING AND MAINTAIN THE STRUCTURAL INTEGRITY OF THE WALLS TO REMAIN.
7. THE CONTRACTOR SHALL PROVIDE ALL TEMPORARY BRACING, SHORING, SCAFFOLDING, ETC., WHICH ARE NECESSARY TO PREVENT COLLAPSE, SUBSIDENCE, DEFLECTION OR ANY OTHER TYPE OF DAMAGE.
8. CONTRACTOR SHALL REVIEW ALL WALLS TO BE DEMOLISHED WITH OWNER TO IDENTIFY ANY ITEMS TO BE SALVAGED AND DETERMINE SALVAGE LOCATION. UNSALVAGEABLE WALL BLOCKS AND FOOTINGS SHALL BE REMOVED FROM SITE AND LEGALLY DISPOSED.

### LEGEND

- EXISTING WALL TO REMAIN
- - - EXISTING WALL TO BE DEMOLISHED
- ===== UNIT LINE



**Isaacson & Arfman, Inc.**  
Civil Engineering Consultants  
128 Monroe Street NE  
Albuquerque, NM 87108  
505-268-8828 | www.iacivil.com

*Professional Engineer Seal: Robert M. Wilsson, No. 17631, State of New Mexico, expires 03/08/22*

|                                                                                                                                                                                                                                                                             |                                                                               |                     |                  |
|-----------------------------------------------------------------------------------------------------------------------------------------------------------------------------------------------------------------------------------------------------------------------------|-------------------------------------------------------------------------------|---------------------|------------------|
| This design, calculations, and concepts are owned by and remain the property of Isaacson & Arfman, Inc. and no part thereof shall be utilized by any person, firm or corporation for any purpose whatsoever except with the written permission of Isaacson & Arfman, Inc. © |                                                                               |                     |                  |
| ASPIRE SUBDIVISION<br>UNITS 1-4<br>SUCCESS LAND HOLDINGS, LLC                                                                                                                                                                                                               |                                                                               |                     |                  |
| WALL DEMOLITION PLAN                                                                                                                                                                                                                                                        |                                                                               |                     |                  |
| Date: 08/20/2020                                                                                                                                                                                                                                                            | No. 1                                                                         | Revised: 12/20/2020 | Date: 12/20/2020 |
| Drawn By: thor                                                                                                                                                                                                                                                              | 2                                                                             | Revised: 03/03/2022 | Job No. 2290     |
| Chk By: ANW                                                                                                                                                                                                                                                                 | ADDED 2-FOOT RAMP ON LOT 18, UNIT 2;<br>CHANGED TO MOUNTABLE CURB LOTS 18-20. |                     | CG-200           |
|                                                                                                                                                                                                                                                                             |                                                                               |                     | SH. OF           |