
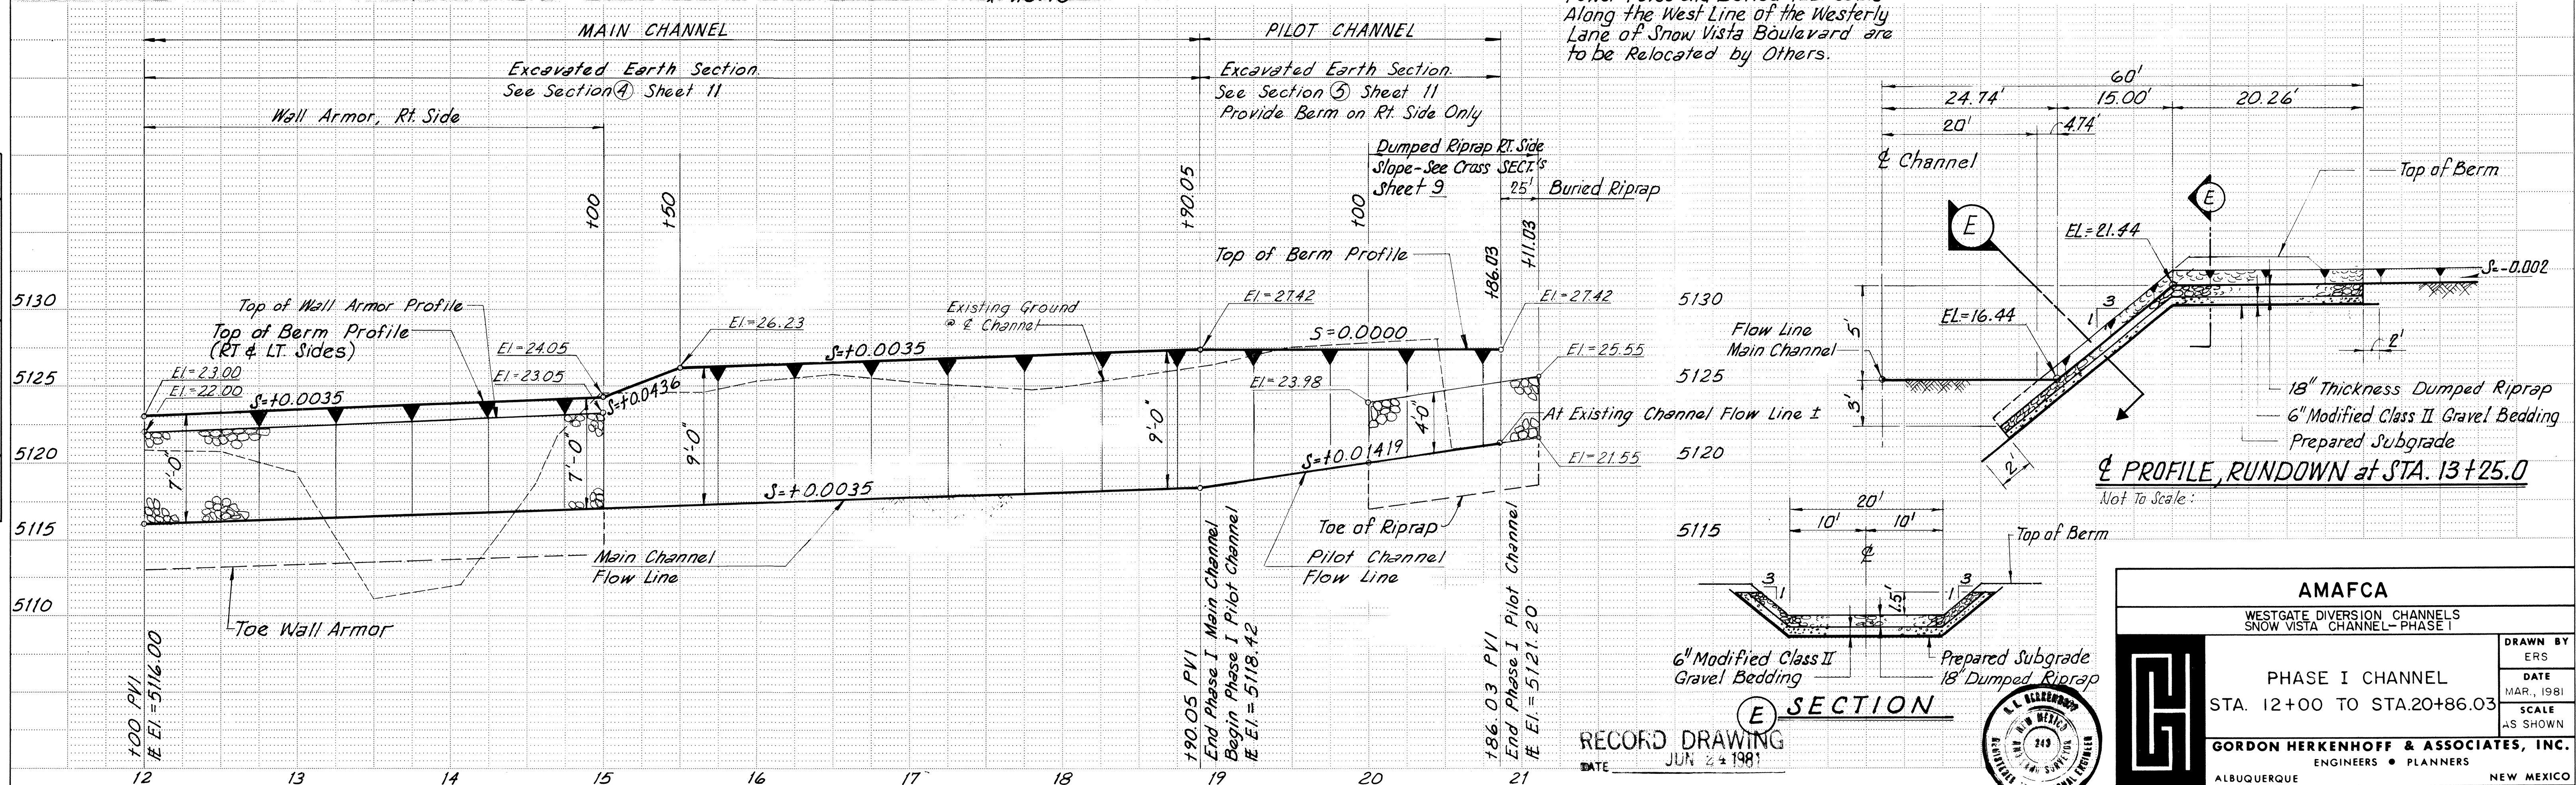


PLAN	DATE	BY	DATE
SURVEYED			
PLOTTED			
NOTED			
NO.			

DESIGNED BY
GORDON HERKENHOFF & ASSOCIATES, INC.
1330 COMMERCE N.E. ALBUQUERQUE, N.M. 87102

PROFILE	DATE	BY	DATE
SURVEYED			
PLOTTED			
NOTED			
NO.			

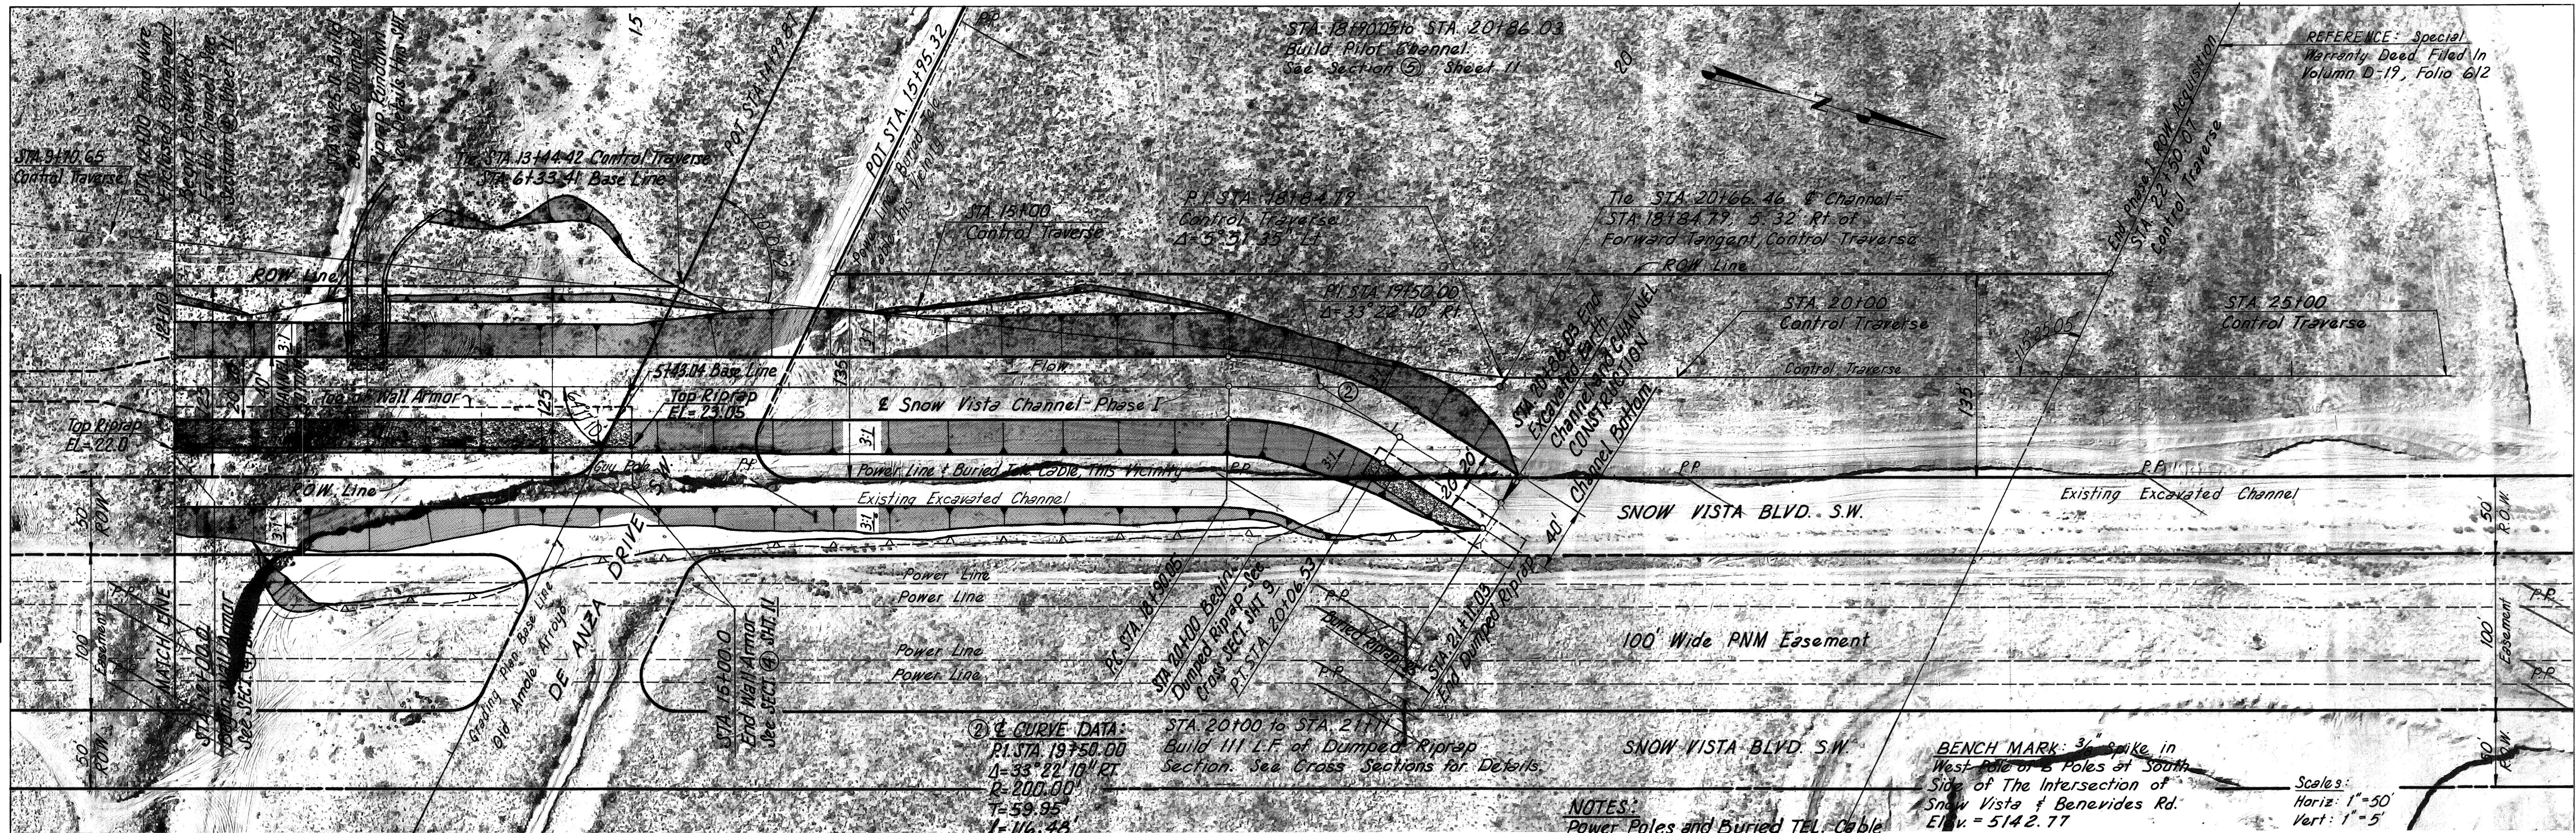

AMAFCA	
WESTGATE DIVERSION CHANNELS SNOW VISTA CHANNEL - PHASE I	
	PHASE I CHANNEL STA. 12+00 TO STA. 20+86.03 GORDON HERKENHOFF & ASSOCIATES, INC. ALBUQUERQUE ENGINEERS • PLANNERS NEW MEXICO
DRAWN BY ERS DATE MAR., 1981 SCALE AS SHOWN	RECORD DRAWING JUN 24 1981