





D3

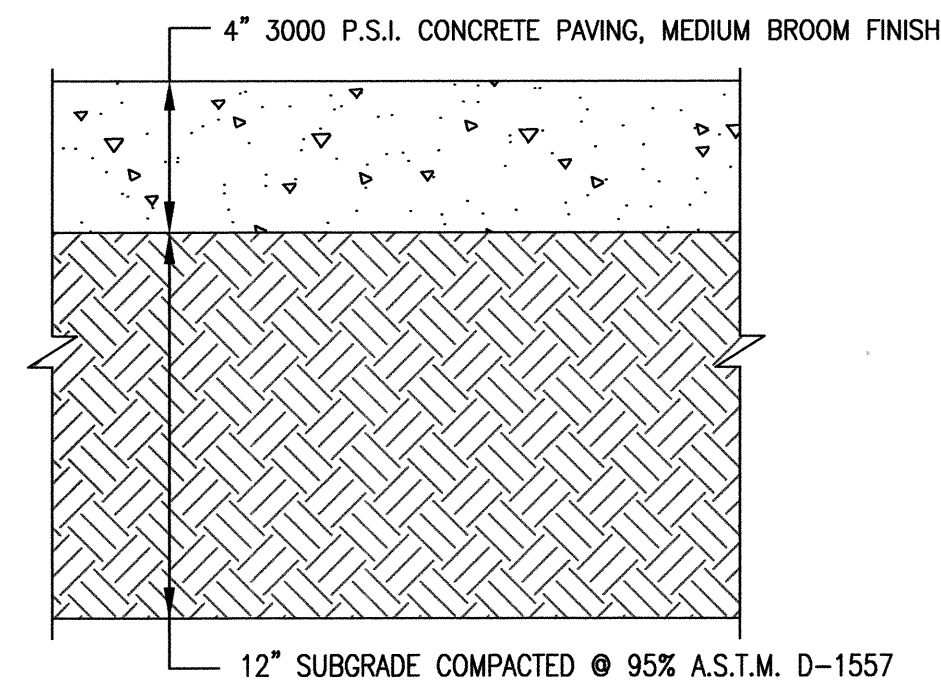


D4

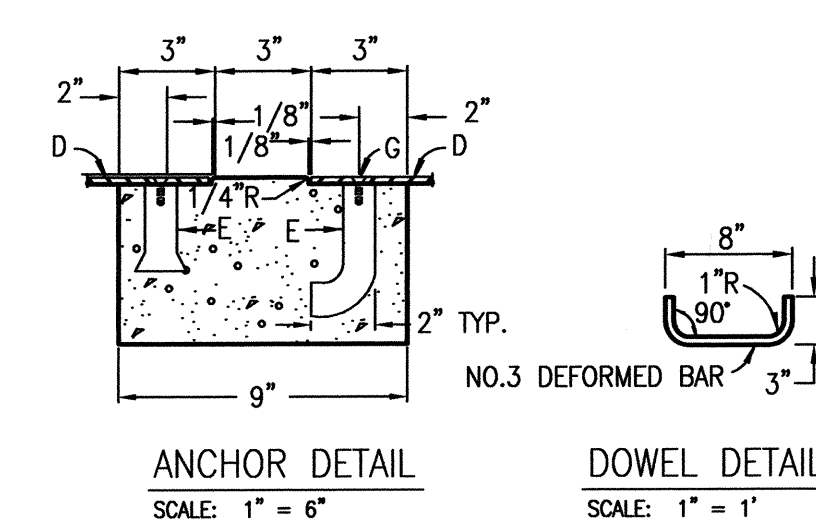


(D6)

D1

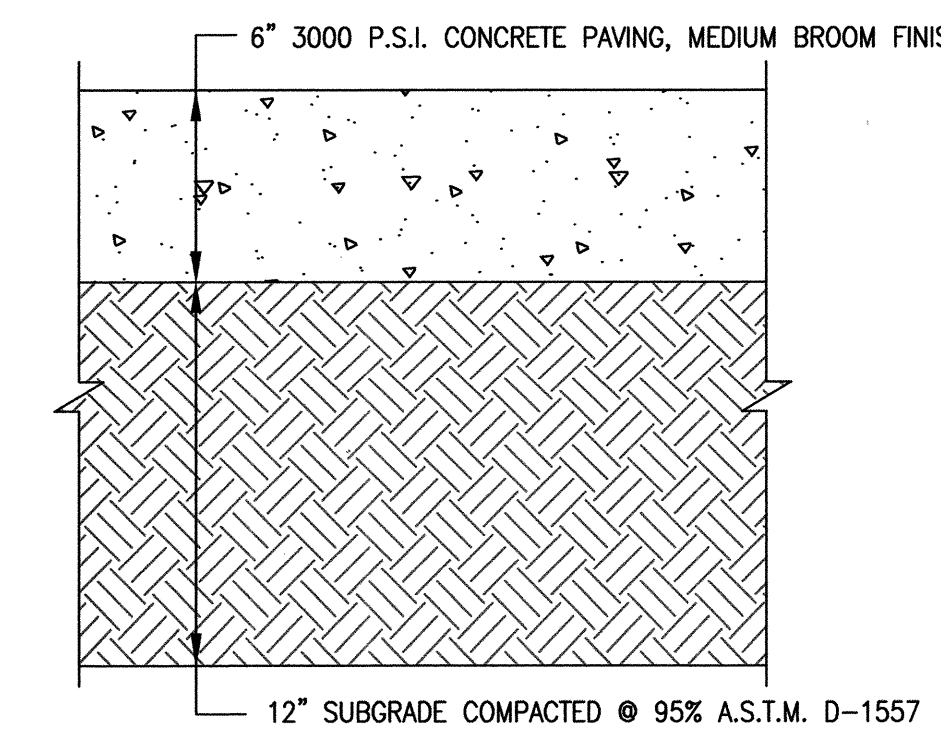

(C3)

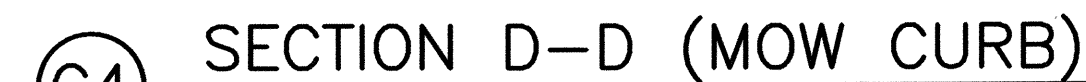

(C4)



(B3)



NOTE: USE THIS SECTION FOR CASES WHERE PAVING SLOPES AWAY FROM FACE OF CURB



A1



(B4)



(A6)

A6

2

