



C1 TYPICAL PERIMETER (HEADER) CURB AT BUILDING SECTION
SCALE: 1" = 0'-6"

KEYED NOTES

- ① TOP OF CURB AT OR JUST BELOW FINISHED FLOOR ELEVATION
- ② NEW 3" ASPHALTIC CONCRETE PAVING PER TYPICAL SECTION
- ③ CONSTRUCT 3000 PSI CONCRETE HEADER CURB
- ④ 12" SUBGRADE COMPACTED @ 95% ASTM D-1557 (TYPICAL)
- ⑤ INSTALL 2"x4" WOOD BLOCKING (TREATED)
- ⑥ INSTALL 5/8" (MIN.) CEMENT BOARD AS "LEAVE IN-PLACE" FORM
- ⑦ FINISHED FLOOR ELEVATION
- ⑧ STEEL BEAM, W-16x40 (EXISTING)
- ⑨ STEEL BAR JOIST (EXISTING)
- ⑩ SILL FLASHING (EXISTING)
- ⑪ WOOD BLOCKING (EXISTING)
- ⑫ STEEL ANGLE, 4"x3"x3/8" LONG, WELDED TO W16x40 WITH ONE 3/8" DIA. BOLT (EXISTING)
- ⑬ SET TOP OF CURB NOT MORE THAN 3/8" BELOW TOP OF BEVELED THRESHOLD FOR ADA COMPLIANCE
- ⑭ EXISTING THRESHOLD
- ⑮ EXISTING DOOR

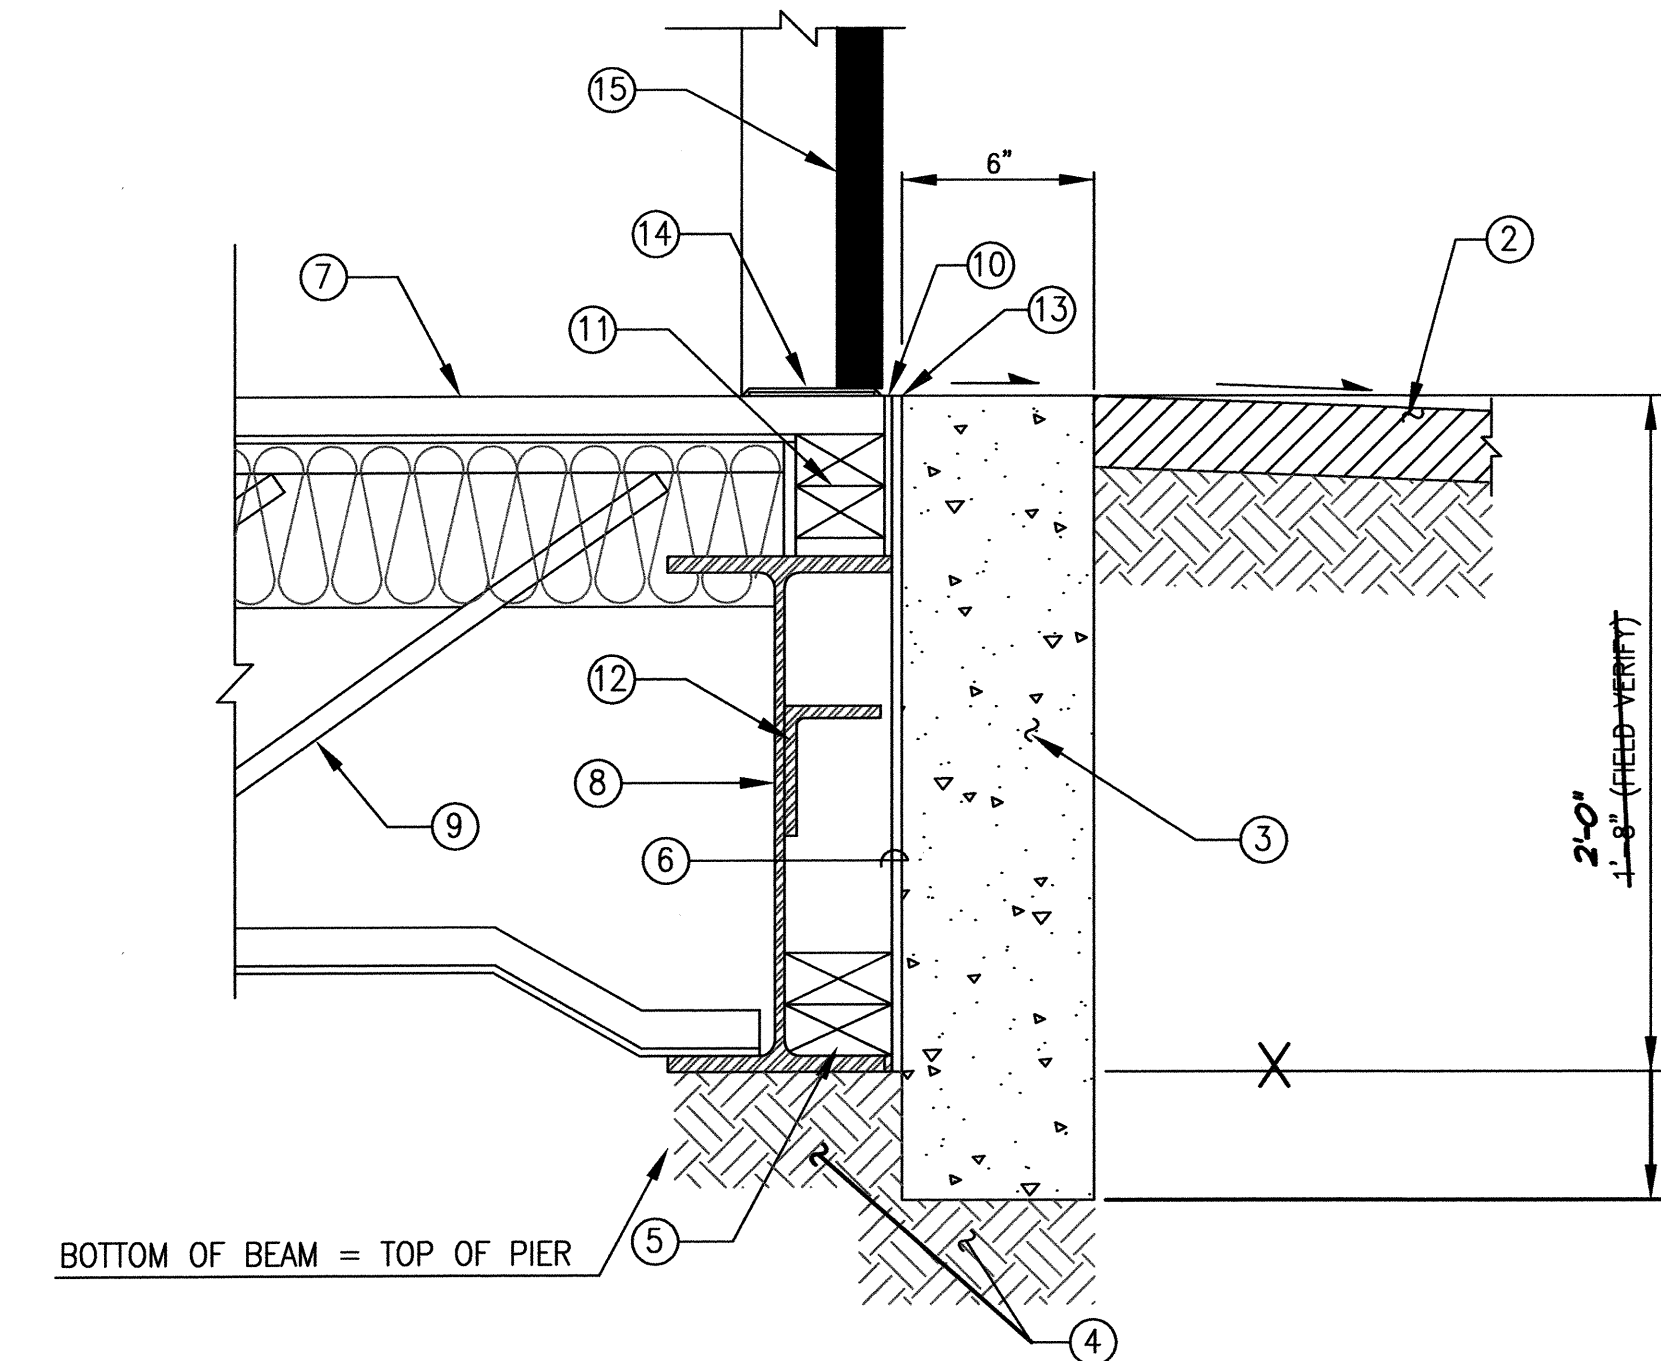

C5 TYPICAL PERIMETER (HEADER) CURB AT DOORWAY SECTION
SCALE: 1" = 0'-6"

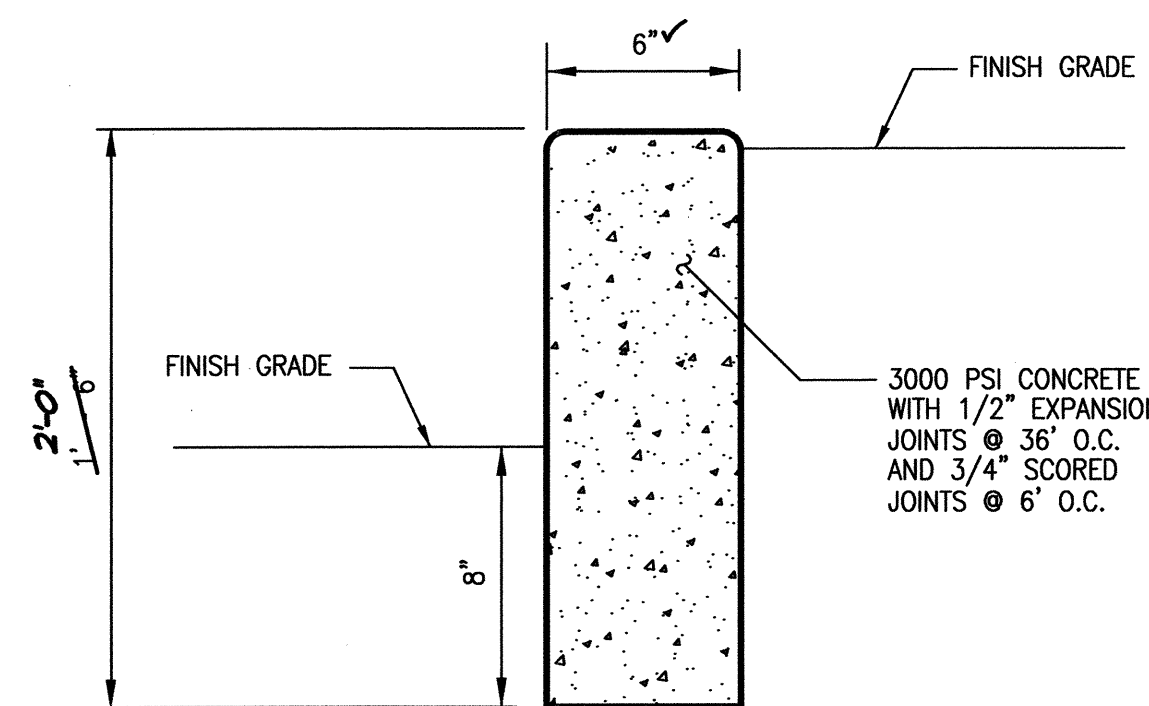


B1 HEADER CURB
SCALE: 1" = 0'-6"

RECORD DRAWING LEGEND

CONSTRUCT	RECORD INFORMATION (VERIFIED BY ENGINEER)
✓	AS-CONSTRUCTED = AS-DESIGNED (VERIFIED BY ENGINEER)
38' 42"	RECORD INFORMATION (VERIFIED BY ENGINEER)
+25.2	RECORD INFORMATION (VERIFIED BY ENGINEER)
28.98' 42"	RECORD INFORMATION (VERIFIED BY ENGINEER)
✓	AS-CONSTRUCTED = AS-DESIGNED (VERIFIED BY AS-BUILT SURVEY)
32' 31.8	RECORD INFORMATION FROM AS-BUILT SURVEY
+26.9	RECORD INFORMATION FROM AS-BUILT SURVEY
31.25' 22"	RECORD INFORMATION FROM AS-BUILT SURVEY

RECORD DRAWING
FOR CERTIFICATION, SEE SHEET 1

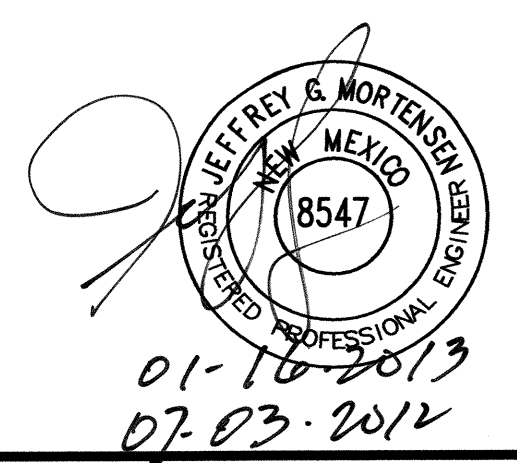

01-10-2013
07-03-2012

HIGH MESA Consulting Group

4010-B MIDWAY PARK BLVD. NE • ALBUQUERQUE, NEW MEXICO 87109
PHONE: 505.345.4250 • FAX: 505.345.4254 • www.highmesacg.com

HEADER CURB SECTIONS
PORTABLE CLASSROOM INSTALLATIONS-PHASE 2
RUDOLFO ANAYA ELEMENTARY SCHOOL
2800 VERMEJO PARK DRIVE SW

DESIGNED BY	NO.	DATE	BY	REVISIONS	JOB NO.
J.G.M.	10-12	B.E.E.	RECORD DRAWING AND CERTIFICATION		2011.183.8
DRAWN BY					DATE
J.Y.R.					06-2012
APPROVED BY					SHEET
J.G.M.					6 OF 11