



(C1) TYPICAL WATER VALVE BOX COLLAR DETAIL

SCALE: 1" = 1'

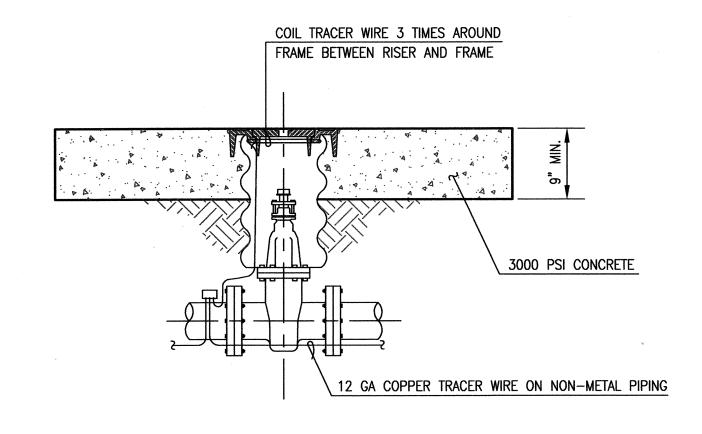


(A1) TYPICAL WATER VALVE BOX SECTION

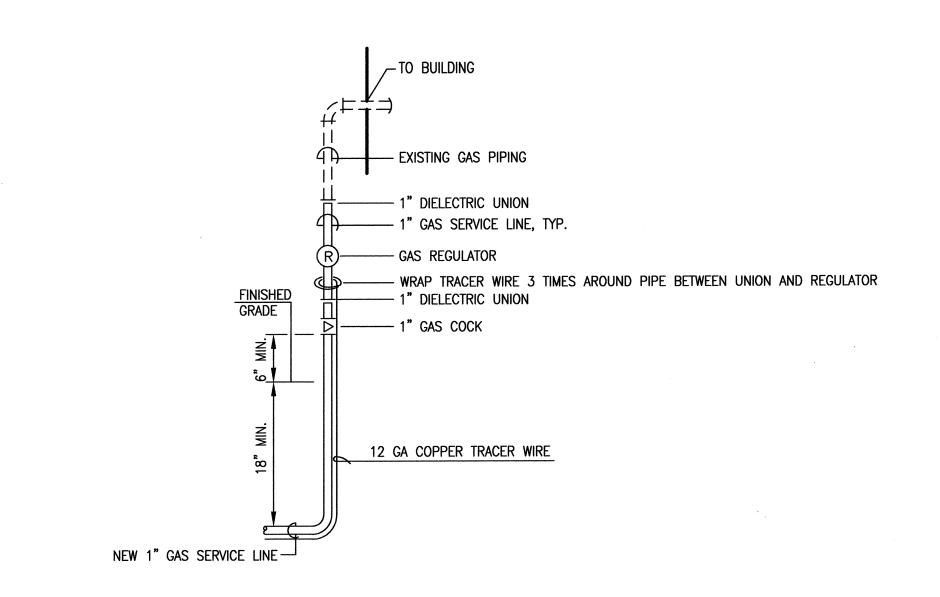

TYPICAL GAS SERVICE CONNECTION


SCALE: 1" = 1'

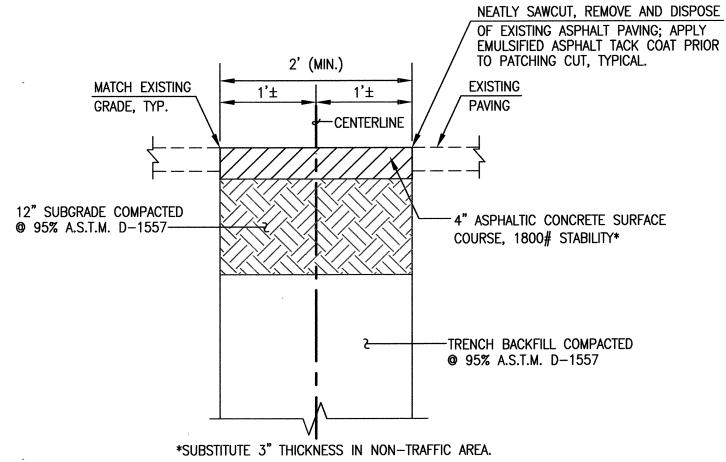

TYPICAL PRIVATE PAVING UTILITY CUT


AND PAVEMENT REPLACEMENT SECTION

SCALE: 1" = 1'

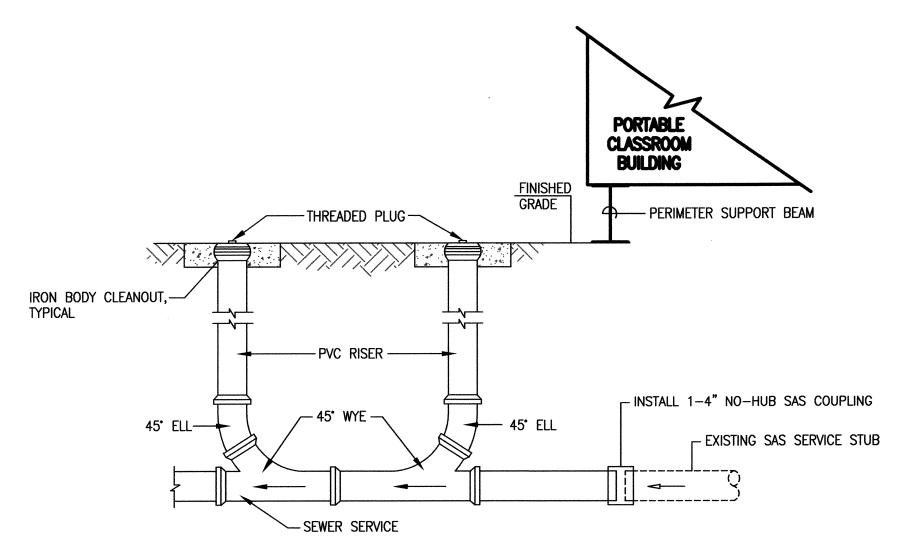


TYPICAL DOUBLE CLEANOUT AND PORTABLE CONNECTION SECTION

NOT TO SCALE

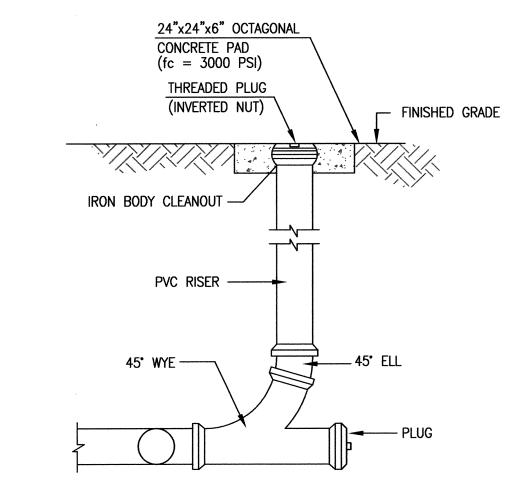


(C5) TYPICAL SINGLE CLEANOUT SECTION

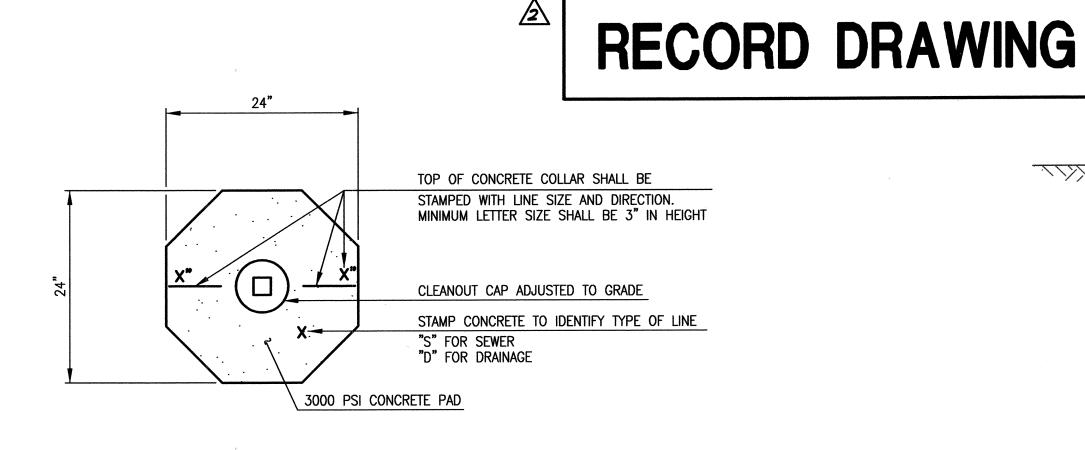

TYPICAL CLEANOUT COLLAR DETAIL

SCALE: 1" = 1"

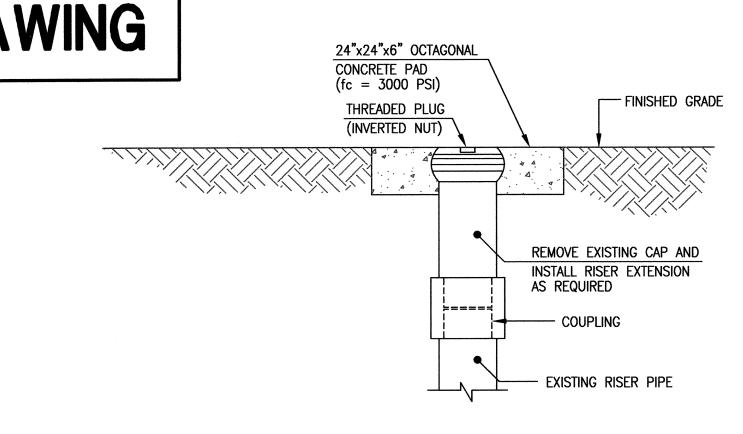

TYPICAL SINGLE CLEANOUT ADJUSTMENT SECTION

NOT TO SCALE

NOTE: ALL UNDERGROUND PIPING SHALL BE INSTALLED WITH CAUTION TAPE



PORTABLE CLASSROOM UTILITY CONNECTION DETAILS
PORTABLE CLASSROOM INSTALLATIONS-PHASE 2
RUDOLFO ANAYA ELEMENTARY SCHOOL
2800 VERMEJO PARK DRIVE SW

Path: P:\DATA\2011.183.8\ENG\R2\ | Plot Date: | 12-07-2012 Name: 111838_SH10_R2.DWG | Plot Time: | 11:36 am