


MB(3)

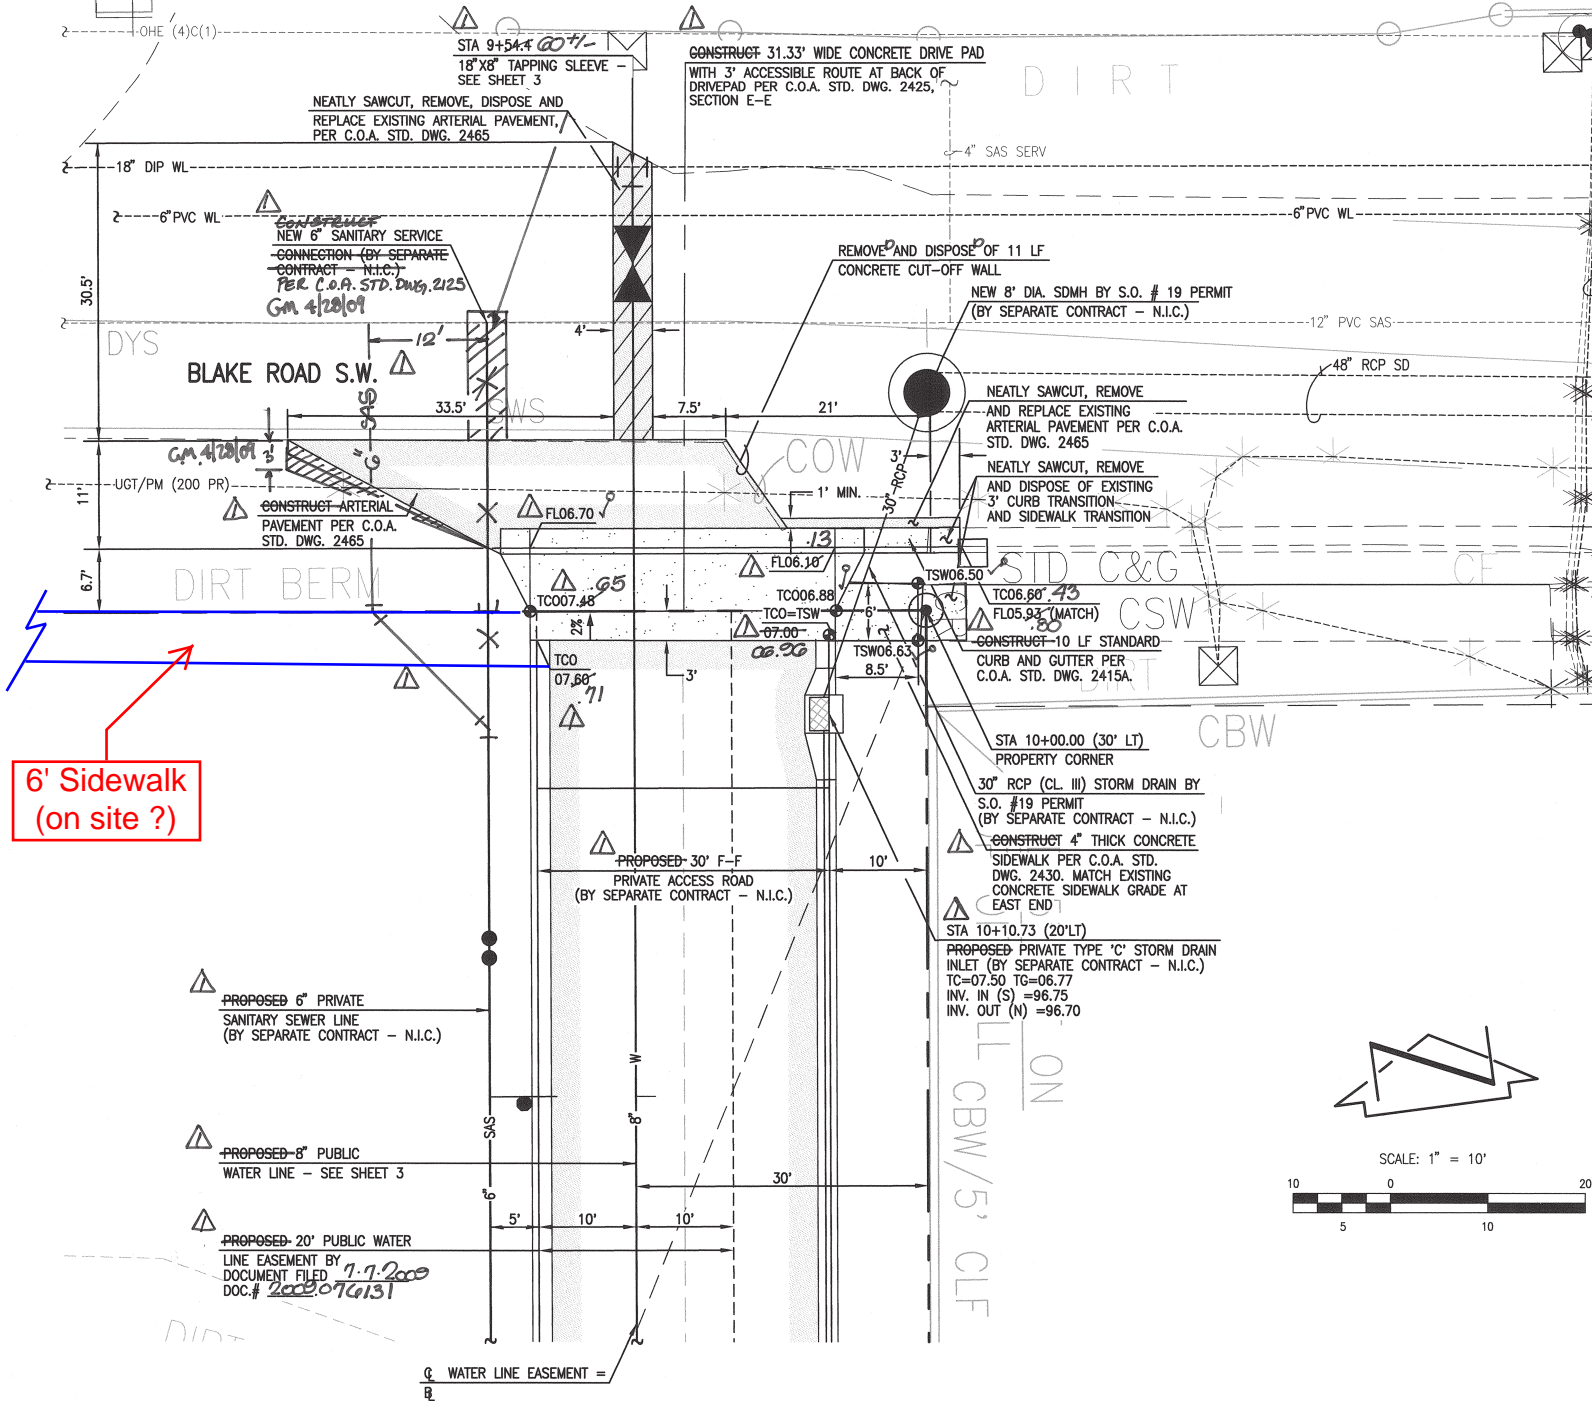

6' Sidewalk
(on site ?)

PUBLIC IMPROVEMENTS DETAIL

SCALE: 1" = 10'

1

3

SCALE: 1" = 10'

