



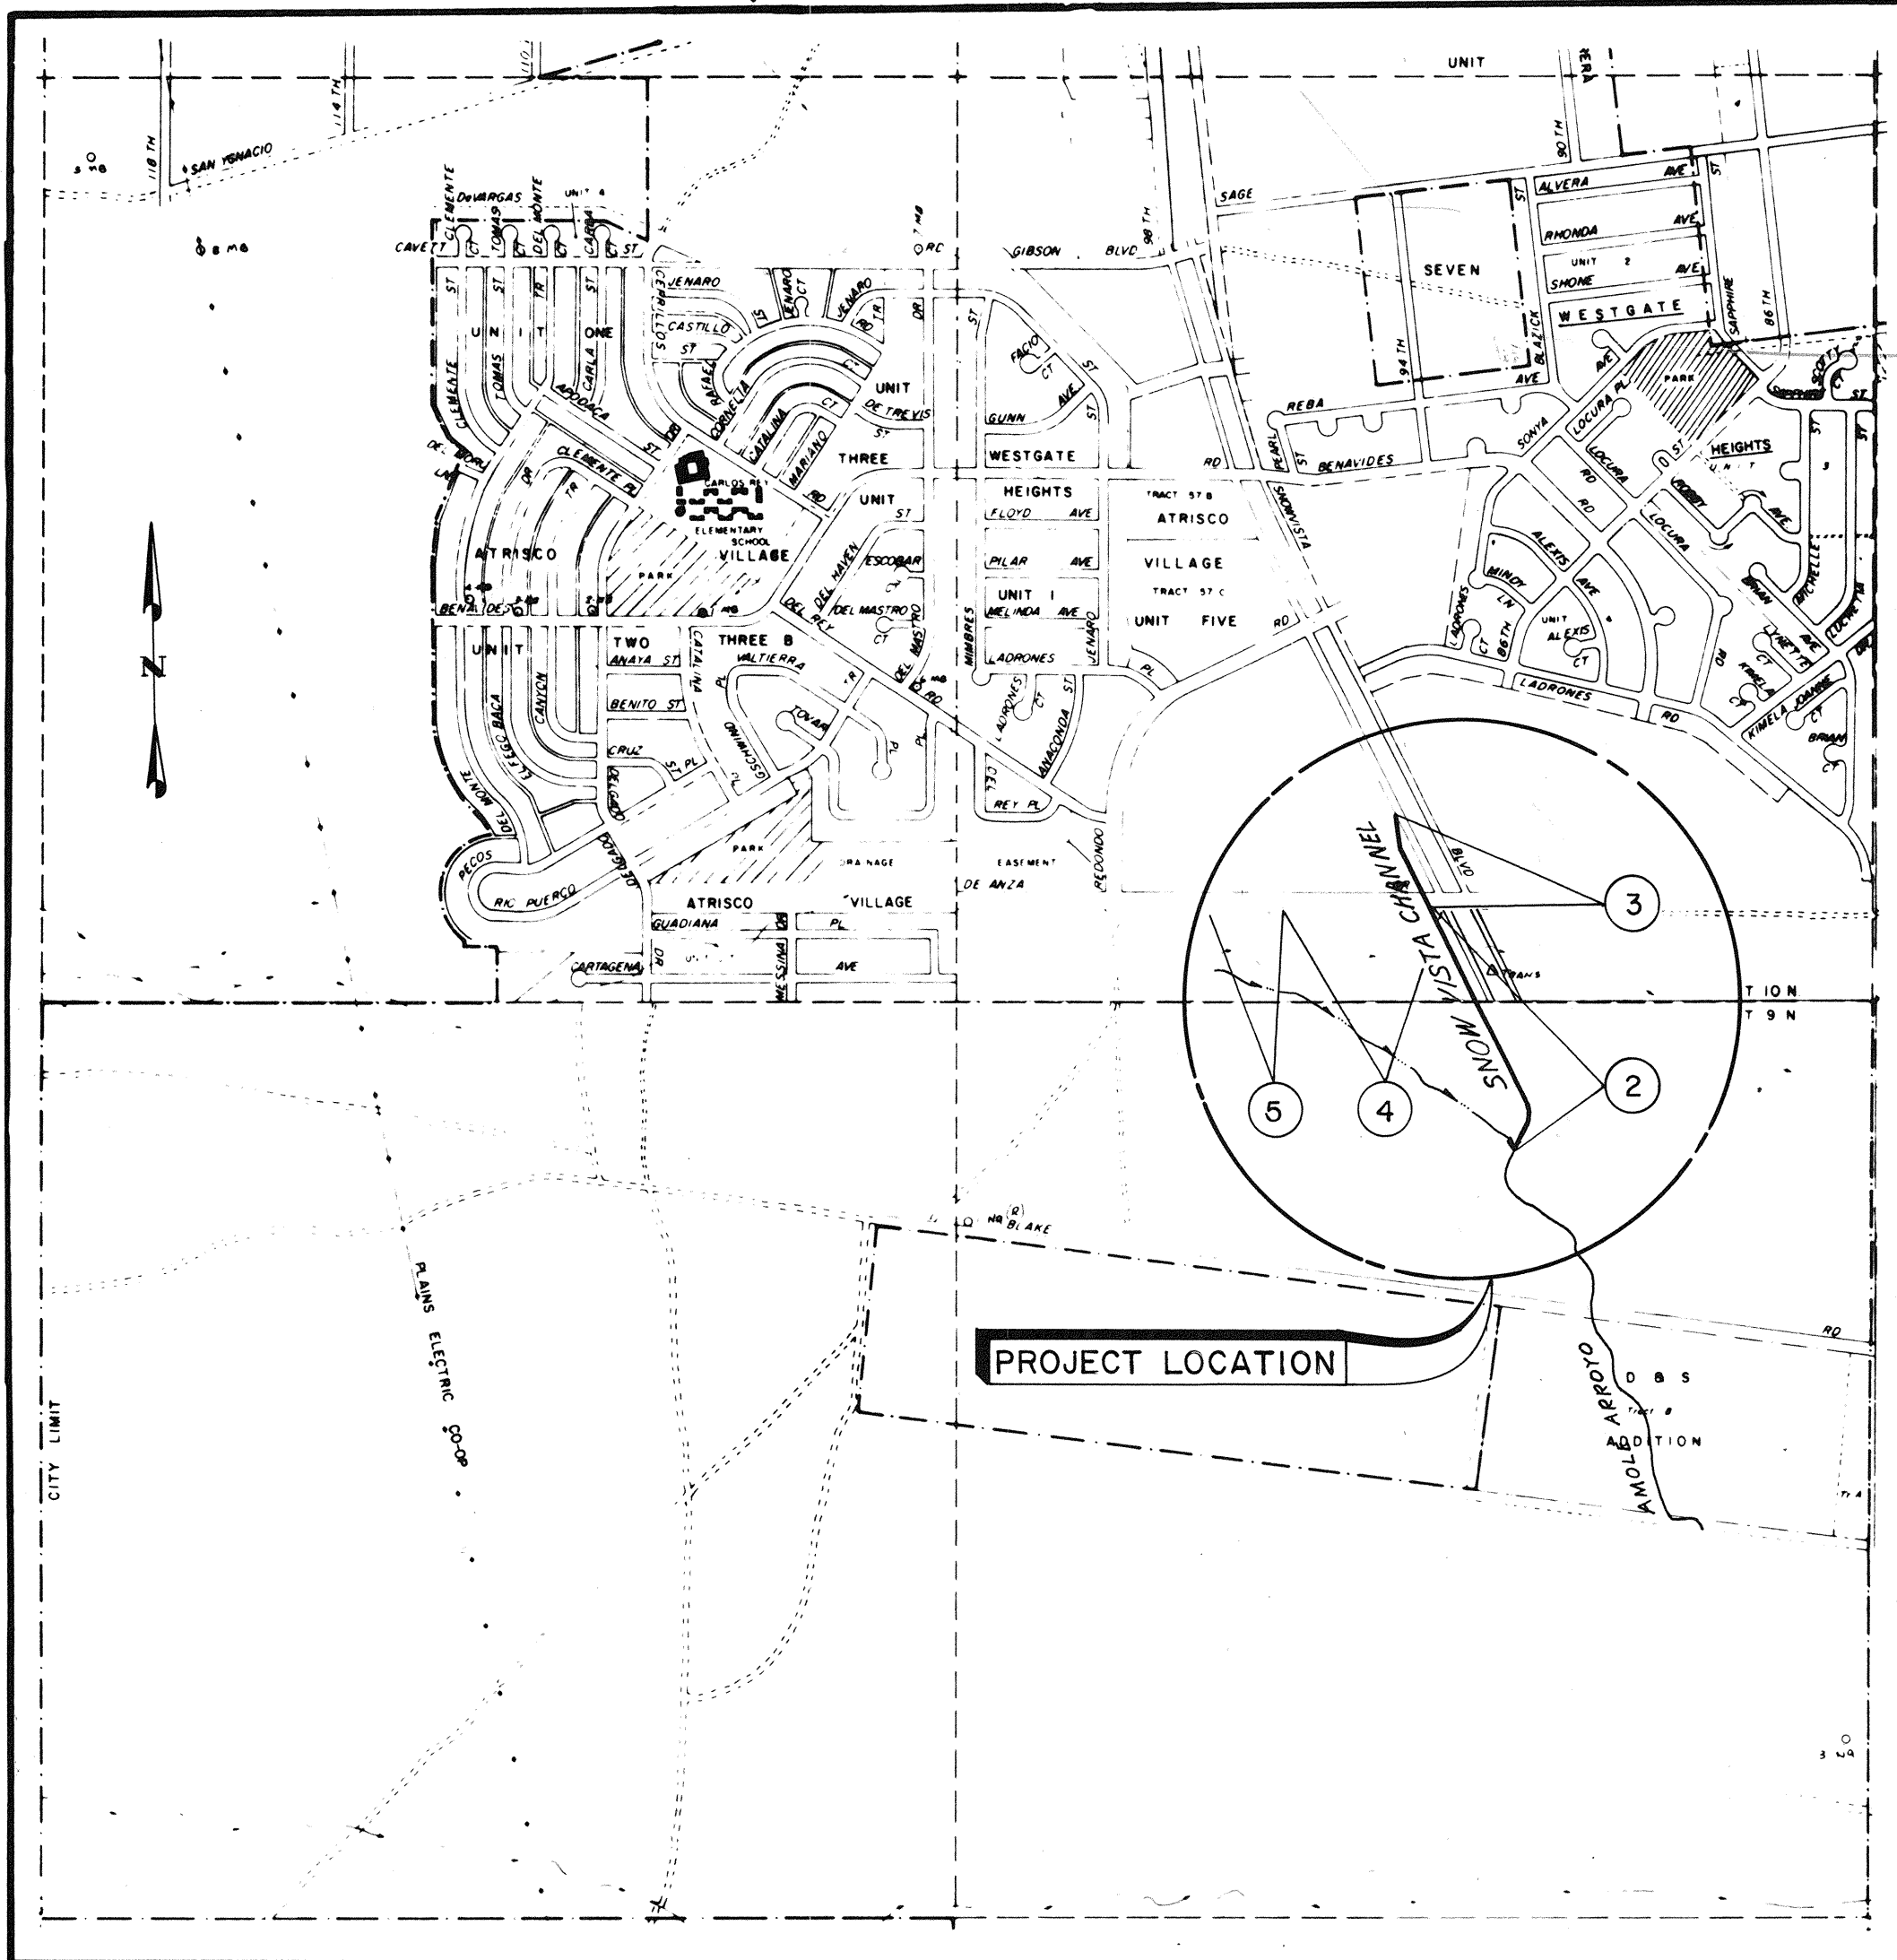

LOCATION MAP
SCALE 1"=1000'

SHEET	TITLE
1 OF II	TITLE SHEET, LOCATION MAP, INDEX OF DRAWINGS
2 OF II	PHASE I CHANNEL STA. 0+00 TO STA. 12+00
3 OF II	PHASE I CHANNEL STA. 12+00 TO STA. 20+86.03
4 OF II	GRADING PLAN-OLD AMOLE ARROYO STA. 9+00 TO STA. 15+00
5 OF II	GRADING PLAN-OLD AMOLE ARROYO STA. 15+00 TO STA. 17+00
6 OF II	CHANNEL CROSS SECTIONS STA. 0+00 TO STA. 7+00
7 OF II	CHANNEL CROSS SECTIONS STA. 8+00 TO STA. 13+00
8 OF II	CHANNEL CROSS SECTIONS STA. 13+50 TO STA. 15+65
9 OF II	CHANNEL CROSS SECTIONS STA. 16+00 TO STA. 20+86.03
10 OF II	OLD AMOLE ARROYO CROSS SECTIONS STA. 12+00 TO STA. 17+35
11 OF II	TYPICAL CHANNEL SECTIONS

ALBUQUERQUE METROPOLITAN ARROYO FLOOD CONTROL AUTHORITY WESTGATE DIVERSION CHANNELS SNOW VISTA CHANNEL - PHASE I

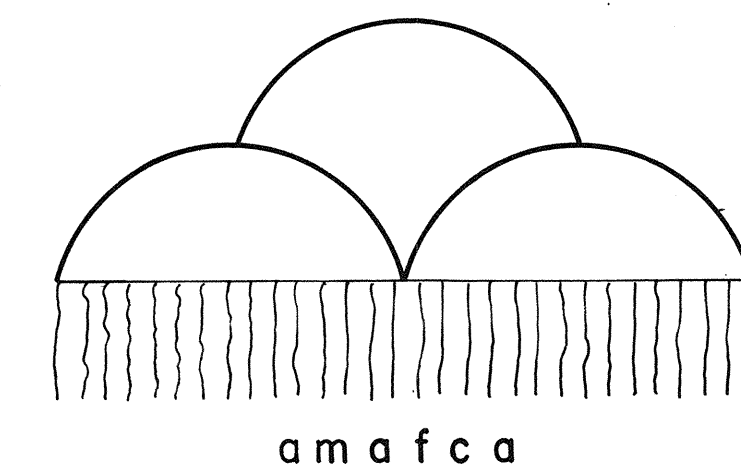


PROJECT LOCATION: ALBUQUERQUE, NEW MEXICO

GORDON HERKENHOFF & ASSOCIATES, INC.

302 Eighth Street, N.W.
Albuquerque, New Mexico 87102
(505) 247-0294

JOB NO. 1787.10

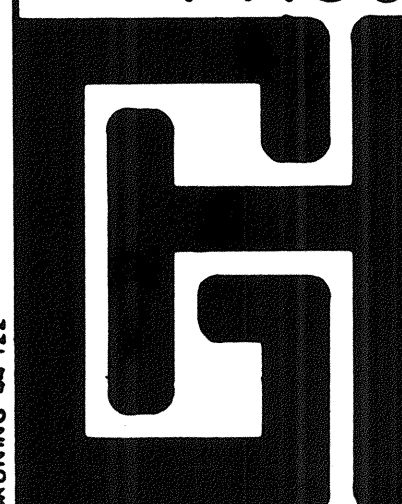

RECORD DRAWING
DATE JUN 24 1981



SHEET 1 OF 11

MARCH, 1981