

PLAN	NO.	DATE
SURVEYED		
PLOTTED		
ALIGNMENT CHECKED		
RT. OF WAY CLEARED		

PHOTO REPRODUCTION BY
 KOOGLE & POULS ENGINEERING
 8334 COMANCHE N.E., ALBUQUERQUE, N.M. 87110


PROFILE	NO.	DATE
SURVEYED		
GRADES CHECKED		
B.M. NOTED		
STRUCTURE NOTATIONS CHK'D		



SMH #1
 42' Rt of STA 21+01
 W Rim EL = 5160.39
 N INV EL = 5151.27
 W INV EL = 5151.52

SMH #2
 42' Rt of STA 22+496
 E Rim EL = 5165.24
 E INV EL = 5152.69
 W INV EL = 5152.78

Scales:
 Horiz: 1" = 50'
 Vert: 1" = 5'

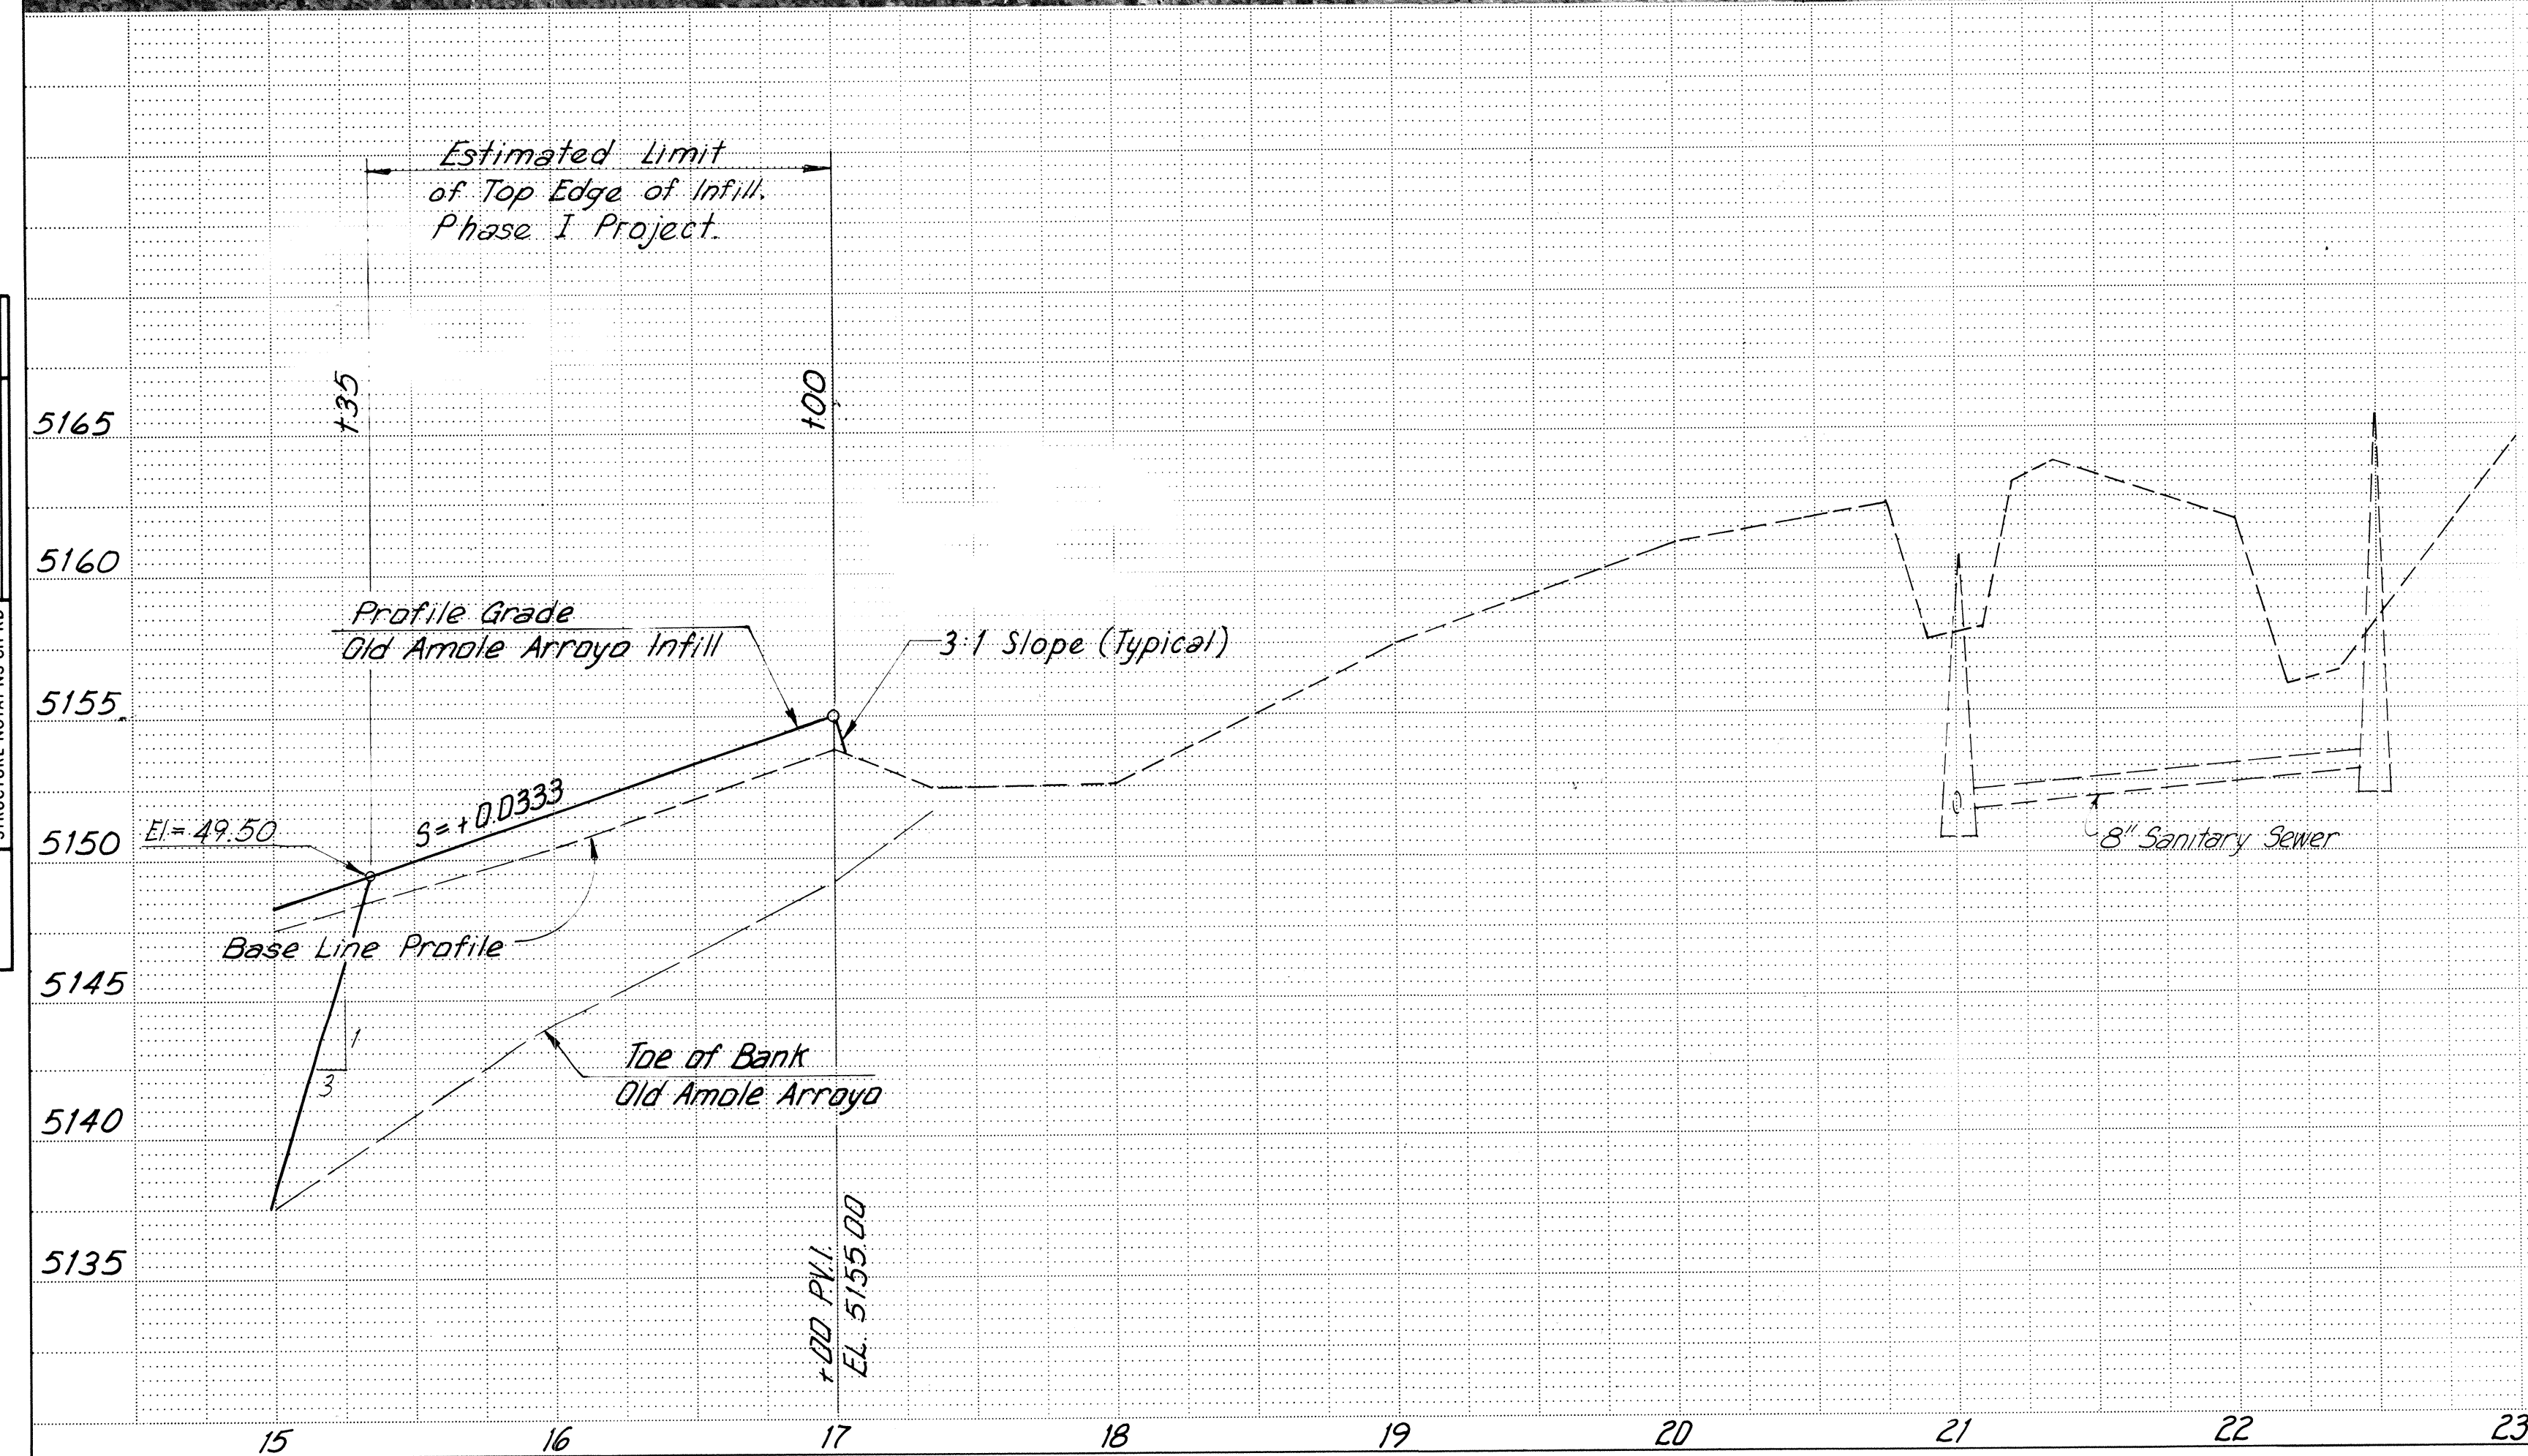

RECORD DRAWING
 DATE JUN 24 1981

AMAFCA	
WESTGATE DIVERSION CHANNELS SNOW VISTA CHANNEL - PHASE I	
	GRADING PLAN OLD AMOLE ARROYO
	STA. 15+00 TO STA. 17+00
	GORDON HERKENHOFF & ASSOCIATES, INC. ENGINEERS • PLANNERS
	ALBUQUERQUE NEW MEXICO
DRAWN BY DDL	DATE MAR, 1981
SCALE AS SHOWN	