



SURVEYED		BY		DATE	
PLOTTED					
TEMPLATE					
AREAS					
AREAS CHECKED					
NO.					

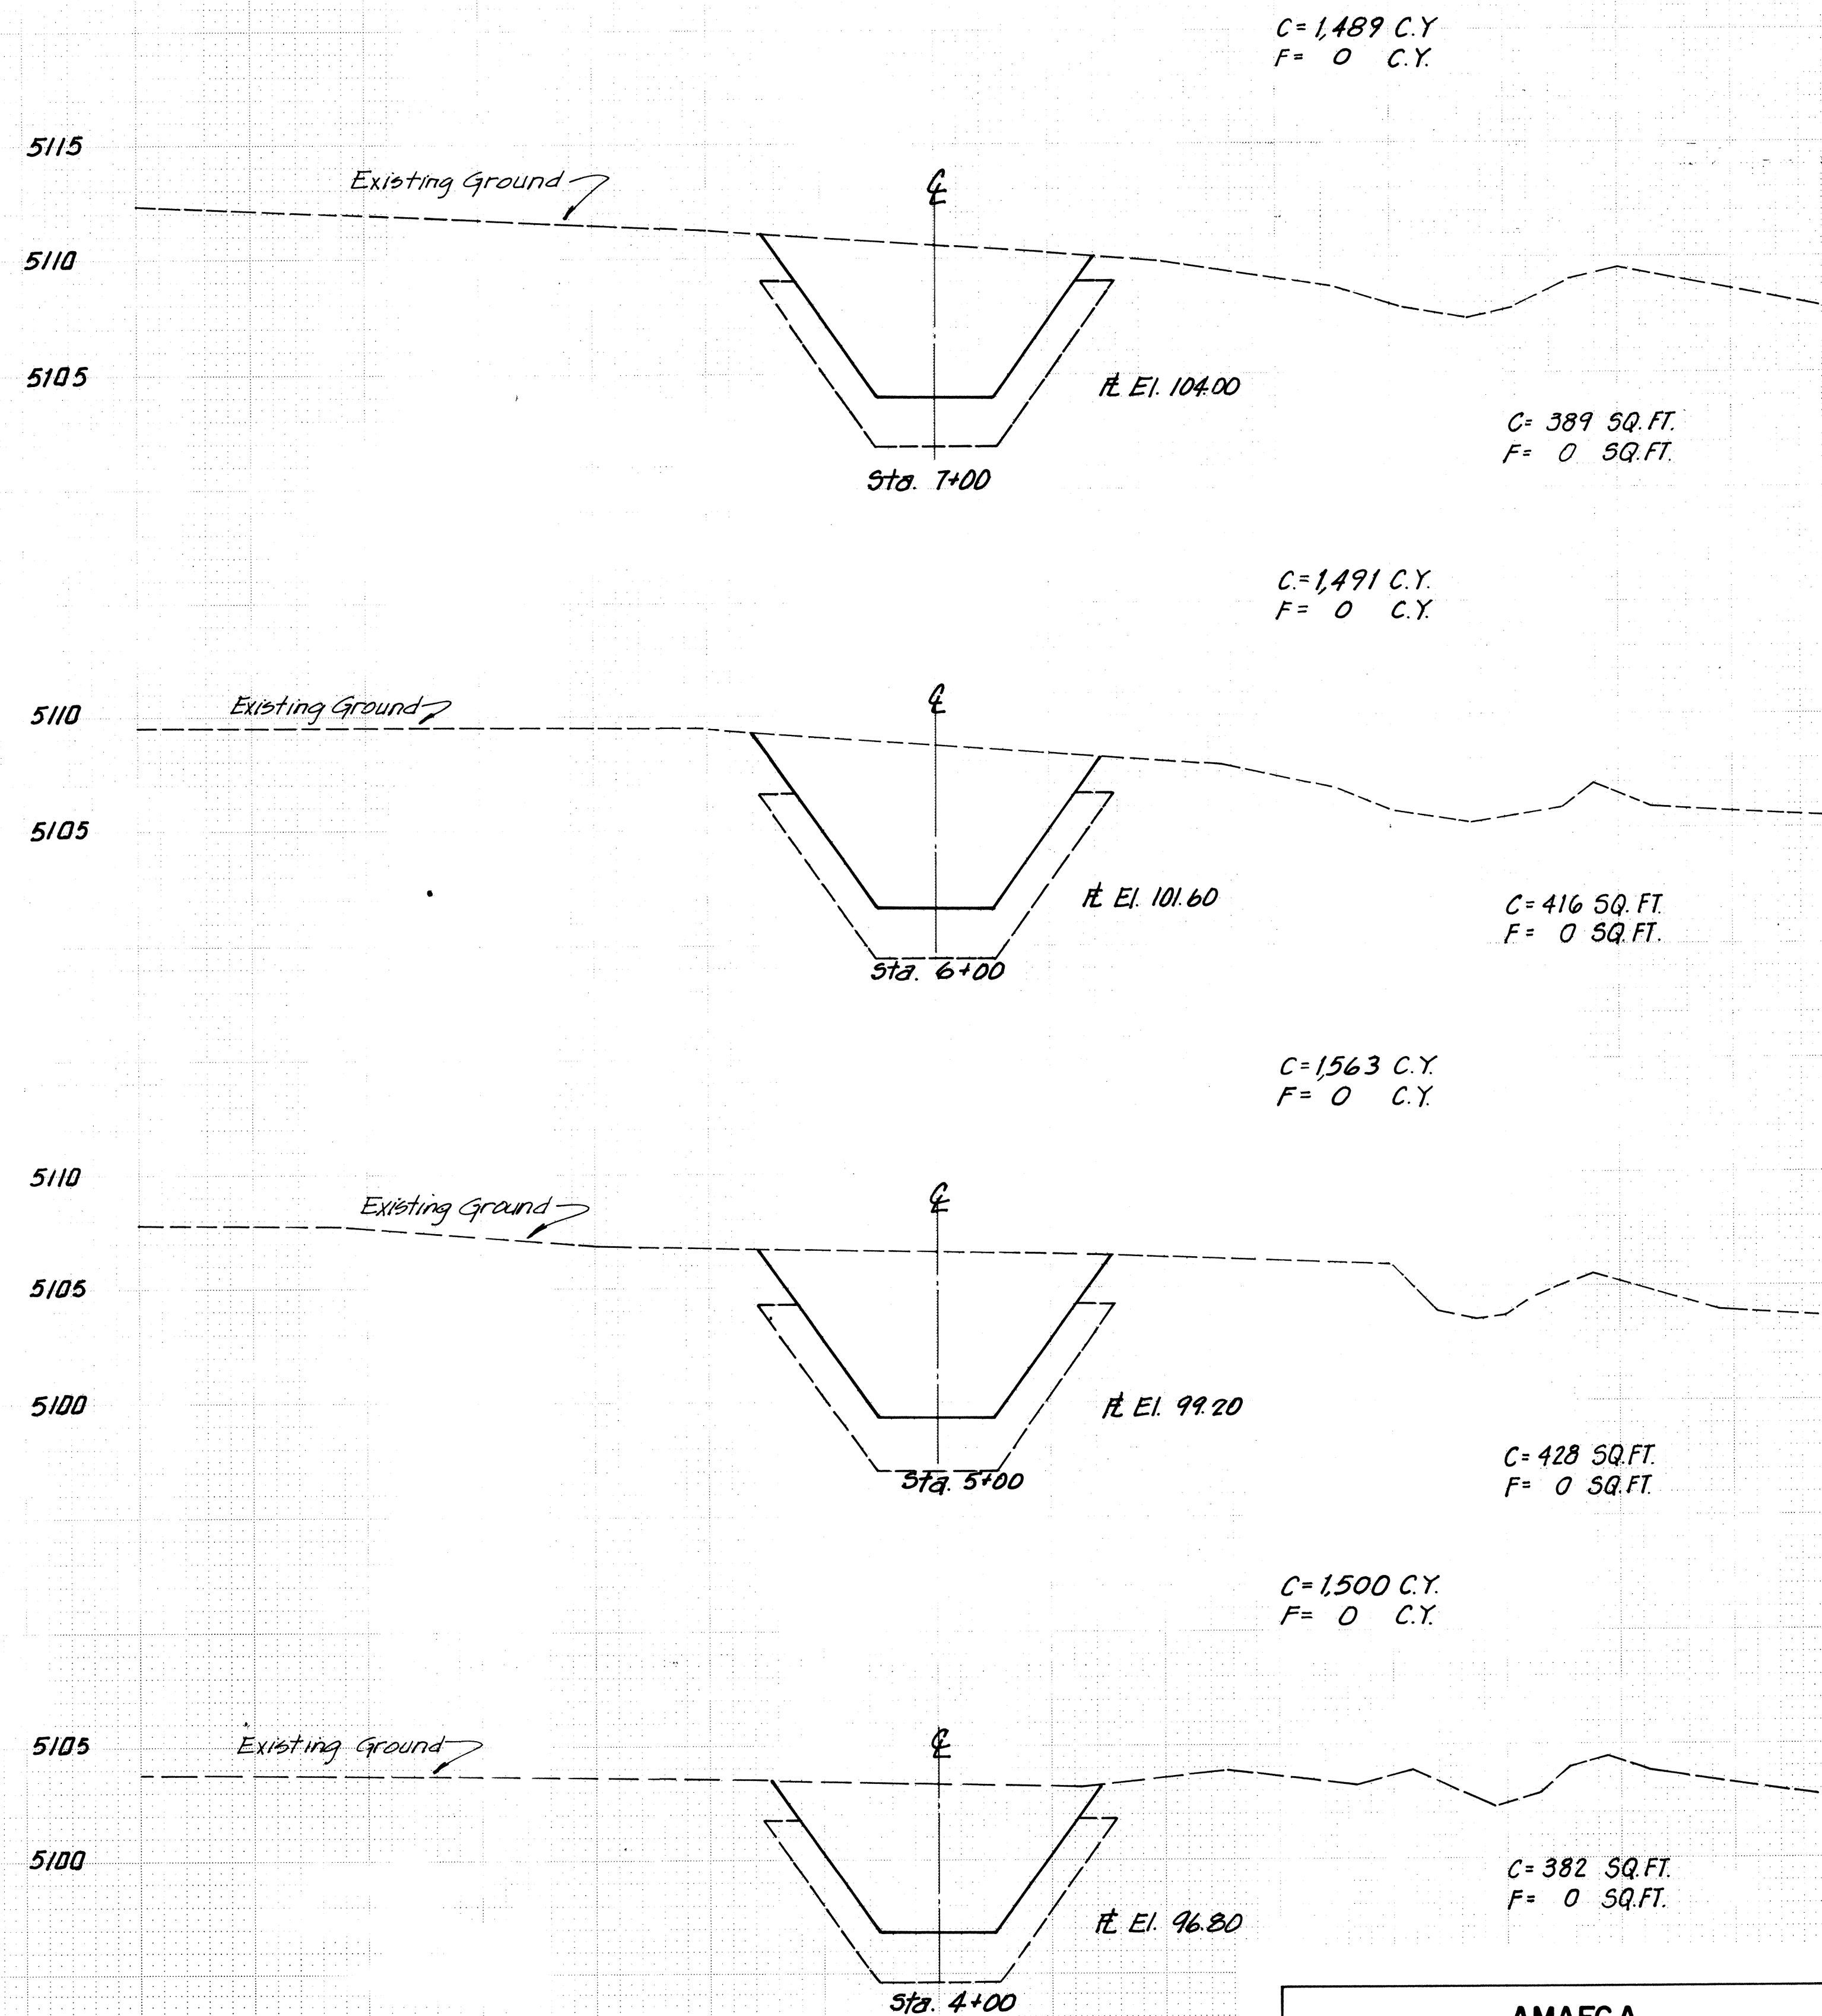

RECORD DRAWING
DATE JUN 24 1981

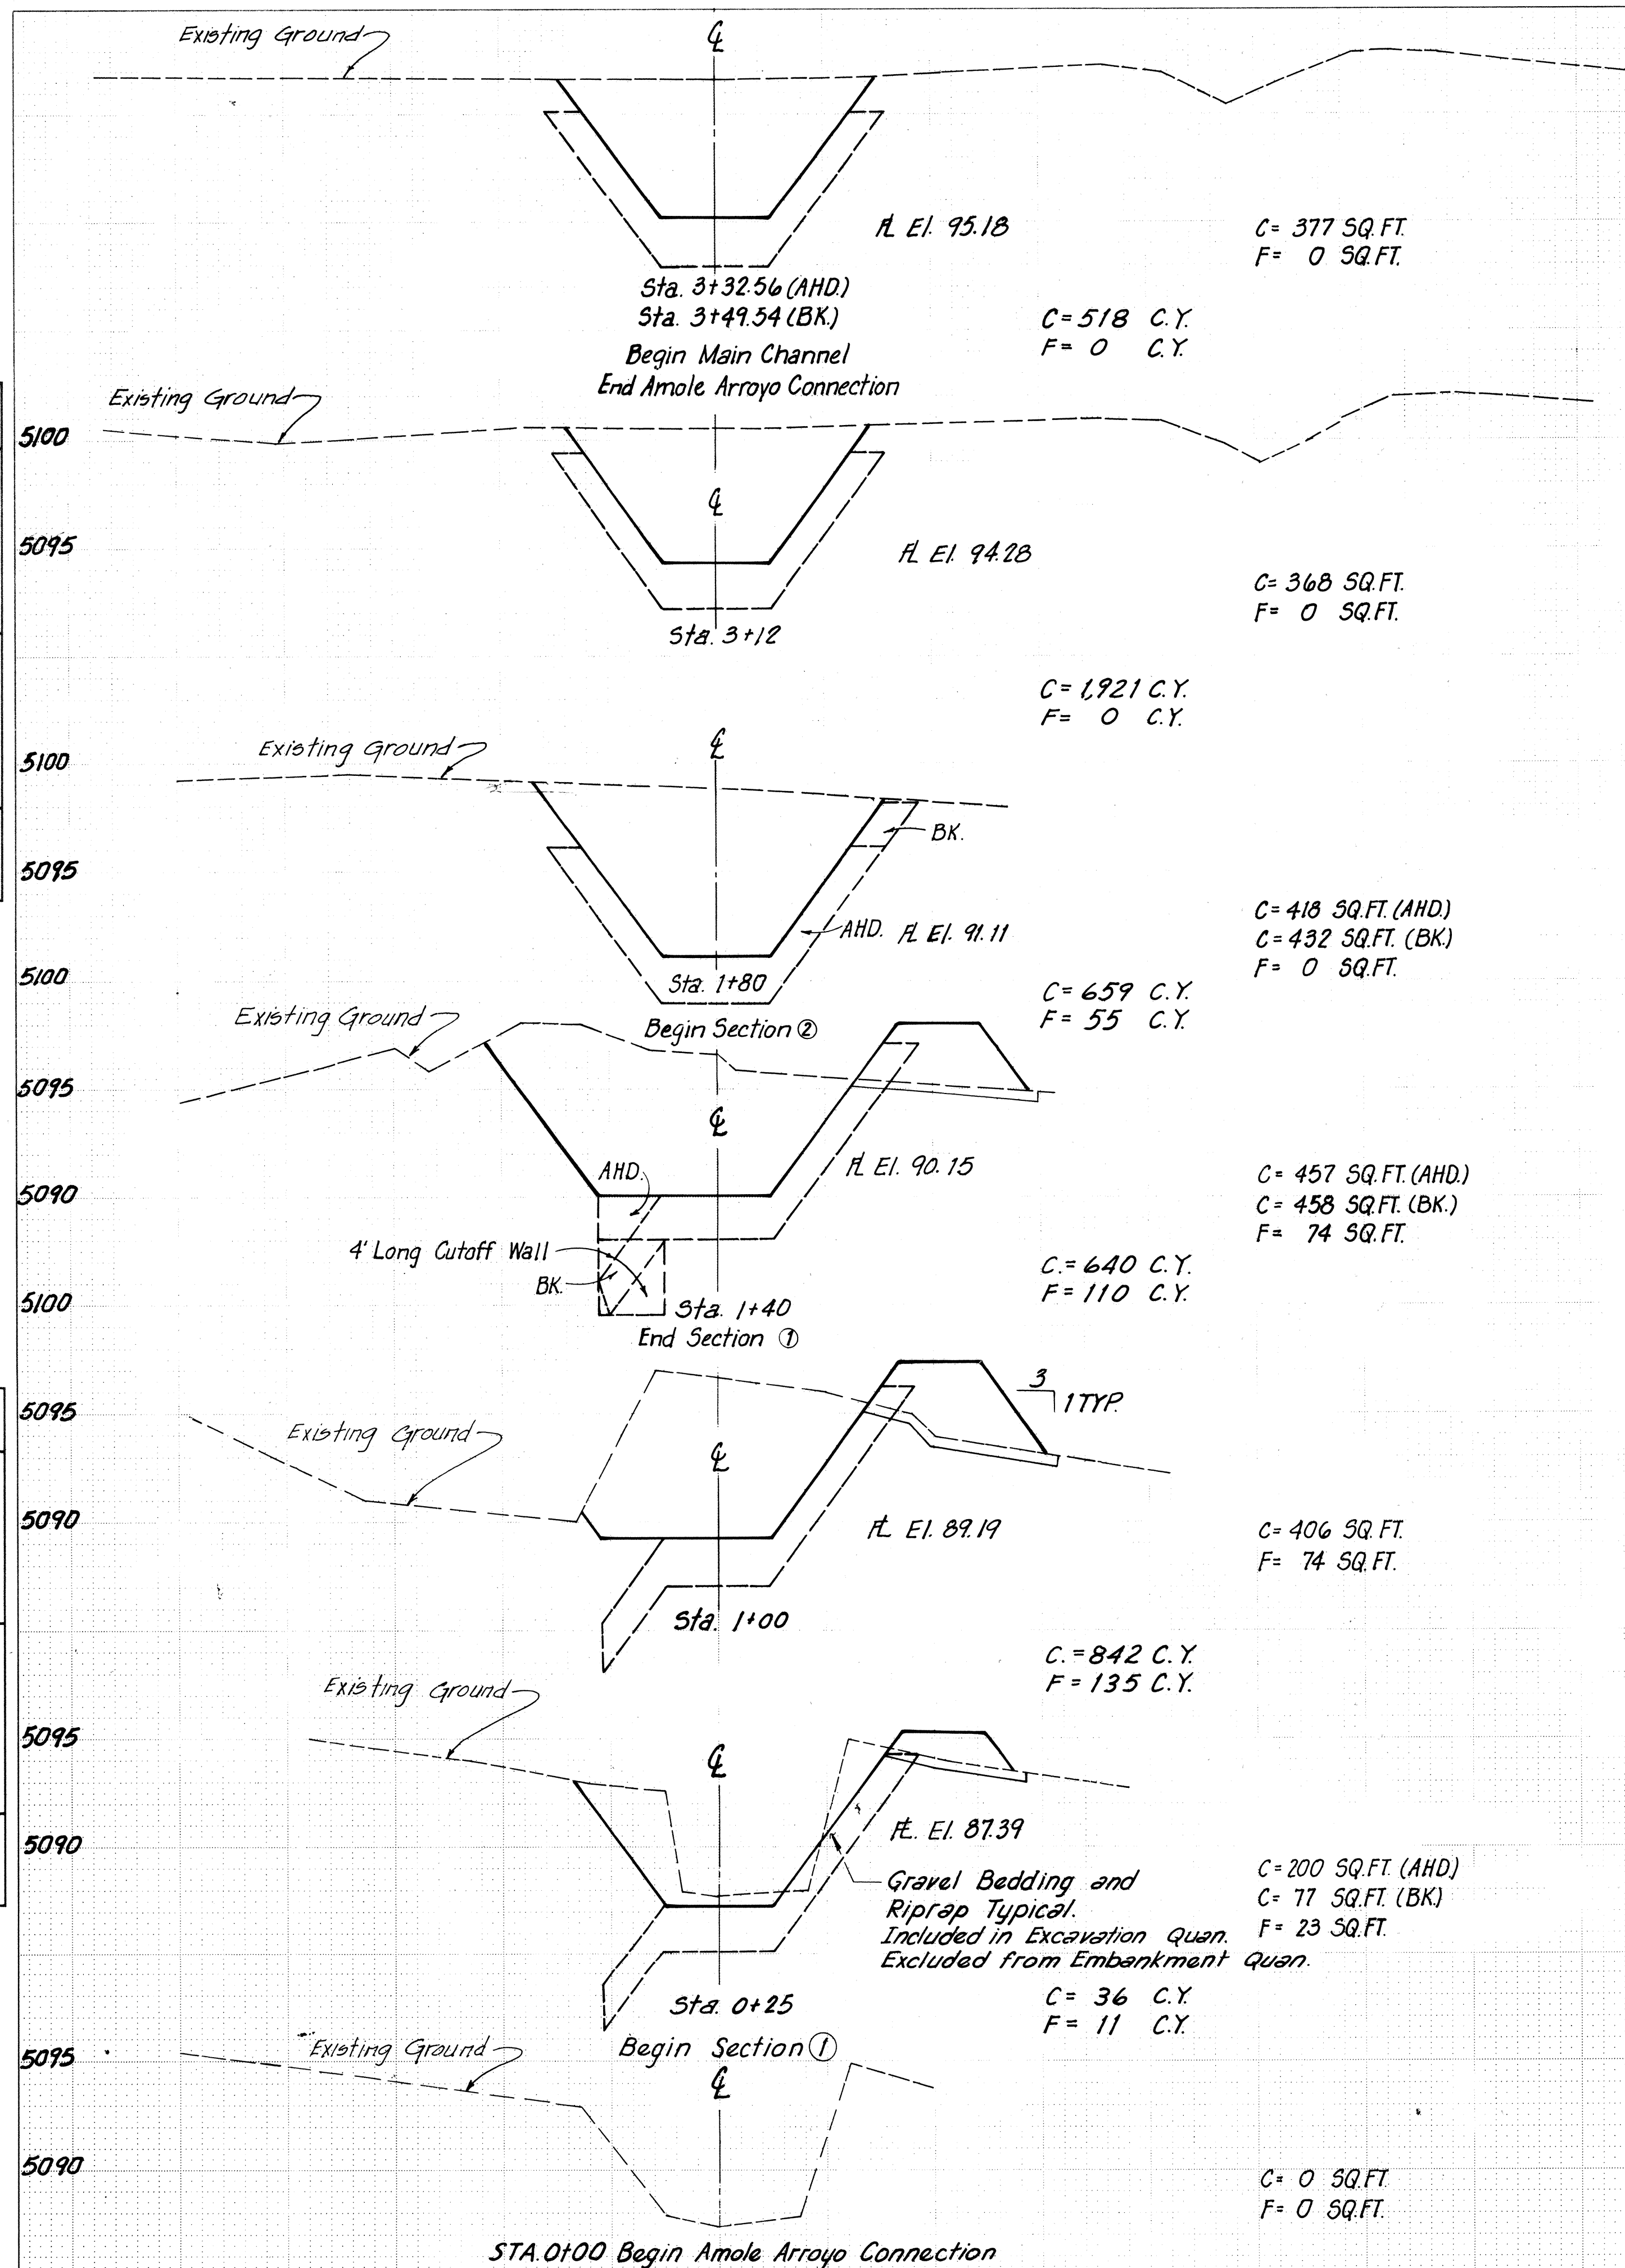

C = 948 C.Y.
F = 0 C.Y.



AMAFCA	
WESTGATE DIVERSION CHANNELS SNOW VISTA CHANNEL - PHASE I	
CHANNEL CROSS SECTIONS STA. 0+00 TO STA. 7+00	DRAWN BY C.P.W.
	DATE MAR., 1981
	SCALE HORIZ. 1" = 20' VERT. 1" = 5'
GORDON HERKENHOFF & ASSOCIATES, INC. ENGINEERS • PLANNERS	
ALBUQUERQUE	NEW MEXICO