



ORIGINAL	SURVEYED _____	BY _____ _____	DATE _____ _____ _____ _____
SURVEY	PLOTTED _____		
NOTE BOOK	TEMPLATE _____		
NO. _____	AREAS _____		
	AREAS CHECKED _____		

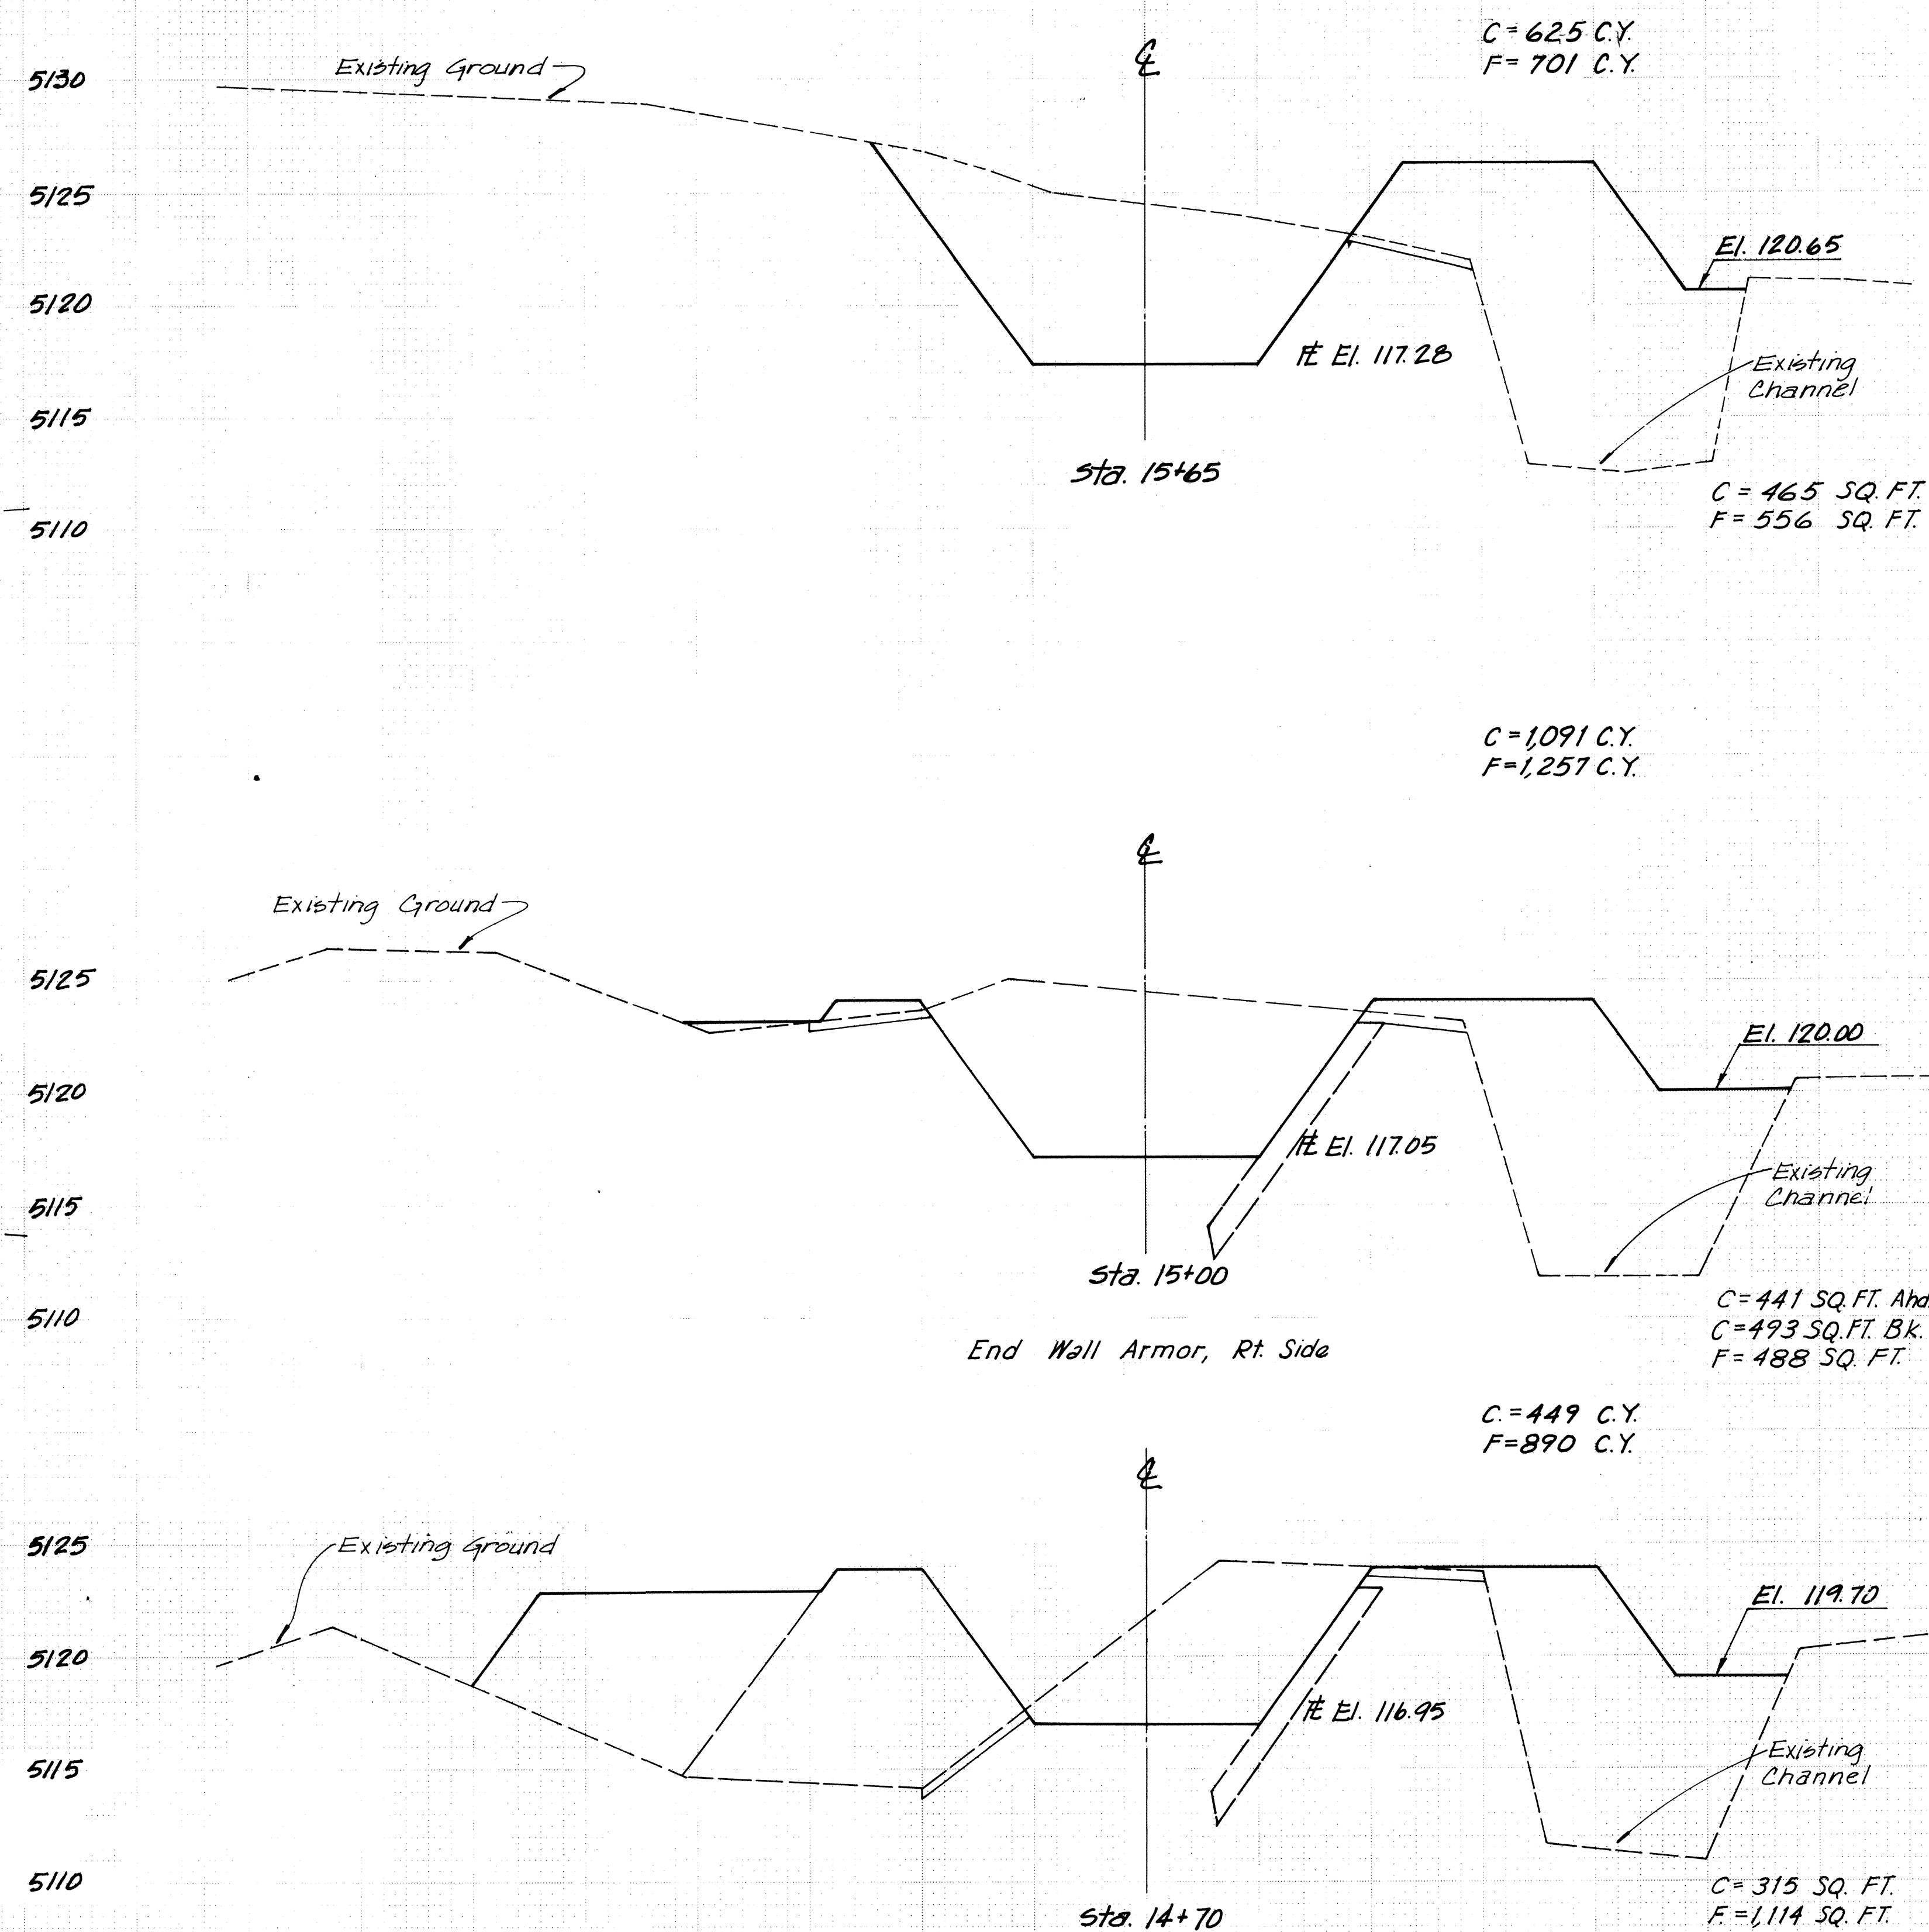

RECORD DRAWING
DATE JUN 24 1981

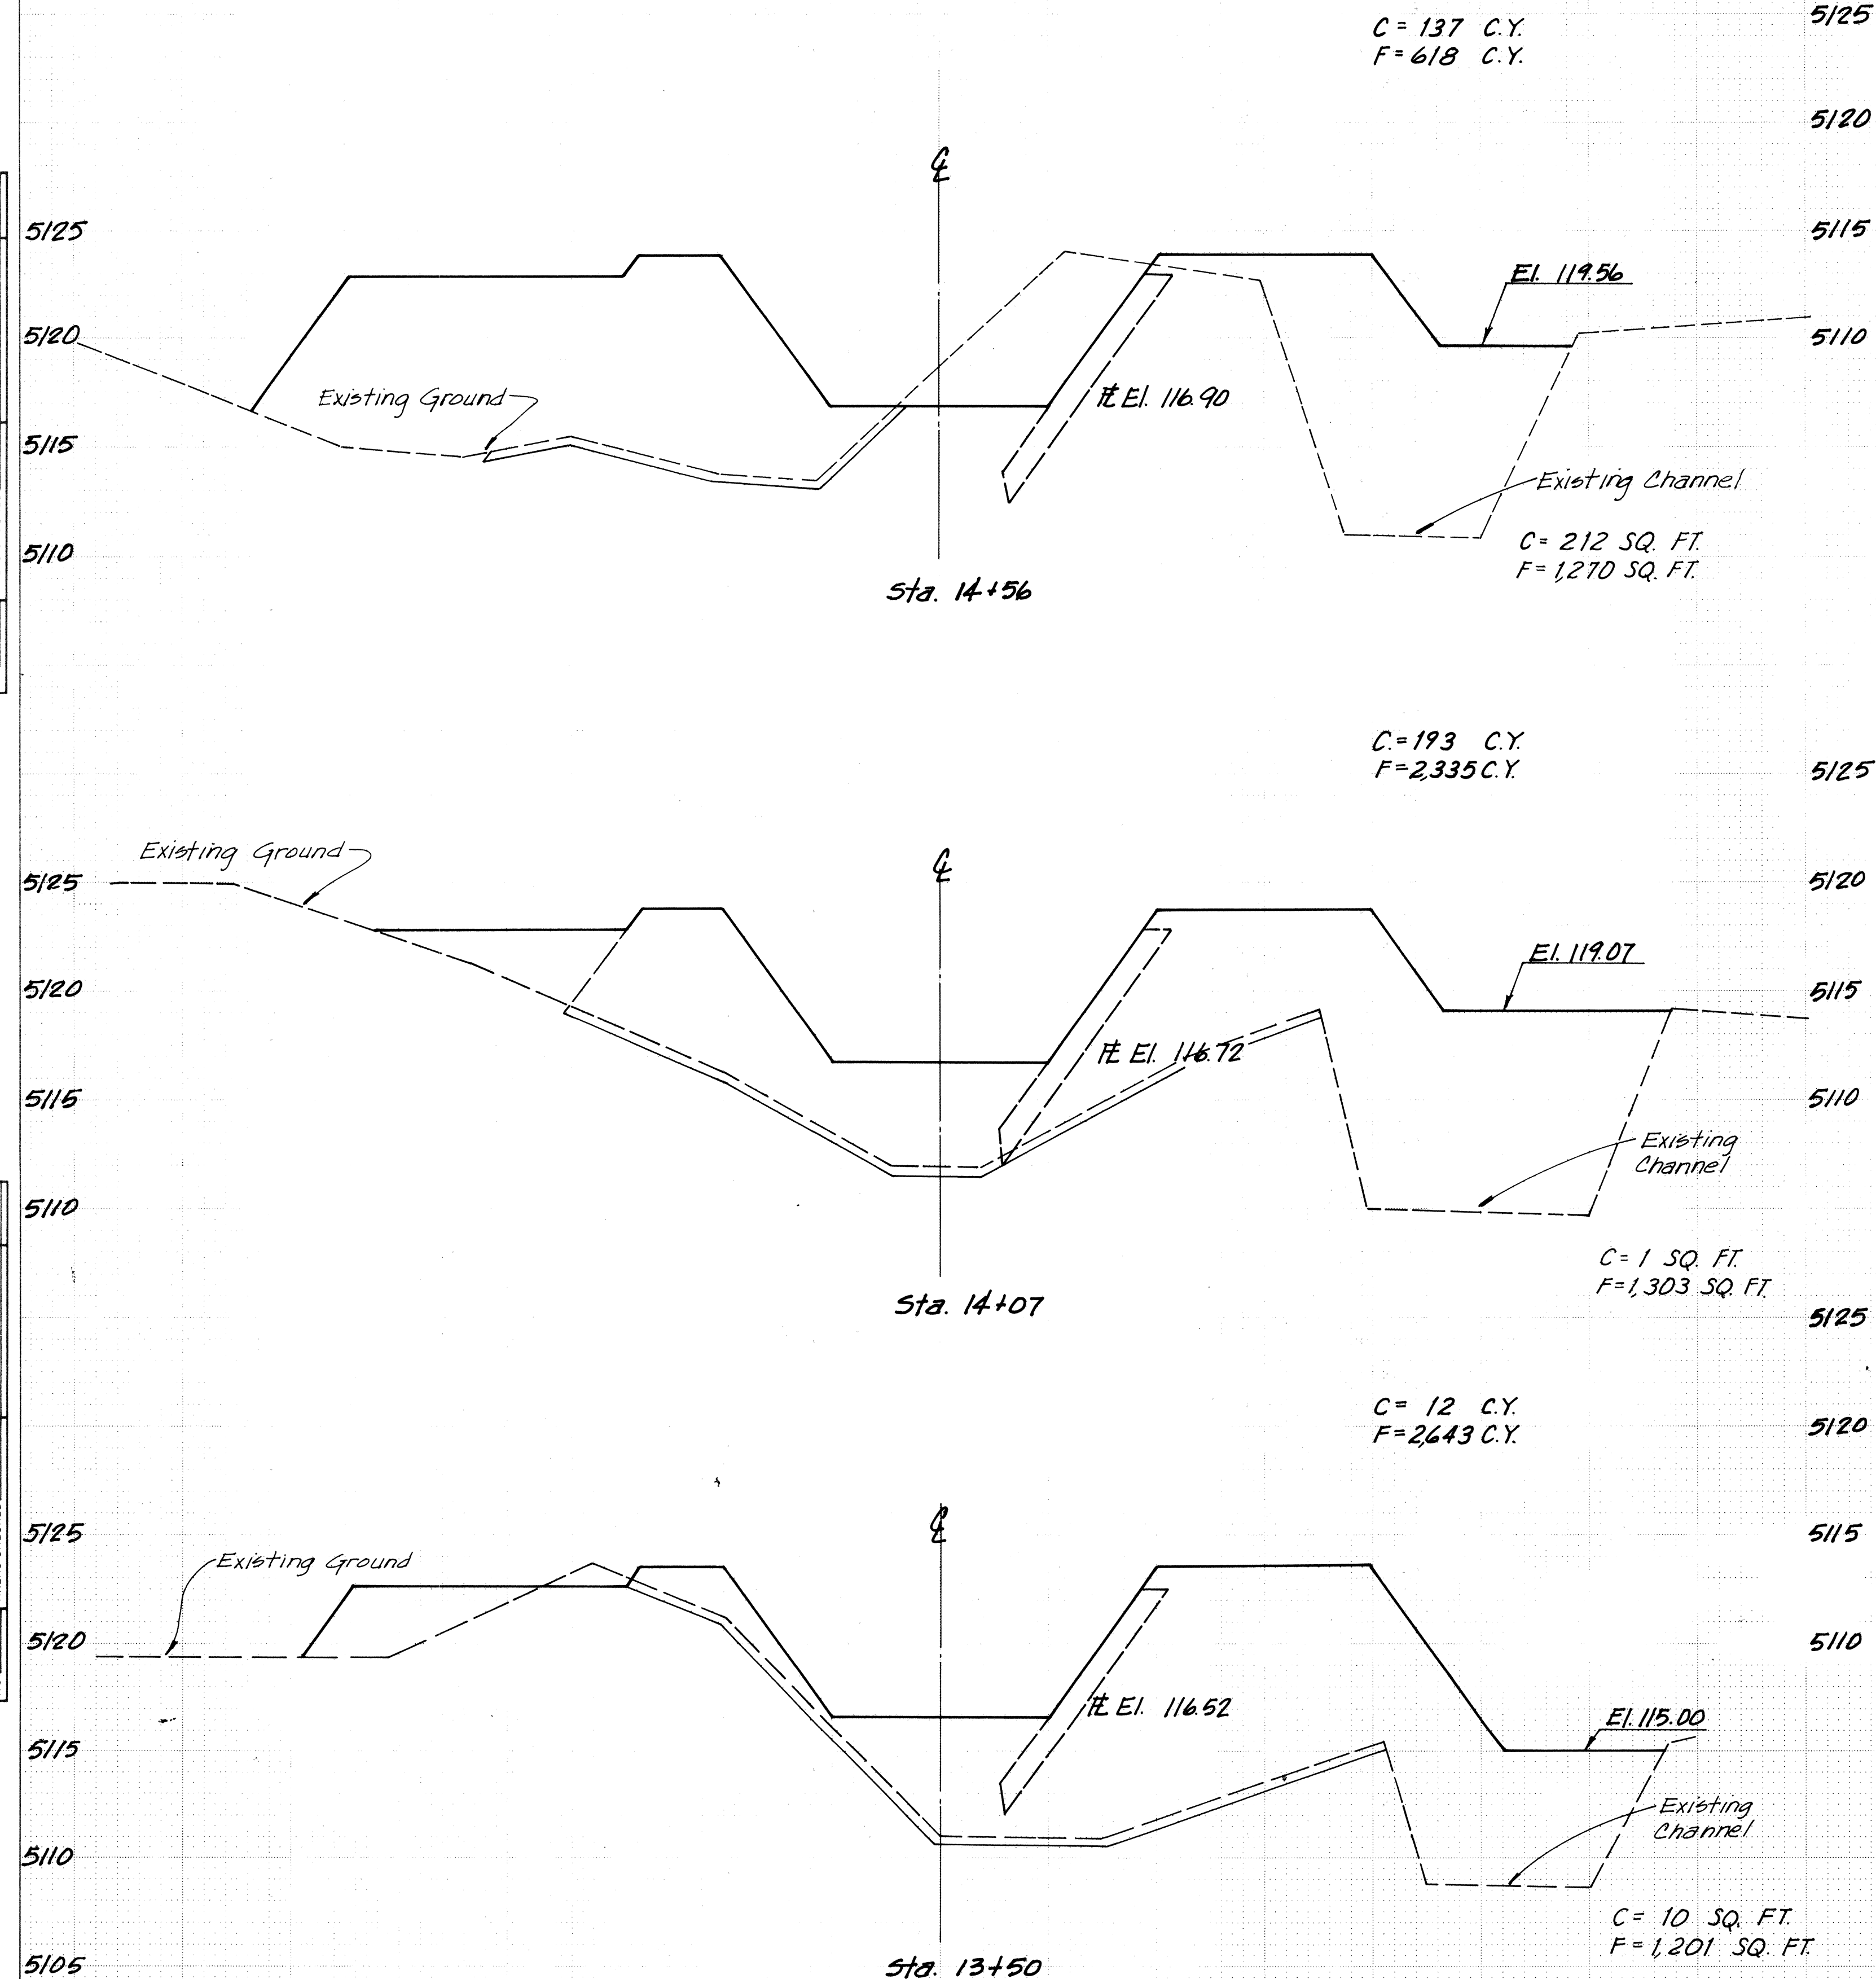

	AMAFCA	
	WESTGATE DIVERSION CHANNELS SNOW VISTA CHANNEL - PHASE I	
	CHANNEL CROSS SECTIONS STA.13+50 TO STA.15+65	DRAWN BY C.P.W.
		DATE MAR., 1981
		SCALE HORIZ. 1" = 20' VERT. 1" = 5'
GORDON HERKENHOFF & ASSOCIATES, INC. ENGINEERS • PLANNERS		
ALBUQUERQUE	NEW MEXICO	