

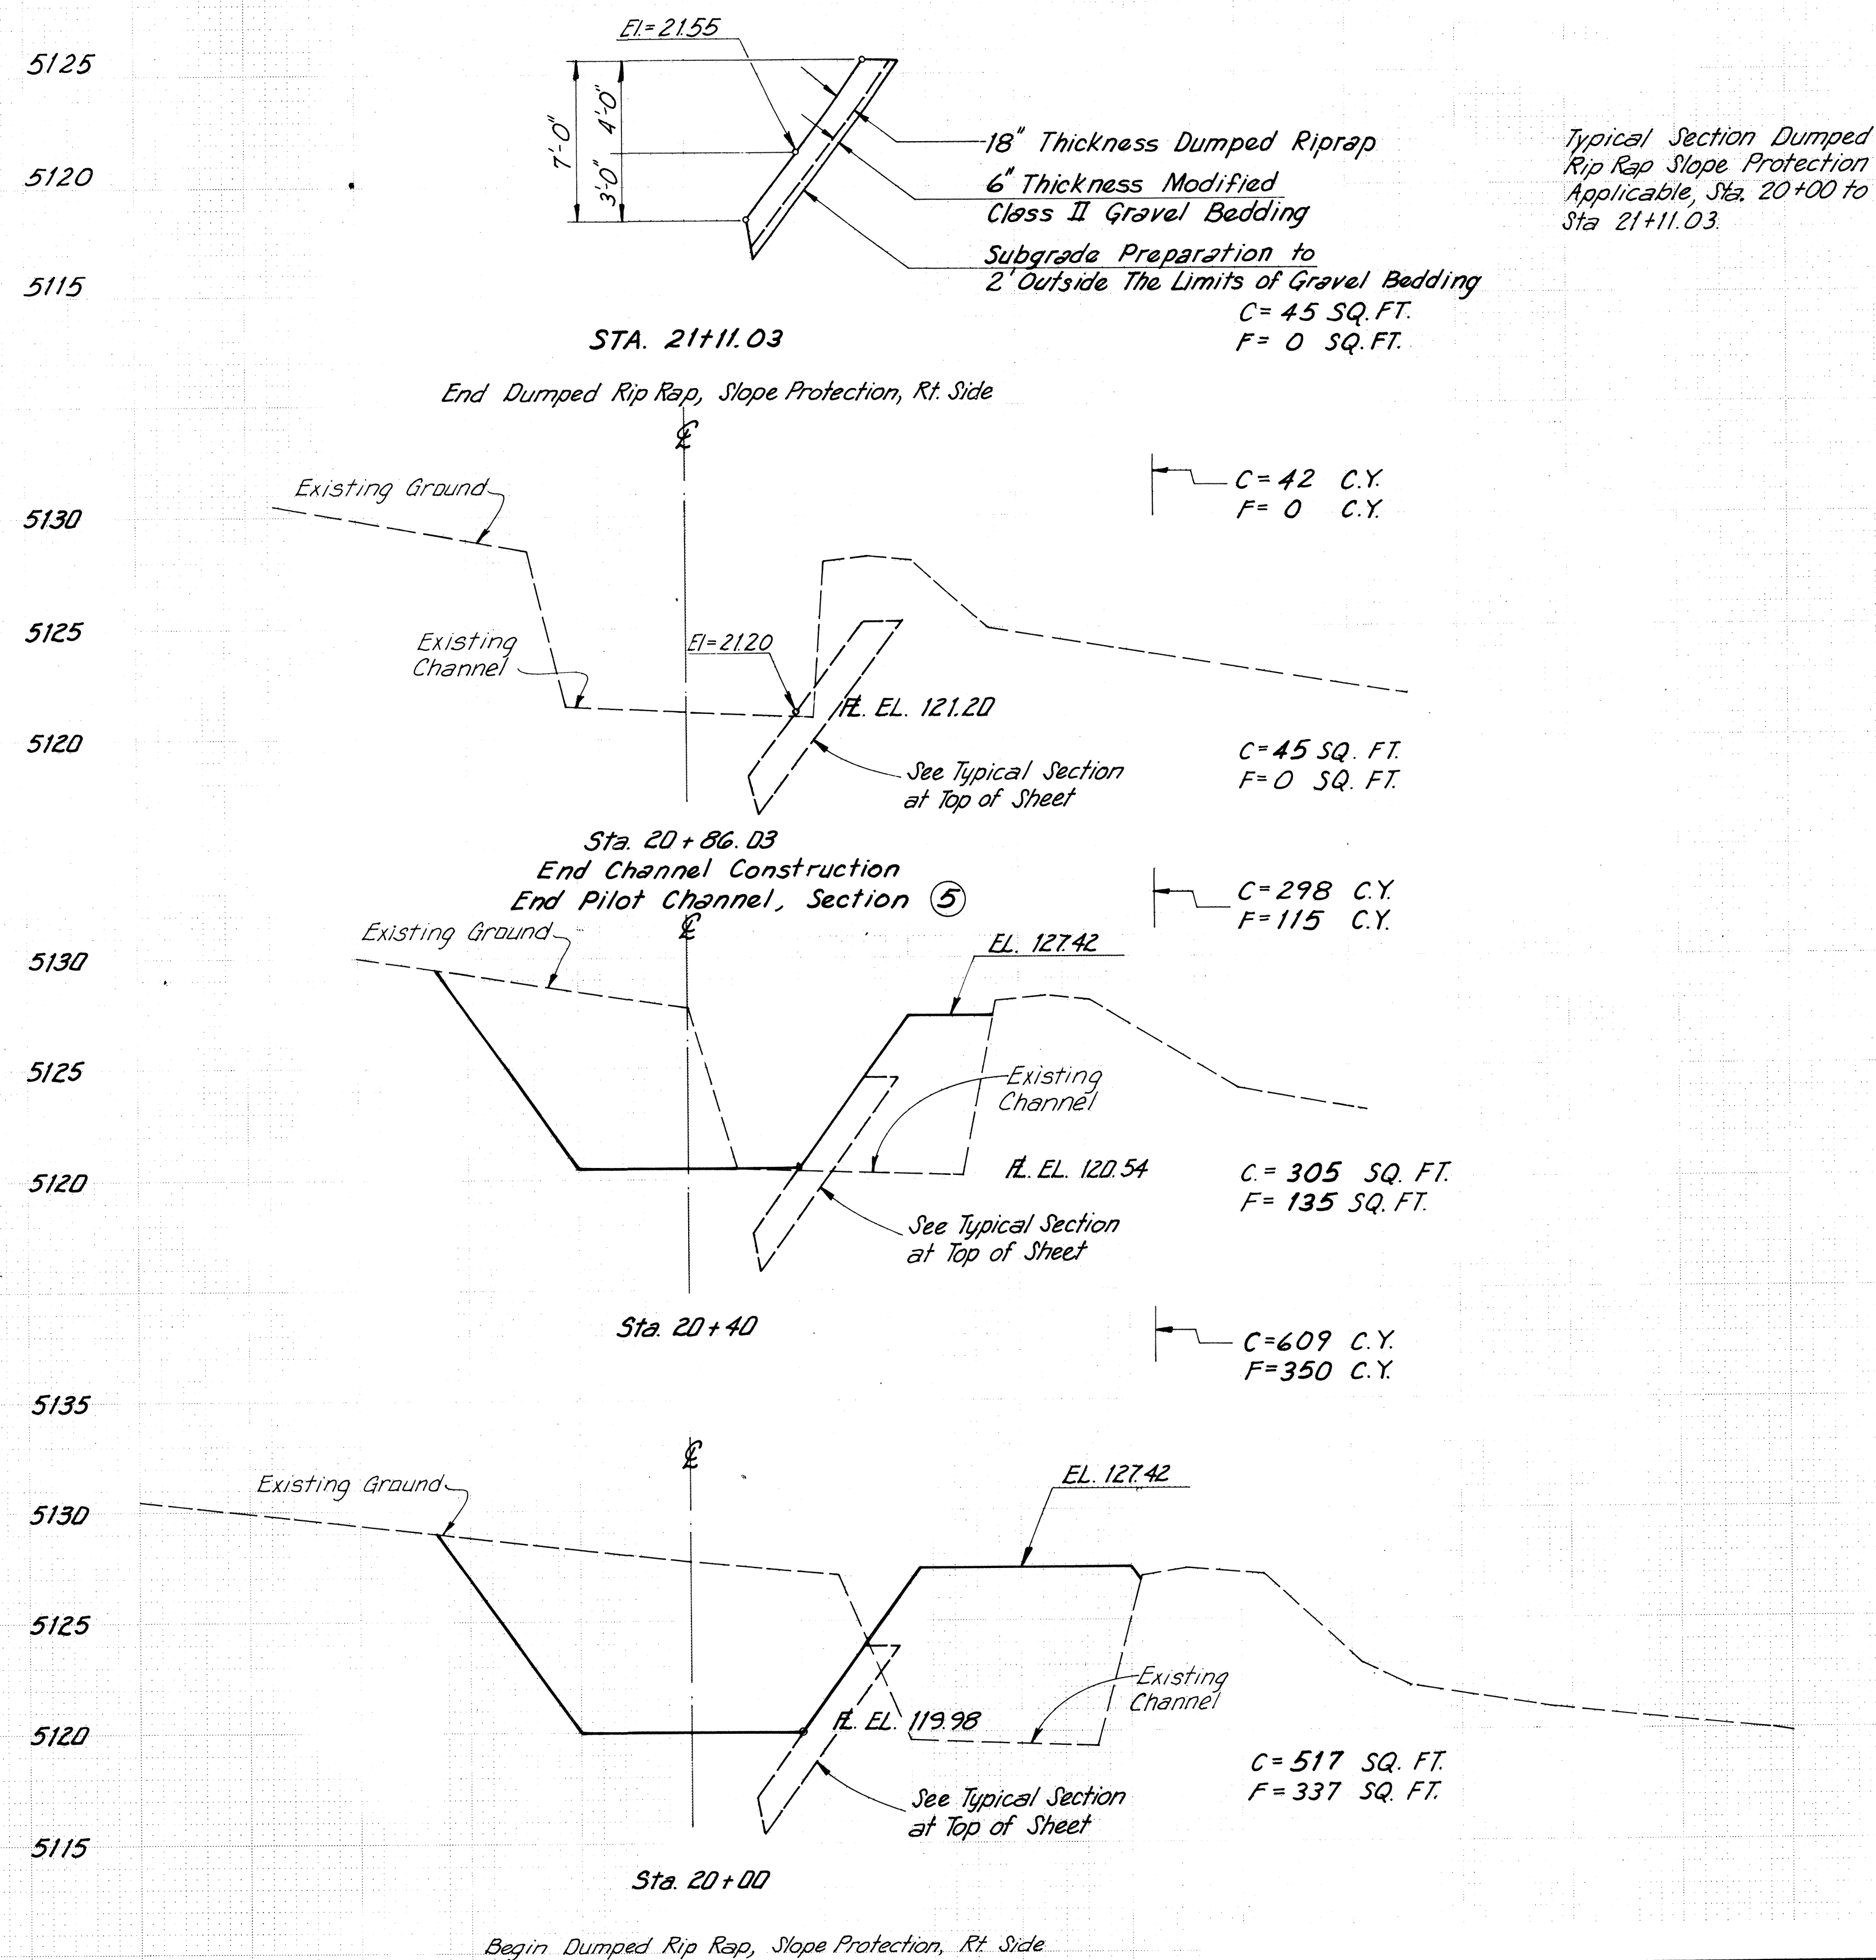


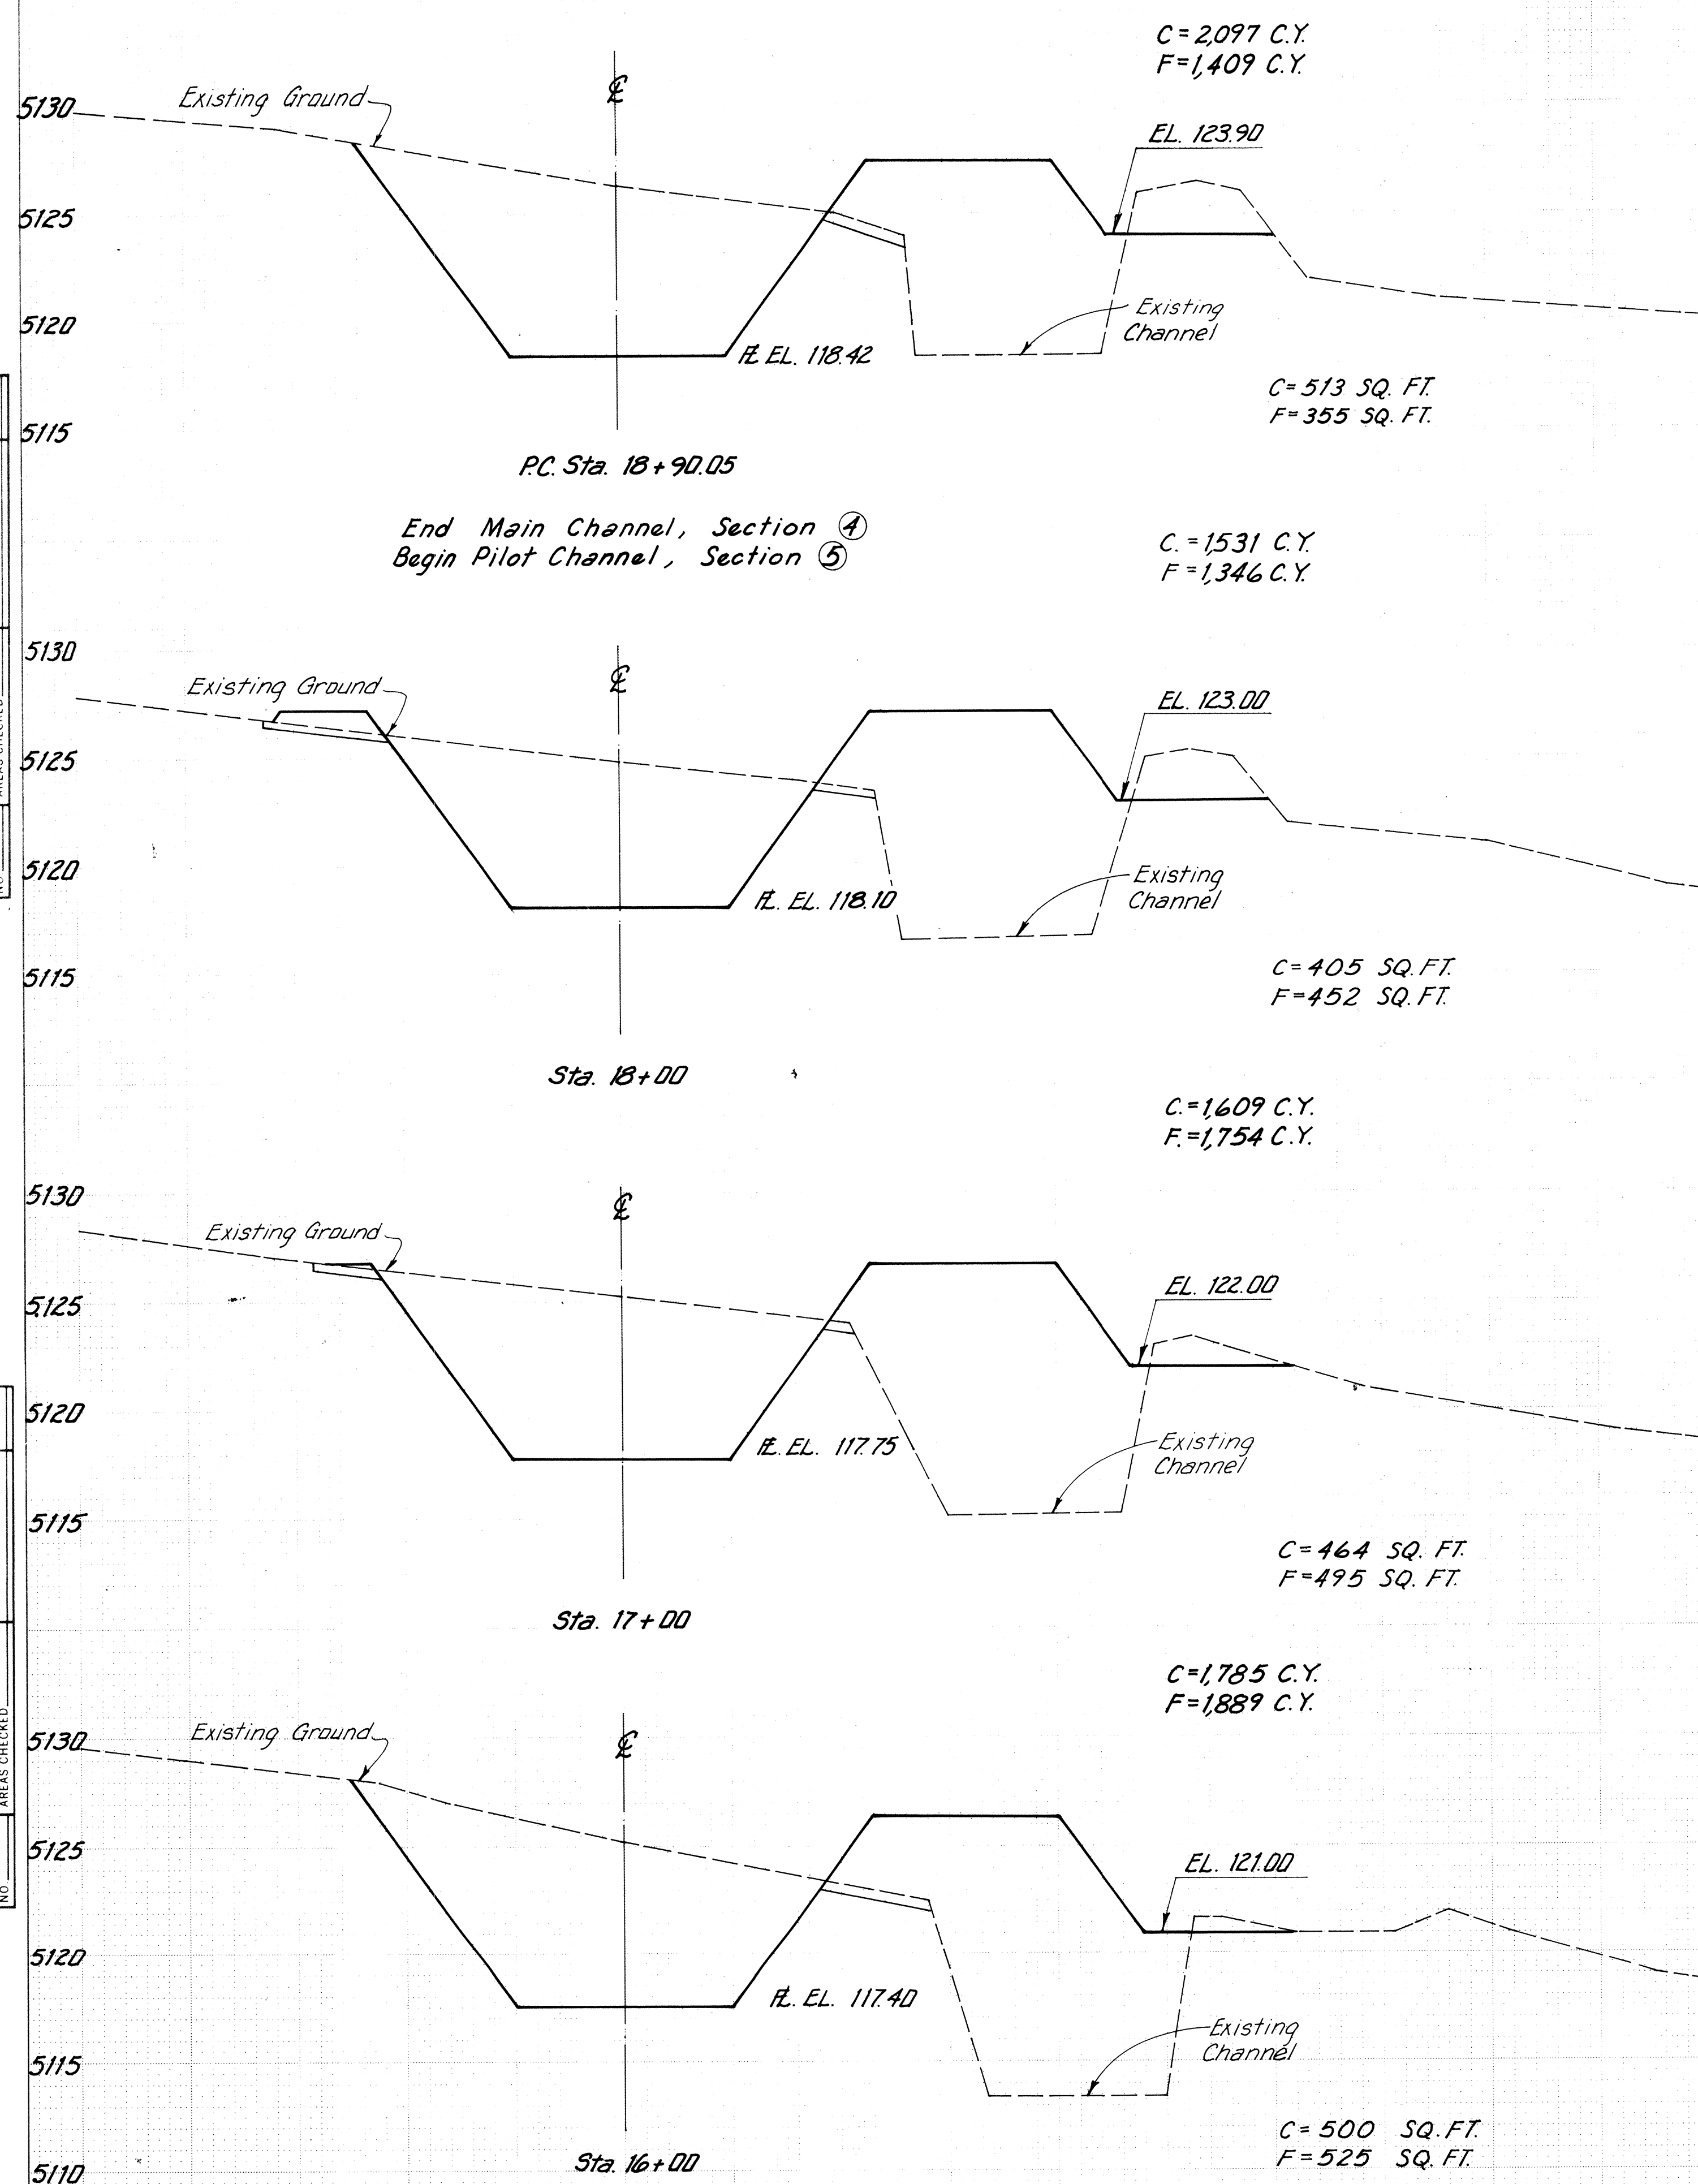

RECORD DRAWING
DATE JUN 24 1981

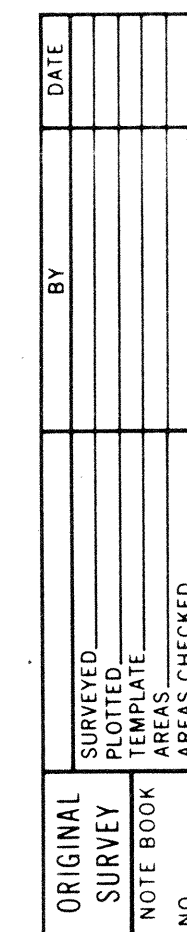

AMAFCA

WESTGATE DIVERSION CHANNELS
SNOW VISTA CHANNEL-PHASE I

CHANNEL CROSS SECTIONS

STA.16+00 TO STA.20+86.03

GORDON HERKENHOFF & ASSOCIATES, INC.
ENGINEERS • PLANNERS
ALBUQUERQUE NEW MEXICO

DRAWN BY D. L.

DATE _____

SCALE
HORIZ. 1" = 20'

VERT. 1" = 5'

ATES, INC.

NEW MEXICO

SHEET 9 OF 11