
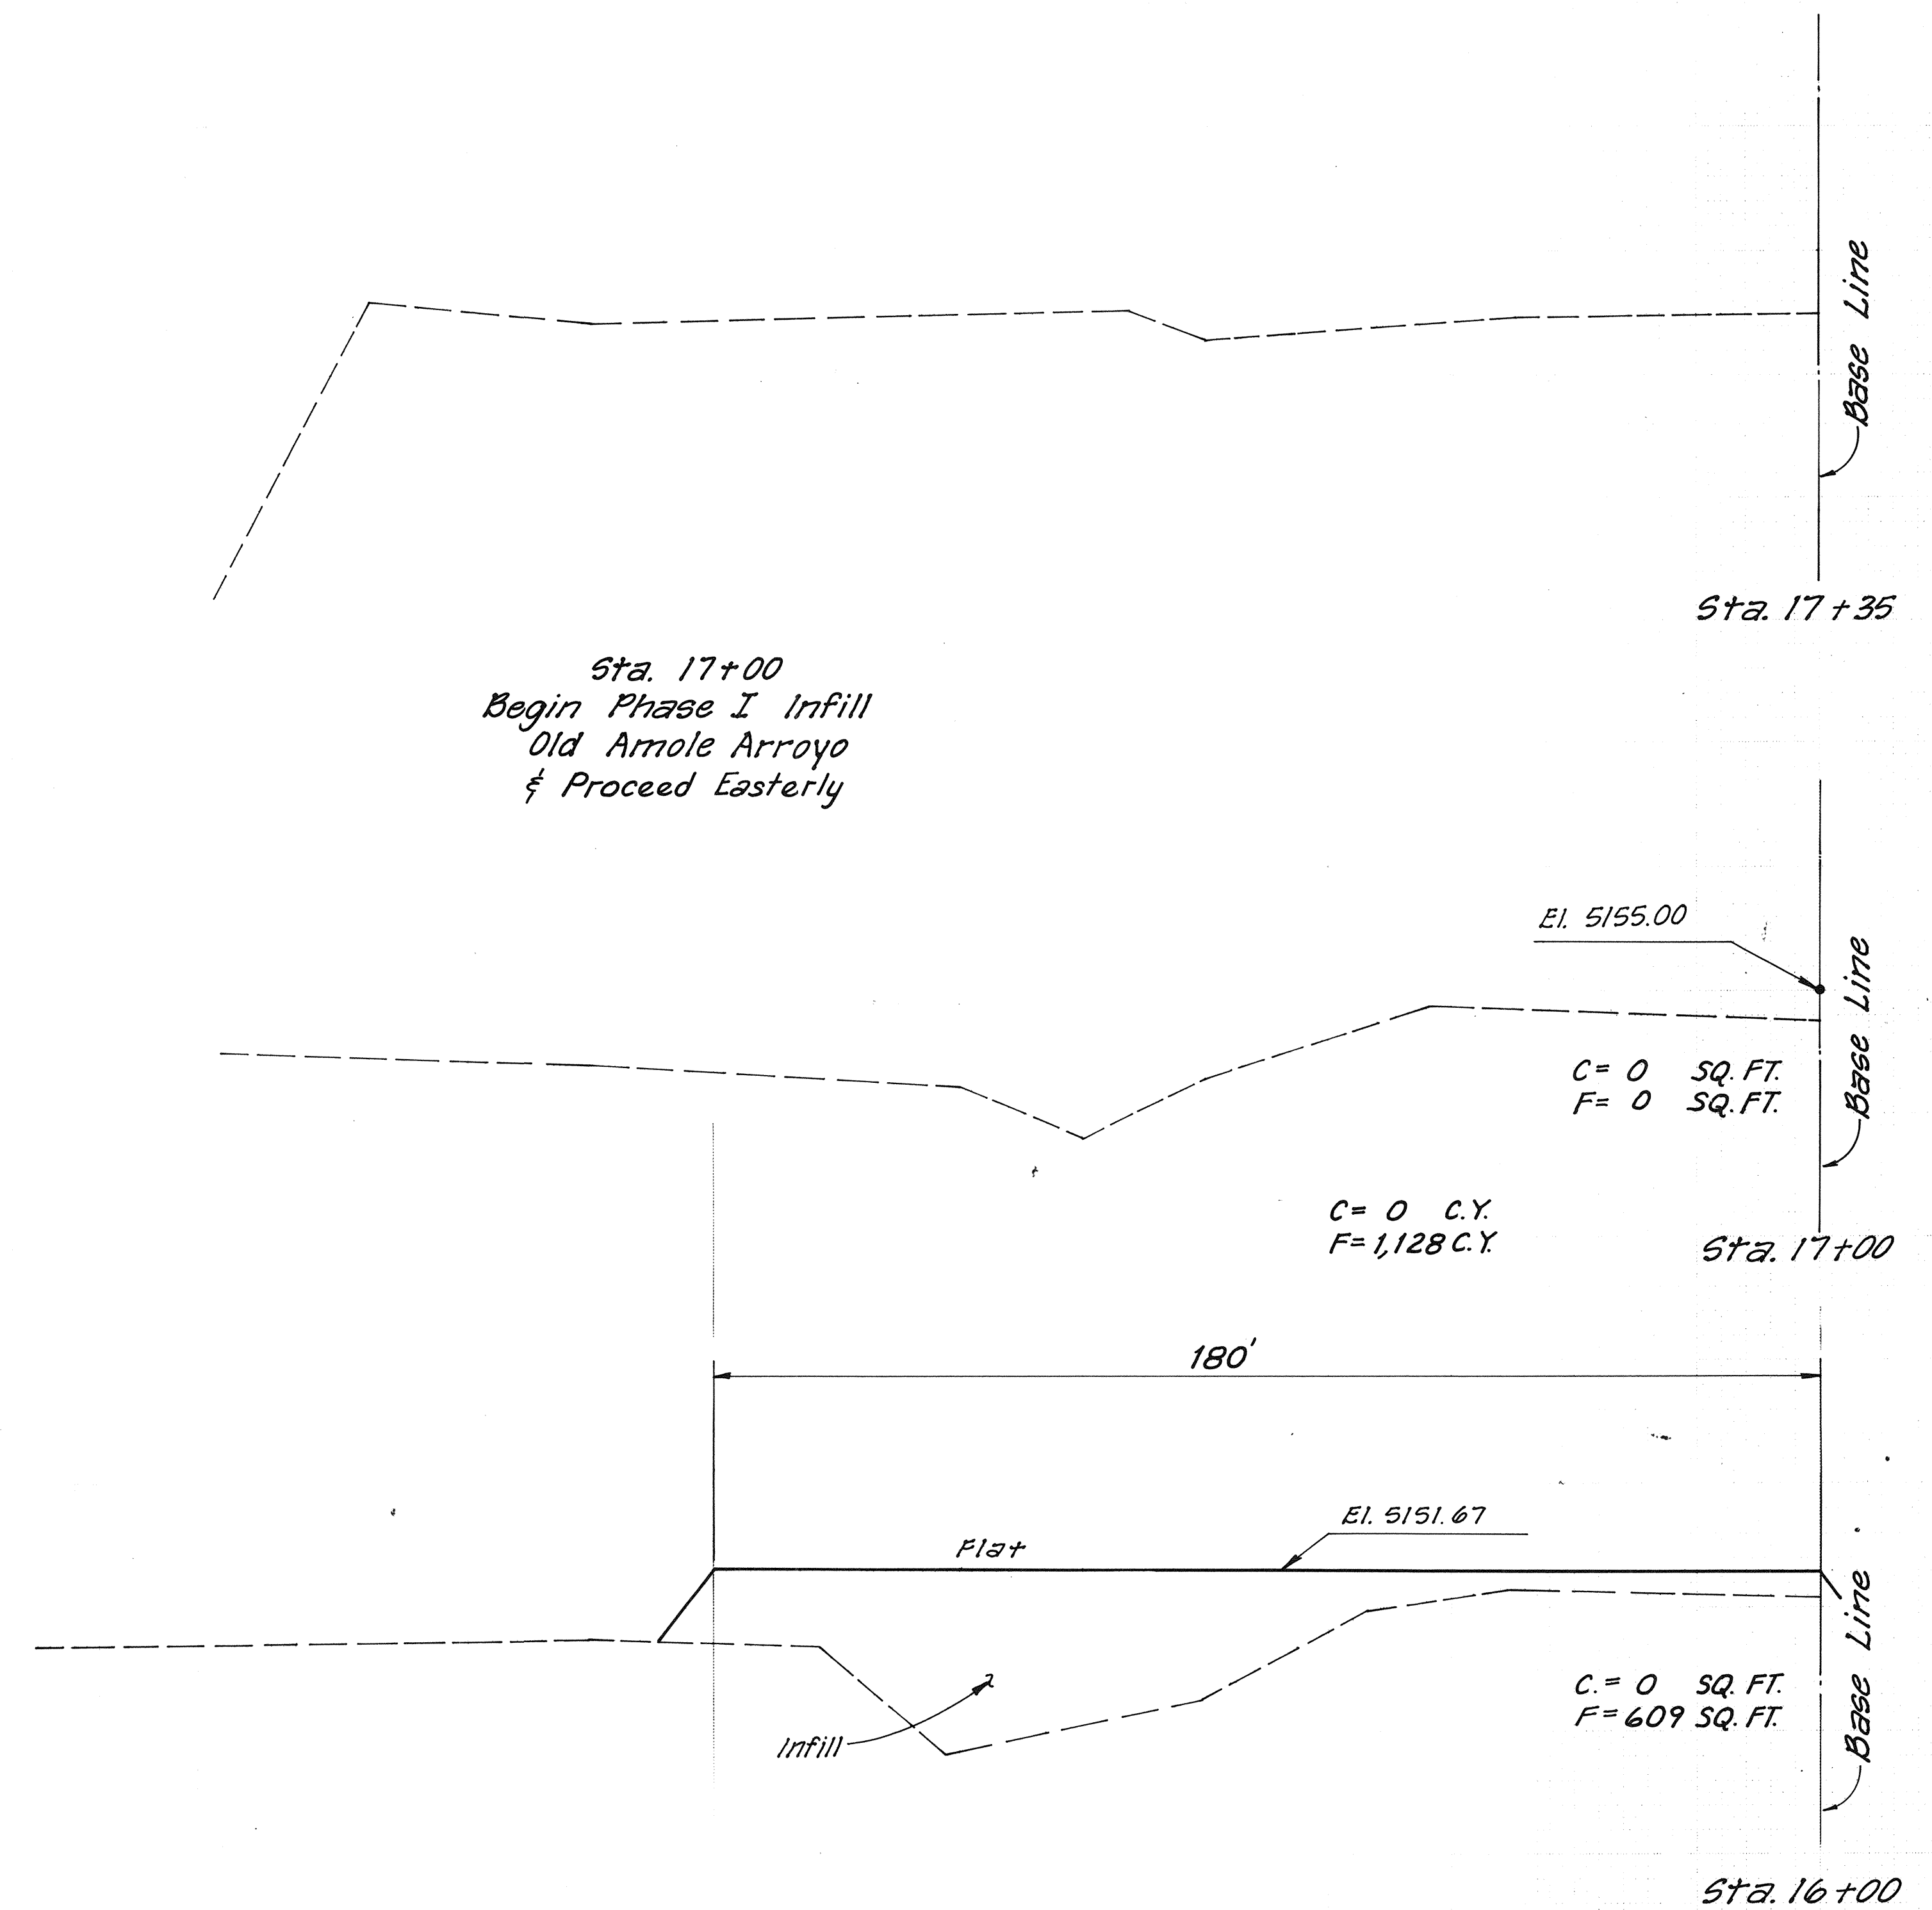


|           |                                                           |    |      |
|-----------|-----------------------------------------------------------|----|------|
| ORIGINAL  | SURVEYED<br>PLOTTED<br>TEMPLATE<br>ARIAS<br>ARIAS CHECKED | BY | DATE |
| SURVEY    |                                                           |    |      |
| NOTE BOOK |                                                           |    |      |
| NO        |                                                           |    |      |

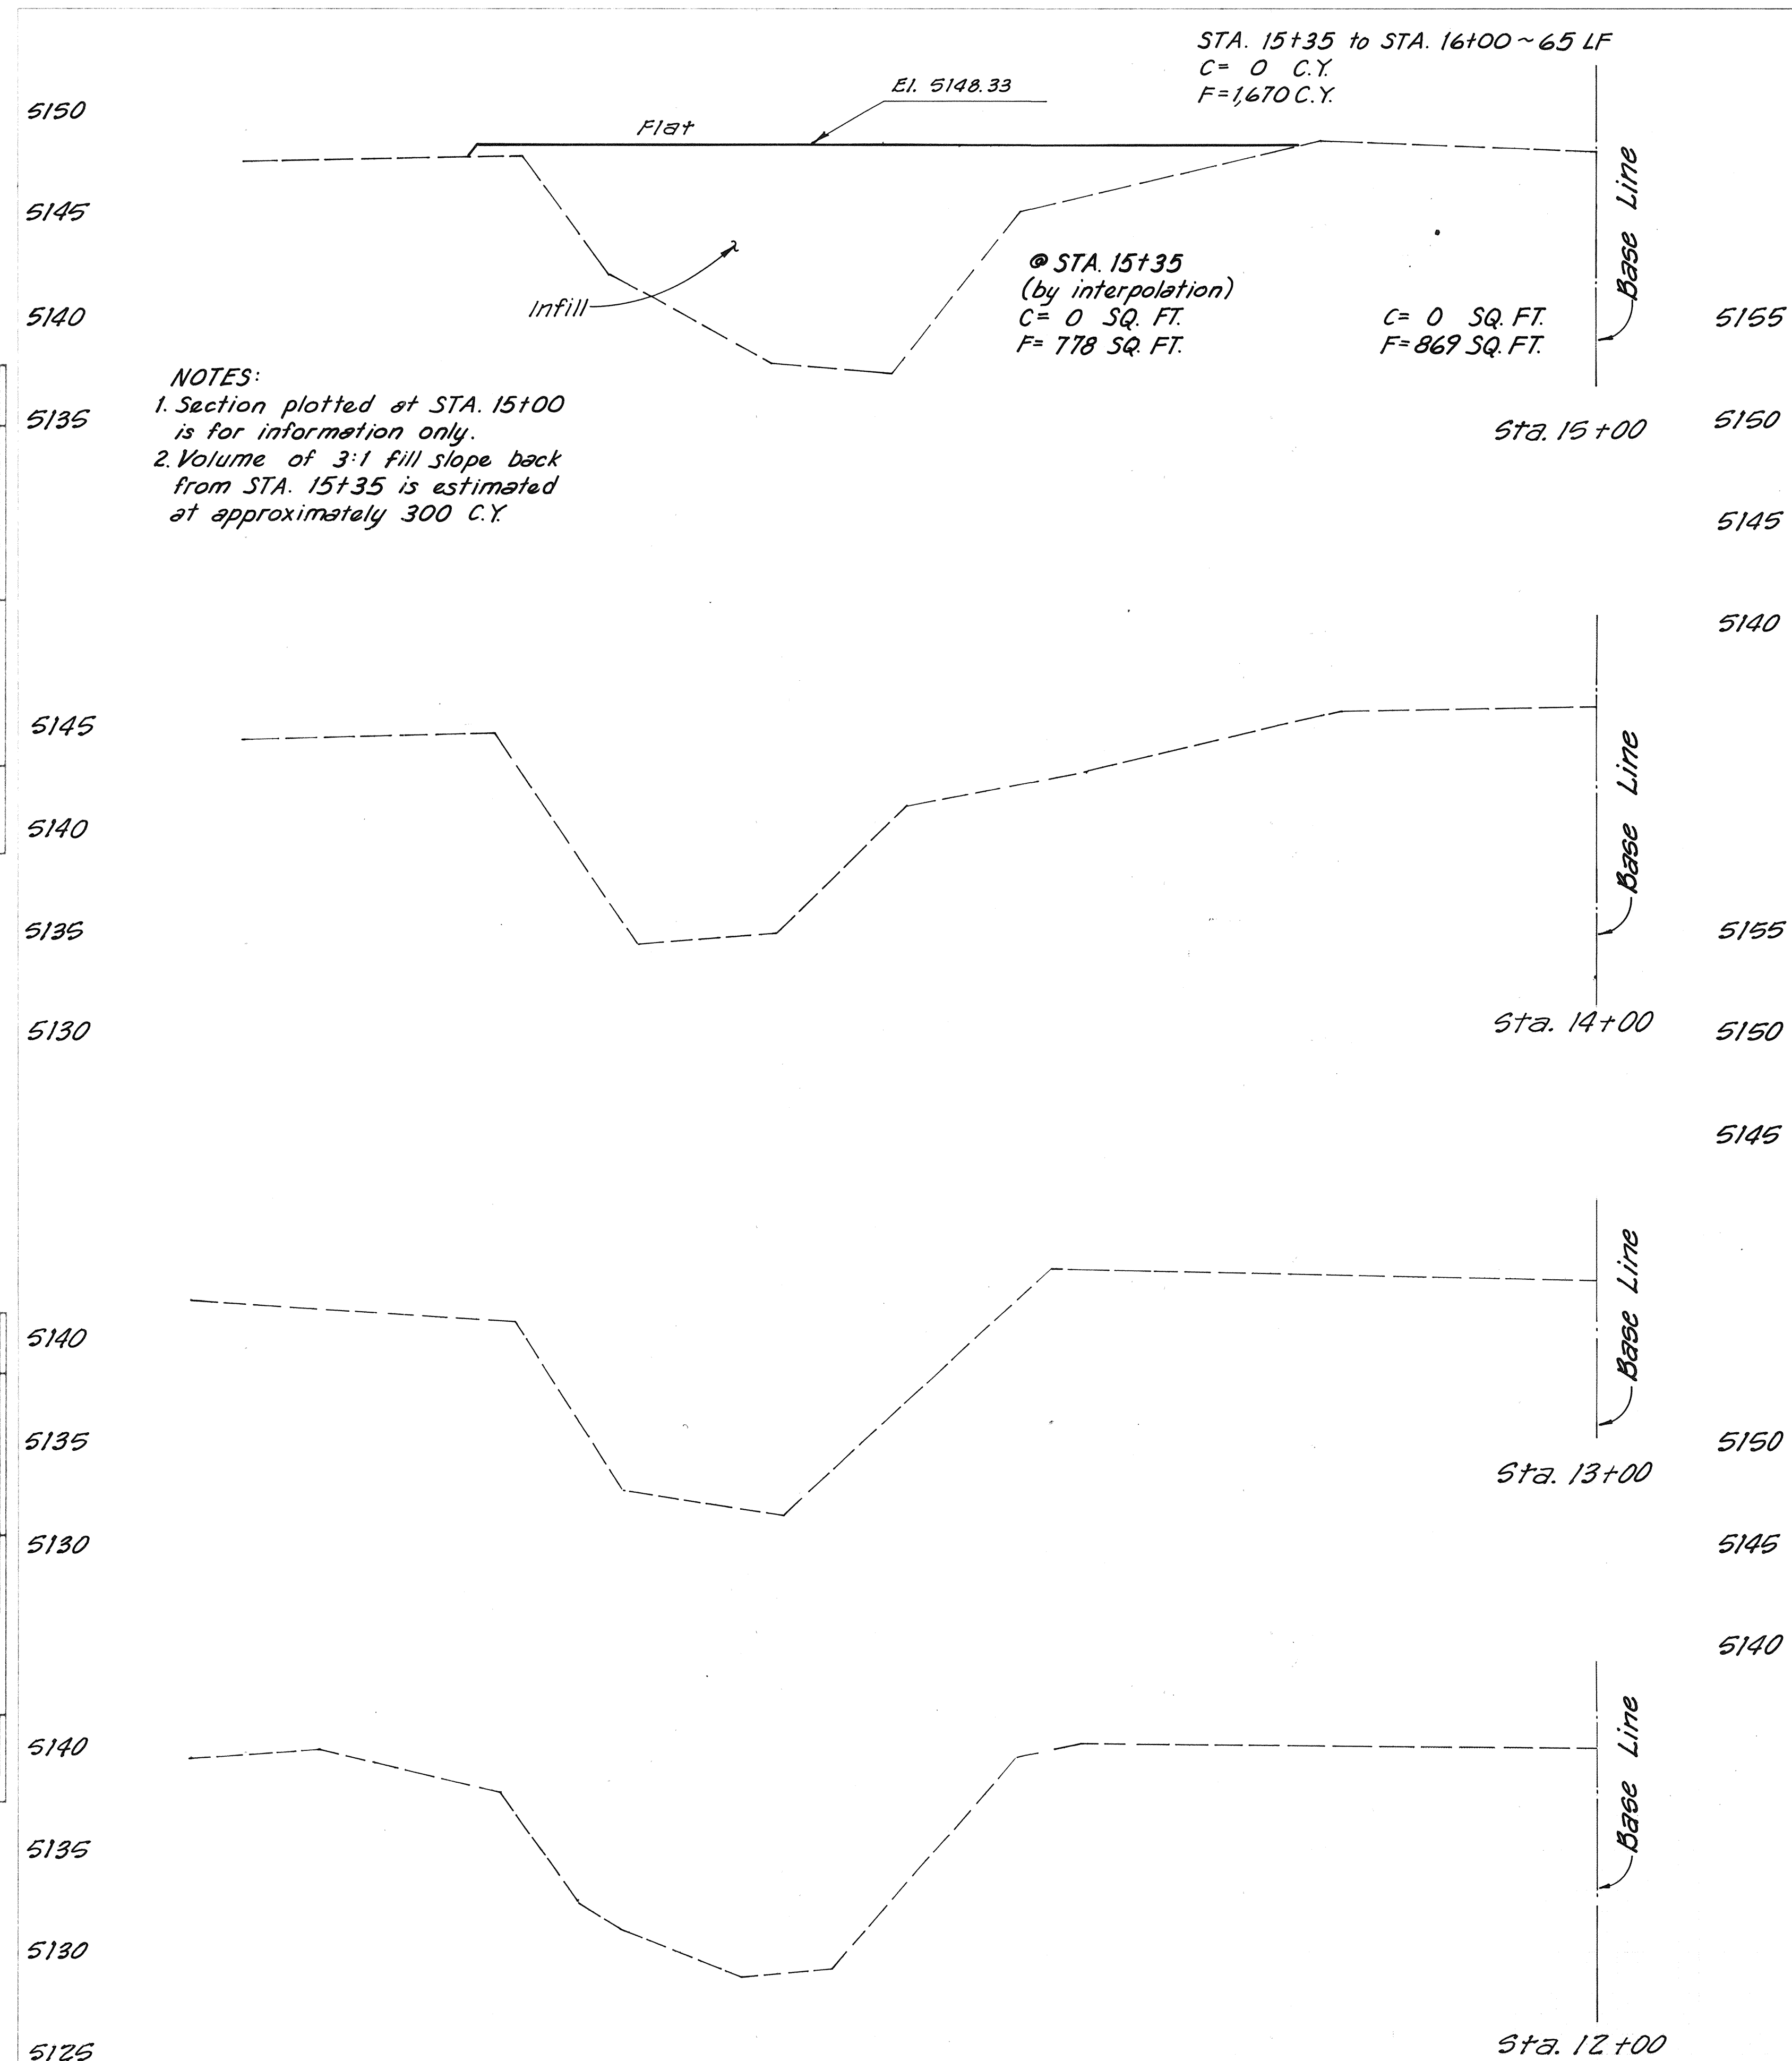

RECORD DRAWING  
DATE JUN 24 1981

**AMAFCA**

WESTGATE DIVERSION CHANNELS  
SNOW VISTA CHANNEL - PHASE I

OLD AMOLE ARROYO  
CROSS SECTIONS

|            |    |            |          |
|------------|----|------------|----------|
| STA. 12+00 | to | STA. 17+35 | HC<br>VE |
|------------|----|------------|----------|

**GORDON HERKENHOFF & ASSOCIATES, INC.**  
ENGINEERS • PLANNERS  
ALBUQUERQUE NEW MEXICO

RAWN BY  
BLS

DATE  
AR. 1981

**SCALE**  
HORIZ. 1" = 20'  
VERT. 1" = 5'

**S, INC.**

MEXICO