

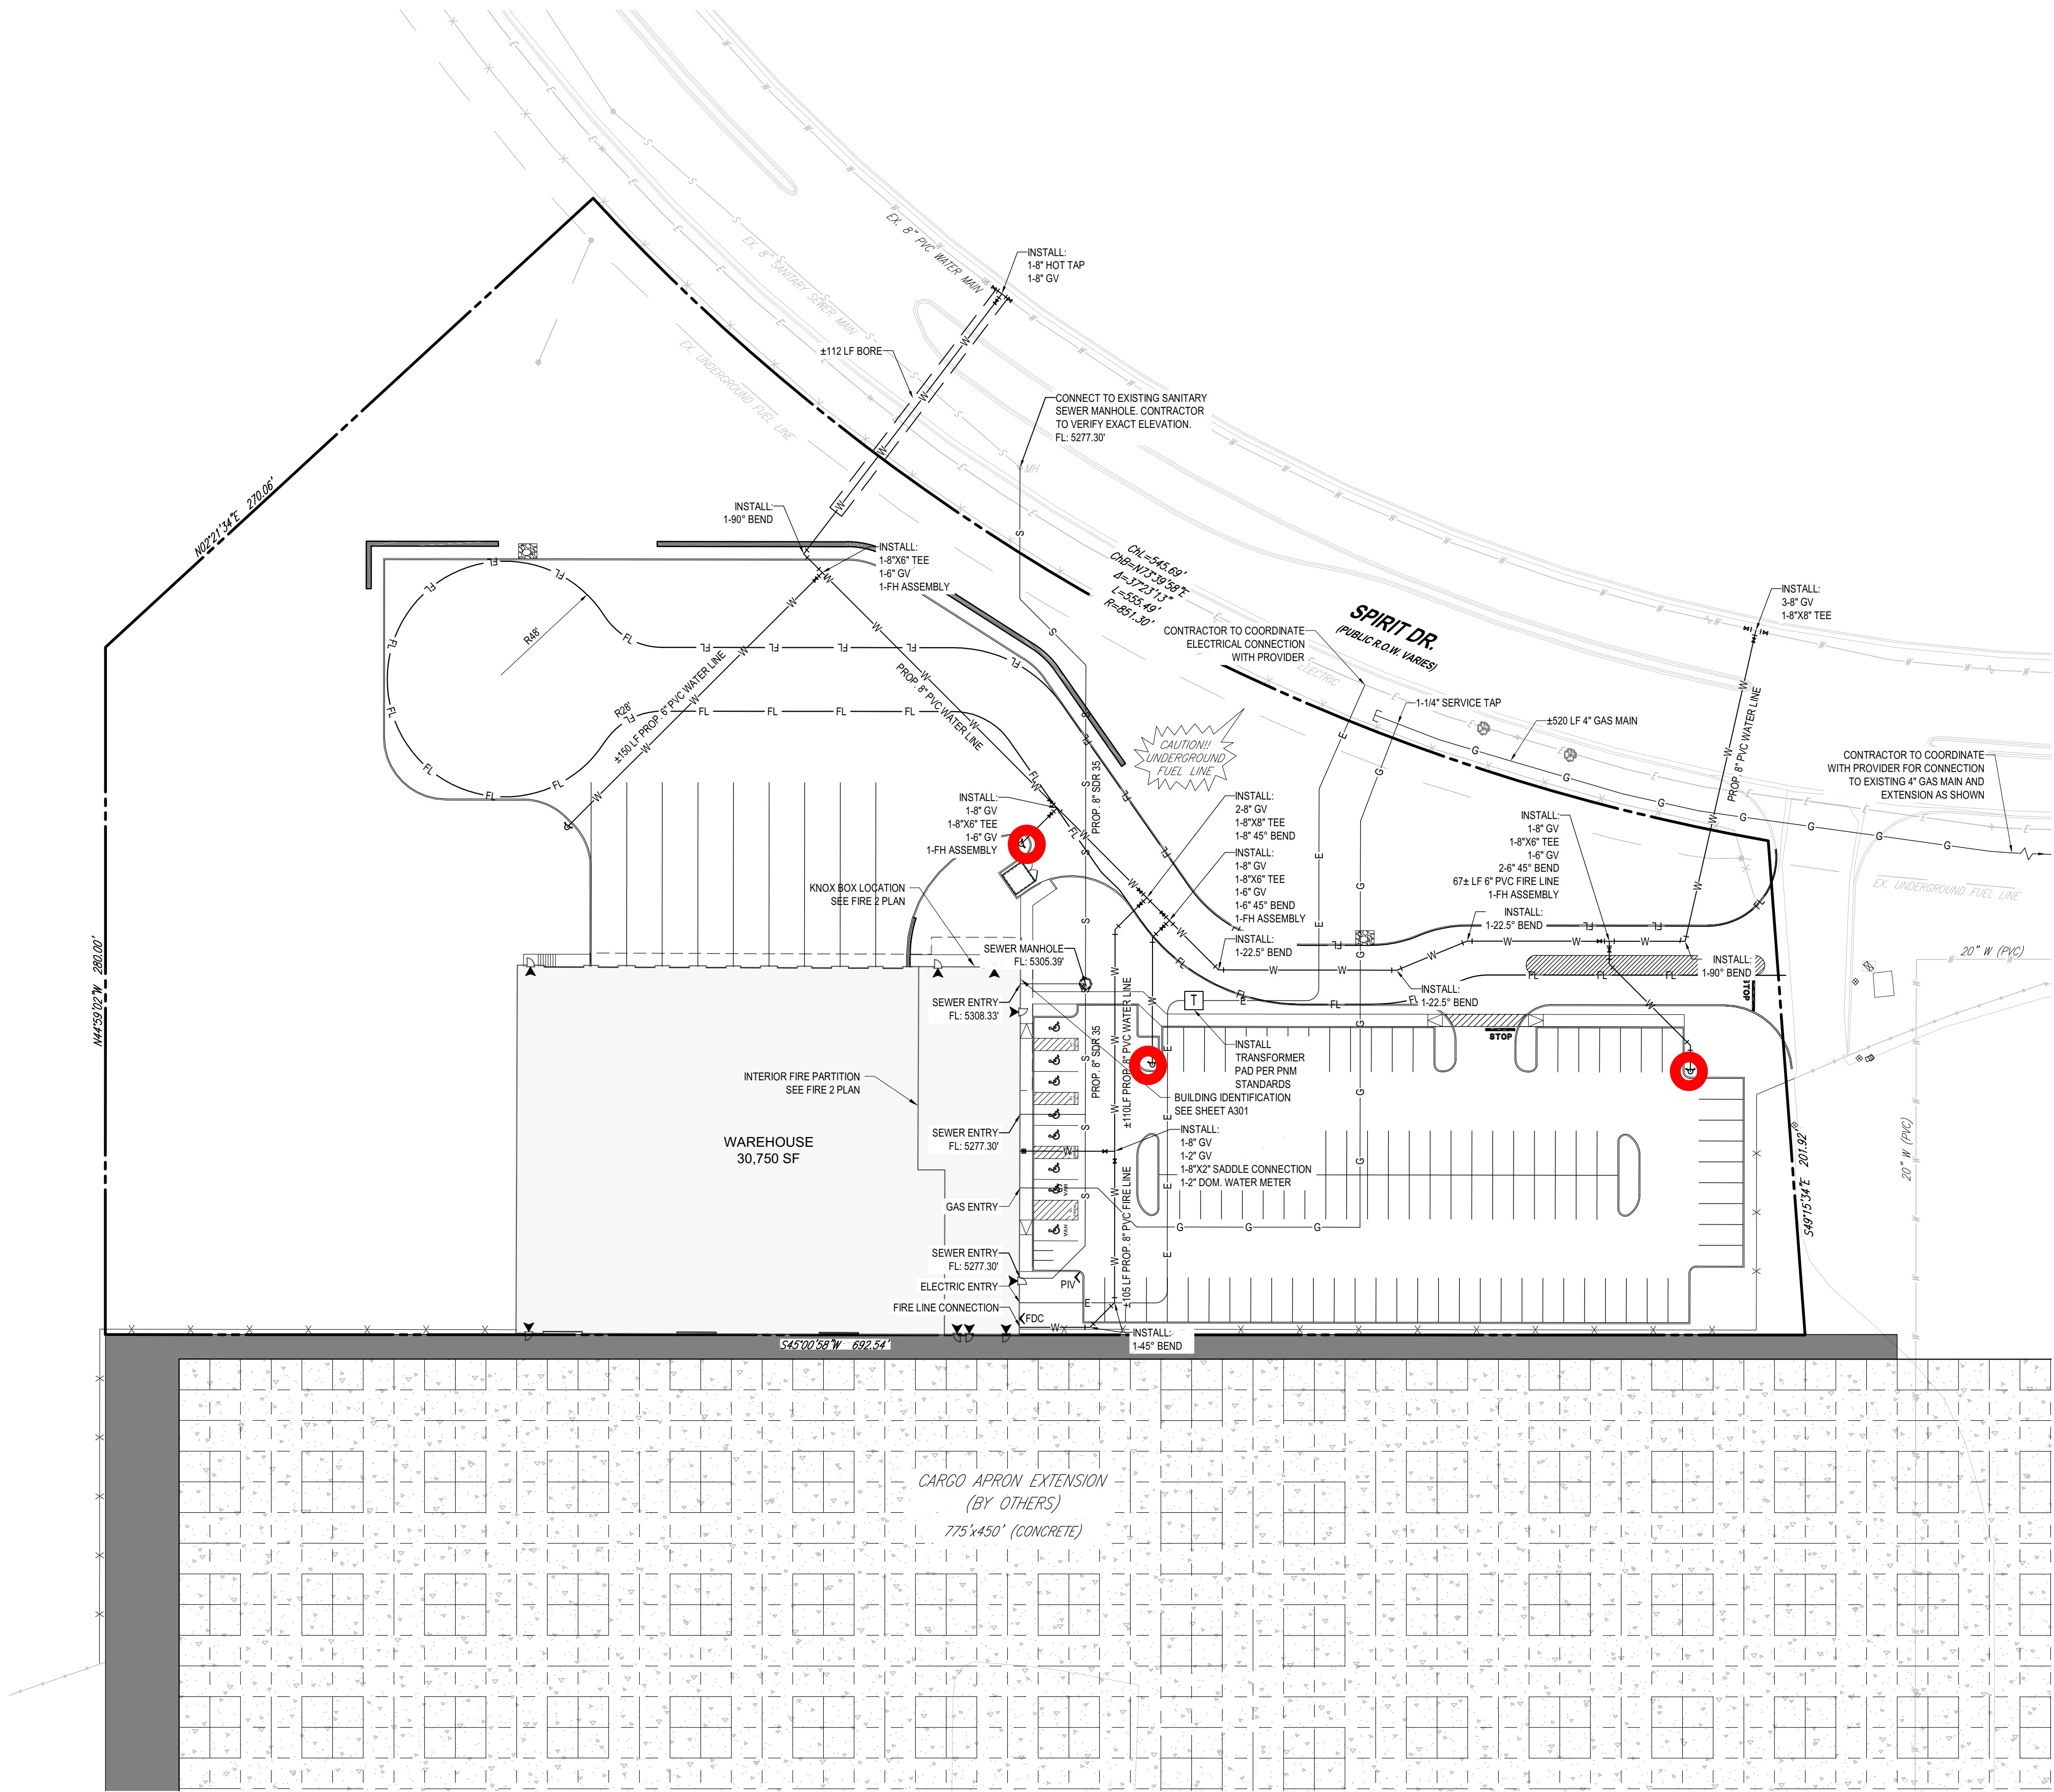


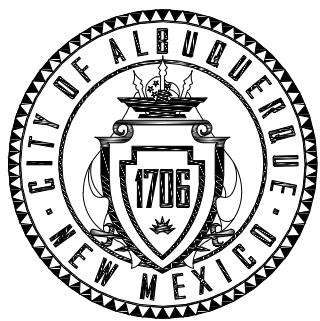

SCALE: 1" : 1000'

LEGEND		
EXISTING NOTE	TYPICAL NOTE TEXT	PROPOSED NOTE
SL	SANITARY SEWER LATERAL	SL
W	UNDERGROUND WATER LINE	W
E	UNDERGROUND ELECTRIC LINE	E
G	UNDERGROUND GAS LINE	G
OH	OVERHEAD WIRE	OH
T	UNDERGROUND TELEPHONE LINE	T
C	UNDERGROUND FIBER OPTIC LINE	FO
	UNDERGROUND CONDUIT	
	STORM SEWER	
S	SANITARY SEWER MAIN	S
HY	HYDRANT	HY
S	SANITARY MANHOLE	S
D	STORM MANHOLE	D
WM	WATER METER	WM
WV	WATER VALVE	WV
GV	GAS VALVE	GV
GM	GAS METER	GM
TES	TYPICAL END SECTION	TES
H	HEADWALL OR ENDWALL	H
YI	YARD INLET	YI
CI	CURB INLET	CI
CO	CLEAN OUT	CO
EM	ELECTRIC MANHOLE	EM
TM	TELEPHONE MANHOLE	TM
EB	ELECTRIC BOX	EB
EP	ELECTRIC PEDESTAL	EP
MW	MONITORING WELL	MW
TP	TEST PIT	TP

CALL NM ONE-CALL
SYSTEM SEVEN (7) DAYS
PRIOR TO ANY EXCAVATION

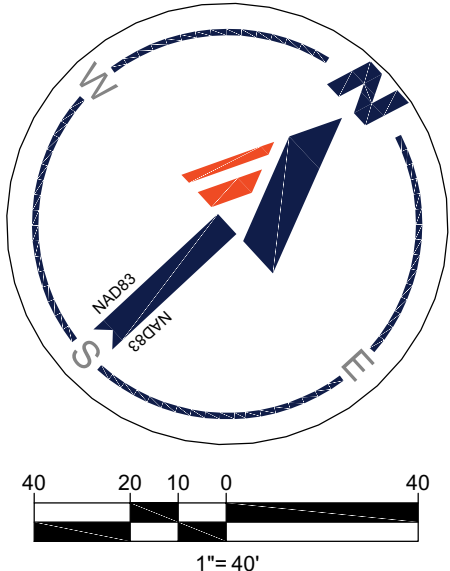

CITY OF ALBUQUERQUE
DEPARTMENT OF MUNICIPAL DEVELOPMENT
ENGINEERING DIVISION

FIRE 1 PLAN

DESIGN REVIEW COMMITTEE	CITY ENGINEER APPROVAL	ZONE MAP NO. NR-SU
		CITY PROJECT NO. 000000
		SHEET NO. FIRE 1

CONSULTANTS

BOHLER

SITE CIVIL AND CONSULTING ENGINEERING
LAND SURVEYING
PROGRAM MANAGEMENT
LANDSCAPE ARCHITECTURE
PLANNING
PERMITTING SERVICES
TRANSPORTATION SERVICES

BENCH MARKS

BM#1
TOP OF SANITARY SEWER MANHOLE
ELEVATION = 5284.30'



SEAL		DESCRIPTION		CONTRACTOR:	
		NO.	DATE	BY	
		AS-BUILT INFORMATION			
		WORK STAKED BY:	DATE:		
		INSPECTOR'S ACCEPTANCE BY:	DATE:		
		FIELD VERIFICATION BY:	DATE:		
		DRAWINGS CORRECTED BY:	DATE:		

DESIGNED BY: AAA
DRAWN BY: AAA
CHECKED BY: DOC
DATE 9/2021