CITY OF ALBUQUERQUE

Planning Department Alan Varela, Director



Mayor Timothy M. Keller

February 3, 2023

Dean Cardwell, P.E. Bohler 6017 Main St. Frisco, TX 75034

RE: KABQ Cargo Facility 3724 Spirit Dr. SE Permanent C.O. – Accepted Engineer's Certification Date: 02/02/23 Engineer's Stamp Date: 08/01/22 Hydrology File: P15D004

Dear Mr. Cardwell:

PO Box 1293

Based on the Certification received 02/03/23 and site visit on 11/08/22, this letter serves as a "green tag" from Hydrology Section for a Permanent Certificate of Occupancy to be issued by the Building and Safety Division.

Albuquerque

If you have any questions, please contact me at 924-3995 or <u>rbrissette@cabq.gov</u>.

NM 87103 Sincerely,

Renée C. Brissette

www.cabq.gov

Renée C. Brissette, P.E. CFM Senior Engineer, Hydrology Planning Department




City of Albuquerque

Planning Department Development & Building Services Division DRAINAGE AND TRANSPORTATION INFORMATION SHEET (REV 10/2018)

Project Title:	_Building Permi	t #: Hydrology File #:
DRB#:	EPC#:	Work Order#:
Legal Description:		
City Address:		
Applicant:		Contact:
Address:		
		E-mail:
Other Contact:		Contact:
Address:		
		E-mail:
TYPE OF DEVELOPMENT: PLAT (# 6	of lots) RE	SIDENCE DRB SITE ADMIN SITE
IS THIS A RESUBMITTAL? Yes	No	
DEPARTMENT:TRAFFIC/TRANSPORT	TATION	HYDROLOGY/DRAINAGE
Check all that Apply:		TYPE OF APPROVAL/ACCEPTANCE SOUGHT: BUILDING PERMIT APPROVAL
TYPE OF SUBMITTAL: ENGINEER/ARCHITECT CERTIFICATIO PAD CERTIFICATION CONCEPTUAL G & D PLAN GRADING PLAN DRAINAGE MASTER PLAN DRAINAGE REPORT FLOODPLAIN DEVELOPMENT PERMIT ELEVATION CERTIFICATE CLOMR/LOMR TRAFFIC CIRCULATION LAYOUT (TCL TRAFFIC IMPACT STUDY (TIS) OTHER (SPECIFY) PRE-DESIGN MEETING?	APPLIC .)	CERTIFICATE OF OCCUPANCY PRELIMINARY PLAT APPROVAL SITE PLAN FOR SUB'D APPROVAL SITE PLAN FOR BLDG. PERMIT APPROVAL FINAL PLAT APPROVAL SIA/ RELEASE OF FINANCIAL GUARANTEE FOUNDATION PERMIT APPROVAL GRADING PERMIT APPROVAL SO-19 APPROVAL PAVING PERMIT APPROVAL GRADING/ PAD CERTIFICATION WORK ORDER APPROVAL CLOMR/LOMR FLOODPLAIN DEVELOPMENT PERMIT OTHER (SPECIFY)
	•	
COA STAFF:		BMITTAL RECEIVED:

FEE PAID:

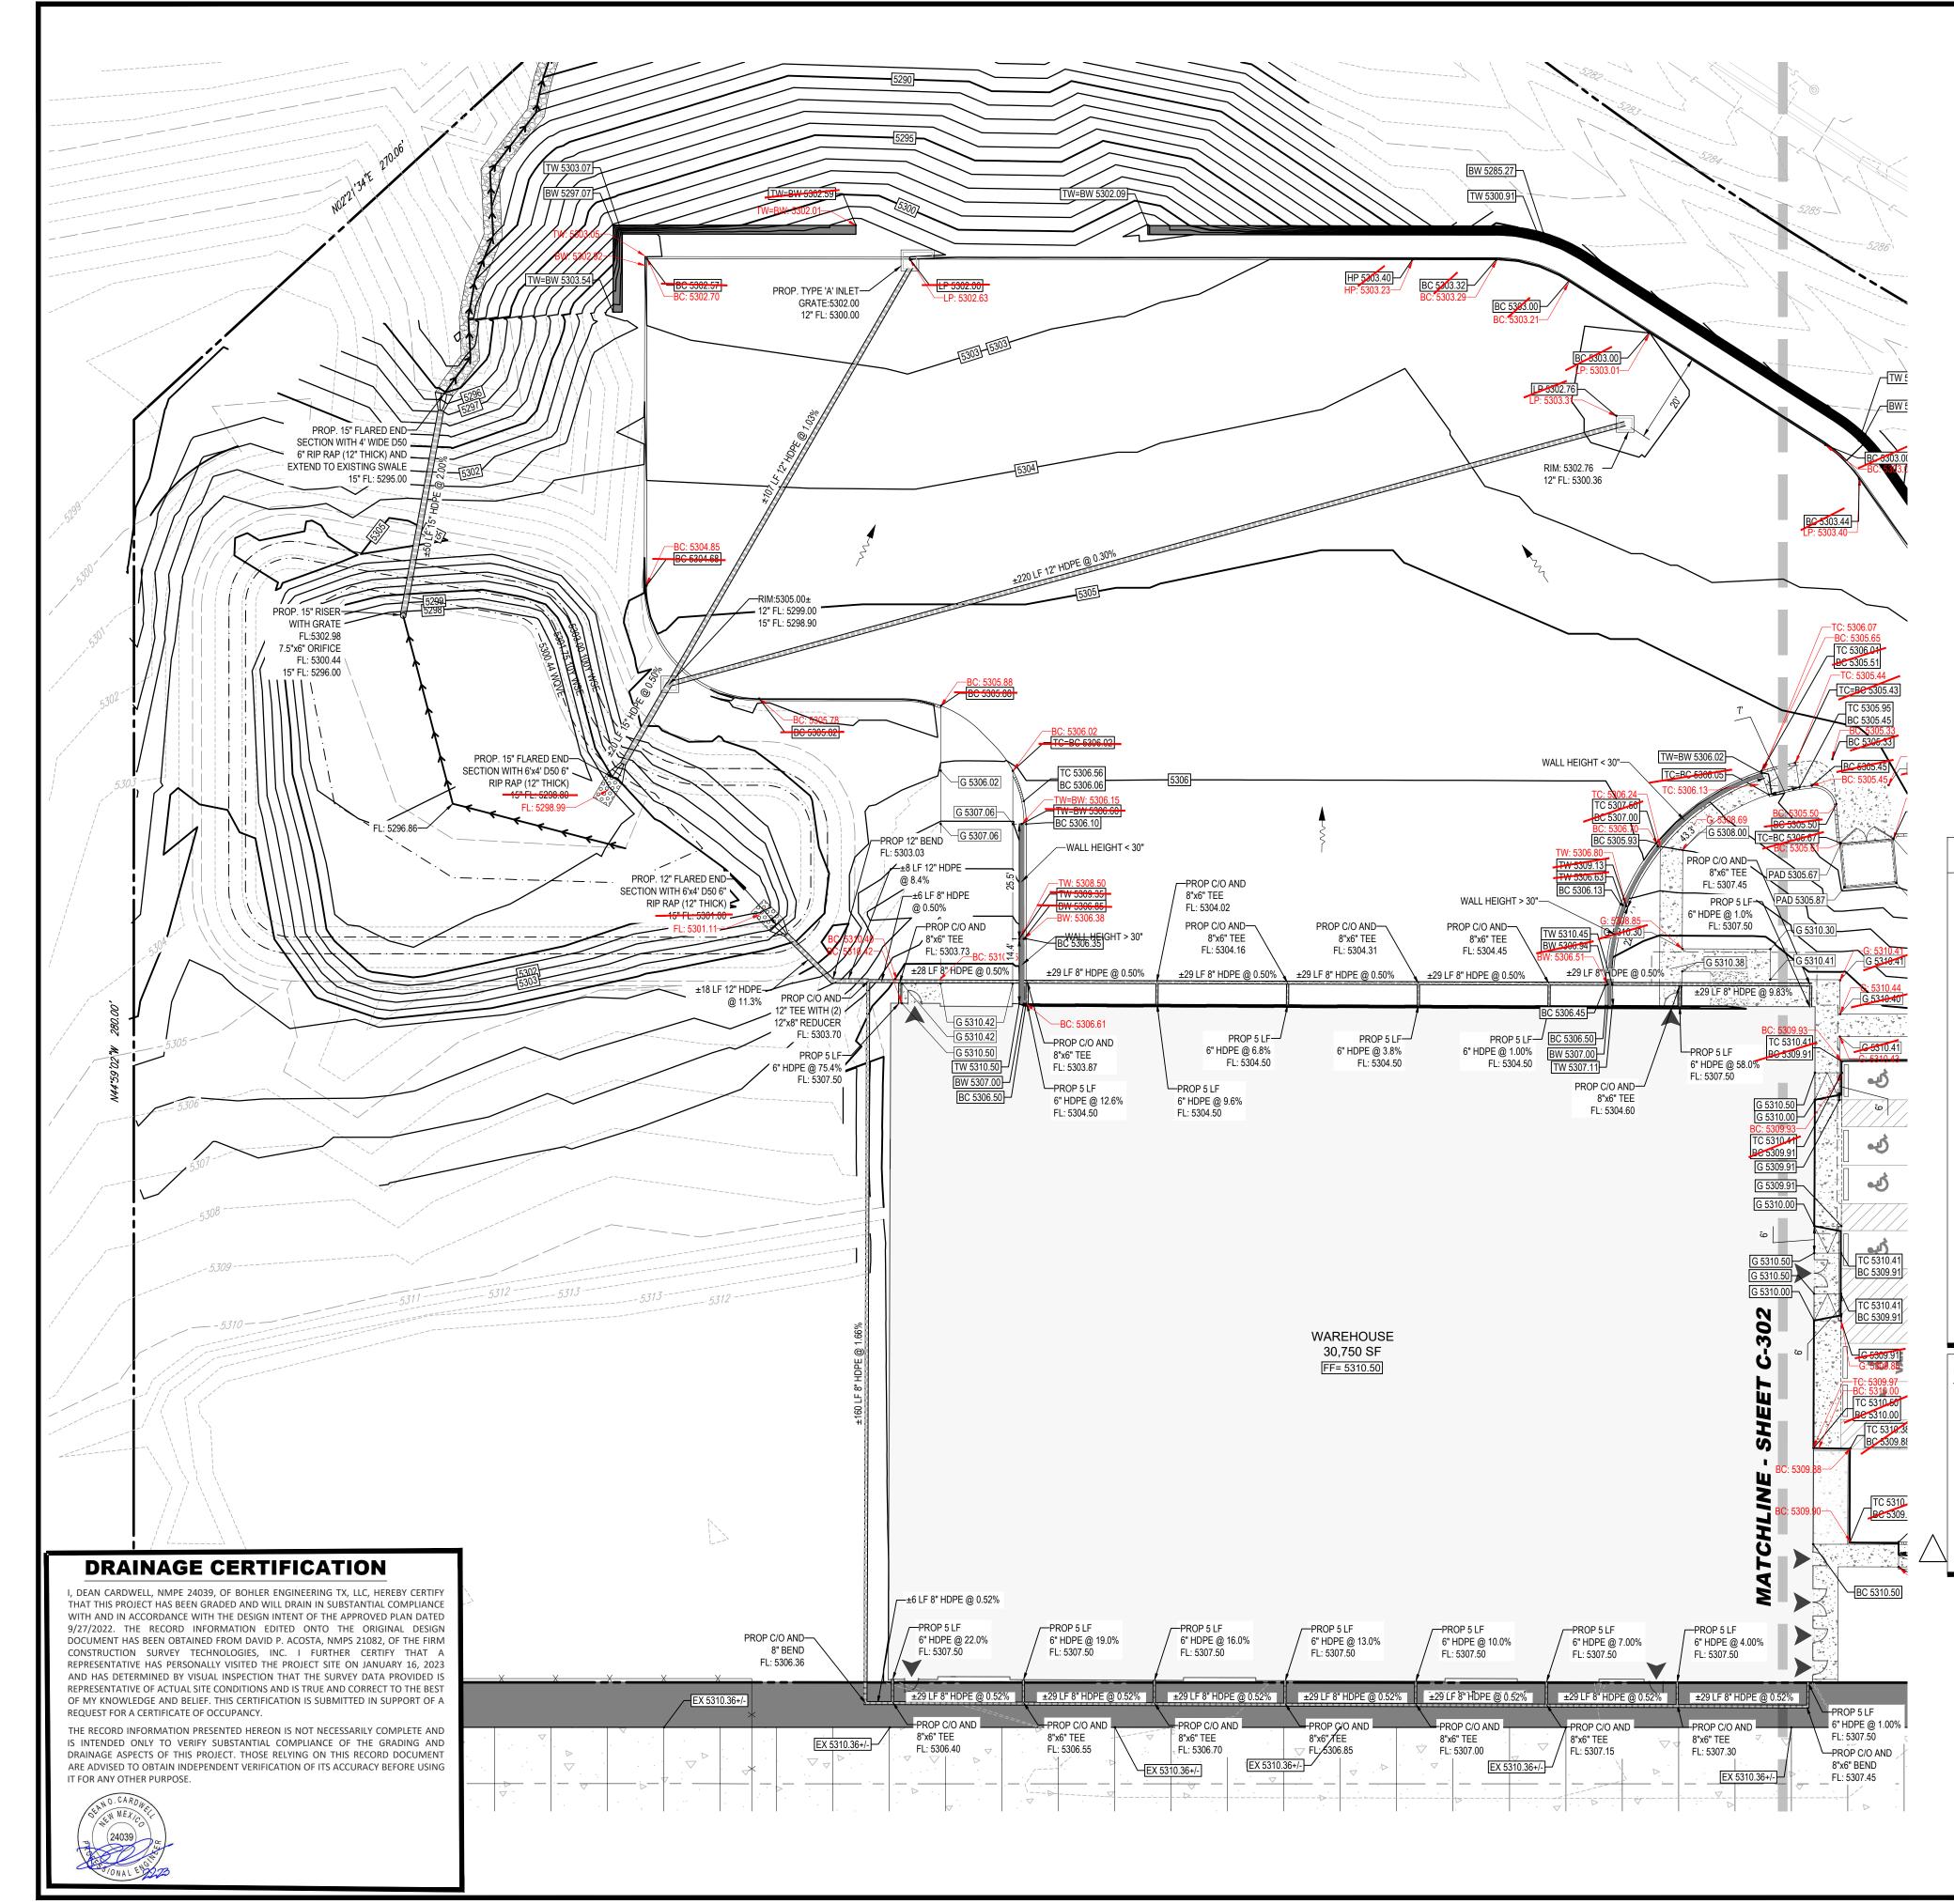

LEASE DESCRIPTION

BEGINNING AT THE NORTHEAST CORNER (IDENTIFIED AS A, WHICH LAYS APPROXIMA S19°01'34"W A DISTANCE OF 5019.24' FROM CONTROL POINT "AP-101", WHENCE THE CA NE CORNER OF SECTION 9 IS S83°44'52"W. DISTANCE OF 1618.99.

THENCE: S45°00'19"W A DISTANCE OF 692.5 SOUTHWEST CORNER IDENTIFIED AS B.

THENCE: DEPARTING FROM SAID POINT N44 DISTANCE OF 280.00' TO AN ANGLE POINT II ASC.

THENCE: DEPARTING FROM SAID POINT N2° DISTANCE OF 270.06' TO THE NORTHWEST IDENTIFIED AS D .

THENCE: ALONG A CURVE TO THE RIGHT W OF 37°17'53", A RADIUS OF 853.25', A LENGT TO AN ANGLE POINT IDENTIFIED AS E .

THENCE: DEPARTING FROM SAID POINT S49 DISTANCE OF 201.92' TO THE BEGINNING NO CORNER OF SAID LEASE, IDENTIFIED AS A

THE ABOVE DESCRIBED LEASE CONTAINS 5 MORE OR LESS.

EXISTING CONDITIONS

THE PROJECT IS LOCATED ON A 5-ACRE LEASE TRACT WITHIN THE SUNPORT AIRPORT PROPERTY AND IS ON THE SOUTH SIDE OF SPIRIT DRIVE ADJACENT TO SECURITY GATE F-1F. IT WAS USED PREVIOUSLY AS AN AIRPORT VIEWING AREA AND HAS A SMALL GRAVEL DRIVE AND PARKING LOT WHICH ARE LOCATED C A 'FLAT' AREA ON TOP OF A LARGE SLOPED HILLSIDE DOWN TO SPIRIT DRIVE THE GRADES OF WHICH EXCEED 20% WITH A VERTICAL DROP OF APPROXIMATE 30'-50'. THE PROJECT IS LOCATED IN ZONE 2 WITH AREAS IN LAND TREATMENT AREAS C AND D. THE EXISTING STORMWATER DISCHARGES UNDETAINED TO ROADSIDE SWALE ON THE SOUTH SIDE OF SPIRIT DRIVE WHICH IS DIRECTED TO AN INLET NEAR THE INTERSECTION OF SPIRIT DRIVE AND UNIVERSITY BOULEVARD. IN REVIEW OF THE PREVIOUSLY APPROVED DRAINAGE REPORT FOR THE ABQ AIRPORT THE PROJECT IS LOCATED IN SUB-BASIN #1202 WHICH IS THE HEADWATERS FOR DRAINAGE BASIN UE AND HAS A MAXIMUM ALLOWABLE RELEASE RATE OF 2.06 CFS/ACRE FOR THE 100-YEAR 6-HOUR STORM EVENT

PROPOSED CONDITIONS

HE FLOW AND STORAGE ARE DIVIDED BETWEEN THREE BASINS AREAS WITH DETAILS AS FI OF WHICH 0.059 AC-FT IS RESERVED FOR STORMWATER QUALITY. STORMWATER QUALITY.

OFFSITE RUNOFF: THIS IS THE AREA IS LOCATED BETWEEN THE SITE IMPROVEMENTS AND SPIRIT DRIVE AND WILL GENERALLY CONTINUE TO RUNOFF TO THE ROADSIDE DRAINAGE SWALE ALONG SPIRIT DRIVE SIMILAR TO THE EXISTING CONDITION. IN TOTAL, THERE ARE FOUR SUB-BASINS CONTAINING APPROXIMATELY 1.09-ACRES OF THE 5.00-ACRE PROJECT AREA ALL OF WHICH IS TREATMENT D LAND AREA. FOR THE 100-YEAR STORM EVENT THIS GENERATES 4.18 CFS OF STORMWATER FLOW AND REQUIRES 0.12 AC-FT OF DETENTION STORAGE, OF WHICH THERE IS NO STORMWATER QUALITY REQUIREMENT AS THERE IS NO PERVIOUS AREA IN THIS BASIN. ADDITIONALLY, THERE IS NO DETENTION FACILITY FOR THIS BASIN, THEREFORE, POND A AND POND B HAVE BEEN OVERSIZED TO ACCOUNT FOR THE VOLUME REQUIREMENTS OF THIS BASIN.

ONE OTHER ITEM OF NOTE, THE PREVIOUSLY APPROVED STUDY FOR THE AIRPORT RESTRICTS THE RELEASE RATE FOR THIS SITE TO 2.06 CFS/ACRE, OR 10.30 CFS FOR THE 5-ACRE PROJECT. AS NOTED ABOVE, THE CALCULATED RUNOFF TOTALS 18.89 CFS. THIS HAS BEEN ACCOUNTED FOR IN THE POND ROUTING MODEL FOR POND A AND POND B AS PERFORMED WITH HEC_HMS.

GRADING NOTES:

- 1. SEE PLAN SHEET C-701 FOR DETENTIO 2. STABILIZE ALL POND SLOPES WITH NAT
- (MUST MEET CGP 2.2.14b). 3. FEDERAL EMERGENCY MANAGEMENT A REFERENCING FLOOD INSURANCE RAT DATE 09/26/2008, INDICATES THIS PARC
- MINIMAL FLOOD HAZARD). 4. ALL CURBS ARE 6" TALL UNLESS NOTE
- RETAINING WALL ELEVATIONS DEPICT GRO ELEVATIONS ARE TYPICALLY 0.5' ABOVE G



VICINITY MAP **IDO ZONE ATLAS NUMBER P-15**



SCALE: 1" : 1000'

N:	LEG	END
OF THE LEASE, ATELY	PROPERTY LINE/LEASE LINE	
A SURVEY ALCULATED A	PROPOSED CONTOURS	85
54' TO THE	MAJOR EXISTING CONTOUR	<i> 85</i>
44°59'41"W A	MINOR EXISTING CONTOUR	84
IDENTIFIED	GROUND SPOT ELEVATION	<u>, </u>
2°20'55"E A CORNER	LOW/HIGH POINT ELEVATION	- LP 83.00
WITH A DELTA TH OF 555.44'	MATCH EXST. GRADE	MATCH EX. G 527.1+/-
49°16'13"E A	TOP CURB / BOTTOM CURB	TC 83.00 BC 83.00
IORTHEAST	DRAINAGE ARROW	~ ~~
5.00 ACRES	SWALE	$\rightarrow \rightarrow \rightarrow \rightarrow$

GRADING NARRATIVE

THE EXISTING DRAINAGE PATTERNS FOR THE PROJECT WILL REMAIN GENERALLY UNCHANGED. HOWEVER, WITH THE ADDITION OF A BUILDING, PAVED DRIV AND PARKING LOTS, AND OTHER IMPROVEMENTS THE IMPERVIOUS AREA IS INCREASING SUCH THAT THE STORMWATER RUNOFF IS INCREASING. THIS INCREASE NECESSITATES THE ADDITION OF A DETENTION FACILITY TO PROTECT THE DOWNSTREAM AREAS WITHIN DRAINAGE BASIN UE. IN ADDITION, THE DETENTION FACILITIES WILL BE DESIGNED TO HOLD AND CONTAIN THE STORMWATER QUALITY EVENT. THE PROJECT IS DIVIDED INTO THREE BASIN AREAS. B, AND OFFSITE RUNOFF, RESPECTIVELY. OVERALL, THE 100-YEAR FLOW RATE FOR THE PROJECT IS 18.89 CFS WITH A REQUIRED 0.73 AC-FT STORAGE VOLUM


BASIN AREA A: THIS AREA GENERALLY INCLUDES THE BUILDING, TRUCK COURT, TRUCK DOCKS AND THE MAIN ACCESS DRIVE WHICH IS COMPRISED OF APPROXIMATELY 2.54-ACRES OF THE 5.00-ACRE PROJECT AREA AND WHICH INCLUDES 0.82-ACRES OF TREATMENT C AND 1.72-ACRES OF TREATMENT D LAN AREAS. FOR THE 100-YEAR STORM EVENT THIS GENERATES 9.97 CFS OF STORMWATER FLOW AND REQUIRES 0.40 AC-FT OF DETENTION STORAGE IN POND A

BASIN AREA B: THIS AREA GENERALLY INCLUDES THE PARKING LOT AND A PORTION OF THE MAIN ACCESS ROADWAY WHICH IS COMPRISED OF APPROXIMATELY 1.09-ACRES OF THE 5.00-ACRE PROJECT AREA ALL OF WHICH IS TREATMENT D LAND AREA. FOR THE 100-YEAR STORM EVENT THIS GENERATES 4.75 CFS OF STORMWATER FLOW AND REQUIRES 0.21 AC-FT OF DETENTION STORAGE IN POND B OF WHICH 0.031 AC-FT IS RESERVED FOR

			SIDE	FOR	DUM	ACCI		N		TANC	
			5/22	3/22	/22	2/22	TE	AS-BUILT INFORMATION) ВҮ:	ACCEPTANC	FIELD VERIFICATION BY:
			07/15/22	07/18/22	08/01/22	11/22/22	DATE	NFO	NED	R'S,	IFIC
ATIVE SEED ANL) AGGREGATE MULCH OR EQUAL			0	0				STA	СТО	VER
TE MAP, MAP N	A FIRMETTE PUBLISHED 09/14/2021, UMBER 35001C0344G EFFECTIVE & LOCATED IN ZONE X (AREA OF		6	10	11	12	NO.	AS-BU	WORK STAKED BY:	INSPECTOR'S	FIELD
				SIG							
ED OTHERWISE.		CALL NM ONE-CALL	DRAWN BY: JJB								
ROUND ELEVATIC GROUND.	DN. TOP OF WALL AND END OF WALL	SYSTEM SEVEN (7) DAYS PRIOR TO ANY EXCAVATION	СН	CHECKED BY: DOC							
		PRIOR TO ANY EAGAVATION	DA	TE			11	/2	202	2	
	A STATE ALL IN THE REAL PROPERTY OF THE REAL PROPER	CITY OF ALBUQUERQUE DEPARTMENT OF MUNICIPAL DEVELOPMENT ENGINEERING DIVISION									
2		grading and				AC	θE	F		A٢	1
	WEX LEAD	(1 ()F	2)						
n	DESIGN REVIEW COMMITTEE	CITY ENGINEER APPROVAL	zo	NEI	MAF	P NC		R-	-Sl	J	
20			CIT	ΓY Ρ	ROJ	JEC) . 00	00	0	
			SH	EET	NO).					

CONSULTANTS				SITE CIVIL AND CONSULTING ENGINEERING		LANDSCAPE ARCHITECTURE SUSTAINABLE DESIGN	PERMITING SERVICES TRANSPORTATION SERVICES	HE INFORMATION, DESIGNAMO CONTREPT OF THE PLANA REPROPENDENT AND AND LIND THE CONFLO POLISIO DRAIN PURPORES WITTEN AUTHORIZZITON FROM SOME REVOLVE APPROPENDIS SIGNED AND SEALLED FLANS SHALL BE UTILIZE FOR CONFTRUCTION INVERDES © 8 DOME ERF	
0		3 73	BC FA		LI ' RIT	TY DR.	SE)	
BENCH MARKS	BM#1 TOP OF SANITARY	SEWER MANHOLE ELEVATION = 5284.30'	BM#2 NO.4 REBAR WI CAP IN RAW LAND	NOKTIFING: 465944.03 EASTING: 386672.45 ELEVATION: 5298.69	BM #3	NO.4 KEBAK W/ CAP IN KAW LAND NORTHING: 466213.90 FASTING: 386683.57	ELEVATION: 5270.95'	BM #4 NO.4 REBAR W/CAP IN RAW LAND NORTHINS: 466367.43'	EASTING: 387207.10'
SEAL				BY					
		DING		NO	OR:	DATE:	DATE:	DATE:	DATE:
SIDEWALK REMOVAL	FORKLIFT RAMP PAVEMENT	DUMPSTER PATH SIDEWALK GRADING	ACCESSIBLE PARKING REVISION	DESCRIPTION	ION CONTRACTOR:		TANCE BY:	BY:	TED BY:
SIDEW	1	1/22	11/22/22	DATE	AS-BUILT INFORMATION	WORK STAKED BY:	NSPECTOR'S ACCEPTANCE BY:	FIELD VERIFICATION BY:	DRAWINGS CORRECTED BY:
07/15/22 SIDEW/	07/18/22	08/01/22	÷			U)	Ü		

C - 301

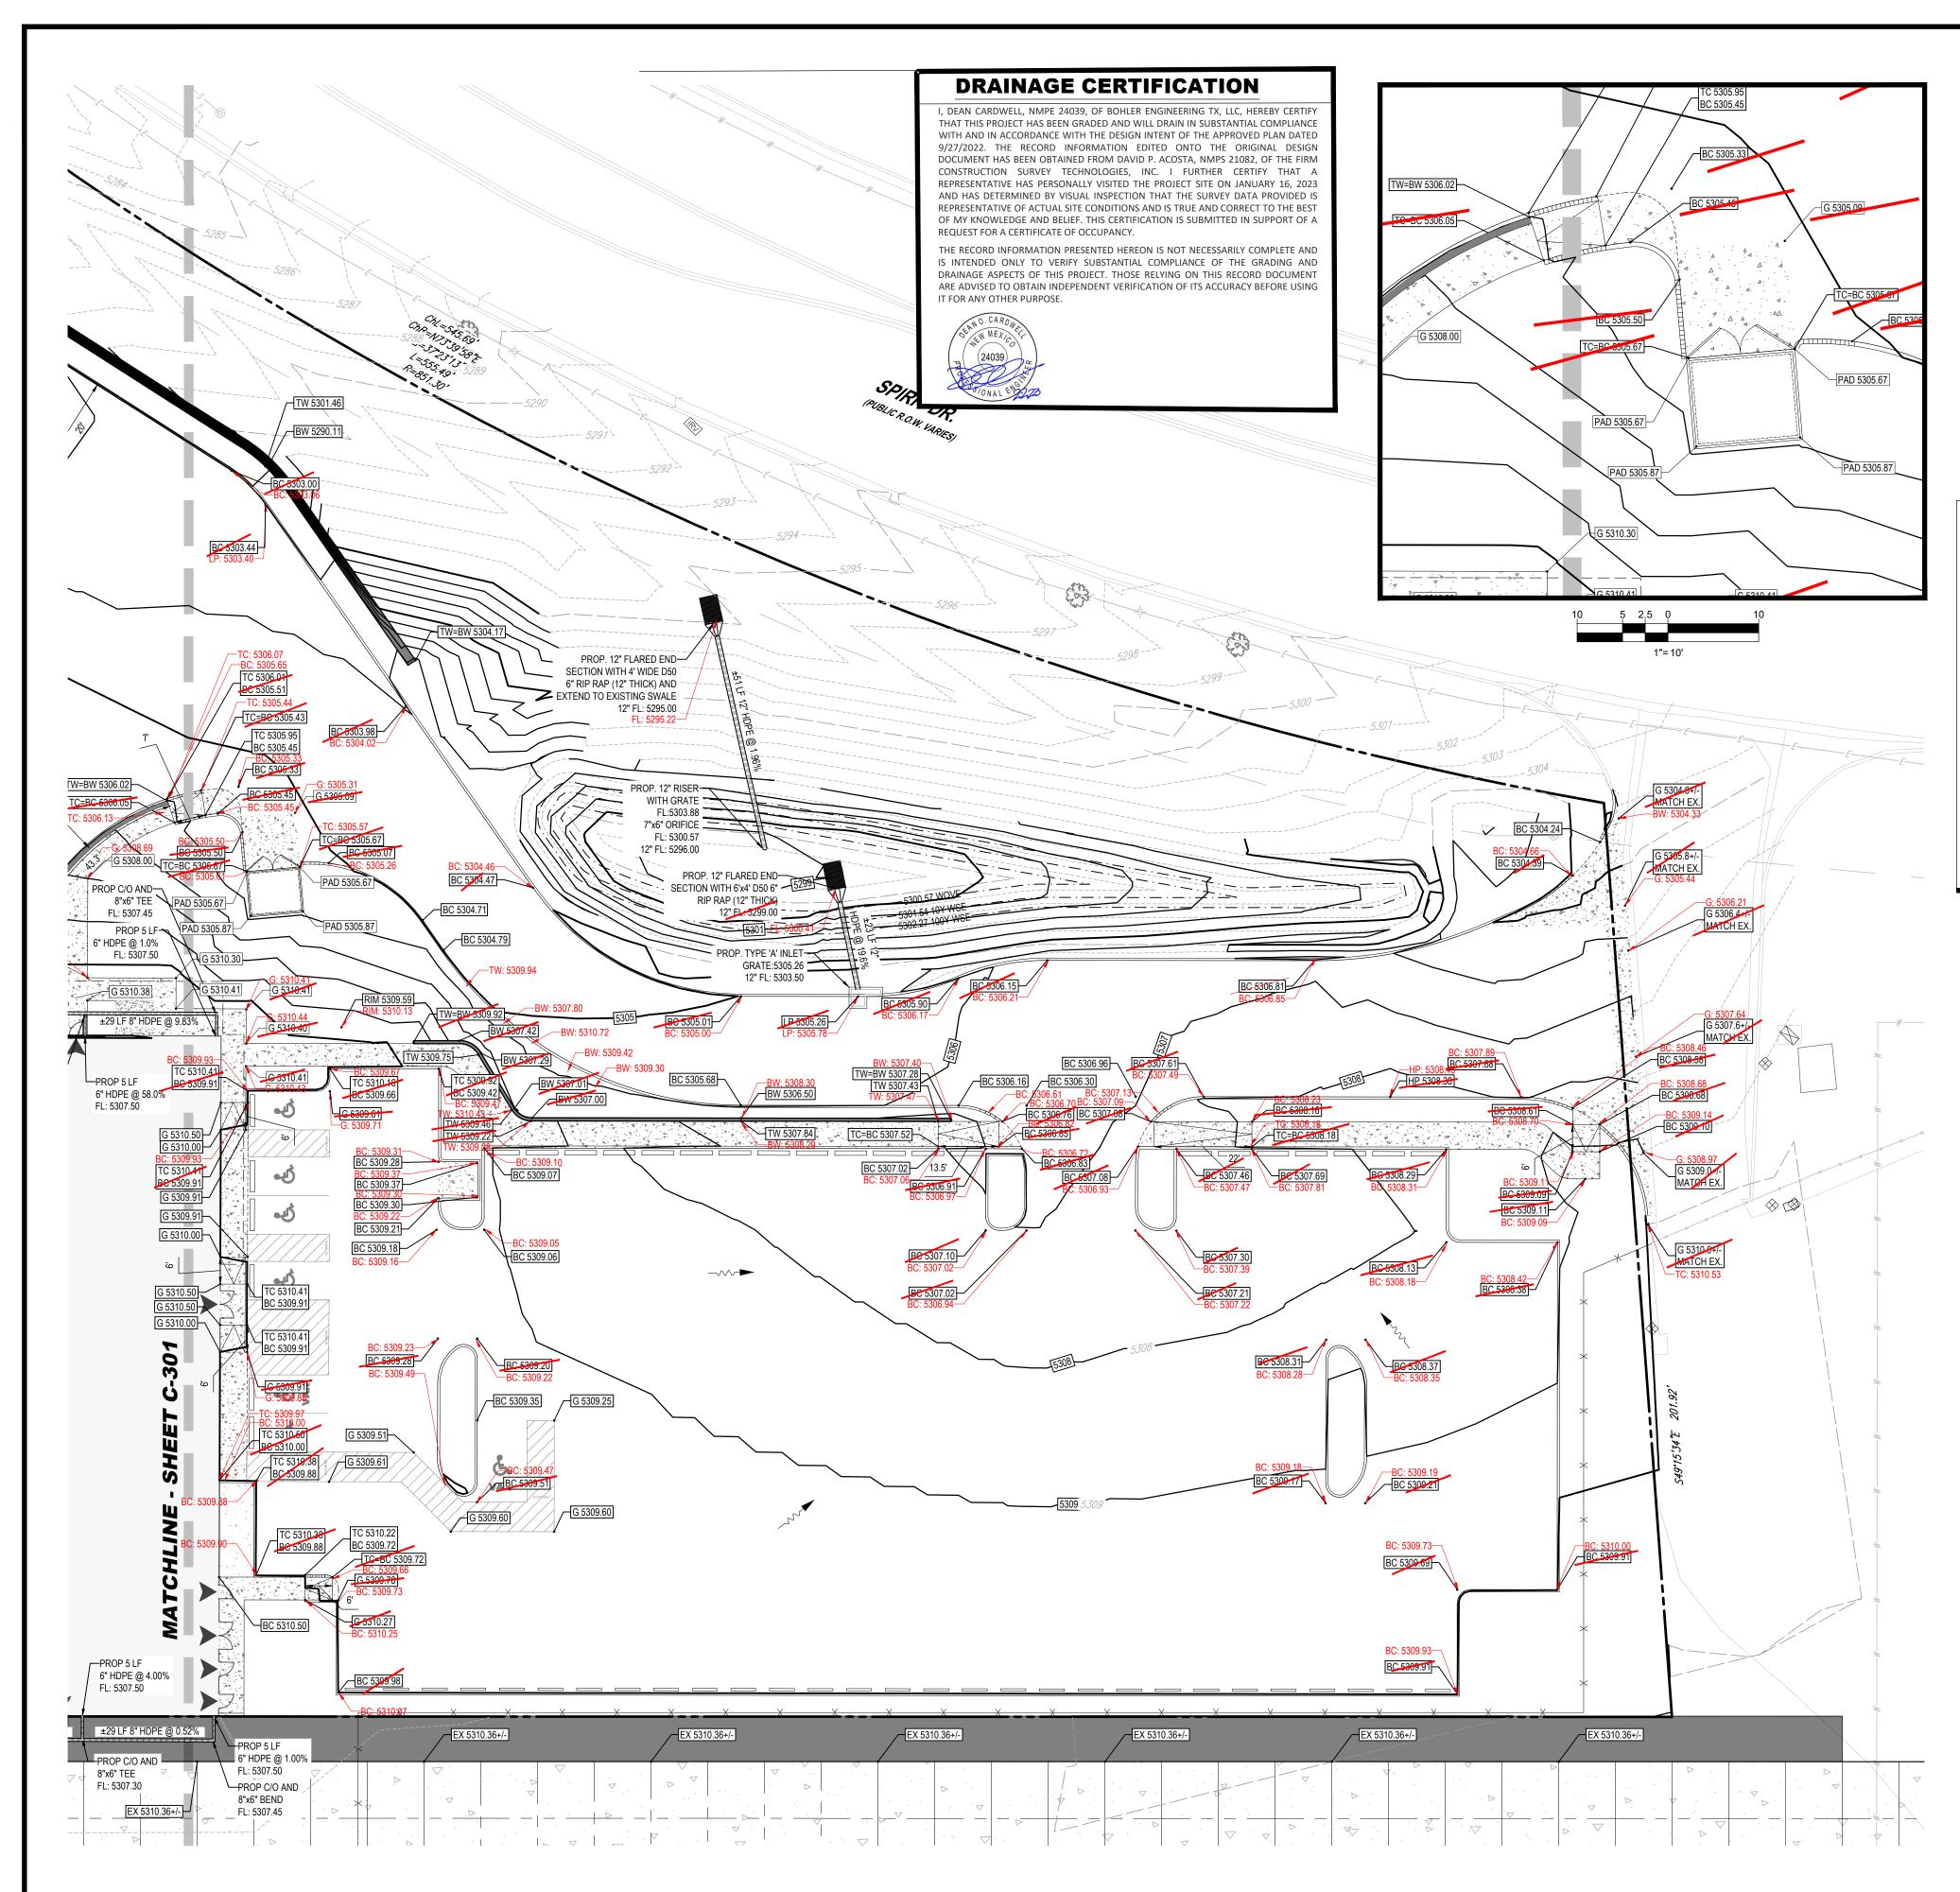



LEASE DESCRIPTION

BEGINNING AT THE NORTHEAST CORNER O IDENTIFIED AS A, WHICH LAYS APPROXIMA S19°01'34"W A DISTANCE OF 5019.24' FROM CONTROL POINT "AP-101", WHENCE THE CAL NE CORNER OF SECTION 9 IS S83°44'52"W. / DISTANCE OF 1618.99.

THENCE: S45°00'19"W A DISTANCE OF 692.54 SOUTHWEST CORNER IDENTIFIED AS B.

THENCE: DEPARTING FROM SAID POINT N44 DISTANCE OF 280.00' TO AN ANGLE POINT ID ASC

THENCE: DEPARTING FROM SAID POINT N2° DISTANCE OF 270.06' TO THE NORTHWEST IDENTIFIED AS D.

THENCE: ALONG A CURVE TO THE RIGHT W OF 37°17'53", A RADIUS OF 853.25', A LENGTH TO AN ANGLE POINT IDENTIFIED AS E .

THENCE: DEPARTING FROM SAID POINT S49 DISTANCE OF 201.92' TO THE BEGINNING NO CORNER OF SAID LEASE, IDENTIFIED AS A .

THE ABOVE DESCRIBED LEASE CONTAINS 5 MORE OR LESS.

EXISTING CONDITIONS

THE PROJECT IS LOCATED ON A 5-ACRE LEASE TRACT WITHIN THE SUNPORT AIRPORT PROPERTY AND IS ON THE SOUTH SIDE OF SPIRIT DRIVE ADJACENT TO SECURITY GATE F-1F. IT WAS USED PREVIOUSLY AS AN AIRPORT VIEWING AREA AND HAS A SMALL GRAVEL DRIVE AND PARKING LOT WHICH ARE LOCATED ON A 'FLAT' AREA ON TOP OF A LARGE SLOPED HILLSIDE DOWN TO SPIRIT DRIVE THE GRADES OF WHICH EXCEED 20% WITH A VERTICAL DROP OF APPROXIMATELY 30'-50'. THE PROJECT IS LOCATED IN ZONE 2 WITH AREAS IN LAND TREATMENT AREAS C AND D. THE EXISTING STORMWATER DISCHARGES UNDETAINED TO A ROADSIDE SWALE ON THE SOUTH SIDE OF SPIRIT DRIVE WHICH IS DIRECTED TO AN INLET NEAR THE INTERSECTION OF SPIRIT DRIVE AND UNIVERSITY BOULEVARD. IN REVIEW OF THE PREVIOUSLY APPROVED DRAINAGE REPORT FOR THE ABQ AIRPORT THE PROJECT IS LOCATED IN SUB-BASIN #1202 WHICH IS THE HEADWATERS FOR DRAINAGE BASIN UE AND HAS A MAXIMUM ALLOWABLE RELEASE RATE OF 2.06 CFS/ACRE FOR THE 100-YEAR 6-HOUR STORM EVENT.

PROPOSED CONDITIONS

THE EXISTING DRAINAGE PATTERNS FOR THE PROJECT WILL REMAIN GENERALLY UNCHANGED. HOWEVER, WITH THE ADDITION OF A BUILDING, PAVED DRIVES AND PARKING LOTS, AND OTHER IMPROVEMENTS THE IMPERVIOUS AREA IS INCREASING SUCH THAT THE STORMWATER RUNOEE IS INCREASING. THIS INCREASE NECESSITATES THE ADDITION OF A DETENTION FACILITY TO PROTECT THE DOWNSTREAM AREAS WITHIN DRAINAGE BASIN UE. IN ADDITION, THE DETENTION FACILITIES WILL BE DESIGNED TO HOLD AND CONTAIN THE STORMWATER QUALITY EVENT. THE PROJECT IS DIVIDED INTO THREE BASIN AREAS, A, B, AND OFFSITE RUNOFF, RESPECTIVELY. OVERALL, THE 100-YEAR FLOW RATE FOR THE PROJECT IS 18.89 CFS WITH A REQUIRED 0.73 AC-FT STORAGE VOLUME. THE FLOW AND STORAGE ARE DIVIDED BETWEEN THREE BASINS AREAS WITH DETAILS AS FOLLOWS:

BASIN AREA A: THIS AREA GENERALLY INCLUDES THE BUILDING, TRUCK COURT, TRUCK DOCKS AND THE MAIN ACCESS DRIVE WHICH IS COMPRISED OF APPROXIMATELY 2.54-ACRES OF THE 5.00-ACRE PROJECT AREA AND WHICH INCLUDES 0.82-ACRES OF TREATMENT C AND 1.72-ACRES OF TREATMENT D LAND AREAS. FOR THE 100-YEAR STORM EVENT THIS GENERATES 9.97 CFS OF STORMWATER FLOW AND REQUIRES 0.40 AC-FT OF DETENTION STORAGE IN POND A OF WHICH 0.059 AC-FT IS RESERVED FOR STORMWATER QUALITY. BASIN AREA B: THIS AREA GENERALLY INCLUDES THE PARKING LOT AND A PORTION OF THE MAIN ACCESS ROADWAY WHICH IS COMPRISED OF

APPROXIMATELY 1.09-ACRES OF THE 5.00-ACRE PROJECT AREA ALL OF WHICH IS TREATMENT D LAND AREA. FOR THE 100-YEAR STORM EVENT THIS GENERATES 4.75 CFS OF STORMWATER FLOW AND REQUIRES 0.21 AC-FT OF DETENTION STORAGE IN POND B OF WHICH 0.031 AC-FT IS RESERVED FOR STORMWATER QUALITY.

OFFSITE RUNOFF: THIS IS THE AREA IS LOCATED BETWEEN THE SITE IMPROVEMENTS AND SPIRIT DRIVE AND WILL GENERALLY CONTINUE TO RUNOFF TO THE ROADSIDE DRAINAGE SWALE ALONG SPIRIT DRIVE SIMILAR TO THE EXISTING CONDITION. IN TOTAL, THERE ARE FOUR SUB-BASINS CONTAINING APPROXIMATELY 1.09-ACRES OF THE 5.00-ACRE PROJECT AREA ALL OF WHICH IS TREATMENT D LAND AREA. FOR THE 100-YEAR STORM EVENT THIS GENERATES 4.18 CFS OF STORMWATER FLOW AND REQUIRES 0.12 AC-FT OF DETENTION STORAGE, OF WHICH THERE IS NO STORMWATER QUALITY REQUIREMENT AS THERE IS NO PERVIOUS AREA IN THIS BASIN. ADDITIONALLY, THERE IS NO DETENTION FACILITY FOR THIS

BASIN, THEREFORE, POND A AND POND B HAVE BEEN OVERSIZED TO ACCOUNT FOR THE VOLUME REQUIREMENTS OF THIS BASIN. ONE OTHER ITEM OF NOTE, THE PREVIOUSLY APPROVED STUDY FOR THE AIRPORT RESTRICTS THE RELEASE RATE FOR THIS SITE TO 2.06 CFS/ACRE, OR 10.30 CFS FOR THE 5-ACRE PROJECT. AS NOTED ABOVE, THE CALCULATED RUNOFF TOTALS 18.89 CFS. THIS HAS BEEN ACCOUNTED FOR IN THE POND ROUTING MODEL FOR POND A AND POND B AS PERFORMED WITH HEC_HMS.

GRADING NOTES:

- 1. SEE PLAN SHEET C-701 FOR DETENTION POND CROSS-SECTIONS.
- (MUST MEET CGP 2.2.14b).
- MINIMAL FLOOD HAZARD).
- 4. ALL CURBS ARE 6" TALL UNLESS NOTED OTHERWISE.



VICINITY MAP **IDO ZONE ATLAS NUMBER P-15**

SCALE: 1" : 1000'

IECEND

N:	LEG	END
OF THE LEASE, ATELY	PROPERTY LINE/LEASE LINE	
I SURVEY ALCULATED A	PROPOSED CONTOURS	85
54' TO THE	MAJOR EXISTING CONTOUR	<i> 85</i>
44°59'41"W A	MINOR EXISTING CONTOUR	84
IDENTIFIED	GROUND SPOT ELEVATION	<u>∕ - [G 84.00]</u>
2°20'55"E A CORNER	LOW/HIGH POINT ELEVATION	HP 83.00 LP 83.00
VITH A DELTA TH OF 555.44'	MATCH EXST. GRADE	MATCH EX. G 527.1+/-
49°16'13"E A	TOP CURB / BOTTOM CURB	TC 83.00 BC 83.00
ORTHEAST	DRAINAGE ARROW	
5.00 ACRES	SWALE	$\rightarrow\rightarrow\rightarrow\rightarrow$

GRADING NARRATIVE

2. STABILIZE ALL POND SLOPES WITH NATIVE SEED AND AGGREGATE MULCH OR EQUAL

FEDERAL EMERGENCY MANAGEMENT AGENCY, FEMA FIRMETTE PUBLISHED 09/14/2021. REFERENCING FLOOD INSURANCE RATE MAP, MAP NUMBER 35001C0344G EFFECTIVE DATE 09/26/2008, INDICATES THIS PARCEL OF LAND IS LOCATED IN ZONE X (AREA OF

	CONSULTANTS	MT			SITE CIVIL AND CONSULTING ENGINEERING			PERMITTING SERVICES TRANSPORTATION SERVICES	THE INFORMATION, DESIGN AND CONTREPT OF THE PLAN ARE SHALL MOT BE CONFID ON USED FOR ANY PURPOSE MITHOUT PRION WRITTEN ALTHORIZATION FROM BONLER, ONLY APPROVED, SIGNED, AND SEALED FUANS SHALL BE UTLIZED FOR CONSTRUCTION PURPOSES	
30			3 73	FA 30 S	CI Spif	LI ' RIT	TY DR.			
END 	BENCH MARKS	BM#1 TOP OF SANITARY	SEWER MANHOLE ELEVATION = 5284.30'	BM#2 NO.4 REBAR W/ CAP IN RAW LAND	NOKI HING: 465944.03 EASTING: 38662.45' ELEVATION: 5298.69'	BM #3	NO. 4 KEBAK W/ CAP IN KAW LAND NORTHING: 466213.90' FASTING: 386633.57'	ELEVATION: 5270.95'	BM #4 NO. 4 REBAR W/CAP IN RAW LAND NORTHING: 466367.43	EASTING: 387207.10' ELEVATION: 5304.16'
Imatch EX. G 527.1+/- Image: Constraint of the state of the st										
E SOUTH SIDE OF SPIRIT DRIVE LL GRAVEL DRIVE AND PARKING LOT ADES OF WHICH EXCEED 20% WITH A MENT AREAS C AND D. THE EXISTING IS DIRECTED TO AN INLET NEAR THE INAGE REPORT FOR THE ABQ AIRPORT & A MAXIMUM ALLOWABLE RELEASE	SEAL				BY		DATE:	DATE:	DATE:	DATE:
TH THE ADDITION OF A BUILDING, THAT THE STORMWATER RUNOFF IS TREAM AREAS WITHIN DRAINAGE ATER QUALITY EVENT. THE PROJECT IS RATE FOR THE PROJECT IS 18.89 CFS SINS AREAS WITH DETAILS AS ACCESS DRIVE WHICH IS COMPRISED TMENT C AND 1.72-ACRES OF DW AND REQUIRES 0.40 AC-FT OF		/EMENT	DEWALK GRADING	IG REVISION	DESCRIPTION	CONTRACTOR:				
OR THE 100-YEAR STORM EVENT THIS OF WHICH 0.031 AC-FT IS RESERVED ILL GENERALLY CONTINUE TO RUNOFF IERE ARE FOUR SUB-BASINS AND AREA. FOR THE 100-YEAR STORM , OF WHICH THERE IS NO IS NO DETENTION FACILITY FOR THIS NTS OF THIS BASIN. TE FOR THIS SITE TO 2.06 CFS/ACRE, OR 5 BEEN ACCOUNTED FOR IN THE POND	SIDEWALK REMOVAL	FORKLIFT RAMP PAVEMENT	DUMPSTER PATH SIDEWALK GRADING	ACCESSIBLE PARKING REVISION		TION		EPTANCE BY:	N BY:	CTED BY:
n m	07/15/22	07/18/22	08/01/22	11/22/22	DATE	AS-BUILT INFORMATION	WORK STAKED BY:	NSPECTOR'S ACCEPTANCE	FIELD VERIFICATION BY	VGS CORRECTED
CALL NM ONE-CALL SYSTEM SEVEN (7) DAYS PRIOR TO ANY EXCAVATION	DF CH	₽ SIG AW	ΝB	Y:	Ju D	JB JB DC				DRAWINGS
CITY OF AL DEPARTMENT OF MU	BU(NIC	IPA		DE	VE	/	02 PN		IT	
ENGINEER GRADING AND (2 (DF	R A				F		A٢		

	MER ANALASA		
	DESIGN REVIEW COMMITTEE	CITY ENGINEER APPROVAL	ZONE MAP NO.
			NR-SU
			CITY PROJECT NO.
0			000000
			SHEET NO.
1			C-302