


CERTIFICATION FOR PERMANENT CERTIFICATE OF OCCUPANCY

I HEREBY CERTIFY THAT I HAVE INSPECTED THE SITE GRADING AND DRAINAGE IMPROVEMENTS AND THAT THEY HAVE BEEN CONSTRUCTED AND ARE EXPECTED TO FUNCTION IN SUBSTANTIAL COMPLIANCE WITH THE INTENT OF THE APPROVED GRADING AND DRAINAGE PLAN. THE AS-CONSTRUCTED INFORMATION SHOWN ON THIS PLAN WAS PROVIDED BY OTHERS. PROPOSED CONTOURS HAVE NOT BEEN REVISED TO REFLECT AS-CONSTRUCTED ELEVATIONS AND SHOULD BE CONSIDERED APPROXIMATE.

Christopher S. Phillips, P.E.
N.M.P.E. No. 11624

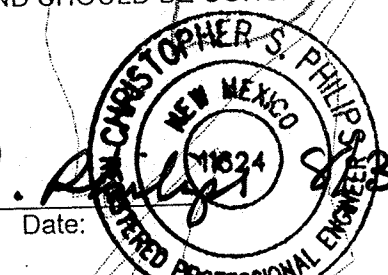

SCALE: 1" = 50'

- LEGEND**
- FEMA FLOOD PLAIN
 - PROPOSED CONDITIONS (PHASE 1) HORIZONTAL LIMITS OF COMPUTED 100-YEAR WATER SURFACES
 - "FUTURE" CONDITIONS DEVELOPED WATERSHED HORIZONTAL LIMITS OF COMPUTED 100-YEAR WATER SURFACES
 - PROPOSED CONDITIONS (PHASE 1) EROSION SETBACK LIMITS FROM ARROYO
 - "FUTURE" CONDITIONS DEVELOPED WATERSHED EROSION SETBACK LIMITS FROM ARROYO

PARCEL "B"

SEE SHEET 5 FOR GRADING IN THIS AREA

CONSTRUCT RUNDOWN PER SECTION B-B, SHEET 6

GRADE ROADWAY PER TYPICAL SECTION A-A, SHEET 6

EXISTING ASPHALT DRIVE TO REMAIN

"FUTURE" CONDITIONS DEVELOPED WATERSHED EROSION SETBACK LIMITS FROM ARROYO

PROPOSED CONDITIONS (PHASE 1) EROSION SETBACK LIMITS FROM ARROYO

"FUTURE" CONDITIONS DEVELOPED WATERSHED EROSION SETBACK LIMITS FROM ARROYO


PROPOSED CONDITIONS (PHASE 1) EROSION SETBACK LIMITS FROM ARROYO

PROPOSED CONDITIONS (PHASE 1) EROSION SETBACK LIMITS FROM ARROYO

"FUTURE" CONDITIONS DEVELOPED WATERSHED EROSION SETBACK LIMITS FROM ARROYO

1	EXTEND RUNDOWN ON SHEETS 4 AND 5	JML	10/97
2	SHOW LOCATIONS OF PROPOSED SEPTIC TANK/LEACH FIELD	JML	12/97
NO.	REVISIONS	BY	DATE

SANTA MARIA DE LA VID CHURCH OVERALL GRADING & DRAINAGE PLAN

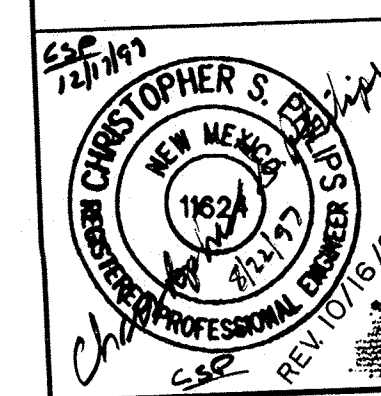


Easterling & Associates, Inc.
CONSULTING ENGINEERS
2600 The American Rd., SE, Suite 100
Rio Rancho, New Mexico 87124
(505) 898-8021 FAX (505) 898-8501








DESIGNED BY JML
DRAWN BY DAH/DWG
CHECKED BY CSP
DATE: 7/97

SHEET 4 OF 6

DWG: T1 PROJECTS 4242 (DWG) PLANS GRADING & DRAINAGE
TIME: 08-21-97 13:11:37

PLAN HOLD INFORMATION
REORDER BY NUMBER 075AR
POSITION USE OF PRINT ON THIS DATE

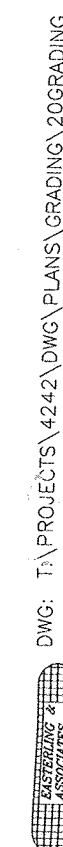

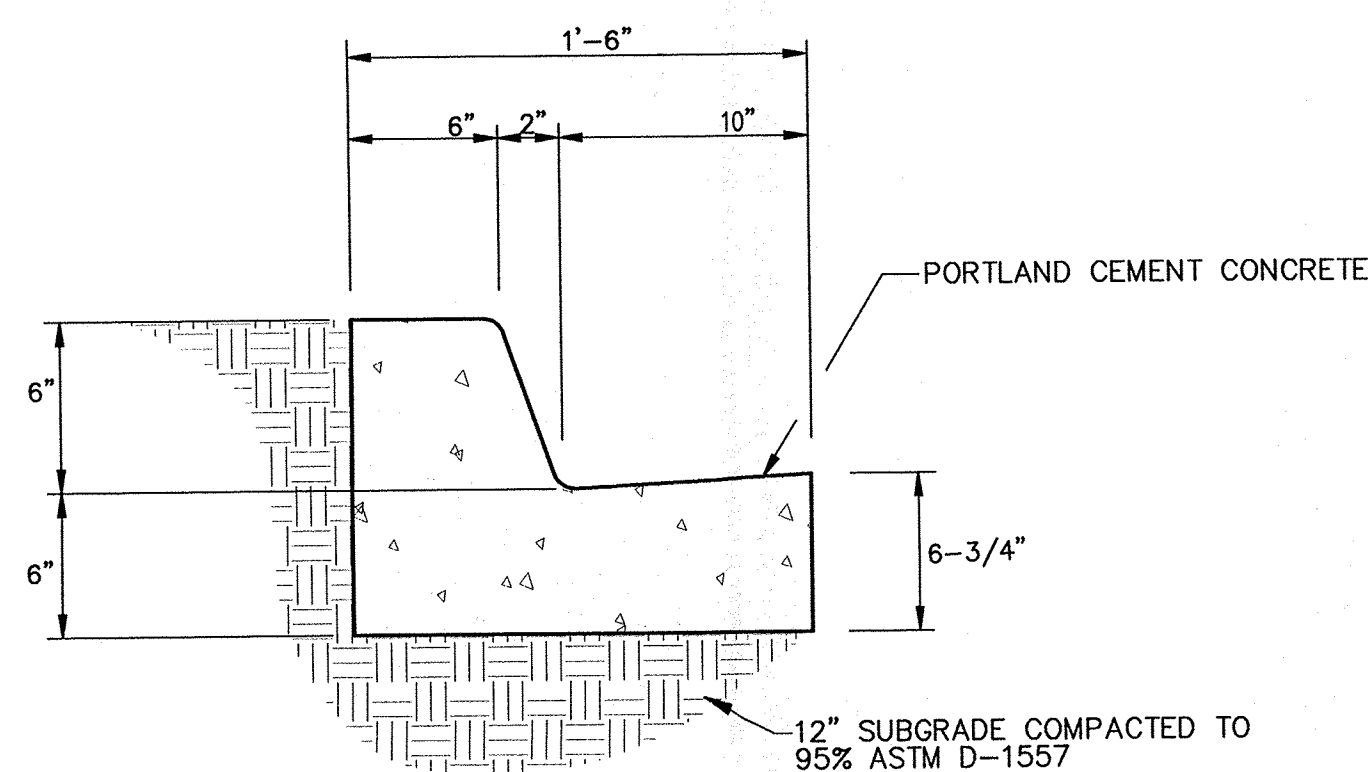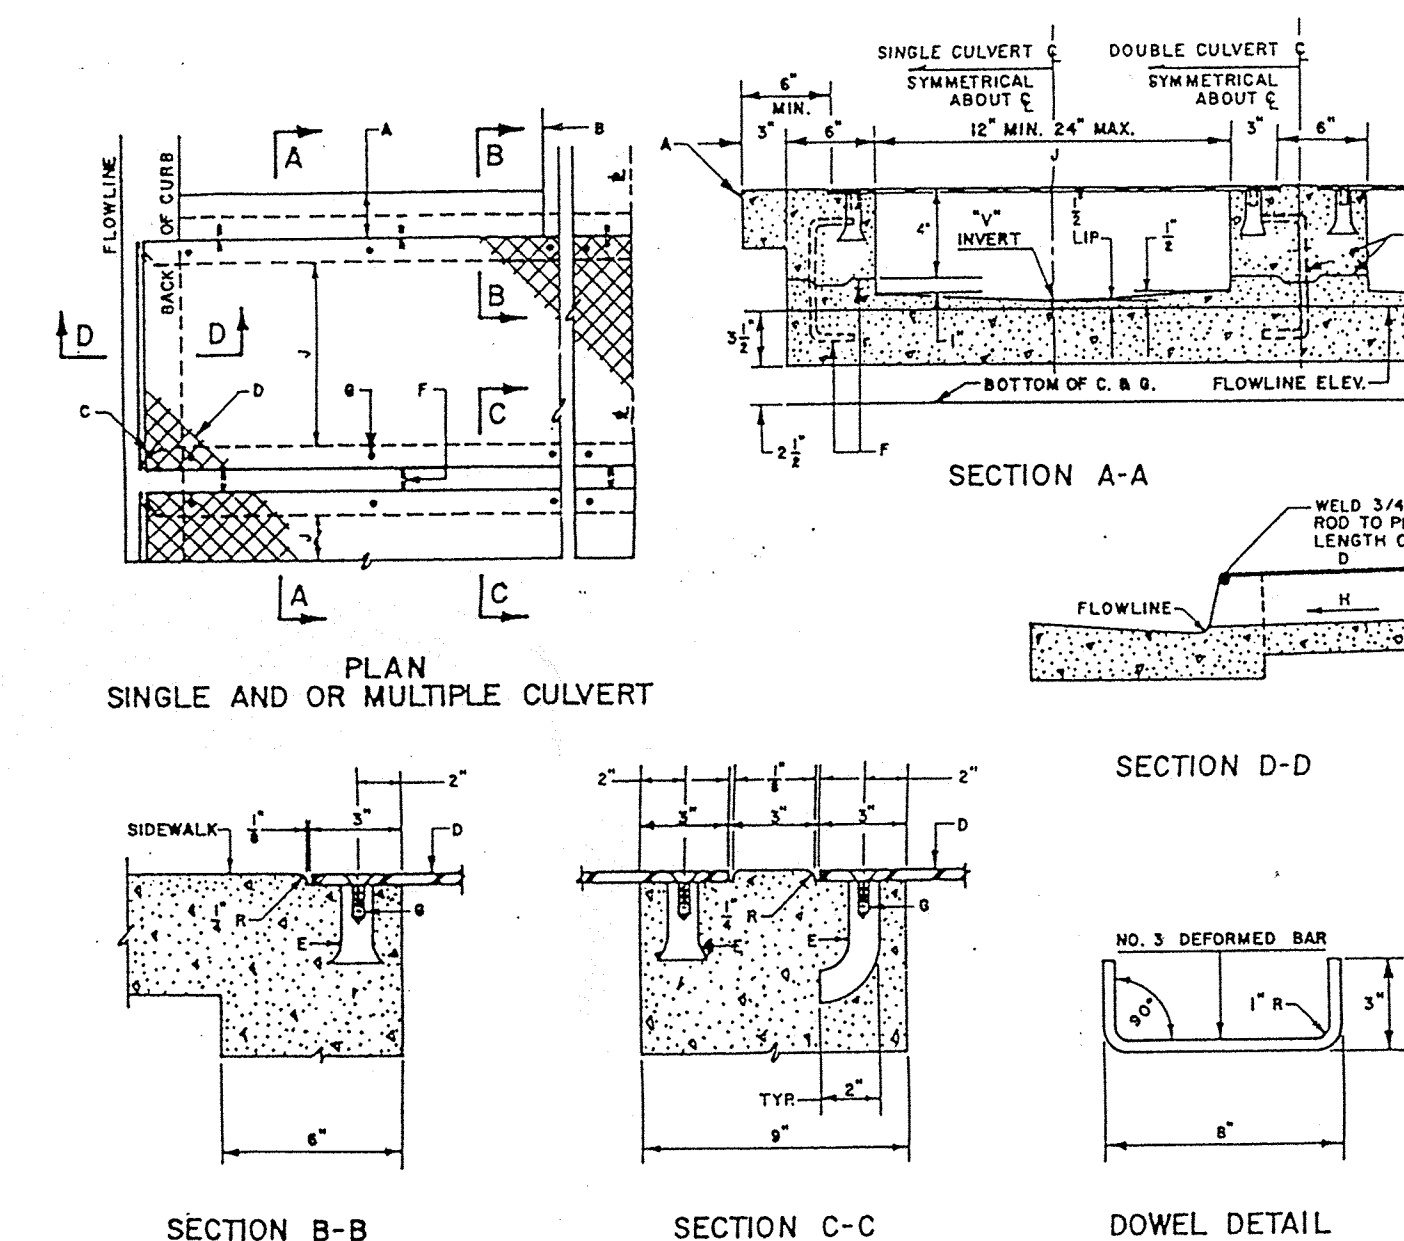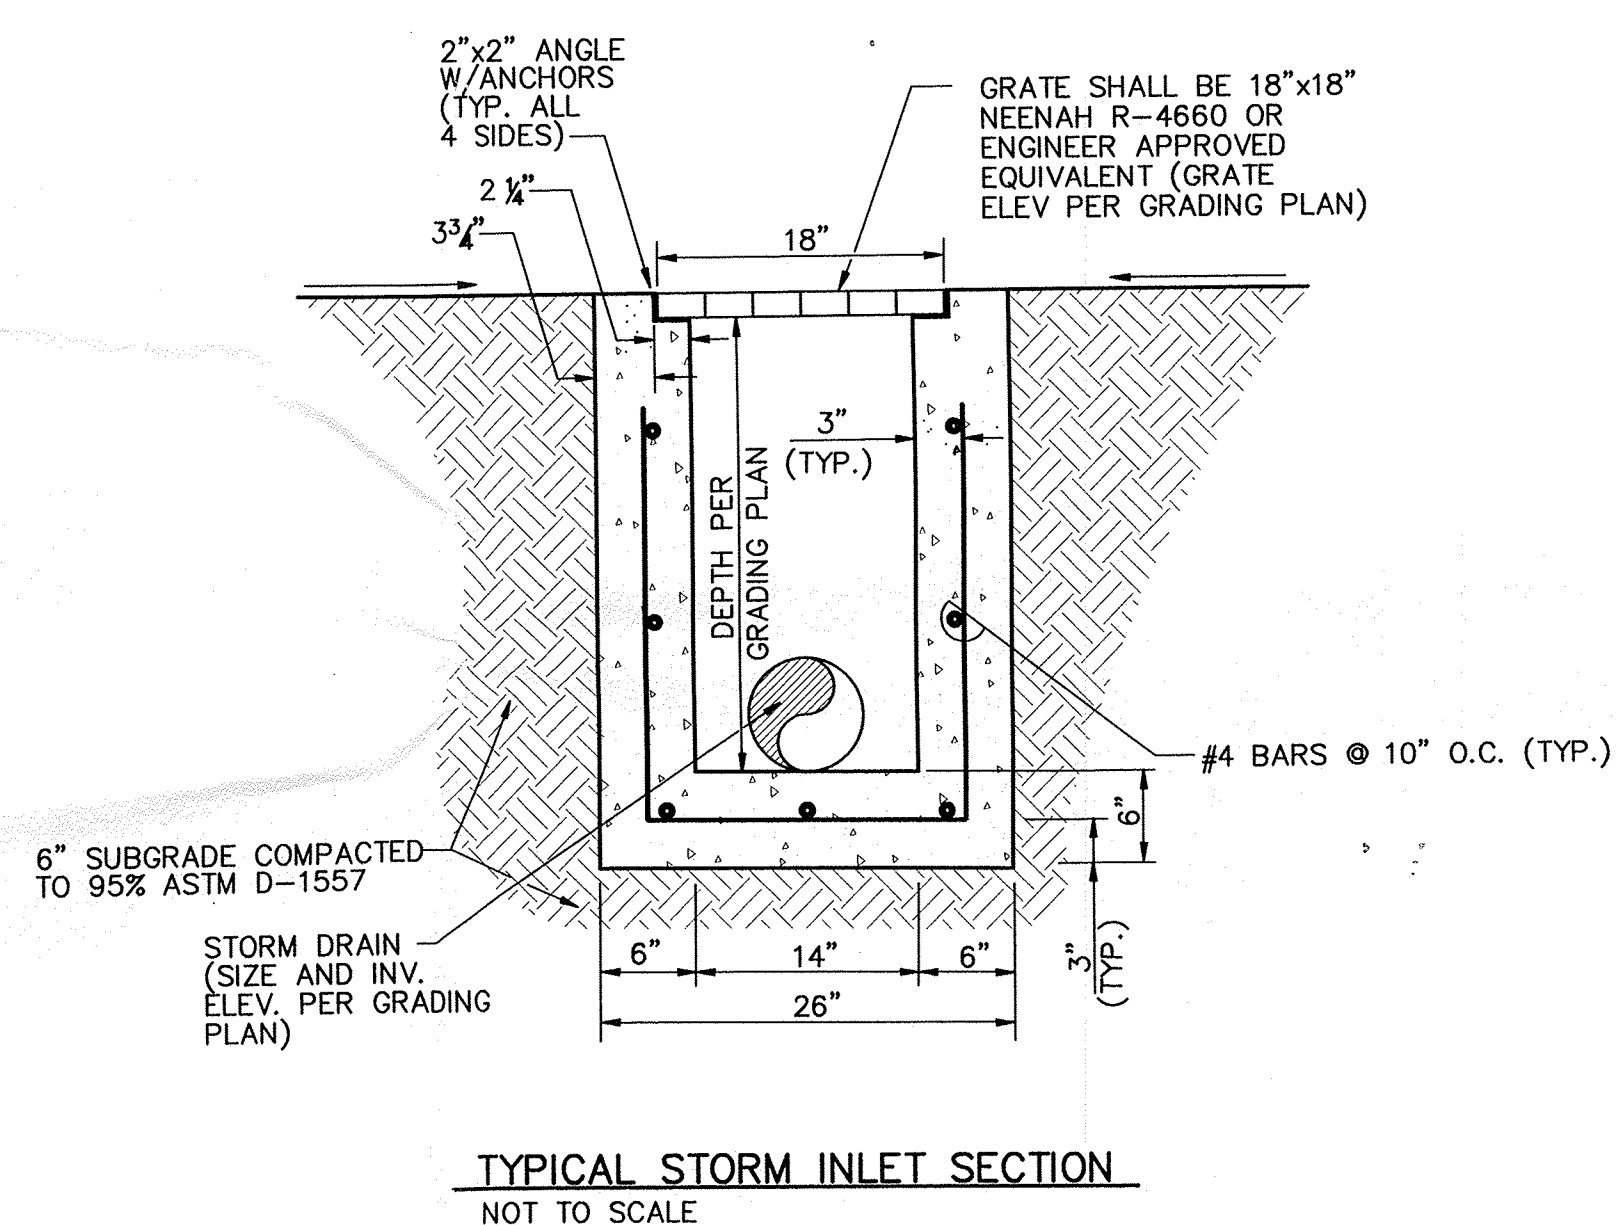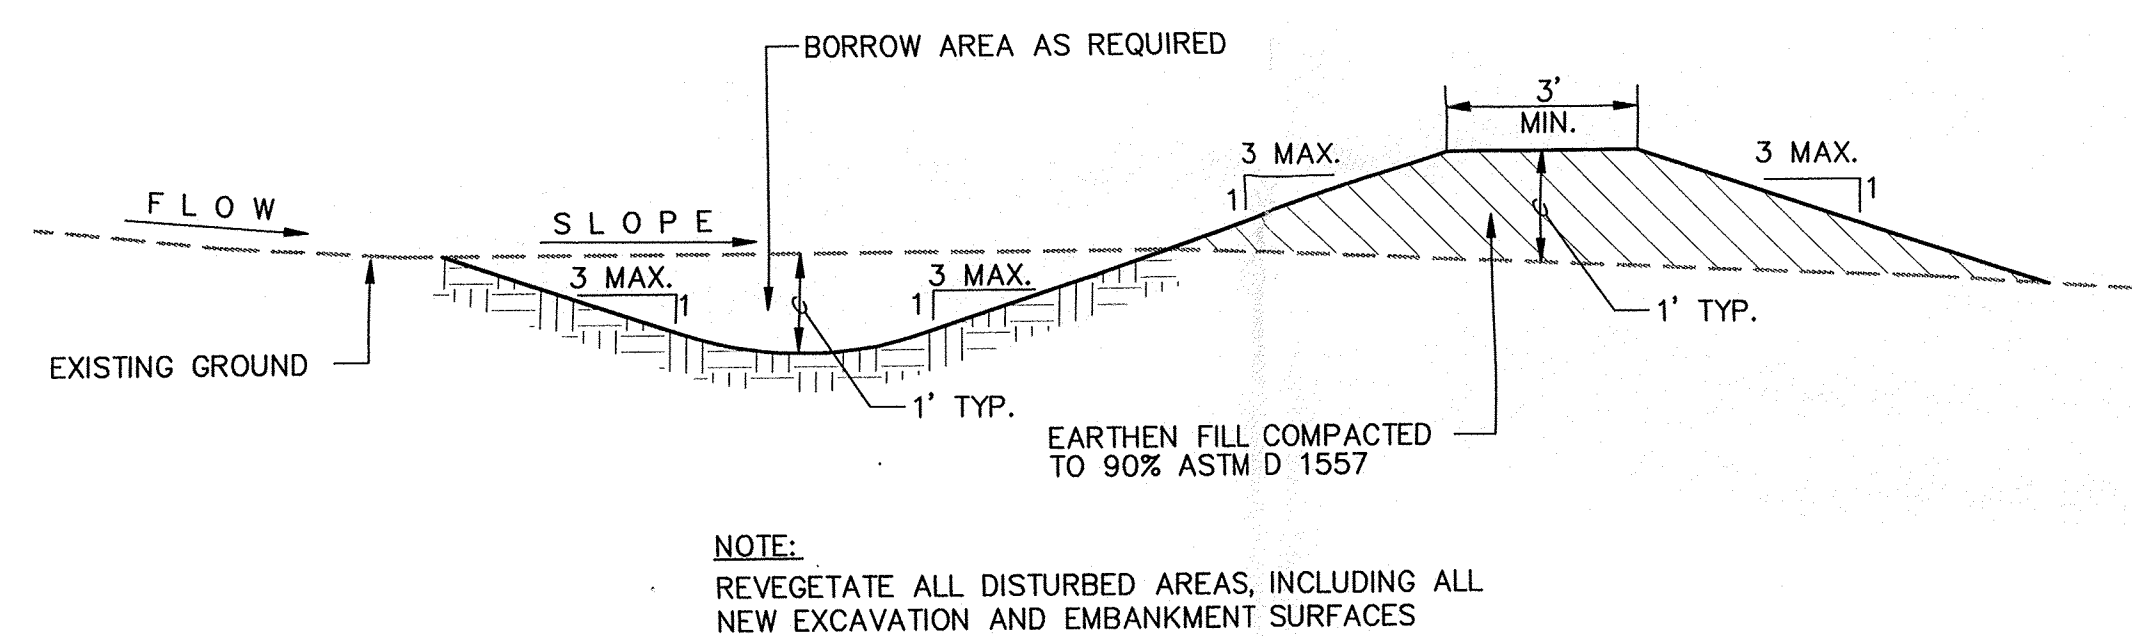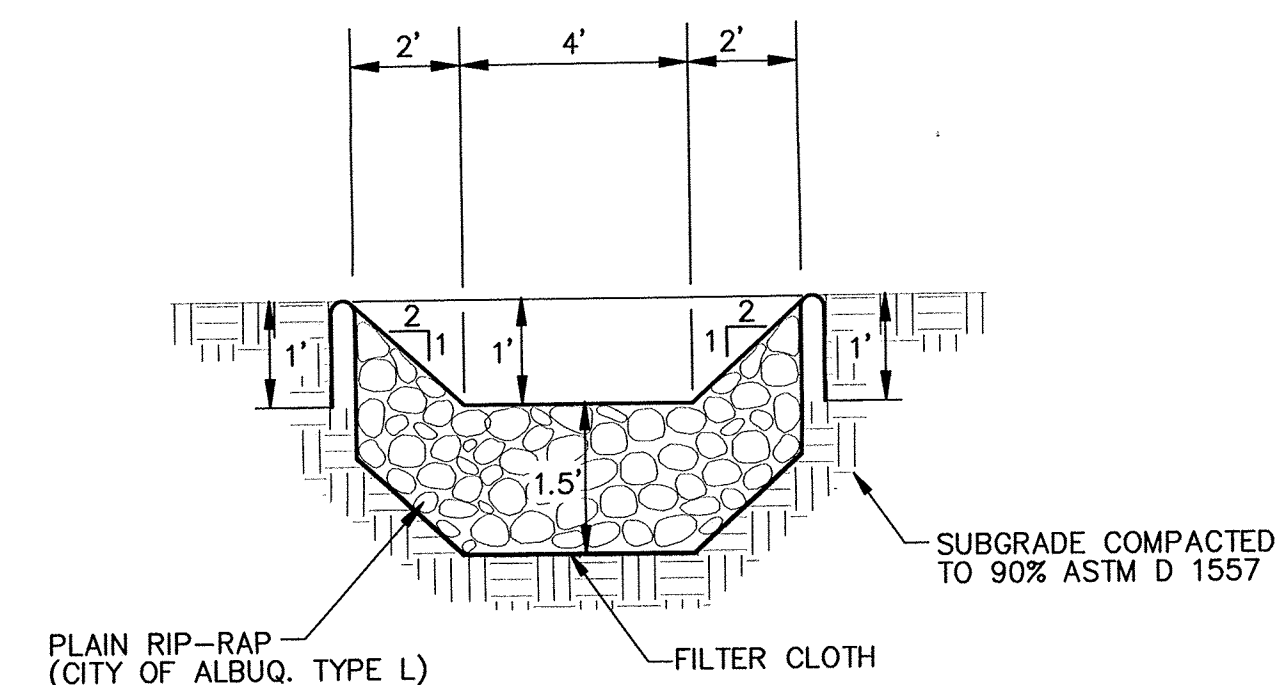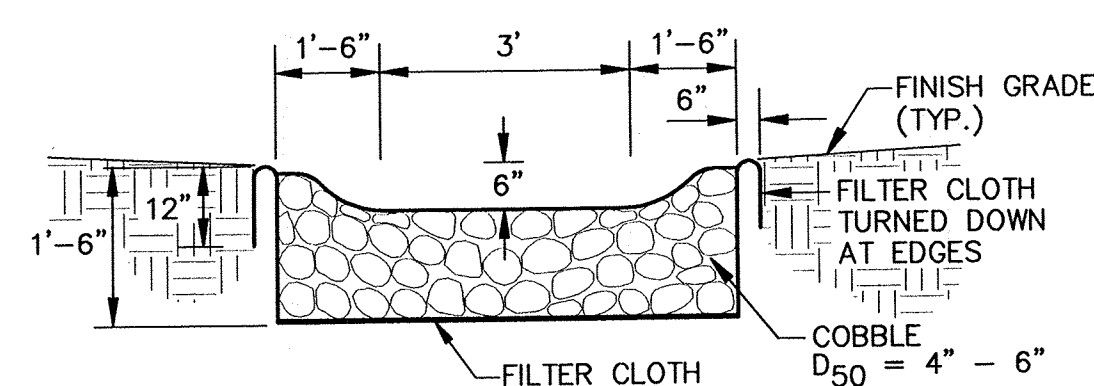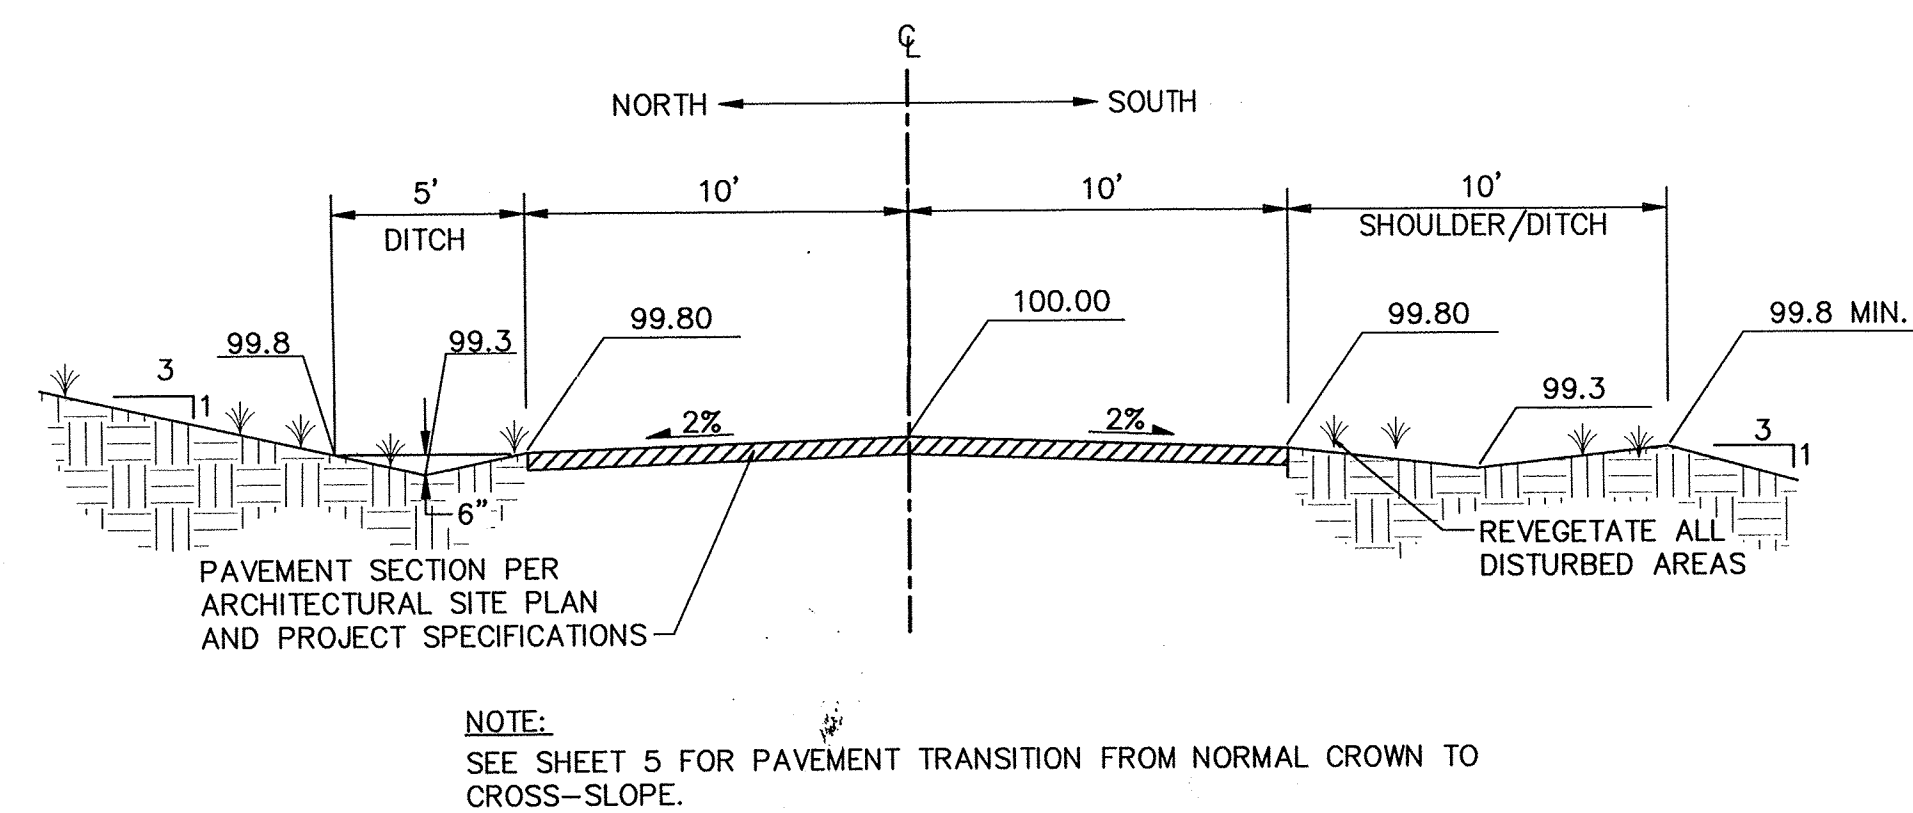

CERTIFICATION FOR PERMANENT CERTIFICATE OF OCCUPANCY

I HEREBY CERTIFY THAT I HAVE INSPECTED THE SITE GRADING AND DRAINAGE IMPROVEMENTS AND THAT THEY HAVE BEEN CONSTRUCTED AND ARE EXPECTED TO FUNCTION IN SUBSTANTIAL COMPLIANCE WITH THE INTENT OF THE APPROVED GRADING AND DRAINAGE PLAN. THE AS-CONSTRUCTED INFORMATION SHOWN ON THIS PLAN WAS PROVIDED BY OTHERS. PROPOSED CONTOURS HAVE NOT BEEN REVISED TO REFLECT AS-CONSTRUCTED ELEVATIONS AND SHOULD BE CONSIDERED APPROXIMATE.

Christopher S. Philips
Christopher S. Philips, P.E.
N.M.P.E. No. 11624

1	EXTEND RUNDOWN ON SHEETS 4 AND 5	JML	10/97
NO.	REVISIONS	BY	DATE
SANTA MARIA DE LA VID CHURCH GRADING & DRAINAGE PLAN DETAILS AND SECTIONS			
		<i>Easterling & Associates, Inc.</i> CONSULTING ENGINEERS 2600 The American Rd., SE, Suite 100 Rio Rancho, New Mexico 87124 (505) 898-8021 FAX (505) 898-8501	
DESIGNED BY JML		DRAWN BY: DAH/RVF	
CHECKED BY: CSP		SHEET 6	
JOB NO: 4242		DATE : 8/97	
		OF 6	