

# CITY OF ALBUQUERQUE

Planning Department  
Brennon Williams, Director



Mayor Timothy M. Keller

June 24, 2021

Michael Balaskovits  
Bohannon Huston, Inc.  
7500 Jefferson St. NE  
Albuquerque, NM 87109

**RE: MDS OS-7 Storm Drain Relocation  
Stryker Rd. and Fellini Blvd.  
Grading and Drainage Report Stamp Date: 5/4/21  
Hydrology File: R16D097A**

Dear Mr. Balaskovits:

Based on the submittal received on 5/5/21, the Grading and Drainage Report is approved for Grading Permit and Work Order.

Please note, at DRC a note must be added to the pond grading sheet stating that pond slopes are to be stabilized with "Native Grass Seed with Aggregate Mulch or equal (Must satisfy the "Final Stabilization criteria" CGP 2.2.14.b.).

If you have any questions, please contact me at 924-3986 or [earnmijo@cabq.gov](mailto:earnmijo@cabq.gov).

Sincerely,

Ernest Armijo, P.E.  
Principal Engineer, Planning Dept.  
Development Review Services

PO Box 1293

Albuquerque

NM 87103

[www.cabq.gov](http://www.cabq.gov)



# City of Albuquerque

Planning Department  
Development & Building Services Division

## DRAINAGE AND TRANSPORTATION INFORMATION SHEET (REV 6/2018)

**Project Title:** MDS OS-7 STORM DRAINAGE RELOCATION **Building Permit #:** \_\_\_\_\_ **Hydrology File #:** \_\_\_\_\_  
**DRB#:** \_\_\_\_\_ **EPC#:** \_\_\_\_\_ **Work Order#:** 775684  
**Legal Description:** TRACT OS-7 AND TRACT A-1-A-1 OF MESA DEL SOL  
**City Address:** STRYKER RD & FELLINI BLVD

**Applicant:** BOHANNAN HUSTON INC **Contact:** MICHAEL BALASKOVITS  
**Address:** 7500 JEFFERSON ST NE COURTYARD I ALBUQUERQUE NM 87109  
**Phone#:** 823-1000 **Fax#:** \_\_\_\_\_ **E-mail:** MBALASKOVITS@BHINC.COM

**Other Contact:** \_\_\_\_\_ **Contact:** \_\_\_\_\_  
**Address:** \_\_\_\_\_  
**Phone#:** \_\_\_\_\_ **Fax#:** \_\_\_\_\_ **E-mail:** \_\_\_\_\_

**TYPE OF DEVELOPMENT:** \_\_\_\_\_ PLAT (# of lots) \_\_\_\_\_ RESIDENCE \_\_\_\_\_ DRB SITE ☒ ADMIN SITE

IS THIS A RESUBMITTAL? \_\_\_\_\_ Yes ☒ No

**DEPARTMENT** \_\_\_\_\_ TRANSPORTATION ☒ HYDROLOGY/DRAINAGE

Check all that Apply:

### TYPE OF SUBMITTAL:

- ☐ ENGINEER/ARCHITECT CERTIFICATION
- ☐ PAD CERTIFICATION
- ☐ CONCEPTUAL G & D PLAN
- ☐ GRADING PLAN
- ☒ DRAINAGE REPORT
- ☐ DRAINAGE MASTER PLAN
- ☐ FLOODPLAIN DEVELOPMENT PERMIT APPLIC
- ☐ ELEVATION CERTIFICATE
- ☐ CLOMR/LOMR
- ☐ TRAFFIC CIRCULATION LAYOUT (TCL)
- ☐ TRAFFIC IMPACT STUDY (TIS)
- ☐ STREET LIGHT LAYOUT
- ☐ OTHER (SPECIFY) \_\_\_\_\_
- ☐ PRE-DESIGN MEETING?

### TYPE OF APPROVAL/ACCEPTANCE SOUGHT:

- ☐ BUILDING PERMIT APPROVAL
- ☐ CERTIFICATE OF OCCUPANCY
- ☐ PRELIMINARY PLAT APPROVAL
- ☐ SITE PLAN FOR SUB'D APPROVAL
- ☐ SITE PLAN FOR BLDG. PERMIT APPROVAL
- ☐ FINAL PLAT APPROVAL
- ☐ SIA/ RELEASE OF FINANCIAL GUARANTEE
- ☐ FOUNDATION PERMIT APPROVAL
- ☒ GRADING PERMIT APPROVAL
- ☐ SO-19 APPROVAL
- ☐ PAVING PERMIT APPROVAL
- ☐ GRADING/ PAD CERTIFICATION
- ☒ WORK ORDER APPROVAL
- ☐ CLOMR/LOMR
- ☐ FLOODPLAIN DEVELOPMENT PERMIT
- ☐ OTHER (SPECIFY) \_\_\_\_\_

**DATE SUBMITTED:** 05-05-2021 **By:** MICHAEL BALASKOVITS

COA STAFF:

ELECTRONIC SUBMITTAL RECEIVED: \_\_\_\_\_

FEE PAID: \_\_\_\_\_



# DRAINAGE MANAGEMENT PLAN FOR MESA DEL SOL OS-7 STORM DRAINAGE RELOCATION

**MAY 2021**

**Prepared for:**

**MDS Investment, LLC**

**4020 Vassar Dr. NE, Suite H**

**Albuquerque, NM 87107**

**Prepared by:**

**Bohannon  Huston**

Engineering

Spatial Data

Advanced Technologies



**DRAINAGE REPORT  
FOR  
MESA DEL SOL OS-7  
STORM DRAINAGE RELOCATION**

**MAY 4, 2021**

Prepared for:  
**MDS INVESTMENT, LLC  
4020 VASSAR DR. NE, SUITE H  
ALBUQUERQUE, NM 87107**

Prepared by:  
**BOHANNAN HUSTON, INC.  
COURTYARD I  
7500 JEFFERSON STREET NE  
ALBUQUERQUE, NM 87109**

**PREPARED BY:**

 05/04/21  
Abraham Mena Ortiz, EI      Date

**UNDER THE SUPERVISION OF:**

  
  
Michael Balaskov, PE      Date



**TABLE OF CONTENTS**

<b>I. PURPOSE .....</b>	<b>1</b>
<b>II. CONCEPTS AND METHODOLOGIES .....</b>	<b>1</b>
<b>III. DEVELOPED HYDRAULIC AND HYDROLOGIC CONDITIONS .....</b>	<b>2</b>
A. EXISTING INFRASTRUCTURE .....	2
B. PROPOSED INFRASTRUCTURE.....	3
C. STORMWATER SUSTAINABILITY .....	3
<b>IV. CONCLUSION .....</b>	<b>4</b>

**APPENDICES**

APPENDIX A - EXISTING CONDITIONS

APPENDIX B - STORM DRAIN HGL ANALYSIS

**EXHIBITS**

EXHIBIT A - IDO ZONE ATLAS MAP

EXHIBIT B - INFRASTRUCTURE AS-BUILTS

EXHIBIT C - BASIN MAP EXHIBIT

EXHIBIT D - GRADING PLAN

EXHIBIT E - FELLINI BLVD. PNP

## I. PURPOSE

---

The purpose of this report is to establish a drainage management plan to support the relocation of the storm drainage infrastructure and vacation of the public drainage easement over Tract OS-7, in Mesa Del Sol, Albuquerque (see **Exhibit A**). The existing 48" RCP storm drain line from the Stryker Rd and Hawkings Dr roundabout to tract OS-7 will be demolished to support a future development. A new underground storm drainage will be constructed on Fellini Blvd from Stryker Rd to a temporary retention pond at the Mesa Del Sol Blvd. couplet. This proposed retention facility will accommodate existing developed flows intercepted by the storm drain network that currently discharges into tract OS-7, in addition to offsite flows from the north and west. This report is submitted in support of easement vacation and public work order approval by the DRC.

## II. CONCEPTS AND METHODOLOGIES

---

Drainage conditions were analyzed utilizing the City of Albuquerque 2020 DPM Part 6-2(A) Procedure for 40-Acre and Smaller Basins. The site is within zone 2 per Table 6.2.7, Section 6-2(A)(1) of the DPM. The 100-year, 6-hour storm event was utilized to determine peak flow rates for design of the storm drainage improvements. The 100-year, 10-day storm event was used to compute retention ponds required storage volume. The stormwater infrastructure Hydraulic Grade Line (HGL) was analyzed with Stormwater Studio Software in accordance with HEC-22, 3<sup>rd</sup> edition.

The following documents were referenced in the preparation of this report:

- *Drainage Management plan for Drainage Area 2*, COA Hydro File #R16/DA2, dated November 2008.
- *Drainage Report for Mesa Del Sol Residential Montage Unit 1 and 2*, COA Hydro File #R16-D003A, dated January 2011.
- *Drainage Report for Mesa Del Sol Residential Montage Unit 1 and 2*, COA Hydro File #R16-D003A, 2018 updated.
- *Drainage Report for Mesa Del Sol Community Center*, COA Hydro File #R16-DA3005, dated June 2007.
- *Drainage Report for Mesa Del Sol Town Center Units 1 and 2*, COA Hydro File #R16-D004, dated August 2007.
- *Mesa Del Sol Level B Plan*, revised September 2012.

### III. DEVELOPED HYDRAULIC AND HYDROLOGIC CONDITIONS

#### A. EXISTING INFRASTRUCTURE

The existing storm drain network in Stryker Rd extends north and west on University Blvd., captures developed flows from the right-of-way as well as a portion of Montage Subdivision basin and the Town Center site at the University Blvd couplet through several inlets and ultimately discharges into tract OS-7 retention pond. See **Exhibit B** for infrastructure as-builts.

Contributing basins to the network, as shown in **Exhibit C**, have been analyzed per the COA 2020 DPM following approved drainage reports land treatment percentages, see **Table 1** for hydrologic results. The 100-year 6-hour design peak flow rate at the connection manhole is computed AP1  $Q_{100yr-6hr} = 77.7$  cfs.

<b><u>BASINS CONTRIBUTING TO STRYKER STORM DRAINAGE</u></b> <b><u>(DISCHARGING TO TRACT OS-7)</u></b>					
Basin ID	Area (Ac)	%D	$Q_{100yr-6hr}$ (CFS)	$V_{100yr-6hr}$ (CF)	$Q_{100yr-10d}$ (CF)
UNIVERSITY 1	5.77	90	24.28	46,046	71,099
UNIVERSITY 2	1.23	90	5.18	9,822	15,167
UNIVERSITY 3	1.17	90	4.93	9,350	14,438
MONTAGE 1	2.75	78	10.95	20,151	30,507
MONTAGE 2	2.14	25	6.71	9,914	12,500
STRYKER 1	0.95	90	4.00	7,585	11,712
STRYKER 2	1.59	90	6.69	12,685	19,587
TOWN CENTER 1	1.66	90	6.98	13,245	20,452
TOWN CENTER 2	1.84	100	7.97	15,523	24,384
<b>TOTAL @ AP1</b>			<b>77.7</b>	<b>144,322</b>	<b>219,846</b>

Table 1: Hydrologic Analysis of Basins conveyed by the Stryker-University Storm Drainage

An existing retention pond is located within the N Mesa Del Sol Blvd. ROW (See **Exhibit C**). This pond serves the Town Center development and undisturbed area south of Stryker Rd., basin TOWN CENTER 3 ( $Q_{100yr-6hr} = 18.60$  cfs;  $Q_{100yr-10d} = 54,718$  cf) and basin M1 ( $Q_{100yr-6hr} = 27.73$  cfs;  $Q_{100yr-10d} = 35,726$  cf) retention requirements. See **Appendix A** for hydrologic analysis.



## B. PROPOSED INFRASTRUCTURE

To divert existing developed flows discharging into tract OS-7 to the new retention facility a new storm drainage is proposed in Fellini Blvd. ROW. The new line will connect the existing network in Stryker Rd at the intersection of Stryker Rd and Fellini Blvd and will discharge into the proposed retention pond at the Mesa Del Sol couplet. (See **Exhibit E**) The existing manhole will be rehab in accordance with COA Standard Specifications for Public Works Construction. The new 48" storm drainage is sized to accommodate existing developed flows at AP1 ( $Q_{100yr-6hr} = 77.7$  cfs). See **Appendix B** for the HGL analysis results.

Offsite developed flows from the Town Center development and area south of Stryker Rd (basins Town Center 3 and M1) will be captured by IN1 ( $Q_{100yr-6hr} = 46.33$  cfs), located on N Mesa del Sol Blvd., west of Fellini Blvd.,. This proposed COA Dbl-Type D inlet in sump condition will ultimately discharge to the new retention pond, eliminating the retention requirements of the existing pond in N Mesa Del Sol Blvd. ROW. This will allow for a portion of the existing pond will be rough-graded and the 78' Public Drainage Easement to be vacated.

The proposed retention pond will be located east of Fellini Blvd between North and South Mesa Del Sol Blvd. couplet, within a new Public Drainage Easement. This facility will accommodate existing developed and undeveloped flows captured by the underground storm drainage system. This pond will retain the 100-yr 10-day storm volume  $V_{100yr-10d} = 7.12$  ac-ft. It will have a capacity of  $V_{Storage} = 8.00$  ac-ft with 2 feet of freeboard. See **Appendix A** for storage calculations and **Exhibit D** for the grading plan. No infiltration is accounted for in the storage calculations.

The 60" pipe outlet discharging into the pond will be constructed with an offset of at least one foot from the pond bottom. An erosion protection rip rap rundown and blanket will be included to prevent erosion during the large storm events.

## C. STORMWATER SUSTAINABILITY

In accordance with COA DPM 2020, developments are required to capture and infiltrate the stormwater quality volume (0.42 inches times impervious area). This volume corresponds to the runoff from small storms and the initial portion of larger storms.

The proposed retention pond satisfies stormwater quality requirements since it captures and infiltrates the 100-year 10-day runoff volume. Infiltration will occur thru the

pond bottom and side slopes, evacuating the pond within 96 hours. Soil amendment measures, if necessary, will be determined by the Geotech report.

In addition to retain and infiltrate developed flows, resulting in the recharge of the aquifers, the proposed pond will function as a centralized facility for pollutants removal. Consequently, oils, chemicals, sediments and other types of pollutants conveyed by the public storm drainage system will not reach natural watercourses, protecting and preserving the local resources. These stormwater sustainability goals are pursuant to the Mesa Del Sol Level B Community Master Plan development guidelines.

Due to soil properties, regular, periodic pond maintenance is required to ensure the facility maintains its intended functions. Maintenance activities should include, but is not limited to:

- Repair of slope rills and erosion
- Removal of sediment to design elevations
- Removal of trash, debris and other pollutants
- Maintenance of clean outlet works conduit
- Inspection of toe of outlet works for scour and undercutting

Maintenance shall occur at least bi-annually and within one week of any significant rainfall event.

#### **IV. CONCLUSION**

---

This drainage management plan provides a detailed study of the proposed public infrastructure to support the removal of the storm drainage and vacation of the public drainage easement on Tract OS-7. The proposed storm drainage in Fellini Blvd. provides an alternative outfall that allows for the safe management of storm runoff in the existing developed conditions. Future drainage analysis reports will be provided upon further development of the Town Center to help develop specific site and roadway drainage schemes. Included is the IDO Zone Atlas Map, infrastructure as-builts, Drainage Management Plan Exhibit, Grading Plan, Fellini Blvd PNP, and all necessary hydrologic and hydraulic analyses. This drainage plan maintains the overall drainage pattern of the area.

## **APPENDICES**

**APPENDIX A:    EXISTING CONDITIONS  
HYDROLOGIC ANALYSIS AND  
POND STORAGE CALCULATIONS**

**APPENDIX B:    STORM DRAIN HGL ANALYSIS**



**APPENDIX A -  
EXISTING CONDITIONS  
HYDROLOGIC ANALYSIS AND POND STORAGE  
CALCULATIONS**

## MESA DEL SOL - TRACT OS7 DRAINAGE RELOCATION

### Basin Data Table

This table is based on the DPM Part 6-2(A), Zone: **2**

Basin	Area	Land Treatment Percentages				Q <sub>(100yr)</sub>	Q <sub>(100yr-6hr)</sub>	V <sub>(100yr-6hr)</sub>	V <sub>(100yr-10day)</sub>	V <sub>(100yr-10day)</sub>
ID	(AC.)	A	B	C	D	(cfs/ac.)	(CFS)	(CF)	CF	AC-FT
UNIVERSITY 1	5.77	0.0%	0.0%	10.0%	90.0%	4.21	24.28	46046	71099	1.63
UNIVERSITY 2	1.23	0.0%	0.0%	10.0%	90.0%	4.21	5.18	9822	15167	0.35
UNIVERSITY 3	1.17	0.0%	0.0%	10.0%	90.0%	4.21	4.93	9350	14438	0.33
MONTAGE 1 (1)	2.75	0.0%	11.0%	11.0%	78.0%	3.98	10.95	20151	30507	0.70
MONTAGE 2 (2)	2.14	0.0%	35.0%	40.0%	25.0%	3.13	6.71	9914	12500	0.29
STRYKER 1	0.95	0.0%	0.0%	10.0%	90.0%	4.21	4.00	7585	11712	0.27
STRYKER 2	1.59	0.0%	0.0%	10.0%	90.0%	4.21	6.69	12685	19587	0.45
TOWN CENTER 1 (3)	1.66	0.0%	0.0%	10.0%	90.0%	4.21	6.98	13245	20452	0.47
TOWN CENTER 2 (3)	1.84	0.0%	0.0%	0.0%	100.0%	4.34	7.97	15523	24384	0.56
<b>TOTAL @ AP1</b>							<b>77.68</b>	<b>144322</b>	<b>219846</b>	<b>5.05</b>
TOWN CENTER 3 (4)	4.45	0.0%	5.0%	5.0%	90.0%	4.18	18.60	35372	54718	1.26
M1	14.02	80.0%	0.0%	20.0%	0.0%	1.98	27.73	35726	35726	0.82
<b>TOTAL @ AP2</b>							<b>124.01</b>	<b>215420</b>	<b>310290</b>	<b>7.12</b>

- (1) Land treatment percentages from COA Hydro File # R16-D003A
- (2) Land treatment percentages from COA Hydro File # R16-D003A 2018 Update
- (3) Land treatment percentages per COA Hydro File #R16-DA3005
- (4) Land treatment percentages per COA Hydro File #R16-DA004

**RETENTION POND INFORMATION:**

BOTTOM ELEVATION =	5274.00
TOP ELEVATION =	5291.00
FREEBOARD =	2.00 FT
V_STORAGE =	8.00 AC-FT
V_100YR_10D =	7.12 AC-FT
Q_100YR_6HR =	124.01 CFS
WSE_100YR_10D =	5288.20
WSE_100YR_6HR =	5285.50

**PIPE INFORMATION:**

DIAMETER =	60"
INVERT ELEVATION =	5275.50



## Retention Pond Stage Storage

Project: MDS OS-7 SD Relocation


Basin Description: Retention Pond at MDS Blvd Couplet

Contour Elevation	Contour Area (sq. ft)		Cumulative Volume Avg. End (cu. ft)	Incremental Volume Avg. End (cu. ft)	Cumulative Volume Conic (cu. ft)	Volume Conic (cu. ft)
5,274.000	119.51	N/A	N/A	0.00	N/A	0.00
5,275.000	8,981.65		4550.58	4550.58	3379.08	3379.08
5,276.000	11,565.66		10273.65	14824.23	10246.46	13625.54
5,277.000	13,509.42		12537.54	27361.77	12524.96	26150.50
5,278.000	15,509.28		14509.35	41871.12	14497.85	40648.35
5,279.000	17,565.24		16537.26	58408.38	16526.60	57174.95
5,280.000	19,677.30		18621.27	77029.65	18611.28	75786.23
5,281.000	21,866.47		20771.88	97801.53	20762.26	96548.49
5,282.000	24,208.27		23037.37	120838.90	23027.45	119575.94
5,283.000	26,787.89		25498.08	146336.98	25487.20	145063.14
5,284.000	29,226.45		28007.17	174344.15	27998.32	173061.46
5,285.000	31,488.24		30357.35	204701.50	30350.32	203411.78 - 4.66 ac-ft
5,285.500 = 100YR-6HR WSE - V_100YR_24HR = 5.0 ac-ft						
5,286.000	33,800.77		32644.51	237346.00	32637.68	236049.46 - 5.42 ac-ft
5,287.000	36,189.17		34994.97	272340.98	34988.18	271037.63
5,288.000	38,654.39		37421.78	309762.75	37415.01	308452.64 - 7.08 ac-ft
5,288.200 = 100YR-10D WSE - V_100YR_10D = 7.12 ac-ft						
5,289.000	41,199.65		39927.02	349689.77	39920.26	348372.90 - 8.00 ac-ft
5,290.000	43,825.24		42512.45	392202.22	42505.69	390878.59
5,291.000	65,129.91		54477.57	446679.79	54127.04	445005.63 - Top of Pond

**APPENDIX B -  
STORM DRAIN HGL ANALYSIS**

Plan View

Stormwater Studio 2021 v 3.0.0.24

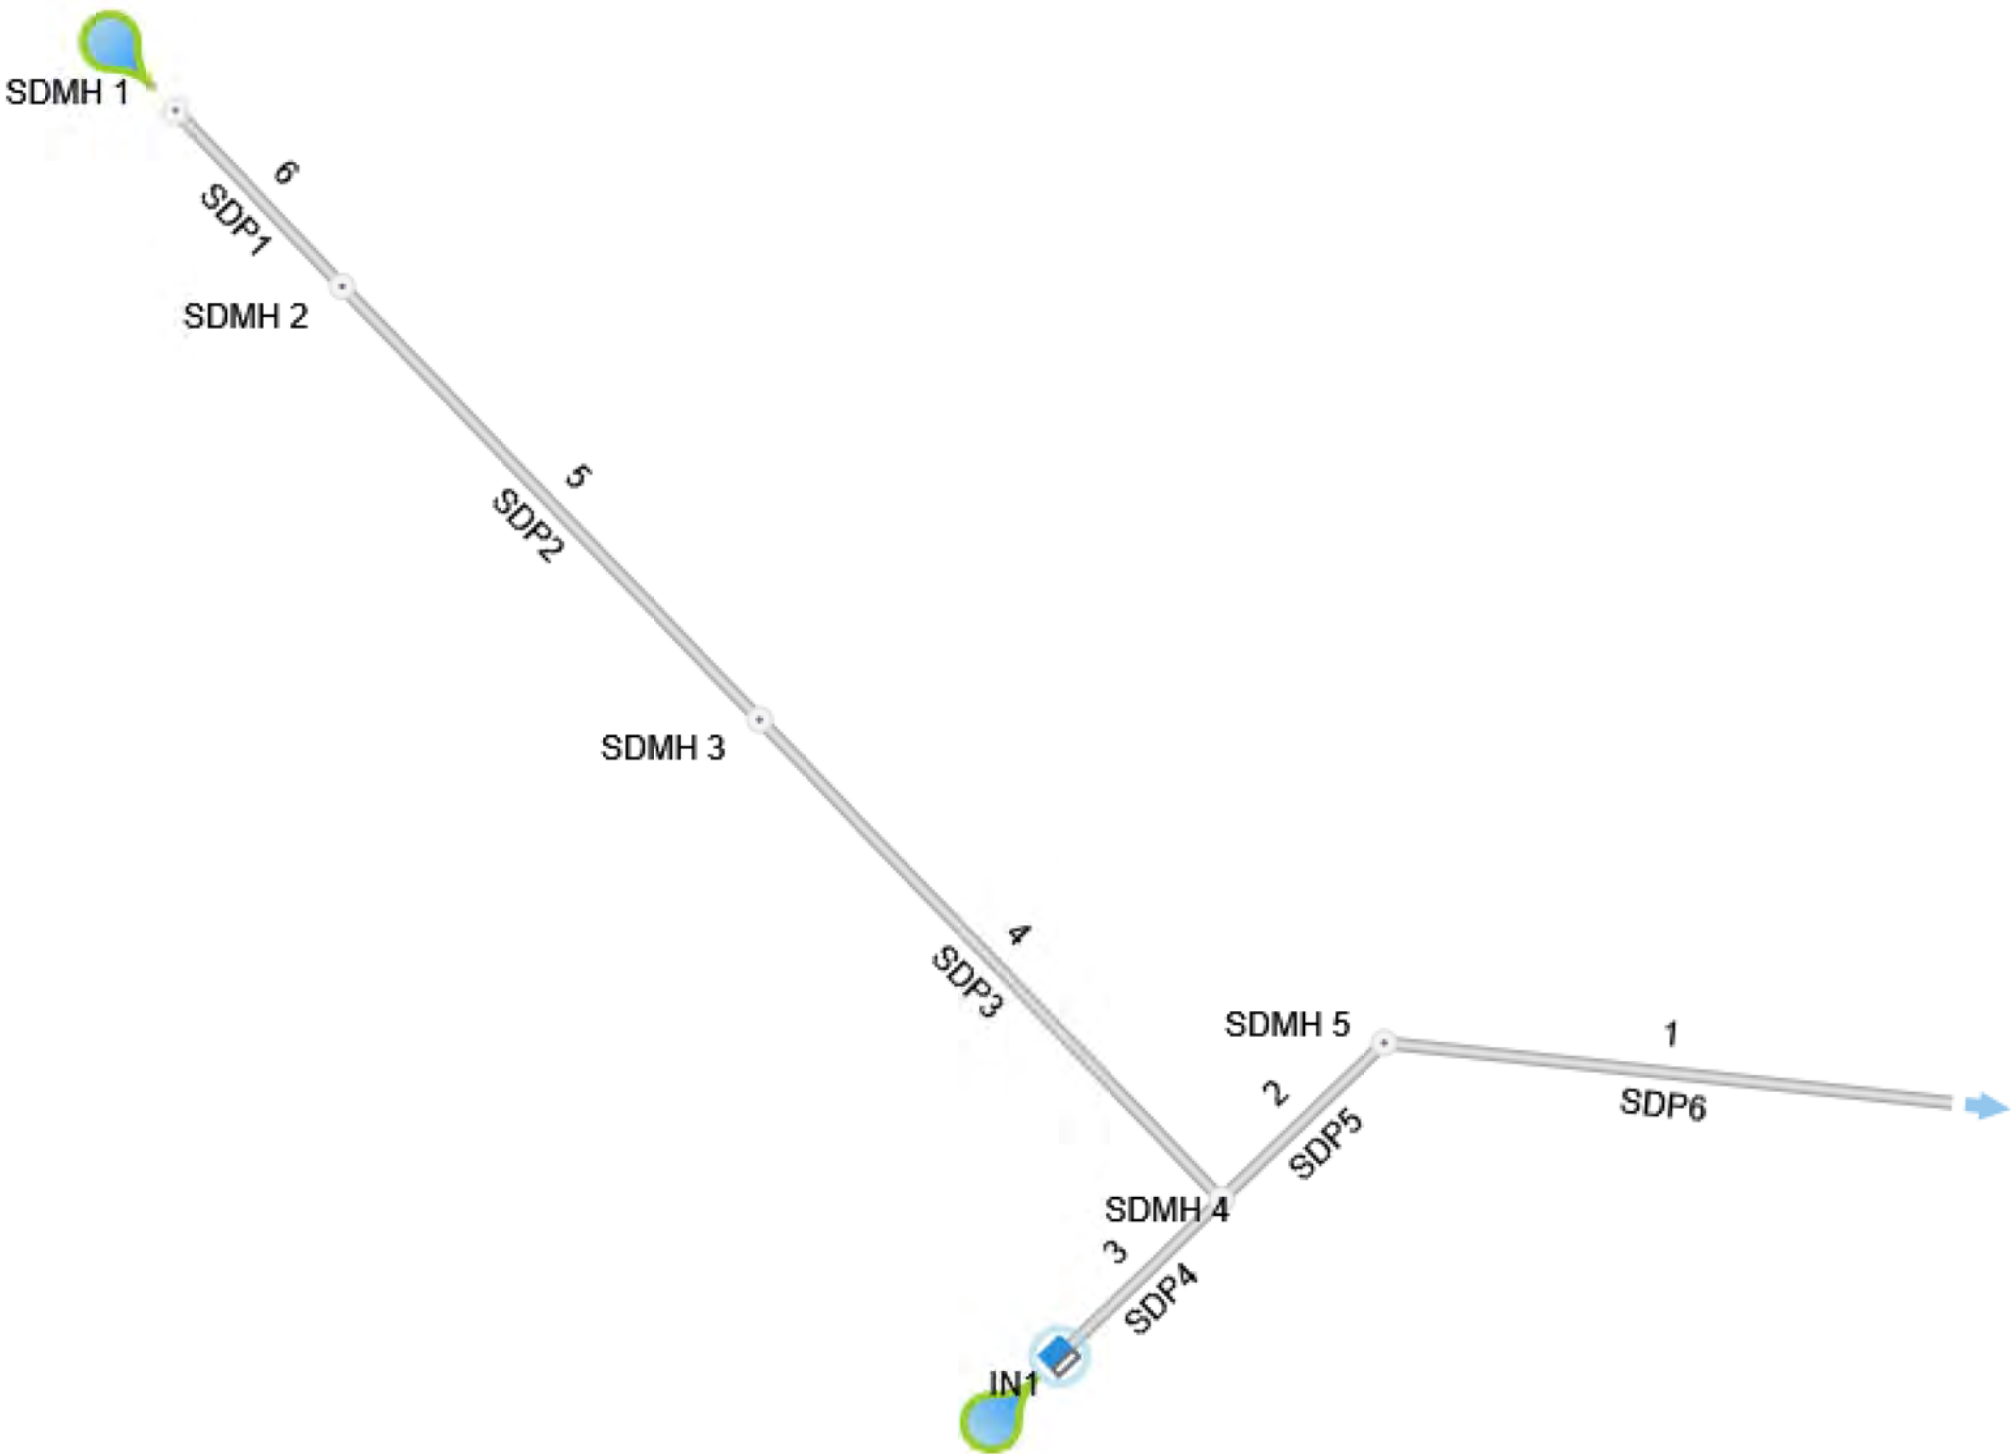




Profile View

Stormwater Studio 2021 v 3.0.0.24

Project Name: MDS OS-7 SD RELOCATION

04-15-2021

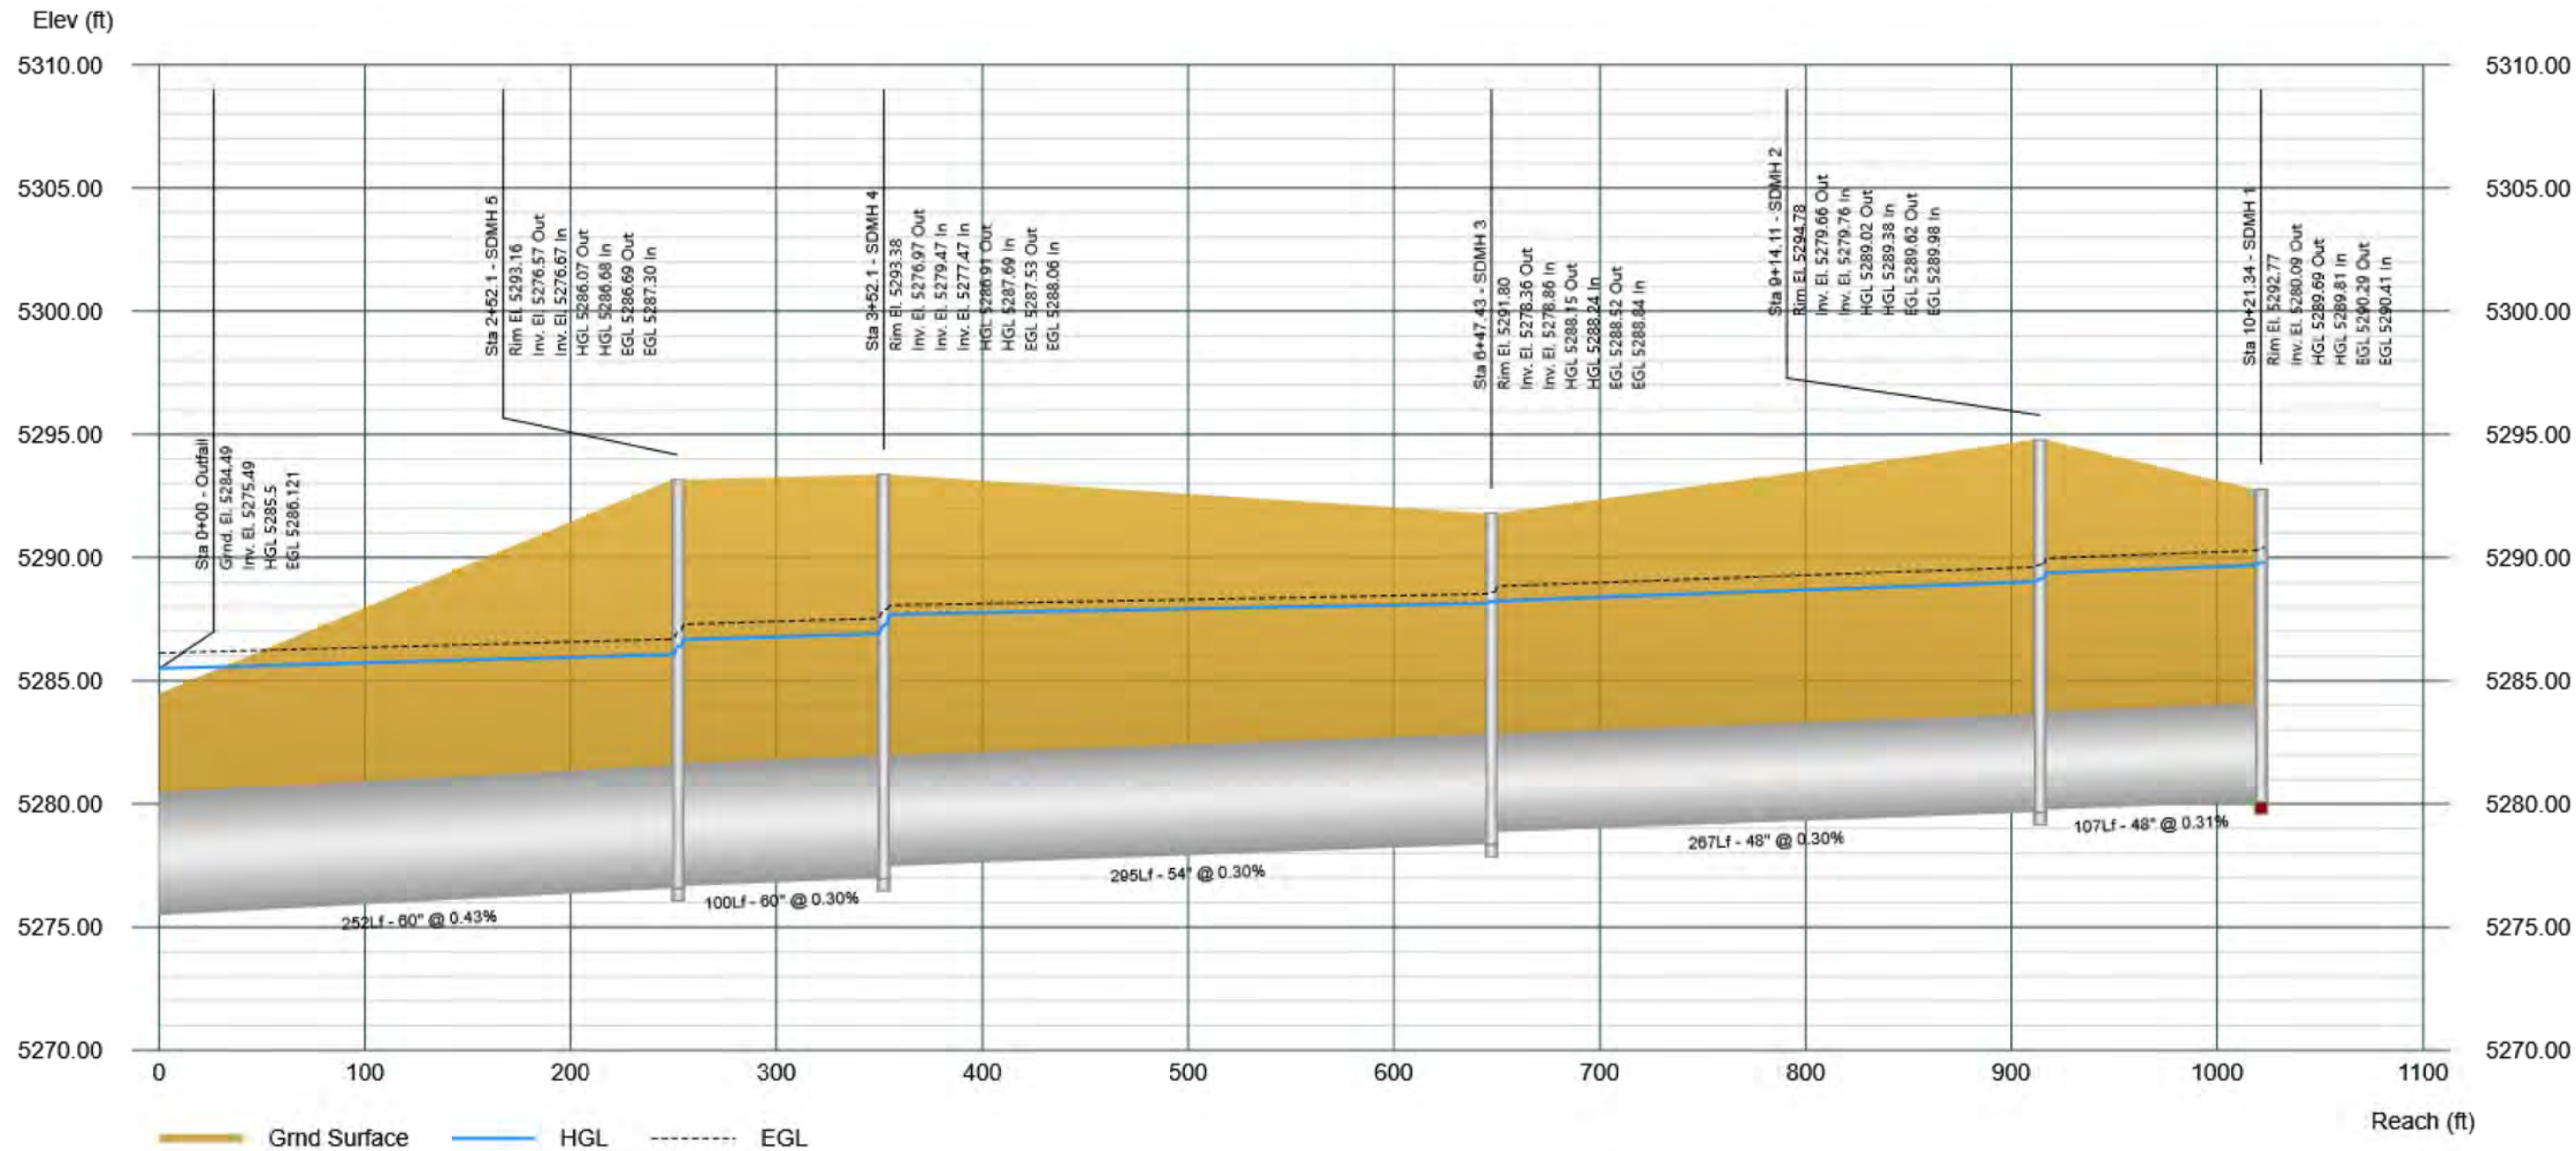


Profile View

Stormwater Studio 2021 v 3.0.0.24

Project Name: MDS OS-7 SD RELOCATION

04-15-2021

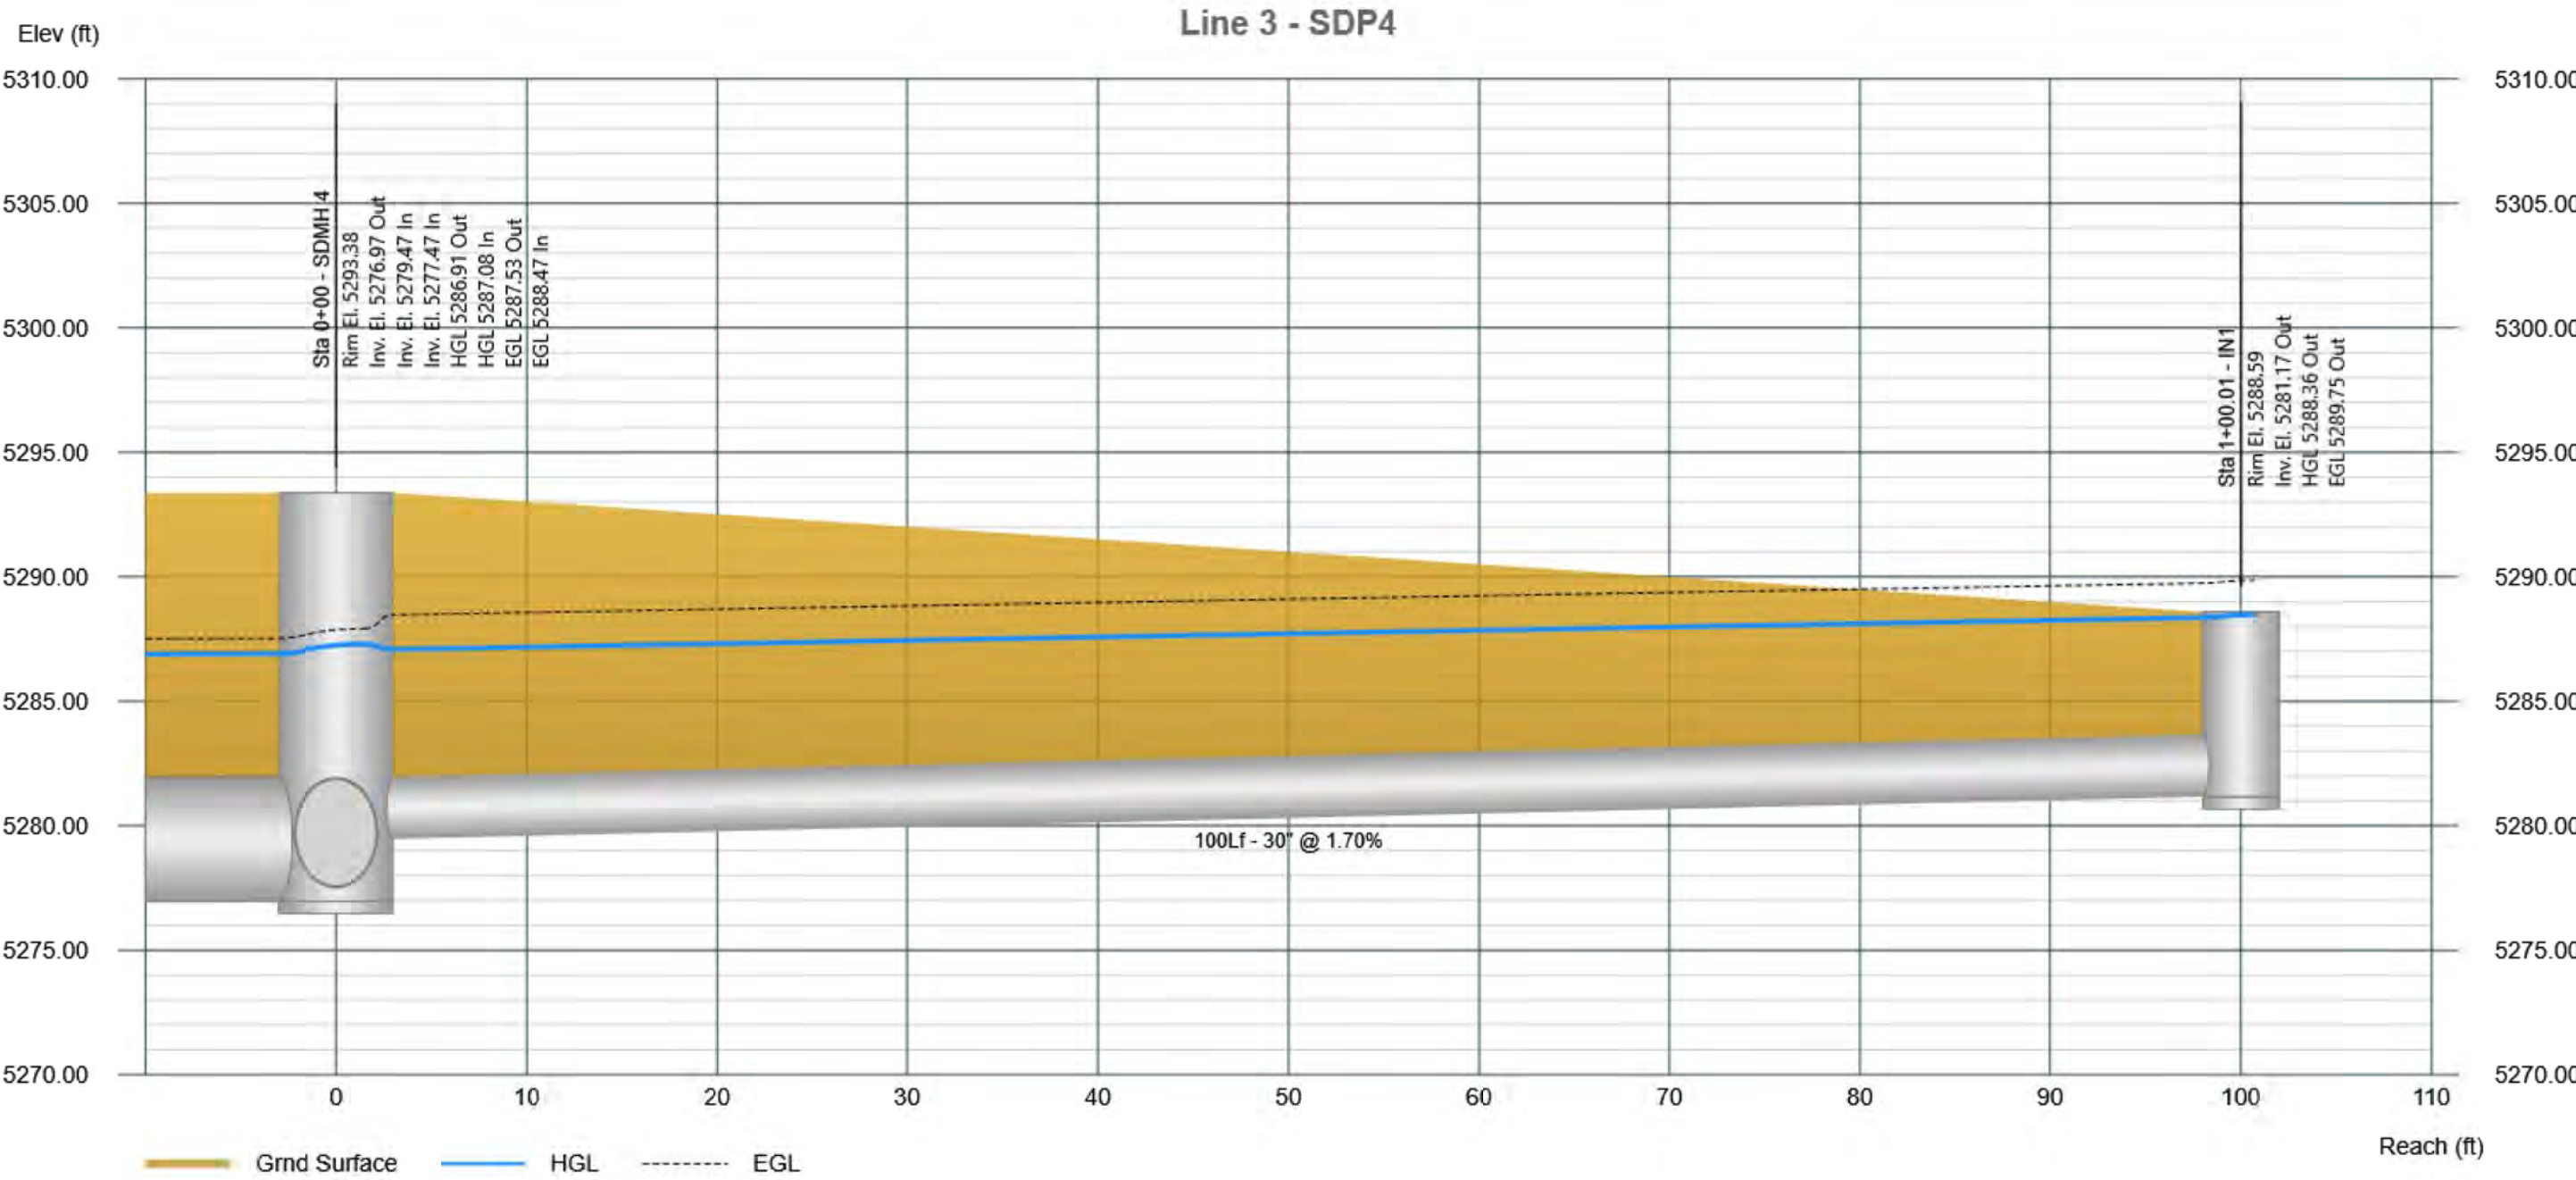

# Energy Grade Line Calculations

Project Name: MDS OS-7 SD RELOCATION

04-15-2021

Line No	Line Size  (in)	Q  (cfs)	Downstream							Length  (ft)	Upstream							Pipe		Junction		
			Invert Elev (ft)	Depth (ft)	Area (sqft)	HGL Elev (ft)	Vel (ft/s)	Vel Head (ft)	EGL Elev (ft)		Invert Elev (ft)	Depth (ft)	Area (sqft)	HGL Elev (ft)	Vel (ft/s)	Vel Head (ft)	EGL Elev (ft)	n Value	Enrgy Loss (ft)	HGLa Elev (ft)	EGLa Elev (ft)	Enrgy Loss (ft)
1	60	124.01	5275.49	5.00	19.63	5285.50	6.32	0.62	5286.12	252.10	5276.57	5.00	19.63	5286.07	6.32	0.62	5286.69	0.013	0.571	5286.43	5287.05	0.36
2	60	124.01	5276.67	5.00	19.63	5286.68	6.32	0.62	5287.30	100.00	5276.97	5.00	19.63	5286.91	6.32	0.62	5287.53	0.013	0.227	5287.29	5287.92	0.39
3	30	46.33	5279.47	2.50	4.91	5287.08	9.44	1.39	5288.47	100.02	5281.17	2.50	4.91	5288.36	9.44	1.38	5289.75	0.013	1.277	5288.48	5289.86	0.12
4	54	77.68	5277.47	4.50	15.90	5287.69	4.89	0.37	5288.06	295.32	5278.36	4.50	15.90	5288.15	4.88	0.37	5288.52	0.013	0.461	5288.23	5288.60	0.07
5	48	77.68	5278.86	4.00	12.56	5288.24	6.18	0.59	5288.84	266.68	5279.66	4.00	12.57	5289.02	6.18	0.59	5289.62	0.013	0.780	5289.14	5289.74	0.12
6	48	77.68	5279.76	4.00	12.56	5289.38	6.18	0.59	5289.98	107.23	5280.09	4.00	12.57	5289.69	6.18	0.59	5290.29	0.013	0.314	5289.81	5290.41	0.12
Notes: Return Period = 2-yrs.																						
Project File: 20210391STORM DRAINAGE.sws																						

# IN1

Double D inlet, in sump conditions:

Open Area (for orifice calc in sq. ft.): 7.8628472

Length of Weir (feet): 9.9166667

Calculation of open area:

	(in^2)	(ft^2)
Total Grate Area	2000	13.888889
Cross Bar Area	-732	-5.0833333
Supports (ends)	-231.25	-1.6059028
Areas Counted Twice	<u>95.5</u>	<u>0.6631944</u>
	1132.25	7.8628472

Calculation of Length of Weir:

	(in)	(ft)
Total Perimeter of Grate	130	10.833333
Short Cross Bars	-7	-0.5833333
End Supports	9	0.75
Bearing Bars	-13	-1.0833333
	119	9.9166667

Head (ft)	Head (in)	Weir Q	Orifice Q	Control Q	
0.05	0.6	0.30	8.47	0.30	
0.1	1.2	0.84	11.97	0.84	
0.15	1.8	1.54	14.66	1.54	
0.2	2.4	2.38	16.93	2.38	
0.25	3	3.32	18.93	3.32	
0.3	3.6	4.37	20.74	4.37	
0.35	4.2	5.50	22.40	5.50	
0.4	4.8	6.72	23.94	6.72	
0.45	5.4	8.02	25.40	8.02	
0.5	6	9.40	26.77	9.40	
0.55	6.6	10.84	28.08	10.84	
0.6	7.2	12.35	29.33	12.35	
0.65	7.8	13.93	30.52	13.93	
0.7	8.4	15.56	31.68	15.56	
0.75	9	17.26	32.79	17.26	
0.8	9.6	19.02	33.86	19.02	
0.85	10.2	20.83	34.90	20.83	
0.9	10.8	22.69	35.92	22.69	
0.95	11.4	24.61	36.90	24.61	
1	12	26.58	37.86	26.58	
1.5	18	48.82	46.37	46.37	Q_100 = 46.33 cfs
2	24	75.17	53.54	53.54	
3	36	138.10	65.57	65.57	
5	60	297.14	84.66	84.66	Q_Capacity = 84.00 cfs

## **EXHIBITS**

**EXHIBIT A: IDO ZONE ATLAS MAP**


**EXHIBIT B: INFRASTRUCTURE AS-BUILTS**

**EXHIBIT C: BASIN MAP EXHIBIT**

**EXHIBIT D: GRADING PLAN**

**EXHIBIT E: FELLINI BLVD. PNP**

**EXHIBIT A -  
IDO ZONE ATLAS MAP**

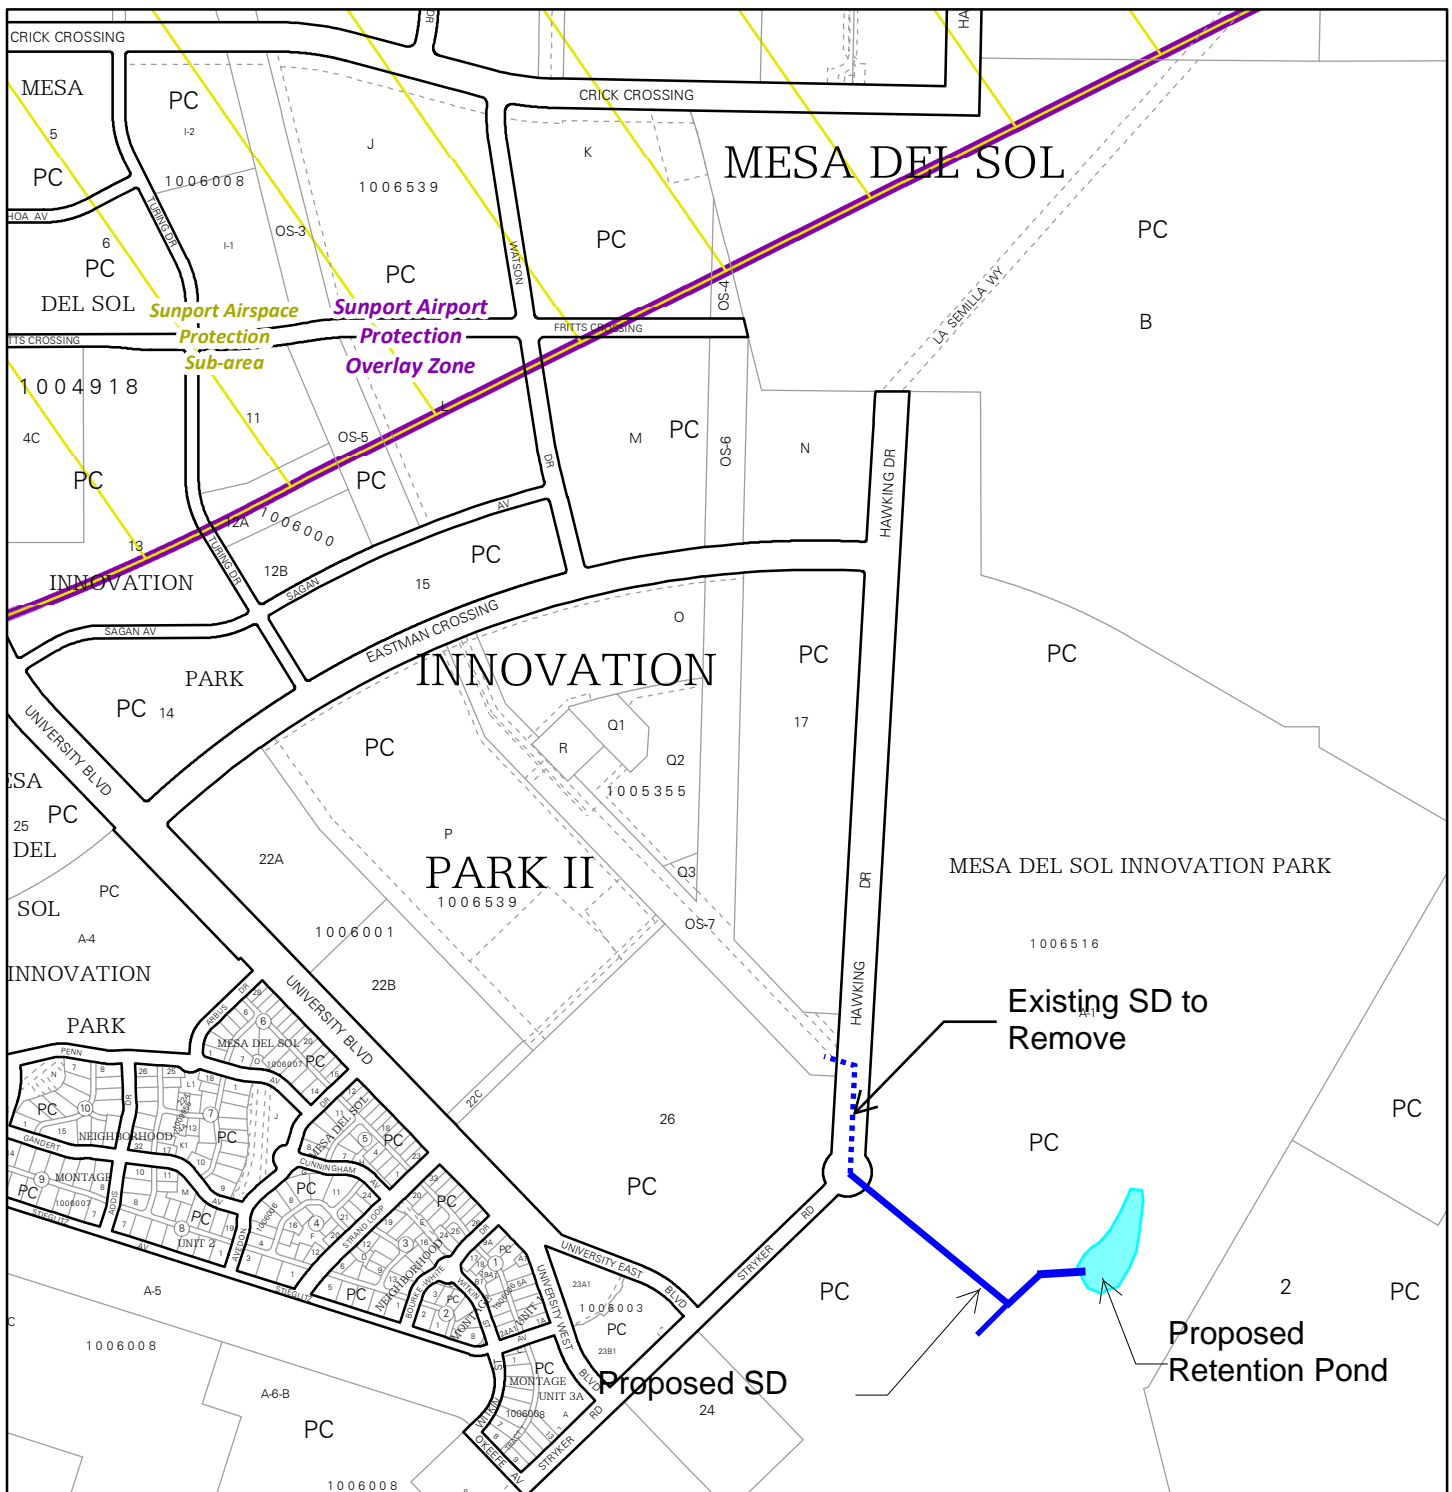


For more details about the Integrated Development Ordinance visit: <http://www.cabq.gov/planning/codes-policies-regulations/integrated-development-ordinance>


# **IDO Zone Atlas** **May 2018**



IDO Zoning information as of May 17, 2018  
The Zone Districts and Overlay Zones  
are established by the  
Integrated Development Ordinance (IDO).

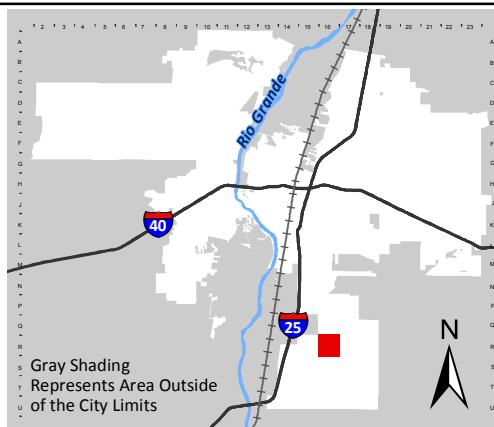

Zone Atlas Page:  
**R-16-Z**

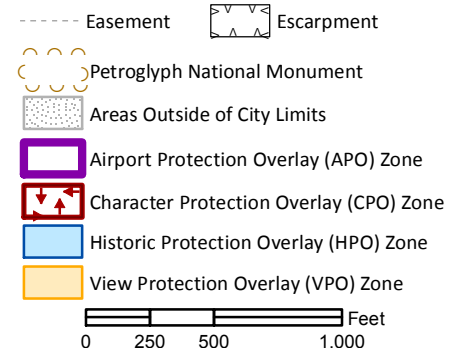

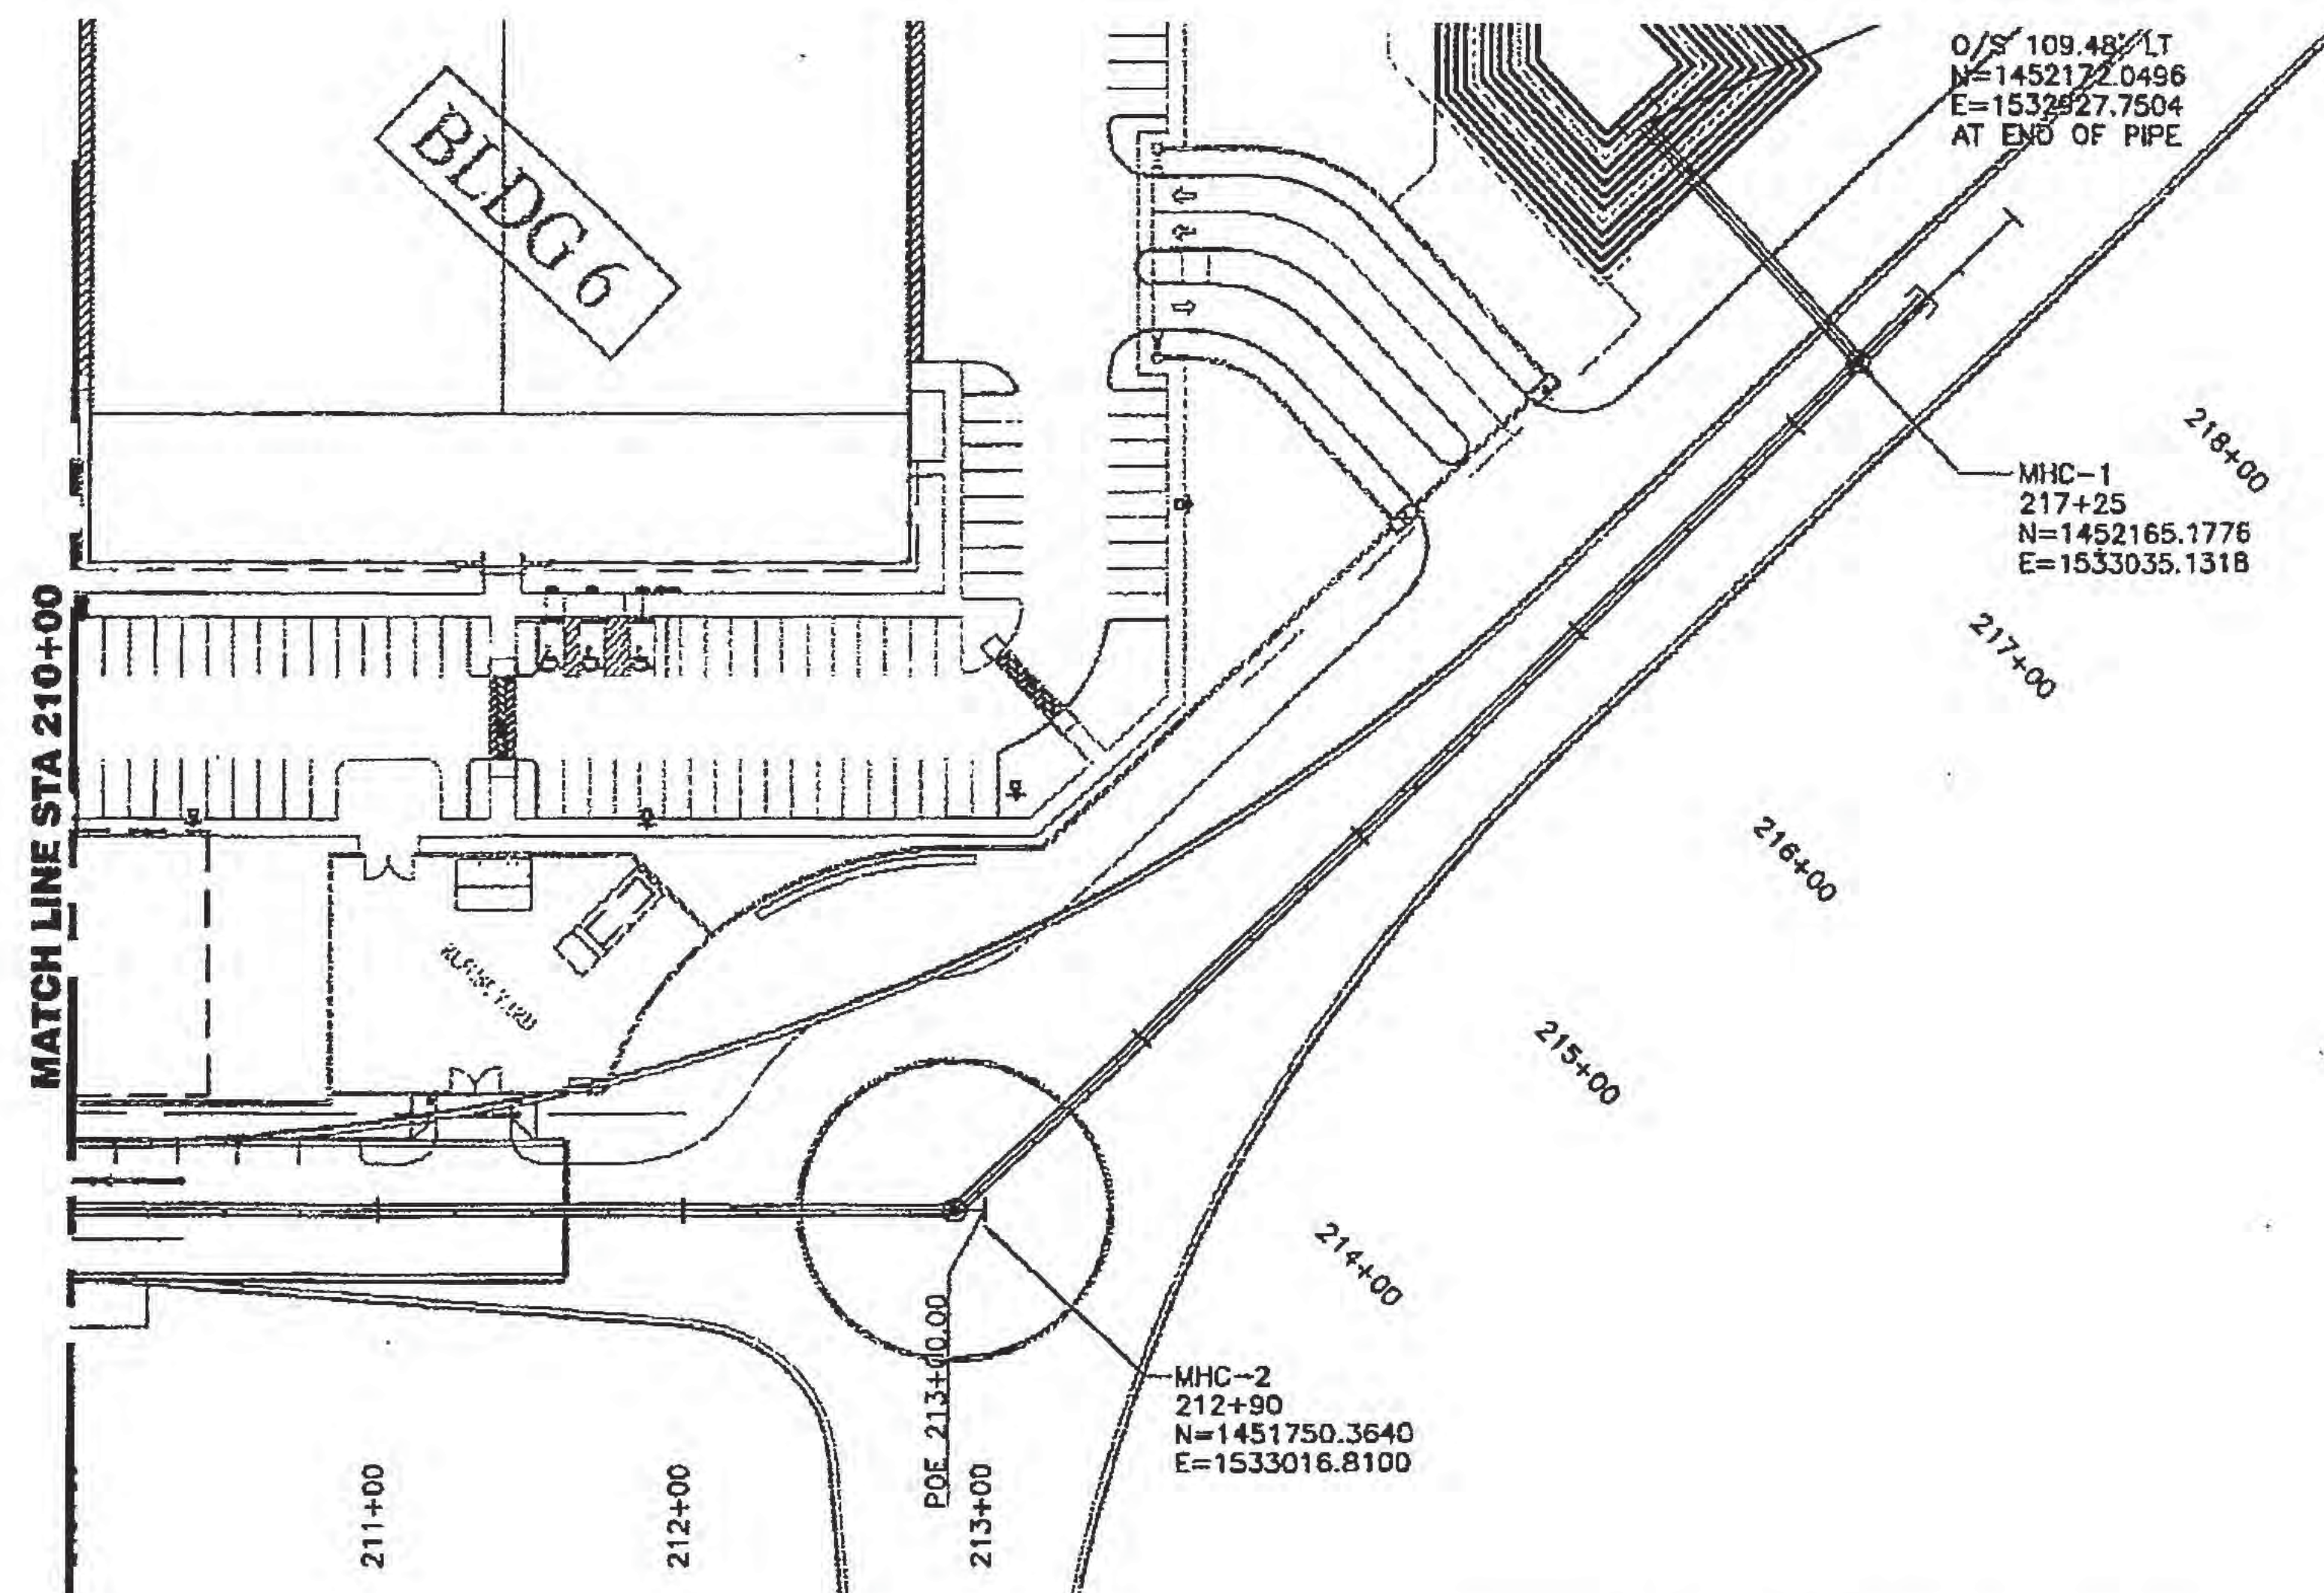


**EXHIBIT B -  
INFRASTRUCTURE AS-BUILTS**











## SIMMS DRIVE STORM DRAIN LINE "C"

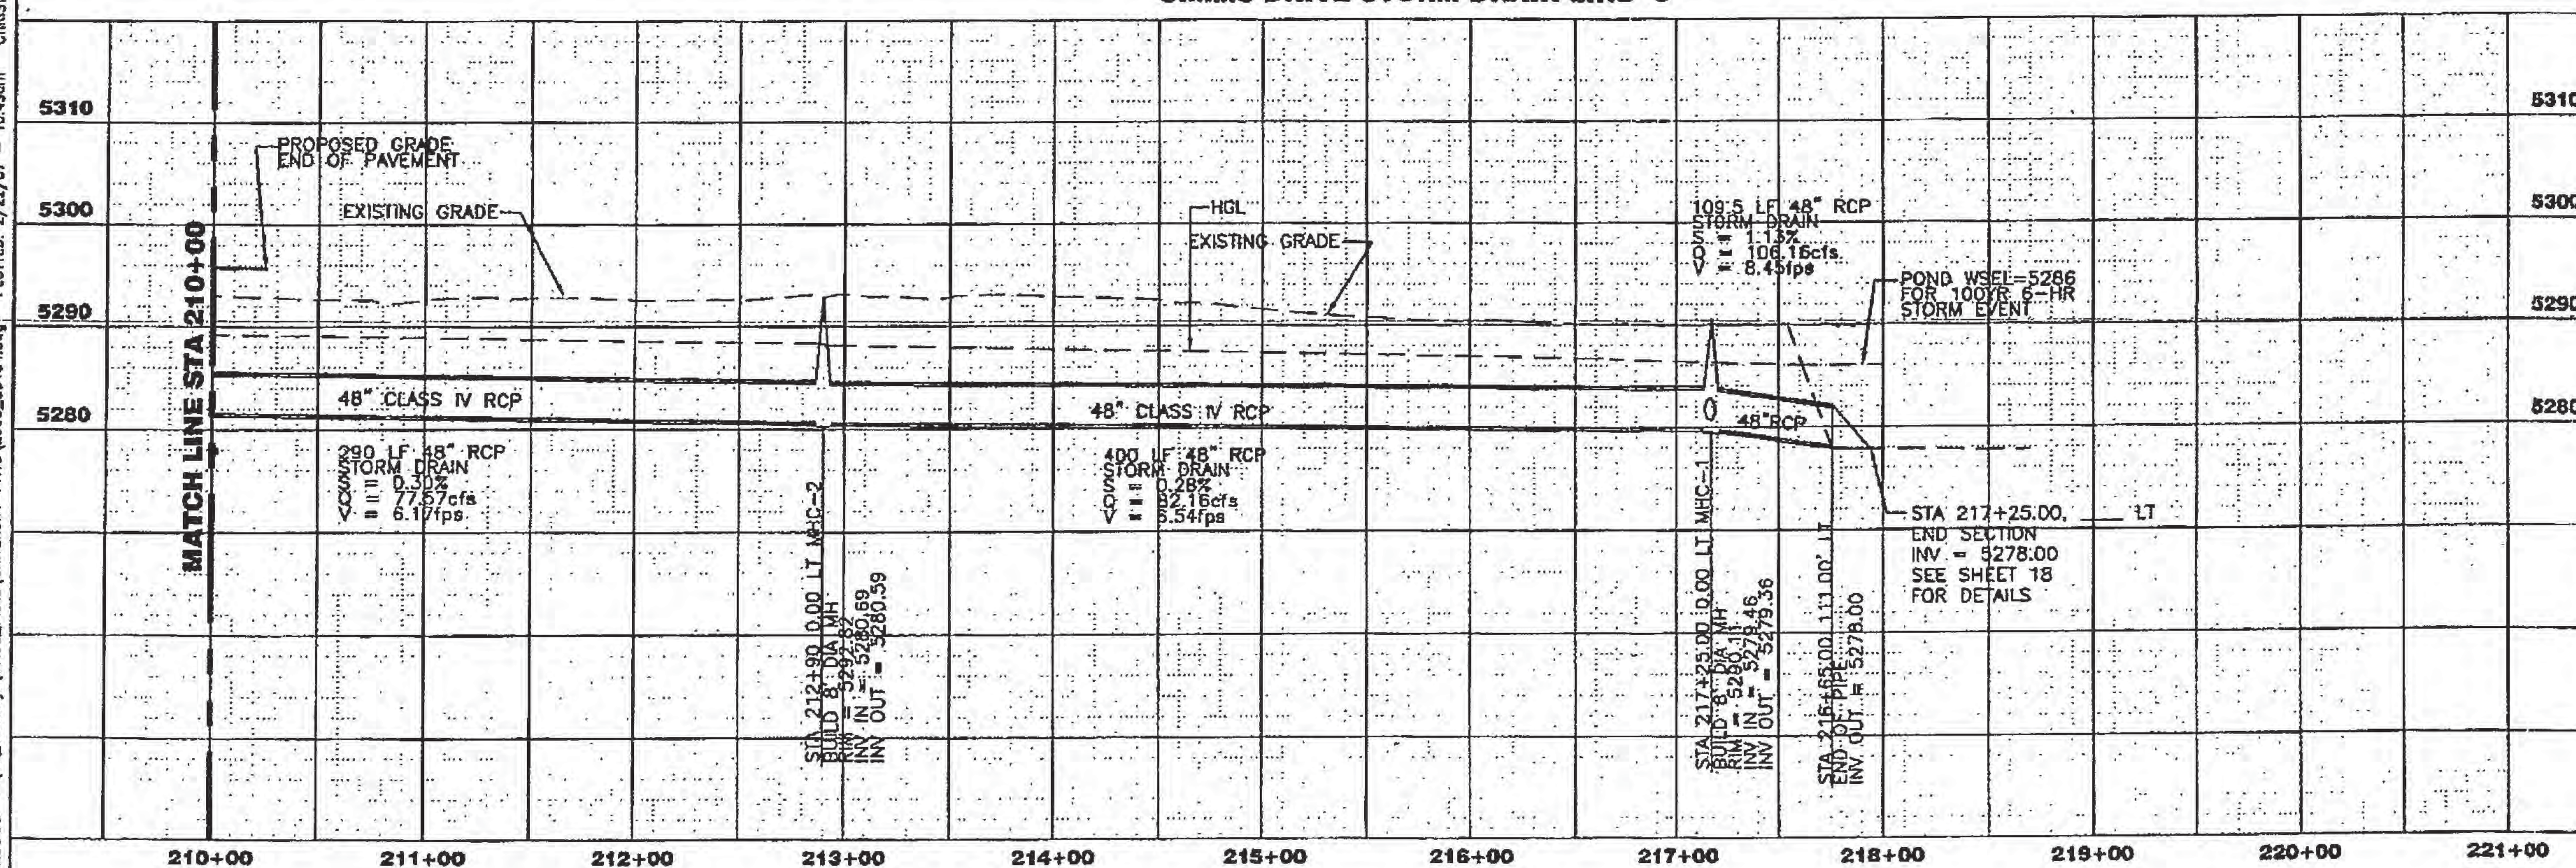

2. ALL STORM DRAIN PIPE  
WILL BE CLASS IV RCP PIPE


## KEYED NOTES

- ① TYPE "A" DOUBLE WING INLET  
SEE SHEET SD--
- ② TYPE "C" MANHOLE PER COA  
STD DWG 2101 FOR DEPTHS  
< 6'. TYPE "E" MANHOLE PER  
COA STD DWG 2102 FOR  
DEPTHS > 6'
- ③ TYPE "A" INLET PER COA STD  
DWG 2201
- ④ PROTECT AND SUPPORT EXISTING  
24" WATERLINE
- ⑤ OUTFALL WITH EROSION CONTROL  
SEE SHEET ---"
- ⑥ WEST POND OUTLET SEE SHEET  
SD--
- ⑦ POND OUTLET STRUCTURE, SEE  
---
- ⑧ DRAINAGE EASEMENT  
REF NO. 2008173798  
RECORDED 17 NOV 2006  
BOOK: A127  
PAGE: 3321
- ⑨ EXISTING EASEMENT  
REF NO: 2008092610  
RECORDED 06 JUN 2006  
BOOK: 2006C  
PAGE: 197

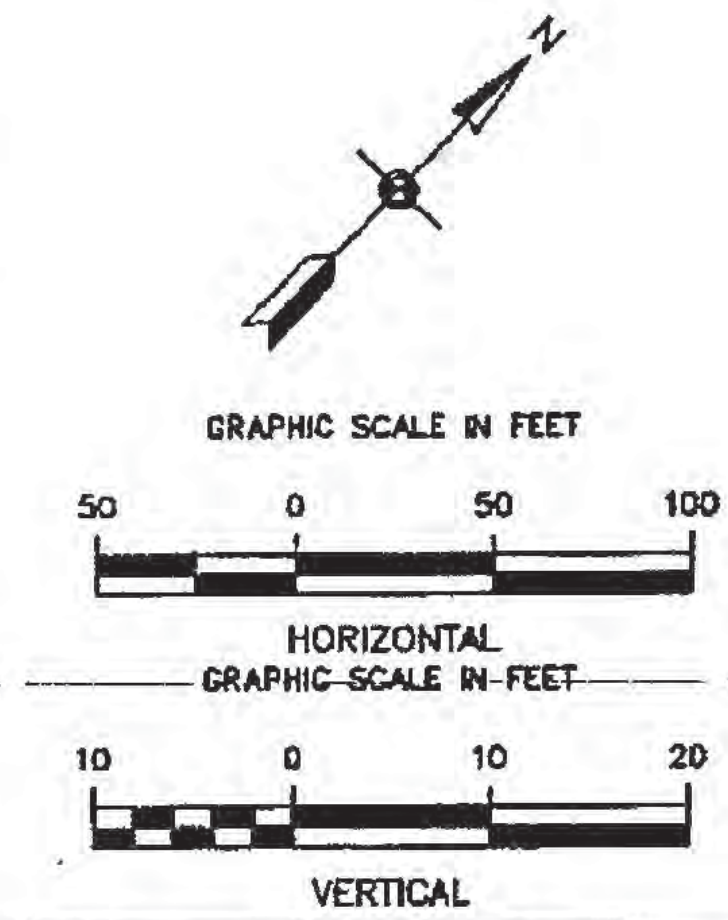

# URS

ONE PARK SQUARE  
6501 AMERICAS PARKWAY, NE  
SUITE 900  
ALBUQUERQUE, NM 87110  
(505) 855-7500



**CITY OF ALBUQUERQUE**  
DEPARTMENT OF  
MUNICIPAL DEVELOPMENT

**TITLE: UNIVERSITY BLVD. EXTENSION - PHASE 1B  
PLAN AND PROFILE  
STA 210+00 TO STA 218+00**

Design Review Committee	City Engineer Approval	Last Design Update	100 / 100%

City Project No. <b>775482</b>	Zone Map No. <b>R-16, S-16</b>	Sheet <b>0</b>	Of
-----------------------------------	-----------------------------------	-------------------	----


24342665 P:\07\_Drawings\07.02\_Plans\UNIVERSITY-PH1B\2665\_SD104.dwg PLOTTED: 2/22/07 - 10:49am CHRISTI\_TANNER



SANITARY SEWER SERVICES			
LOT ID	SAS STATION & OFFSET	SAS LENGTH	TOP OF PIPE AT PLUG (W/ RISER)
1-11	1329+96.02 52.00' LT	22.12'	5296.00
1-12	1330+08.73 52.00' LT	22.12'	5295.90
1-13	1330+29.51 52.00' LT	22.05'	5296.67
1-14	1330+50.28 52.00' LT	22.01'	5296.59
1-15	1330+69.72 51.37' LT	22.66'	5296.44
1-16	1330+89.95 48.82' LT	25.40'	5296.41
3-26	1331+73.02 42.00' LT	32.00'	5296.12
3-27	1332+05.02 42.00' LT	32.00'	5296.16
3-28	1332+40.02 42.00' LT	32.00'	5296.30
3-29	1332+73.12 42.00' LT	32.00'	5296.43
3-30	1333+02.12 42.00' LT	32.00'	5296.57
3-31	1333+63.26 42.00' LT	32.00'	5296.43
3-32	1333+95.23 42.00' LT	32.00'	5296.30
3-33	1334+30.23 42.00' LT	32.00'	5296.16
5-22	1335+46.23 42.00' LT	32.00'	5296.19
5-23	1335+16.23 42.00' LT	32.00'	5296.07

NOTE: WATER METER LOCATIONS ARE DESIGNATED BY STATIONING AT PROPERTY CORNERS.


SANITARY SEWER SERVICES ALONG UNIVERSITY BLVD SHALL BE TERMINATED 5' BEHIND SIDEWALK. WATER SERVICES SHALL ALSO BE EXTENDED 5' BEHIND SIDEWALK (FOR DETAIL SEE SHEET 31)

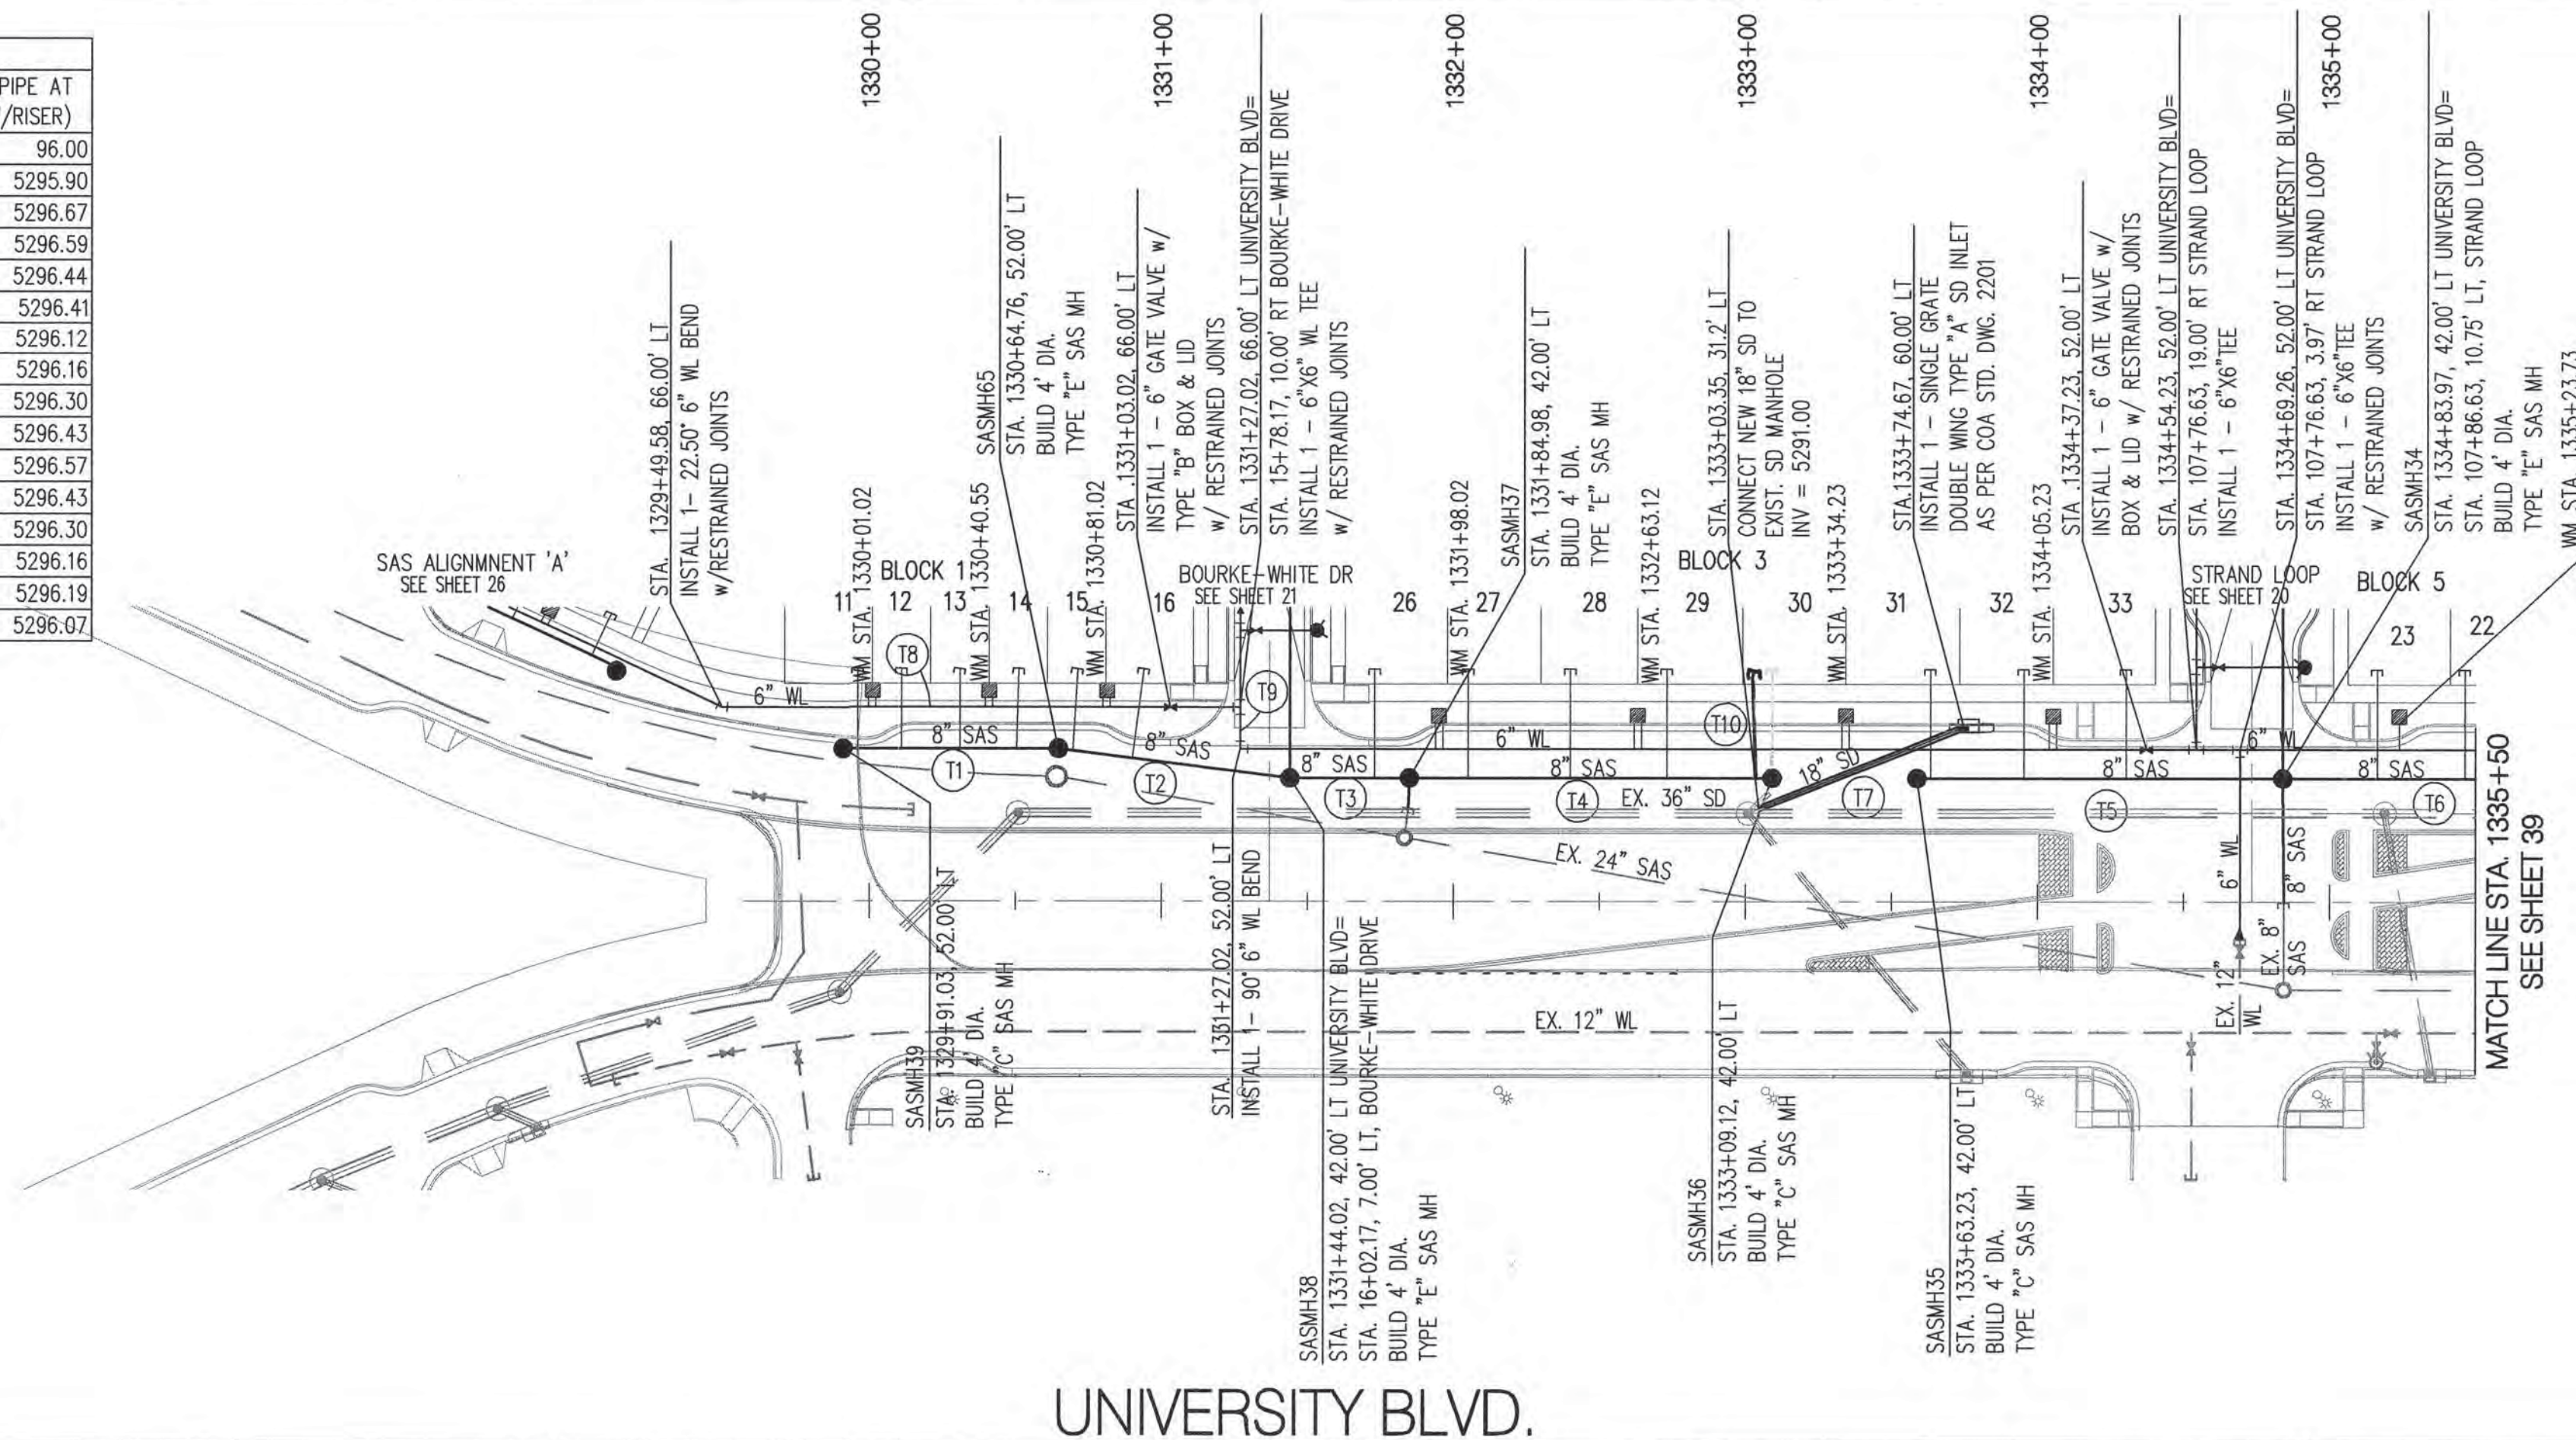

SAS TANGENT TABLE		
ID	BEARING	LENGTH
T1	S43°57'36"E	68.74'
T2	S36°46'10"E	79.89'
T3	S43°57'36"E	40.96'
T4	N43°57'36"W	124.14'
T5	S43°57'36"E	120.75'
T6	N43°57'36"W	182.25'

SD TANGENT TABLE		
ID	BEARING	LENGTH
T7	N65°28'23"W	75.15'

WL TANGENT TABLE		
ID	BEARING	LENGTH
T8	S43°57'36"E	177.44'
T9	N46°02'24"E	14.00'
T10	S43°57'36"E	1324.84'

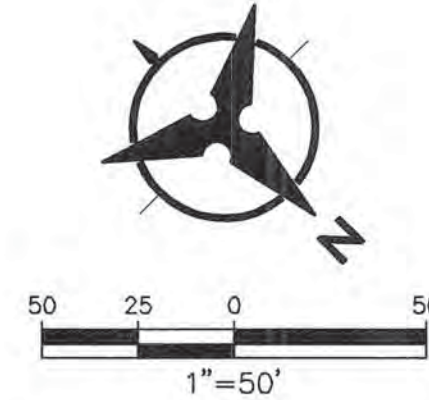

## GENERAL NOTES

- THE CONTRACTOR SHALL FIELD VERIFY ALL EXISTING UTILITY LOCATIONS AND NOTIFY THE ENGINEER IMMEDIATELY OF ANY DISCREPANCIES.
- ALL CURVE DATA AND DIMENSIONS ARE CALCULATED FROM CENTERLINE OF PIPE OR MANHOLE. ALL SAS & SD SLOPES ARE CALCULATED TO TRUE PIPE DIMENSIONS FROM INVERT TO INVERT. (PAY ITEMS ARE SHOWN IN PARENTHESES)
- GRADE ELEVATIONS, WHERE NOTED, ARE FOR FLOWLINE OF STANDARD CURB UNLESS OTHERWISE SPECIFIED.
- CONTRACTOR IS TO INSTALL A 4" X 4" X 5' POST AND E.M.S. AT THE END OF EACH SANITARY SEWER SERVICE.
- CONTRACTOR IS RESPONSIBLE FOR REPAIR AND/OR REPLACEMENT OF ALL DAMAGED EXISTING UTILITY CONDUITS AND EXISTING LINES.
- CONTRACTOR SHALL PROVIDE THE INSPECTORS WITH THE PROPOSED HYDRO-STATIC PRESSURE TESTING PLAN. THE PLAN MUST BE APPROVED BEFORE TESTING OPERATIONS BEGIN.
- CONTRACTOR SHALL PARK EQUIPMENT AND VEHICLES AS NOT TO INTERFERE WITH NORMAL ACTIVITIES OF RESIDENTS OR OTHER CONTRACTORS ON SITE.
- ANY DAMAGE TO THE EXISTING FACILITIES (CURB & GUTTER, PAVEMENT, LANDSCAPING, ETC.) DURING CONSTRUCTION SHALL BE REPLACED AT THE CONTRACTOR'S EXPENSE.
- MH RIMS & CATCH BASIN INLET ELEVATIONS, FIRE HYDRANT & FLANGE ELEVATIONS ARE APPROXIMATE. CONTRACTOR SHALL FIELD VERIFY AND ADJUST TO FINAL PAVEMENT OR SURFACE GRADES.
- SAS STATIONING FOLLOWS CL OF ROAD UNLESS OTHERWISE NOTED.
- STATIONING OF DROP INLET IS TO MIDDLE OF DOWN HILL GRATE AT FACE OF CURB.
- FLOWLINE ELEVATIONS FOR DROP INLETS ARE PROJECTED FROM FLOWLINE OF STANDARD CURB TO MIDDLE OF DOWNHILL GRATE.
- ALL WATERLINE APPURTENANCES SHALL USE RESTRAINED JOINTS.
- AT UTILITY CROSSING WHERE LESS THAN 1 FOOT OF COVER OVER STORM DRAIN PIPE IS PRESENT LEAN FILL IS TO BE USED FOR A DISTANCE OF 5 FEET ON EACH SIDE OF THE SD & FROM TOP OF STORM DRAIN TO BOTTOM OF SANITARY SEWER OR WATER LINE.
- CONTRACTOR SHALL ADJUST ALL EXISTING MANHOLE RIMS AND VALVE BOXES TO FINISHED GRADE WITHIN UNIVERSITY BLVD.

## LEGEND

- DOUBLE WATER METER
- SINGLE WATER METER
- WATER LINE SHUTOFF VALVE
- WATER LINE TEE
- SAS LATERAL
- SAS MANHOLE
- STORM DRAIN MANHOLE
- STORM DRAIN INLET
- PROPOSED FIRE HYDRANT
- EXISTING WATER VALVE

**Mesa del Sol**

**Bohannon & Huston**

Courtyard I 7800 Jefferson St. NE Albuquerque, NM 87109-4335  
ENGINEERING • SPATIAL DATA • ADVANCED TECHNOLOGIES



**CITY OF ALBUQUERQUE  
PUBLIC WORKS DEPARTMENT**

MESA DEL SOL NEIGHBORHOOD MONTAGE UNIT 1  
UNIVERSITY BLVD. STA. 1330+50 TO STA. 1335+50  
UTILITY PLAN AND PROFILE



City Project No.

775485

Zone Map No.

R-15,16 S-16


Sheet

38

Of

43



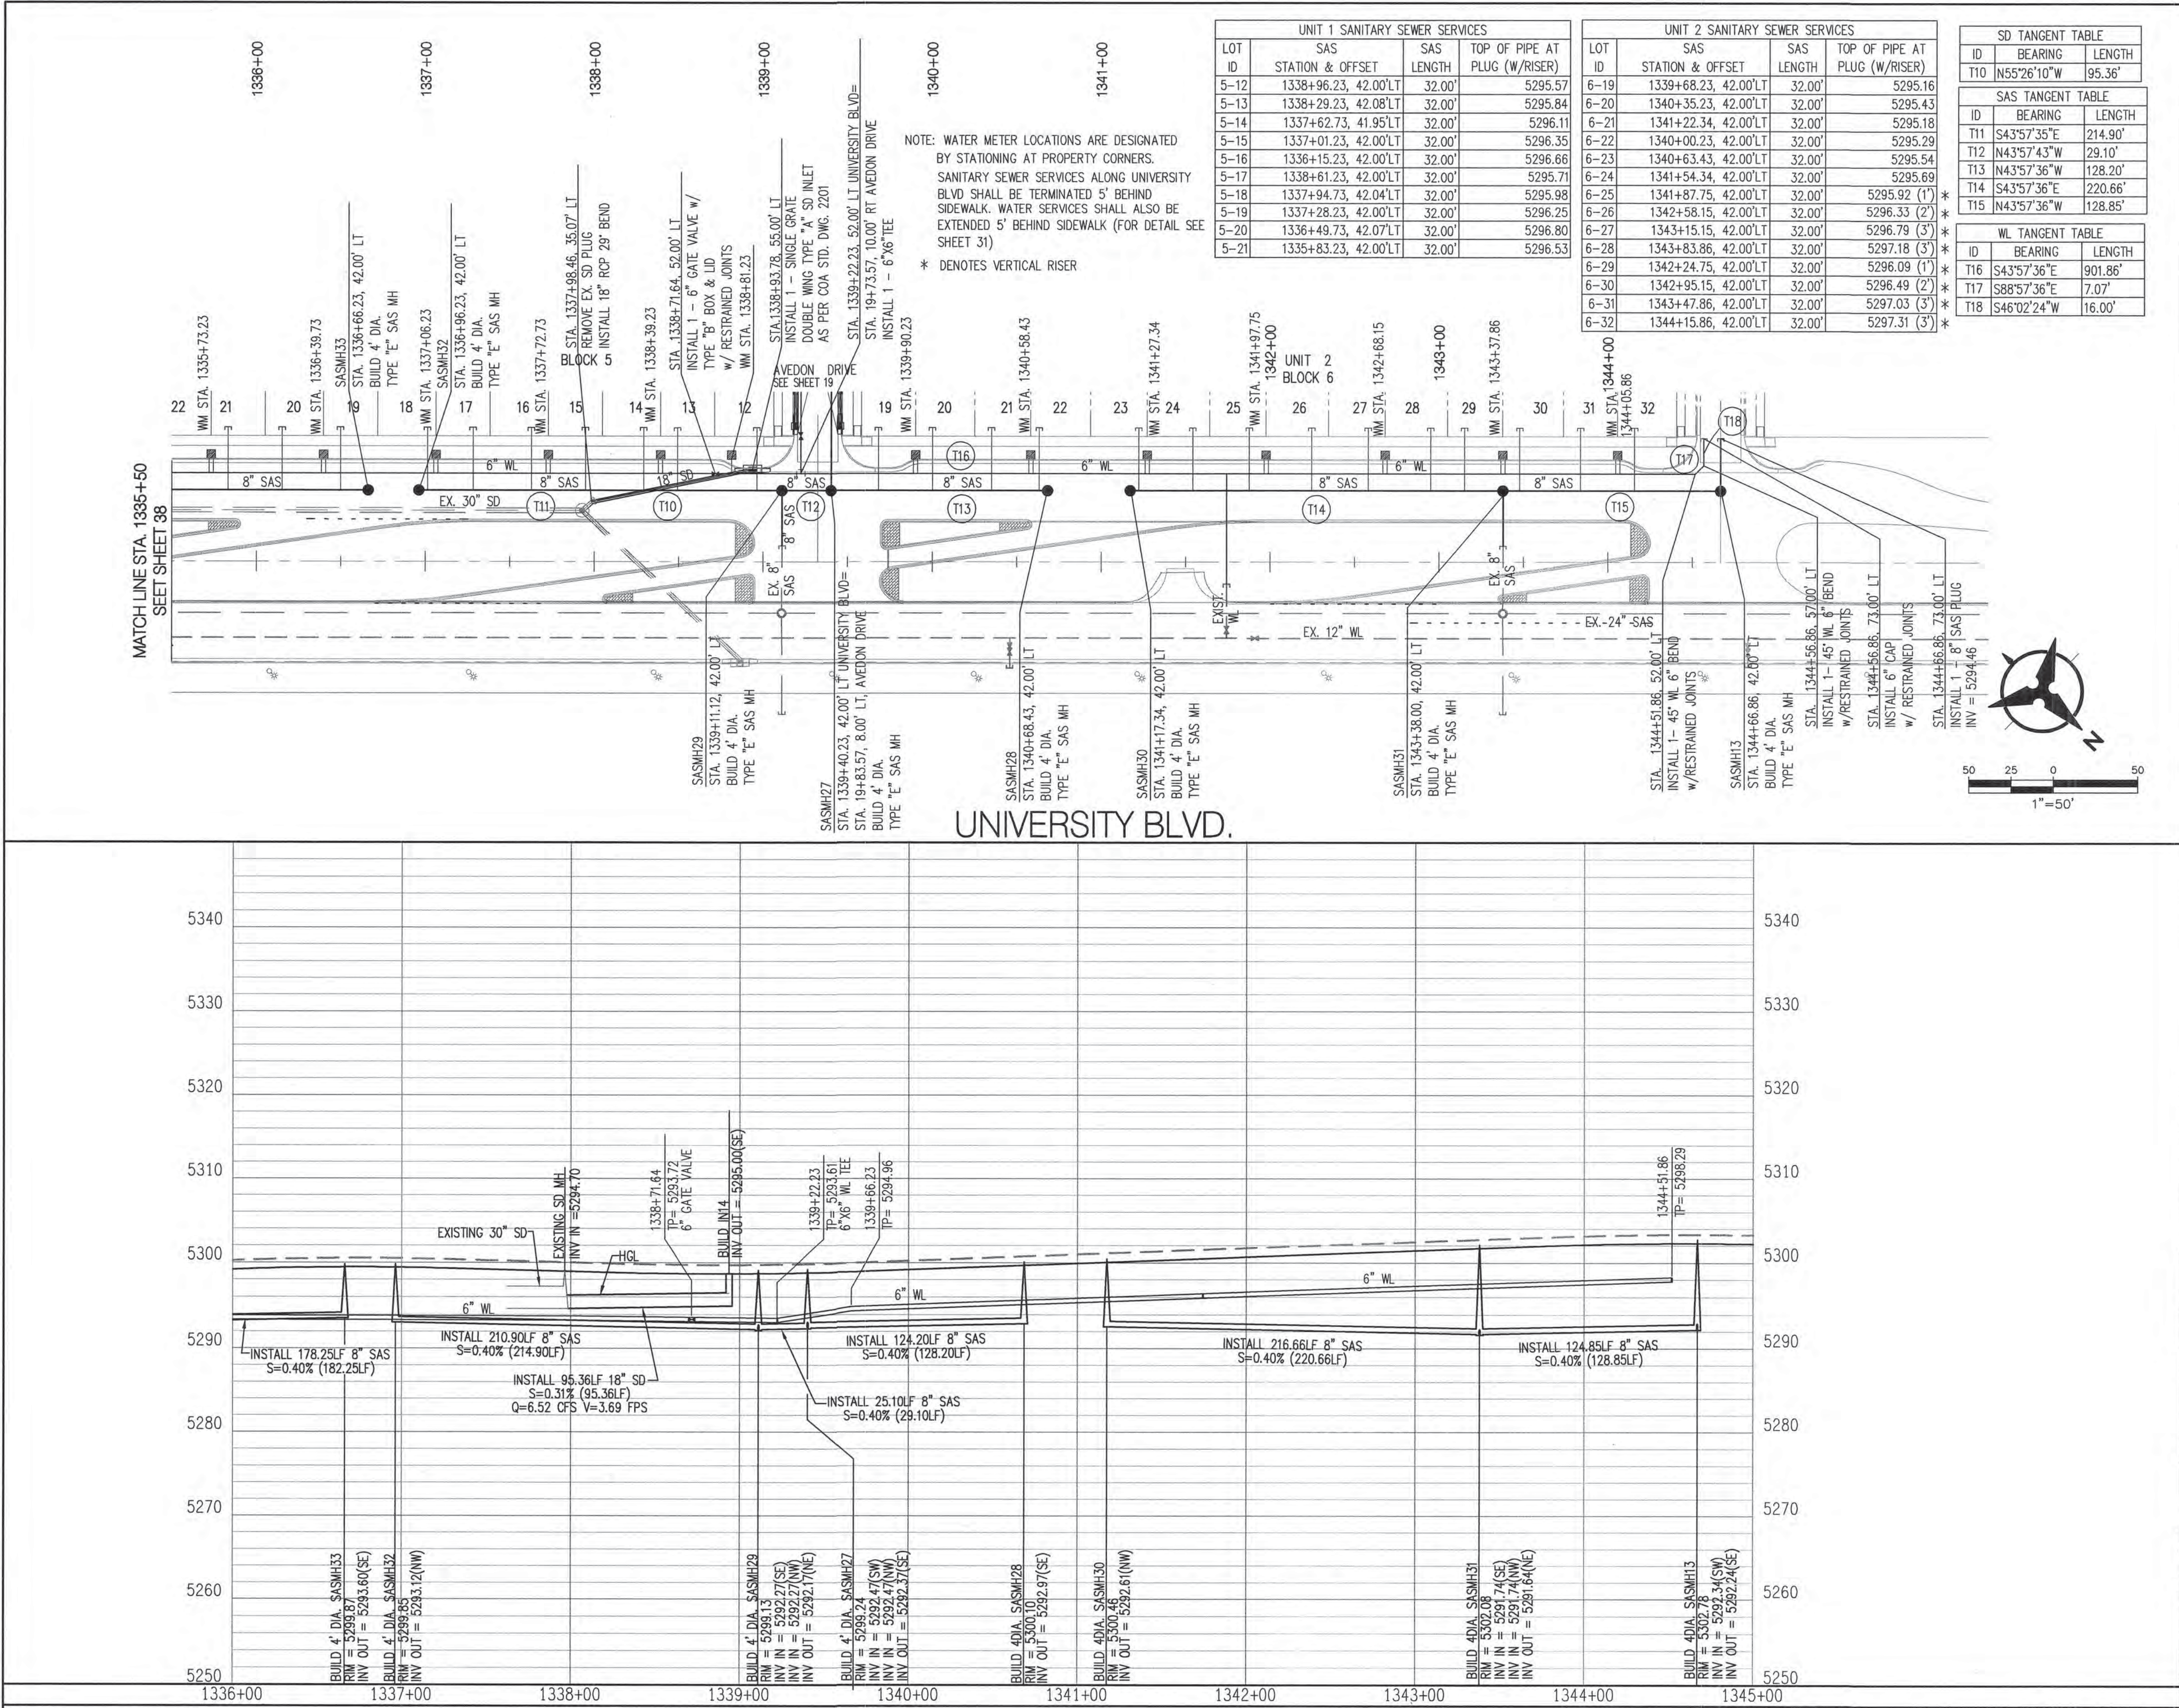

UNIT 1 SANITARY SEWER SERVICES			
LOT ID	SAS STATION & OFFSET	SAS LENGTH	TOP OF PIPE AT PLUG (W/ RISER)
5-12	1338+96.23, 42.00' LT	32.00'	5295.57
5-13	1338+29.23, 42.08' LT	32.00'	5295.84
5-14	1337+62.73, 41.95' LT	32.00'	5296.11
5-15	1337+01.23, 42.00' LT	32.00'	5296.35
5-16	1336+15.23, 42.00' LT	32.00'	5296.66
5-17	1338+61.23, 42.00' LT	32.00'	5295.71
5-18	1337+94.73, 42.04' LT	32.00'	5295.98
5-19	1337+28.23, 42.00' LT	32.00'	5296.25
5-20	1336+49.73, 42.07' LT	32.00'	5296.80
5-21	1335+83.23, 42.00' LT	32.00'	5296.53

UNIT 2 SANITARY SEWER SERVICES			
LOT ID	SAS STATION & OFFSET	SAS LENGTH	TOP OF PIPE AT PLUG (W/ RISER)
6-19	1339+68.23, 42.00' LT	32.00'	5295.16
6-20	1340+35.23, 42.00' LT	32.00'	5295.43
6-21	1341+22.34, 42.00' LT	32.00'	5295.18
6-22	1340+00.23, 42.00' LT	32.00'	5295.29
6-23	1340+63.43, 42.00' LT	32.00'	5295.54
6-24	1341+54.34, 42.00' LT	32.00'	5295.69
6-25	1341+87.75, 42.00' LT	32.00'	5295.92 (1) *
6-26	1342+58.15, 42.00' LT	32.00'	5296.33 (2) *
6-27	1343+15.15, 42.00' LT	32.00'	5296.79 (3) *
6-28	1343+83.86, 42.00' LT	32.00'	5297.18 (3) *
6-29	1342+24.75, 42.00' LT	32.00'	5296.09 (1) *
6-30	1342+95.15, 42.00' LT	32.00'	5296.49 (2) *
6-31	1343+47.86, 42.00' LT	32.00'	5297.03 (3) *
6-32	1344+15.86, 42.00' LT	32.00'	5297.31 (3) *

SD TANGENT TABLE		
ID	BEARING	LENGTH
T10	N55°26'10"W	95.36'

SAS TANGENT TABLE		
ID	BEARING	LENGTH
T11	S43°57'35"E	214.90'
T12	N43°57'43"W	29.10'
T13	N43°57'36"W	128.20'
T14	S43°57'36"E	220.66'
T15	N43°57'36"W	128.85'

WL TANGENT TABLE		
ID	BEARING	LENGTH
T16	S43°57'36"E	901.86'
T17	S88°57'36"E	7.07'
T18	S46°02'24"W	16.00'

- GENERAL NOTES**
- THE CONTRACTOR SHALL FIELD VERIFY ALL EXISTING UTILITY LOCATIONS AND NOTIFY THE ENGINEER IMMEDIATELY OF ANY DISCREPANCIES.
  - ALL CURVE DATA AND DIMENSIONS ARE CALCULATED FROM CENTERLINE OF PIPE OR MANHOLE. ALL SAS & SD SLOPES ARE CALCULATED TO TRUE PIPE DIMENSIONS FROM INVERT TO INVERT. (PAY ITEMS ARE SHOWN IN PARENTHESES)
  - GRADE ELEVATIONS, WHERE NOTED, ARE FOR FLOWLINE OF STANDARD CURB UNLESS OTHERWISE SPECIFIED.
  - CONTRACTOR IS TO INSTALL A 4" X 4" X 5' POST AND E.M.S. AT THE END OF EACH SANITARY SEWER SERVICE.
  - CONTRACTOR IS RESPONSIBLE FOR REPAIR AND/OR REPLACEMENT OF ALL DAMAGED EXISTING UTILITY CONDUITS AND EXISTING LINES.
  - CONTRACTOR SHALL PROVIDE THE INSPECTORS WITH THE PROPOSED HYDRO-STATIC PRESSURE TESTING PLAN. THE PLAN MUST BE APPROVED BEFORE TESTING OPERATIONS BEGIN.
  - CONTRACTOR SHALL PARK EQUIPMENT AND VEHICLES AS NOT TO INTERFERE WITH NORMAL ACTIVITIES OF RESIDENTS OR OTHER CONTRACTORS ON SITE.
  - ANY DAMAGE TO THE EXISTING FACILITIES (CURB & GUTTER, PAVEMENT, LANDSCAPING, ETC.) DURING CONSTRUCTION SHALL BE REPLACED AT THE CONTRACTOR'S EXPENSE.
  - MH RIMS & CATCH BASIN INLET ELEVATIONS, FIRE HYDRANT & FLANGE ELEVATIONS ARE APPROXIMATE. CONTRACTOR SHALL FIELD VERIFY AND ADJUST TO FINAL PAVEMENT OR SURFACE GRADES.
  - SAS STATIONING FOLLOWS CL OF ROAD UNLESS OTHERWISE NOTED.
  - STATIONING OF DROP INLET IS TO MIDDLE OF DOWN HILL GRATE AT FACE OF CURB.
  - FLOWLINE ELEVATIONS FOR DROP INLETS ARE PROJECTED FROM FLOWLINE OF STANDARD CURB TO MIDDLE OF DOWNHILL GRATE.
  - ALL WATERLINE APPURTENANCES SHALL USE RESTRAINED JOINTS.
  - AT UTILITY CROSSING WHERE LESS THAN 1 FOOT OF COVER OVER STORM DRAIN PIPE IS PRESENT LEAN FILL IS TO BE USED FOR A DISTANCE OF 5 FEET ON EACH SIDE OF THE SD & FROM TOP OF STORM DRAIN TO BOTTOM OF SANITARY SEWER OR WATER LINE.
  - CONTRACTOR SHALL ADJUST ALL EXISTING MANHOLE RIMS AND VALVE BOXES TO FINISHED GRADE WITHIN UNIVERSITY BLVD.

- LEGEND**
- DOUBLE WATER METER
  - SINGLE WATER METER
  - WATER LINE SHUTOFF VALVE
  - WATER LINE TEE
  - SAS LATERAL
  - SAS MANHOLE
  - STORM DRAIN MANHOLE
  - STORM DRAIN INLET
  - PROPOSED FIRE HYDRANT
  - EXISTING WATER VALVE

Courtney | 7800 Jefferson St. NE Albuquerque, NM 87109-4385  
ENGINEERING • SPATIAL DATA • ADVANCED TECHNOLOGIES

**CITY OF ALBUQUERQUE**  
**PUBLIC WORKS DEPARTMENT**

MESA DEL SOL NEIGHBORHOOD MONTAGE UNIT 1  
UNIVERSITY BLVD  
UTILITY PLAN AND PROFILE

Design Review Committee	City Engineer Approval	Mo./Day/Yr.	Mo./Day/Yr.


City Project No. **775485** Zone Map No. **R-15,16 S-16** Sheet **39** Of **43**

AS-BUILT INFORMATION		BENCH MARKS		SURVEY INFORMATION		ENGINEER'S SEAL	
CONTRACTOR	DATE	CONTRACTOR	DATE	NO.	DATE	NO.	DATE
WORK BY	DATE	ACS BRASS TABLE STAMPED "1, R16, 1984"	DATE	BY	DATE	By	DATE
INSPECTOR'S ACCEPTANCE BY	DATE	GEOGRAPHIC POSITION (NAD 83)	DATE	REMARKS	REVISIONS	REMARKS	REVISIONS
VERIFICATION BY	DATE	N.M. STATE PLANE COORDINATES (CENTRAL ZONE)	DATE	No.	Date	No.	Date
DESIGNED BY	DATE	X = 1,532,715.669 Y = 1,453,438.899	DATE	DESIGN	DESIGN	DESIGN	DESIGN
DRAWN BY	DATE	GROUND-TO-GRID FACTOR = 0.999664099	DATE				
CHECKED BY	DATE	Δα = -00°12'22.46"	DATE				
	NO.	NAVD 1988 ELEVATION = 5291.451	NO.				








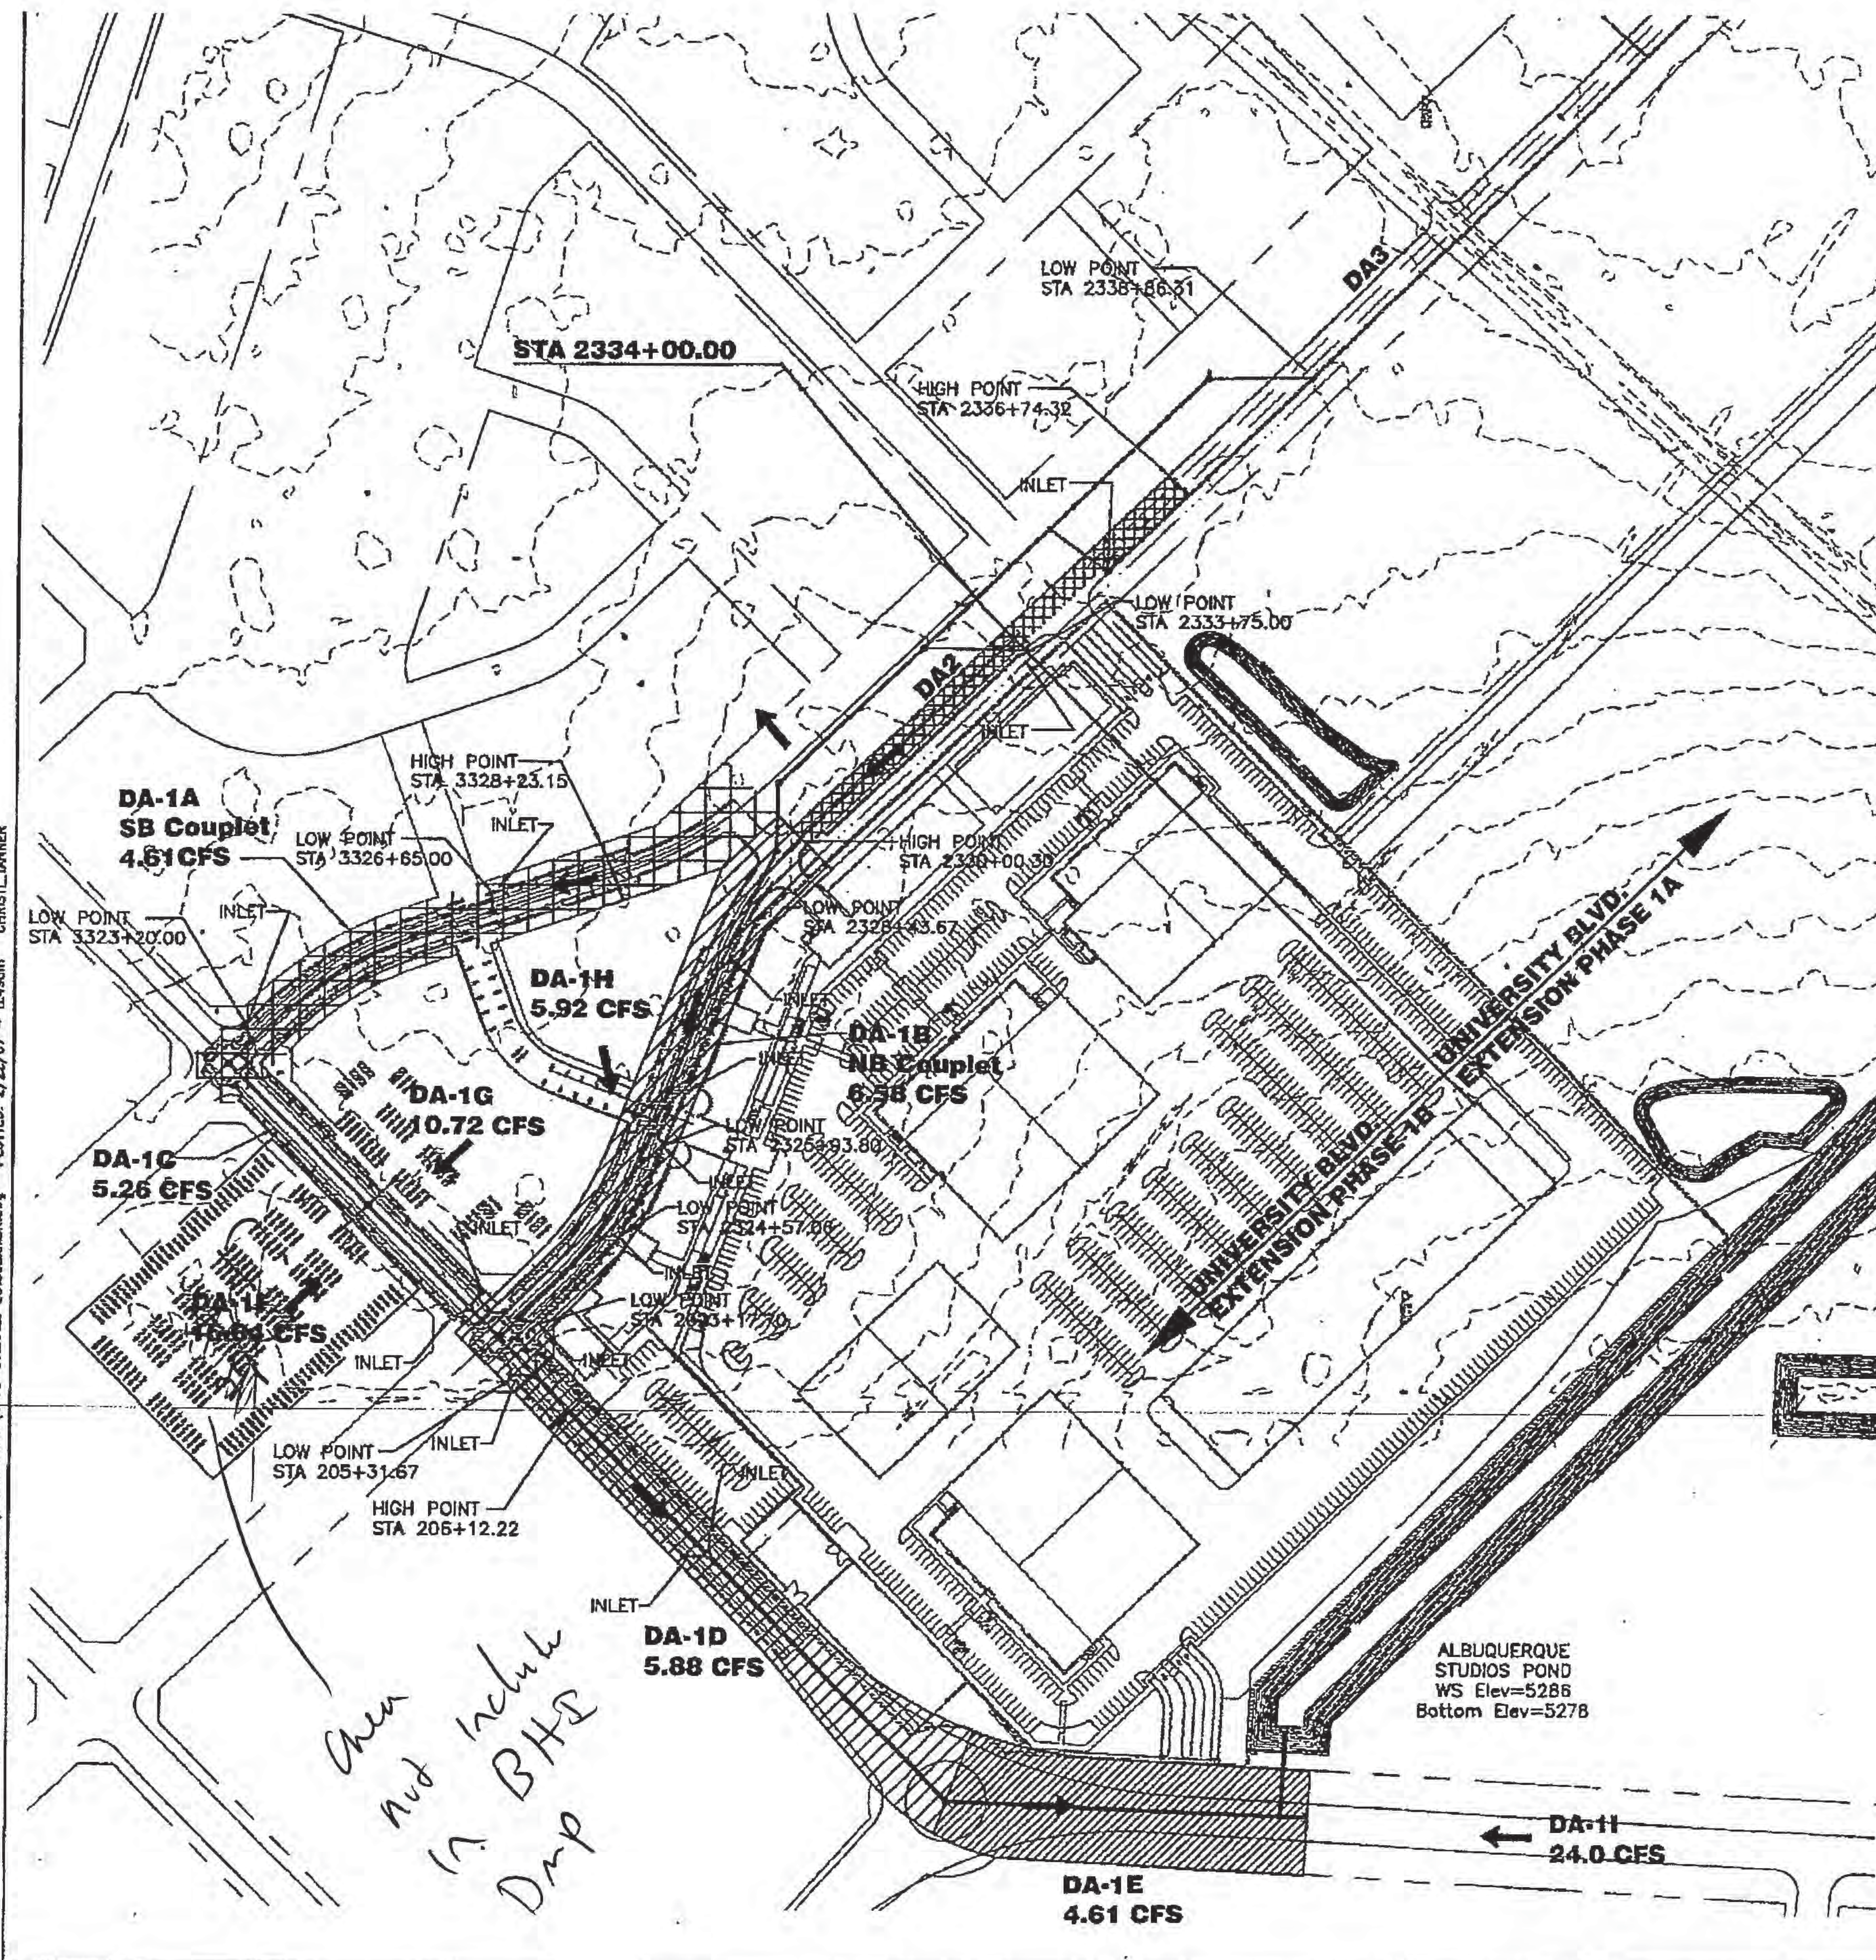

ENGINEER'S SEAL				SURVEY INFORMATION				BENCH MARKS				AS BUILT INFO			
				FIELD NOTES				ACS 3-1/4" ALUMINUM CAP RIVETED TO A TUBE SET IN A CONCRETE BASE IN THE GROUND STAMPED "5-0-14, 1987," FROM THE RIO BRAVO BLVD AND BROADWAY INTERSECTION GO SOUTH 0.9 MILES AND PROCEED 123' WEST OF THE CENTERLINE. STATE PLANE COORDINATES (CENTRAL ZONE, NAD83/NAVDB88) N=1480471.432, E=1521388.180 (GROUND) ELEVATION=4981.17'				CONTRACTOR WORK DRAWN BY CHECKED BY RECORDED BY			
				No.	By		Date								
REVISIONS				DESIGN											
Designed By				CR				Date				10/08			
Drawn By				UKS				Date				10/08			
Checked By				EPB				Date				10/08			
No.				Remarks				By							

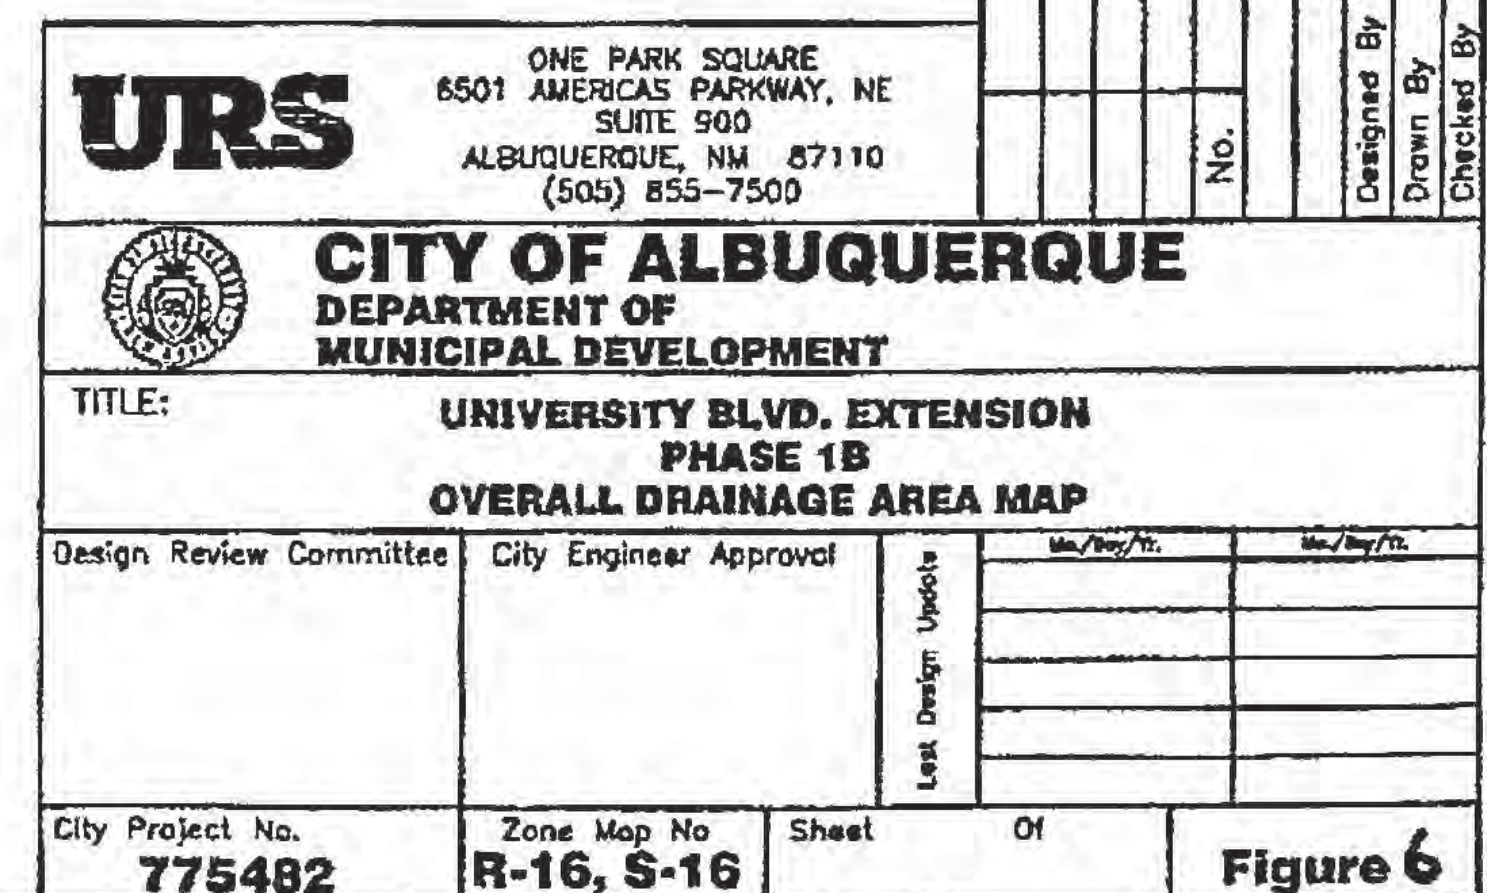












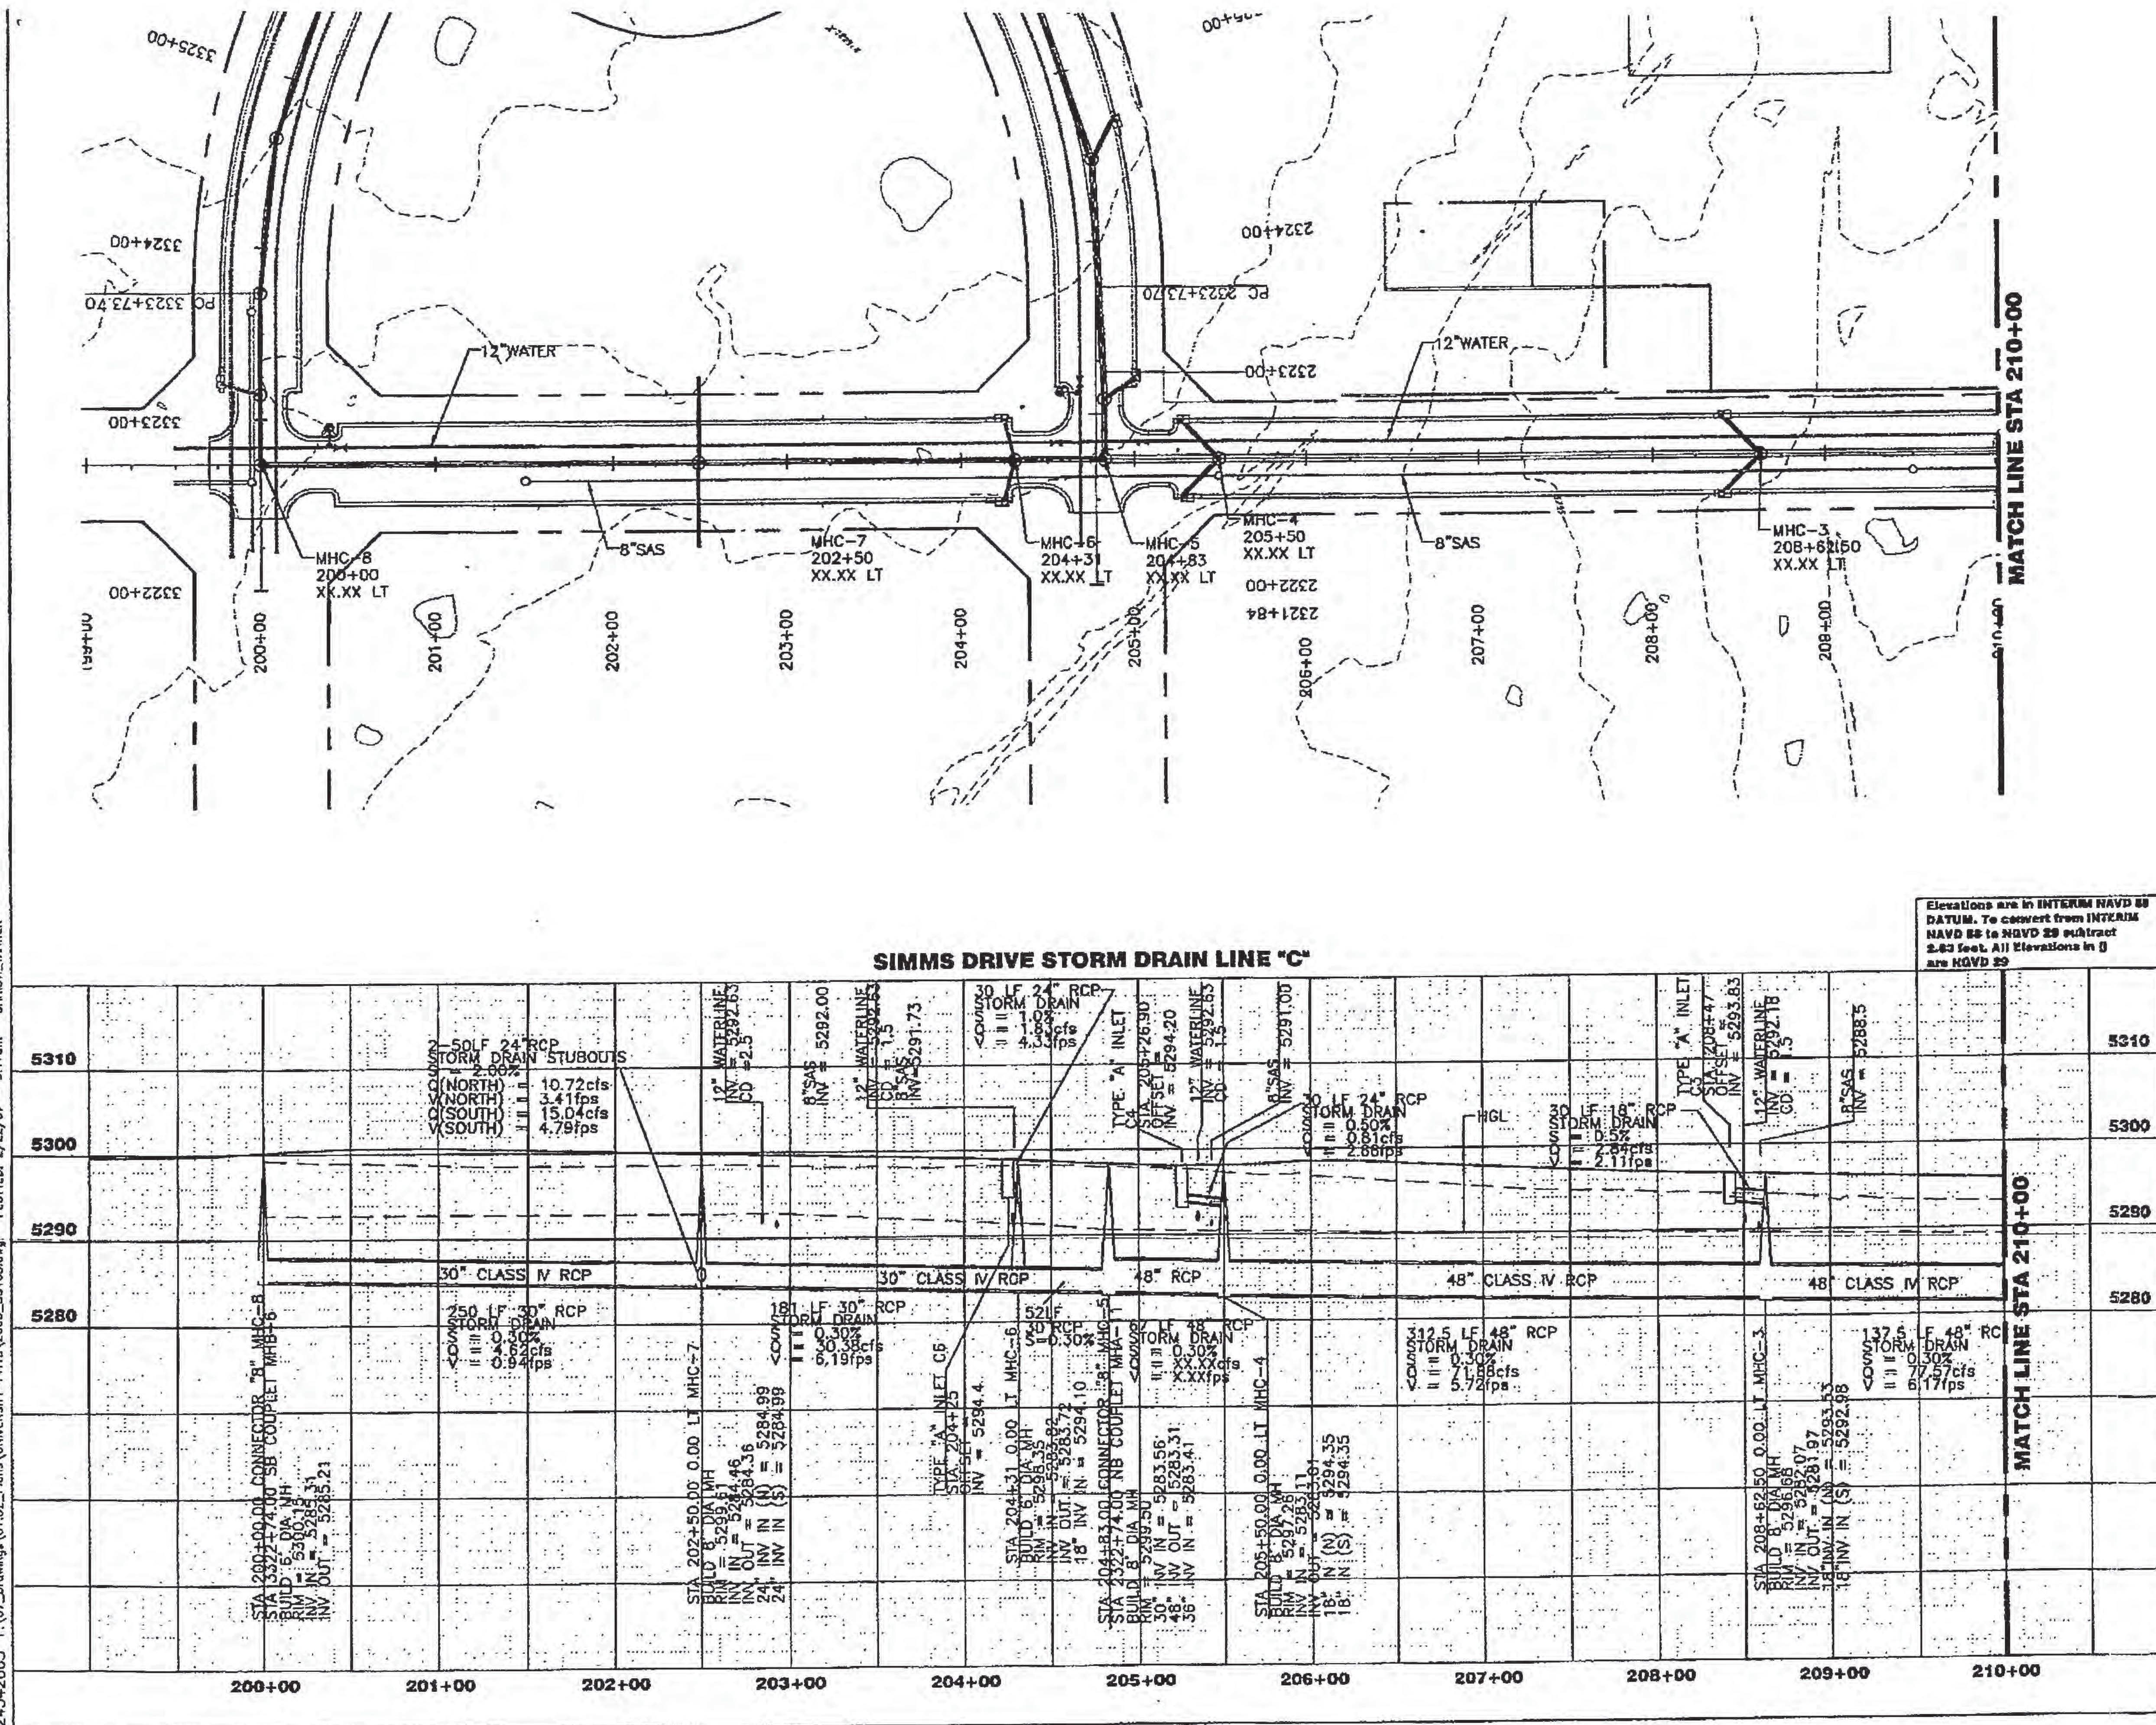


2. ALL STORM DRAIN PIPE  
WILL BE CLASS IV RCP PIPE

## KEYED NOTES

- ① TYPE "A" DOUBLE WING INLET  
SEE SHEET SD--
- ② TYPE "C" STD MANHOLE PER COA  
STD DWG 2101 FOR DEPTHS  
< 8'. TYPE "E" MANHOLE PER  
COA STD DWG 2102 FOR  
DEPTHS > 8'
- ③ TYPE "A" INLET PER COA STD  
DWG 2201
- ④ PROTECT AND SUPPORT EXISTING  
24" WATERLINE
- ⑤ OUTFALL WITH EROSION CONTROL  
SEE SHEET -- --
- ⑥ WEST POND OUTLET SEE SHEET  
SD--
- ⑦ POND OUTLET STRUCTURE, SEE  
\_\_\_\_\_
- ⑧ DRAINAGE EASEMENT  
REF NO. 2006173798  
RECORDED 17 NOV 2006  
BOOK: A127  
PAGE: 3321
- ⑨ EXISTING EASEMENT  
REF NO. 2006092610  
RECORDED 06 JUN 2006  
BOOK: 2006C  
PAGE: 197

ENGINEER'S SEAL						SURVEY INFORMATION		BENCH MARKS		AS BUILT INFO	
						FIELD NOTES					
No.	Remarks	By	No.	By	Date						
						ACS 3-1/4" ALUMINUM CAP RIVETED TO A TUBE SET IN A CONCRETE BASE IN THE GROUND STAMPED "S-O-14, 1987", FROM THE RIO BRAVO BLVD AND BROADWAY INTERSECTION GO SOUTH 0.9 MILES AND PROCEED 123' WEST OF THE CENTERLINE. STATE PLANE COORDINATES [CENTRAL ZONE, NAD83/NAVD88] N=1460471.432, E=#		MICRO-FILM IN RECORD BY			
Designed By	URS		Date	10/06							
Drawn By			Date	10/06							

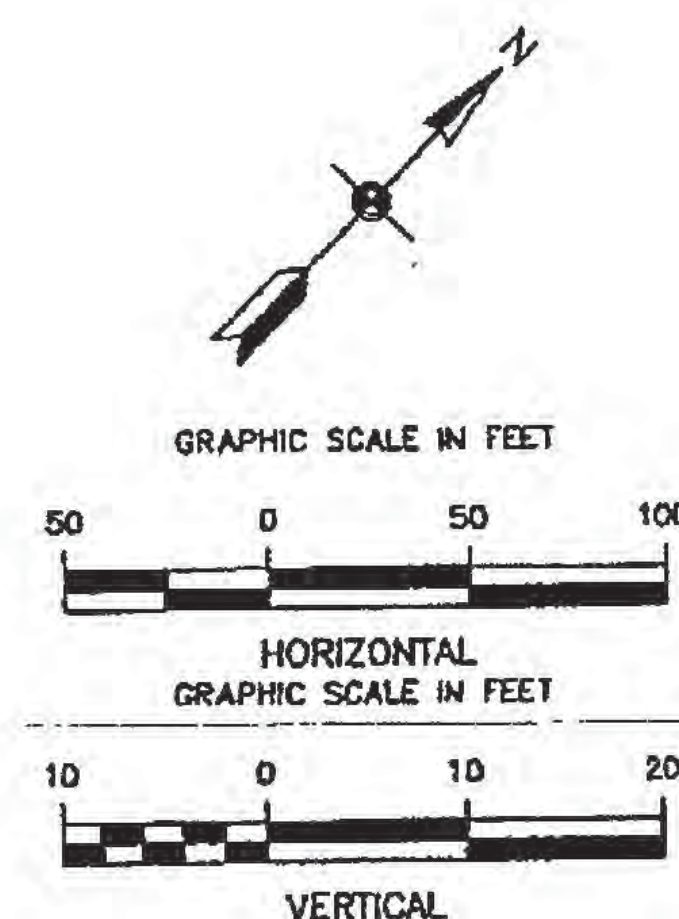

# URS

ONE PARK SQUARE  
6501 AMERICAS PARKWAY, NE  
SUITE 900  
ALBUQUERQUE, NM 87110  
(505) 855-7500



**CITY OF ALBUQUERQUE**  
DEPARTMENT OF  
MUNICIPAL DEVELOPMENT

TITLE: UNIVERSITY BLVD. EXTENSION - PHASE 1B  
STORM DRAIN PLAN AND PROFILE  
STA 200+00 TO STA 210+00

Design Review Committee	City Engineer Approval
-------------------------	------------------------

[illegible]

Downloaded from <http://ajphaphysoc.phapublications.org/>

[illegible][illegible][illegible]

City Project No. **EE-100** Zone Map No. **B-16 S-16** Sh

775482	R-10, S-10	
--------	------------	--

Ln	Mo./Day/Yr.	Mo./Day/Yr.
----	-------------	-------------

[illegible][illegible][illegible]

1	2	3	100
---	---	---	---	---	---	---	---	---	----	----	-----

1	2	3	100
---	---	---	---	---	---	---	---	---	----	----	-----


SP-15

0 SP-10



**EXHIBIT C -  
BASIN MAP EXHIBIT**




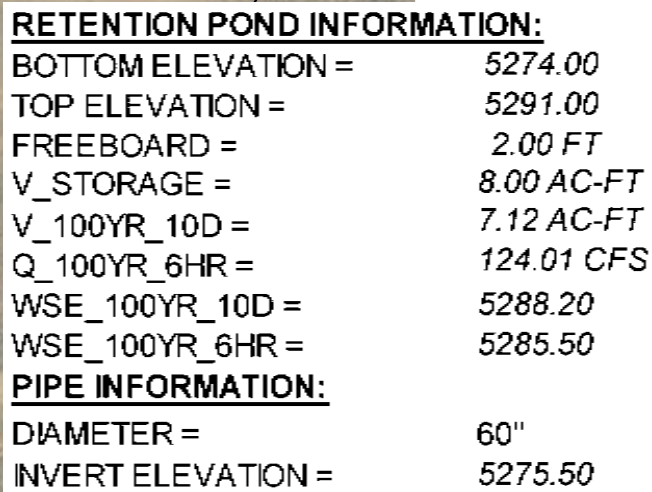

- (1) Land treatment percentages from COA Hydro File # R16-D003A
- (2) Land treatment percentages from COA Hydro File # R16-D003A 2018 Update
- (3) Land treatment percentages per COA Hydro File #R16-DA3005
- (4) Land treatment percentages per COA Hydro File #R16-DA004

Capacity Based on Manning's Eq w/  $N=0.013$ 

\* IN SUMP CONDITION, BASED ON THE LESSER OF ORIFICE AND WEIR EQUATIONS

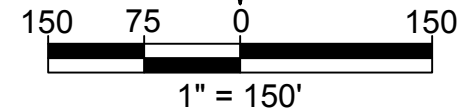

DRAWN BY:	AO	DATE:	04/20/2021
CHECKED BY:	MJB	BHI PROJECT NO.	20210391
		SHEET NO.	1 OF 1



**EXHIBIT D -  
GRADING PLAN**



**EXHIBIT E -  
FELLINI BLVD. PNP**





