CITY OF ALBUQUERQUE

Planning Department Alan Varela, Director



Mayor Timothy M. Keller

August 1, 2022

Mike Balaskovits, P.E. Bohannan Huston, Inc. 7500 Jefferson St NE Albuquerque, NM 87109

RE: MDS OS-7 Storm Drainage Relocation Engineer's Certification Date: 06/21/22 Engineer's Stamp Date: 08/16/21 Hydrology File: R16D097A CPN #775684

Dear Mr. Balaskovits:

Based on the Certification received 07/28/2022 and site visit on 07/29/2022, this certification is approved in support of closing out the Work Order CPN #775684 by Hydrology.

If you have any questions, please contact me at 924-3995 or <u>rbrissette@cabq.gov</u>.

Albuquerque Sincerely,

NM 87103

Renée C. Brissette

Renée C. Brissette, P.E. CFM Senior Engineer, Hydrology Planning Department

www.cabq.gov



City of Albuquerque


Planning Department Development & Building Services Division DRAINAGE AND TRANSPORTATION INFORMATION SHEET (REV 11/2018)

Project Title:	Building	Permit #: Hydrology File #:
DRB#:	EPC#:	Work Order#:
Legal Description:		
City Address:		
Applicant:		Contact:
Address:		
		E-mail:
Owner:		Contact:
Address:		
Phone#:	Fax#:	E-mail:
TYPE OF SUBMITTAL: PLAT	(# OF LOTS)	_ RESIDENCE DRB SITE ADMIN SITE
IS THIS A RESUBMITTAL?:	Yes	No
DEPARTMENT: TRAFFIC/ TR	ANSPORTATION	HYDROLOGY/ DRAINAGE
Check all that Apply: TYPE OF SUBMITTAL: ENGINEER/ARCHITECT CERTI PAD CERTIFICATION CONCEPTUAL G & D PLAN GRADING PLAN DRAINAGE MASTER PLAN DRAINAGE REPORT FLOODPLAIN DEVELOPMENT I ELEVATION CERTIFICATE CLOMR/LOMR TRAFFIC CIRCULATION LAYO TRAFFIC IMPACT STUDY (TIS) OTHER (SPECIFY) PRE-DESIGN MEETING?	PERMIT APPLIC UT (TCL)	TYPE OF APPROVAL/ACCEPTANCE SOUGHT: BUILDING PERMIT APPROVAL CERTIFICATE OF OCCUPANCY PRELIMINARY PLAT APPROVAL SITE PLAN FOR SUB'D APPROVAL SITE PLAN FOR BLDG. PERMIT APPROVAL FINAL PLAT APPROVAL SIA/ RELEASE OF FINANCIAL GUARANTEE FOUNDATION PERMIT APPROVAL GRADING PERMIT APPROVAL SO-19 APPROVAL APPROVAL AVING PERMIT APPROVAL GRADING/ PAD CERTIFICATION WORK ORDER APPROVAL CLOMR/LOMR FLOODPLAIN DEVELOPMENT PERMIT

COA STAFF:

ELECTRONIC SUBMITTAL RECEIVED:

FEE PAID:

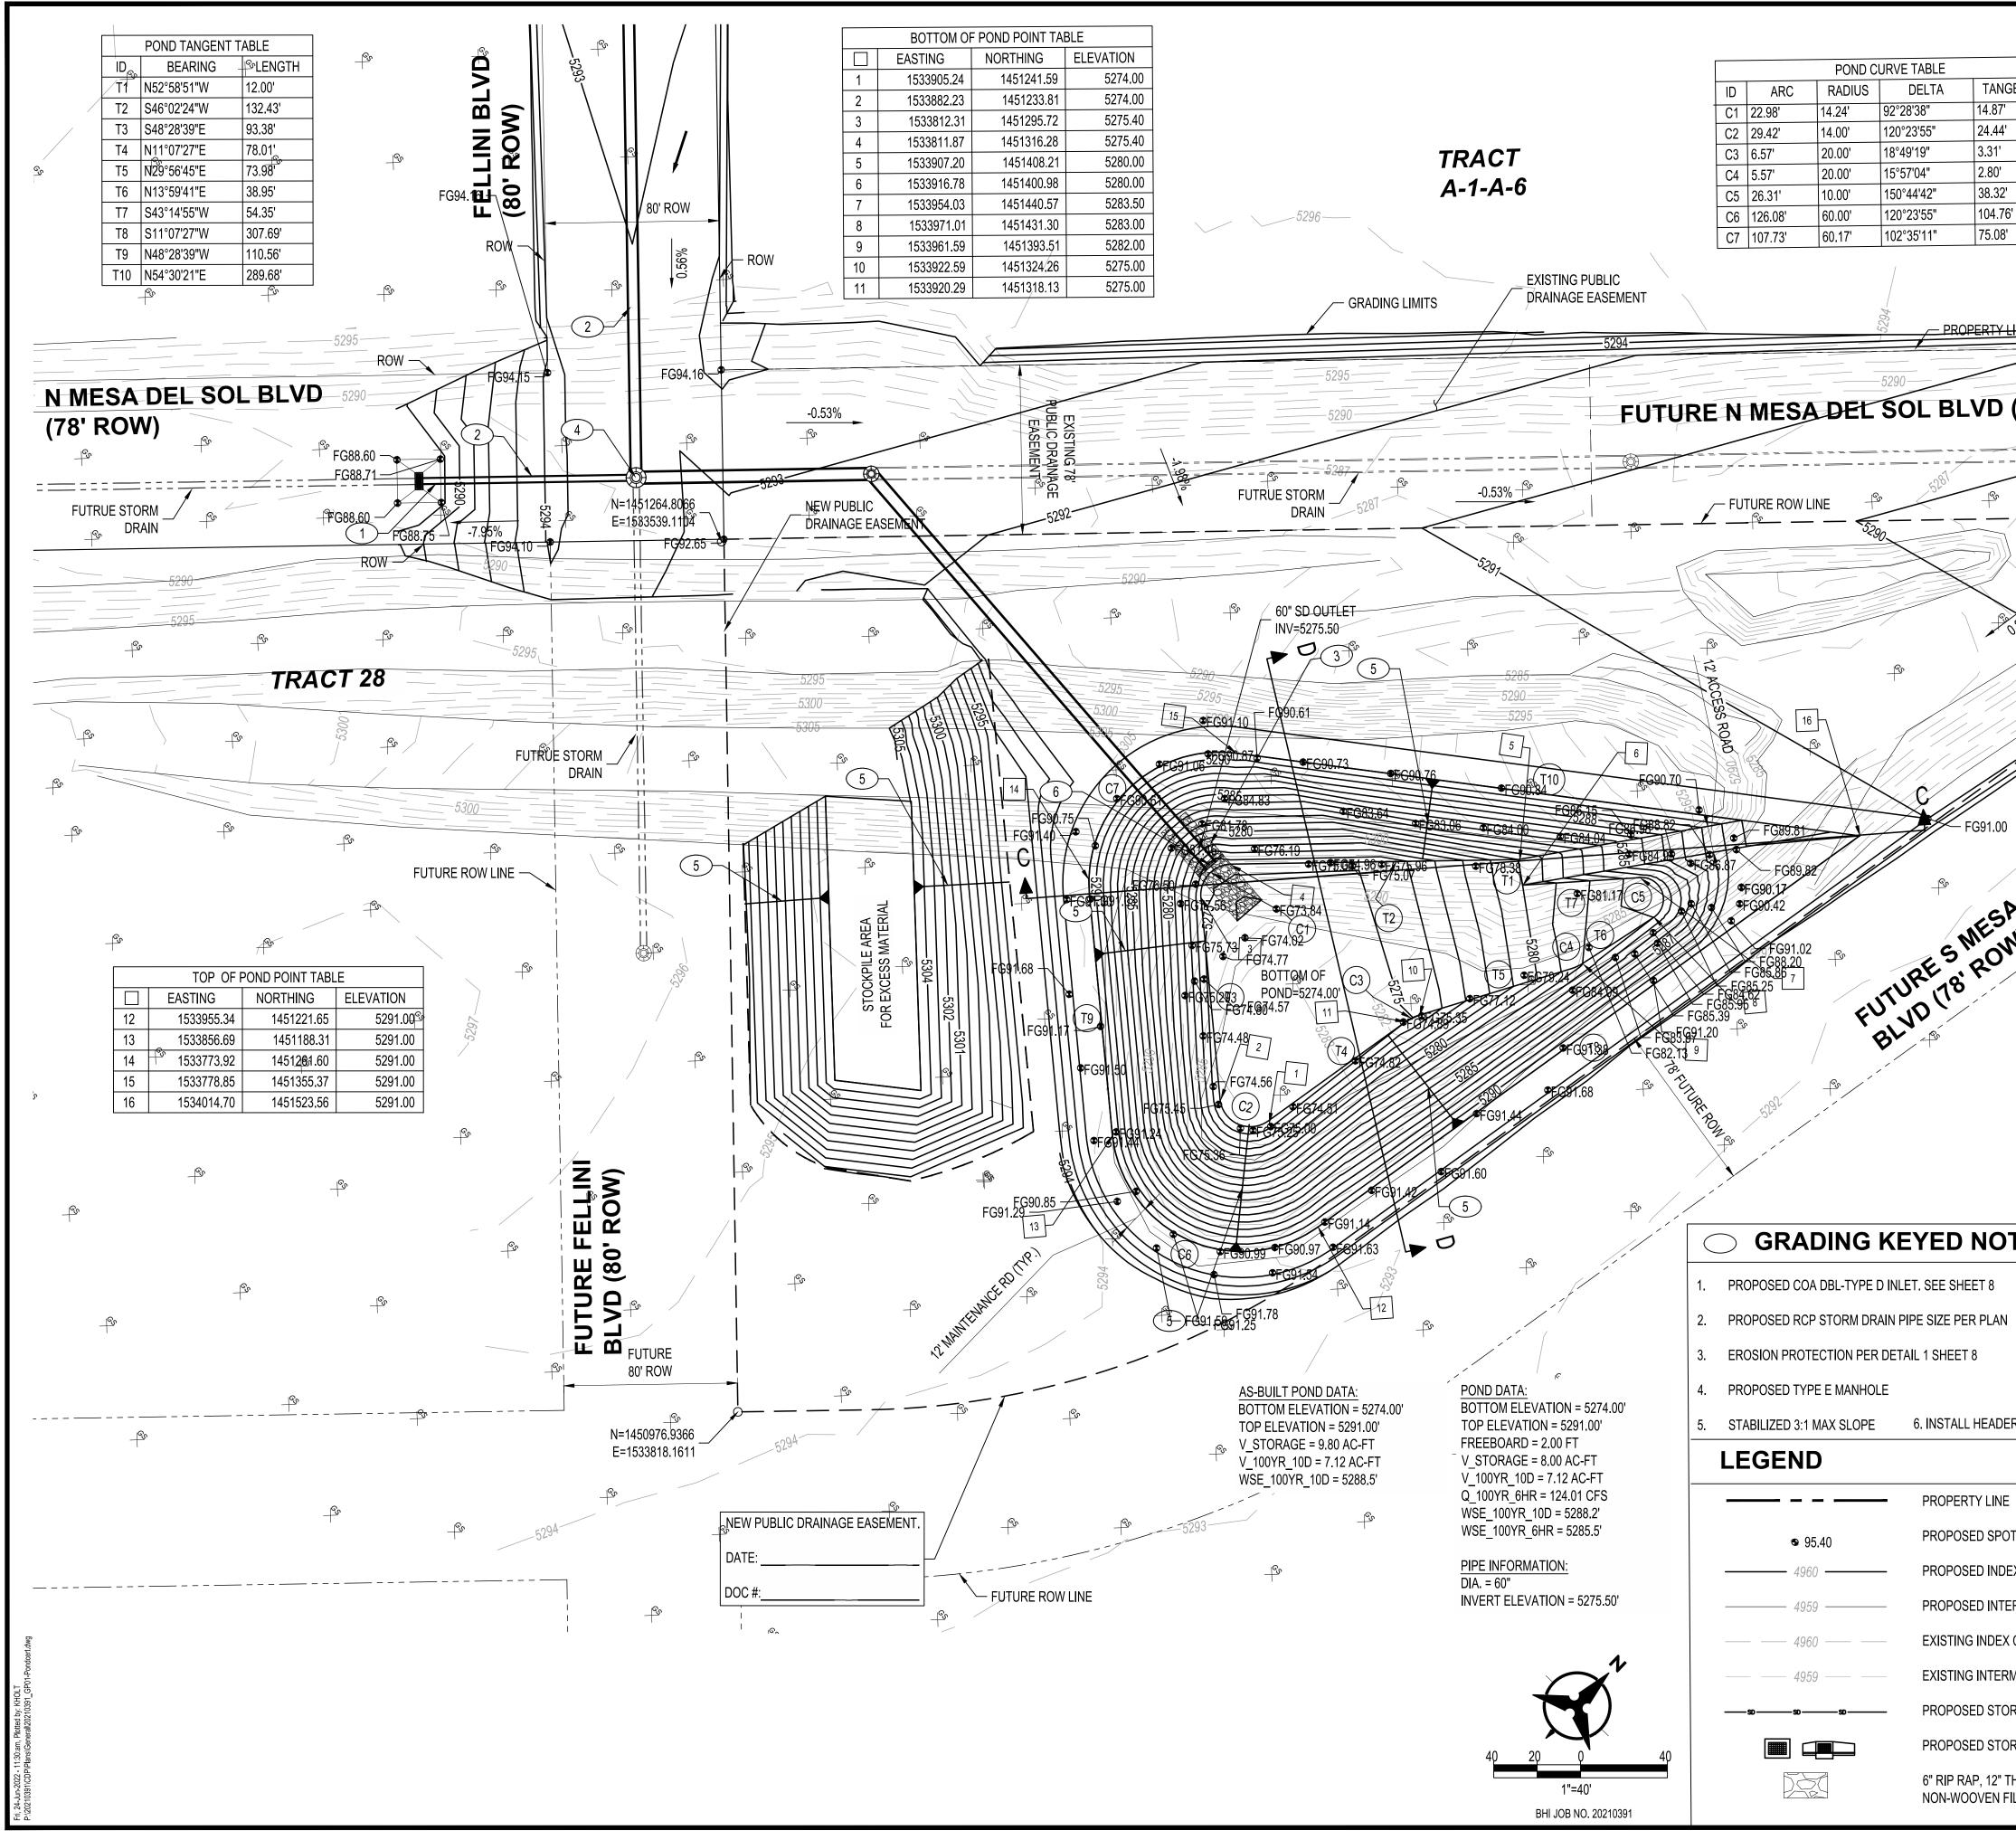

4' I, MICHAE ' GRADED / ' GRADED / 2' AND IN A 2' ADPROVEI 76' EDITED OI 8' AUI INC. THE PROJ VISUAL IN REPRESEN AND CORI THIS CER FOR PUBL	NC., HEREBY CERTIFY TH AND WILL DRAIN IN SUBS CCORDANCE WITH THE DE D PLAN DATED 8/16/21. NTO THE ORIGINAL DESIGN BY TIMOTHY M. SOLINSKI I FURTHER CERTIFY THAT IECT SITE ON 6/21/22 AN ISPECTION THAT THE SURV ITATIVE OF ACTUAL SITE OF RECT TO THE BEST OF MY	THE RECORD INFORMATION DOCUMENT HAS BEEN , NMPS 17531, OF THE FIRM I HAVE PERSONALLY VISITED ND HAVE DETERMINED BY VEY DATA PROVIDED IS CONDITIONS AND IS TRUE Y KNOWLEDGE AND BELIEF. N SUPPORT OF A REQUEST	CONSULTANTS	Bohannan	AHuston	www.bhinc.com	800.877.5332		
NECESSAF SUBSTAN ASPECTS RECORD I VERIFICAT OTHER F	OF THIS PROJECT. THOS DOCUMENT ARE ADVISED T TON OF ITS ACCURACY BE	NDED ONLY TO VERIFY GRADING AND DRAINAGE E RELYING ON THIS TO OBTAIN INDEPENDENT FORE USING IT FOR ANY	BENCH MARKS						
6/21/22 • FG9 • FG9 • FG9 • FG9 • FG9	LEGEND 5.40 AS-BUILT GRADE	W	SEAL		BY				
M M P	GRASS SEED WITH AGGR	L BE STABILIZED WITH NATIVE REGATE MULCH OR EQUAL (MUST STABILIZATION CRITERIA" CGP			<u> </u>	DATE:	DATE:	DATE:	DATE:
DTES	NOTIFY ENGINEER IM DISCREPANCIES. 2. DAMAGE TO UTILITIES PROJECT RIGHT-OF-V EXISTING CONDITION PLANS. 3. GRADING LIMITS SHO	S OR FACILITIES WITHIN THE VAY SHALL BE RESTORED TO S UNLESS OTHERWISE DENOTED IN WN ARE APPROXIMATE AND ED FIELD CONDITIONS, AS			NO. DATE DESCRIPTION AS-BUILT INFORMATION CONTRACTOR:	WORK STAKED BY:	NSPECTOR'S ACCEPTANCE BY:	FIELD VERIFICATION BY:	DRAWINGS CORRECTED BY:
DER WALL. SEE SHEET 8		CALL NM ONE-CALL SYSTEM SEVEN (7) DAYS PRIOR TO ANY EXCAVATION CITY OF ALE	DRAW CHECK DATE BUQU	NED BY: N BY: KED BY: ERQUI	AO AO MJB 03/26/2	2021			DRAV
DEX CONTOUR TERMEDIATE CONTOUR EX CONTOUR ERMEDIATE CONTOUR		DEPARTMENT OF MUN ENGINEERI MDS OS-7 STORM DR GRADIN	ng di Aina Ng pl	VISION GE RE AN	LOC				
TORM DRAIN PIPE TORM DRAIN INLETS " THICK, PLACED OVER I FILTER FABRIC	DESIGN REVIEW COMMITTE	E CITY ENGINEER APPROVAL		ROJECT 7	R-16 NO. 7568			8	