CITY OF ALBUQUERO

Planning Department Alan Varela, Director



June 27, 2024

Scott McGee, PE SMM PE LLC PO BOX 1273 Elephant Butte, NM 87935

RE: Encanto Apartments - Bldg. I & J

2500 Eastman Crossing SE

Temporary Certificate of Occupancy Engineer's Certification Date: 6/25/24

Engineer's Stamp Date: 5/18/23 Hydrology File: R16D101

Dear Mr. McGee:

Based on the Engineer's Partial Grading and Drainage Certification received 06/25/2024 and site visit on 6/27/2024, this letter serves as a "green tag" from Hydrology Section for a 30-day

Temporary Certificate of Occupancy for the Encanto Apartments, Building I & J to be issued by the Building and Safety Division. The following comment needs to be addressed prior to

acceptance for Permanent C.O. of the above referenced project:

Albuquerque

PO Box 1293

Install the steel plates on all of the sidewalk culverts where they are missing in the area and provide proof if installation to Hydrology when complete.

NM 87103

Please resubmit for a request for permanent release of Certificate of Occupancy once the above items are complete.

www.cabq.gov

If you have any questions, please contact me at 924-3314 or amontoya@cabq.gov.

Sincerely,

Anthony Montoya, Jr., P.E. Senior Engineer, Hydrology

an Mus

Planning Department, Development Review Services



City of Albuquerque

Planning Department

Development & Building Services Division

DRAINAGE AND TRANSPORTATION INFORMATION SHEET (REV 10/2018)

Project Title:	Building Permit #:		Hydrology File #:	
DRB#:	EPC#:		Work Order#:	
Legal Description:				
City Address:				
Applicant:			Contact:	
Address:				
		E-mail:		
Other Contact:			Contact:	
Address:				
Phone#:	Fax#:		E-mail:	
TYPE OF DEVELOPMENT:	_ PLAT (# of lots)	RESIDENCE _	DRB SITE	ADMIN SITE
IS THIS A RESUBMITTAL? Y	es No			
DEPARTMENT: TRAFFIC/TRANSPORTATION		HYDROLOGY/DRAINAGE		
Check all that Apply: TYPE OF SUBMITTAL: ENGINEER/ARCHITECT CERTIFICATION PAD CERTIFICATION CONCEPTUAL G & D PLAN GRADING PLAN DRAINAGE MASTER PLAN DRAINAGE REPORT FLOODPLAIN DEVELOPMENT PERMIT APPLIC ELEVATION CERTIFICATE CLOMR/LOMR TRAFFIC CIRCULATION LAYOUT (TCL) TRAFFIC IMPACT STUDY (TIS) OTHER (SPECIFY) PRE-DESIGN MEETING?		TYPE OF APPROVAL/ACCEPTANCE SOUGHT: BUILDING PERMIT APPROVAL CERTIFICATE OF OCCUPANCY PRELIMINARY PLAT APPROVAL SITE PLAN FOR SUB'D APPROVAL SITE PLAN FOR BLDG. PERMIT APPROVAI FINAL PLAT APPROVAL SIA/ RELEASE OF FINANCIAL GUARANTEE FOUNDATION PERMIT APPROVAL GRADING PERMIT APPROVAL SO-19 APPROVAL PAVING PERMIT APPROVAL GRADING/ PAD CERTIFICATION WORK ORDER APPROVAL CLOMR/LOMR FLOODPLAIN DEVELOPMENT PERMIT OTHER (SPECIFY)		
DATE SUBMITTED:	By:			

FEE PAID:___


5.0

DRAINAGE CERTIFICATION

ZURN

TRENCH

DETAIL

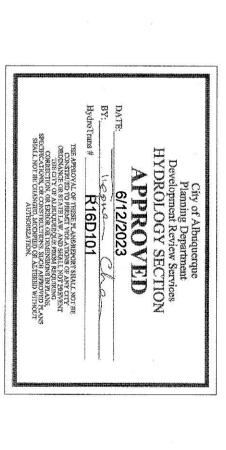

REVISED COMMUNITY BUILDING AREA

GRADING AND DRAINAGE PLAN


ENCANTO APARTMENTS

MESA DEL

SOL

MAY, 2023



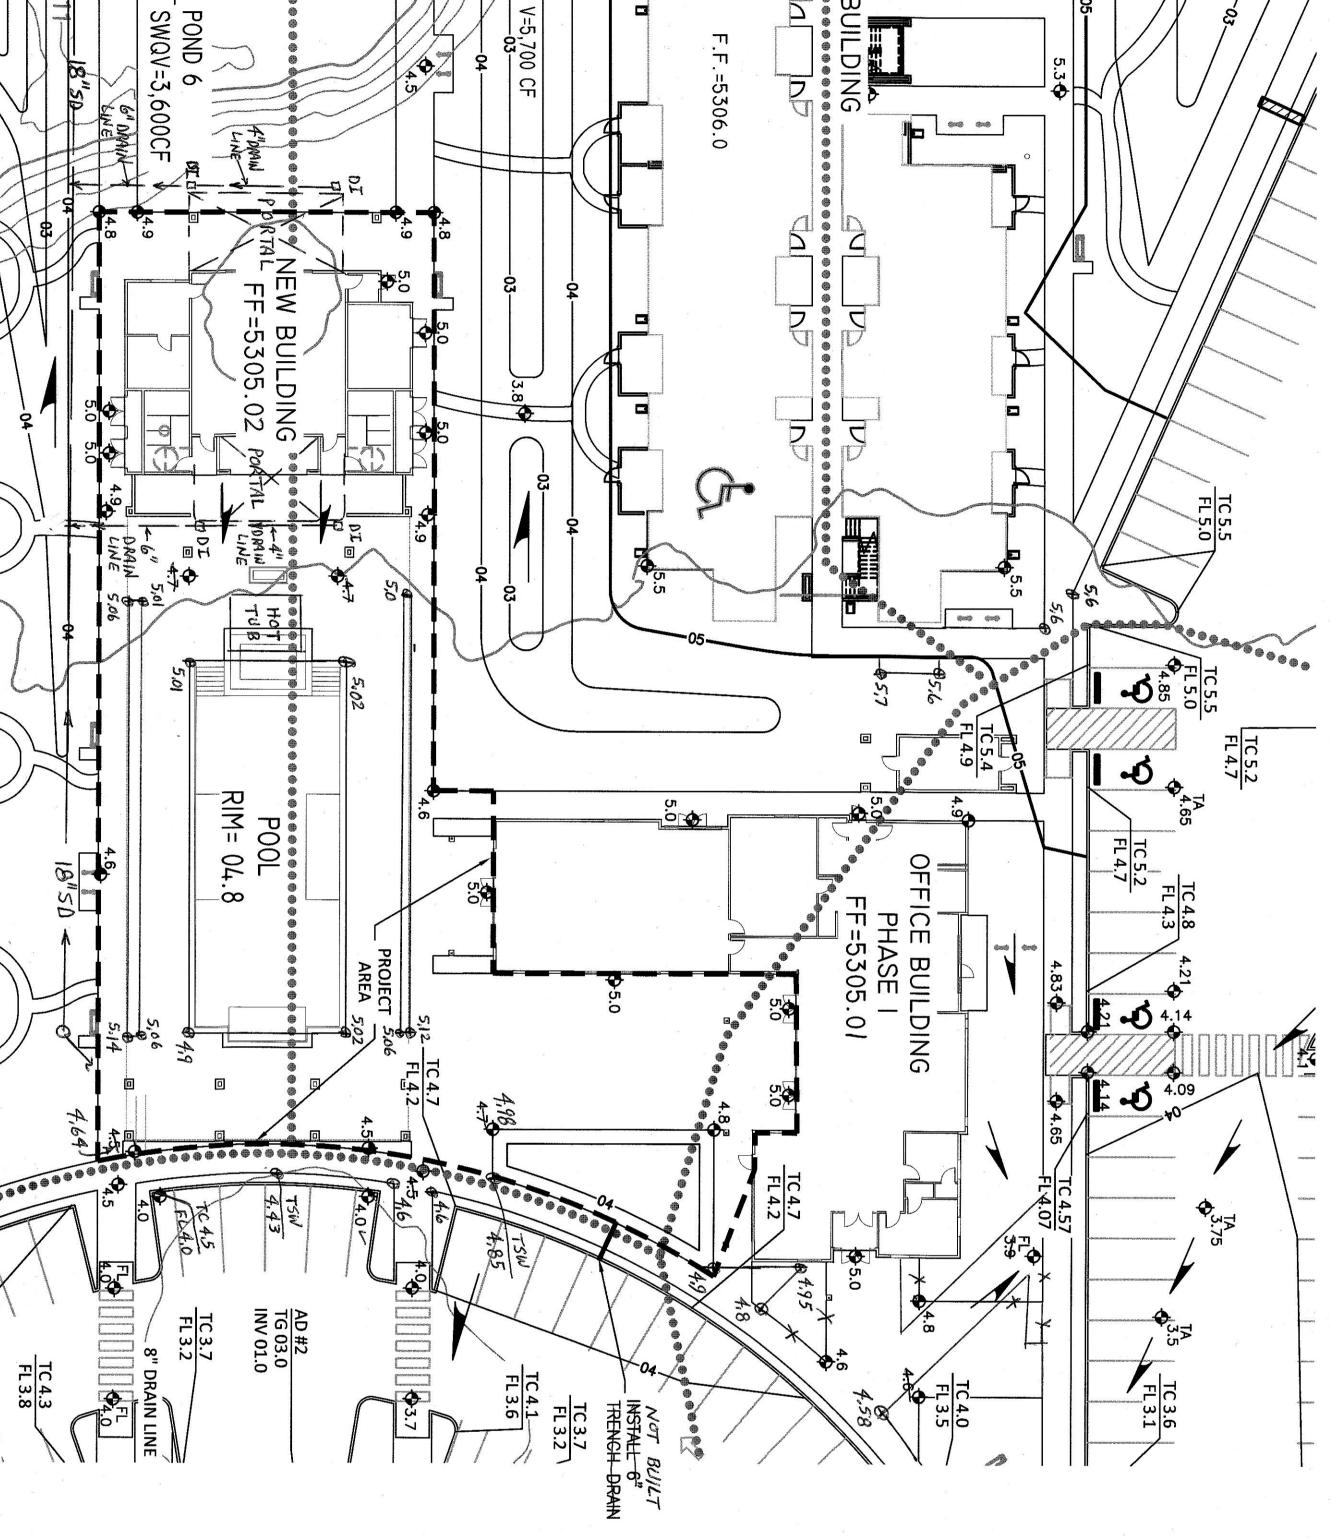

PROJECT AREA: 0.41 AC LEGAL DESCRIPTION: (17,850 SF)

BENCHMARK: City of Albuquerque Station '5-R15' being a brass cap. ELEV= 5306.674 (NAVD 1988)

FLOOD HAZARD: From FEMA Map 35001C0555H (8/16/2012), this site is identified as being within Zone 'X' which is determined to be an area of minimal flood hazard. SURVEYOR: Harris Surveying Inc. dated November, 2020

DRAINAGE BASIN BOUNDARY
STORM DRAIN

NEW CONTOUR -

8

EXISTING CONTOUR - MAJOR
EXISTING CONTOUR - MINOR

Legend

EXISTING CONDITIONS: This site is currently under construction and is being developed as a multi-family residential project. This site has an approved building permit Grading plan (R16/D101) on file.

PROPOSED IMPROVEMENTS: The revised improvements include a new pool building, a larger pool, and a revised community building in the interior of the site. The remainder of the site is unchanged.

-.=5305.0

FINISH FLOOR ELEVATION

ROOF DRAIN

COVERED PARKING AREA

TOP OF CURB

AS-BUILT ELEVATION

44.5

SPOT ELEVATION

STORM DRAIN INLET

PROJECT AREA

FLOW DIRECTION


DRAINAGE APPROACH: The new drainage plan will follow the approved Drainage plan and impacts Basins 6 and 9 of the approved plan. Basin 9 has an additional SWQ volume (5700 - 1701) V = 3,999 CF above what is required.

SWQ V= (5,378)(0.42/12)= 188 CF Basin 9 pond has 3,999 CF additional capacity (OK)

TRACT A-4-A MESA DEL SOL INNOVATION PARK

Existing land treatment: 5% B, 33% C, and 62% D Q= [(0.05)(2.36)+(0.33)(3.05)+(.62)(4.34)](0.41)= 1.6 CFS Proposed land treatment: 2% B, 6% C and 92% D Q= [(0.02)(2.36)+(0.06)(3.05)+(.92)(4.34)](0.41)= 1.7 CFS The added impervious area 'D'= (0.92-0.62)(0.41)(43560)=5,378 SF

This developed flow will discharge to onsite retention ponding areas located in Basins 6 and 9 on the site. The SWQ volume of 188 CF will be retained in the ponds as shown. Site discharge will not increase above the allowable: Q=(11.91/15.15) 56.08 = 44.0CFS.

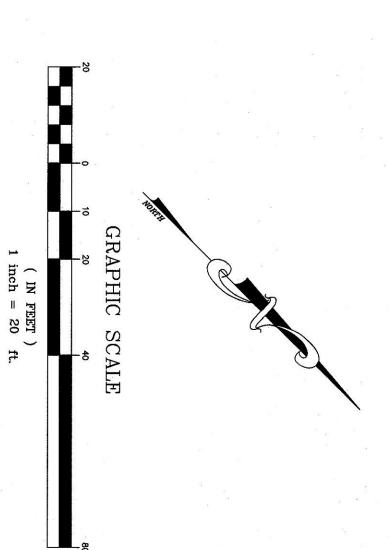



SCOTT M MCGEE,

Mode 6/25/

RECORD INFORMATION SHOWN HEREON IS NOT NECESSARILY CO
IFY SUBSTANTIAL COMPLIANCE OF THE GRADING AND DRAINAGE A
/ING ON THIS RECORD DOCUMENT ARE ADVISED TO OBTAIN HODE
ORE USING IT FOR ANY PURPOSE.

PLETE AND IS ONLY INTENDED TO PECTS OF THIS PROJECT. THOSE NDENT ACCURACY VERIFICATION

IAT THIS SITE HAS
INT OF THE
LAN WAS PROVIDED
IT I PERSONALLY
THE SURVEY DATA
ICT TO THE BEST OF
I FOR A

Scott X McGee

9700 Sand Verbena Trail NE Albuquerque, NM 87122 505.263.2905 scottmmcgee@gmail.com 上 石