


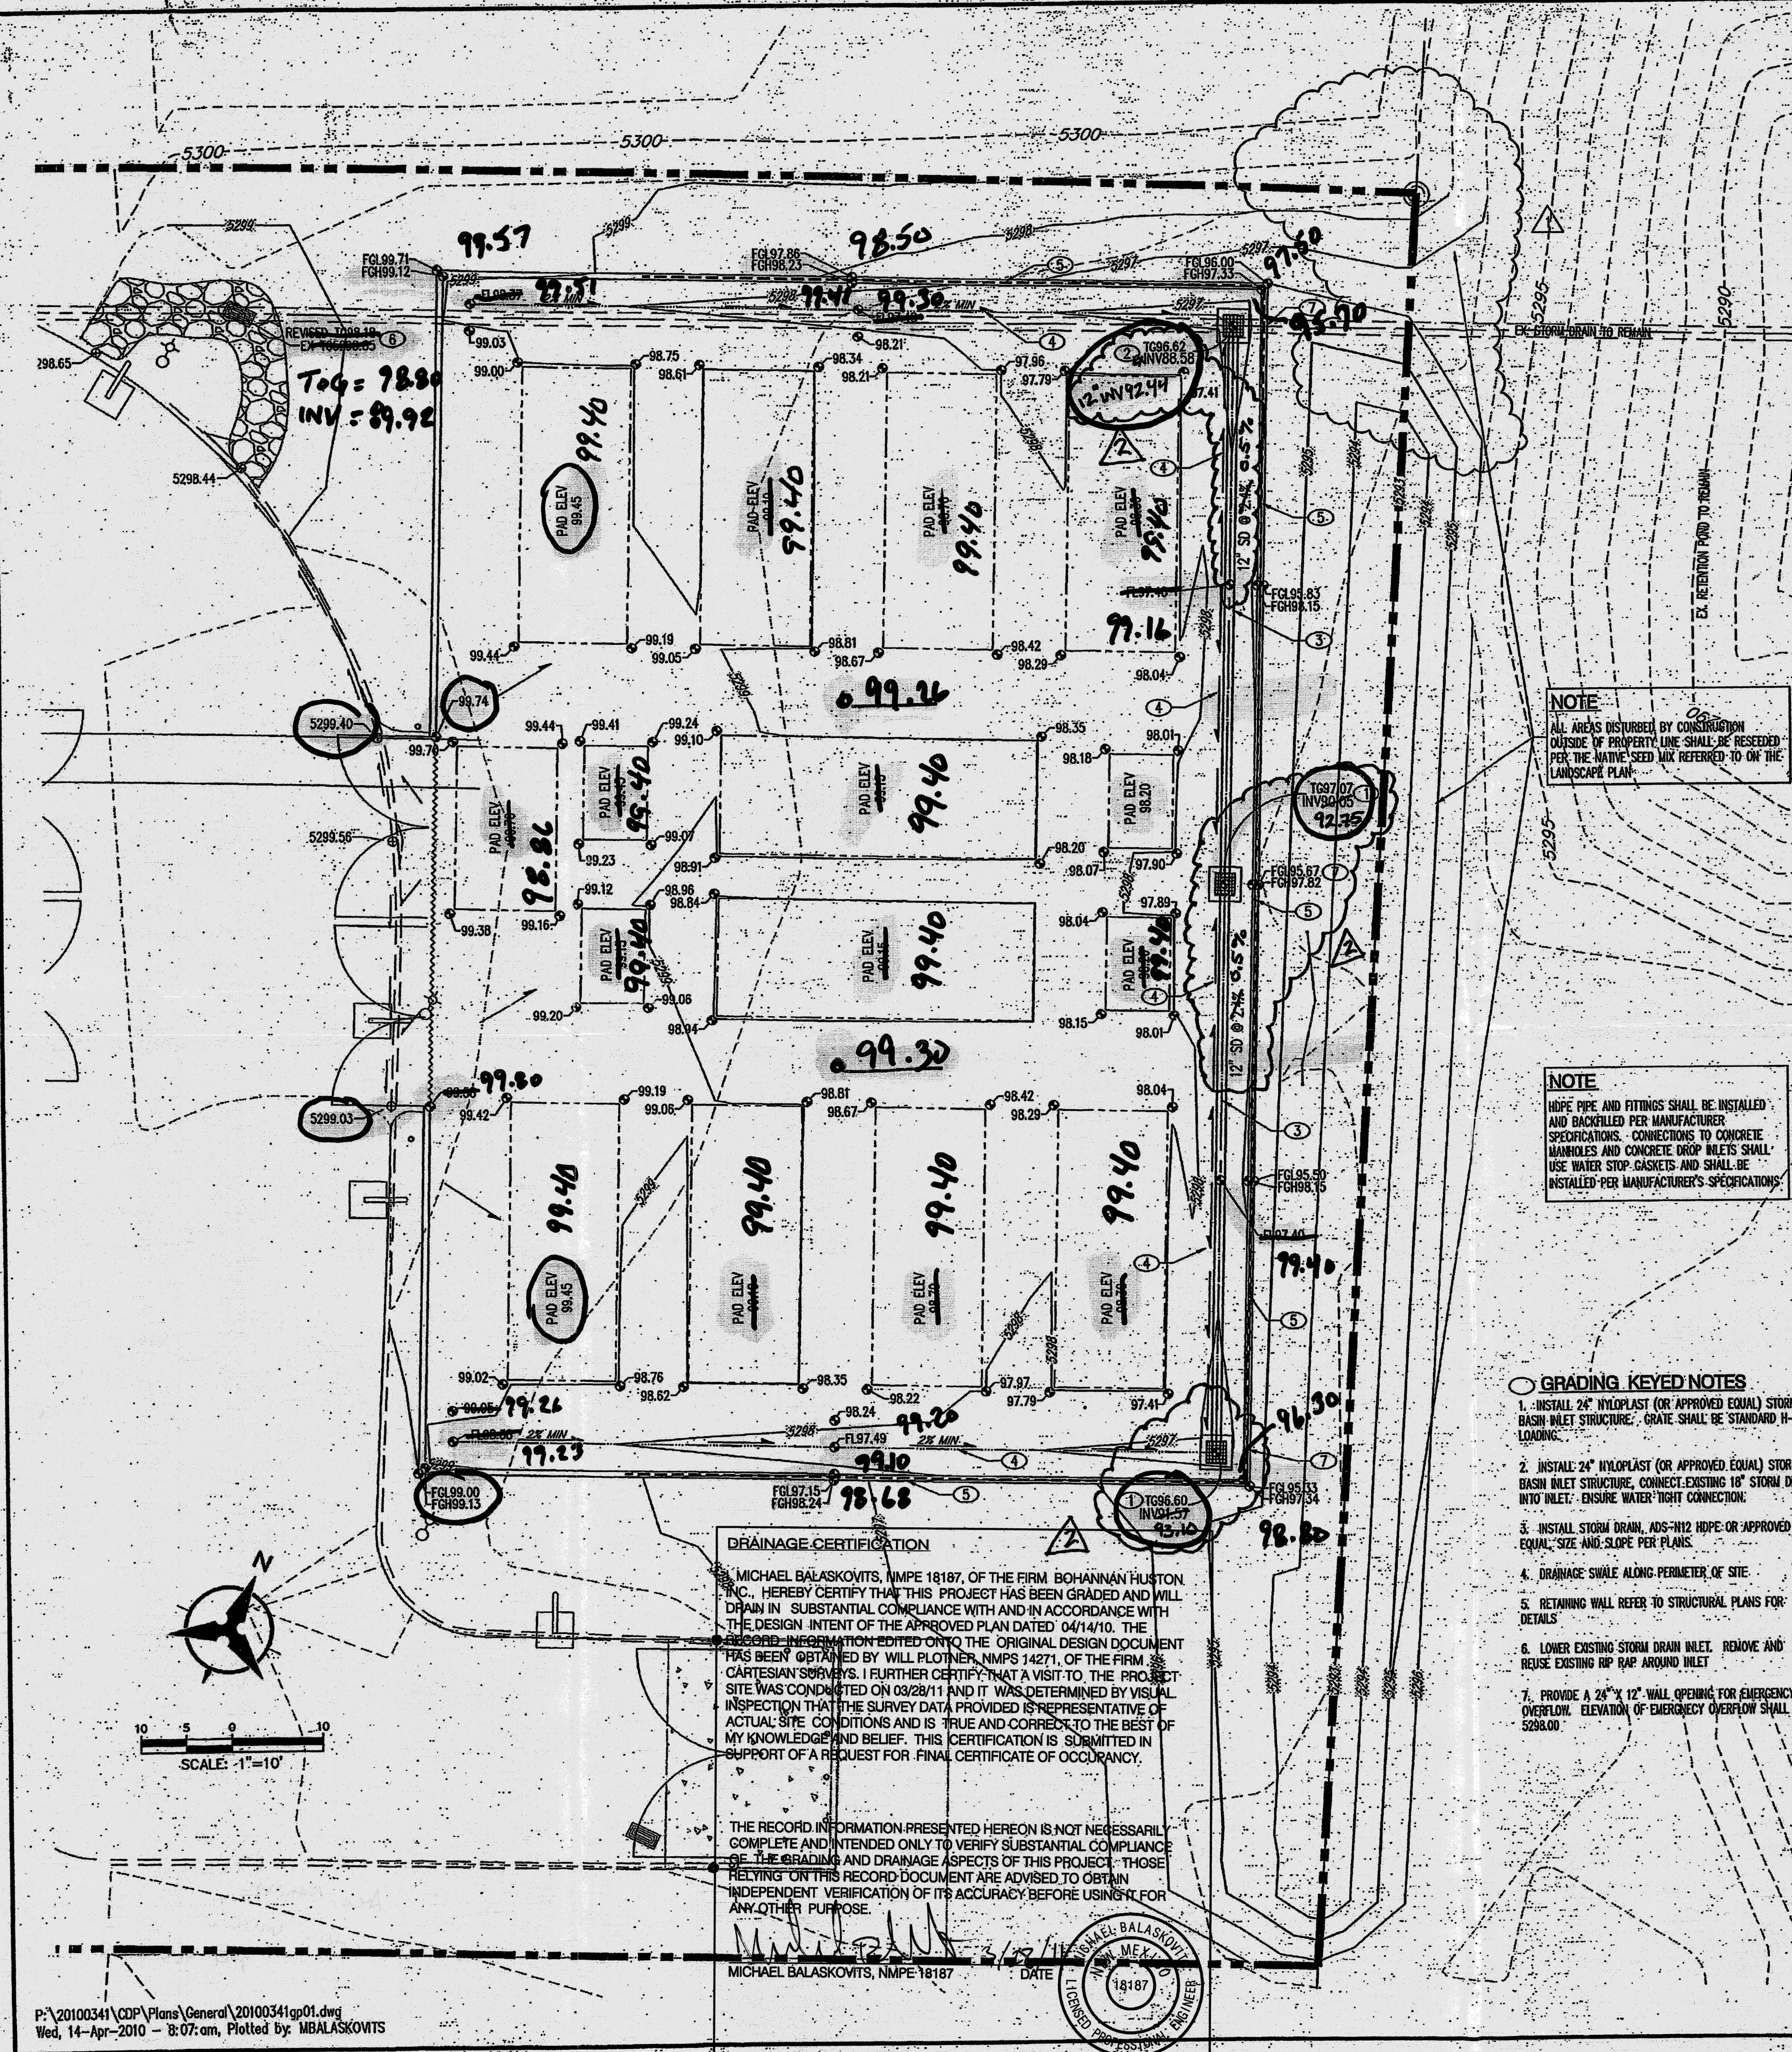

GENERAL NOTES

1. ALL WORK DETAILED ON THESE PLANS AND PERFORMED UNDER THIS CONTRACT SHALL BE CONSTRUCTED IN ACCORDANCE WITH THE PROJECT SPECIFICATIONS AND THE PROJECT GEOTECHNICAL REPORT, WHERE APPLICABLE. CITY OF ALBUQUERQUE PUBLIC WORKS STANDARDS SHALL APPLY.
2. THE CONTRACTOR SHALL ABIDE BY ALL LOCAL, STATE, AND FEDERAL LAWS, RULES AND REGULATIONS WHICH APPLY TO THE CONSTRUCTION OF THESE IMPROVEMENTS, INCLUDING EPA REQUIREMENTS WITH RESPECT TO STORM WATER DISCHARGE.
3. PRIOR TO CONSTRUCTION, THE CONTRACTOR SHALL FIELD VERIFY THE HORIZONTAL AND VERTICAL LOCATIONS OF ALL POTENTIAL OBSTRUCTIONS INCLUDING ALL UNDERGROUND UTILITIES. SHOULD A CONFLICT EXIST, THE CONTRACTOR SHALL NOTIFY THE CONSTRUCTION OBSERVER OR ENGINEER SO THAT THE CONFLICT CAN BE RESOLVED WITH A MINIMUM AMOUNT OF DELAY.
4. TWO (2) WORKING DAYS PRIOR TO ANY EXCAVATION, THE CONTRACTOR SHALL CONTACT LINE LOCATING SERVICE FOR LOCATION OF EXISTING UTILITIES.
5. ALL ELECTRICAL, TELEPHONE, CABLE TV, GAS, AND OTHER UTILITY LINES, CABLES, AND APPURTENANCES ENCOUNTERED DURING CONSTRUCTION THAT REQUIRE RELOCATION, SHALL BE COORDINATED WITH THAT UTILITY. THE CONTRACTOR SHALL BE RESPONSIBLE FOR COORDINATION OF ALL NECESSARY UTILITY ADJUSTMENTS. NO ADDITIONAL COMPENSATION WILL BE ALLOWED FOR DELAYS OR INCONVENIENCES CAUSED BY UTILITY COMPANY WORK CREWS. THE CONTRACTOR MAY BE REQUIRED TO RESCHEDULE HIS ACTIVITIES TO ALLOW UTILITY CREWS TO PERFORM THEIR REQUIRED WORK.
6. THE CONTRACTOR IS RESPONSIBLE FOR PROTECTING ALL EXISTING UTILITY LINES WITHIN THE CONSTRUCTION AREA. ANY DAMAGE TO EXISTING FACILITIES CAUSED BY CONSTRUCTION ACTIVITY SHALL BE REPAIRED OR REPLACED AT THE CONTRACTOR'S EXPENSE AND APPROVED BY THE CONSTRUCTION OBSERVER.
7. CONSTRUCTION ACTIVITY SHALL BE LIMITED TO THE PROPERTY AND/OR PROJECT LIMITS. ANY DAMAGE TO ADJACENT PROPERTIES RESULTING FROM THE CONSTRUCTION PROCESS SHALL BE REPAIRED OR REPLACED AT THE CONTRACTOR'S EXPENSE.
8. OVERNIGHT PARKING OF CONSTRUCTION EQUIPMENT SHALL NOT OBSTRUCT DRIVEWAYS OR DESIGNATED TRAFFIC LANES. THE CONTRACTOR SHALL NOT STORE ANY EQUIPMENT OR MATERIAL WITHIN THE PUBLIC RIGHT-OF-WAY.
9. THE CONTRACTOR SHALL OBTAIN ALL THE NECESSARY PERMITS FOR THE PROJECT PRIOR TO COMMENCING CONSTRUCTION (I.E., BARRICADING, TOPSOIL DISTURBANCE, EXCAVATION PERMITS, EPA STORM WATER PERMITS, ETC.).
10. ALL PROPERTY CORNERS DESTROYED DURING CONSTRUCTION SHALL BE REPLACED AT THE CONTRACTOR'S EXPENSE. ALL PROPERTY CORNERS MUST BE RESET BY A REGISTERED LAND SURVEYOR.
11. THE CONTRACTOR SHALL PREPARE A CONSTRUCTION TRAFFIC CONTROL AND SCHEDULING PLAN AND OBTAIN APPROVAL OF SUCH PLAN FROM THE CITY OF ALBUQUERQUE, TRAFFIC ENGINEERING DEPARTMENT, PRIOR TO BEGINNING ANY CONSTRUCTION WORK ON OR ADJACENT TO EXISTING STREETS.
12. ALL BARRICADES AND CONSTRUCTION SCHEDULING SHALL CONFORM TO APPLICABLE SECTIONS OF THE "MANUAL-ON-UNIFORM TRAFFIC CONTROL DEVICES" (MUTCD), U.S. DEPARTMENT OF TRANSPORTATION, LATEST EDITION.
13. THE CONTRACTOR SHALL MAINTAIN ALL CONSTRUCTION BARRICADES AND SCHEDULING AT ALL TIMES. THE CONTRACTOR SHALL VERIFY THE PROPER LOCATION OF ALL BARRICADES AT THE END AND BEGINNING OF EACH DAY.
14. THE CONTRACTOR SHALL TAKE ALL STEPS NECESSARY TO CONFORM WITH EPA REQUIREMENTS, INCLUDING COMPLIANCE WITH NPDES PHASE 2 REQUIREMENTS.

GRADING NOTES

1. EXCEPT AS PROVIDED HEREIN, GRADING SHALL BE PERFORMED AT THE ELEVATIONS AND IN ACCORDANCE WITH THE DETAILS SHOWN ON THIS PLAN.
2. THE COST FOR REQUIRED CONSTRUCTION DUST AND EROSION CONTROL MEASURES SHALL BE INCIDENTAL TO THE PROJECT COST.
3. ALL WORK RELATIVE TO FOUNDATION CONSTRUCTION, SITE PREPARATION, AND PAVEMENT INSTALLATION, AS SHOWN ON THIS PLAN, SHALL BE CONSTRUCTED IN ACCORDANCE WITH THE "GEOTECHNICAL INVESTIGATION," AS PROVIDED BY THE ARCHITECT OR OWNER. ALL OTHER WORK SHALL UNLESS OTHERWISE STATED OR PROVIDED FOR HEREIN, BE CONSTRUCTED IN ACCORDANCE WITH THE PROJECT, (FIRST PRIORITY) SPECIFICATIONS, AND/OR THE CITY OF ALBUQUERQUE (COA) STANDARD SPECIFICATIONS FOR PUBLIC WORKS (SECOND PRIORITY).
4. EARTH SLOPES SHALL NOT EXCEED 3 HORIZONTAL TO 1 VERTICAL UNLESS SHOWN OTHERWISE.
5. IT IS THE INTENT OF THESE PLANS THAT THE CONTRACTOR SHALL NOT PERFORM ANY WORK OUTSIDE OF THE PROPERTY BOUNDARIES EXCEPT AS REQUIRED BY THIS PLAN.
6. THE CONTRACTOR IS TO ENSURE THAT NO SOIL ERODES FROM THE SITE-ONTO ADJACENT PROPERTY OR PUBLIC RIGHT-OF-WAY. THIS SHOULD BE ACHIEVED BY CONSTRUCTING TEMPORARY BERM OR SILT FENCE AT THE PROPERTY LINES AND NETTING THE SOIL TO PROTECT IT FROM WIND EROSION.
7. A DISPOSAL SITE FOR ANY & ALL EXCESS EXCAVATION MATERIAL AND UNSTABLE MATERIAL AND/OR A BORROW SITE CONTAINING ACCEPTABLE FILL MATERIAL SHALL BE OBTAINED BY THE CONTRACTOR IN COMPLIANCE WITH APPLICABLE ENVIRONMENTAL REGULATIONS AND APPROVED BY THE OBSERVER. ALL COSTS INCURRED IN OBTAINING A DISPOSAL OR BORROW SITE AND Haul TO OR FROM SHALL BE CONSIDERED INCIDENTAL TO THE PROJECT AND NO SEPARATE MEASUREMENT OR PAYMENT SHALL BE MADE.
8. PAVING AND ROADWAY GRADES SHALL BE +/- 0.1' FROM PLAN ELEVATIONS. PAD ELEVATION SHALL BE +/- 0.1' FROM BUILDING PLAN ELEVATION.
9. ALL PROPOSED CONTOURS REFLECT TOP OF PAVEMENT ELEVATIONS IN THE PARKING AREA AND MUST BE ADJUSTED FOR MEDIAN AND ISLANDS.
10. VERIFY ALL ELEVATIONS SHOWN ON PLAN FROM BASIS OF ELEVATION CONTROL STATION PRIOR TO BEGINNING CONSTRUCTION.
11. SITE CONSTRUCTION TO MEET REQUIREMENTS OF SUPPLY (STORM WATER POLLUTION PREVENTION PLAN).

NOTE
ALL AREAS DISTURBED BY CONSTRUCTION OUTSIDE OF PROPERTY LINE SHALL BE RESEED PER THE NATIVE SEED MIX REFERRED TO ON THE LANDSCAPE PLAN.

NOTE
HOPE PIPE AND FITTINGS SHALL BE INSTALLED AND BACKFILLED PER MANUFACTURER SPECIFICATIONS. CONNECTIONS TO CONCRETE MANHOLES AND CONCRETE DROP INLETS SHALL USE WATER STOP GASKETS AND SHALL BE INSTALLED PER MANUFACTURER'S SPECIFICATIONS.


GRADING KEYED NOTES

1. INSTALL 24" HDPE (OR APPROVED EQUAL) STORM DRAIN INLET STRUCTURE. GRATE SHALL BE STANDARD H-25 LOADING.
2. INSTALL 24" HDPE (OR APPROVED EQUAL) STORM DRAIN INLET STRUCTURE. CONNECT EXISTING 18" STORM DRAIN INTO INLET. ENSURE WATER-TIGHT CONNECTION.
3. INSTALL STORM DRAIN, ADS-H12 HDPE OR APPROVED EQUAL, SIZE AND SLOPE PER PLANS.
4. DRAINAGE SHALE ALONG PERIMETER OF SITE.
5. RETAINING WALL REFER TO STRUCTURAL PLANS FOR DETAILS.
6. LOWER EXISTING STORM DRAIN INLET. REMOVE AND REUSE EXISTING R/R RAP AROUND INLET.
7. PROVIDE A 24" X 12" WALL OPENING FOR EMERGENCY OVERFLOW. ELEVATION OF EMERGENCY OVERFLOW SHALL BE 5298.00.

SURVEYOR'S CERTIFICATION

I, WILL PLOTNER JR., A DULY QUALIFIED, REGISTERED, PROFESSIONAL LAND SURVEYOR UNDER THE LAWS OF THE STATE OF NEW MEXICO, DO HEREBY CERTIFY THAT THE "AS-BUILT" INFORMATION SHOWN ON THESE DRAWINGS WAS OBTAINED FROM FIELD CONSTRUCTION AND "AS-BUILT" SURVEYS PERFORMED BY ME OR UNDER MY SUPERVISION, THAT THE "AS-BUILT" INFORMATION SHOWN ON THESE DRAWINGS WAS ADDED BY ME OR UNDER MY SUPERVISION, AND THAT THIS "AS-BUILT" INFORMATION IS TRUE AND CORRECT TO THE BEST OF MY KNOWLEDGE AND BELIEF. CARTESIAN SURVEYS IS NOT RESPONSIBLE FOR ANY OF THE DESIGN, CONCEPTS, CALCULATIONS, ENGINEERING, OR INTENT OF THE RECORD DRAWINGS.

WILL PLOTNER JR.
WILL PLOTNER JR., NMP 14271
3/23/11

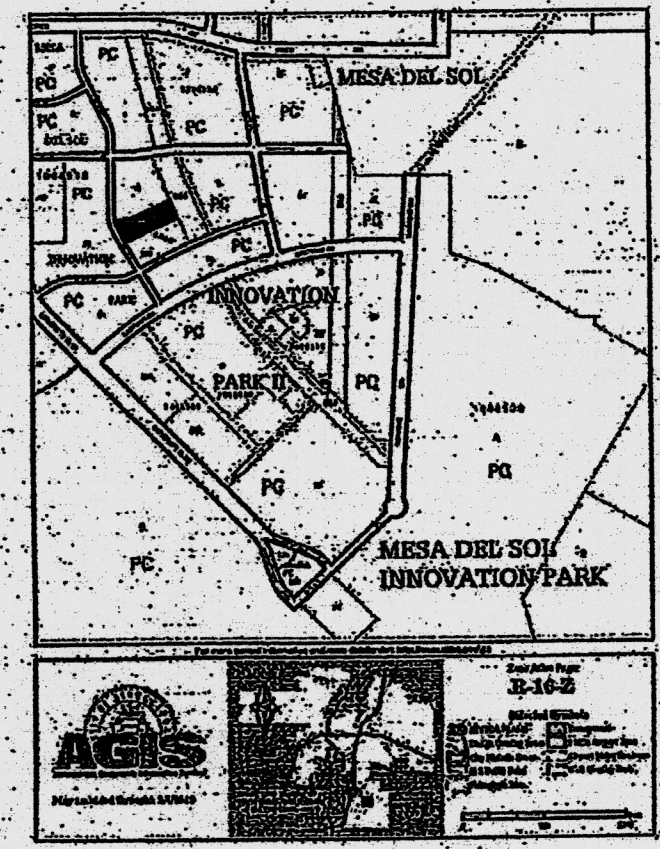

BENCH MARKS:

BENCHMARK #1
1. R16
N1453939.35 E1533242.614 5291.48

BENCHMARK #2
3.018
N1457546.788 E1534025.978 5310.42

LEGEND

- PROPERTY LINE
- - - - - EXISTING CONTOURS
- x 5301.15 EXISTING GROUND SPOT ELEVATION
- o 65.23 PROPOSED SPOT ELEVATION
- - - - - TO-TOF OF CURB, FL=FLOW LINE
- - - - - TO-TOF OF GRADE, TS=TOP OF SOIL
- - - - - TO-TOF OF ASPHALT
- - - - - PROPOSED DIRECTION OF FLOW
- - - - - WATER BLOCK
- - - - - PROPOSED INDEX CONTOURS
- - - - - PROPOSED INTER CONTOURS
- - - - - PROPOSED RETAINING WALL
- - - - - EASEMENT
- - - - - PROPOSED STORM DRAIN LINE
- o PROPOSED STORM DRAIN MANHOLE
- o PROPOSED STORM DRAIN INLET

DRAINAGE CERTIFICATION

MICHAEL BALASKOVITS, NMP 18187, OF THE FIRM BOHANNAN HUSTON, INC., HEREBY CERTIFY THAT THIS PROJECT HAS BEEN GRADED AND WILL DRAIN IN SUBSTANTIAL COMPLIANCE WITH AND IN ACCORDANCE WITH THE DESIGN INTENT OF THE APPROVED PLAN DATED 04/14/10. THE SECOND INFORMATION EDITED ON TO THE ORIGINAL DESIGN DOCUMENT HAS BEEN OBTAINED BY WILL PLOTNER, NMP 14271, OF THE FIRM BOHANNAN HUSTON, INC. I FURTHER CERTIFY THAT A VISIT TO THE PROJECT SITE WAS CONDUCTED ON 03/28/11 AND IT WAS DETERMINED BY VISUAL INSPECTION THAT THE SURVEY DATA PROVIDED IS REPRESENTATIVE OF ACTUAL SITE CONDITIONS AND IS TRUE AND CORRECT TO THE BEST OF MY KNOWLEDGE AND BELIEF. THIS CERTIFICATION IS SUBMITTED IN SUPPORT OF A REQUEST FOR FINAL CERTIFICATE OF OCCUPANCY.

THE RECORD INFORMATION PRESENTED HEREON IS NOT NECESSARILY COMPLETE AND INTENDED ONLY TO VERIFY SUBSTANTIAL COMPLIANCE OF THE GRADING AND DRAINAGE ASPECTS OF THIS PROJECT. THOSE RELYING ON THIS RECORD DOCUMENT ARE ADVISED TO OBTAIN INDEPENDENT VERIFICATION OF ITS ACCURACY BEFORE USING IT FOR ANY OTHER PURPOSE.

MICHAEL BALASKOVITS, NMP 18187
DATE 3/23/11
WILL PLOTNER JR., NMP 14271



Bohannon & Huston
Engineering • Spatial Data • Advanced Technologies

CONSULTING ENGINEERS

CONTRACTOR

ARCHITECT

DATA EQUIPMENT EXPANSION FOR

MOLINA
2610 TURNING DRIVE
ALBUQUERQUE, NEW MEXICO 87105

JOB NO :


DRAWN BY :
MJB

ISSUE DATE :
02/16/10

REVISIONS

1	04-14-2010
2	03-23-2010
3	
4	
5	

SHEET NUMBER
C100

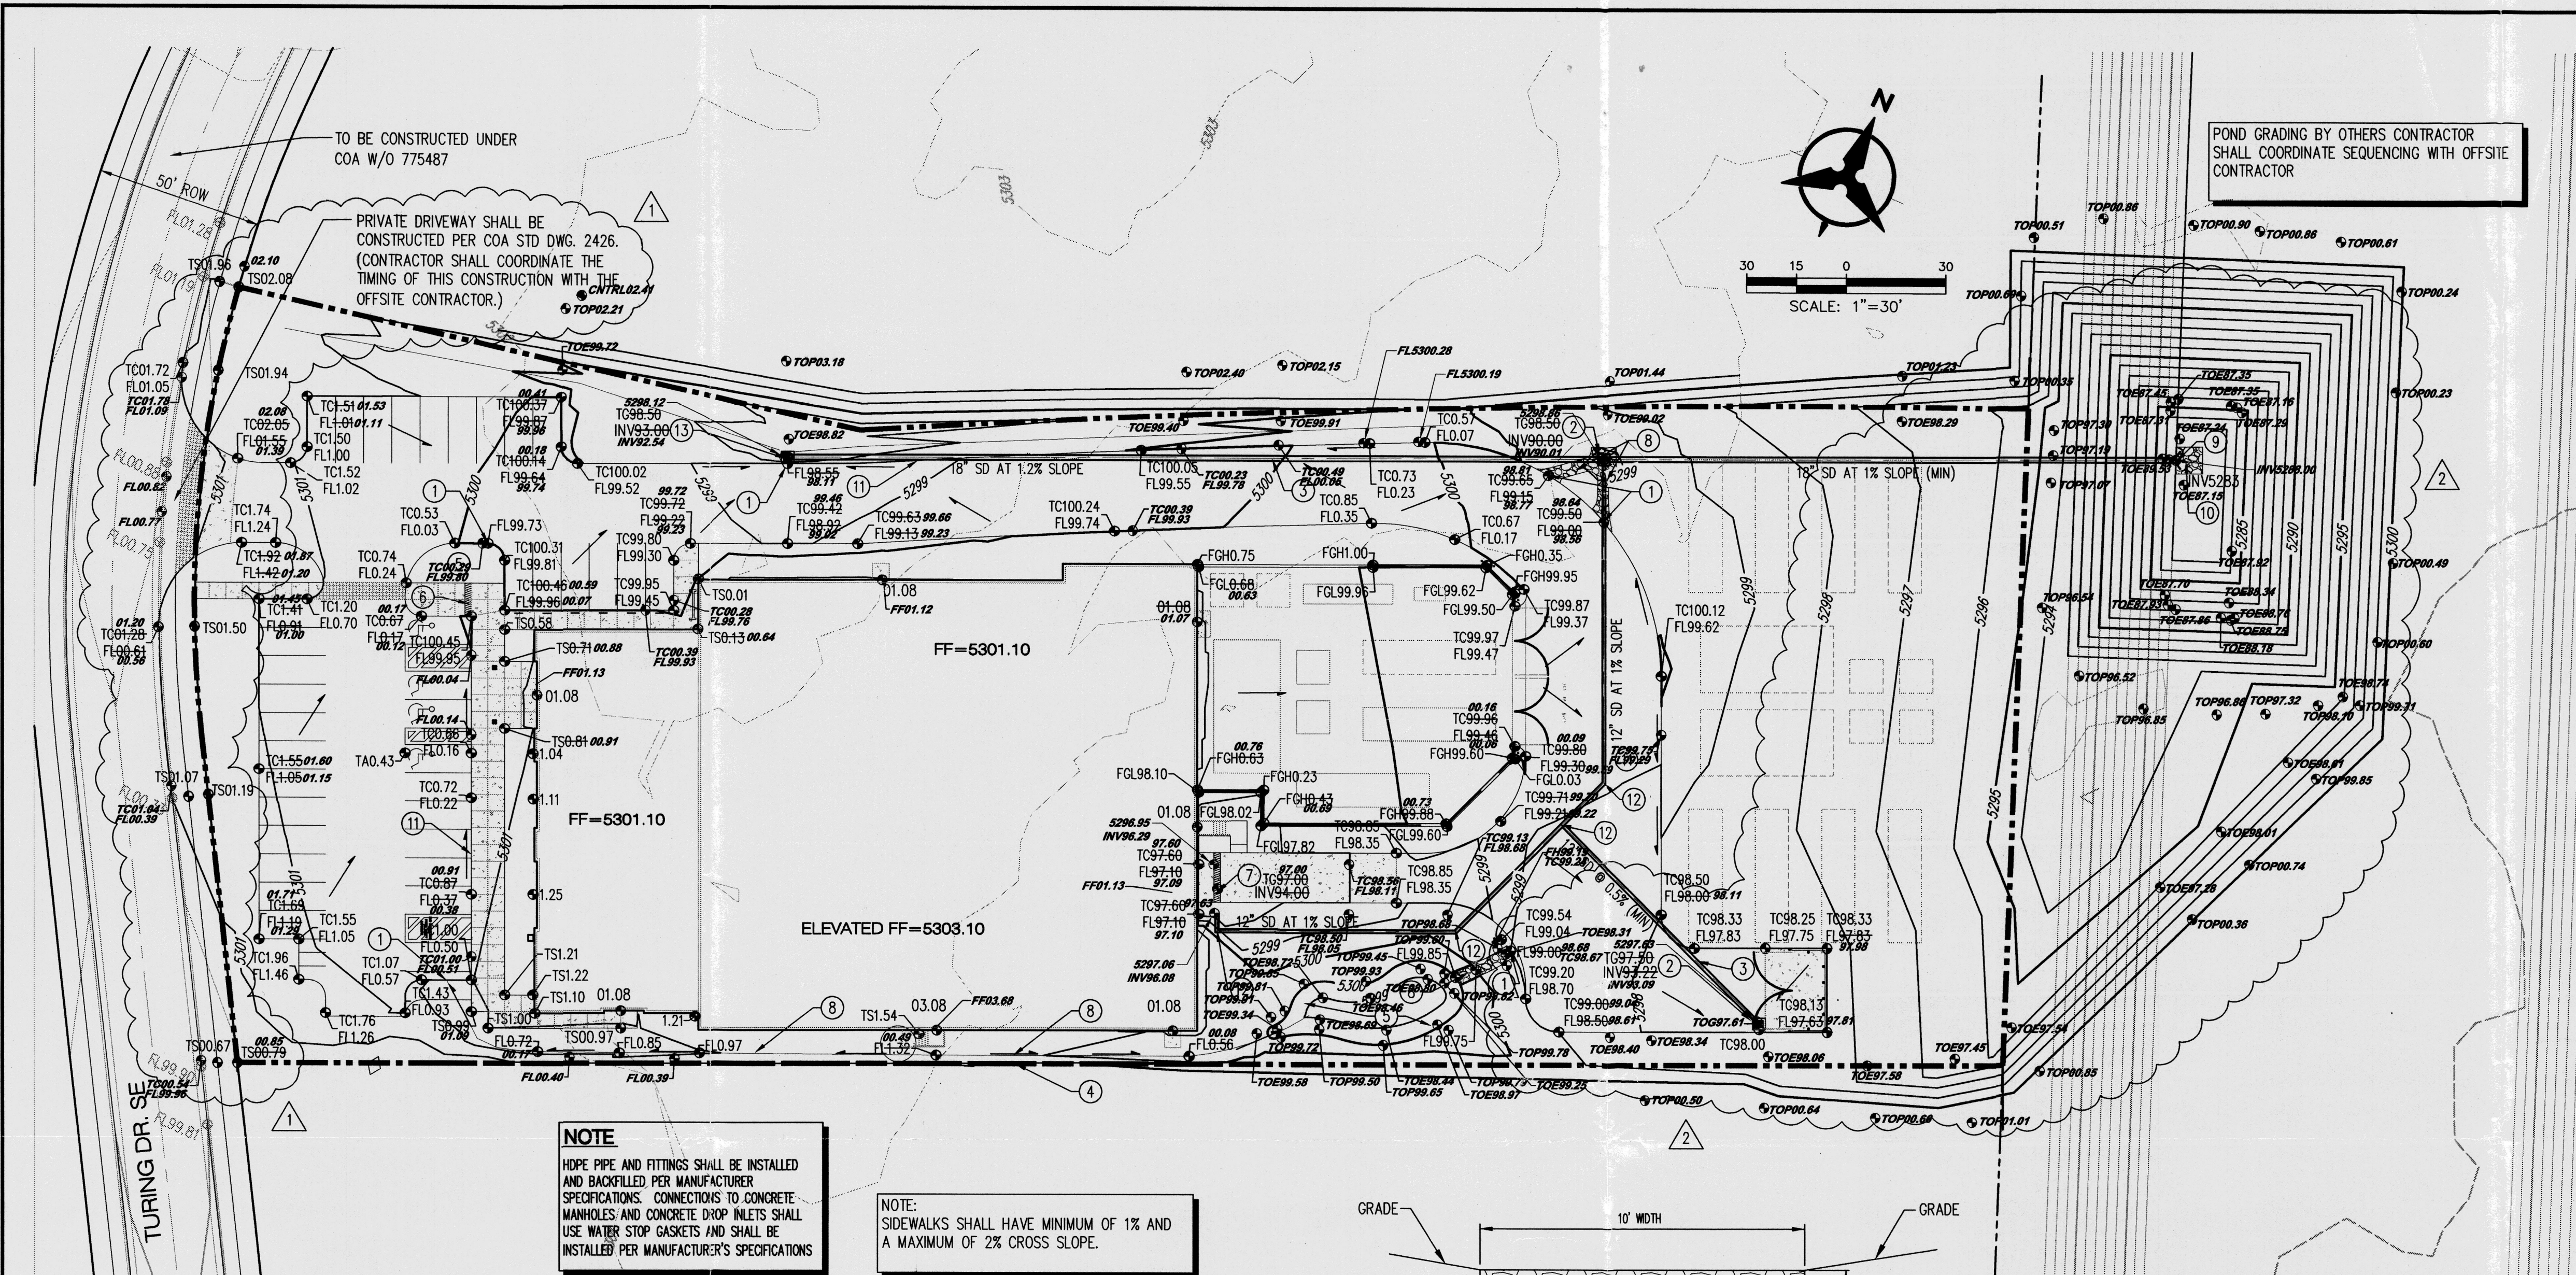

PROJECT BENCH MARKS:

BENCHMARK #1
1.316
N1453939.35 E1533242.614 5291.48

BENCHMARK #2
3.016
N1457546.798 E1534025.978 5310.42

LEGEND

- PROPERTY LINE
- EXISTING CONTOURS
- EXISTING GROUND SPOT ELEVATION
- PROPOSED SPOT ELEVATION
- PROPOSED DIRECTION OF FLOW
- WATER BLOCK
- PROPOSED INDEX CONTOURS
- PROPOSED INTER CONTOURS
- PROPOSED RETAINING WALL
- EASEMENT
- PROPOSED STORM DRAIN LINE
- PROPOSED STORM DRAIN MANHOLE
- PROPOSED STORM DRAIN INLET

GRADING KEYED NOTES

- INSTALL 24" WIDE CURB OPENING PER DETAIL THIS SHEET.
- INSTALL 24" NYLOPLAST (OR APPROVED EQUAL) STORM BASIN INLET STRUCTURE. GRATE SHALL BE STANDARD A-25 LOADING.
- INSTALL STORM DRAIN, ADS-N12 HOPE OR APPROVED EQUAL, SIZE PER PLANS.
- INSTALL 1' TALL DRAINAGE CONTROL BERM WITH 3:1 SLOPE AND 1' WIDE TOP.
- WATER HARVESTING AREA
- INSTALL 24" SIDEWALK CULVERT PER COA STD DWG 2236
- INSTALL TRENCH DRAIN PER DETAIL THIS SHEET.
- DRAINAGE SWALE PER DETAIL THIS SHEET.
- INSTALL CMP END SECTION, SEE PLANS FOR SIZE.
- INSTALL 10'X10' RIP-RAP BLANKET PER DETAIL THIS SHEET.
- STD MEDIAN CURB AND GUTTER PER COA STD. DWG 2415B
- INSTALL PREMANUFACTURED FITTING. SEE PLANS FOR SIZE.
- INSTALL SINGLE GRATE TYPE 'D' INLET PER COA STD DWG. 2206.

GENERAL NOTES



- ALL WORK DETAILED ON THESE PLANS AND PERFORMED UNDER THIS CONTRACT SHALL BE CONSTRUCTED IN ACCORDANCE WITH THE PROJECT SPECIFICATIONS AND THE PROJECT GEOTECHNICAL REPORT. WHERE APPLICABLE, CITY OF ALBUQUERQUE PUBLIC WORKS STANDARDS SHALL APPLY.
- THE CONTRACTOR SHALL ABIDE BY ALL LOCAL, STATE, AND FEDERAL LAWS, RULES AND REGULATIONS WHICH APPLY TO THE CONSTRUCTION OF THESE IMPROVEMENTS, INCLUDING EPA REQUIREMENTS WITH RESPECT TO STORM WATER DISCHARGE.
- PRIOR TO CONSTRUCTION, THE CONTRACTOR SHALL FIELD VERIFY THE HORIZONTAL AND VERTICAL LOCATIONS OF ALL POTENTIAL OBSTRUCTIONS INCLUDING ALL UNDERGROUND UTILITIES. SHOULD A CONFLICT EXIST, THE CONTRACTOR SHALL NOTIFY THE CONSTRUCTION OBSERVER OR ENGINEER SO THAT THE CONFLICT CAN BE RESOLVED WITH A MINIMUM AMOUNT OF DELAY.
- TWO (2) WORKING DAYS PRIOR TO ANY EXCAVATION, THE CONTRACTOR SHALL CONTACT LINE LOCATING SERVICE FOR LOCATION OF EXISTING UTILITIES.
- ALL ELECTRICAL, TELEPHONE, CABLE TV, GAS AND OTHER UTILITY LINES, CABLES, AND APPURTENANCES ENCOUNTERED DURING CONSTRUCTION THAT REQUIRE RELOCATION, SHALL BE COORDINATED WITH THAT UTILITY. THE CONTRACTOR SHALL BE RESPONSIBLE FOR COORDINATION OF ALL NECESSARY UTILITY ADJUSTMENTS. NO ADDITIONAL COMPENSATION WILL BE ALLOWED FOR DELAYS OR INCONVENIENCES CAUSED BY UTILITY COMPANY WORK CREWS. THE CONTRACTOR MAY BE REQUIRED TO RESCHEDULE HIS ACTIVITIES TO ALLOW UTILITY CREWS TO PERFORM THEIR REQUIRED WORK.
- THE CONTRACTOR IS RESPONSIBLE FOR PROTECTING ALL EXISTING UTILITY LINES WITHIN THE CONSTRUCTION AREA. ANY DAMAGE TO EXISTING FACILITIES CAUSED BY CONSTRUCTION ACTIVITY SHALL BE REPAIRED OR REPLACED AT THE CONTRACTOR'S EXPENSE AND APPROVED BY THE CONSTRUCTION OBSERVER.
- CONSTRUCTION ACTIVITY SHALL BE LIMITED TO THE PROPERTY AND/OR PROJECT LIMITS. ANY DAMAGE TO ADJACENT PROPERTIES RESULTING FROM THE CONSTRUCTION PROCESS SHALL BE REPAIRED OR REPLACED AT THE CONTRACTOR'S EXPENSE.
- OVERNIGHT PARKING OF CONSTRUCTION EQUIPMENT SHALL NOT OBSTRUCT DRIVEWAYS OR DESIGNATED TRAFFIC LANES. THE CONTRACTOR SHALL NOT STORE ANY EQUIPMENT OR MATERIAL WITHIN THE PUBLIC RIGHT-OF-WAY.
- THE CONTRACTOR SHALL OBTAIN ALL THE NECESSARY PERMITS FOR THE PROJECT PRIOR TO COMMENCING CONSTRUCTION (I.E., BARRICADING, TOPSOIL DISTURBANCE, EXCAVATION PERMITS, EPA STORM WATER PERMITS, ETC.).
- ALL PROPERTY CORNERS DESTROYED DURING CONSTRUCTION SHALL BE REPLACED AT THE CONTRACTOR'S EXPENSE. ALL PROPERTY CORNERS MUST BE RESET BY A REGISTERED LAND SURVEYOR.
- THE CONTRACTOR SHALL PREPARE A CONSTRUCTION TRAFFIC CONTROL AND SIGNING PLAN AND OBTAIN APPROVAL OF SUCH PLAN FROM THE CITY OF ALBUQUERQUE, TRAFFIC ENGINEERING DEPARTMENT, PRIOR TO BEGINNING ANY CONSTRUCTION WORK ON OR ADJACENT TO EXISTING STREETS.
- ALL BARRICADES AND CONSTRUCTION SIGNING SHALL CONFORM TO APPLICABLE SECTIONS OF THE "MANUAL ON UNIFORM TRAFFIC CONTROL DEVICES" (MUTCD), US DEPARTMENT OF TRANSPORTATION, LATEST EDITION.
- THE CONTRACTOR SHALL MAINTAIN ALL CONSTRUCTION BARRICADES AND SIGNING AT ALL TIMES. THE CONTRACTOR SHALL VERIFY THE PROPER LOCATION OF ALL BARRICADING AT THE END AND BEGINNING OF EACH DAY.
- THE CONTRACTOR SHALL TAKE ALL STEPS NECESSARY TO CONFORM WITH EPA REQUIREMENTS, INCLUDING COMPLIANCE WITH NPDES PHASE 2 REQUIREMENTS.

GRADING NOTES

- EXCEPT AS PROVIDED HEREIN, GRADING SHALL BE PERFORMED AT THE ELEVATIONS AND IN ACCORDANCE WITH THE DETAILS SHOWN ON THIS PLAN.
- THE COST FOR REQUIRED CONSTRUCTION DUST AND EROSION CONTROL MEASURES SHALL BE INCIDENTAL TO THE PROJECT COST.
- ALL WORK RELATIVE TO FOUNDATION CONSTRUCTION SITE PREPARATION, AND PAVEMENT INSTALLATION, AS SHOWN ON THIS PLAN, SHALL BE CONSTRUCTED IN ACCORDANCE WITH THE "GEOTECHNICAL INVESTIGATION," AS PROVIDED BY THE ARCHITECT OR OWNER. ALL OTHER WORK SHALL, UNLESS OTHERWISE STATED OR PROVIDED FOR HEREON, BE CONSTRUCTED IN ACCORDANCE WITH THE PROJECT, (FIRST PRIORITY) SPECIFICATIONS, AND/OR THE CITY OF ALBUQUERQUE (COA) STANDARD SPECIFICATIONS FOR PUBLIC WORKS (SECOND PRIORITY).
- EARTH SLOPES SHALL NOT EXCEED 3 HORIZONTAL TO 1 VERTICAL UNLESS SHOWN OTHERWISE.
- IT IS THE INTENT OF THESE PLANS THAT THIS CONTRACTOR SHALL NOT PERFORM ANY WORK OUTSIDE OF THE PROPERTY BOUNDARIES EXCEPT AS REQUIRED BY THIS PLAN.


NOTE
HOPE PIPE AND FITTINGS SHALL BE INSTALLED AND BACKFILLED PER MANUFACTURER SPECIFICATIONS. CONNECTIONS TO CONCRETE MANHOLES AND CONCRETE DROP INLETS SHALL USE WATER STOP GASKETS AND SHALL BE INSTALLED PER MANUFACTURER'S SPECIFICATIONS

NOTE:
SIDEWALKS SHALL HAVE MINIMUM OF 1% AND A MAXIMUM OF 2% CROSS SLOPE.

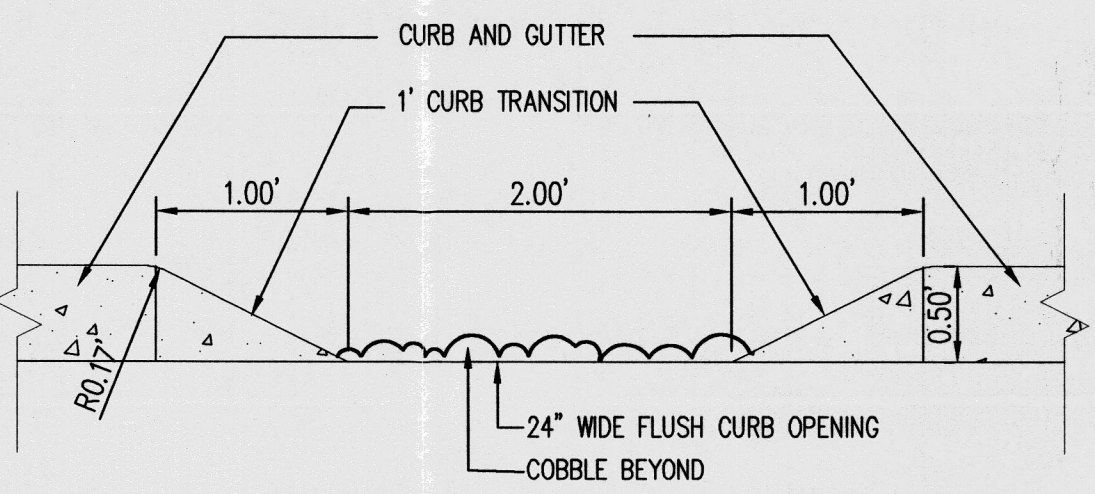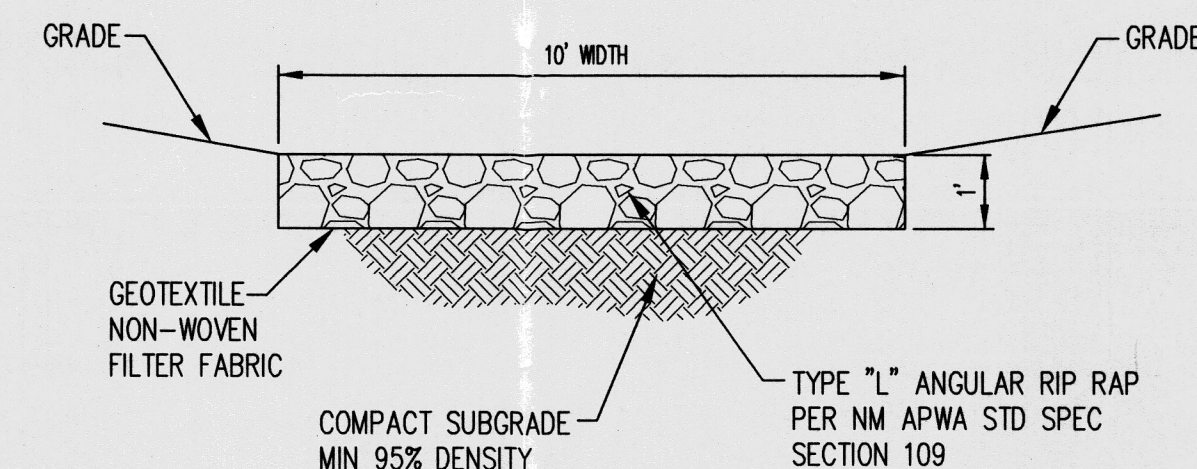

NOTE: SEE PLAN FOR CURB CUT LOCATIONS.

TYPICAL CURB CUT OPENING
N.T.S.

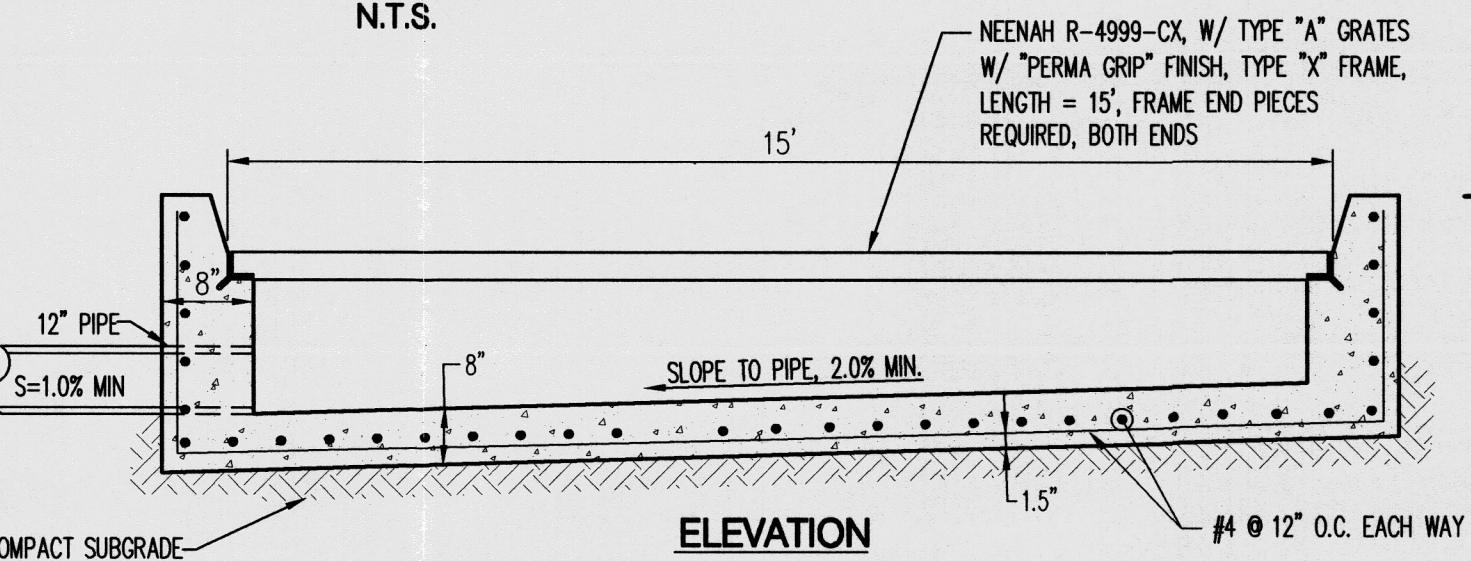

TRENCH DRAIN DETAIL
N.T.S.

DRAINAGE CERTIFICATION

I, MICHAEL BALASKOVITS, NMPE 18187, OF THE FIRM BOHANNAN HUSTON INC., HEREBY CERTIFY THAT THIS PROJECT HAS BEEN GRADED AND WILL DRAIN IN SUBSTANTIAL COMPLIANCE WITH AND IN ACCORDANCE WITH THE DESIGN INTENT OF THE APPROVED PLAN DATED 10/02/08. THE RECORD INFORMATION EDITED ONTO THE ORIGINAL DESIGN DOCUMENT HAS BEEN OBTAINED BY WILL PLOTNER, OF THE FIRM CARTESIAN SURVEYS. I FURTHER CERTIFY THAT A VISIT TO THE PROJECT SITE WAS CONDUCTED ON 05/27/09 AND IT WAS DETERMINED BY VISUAL INSPECTION THAT THE SURVEY DATA PROVIDED IS REPRESENTATIVE OF ACTUAL SITE CONDITIONS AND IS TRUE AND CORRECT TO THE BEST OF MY KNOWLEDGE AND BELIEF. THIS CERTIFICATION IS SUBMITTED IN SUPPORT OF A REQUEST FOR PERMANENT CERTIFICATE OF OCCUPANCY.


THE RECORD INFORMATION PRESENTED HEREON IS NOT NECESSARILY COMPLETE AND INTENDED ONLY TO VERIFY SUBSTANTIAL COMPLIANCE OF THE GRADING AND DRAINAGE ASPECTS OF THIS PROJECT. THOSE RELYING ON THIS RECORD DOCUMENT ARE ADVISED TO OBTAIN INDEPENDENT VERIFICATION OF ITS ACCURACY BEFORE USING IT FOR ANY OTHER PURPOSE.

Michael Balaskovits
MICHAEL BALASKOVITS, NMPE 18187

- FL33.20 DESIGN GRADE
- FL34.42 AS-BUILT GRADE
- SL.08

LEGEND

- FL33.20 DESIGN GRADE
- FL34.42 AS-BUILT GRADE
- SL.08

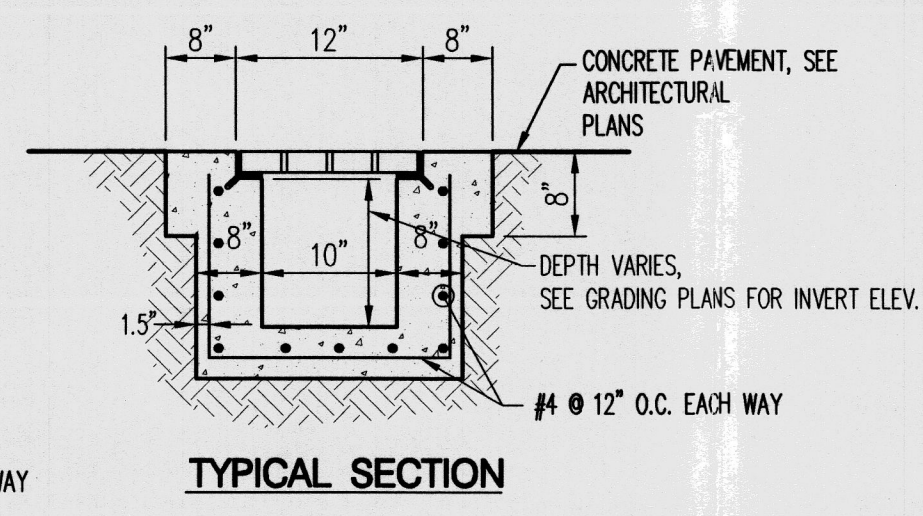

TYPICAL SECTION

CONSULTING ENGINEERS
ELECTRICAL: BOHANNAN HUSTON, INC. 1750 SOUTH BRENTWOOD, SUITE 800 ST. LOUIS, MISSOURI 63144 (P) 314-483-9715
STRUCTURAL: C. MICHAEL BALASKOVITS, P.E. 605 823-1000 ALBUQUERQUE, NM 87109
MECHANICAL: C. MICHAEL BALASKOVITS, P.E. 605 823-1000 ALBUQUERQUE, NM 87109
FIRE PROTECTION: KAUFMAN FIRE PROTECTION 3301 GRAND NE 1818 CLEVELAND BLVD. ALBUQUERQUE, NM 87109
CITY ENGINEER: C. DON KAUFMAN, P.E. 505-844-2447


CONTRACTOR: 1750 SOUTH BRENTWOOD, SUITE 800 ST. LOUIS, MISSOURI 63144 (P) 314-483-9715
ARCHITECT: GMA DESIGN GROUP INC. A DIVISION OF ARCO NATIONAL CONSTRUCTION 1818 CLEVELAND BLVD. ALBUQUERQUE, NM 87109 (P) 505-844-2447

PROJECT HAL
LOT 12A MESA DEL SOL
ALBUQUERQUE, NEW MEXICO

RECEIVED
MAY 27 2009

REVISIONS
1 10-2-08
2 10-10-08
3 5-15-09

JOB NO : SP5082
DRAWN BY :
ISSUE DATE :
SHEET NUMBER C-1

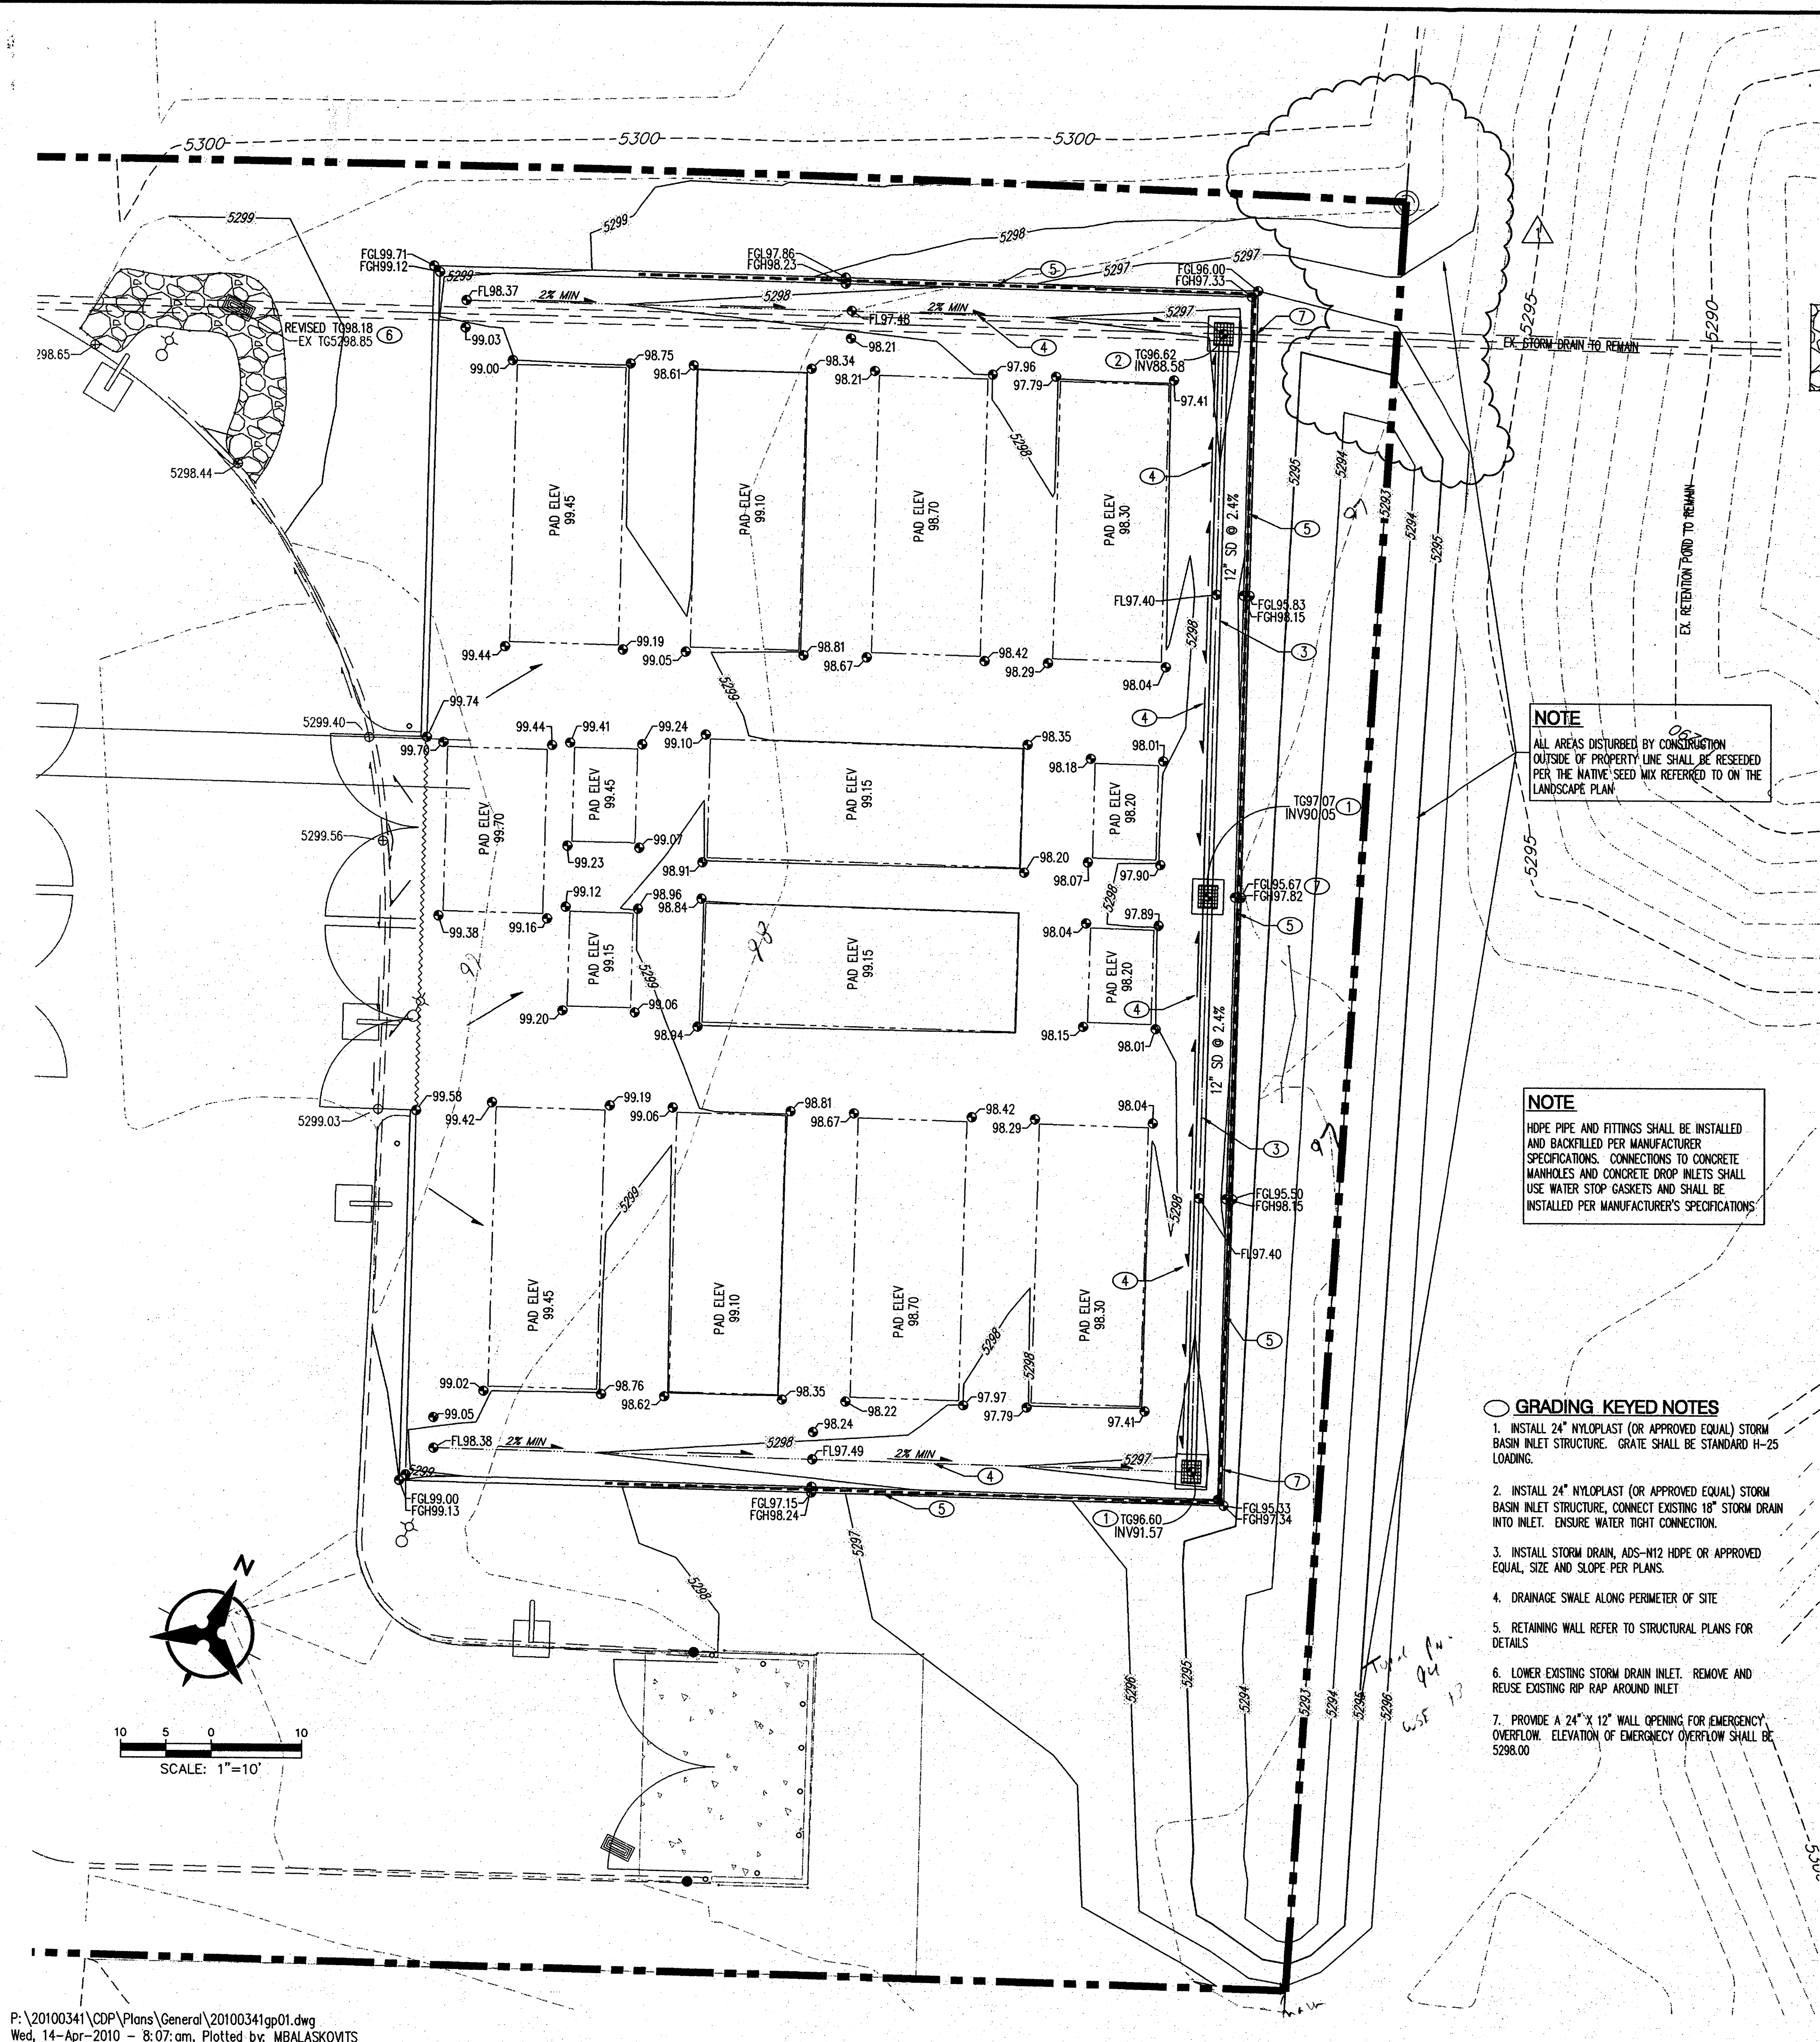


GENERAL NOTES

1. ALL WORK DETAILED ON THESE PLANS AND PERFORMED UNDER THIS CONTRACT SHALL BE CONSTRUCTED IN ACCORDANCE WITH THE PROJECT SPECIFICATIONS AND THE PROJECT GEOTECHNICAL REPORT. WHERE APPLICABLE, CITY OF ALBUQUERQUE PUBLIC WORKS STANDARDS SHALL APPLY.
2. THE CONTRACTOR SHALL ABIDE BY ALL LOCAL, STATE, AND FEDERAL LAWS, RULES AND REGULATIONS WHICH APPLY TO THE CONSTRUCTION OF THESE IMPROVEMENTS, INCLUDING EPA REQUIREMENTS WITH RESPECT TO STORM WATER DISCHARGE.
3. PRIOR TO CONSTRUCTION, THE CONTRACTOR SHALL FIELD VERIFY THE HORIZONTAL AND VERTICAL LOCATIONS OF ALL POTENTIAL OBSTRUCTIONS INCLUDING ALL UNDERGROUND UTILITIES. SHOULD A CONFLICT EXIST, THE CONTRACTOR SHALL NOTIFY THE CONSTRUCTION OBSERVER OR ENGINEER SO THAT THE CONFLICT CAN BE RESOLVED WITH A MINIMUM AMOUNT OF DELAY.
4. TWO (2) WORKING DAYS PRIOR TO ANY EXCAVATION, THE CONTRACTOR SHALL CONTACT THE UTILITY LOCATING SERVICE FOR LOCATION OF EXISTING UTILITIES.
5. ALL ELECTRICAL, TELEPHONE, CABLE TV, GAS AND OTHER UTILITY LINES, CABLES, AND APPURTENANCES EXCAVATED DURING CONSTRUCTION THAT REQUIRE RELOCATION, SHALL BE COORDINATED WITH THAT UTILITY. THE CONTRACTOR SHALL BE RESPONSIBLE FOR COORDINATION OF ALL NECESSARY UTILITY ADJUSTMENTS. NO ADDITIONAL COMPENSATION WILL BE ALLOWED FOR DELAYS OR INCONVENIENCES CAUSED BY UTILITY COMPANY WORK CREWS. THE CONTRACTOR MAY BE REQUIRED TO RESCHEDULE HIS ACTIVITIES TO ALLOW UTILITY CREWS TO PERFORM THEIR REQUIRED WORK.
6. THE CONTRACTOR IS RESPONSIBLE FOR PROTECTING ALL EXISTING UTILITY LINES WITHIN THE CONSTRUCTION AREA. ANY DAMAGE TO EXISTING FACILITIES CAUSED BY CONSTRUCTION ACTIVITY SHALL BE REPAIRED OR REPLACED AT THE CONTRACTOR'S EXPENSE AND APPROVED BY THE CONSTRUCTION OBSERVER.
7. CONSTRUCTION ACTIVITY SHALL BE LIMITED TO THE PROPERTY AND/OR PROJECT LIMITS. ANY DAMAGE TO ADJACENT PROPERTIES RESULTING FROM THE CONSTRUCTION PROCESS SHALL BE REPAIRED OR REPLACED AT THE CONTRACTOR'S EXPENSE.
8. OVERNIGHT PARKING OF CONSTRUCTION EQUIPMENT SHALL NOT OBSTRUCT DRIVEWAYS OR DESIGNATED TRAFFIC LANES. THE CONTRACTOR SHALL NOT STORE ANY EQUIPMENT OR MATERIAL WITHIN THE PUBLIC RIGHT-OF-WAY.
9. THE CONTRACTOR SHALL OBTAIN ALL THE NECESSARY PERMITS FOR THE PROJECT PRIOR TO COMMENCING CONSTRUCTION (I.E., BARRICADING, TOPSOIL DISTURBANCE, EXCAVATION PERMITS, EPA STORM WATER PERMITS, ETC.).
10. ALL PROPERTY CORNERS DESTROYED DURING CONSTRUCTION SHALL BE REPLACED AT THE CONTRACTOR'S EXPENSE. ALL PROPERTY CORNERS MUST BE RESET BY A REGISTERED LAND SURVEYOR.
11. THE CONTRACTOR SHALL PREPARE A CONSTRUCTION TRAFFIC CONTROL AND SIGNING PLAN AND OBTAIN APPROVAL OF SUCH PLAN FROM THE CITY OF ALBUQUERQUE, TRAFFIC ENGINEERING DEPARTMENT, PRIOR TO BEGINNING ANY CONSTRUCTION WORK ON OR ADJACENT TO EXISTING STREETS.
12. ALL BARRICADES AND CONSTRUCTION SIGNING SHALL CONFORM TO APPLICABLE SECTIONS OF THE "MANUAL ON UNIFORM TRAFFIC CONTROL DEVICES" (MUTCD), US DEPARTMENT OF TRANSPORTATION, LATEST EDITION.
13. THE CONTRACTOR SHALL MAINTAIN ALL CONSTRUCTION BARRICADES AND SIGNING AT ALL TIMES. THE CONTRACTOR SHALL VERIFY THE PROPER LOCATION OF ALL BARRICADE AT THE END AND BEGINNING OF EACH DAY.
14. THE CONTRACTOR SHALL TAKE ALL STEPS NECESSARY TO CONFORM WITH EPA REQUIREMENTS, INCLUDING COMPLIANCE WITH NPDES PHASE 2 REQUIREMENTS.


GRADING NOTES

1. EXCEPT AS PROVIDED HEREIN, GRADING SHALL BE PERFORMED AT THE ELEVATIONS AND IN ACCORDANCE WITH THE DETAILS SHOWN ON THIS PLAN.
2. THE COST FOR REQUIRED CONSTRUCTION DUST AND EROSION CONTROL MEASURES SHALL BE INCIDENTAL TO THE PROJECT COST.
3. ALL WORK RELATIVE TO FOUNDATION CONSTRUCTION, SITE PREPARATION, AND PAVEMENT INSTALLATION, AS SHOWN ON THIS PLAN, SHALL BE CONSTRUCTED IN ACCORDANCE WITH THE "GEOTECHNICAL INVESTIGATION," AS PROVIDED BY THE ARCHITECT OR OWNER. ALL OTHER WORK SHALL, UNLESS OTHERWISE STATED OR PROVIDED FOR HEREON, BE CONSTRUCTED IN ACCORDANCE WITH THE PROJECT, (FIRST PRIORITY) SPECIFICATIONS, AND/OR THE CITY OF ALBUQUERQUE (COA) STANDARD SPECIFICATIONS FOR PUBLIC WORKS (SECOND PRIORITY).
4. EARTH SLOPES SHALL NOT EXCEED 3 HORIZONTAL TO 1 VERTICAL UNLESS SHOWN OTHERWISE.
5. IT IS THE INTENT OF THESE PLANS THAT THIS CONTRACTOR SHALL NOT PERFORM ANY WORK OUTSIDE OF THE PROPERTY BOUNDARIES EXCEPT AS REQUIRED BY THIS PLAN.
6. THE CONTRACTOR IS TO ENSURE THAT NO SOIL ERODES FROM THE SITE ONTO ADJACENT PROPERTY OR PUBLIC RIGHT-OF-WAY. THIS SHOULD BE ACHIEVED BY CONSTRUCTING TEMPORARY BERMS OR SILT FENCE AT THE PROPERTY LINES AND WETTING THE SOIL TO PROTECT IT FROM WIND EROSION.
7. A DISPOSAL SITE FOR ANY & ALL EXCESS EXCAVATION MATERIAL, AND UNSUITABLE MATERIAL AND/OR A BORROW SITE CONTAINING ACCEPTABLE FILL MATERIAL SHALL BE OBTAINED BY THE CONTRACTOR IN COMPLIANCE WITH APPLICABLE ENVIRONMENTAL REGULATIONS AND APPROVED BY THE OBSERVER. ALL COSTS INCURRED IN OBTAINING A DISPOSAL OR BORROW SITE AND HAUL TO OR FROM SHALL BE CONSIDERED INCIDENTAL TO THE PROJECT AND NO SEPARATE MEASUREMENT OR PAYMENT SHALL BE MADE.
8. PAVING AND ROADWAY GRADES SHALL BE +/- 0.1' FROM PLAN ELEVATIONS. PAD ELEVATION SHALL BE +/- 0.1' FROM BUILDING PLAN ELEVATION.
9. ALL PROPOSED CONTOURS REFLECT TOP OF PAVEMENT ELEVATIONS IN THE PARKING AREA AND MUST BE ADJUSTED FOR MEDIANS AND ISLANDS.
10. VERIFY ALL ELEVATIONS SHOWN ON PLAN BASIS OF ELEVATION CONTROL STATION PRIOR TO BEGINNING CONSTRUCTION.
11. SITE CONSTRUCTION TO MEET REQUIREMENTS OF SWPPP (STORM WATER POLLUTION PREVENTION PLAN).

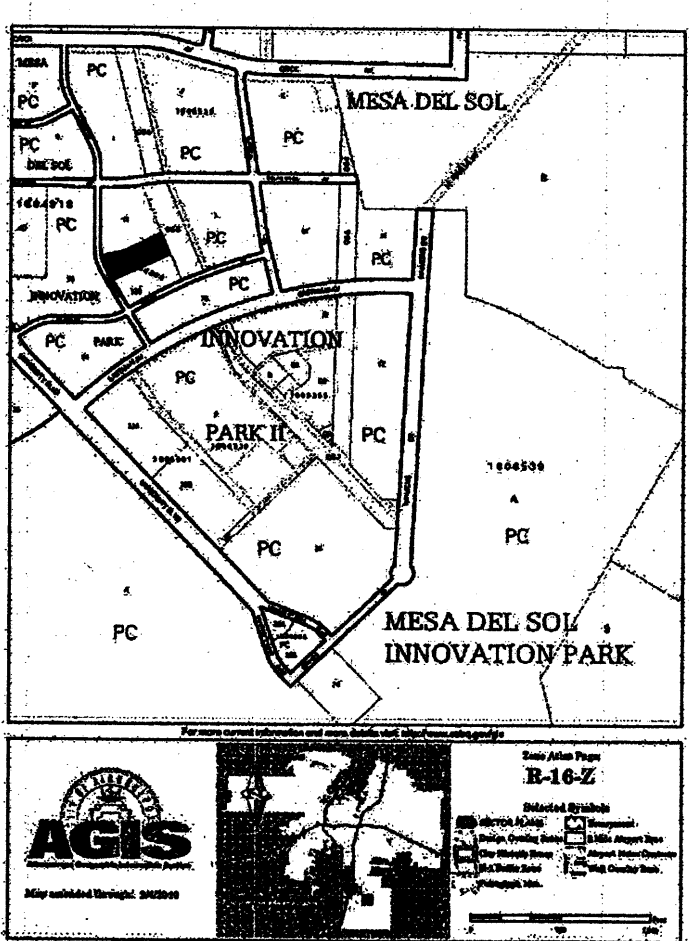

LOCATION MAP
ZONE ATLAS INDEX MAP R-16
NOT TO SCALE

BENCH MARKS:
BENCHMARK #1
1_R16
N1453939.35 E1533242.614 5291.48
BENCHMARK #2
3_Q16
N1457546.798 E1534025.978 5310.42

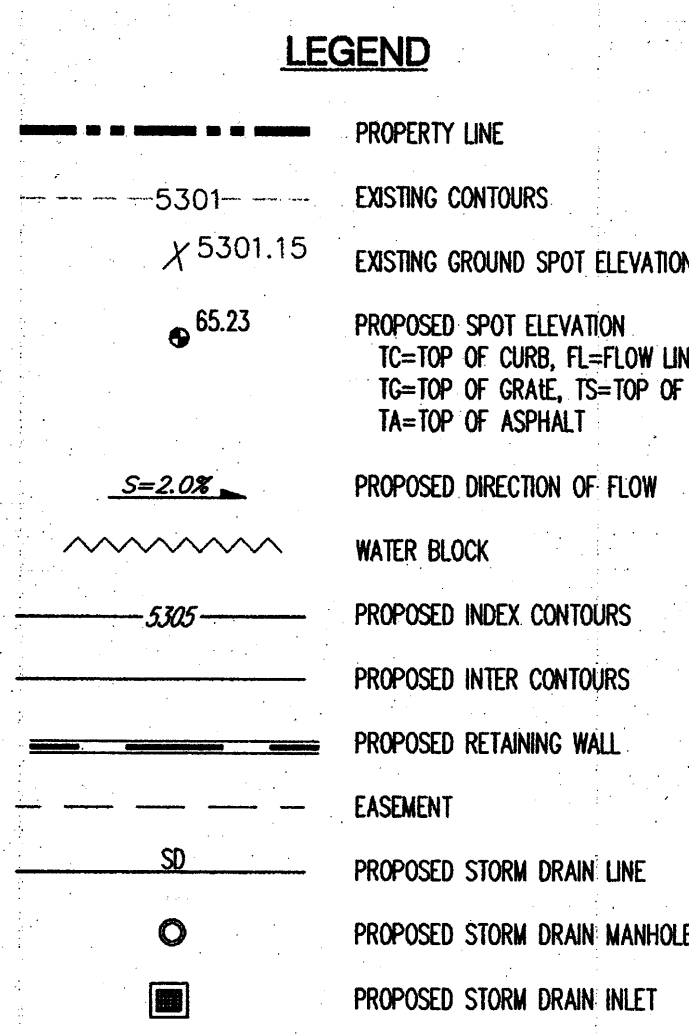

GRADING KEYED NOTES

1. INSTALL 24" NYLOPLAST (OR APPROVED EQUAL) STORM BASIN INLET STRUCTURE. GRATE SHALL BE STANDARD H-25 LOADING.
2. INSTALL 24" NYLOPLAST (OR APPROVED EQUAL) STORM BASIN INLET STRUCTURE. CONNECT EXISTING 18" STORM DRAIN INTO INLET. ENSURE WATER TIGHT CONNECTION.
3. INSTALL STORM DRAIN, ADS-N12 HOPE OR APPROVED EQUAL, SIZE AND SLOPE PER PLANS.
4. DRAINAGE SWALE ALONG PERIMETER OF SITE
5. RETAINING WALL REFER TO STRUCTURAL PLANS FOR DETAILS
6. LOWER EXISTING STORM DRAIN INLET. REMOVE AND REUSE EXISTING RIP RAP AROUND INLET
7. PROVIDE A 24" X 12" WALL OPENING FOR EMERGENCY OVERFLOW. ELEVATION OF EMERGENCY OVERFLOW SHALL BE 5298.00

RECEIVED

APR 14 2010
HYDROLOGY
SECTION

Bohannon & Huston
Courtyard | 7500 Jefferson St NE Albuquerque, NM 87109-4395
ENGINEERING • SPATIAL DATA • ADVANCED TECHNOLOGIES


CONSULTING ENGINEERS
ELECTRICAL: BOHANNAN & HUSTON, 7500 JEFFERSON NE, ALBUQUERQUE, NM 87109-4395, (505) 824-3447
STRUCTURAL: BOHANNAN & HUSTON, 7500 JEFFERSON NE, ALBUQUERQUE, NM 87109-4395, (505) 824-3447
MECHANICAL: BOHANNAN & HUSTON, 7500 JEFFERSON NE, ALBUQUERQUE, NM 87109-4395, (505) 824-3447

CONTRACTOR
ARCO, 1700 S BROADWAY, SUITE 801, ALBUQUERQUE, NM 87102, (505) 241-4675



ARCHITECT
GMA DESIGN GROUP, INC., 1700 S BROADWAY, SUITE 801, ALBUQUERQUE, NM 87102, (505) 241-4675

DATA EQUIPMENT EXPANSION FOR:
MOLINA HEALTHCARE
2610 TURNING DRIVE SE, ALBUQUERQUE, NEW MEXICO 87106

JOB NO.:
DRAWN BY: MJB
ISSUE DATE: 02/16/10
REVISIONS: 04-14-2010
SHEET NUMBER: C100

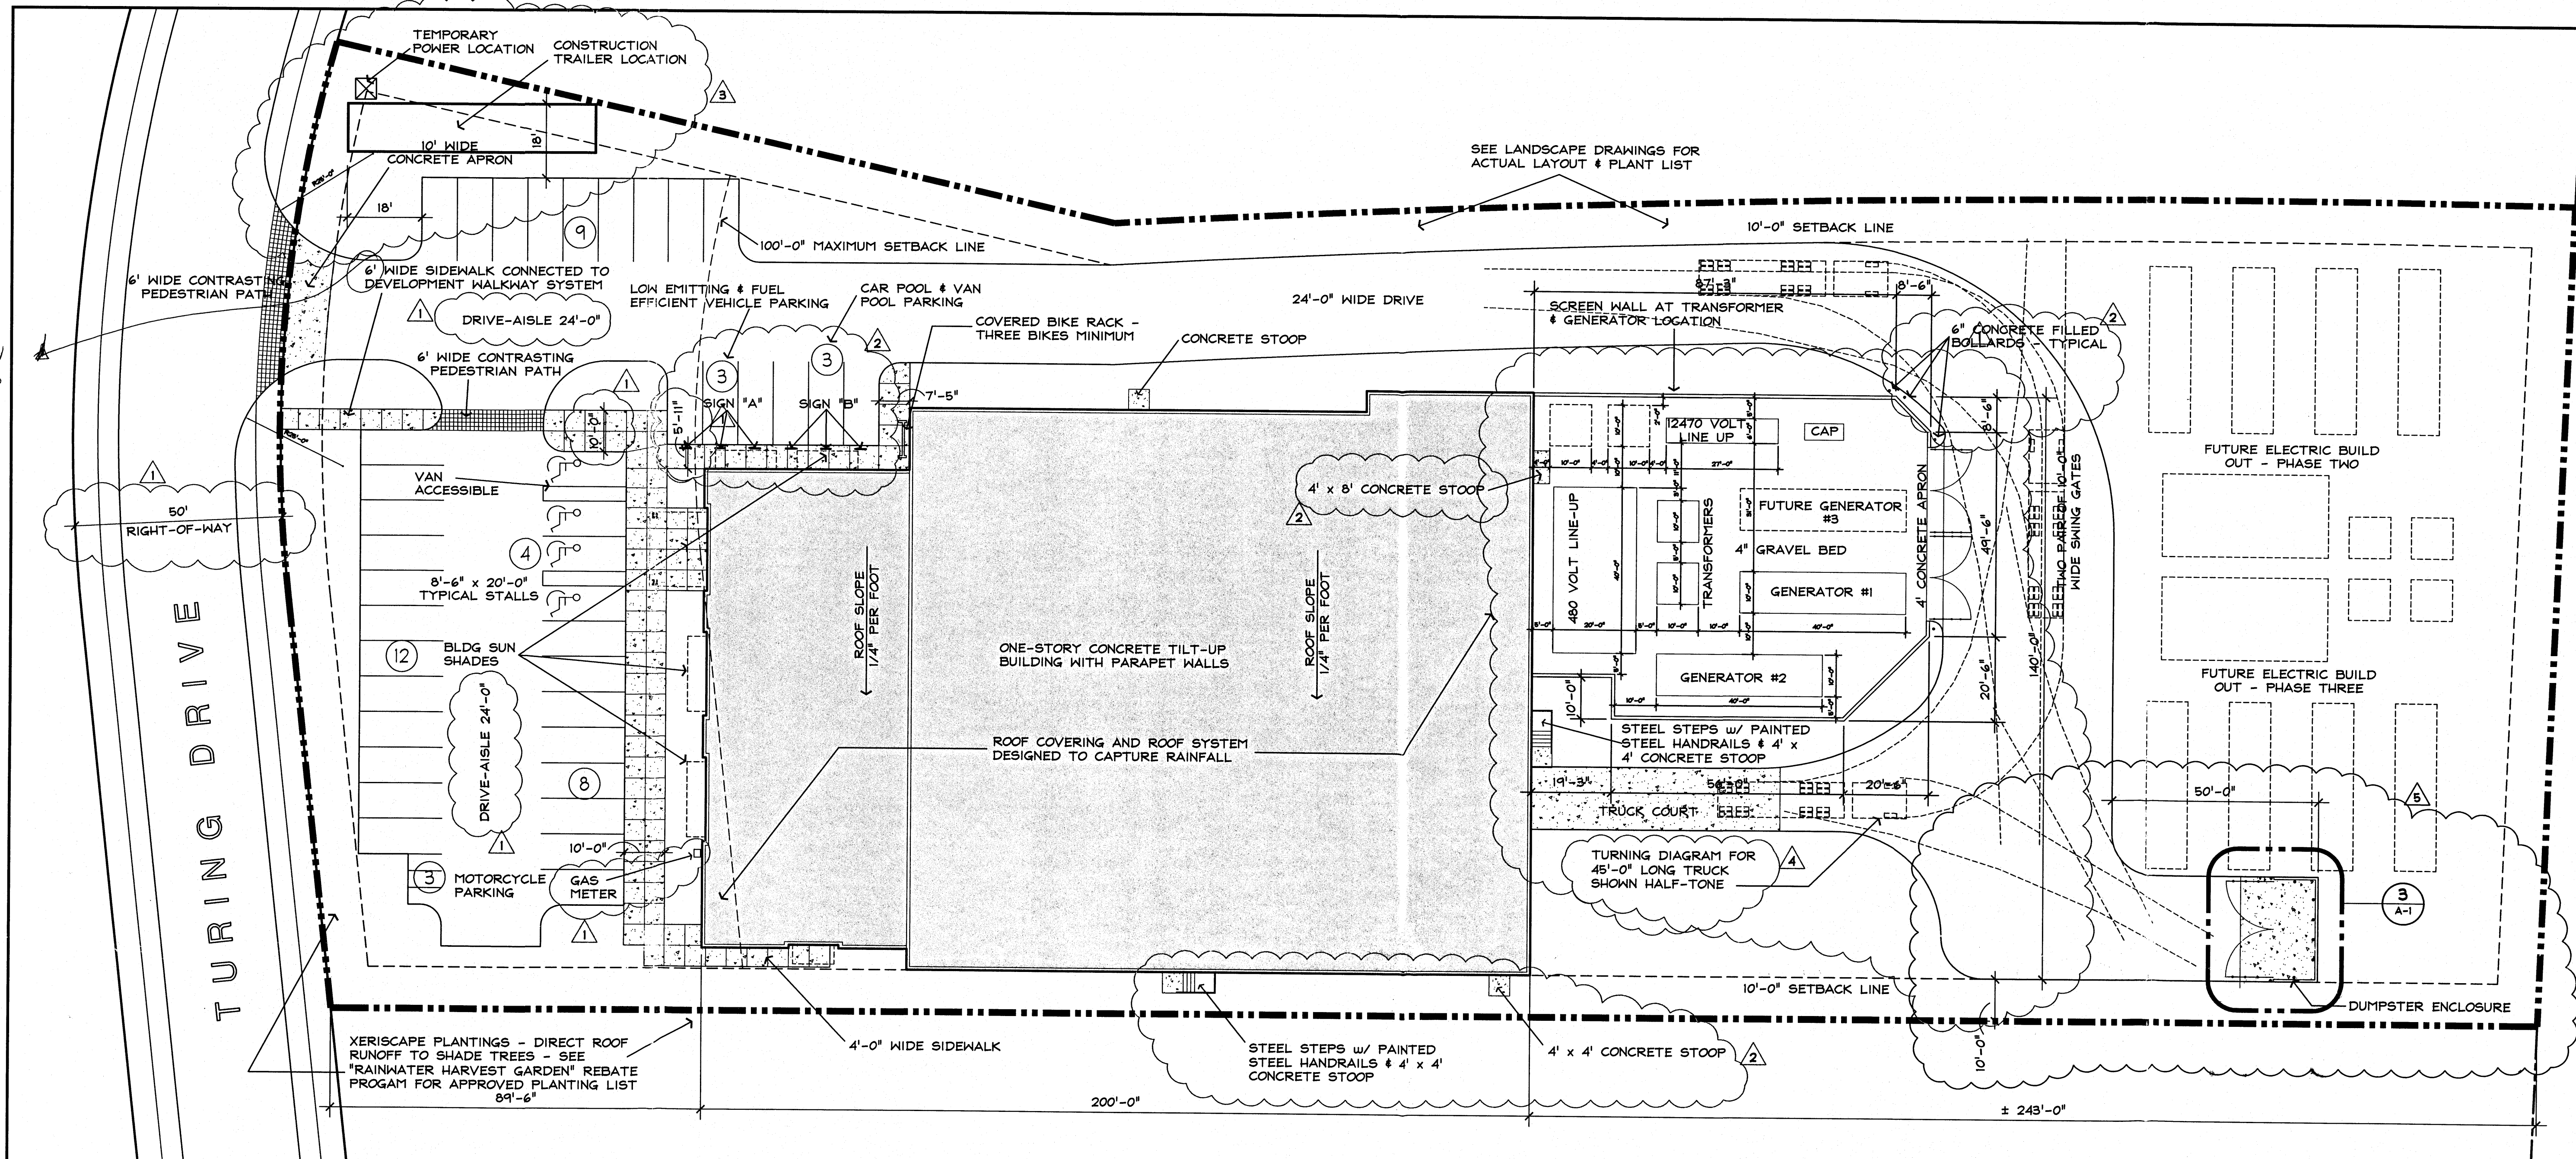

PROPOSED SITE PLAN
SCALE: 1" = 20'-0"

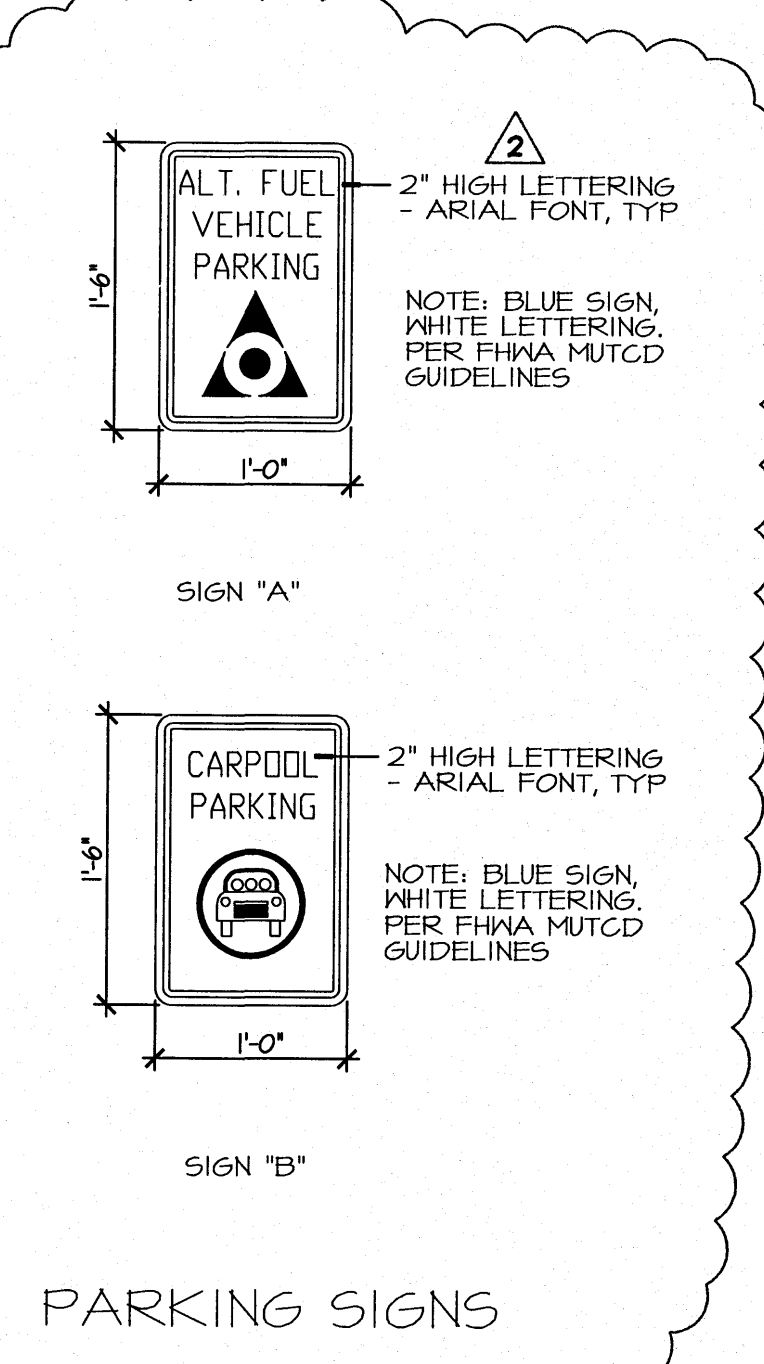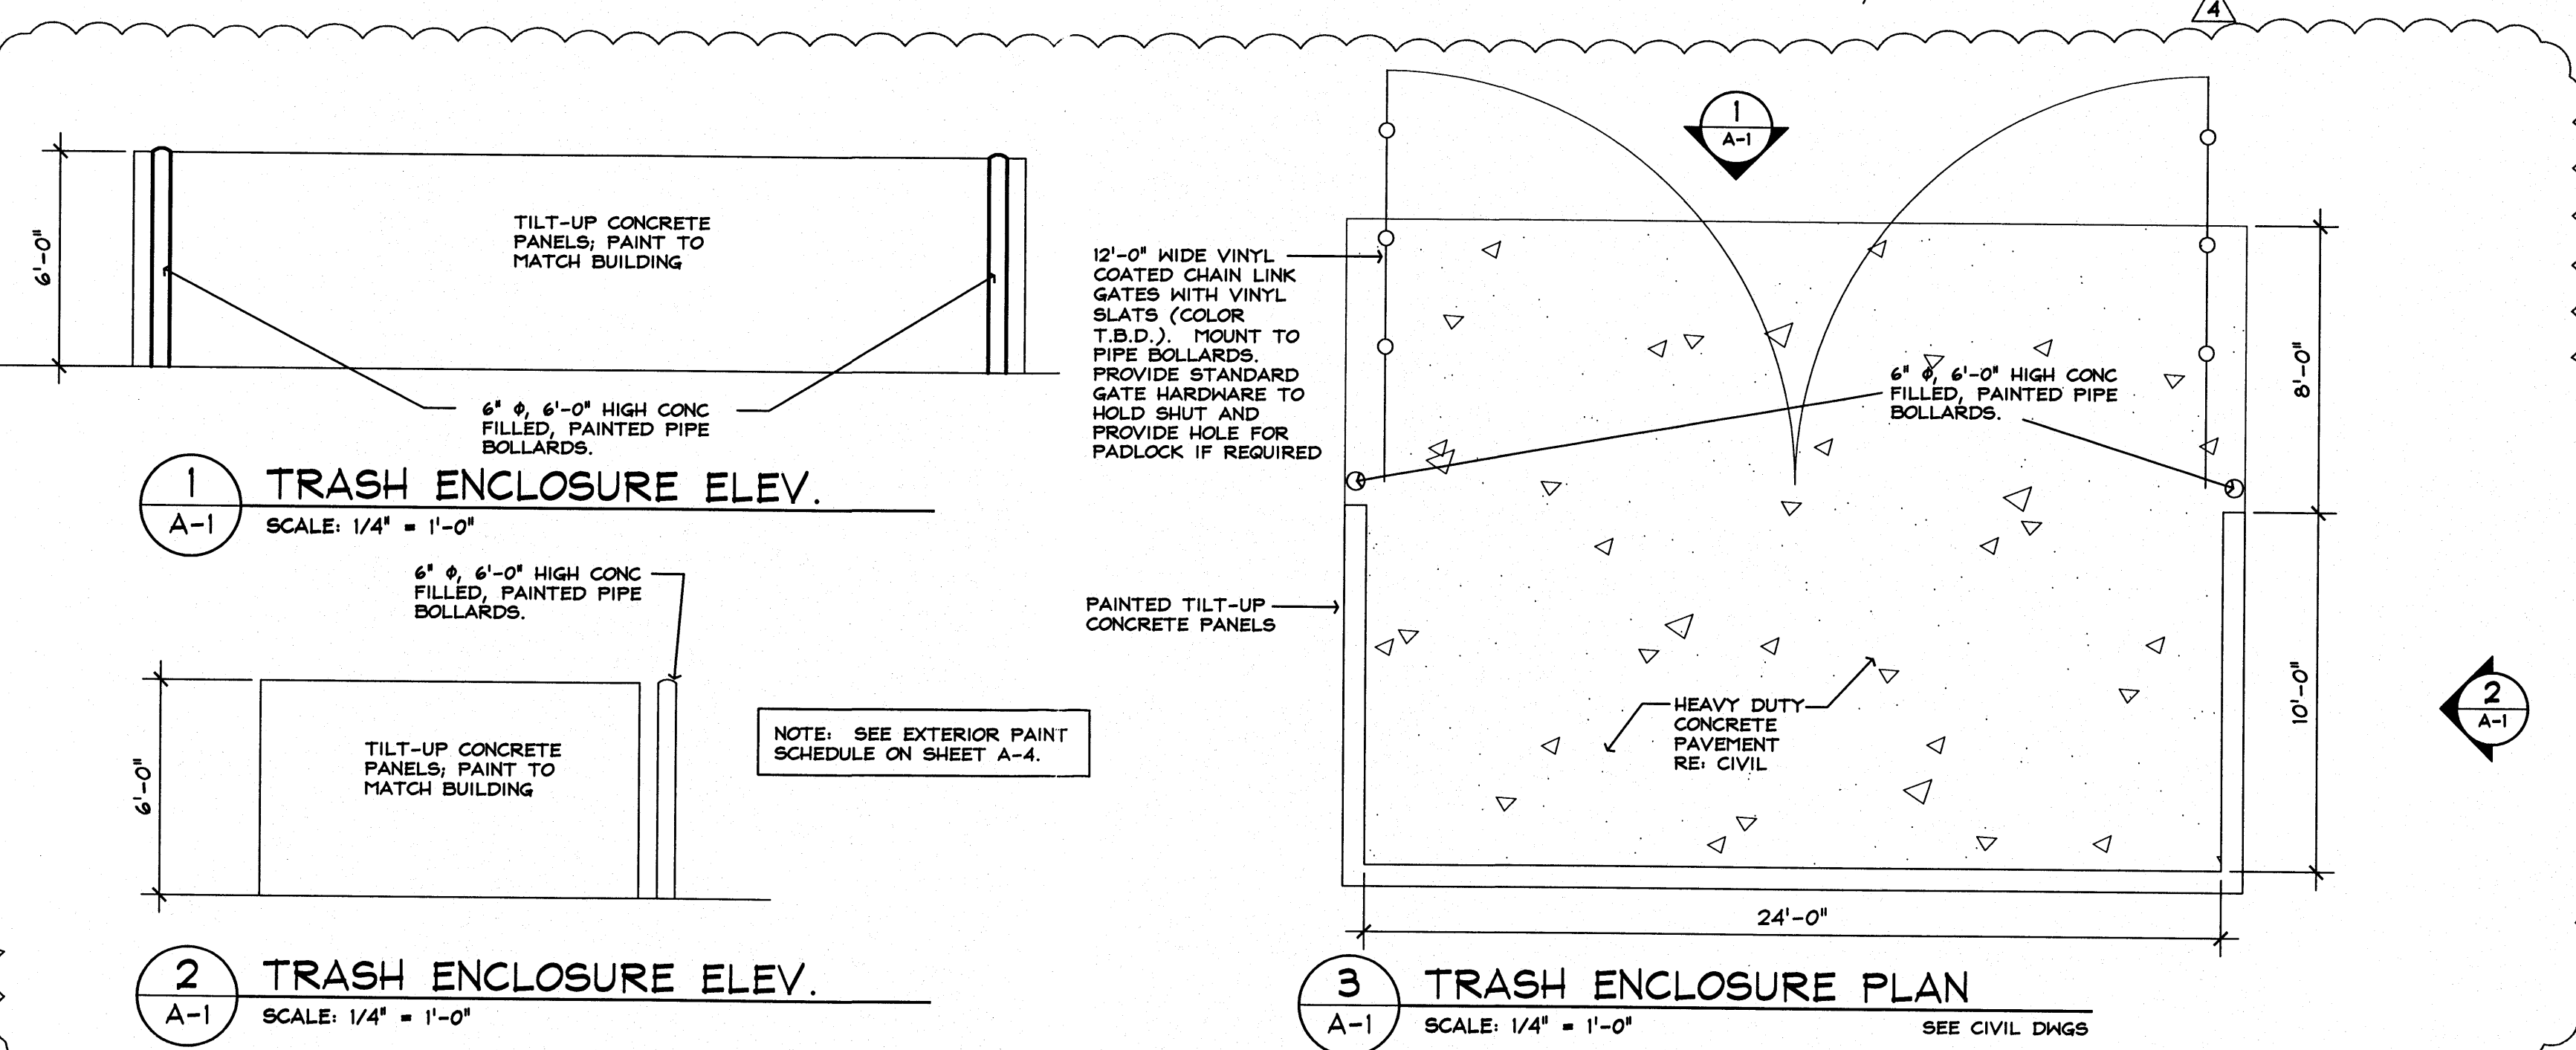

PARKING CALCULATIONS

	REQUIRED	PROVIDED
OFFICE	7,500 SF/ 200 SF =	38
COMPUTER ROOM	10,000 SF/ 1,000 SF =	10
WAREHOUSE	7,500 SF/ 2,000 SF =	4
TOTAL REQUIRED PARKING	52	52
MOTORCYCLE PARKING PER 14-16-3-1 (C)	3	39
ACCESSIBLE PARKING PER 14-16-3-1 (F) 9	4	4
PREFERRED PARKING PER Mesa del Sol STDS	4	3
BICYCLE PARKING PER Mesa del Sol STDS	3	3
TOTAL PERVIOUS AREA CALCULATIONS		
BUILDING AREA	26,171 SQ FT	6
SIDEWALK PAVEMENT	3,028 SQ FT	3
DRIVEWAY PAVEMENT	28,716 SQ FT	
TOTAL IMPERVIOUS AREA	57,915 SQ FT	
TOTAL SITE AREA	109,790 SQ FT	
TOTAL PERVIOUS AREA	51,875 SQ FT (47.2%)	

NOTE: MAXIMUM SIZE DELIVERY TRUCK IS 45'-0" LONG

CONSULTING ENGINEERS

CONTRACTOR: ARCO National Construction Company, Inc.
1790 SOUTH BRENTWOOD, SUITE 600
ALBUQUERQUE, NM 87109
(505) 344-8375

ARCHITECT: GMA DESIGN GROUP INC.
ARCHITECTURAL DESIGN SERVICES
1790 SOUTH BRENTWOOD, SUITE 600
ALBUQUERQUE, NM 87109
(505) 344-8375

PROJECT HAL

LOT 12A MESA DEL SOL
ALBUQUERQUE, NEW MEXICO

REVISIONS

NO.	DATE	DESCRIPTION
1	07-15-08	ARC Comments
2	07-28-08	
3	08-05-08	
4	09-12-08	
5	10-07-08	

JOB NO: SJ0716
DRAWN BY: FCW
ISSUE DATE: 08-28-08

SHEET NUMBER
A-1
SITE PLAN

RECEIVED
May 29 2009
HYDROLOGY SECTION

