

Introduction
This drainage management plan is in support of the Water Utility Site at Mesa del Sol. With this submittal we are requesting COA hydrology approval for DRB Site Plan Administrative Amendment Approval and Building Permit Approval.

Existing Conditions
The elevated reservoir site ("The Site") is Tract 20 of the Bulk Land Plot for Mesa del Sol Innovation Park. This 6.24 acre lot is currently undeveloped and slopes 0.5% to 1.0% from the west to east. It is located in between the two Regional Retention Ponds ("Ponds") constructed with the Albuquerque Studios Site (COA Hydro File #R16/0002A).

Off-site Drainage
Current drainage from the undeveloped land to the west of the site drains into the existing pond constructed with the Albuquerque Studios site via storm drain and surface flow. A temporary swale west of the access road will direct flows to the existing pond. All drainage to the east of these adjacent tracts continues to outfall to the existing plays system to the east and will not affect the site. Drainage from the north will be diverted east into the existing ponds via a temporary swale. Upon development of the future parcels, drainage will be conveyed to the existing ponds in a manner suitable to each specific site plan, and each site will be subject to future submittal and approval.

Proposed Site Grading
The slope of the site under proposed conditions will be between 0.5% to 1.0%. A portion of the site will drain to the eastern pond (Basin 1) while the remainder of the site will drain to the southwestern pond (Basin 2). This site will not be paved but seeded resulting in land treatments to be 50% D, 25% C and 25% B (See Table 1 for basin calculations).

The Ponds have previously been constructed to account for developed flows from this site with the Albuquerque Studios submittal. Currently there are only a few basins contributing to the existing Ponds. Under current conditions for these basins (including the developed flows from The Site), the maximum water surface elevation (WSEL) is approximately 5284.60.

(Note: the ponds were sized to accept the 100 year, 10 day storm generated by the fully developed drainage area in accordance with the methodology outlined in the DPM section 22.2. Developed land treatments for Mesa del Sol sites are assumed to be 90% treatment D and 10% treatment B. Currently the top of the ponds extend to 5288.00).

A portion of the existing western pond constructed with the Albuquerque Studios site will be filled in order to allow room for an access road and future utilities to serve both the Elevated Reservoir site and the Mesa del Sol development. The pond to the east will be extended to the north to account for this volume. (Total pond volume provided after pond adjustments = 42.4 acre-ft, Total volume required for current contributing basins to the existing ponds = 18.9 acre-ft).

Floodplain
In accordance with FEMA Community Map Panel #35001C0555E, the site is not located within a floodplain.

Conclusion
This drainage submittal has been prepared in accordance with City of Albuquerque requirements. This plan demonstrates the proposed grading and drainage design. The implementation of this design would result in the safe passage and retention of the 100 yr, 10 day storm event. We have previously received hydrology approval for DRB site plan approval and rough grading and foundation permit approval. With this submittal we are requesting COA Hydrology Department approval for DRB Administrative Amendment approval and building permit approval.

GENERAL NOTES

1. CONTRACTOR MUST OBTAIN A TOPSOIL DISTURBANCE PERMIT FROM THE ENVIRONMENTAL HEALTH DIVISION PRIOR TO CONSTRUCTION.
2. THE CONTRACTOR IS TO REFER TO EARTHWORK SPECIFICATION AS NOTED IN THE SOILS REPORT BY GEO-TEST, INC. DATED 1/07 (JOB NO. 1-81202).
3. THE CONTRACTOR SHALL CONFORM TO ALL CITY, COUNTY, STATE, AND FEDERAL DUST CONTROL MEASURES & REQUIREMENTS AND WILL BE RESPONSIBLE FOR PREPARING AND OBTAINING ALL NECESSARY APPLICATIONS AND APPROVALS.
4. THE CONTRACTOR SHALL ENSURE THAT NO SOIL ERODES FROM THE LOTS INTO PUBLIC RIGHT-OF-WAY. THIS CAN BE ACHIEVED BY CONSTRUCTING TEMPORARY BERMS AND NETTING THE SOIL TO KEEP IT FROM BLOWING.
5. Boulders greater than 3 feet in diameter excavated during grading activities shall be stockpiled and disposed of at the discretion of the owner.
6. ALL WALLS SHOWN ARE TO BE PLACED ALONG PROPERTY LINE.

TABLE 1 ELEVATED RESERVOIR - DEVELOPED HYDRAULIC CALCULATIONS									
Basin Data Table									
This table is based on the DPM Section 22.2, Zone 12									
SUB-BASIN ID	Area (SQ. FT)	Area (AC.)	Land Treatment Percentages				Q(100) (cfs/acre)	Q(100) (cfs)	WT E (Inches)
			A	B	C	D			
Basin 1	110391	2.53	0.0%	25.0%	25.0%	50.0%	4.29	10.87	1.88
Basin 2	162941	3.74	0.0%	25.0%	25.0%	50.0%	3.71	13.86	1.84
Total	273331.68	6.27						36661.29	67683.40

KEYED NOTES

1. INSTALL CONCRETE WEIR AND RUNDOWN PER DETAIL A & B, SHEET 5B. TRANSITION FROM WEIR SECTION TO RUNDOWN SECTION OVER 10'.
2. INSTALL TURN BLOCKS FOR DRAINAGE EVERY 20 FT.O.C.
3. INSTALL 10'X10' R/P RAP BLANKET, 12" THICK.
4. FUTURE 2-36" RCP STORM DRAIN PIPES (TO BE CONSTRUCTED AT A LATER DATE).
5. INSTALL 36" RCP END SECTION.
6. INSTALL TYPE E MANHOLE PER COA STANDARD DRAWING 2101.
7. TIE TO EXISTING STUB.
8. INSTALL 30" RCP END SECTION.
9. PROVIDE 1' HIGH BERM, 2FT WIDE TOP, WITH 3:1 SIDE SLOPES. EXTEND 50' BEYOND CONCRETE RUNDOWN.

LEGEND


- 91.62 PROPOSED SPOT ELEVATIONS
- 92.48 EXISTING SPOT ELEVATIONS
- 5470 EXISTING CONTOUR W/ INDEX ELEVATION
- FLOW ARROW
- PROPOSED TANK WATER LINE
- DRAINAGE BASIN BOUNDARIES
- PROPOSED WALL
- PROPOSED SLOPE

BHI JOB NO. 070204


Bohannon & Huston
Courtney I. 7800 Jefferson St. NE Albuquerque, NM 87109-4335
ENGINEERING & SPATIAL DATA & ADVANCED TECHNOLOGIES

CITY OF ALBUQUERQUE
DEPARTMENT OF MUNICIPAL DEVELOPMENT
MESA DEL SOL
ELEVATED WATER RESERVOIR
SITE GRADING, DRAINAGE, AND UTILITY PLAN


DESIGN REVIEW COMMITTEE	CITY ENGINEER APPROVAL	MO./DAY/YR.	MO./DAY/YR.
LAST DESIGN UPDATE			
CITY PROJECT NO.	ZONE MAP NO.	SHEET	OF
	R-16-Z	5A	5

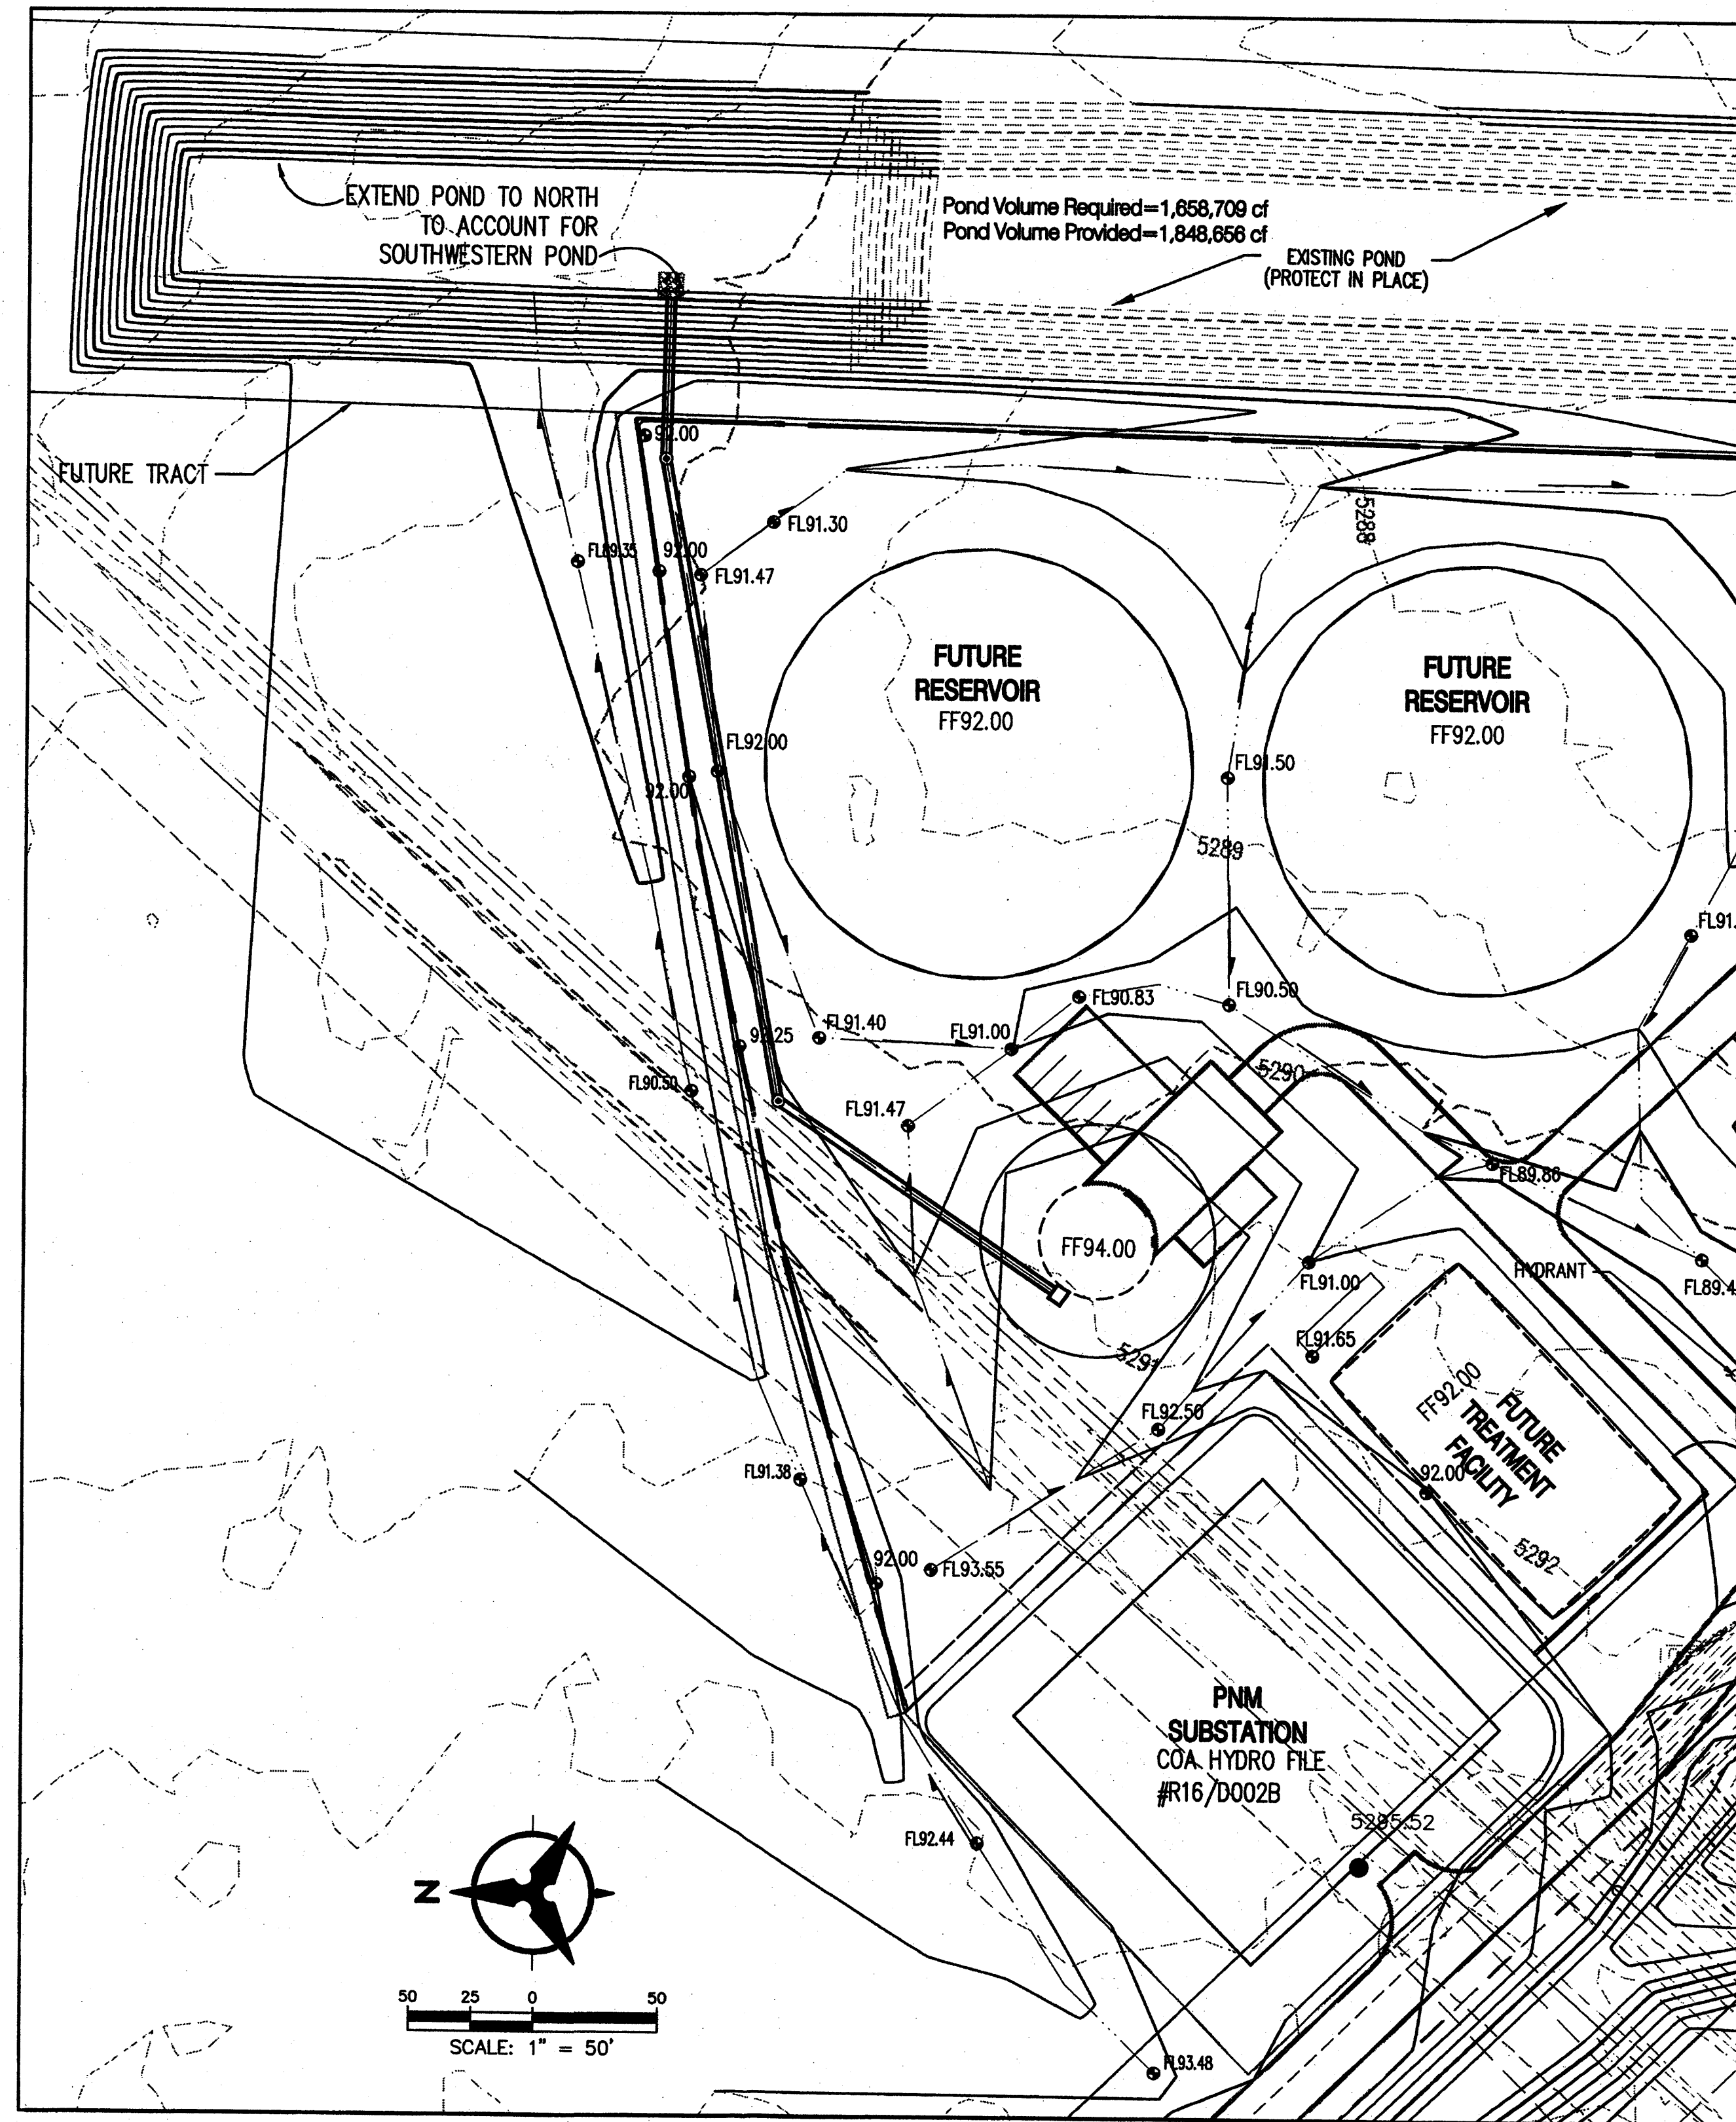


- LEGEND**
- PROPERTY LINE
 - EXISTING CONTOUR
 - PROPOSED INDEX CONTOUR
 - PROPOSED INTERMEDIATE CONTOUR
 - PROPOSED SPOT ELEVATION
 - PROPOSED SWALE FLOWLINE

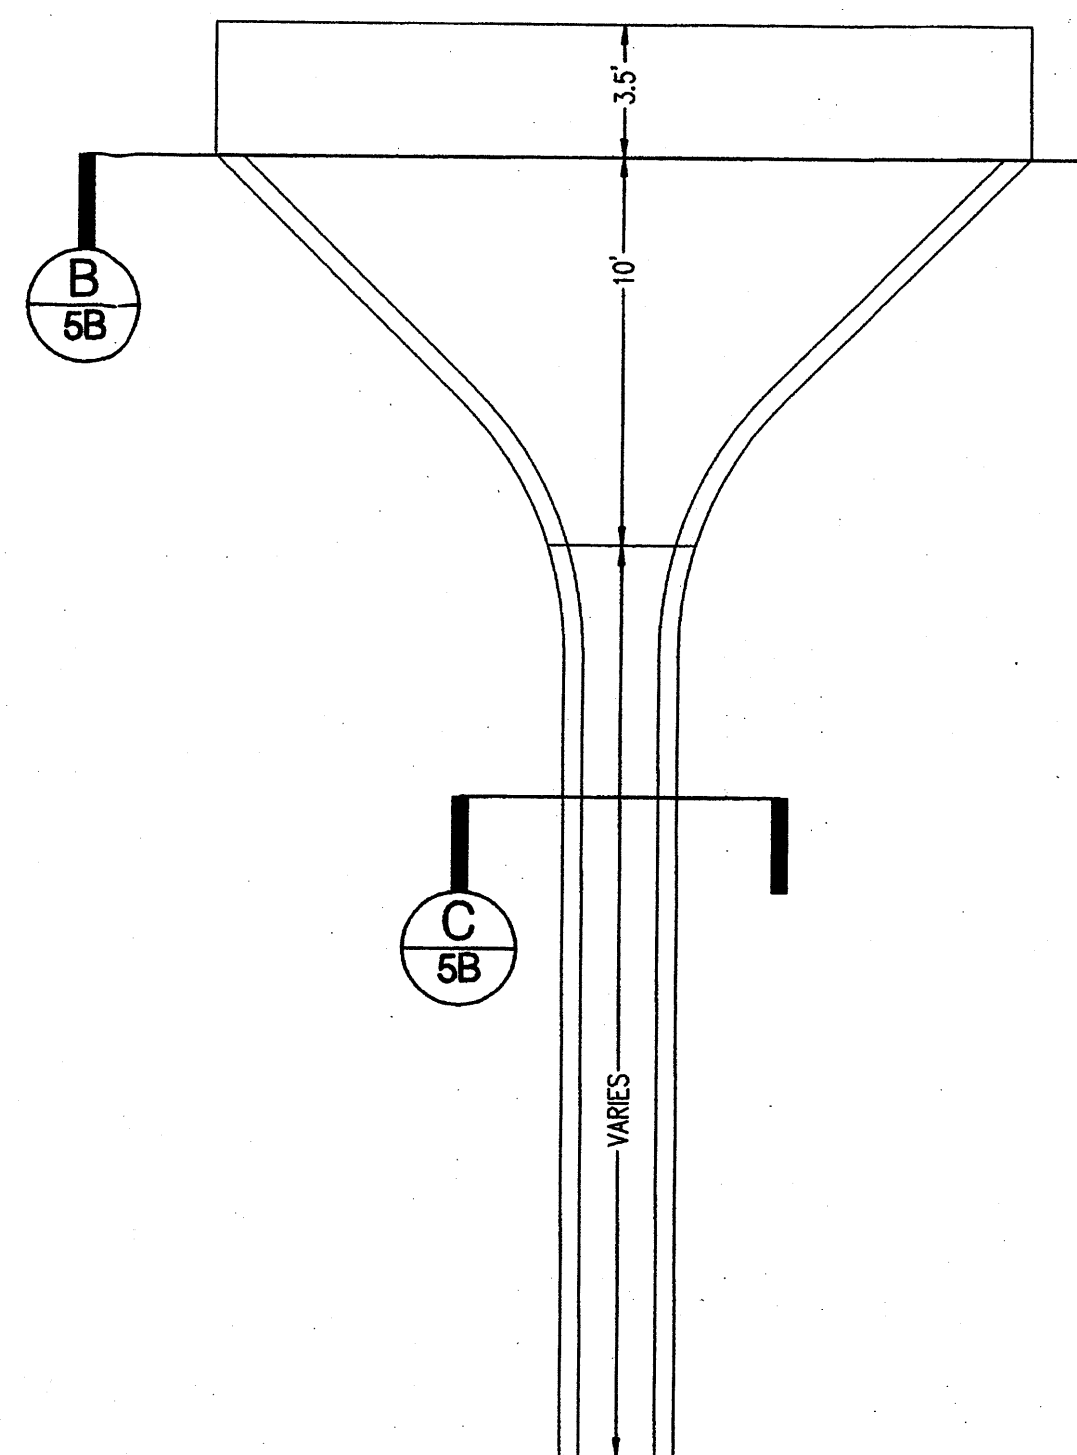


B 5B PLAN VIEW OF CONCRETE WIER AND RUNDOWN
N.T.S.

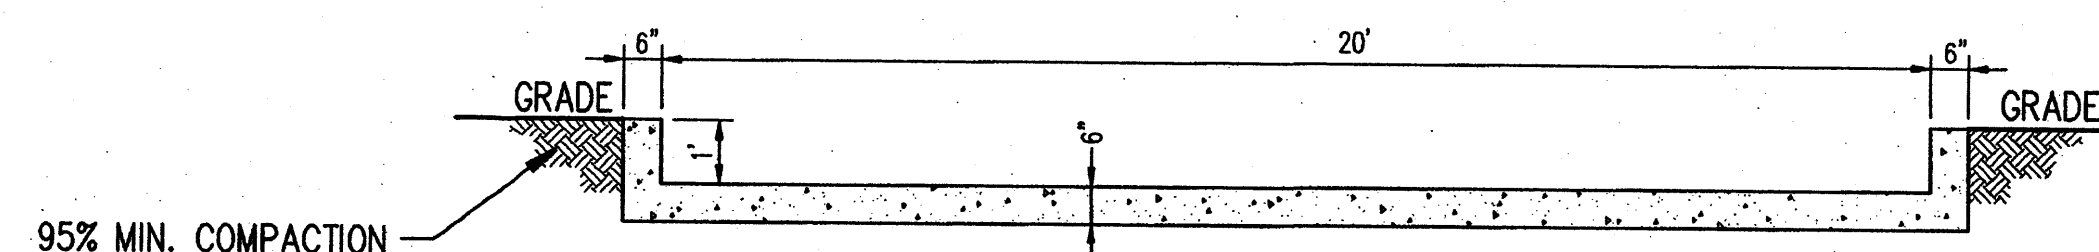

B 5B CONCRETE RUNDOWN WEIR SECTION
N.T.S.

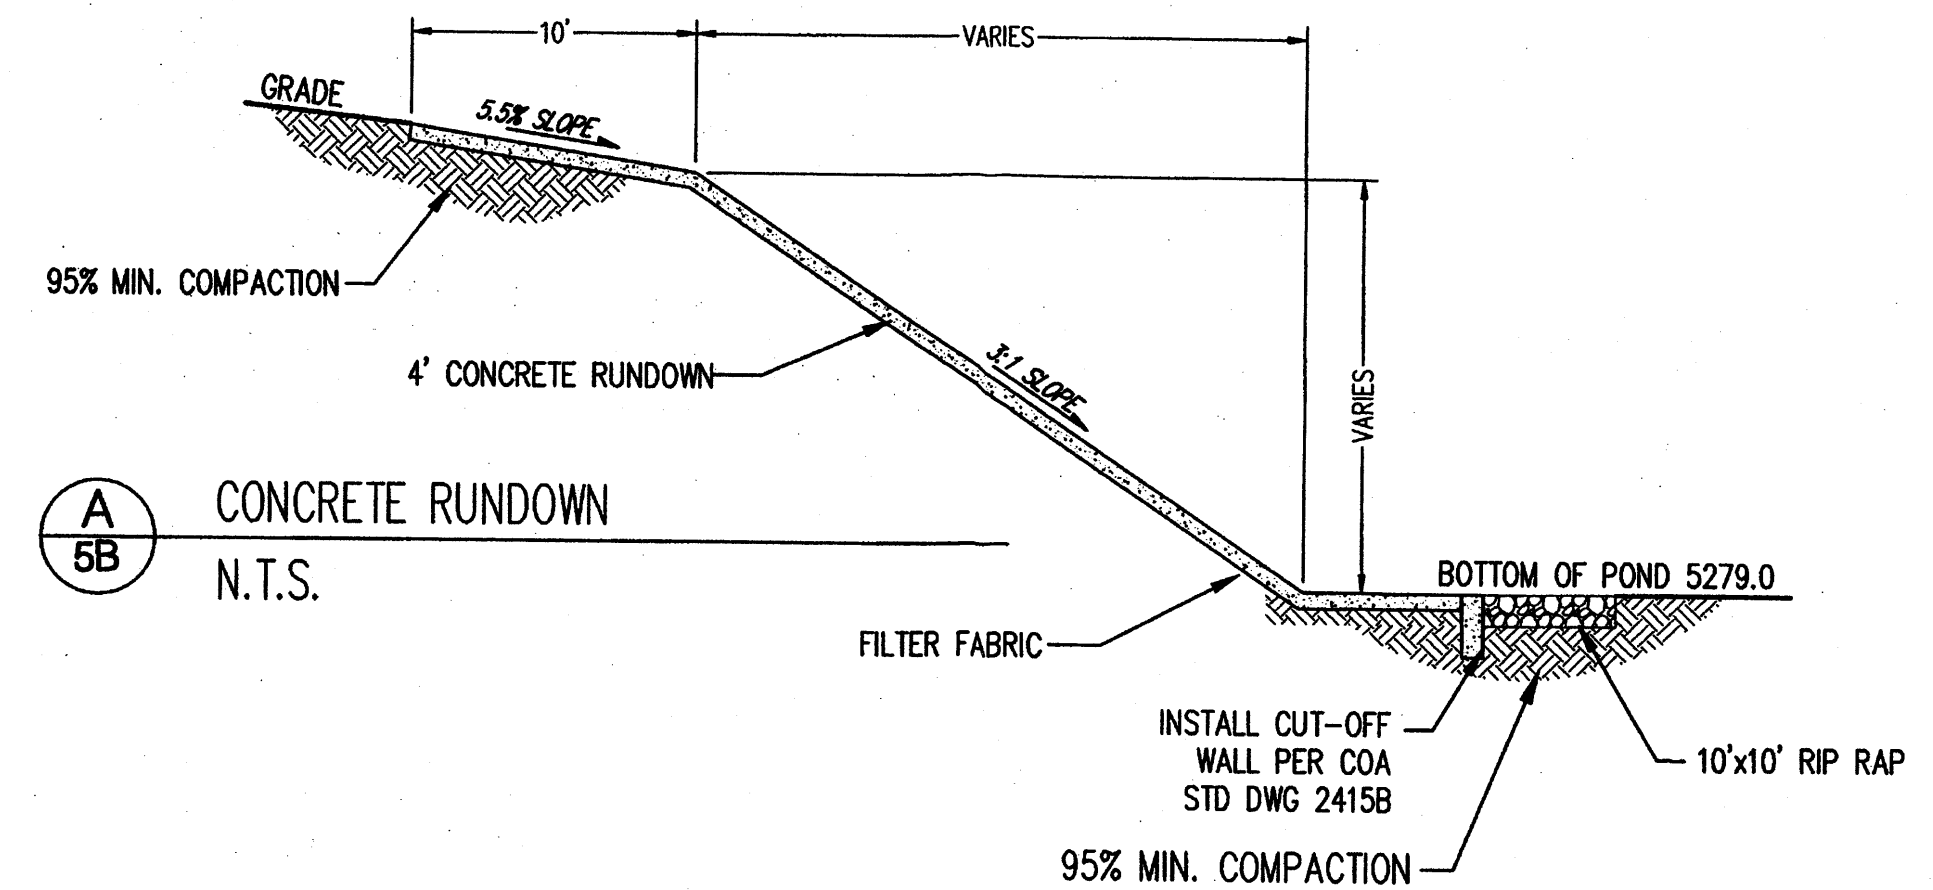


A 5B CONCRETE RUNDOWN
N.T.S.

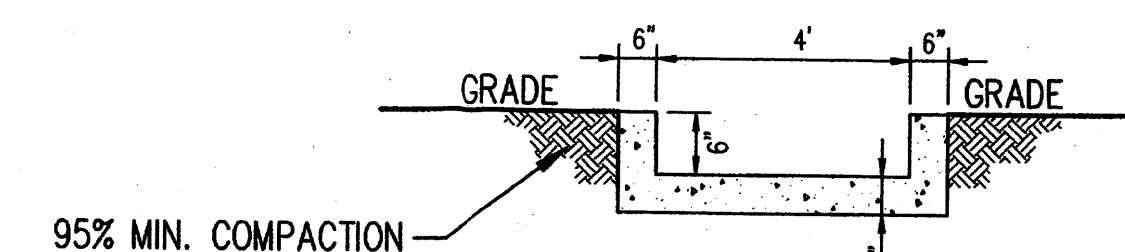

C 5B CONCRETE RUNDOWN TYPICAL SECTION
N.T.S.

Bohannon & Huston Courtyard I 7000 Jefferson St. NE Albuquerque, NM 87109-4395 ENGINEERING • SPATIAL DATA • ADVANCED TECHNOLOGIES		CITY OF ALBUQUERQUE DEPARTMENT OF MUNICIPAL DEVELOPMENT MESA DEL SOL ELEVATED RESERVOIR CONCEPTUAL OFFSITE GRADING & DRAINAGE PLAN	
DESIGN REVIEW COMMITTEE	CITY ENGINEER APPROVAL	NO. / DAY / YR.	NO. / DAY / YR.
CITY PROJECT NO.		ZONE MAP NO.	SHEET
R-16-Z		5B	5


AS-BUILT INFORMATION		BENCH MARKS		SURVEY INFORMATION		ENGINEER'S SEAL		REVISIONS		DESIGNED BY		DRAWN BY		CHECKED BY	
CONTRACTOR	DATE	ACCS 3-1/4" ALUMINUM CAP REVEALED TO A TUBE SET IN A CONCRETE BASE IN THE GROUND STAMPED "5-Q-14, 1987"	DATE	NO.	BY	DATE	DATE	NO.	DATE	NO.	DATE	NO.	DATE	NO.	DATE
		FROM THE RIO BRAVO BLVD. AND BROADWAY INTERSECTION GO SOUTH 0.9 MILES AND PROCEED 123' WEST OF THE CENTERLINE. STATE PLANE COORDINATES (CENTRAL ZONE, NAD83/NAVD88) N=1460471.432, E=1521386.180 (GROUND) ELEV=4981.17													

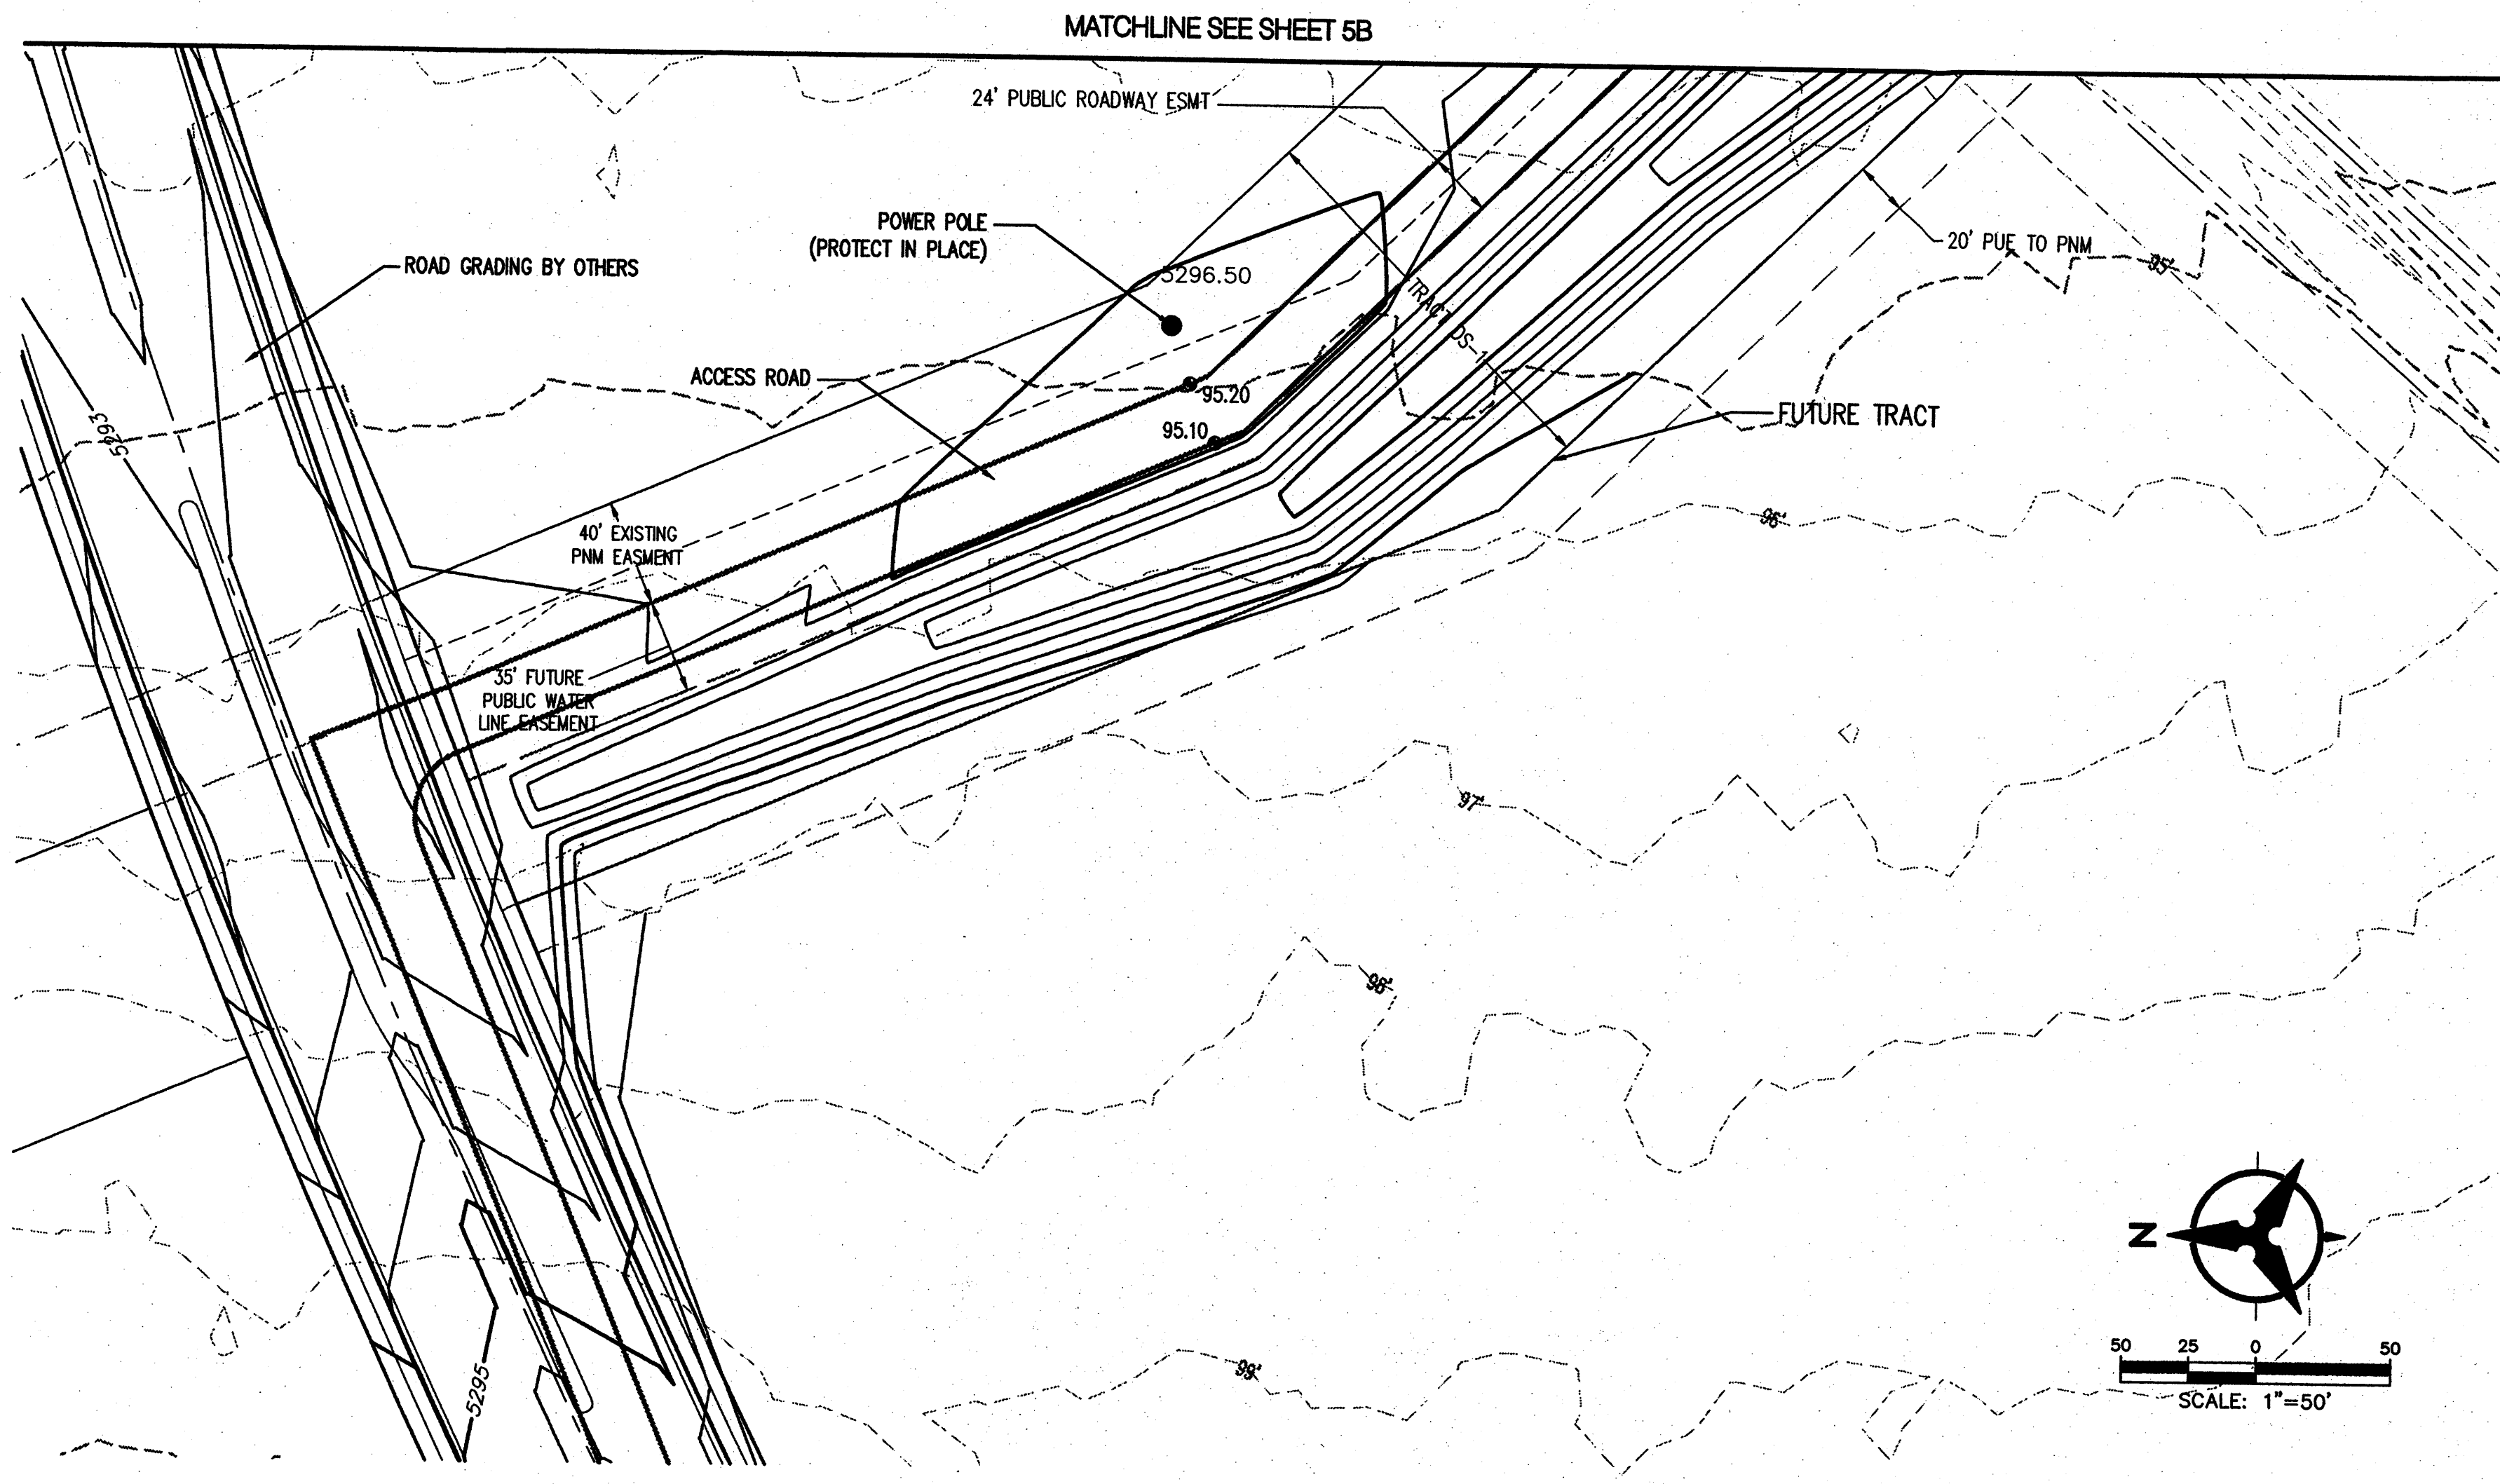

LEGEND	
—	PROPERTY LINE
---5289---	EXISTING CONTOUR
---90---	PROPOSED INDEX CONTOUR
---91---	PROPOSED INTERMEDIATE CONTOUR
● 92.50	PROPOSED SPOT ELEVATION
—>—	PROPOSED SWALE FLOWLINE

Bohannon & Huston Court yard 1 7800 Jefferson St. NE Albuquerque, NM 87109-4898 ENGINEERING • SPATIAL DATA • ADVANCED TECHNOLOGIES	
CITY OF ALBUQUERQUE DEPARTMENT OF MUNICIPAL DEVELOPMENT	
MESA DEL SOL ELEVATED RESERVOIR CONCEPTUAL OFFSITE GRADING & DRAINAGE PLAN	
DESIGN REVIEW COMMITTEE	CITY ENGINEER APPROVAL
LAST DESIGN UPDATE	
MO./DAY/YR. MO./DAY/YR.	
CITY PROJECT NO. ZONE MAP NO. R-16-Z SHEET 5C 5	

ENGINEER'S SEAL		SURVEY INFORMATION		BENCH MARKS		AS-BUILT INFORMATION	
		FIELD NOTES		ACS 3-1/4" ALUMINUM CAP REVEIT TO A TUBE SET IN A CONCRETE BASE IN THE GROUND STAMPED "S-Q-14, 1987" FROM THE RIO BRAVO BLVD. AND BROADWAY INTERSECTION GO SOUTH 0.9 MILES AND PROCEED 123' WEST OF THE CENTERLINE. STATE PLANE COORDINATES (CENTRAL ZONE, NAD83/NAVD83) N=1460471.432, E=1521388.180 (GROUND) ELEV.=4981.17		CONTRACTOR	
BY		DATE		WORKED BY		DATE	
REMARKS		DATE		ACCEPTED BY		DATE	
REVISIONS		DATE		FIELD CHECKED BY		DATE	
DESIGN		DATE		CORRECTED BY		DATE	
DESIGNED BY		DATE		MICRO-FILM INFORMATION		RECORDED BY	
DRAWN BY		DATE		NO.		DATE	
CHECKED BY		DATE		NO.		DATE	

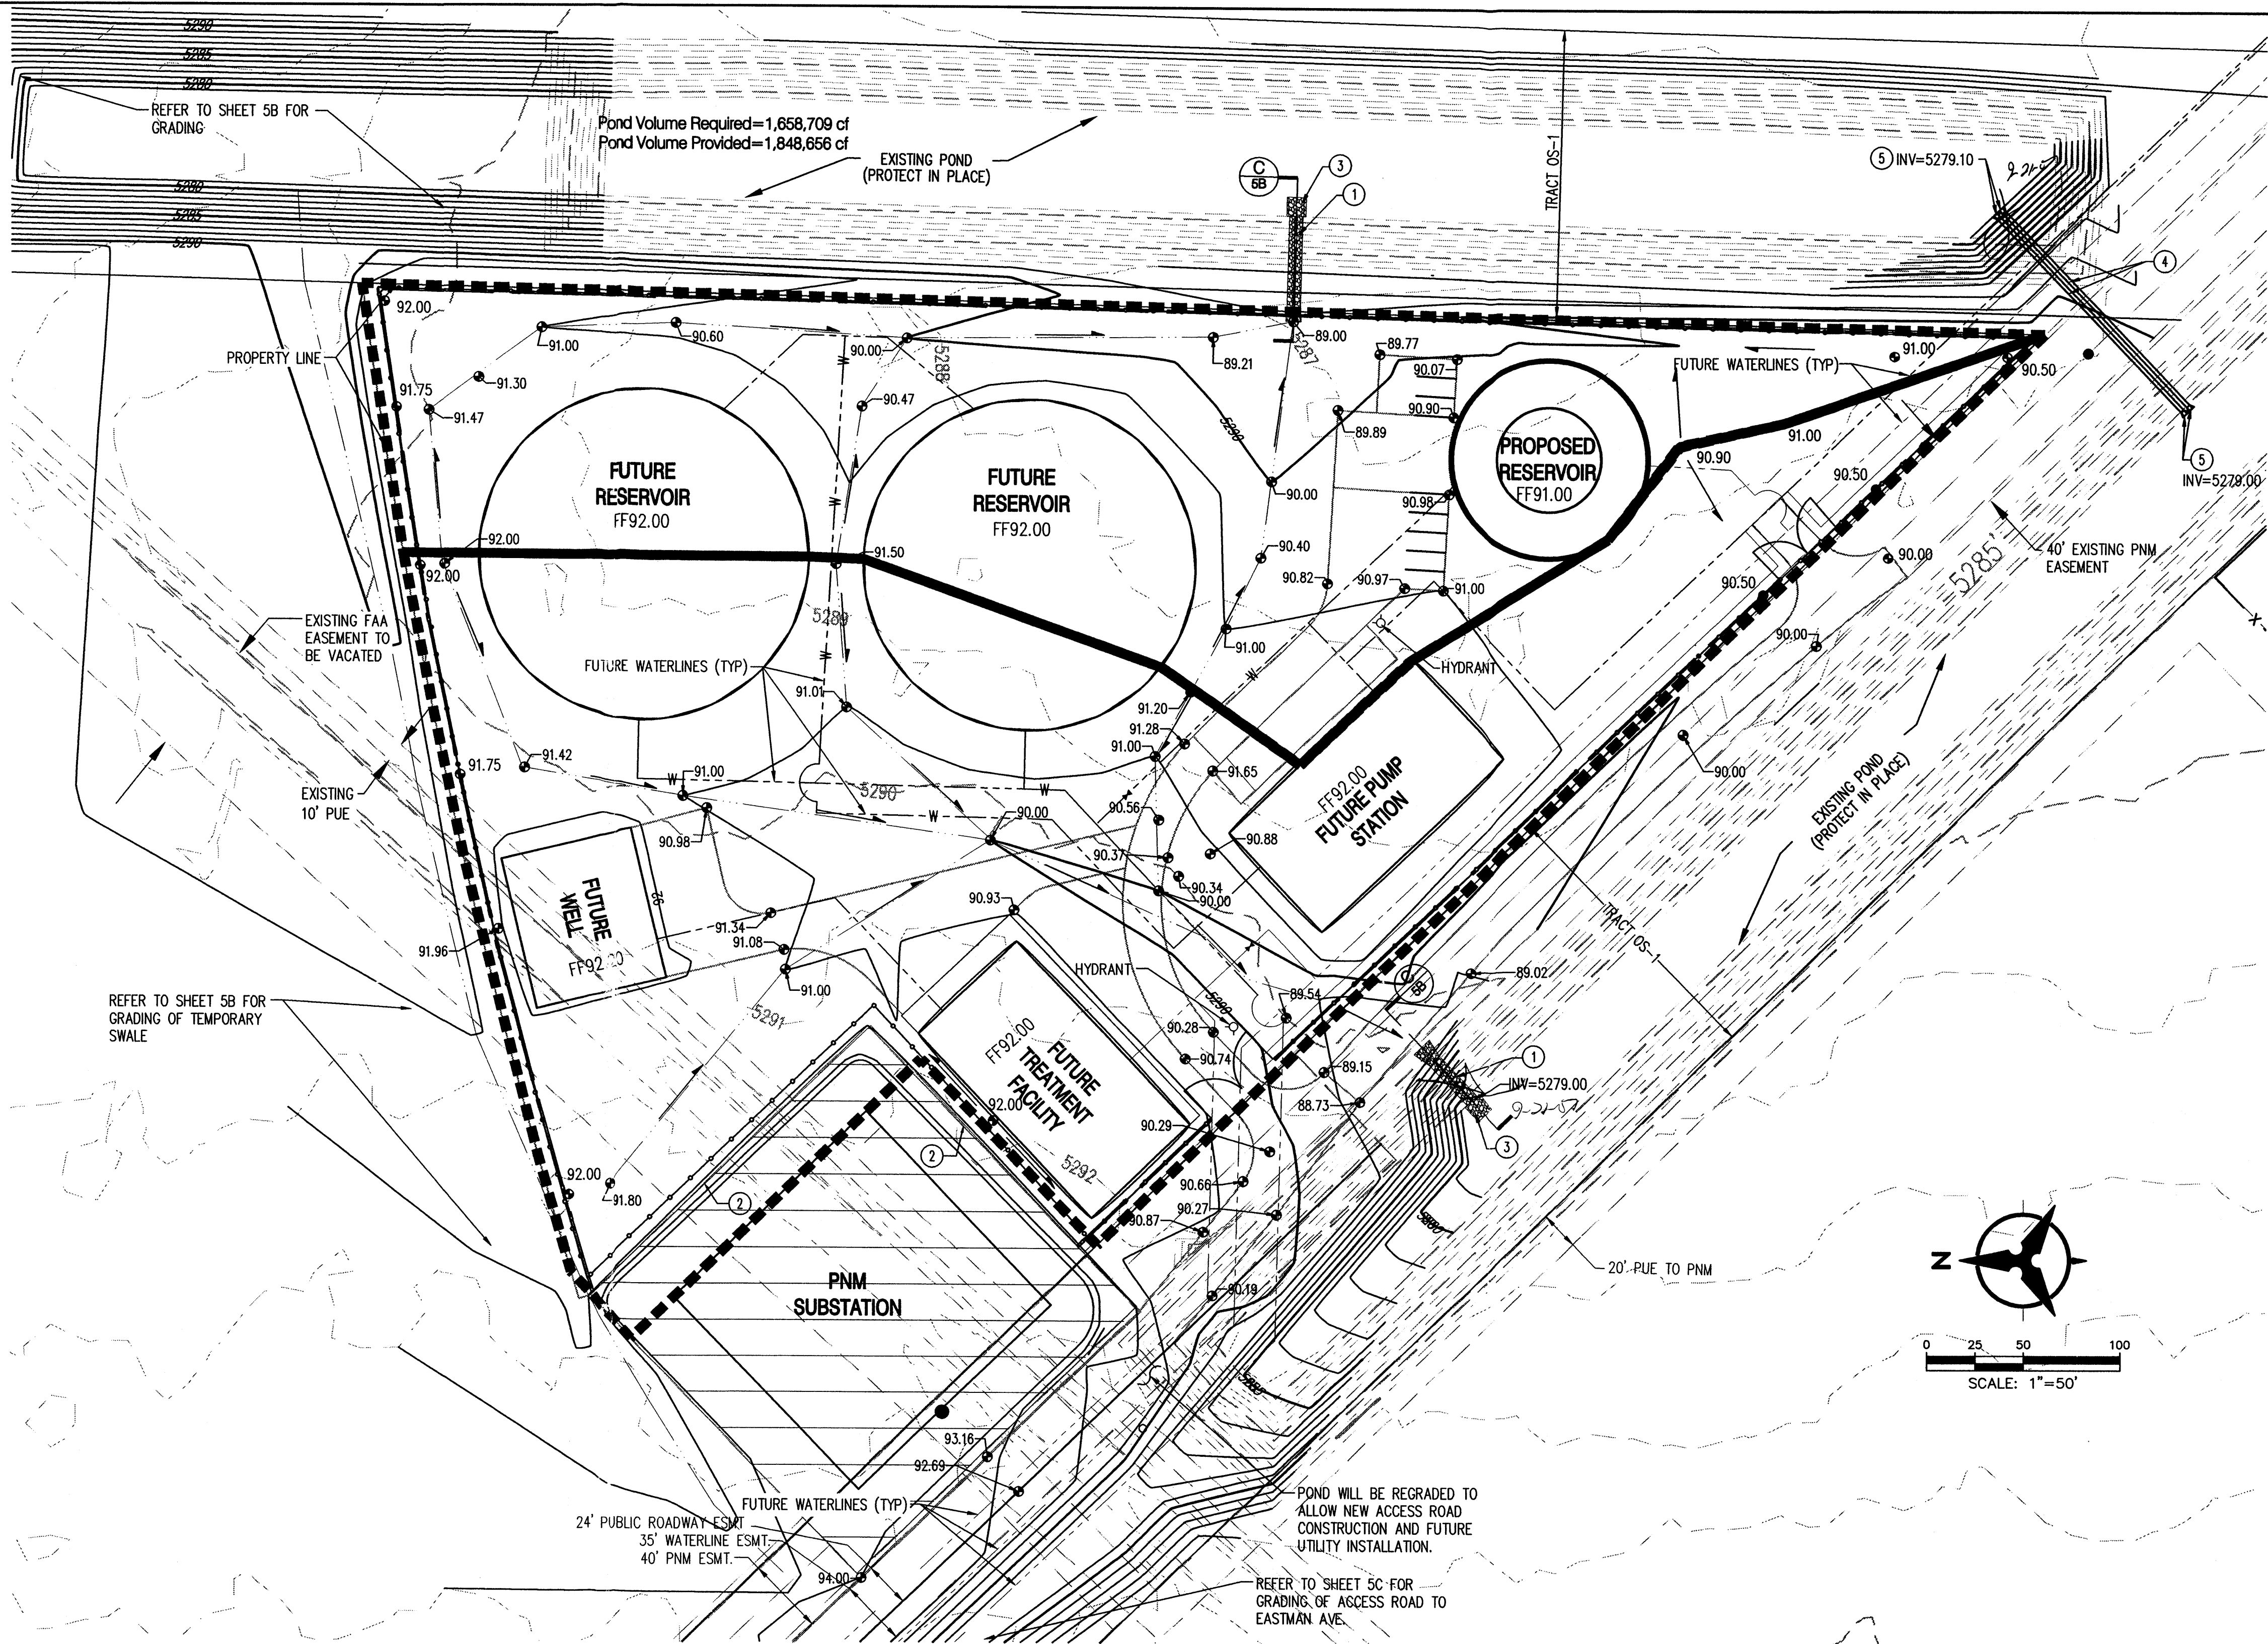


GENERAL NOTES

- CONTRACTOR MUST OBTAIN A TOPSOIL DISTURBANCE PERMIT FROM THE ENVIRONMENTAL HEALTH DIVISION PRIOR TO CONSTRUCTION.
- THE CONTRACTOR IS TO REFER TO EARTHWORK SPECIFICATION AS NOTED IN THE SOILS REPORT BY GEO-TEST, INC. DATED 1/07 (JOB NO. 1-61202).
- THE CONTRACTOR SHALL CONFORM TO ALL CITY, COUNTY, STATE, AND FEDERAL DUST CONTROL MEASURES & REQUIREMENTS AND WILL BE RESPONSIBLE FOR PREPARING AND OBTAINING ALL NECESSARY APPLICATIONS AND APPROVALS.
- THE CONTRACTOR SHALL ENSURE THAT NO SOIL ERODES FROM THE LOTS INTO PUBLIC RIGHT-OF-WAY. THIS CAN BE ACHIEVED BY CONSTRUCTING TEMPORARY BERMS AND WETTING THE SOIL TO KEEP IT FROM BLOWING.
- BOULDERS GREATER THAN 3 FEET IN DIAMETER EXCAVATED DURING GRADING ACTIVITIES SHALL BE STOCKPILED AND DISPOSED OF AT THE DISCRETION OF THE OWNER.
- ALL WALLS SHOWN ARE TO BE PLACED ALONG PROPERTY LINE.

TABLE 1 ELEVATED RESERVOIR - DEVELOPED HYDRAULIC CALCULATIONS												
Basin Data Table												
This table is based on the DPM Section 22.2, Zone 2												
SUB-BASIN	Area	Land Treatment Percentages					Q(100)	WT E	V(100) _{base}	V(100) _{today}	V(100) _{today}	
ID	(SQ. FT)	(AC.)	A	B	C	D	(cfs/ac.)	(cfs)	(inches)	(CF)	(CF)	(Acre-FT)
Basin 3A (Open Space/Regional Retention Ponds)	531834	12.21	0.0%	50.0%	50.0%	0.0%	3.33	40.60	1.27	56286	56286	1.29
Basin 3B*	337488	7.75	50.0%	50.0%	0.0%	0.0%	1.92	14.87	0.66	18420	18420	0.42
Basin 3C1 (PNM Substation)	39640	0.91	0.0%	10.0%	0.0%	90.0%	4.46	4.06	1.99	6560	11317	0.26
Basin 3C2 (Elevated Reservoir)	271814	6.24	0.0%	10.0%	0.0%	90.0%	4.46	27.82	1.99	44985	77603	1.78
Basin 3E (University Blvd and Hawking Dr)	735836	16.89	0.0%	10.0%	0.0%	90.0%	4.46	75.31	1.99	121781	210081	4.82
Basin 3H*	689417	15.83	50.0%	50.0%	0.0%	0.0%	1.92	30.39	0.66	37631	37631	0.86
Basin 3I*	1111881	25.53	50.0%	50.0%	0.0%	0.0%	1.92	49.01	0.66	60690	60690	1.39
Basin 3J (Albuquerque Studios)	1231689	28.28	0.0%	10.0%	0.0%	90.0%	4.46	126.05	1.99	203844	351647	8.07
Total/	4080278.80	93.67								475491.81	823675.14	18.91
* UNDEVELOPED CONDITIONS AT THIS TIME												

LEGEND

- 91.62 PROPOSED SPOT ELEVATIONS
- 92.46 EXISTING SPOT ELEVATIONS
- 5470 EXISTING CONTOUR W/ INDEI ELEVATION
- FLOW ARROW
- W PROPOSED TANK WATER LINE
- DRAINAGE BASIN BOUNDARIES
- PROPOSED WALL
- PROPOSED SLOPE

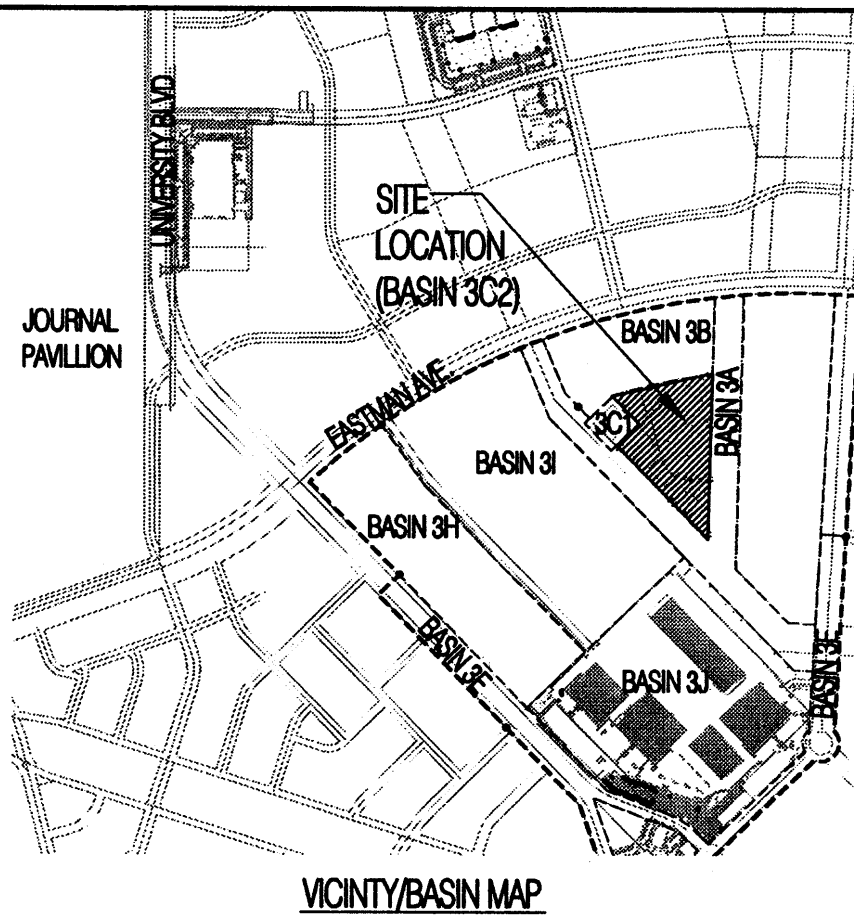

Existing Conditions

The elevated reservoir site ("The Site") is located on approximately 6.24 acre lot, which currently is undeveloped and slopes 0.5% to 1.0% from the west to east. It is located in between the two Regional Retention Ponds ("Ponds") constructed with the Albuquerque Studios Site (COA Hydro File #R16/D002A).

In addition, a PNM substation has been constructed to the northwest of The Site. The majority of this site is self contained and will not adversely affect the elevated reservoir site (See COA Hydro File #R16/D002B).

Once The Site is completed, it will be bound on three sides. The Ponds to the east and southwest and a future developed parcel to the north.

Offsite Drainage

Current drainage from the undeveloped land to the west of the site drains into the existing pond constructed with the Albuquerque Studios site via storm drain and surface flow. A temporary swale west of the access road will direct flows to the existing pond. All drainage to the east of these adjacent tracts continues to outfall to the existing plays system to the east and will not affect the site. Drainage from the north will be diverted east into the existing ponds via a temporary swale. Upon development of the future parcels, drainage will be conveyed to the existing ponds in a manner suitable to each specific site plan, and each site will be subject to future submittal and approval.

Proposed Site Grading

The slope of the site under proposed conditions will be between 0.5% to 1.0%. A portion of the site will drain to the eastern pond while the remainder of the site will drain to the southwestern pond (See drainage basin boundaries).

All drainage will be diverted into a rip-rap runoff to prevent erosion. The ponds have previously been constructed to account for developed flows from this site with the Albuquerque Studios submittal. Currently there are only a few basins contributing to the existing Ponds. Under current conditions for these basins (including the developed flows from The Site), the maximum water surface elevation (MWSEL) is approximately 5284.60.

(Note: the ponds were sized to accept the 100 year, 10 day storm generated by the fully developed drainage area in accordance with the methodology outlined in the DPM section 22.2. Developed land treatments for Mesa del Sol sites are assumed to be 90% treatment D and 10% treatment B. Currently the top of the ponds extend to 5289.00).

A portion of the existing western pond constructed with the Albuquerque Studios site will be filled in order to allow room for an access road and future utilities to serve both the Elevated Reservoir site and the Mesa del Sol development. The pond to the east will be extended to the north to account for this volume. (Total pond volume provided after pond adjustments = 42.4 acre-ft. Total volume required for current contributing basins to the existing ponds = 18.9 acre-ft - see Table 1).

Floodplain

In accordance with FEMA Community Map Panel #35001C0555E, the site is not located within a floodplain.

Conclusion

This drainage submittal has been prepared in accordance with City of Albuquerque requirements. This plan demonstrates the proposed grading and drainage design. The implementation of this design would result in the safe passage and retention of the 100 yr, 10 day storm event. With this submittal we request COA Hydrology Department approval for DRB Site Plan approval, foundation permit approval and rough grading approval.

KEYED NOTES

- INSTALL RIP RAP WEIR AND RUNDOWN PER DETAIL A & B, SHEET 5B. TRANSITION FROM WEIR SECTION TO RUNDOWN SECTION OVER 10'.
- INSTALL TURN BLOCKS FOR DRAINAGE EVERY 20 FT.O.C.
- INSTALL 10"x10" RIP RAP BLANKET.
- INSTALL 2'-36" RCP STORM DRAIN PIPES.
- INSTALL 36" RCP END SECTION.

ROUGH GRADING (±0.5')

APPROVED FOR ROUGH GRADING DATE

Bohannon & Huston

Courtyard I 7000 Jefferson St. NE Albuquerque, NM 87108-4305

ENGINEERING • SPATIAL DATA • ADVANCED TECHNOLOGIES



CITY OF ALBUQUERQUE
DEPARTMENT OF
MUNICIPAL DEVELOPMENT

JUL 25 2007

ELEVATED WATER RESERVOIR
SITE GRADING, DRAINAGE, AND UTILITY PLAN

DESIGN REVIEW COMMITTEE

CITY ENGINEER APPROVAL

MO./DAY/YR. MO./DAY/YR.

CITY PROJECT NO.

ZONE MAP NO.


SHEET OF

DRB

R-16-Z

5A 5


BHI JOB NO. 070204

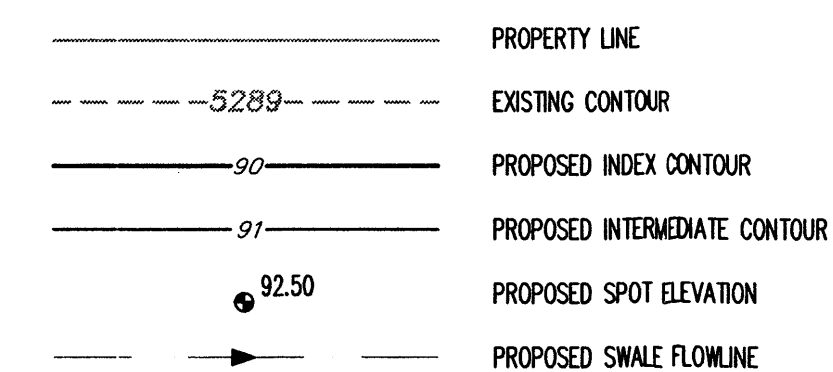

P:\070204\cdp\general\070204gp01.dwg
Mon, 23-Jul-2007 - 5:09:pm, Plotted by: MBALASKOVITS

BHI JOB NO. 070204

<div style="text-align: center;"> </div>						ENGINEER'S SEAL		SURVEY INFORMATION		BENCH MARKS		AS-BUILT INFORMATION	
							NO.	BY	DATE	TUBE SET IN A CONCRETE BASE IN THE	CONTRACTOR	DATE	
										GROUND STAMPED "5-Q-14, 1987".	WORK STAKED BY	DATE	
							NO. DATE	REMARKS	BY	FROM THE RIO BRAVO BLVD. AND BROADWAY	ACCEPTANCE BY	DATE	
								REVIEWS		INTERSECTION GO SOUTH 0.9 MILES AND	DRAWINGS	DATE	
								DESIGN		PROCEED 123' WEST OF THE CENTERLINE.	CORRECTED BY	DATE	
							DESIGNED BY			STATE PLANE COORDINATES (CENTRAL ZONE,	MICRO-FILM	INFORMATION	
							DRAWN BY	DATE		NAD83 (NAVD86) N=1460471.43Z.	RECORDED BY	DATE	
							CHECKED BY	DATE		E=1521388.180 (GROUND) ELEV.=+4981.17	No.	DATE	

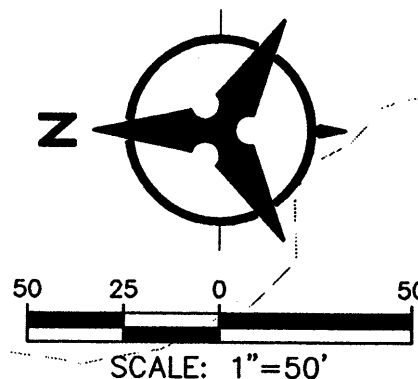

PROPERTY LINE

EXISTING CONTOUR -52.89

PROPOSED INDEX CONTOUR 90



PROPOSED INTERMEDIATE CONTOUR 91

PROPOSED SPOT ELEVATION 92.50

PROPOSED SWALE FLOWLINE

P: \070204\cdp\general\070204gp02.dwg
Tue, 24-Jul-2007 - 8:42:am, Plotted by: MBALASKOVITS

BHI JOB NO. 070204

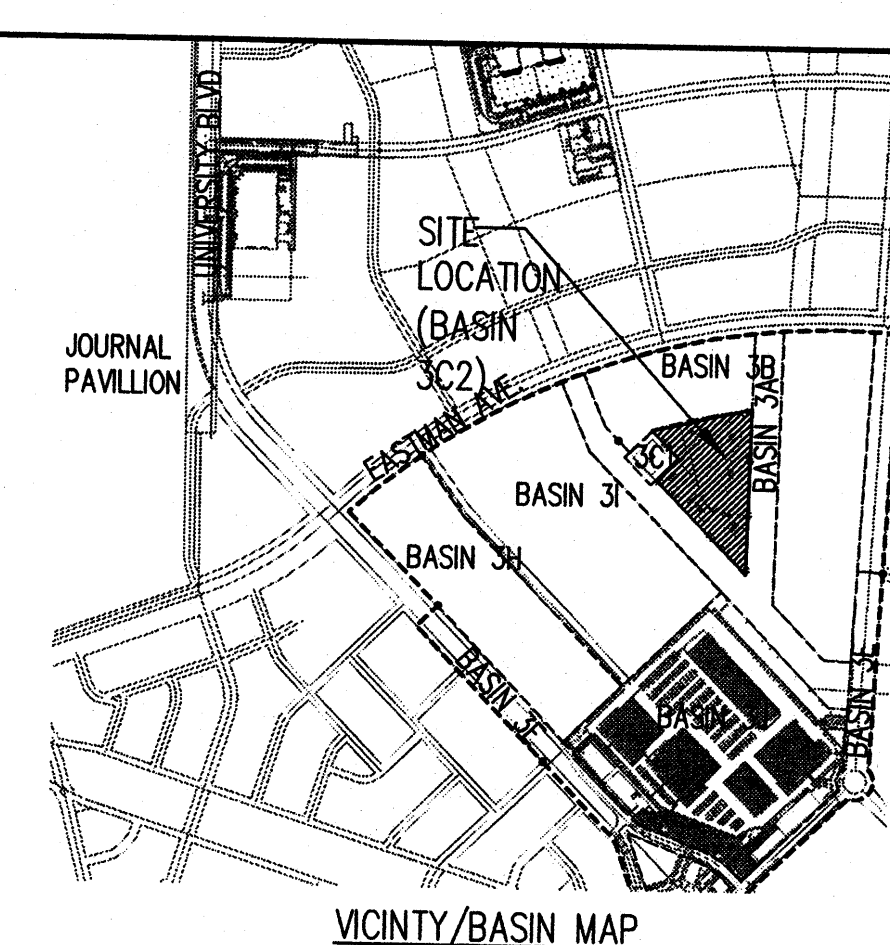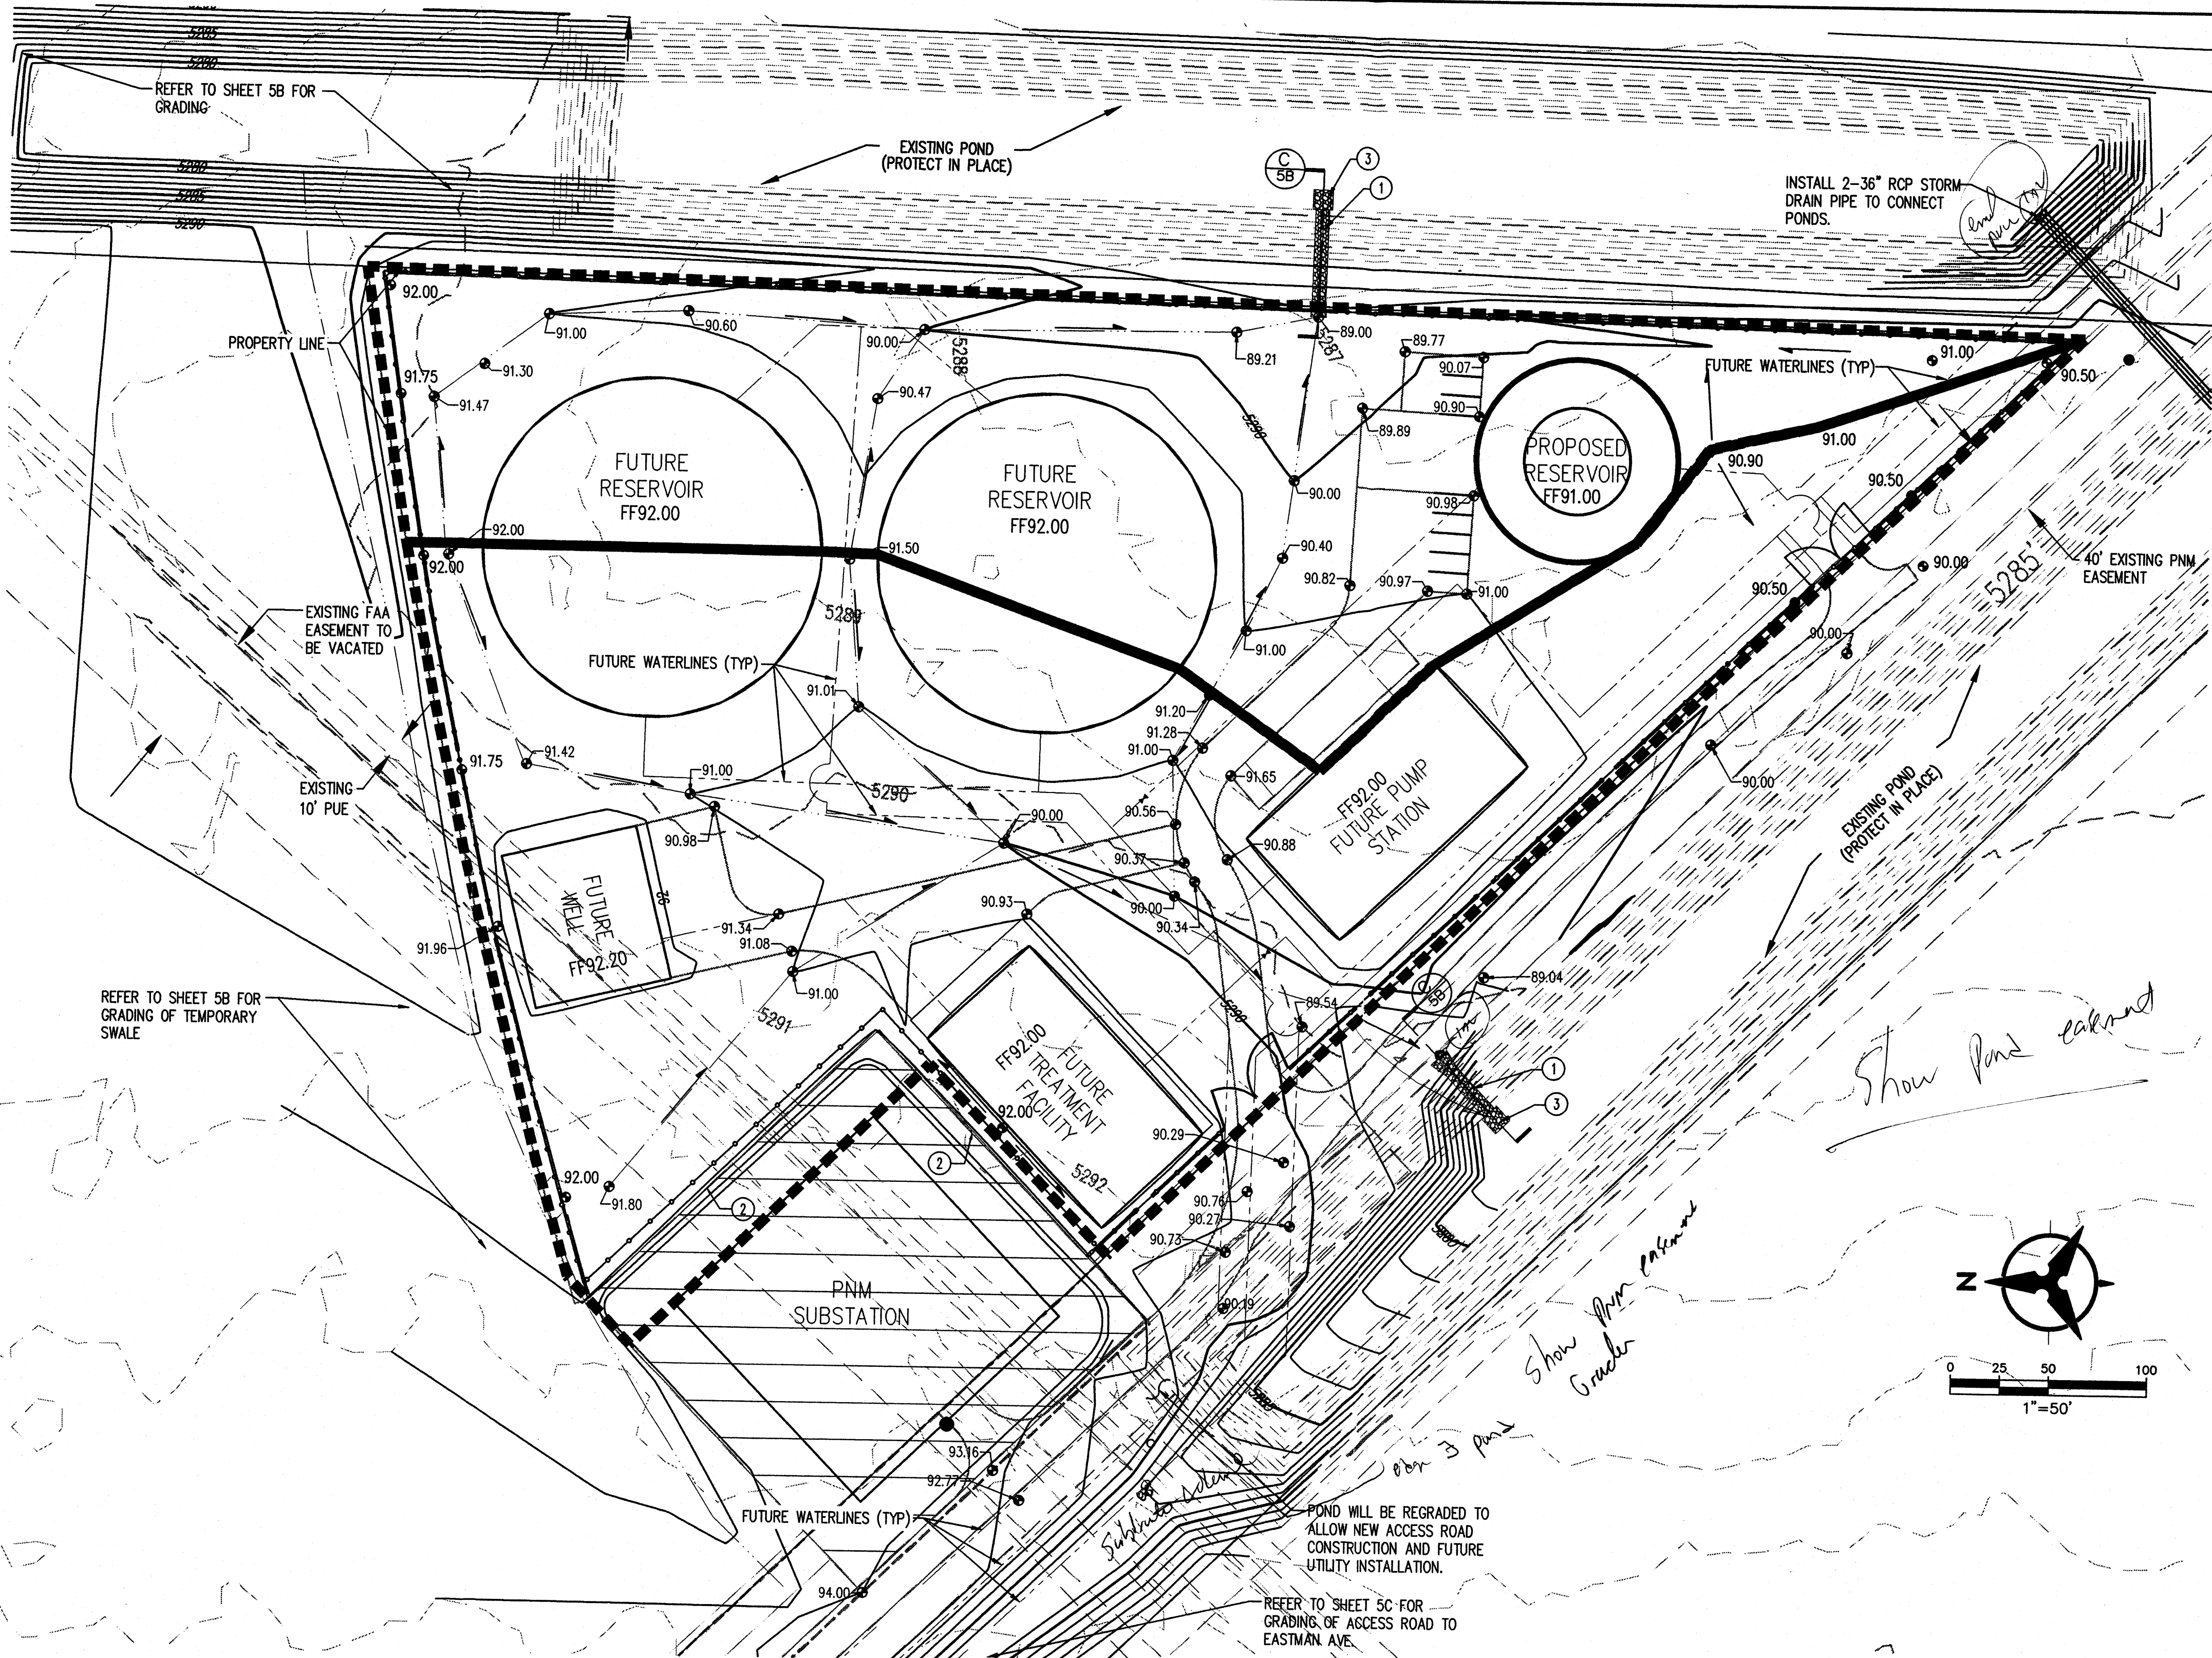

Existing Conditions
The elevated reservoir site ("The Site") is located on approximately 6.24 acre lot, which currently is undeveloped and slopes 0.5% to 1.0% from the west to east. It is located in between the two Regional Retention Ponds ("Ponds") constructed with the Albuquerque Studios Site (COA Hydro File #R16/0002A).

In addition, a PNM substation has been constructed to the northwest of The Site. The majority of this site is self contained and will not adversely affect the elevated reservoir site (See COA Hydro File #R16/0002B).

Once The Site is completed, it will be bound on three sides. The Ponds to the east and southwest and a future developed parcel to the north.

Offsite Drainage
Current drainage from the undeveloped land to the west of the site drains into the existing pond constructed with the Albuquerque Studios site via storm drain and surface flow. A temporary swale west of the access road will direct flows to the existing pond. All drainage to the east of these adjacent tracts continues to outfall to the existing plays system to the east and will not affect the site. Drainage from the north will be diverted east into the existing ponds via a temporary swale. Upon development of the future parcels, drainage will be conveyed to the existing ponds in a manner suitable to each specific site plan, and each site will be subject to future submittal and approval.

Proposed Site Grading
The slope of the site under proposed conditions will be between 0.5% to 1.0%. A portion of the site will drain to the eastern pond while the remainder of the site will drain to the southwestern pond (See drainage basin boundaries).

All drainage will be diverted into a rip-rap random to prevent erosion. The ponds have previously been constructed to account for developed flows from this site with the Albuquerque Studios submittal. Currently there are only a few basins contributing to the existing Ponds. Under current conditions for these basins (including the developed flows from The Site), the maximum water surface elevation (MWSEL) is approximately 5284.60.

(Note: the ponds were sized to accept the 100 year, 10 day storm generated by the fully developed drainage area in accordance with the methodology outlined in the DPM section 22.2. Developed land treatments for Mesa del Sol sites are assumed to be 90% treatment D and 10% treatment B. Currently the top of the ponds extend to 5289.00).

A portion of the existing western pond constructed with the Albuquerque Studios site will be filled in order to allow room for an access road and future utilities to serve both the Elevated Reservoir site and the Mesa del Sol development. The pond to the east will be extended to the north to account for this volume. (Total pond volume provided after pond adjustments = 42.4 acre-ft. Total volume required for current contributing basins to the existing ponds = 18.9 acre-ft - see Table 1).

Floodplain
In accordance with FEMA Community Map Panel #35001C0555C, the site is not located within a floodplain.

Conclusion
This drainage submittal has been prepared in accordance with City of Albuquerque requirements. This plan demonstrates the proposed grading and drainage design. The implementation of this design would result in the safe passage and retention of the 100 yr, 10 day storm event. With this submittal we request COA Hydrology Department approval for DRB Site Plan approval, foundation permit approval and rough grading approval.

- KEYED NOTES**
- INSTALL RIP RAP WEIR AND RUNDOWN PER DETAIL A & B, SHEET 5B. TRANSITION FROM WEIR SECTION TO RUNDOWN SECTION OVER 10'.
 - INSTALL TURN BLOCKS FOR DRAINAGE EVERY 20 FT, O.C.
 - INSTALL 10"x10" RIP RAP BLANKET.

GENERAL NOTES

- CONTRACTOR MUST OBTAIN A TOPSOIL DISTURBANCE PERMIT FROM THE ENVIRONMENTAL HEALTH DIVISION PRIOR TO CONSTRUCTION.
- THE CONTRACTOR IS TO REFER TO EARTHWORK SPECIFICATION AS NOTED IN THE SOILS REPORT BY GEO-TEST, INC. DATED 1/07 (JOB NO. 1-61202).
- THE CONTRACTOR SHALL CONFORM TO ALL CITY, COUNTY, STATE, AND FEDERAL DUST CONTROL MEASURES & REQUIREMENTS AND WILL BE RESPONSIBLE FOR PREPARING AND OBTAINING ALL NECESSARY APPLICATIONS AND APPROVALS.
- THE CONTRACTOR SHALL ENSURE THAT NO SOIL ERODES FROM THE LOTS INTO PUBLIC RIGHT-OF-WAY. THIS CAN BE ACHIEVED BY CONSTRUCTING TEMPORARY BERMS AND WETTING THE SOIL TO KEEP IT FROM BLOWING.
- BOULDERS GREATER THAN 3 FEET IN DIAMETER EXCAVATED DURING GRADING ACTIVITIES SHALL BE STOCKPILED AND DISPOSED OF AT THE DISCRETION OF THE OWNER.
- ALL WALLS SHOWN ARE TO BE PLACED ALONG PROPERTY LINE.

This table is based on the DPM Section 22.2, Zone II											
Basin Data Table											
SUB-BASIN ID	Area (SQ. FT)	Area (AC.)	Land Treatment Percentages				Q(100) (cfs)	Q(100) (cfs)	WTE (Inches)	V(100) (CF)	V(100) (CF)
			A	B	C	D					
Basin 3A (Open Space/Regional Retention Ponds)	531834	12.21	0.0%	50.0%	50.0%	0.0%	3.33	40.80	1.27	56286	56286
Basin 3B	337468	7.75	50.0%	50.0%	0.0%	0.0%	1.92	14.87	0.88	18420	18420
Basin 3C1 (PNM Substation)	39640	0.91	0.0%	10.0%	0.0%	90.0%	4.46	4.06	1.99	6580	11317
Basin 3C2 (Elevated Reservoir)	271814	6.24	0.0%	10.0%	0.0%	90.0%	4.46	27.82	1.99	44985	77903
Basin 3E (Unimproved Blvd. and (Hawthorn Dr))	735536	16.89	0.0%	10.0%	0.0%	90.0%	4.46	75.31	1.99	121781	210081
Basin 3H	689417	15.83	50.0%	50.0%	0.0%	0.0%	1.92	30.39	0.88	37631	37631
Basin 3I	1111881	25.83	50.0%	50.0%	0.0%	0.0%	1.92	49.91	0.88	60690	60690
Basin 3J (Albuquerque Studios)	1231689	28.28	0.0%	10.0%	0.0%	90.0%	4.46	126.05	1.99	203844	361847
Total	4080276.80	92.87								476491.81	823878.14
* UNDEVELOPED CONDITIONS AT THIS TIME											

- LEGEND**
- 91.62 PROPOSED SPOT ELEVATIONS
 - 92.48 EXISTING SPOT ELEVATIONS
 - 5470 EXISTING CONTOUR W/ INDEX ELEVATION
 - FLOW ARROW
 - 16"W PROPOSED TANK WATER LINE
 - DRAINAGE BASIN BOUNDARIES
 - PROPOSED WALL
 - PROPOSED SLOPE


Bohannon & Huston
Engineering & Spatial Data & Advanced Technologies
1700 Jefferson St. NE Albuquerque, NM 87106-6366

CITY OF ALBUQUERQUE
DEPARTMENT OF MUNICIPAL DEVELOPMENT

MESA DEL SOL
ELEVATED WATER RESERVOIR
SITE GRADING AND DRAINAGE PLAN


DESIGN REVIEW COMMITTEE	CITY ENGINEER APPROVAL	MO./DAY/YR.	MO./DAY/YR.

CITY PROJECT NO. **R-16-Z** SHEET **5A** OF **5**

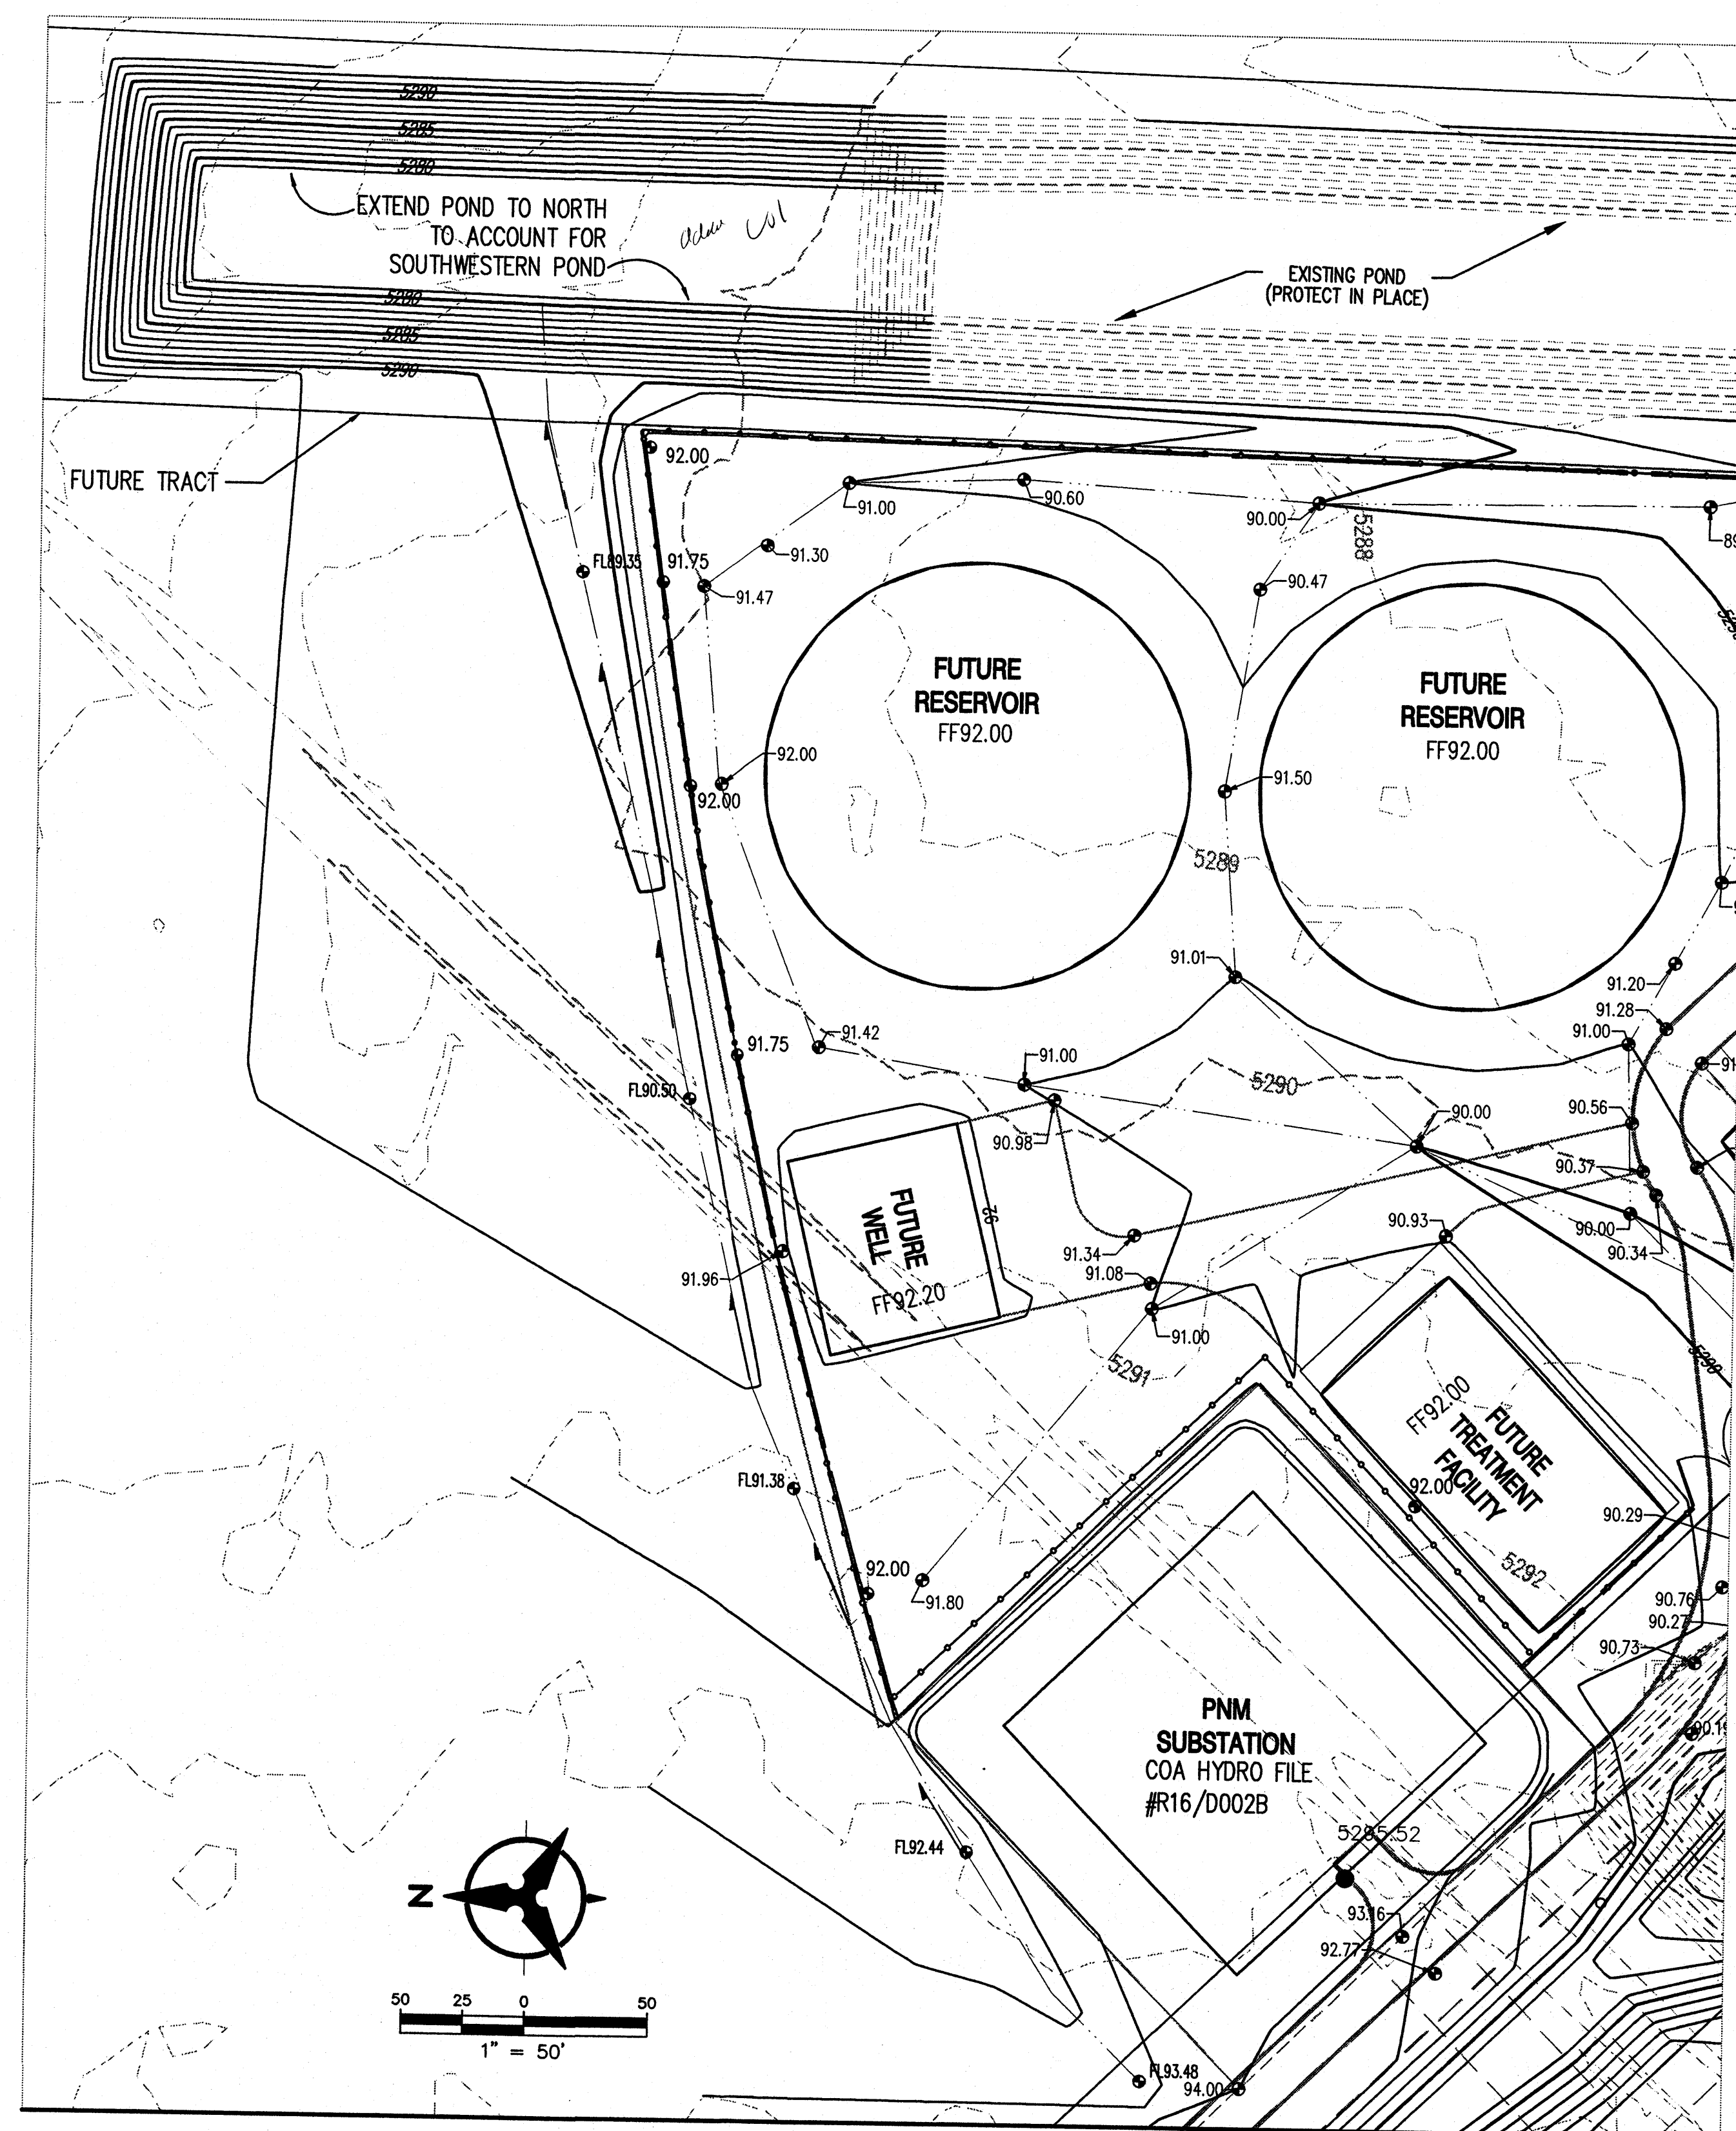

MATCHLINE SEE SHEET 5C

P: \070204\cdp\general\070204gp01.dwg
Fri, 6-Jul-2007 - 12:50:pm, Plotted by: MBALASKOVITS

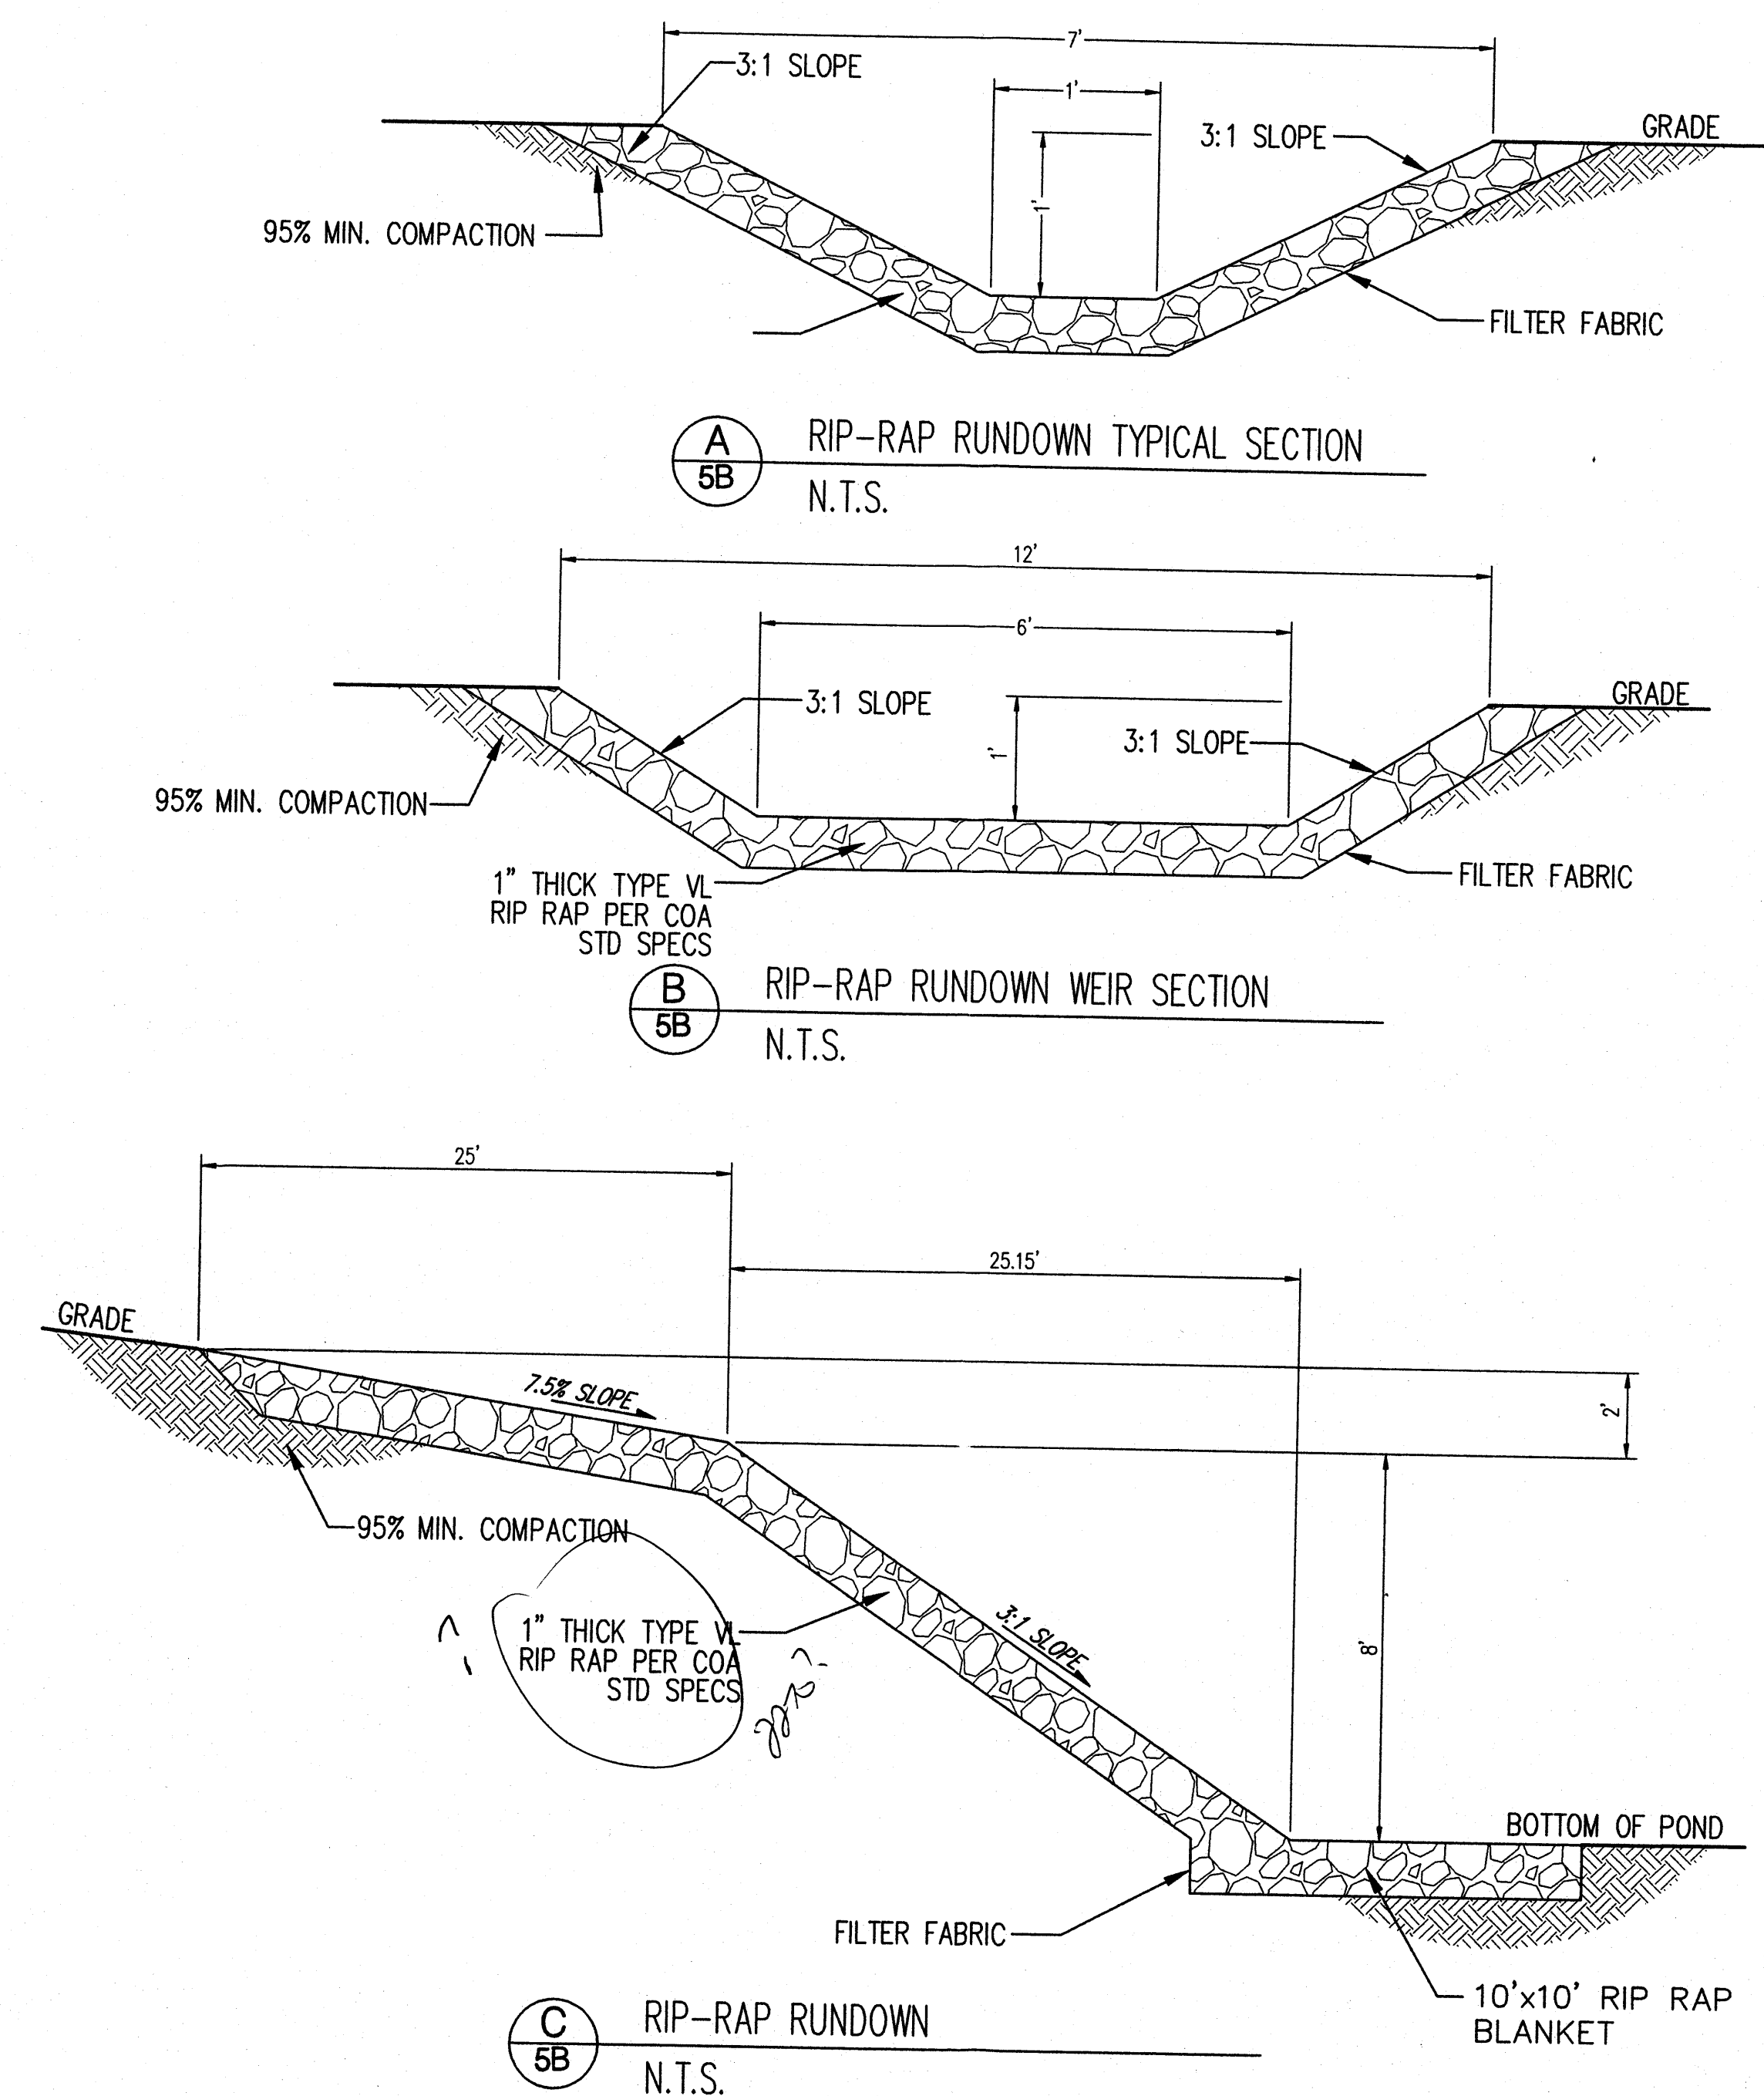

LEGEND

PROPERTY LINE

EXISTING CONTOUR
5289

PROPOSED INDEX CONTOUR
90

PROPOSED INTERMEDIATE CONTOUR
91

PROPOSED SPOT ELEVATION
92.50

PROPOSED SWALE FLOWLINE

BHI JOB NO. 070204

Bohannon ▲ Huston[®]

Courtyard | 7500 Jefferson St. NE Albuquerque, NM 87109-4335
ENGINEERING • SPATIAL DATA • ADVANCED TECHNOLOGIES



CITY OF ALBUQUERQUE
DEPARTMENT OF
MUNICIPAL DEVELOPMENT

MESA DEL SOL ELEVATED RESERVOIR
OFFSITE GRADING PLAN

DESIGN REVIEW COMMITTEE

CITY ENGINEER APPROVAL

MO./DAY/YR.	MO./DAY/YR.
-------------	-------------


CITY PROJECT NO.

4706 MAP NO

R-16-

SHEET	OF
-------	----

SHEET 5B OF 5

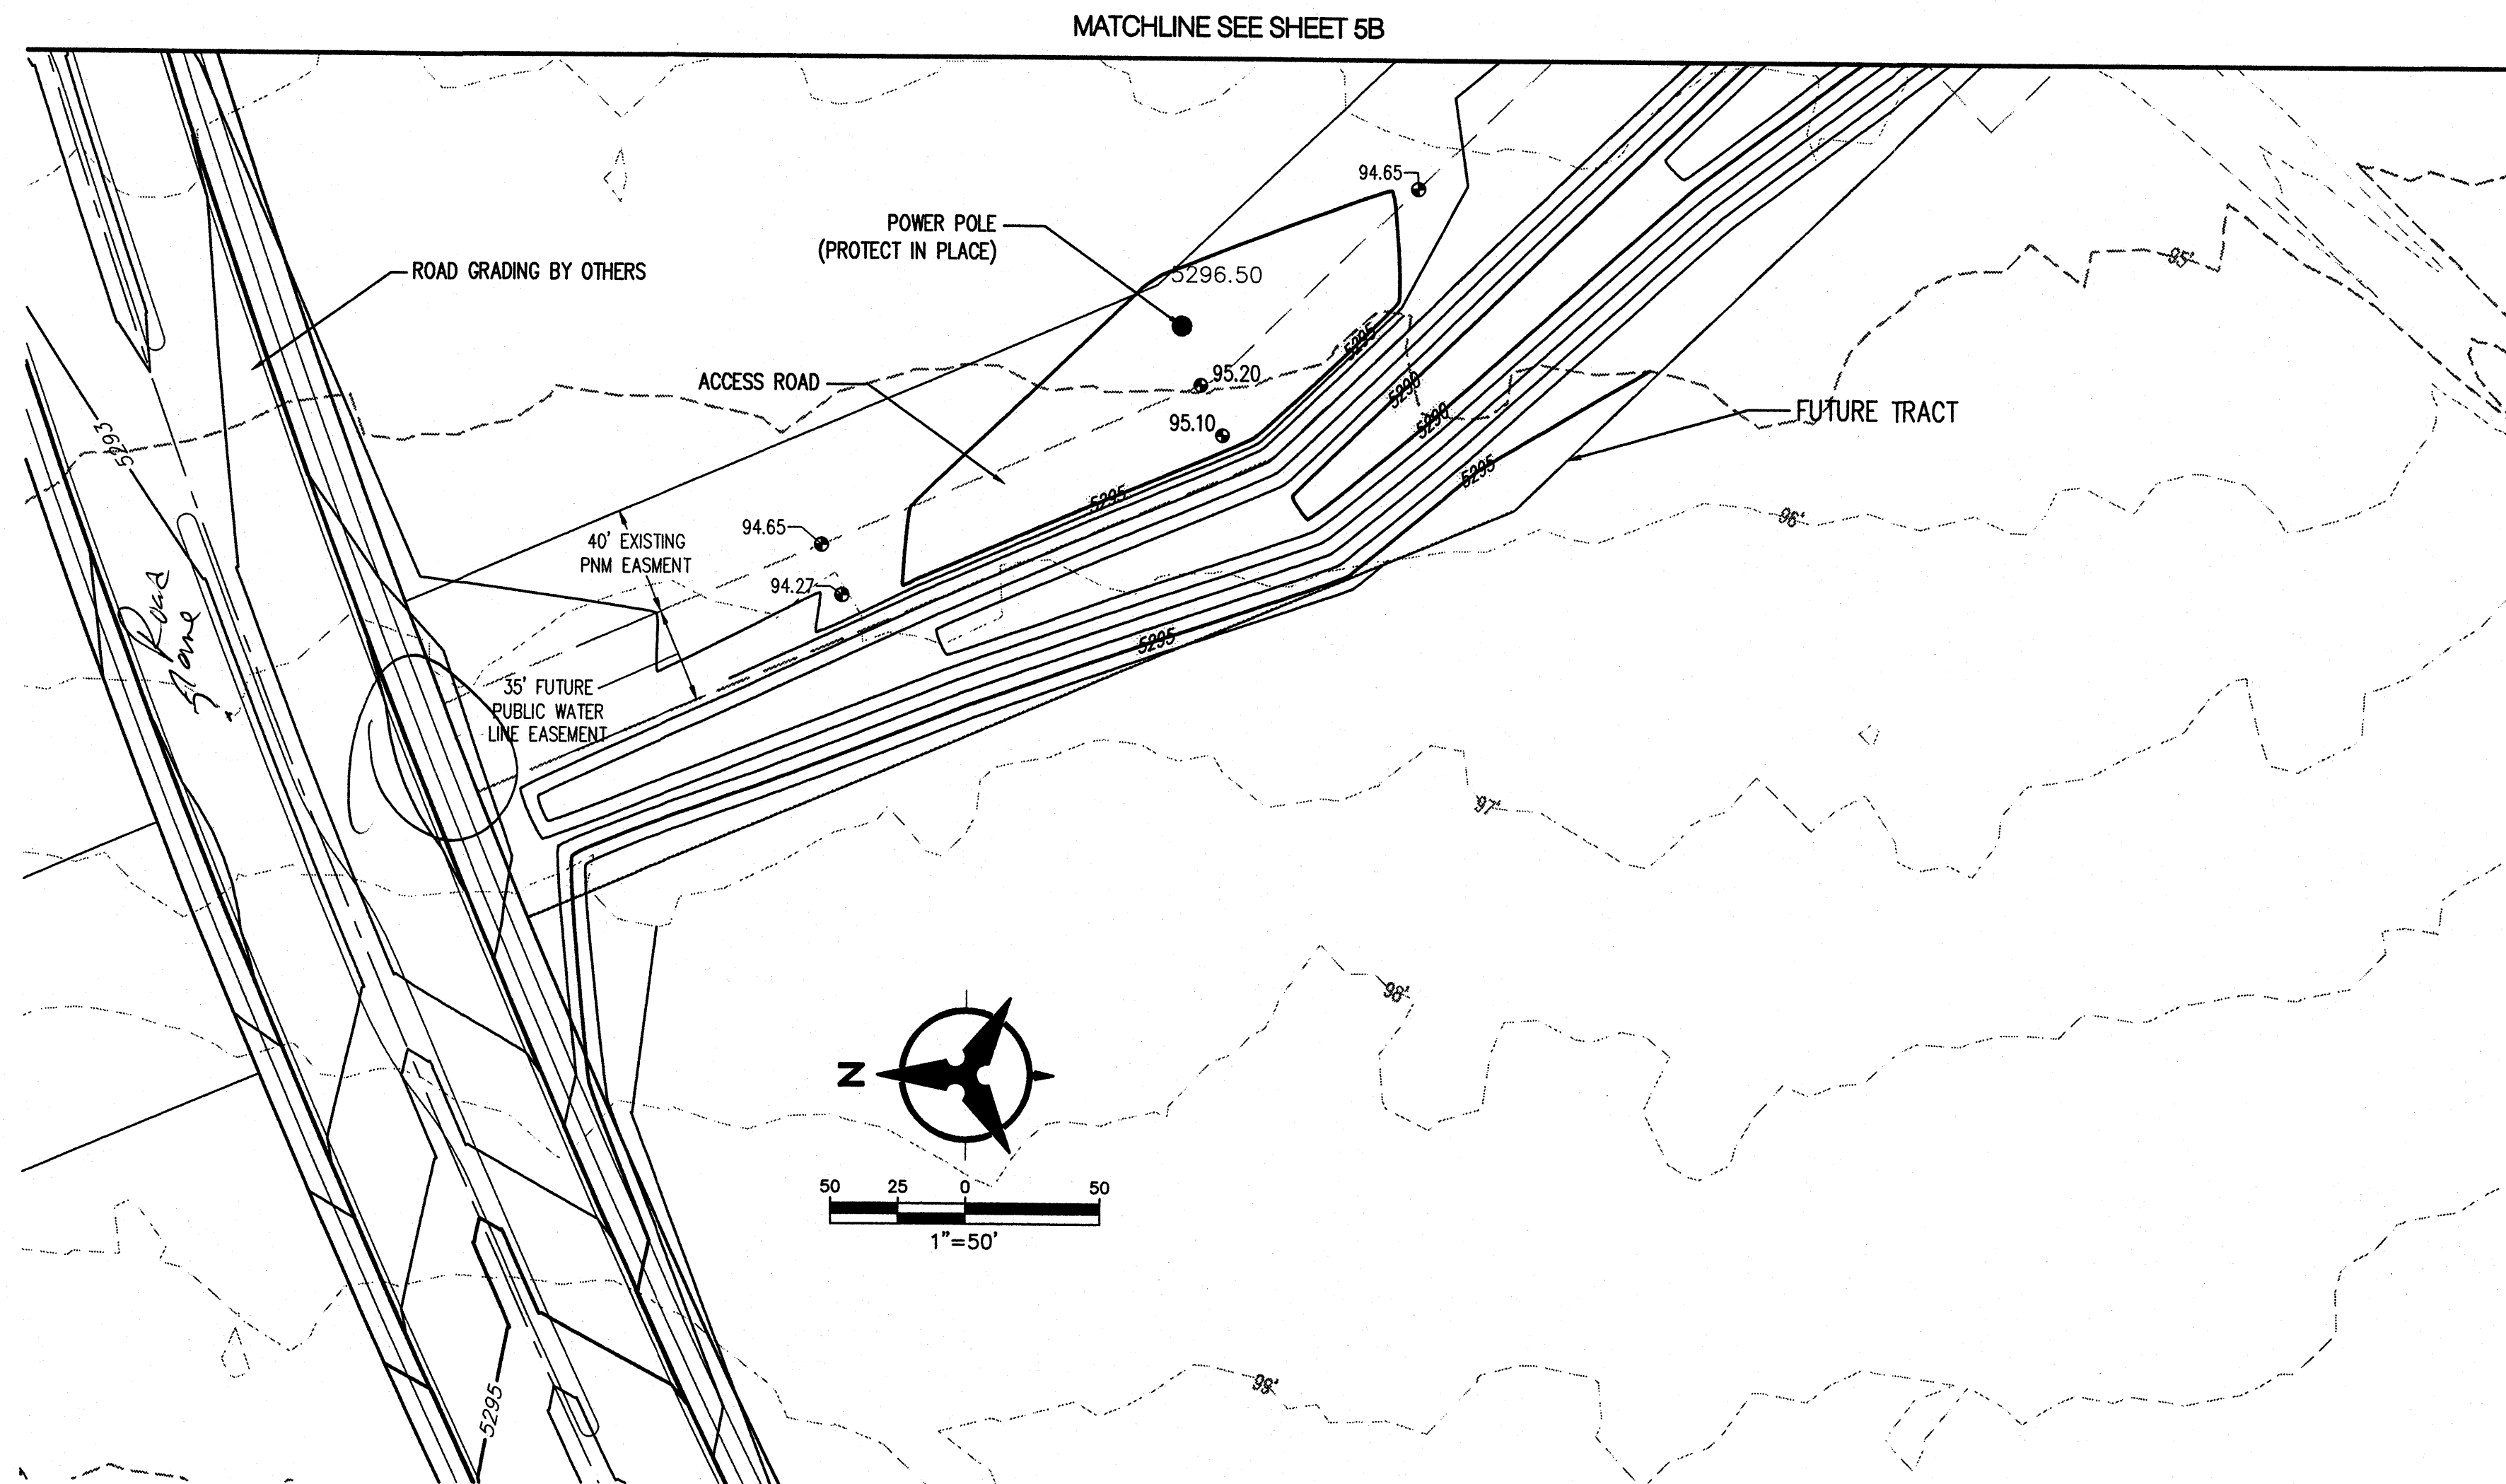

LEGEND

	PROPERTY LINE
	EXISTING CONTOUR
	PROPOSED INDEX CONTOUR
	PROPOSED INTERMEDIATE CONTOUR
	PROPOSED SPOT ELEVATION
	PROPOSED SEWAGE FLOWLINE

Bohannon & Huston
 Courtyard 1 7800 Jefferson St. NE Albuquerque, NM 87109-4395
 ENGINEERING • SPATIAL DATA • ADVANCED TECHNOLOGIES

CITY OF ALBUQUERQUE
 DEPARTMENT OF MUNICIPAL DEVELOPMENT
**MESA DEL SOL ELEVATED RESERVOIR
 OFFSITE GRADING PLAN**


DESIGN REVIEW COMMITTEE	CITY ENGINEER APPROVAL	MO./DAY/YR.	MO./DAY/YR.
CITY PROJECT NO.	ZONE MAP NO.	SHEET	OF
	R-16-Z	5C	5

JEFFREY L. MULBERRY
 16858
 PROFESSIONAL ENGINEER

REMARKS
 REVISIONS
 DESIGN

DESIGNED BY
 DRAWN BY
 CHECKED BY

DATE
 DATE
 DATE

ENGINEER'S SEAL		SURVEY INFORMATION		BENCH MARKS		AS-BUILT INFORMATION	
		FIELD NOTES		ACS 3-1/4" ALUMINUM CAP REVEALED TO A		CONTRACTOR	
		NO.	BY	DATE	TUBE SET IN A CONCRETE BASE IN THE	WORK	DATE
					GROUND STAMPED "S-Q-14, 1987",	SUBMITTED BY	DATE
					FROM THE RIO BRAVO BLVD. AND BROADWAY	FIELD VERIFICATION BY	DATE
					INTERSECTION GO SOUTH 0.9 MILES AND	DRAWINGS	DATE
				PROCEEDED 123' WEST OF THE CENTERLINE.		CORRECTED BY	
				STATE PLANE COORDINATES (CENTRAL ZONE,		MICRO-FILM INFORMATION	
				NAD83/NAVD83) N=1460471.432,		RECORDED BY	
				E=1521388.180 (GROUND) ELEV=4981.17		NO.	
						DATE	