
 


CITY OF
ALBUQUERQUE—NEW MEXICO
PLANS
FOR CONSTRUCTION
OF
SPECIAL ASSESSMENT DISTRICT NO. 166-C

AS BUILT


1	2	3	4	5	6	7	8	9	10	11	12	13	14	15	16	17	18	19	20	21	22	23	24	25	26	27
0	1	6	6	3	0	1	6	9											2	0						

08
09
07

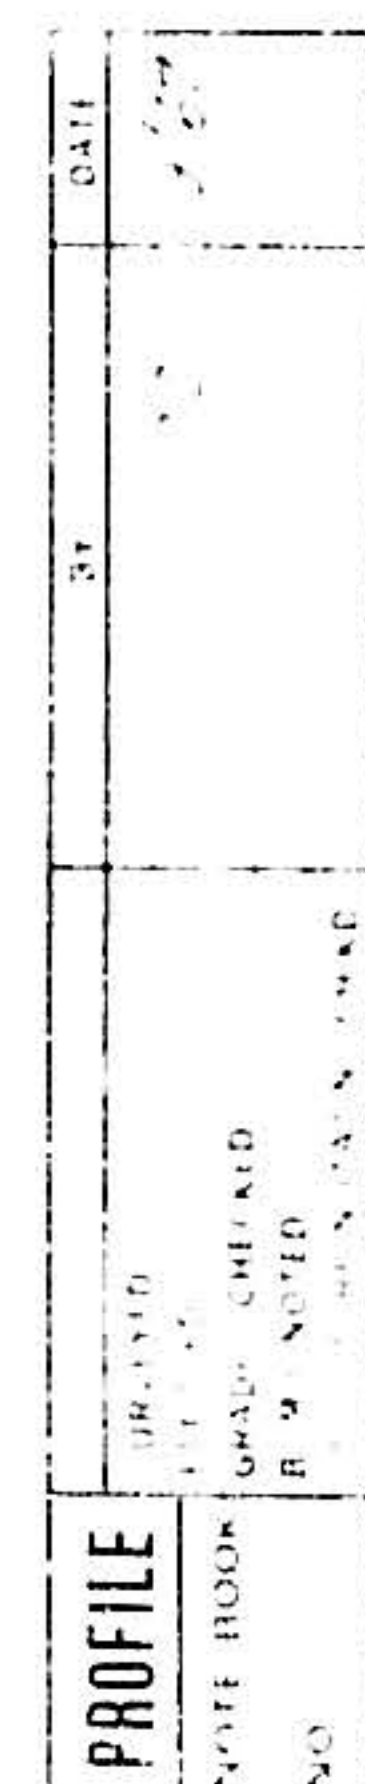




 





ALBUQUERQUE, NEW MEXICO			
LOCATION MAP			
GORDON HERRINGHOFF & ASSOCIATES, INC. CONSULTING ENGINEERS			
DATE	DRAWN	BY	NEW MEXICO
1964	10/20	10/20	10/20

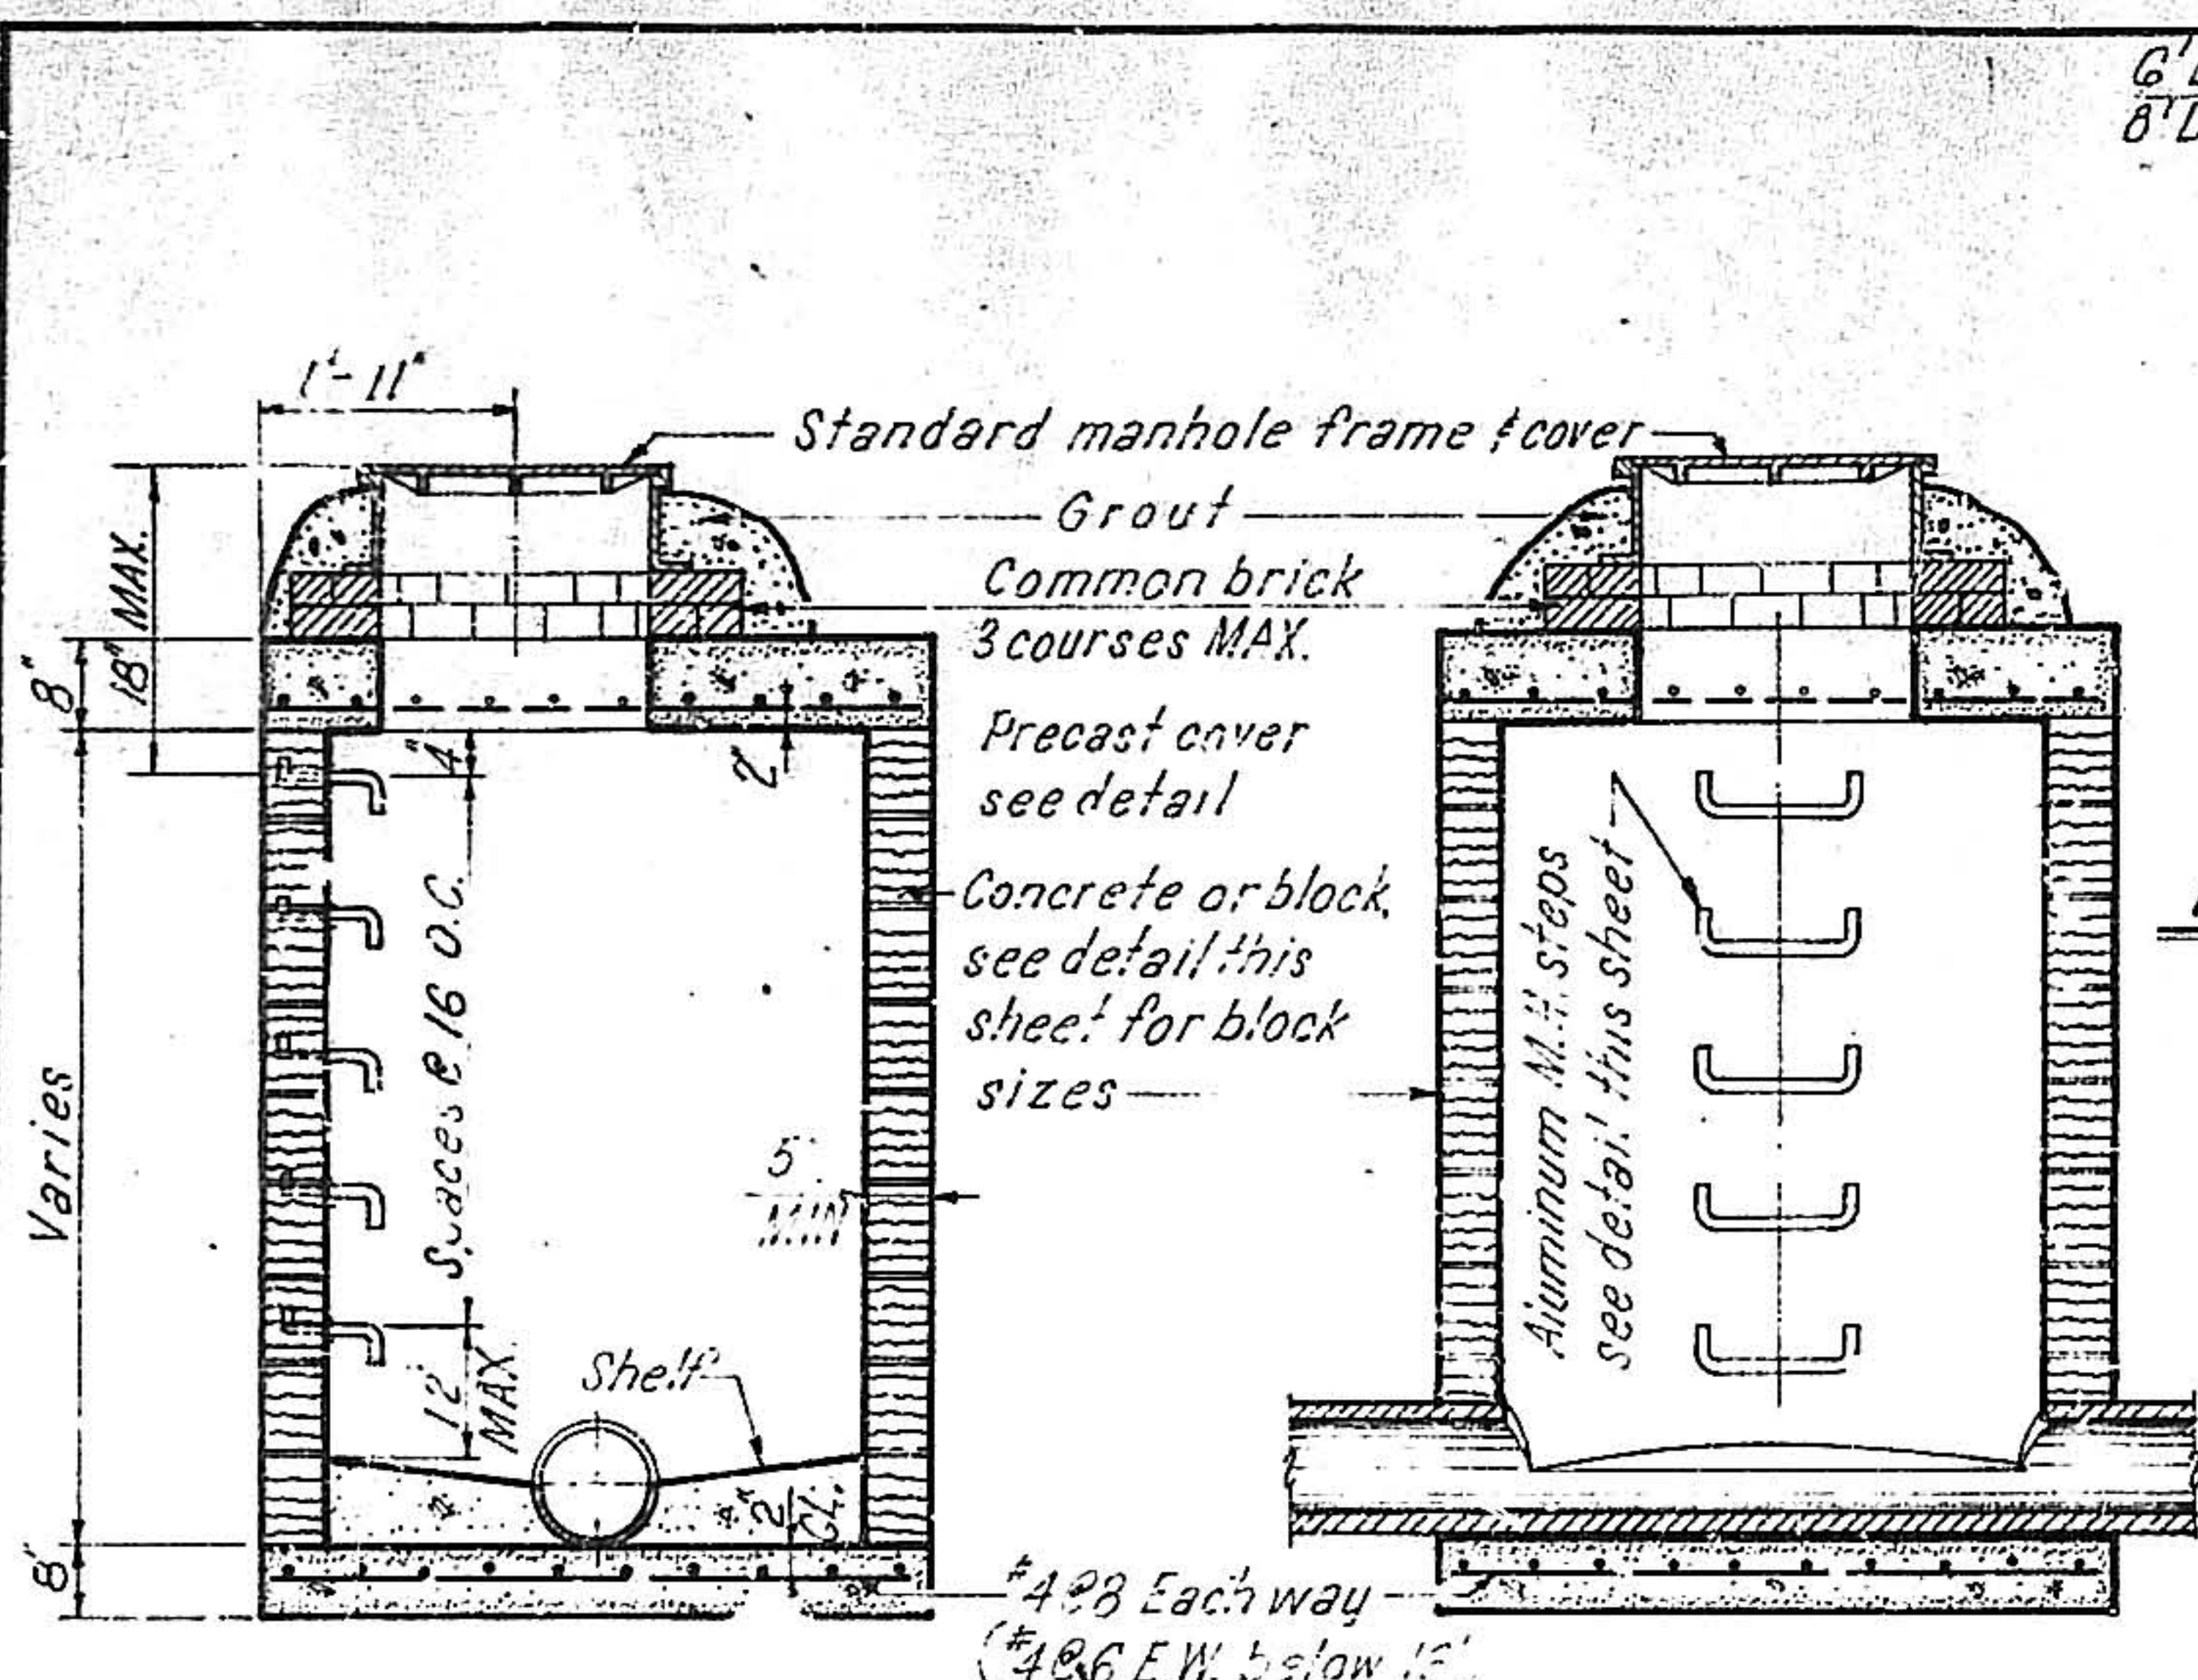


TRANSVERSE SECTION
LONGITUDINAL SECTION
T-TYPE A MANHOLE
Scale: 1/2" = 1'-0"

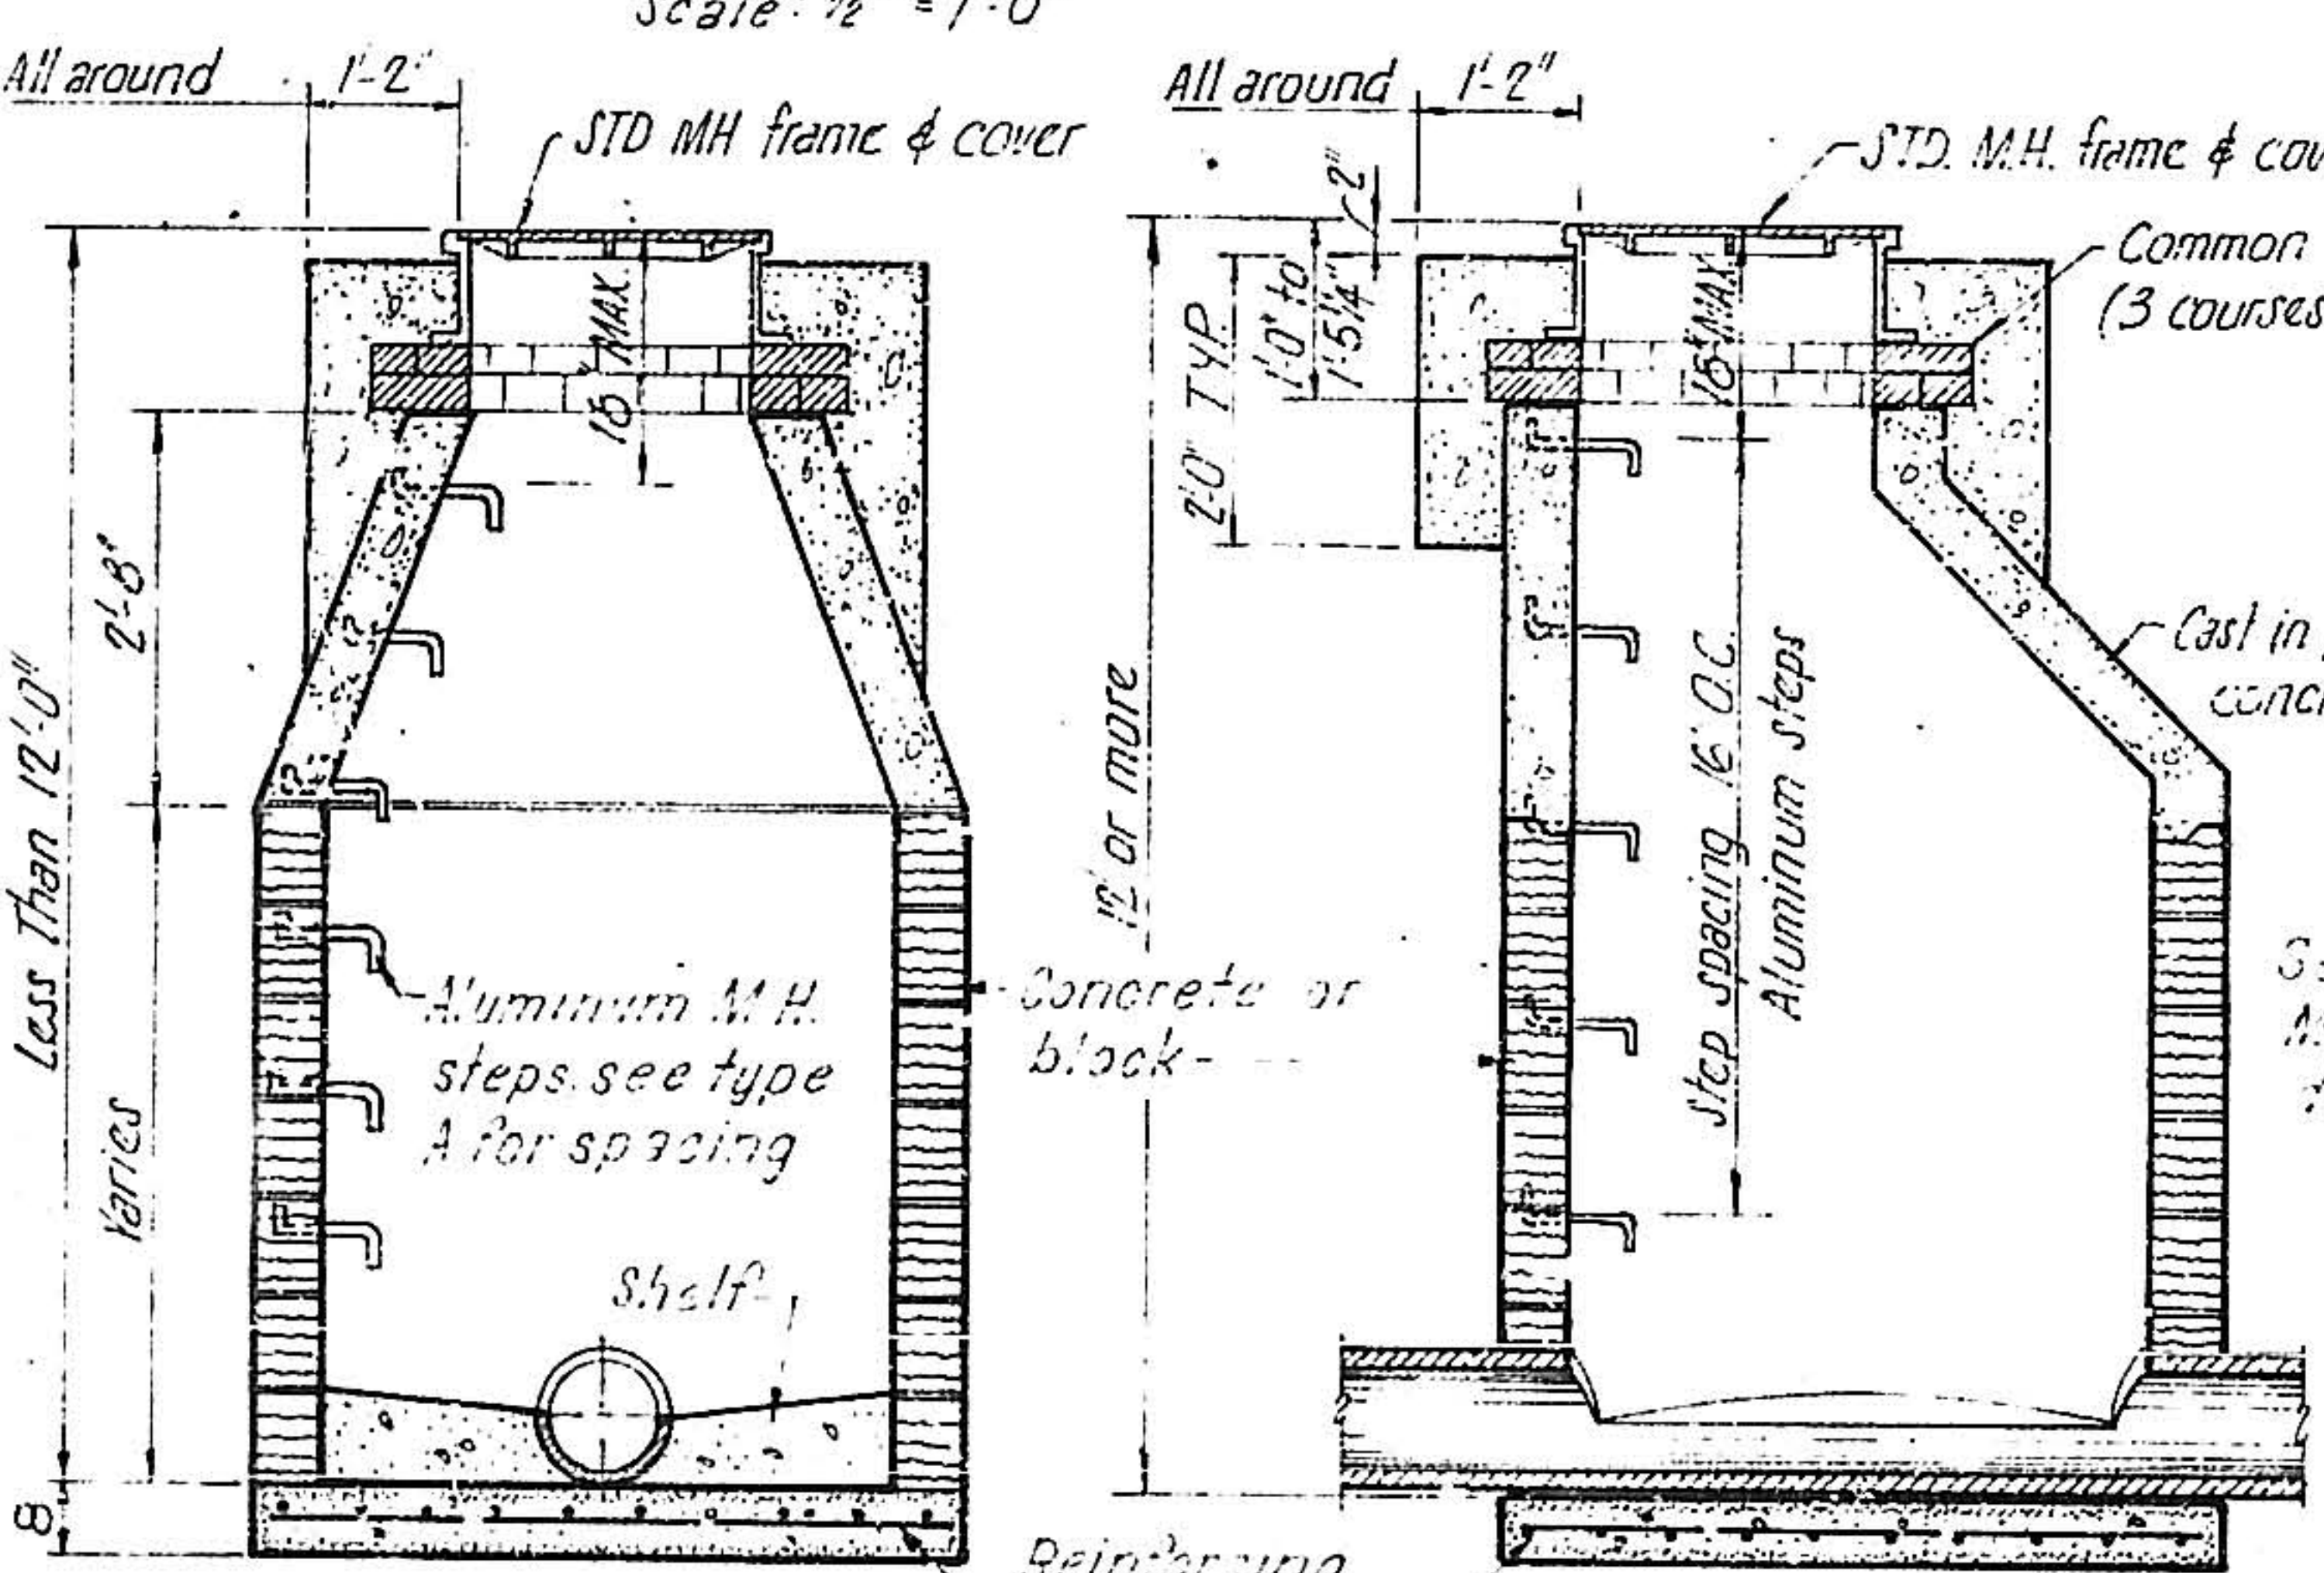


CONCENTRIC CONE
MANHOLES LESS THAN 12' DEEP
OFF-SET CONE
MANHOLES MORE THAN 12' DEEP
TYPE B MANHOLE
Scale: 1/2" = 1'-0"

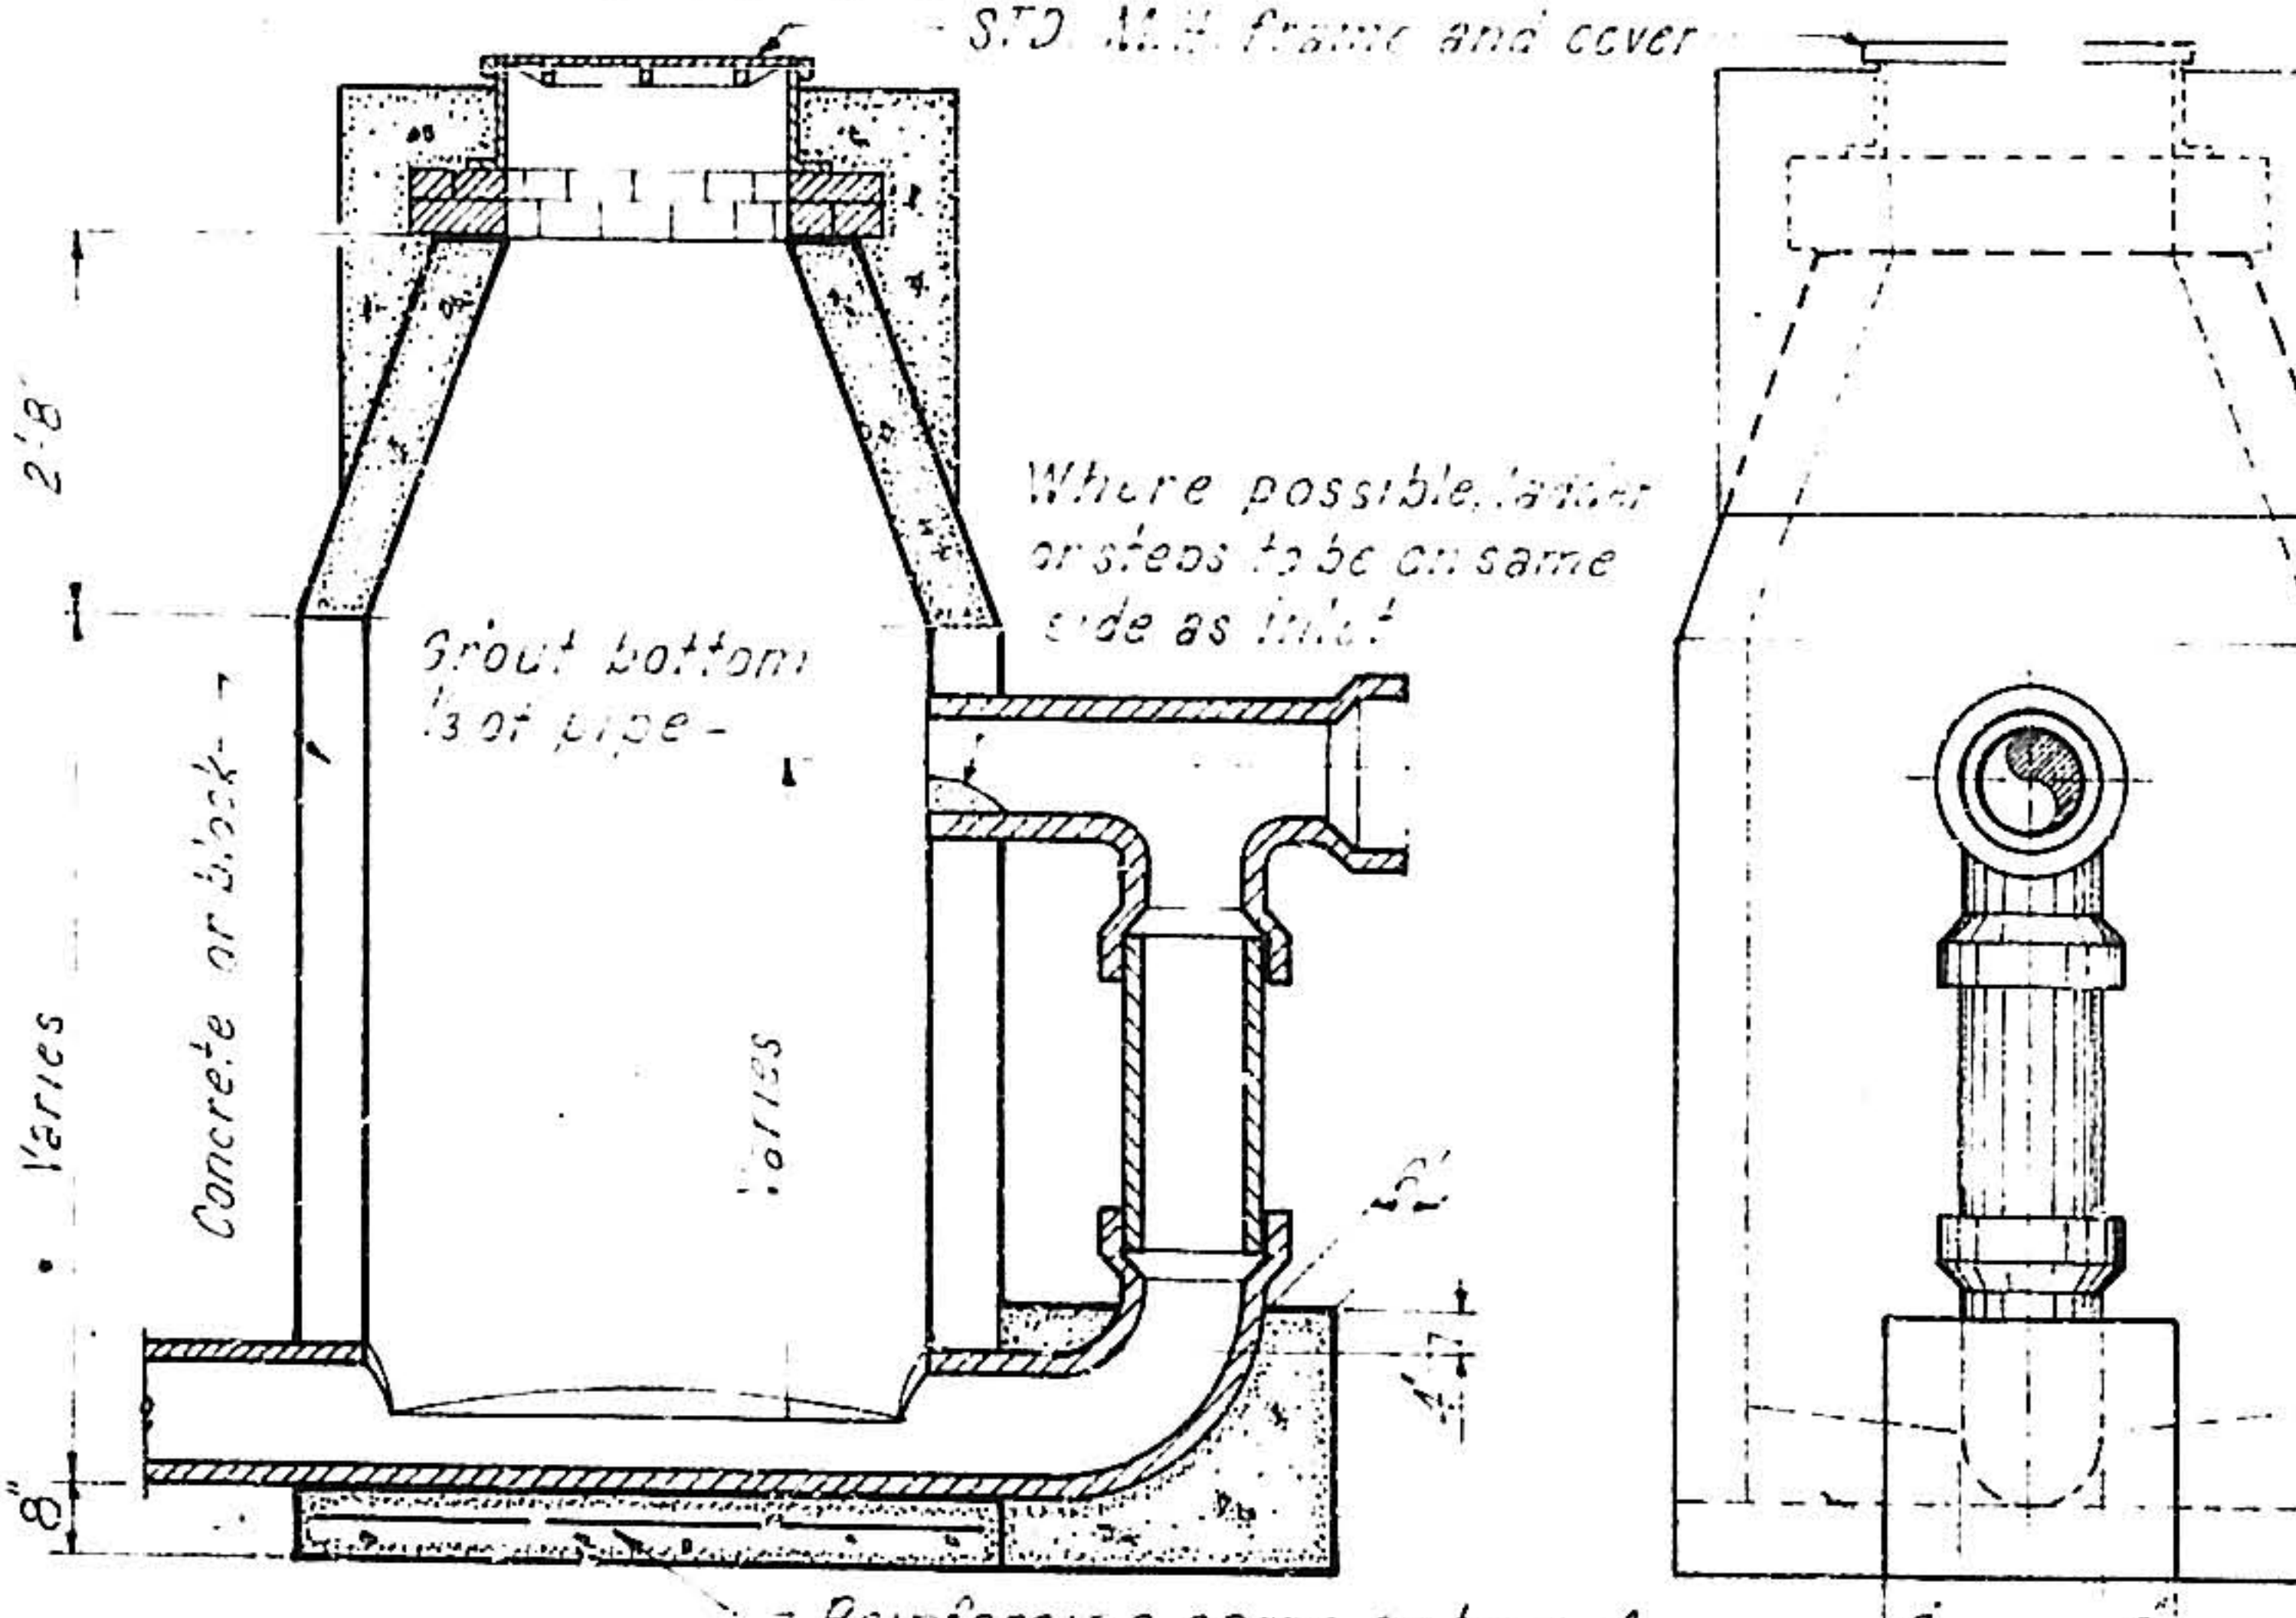


LONGITUDINAL SECTION
ELEVATION
DROP MANHOLE
Scale: 1/2" = 1'-0"

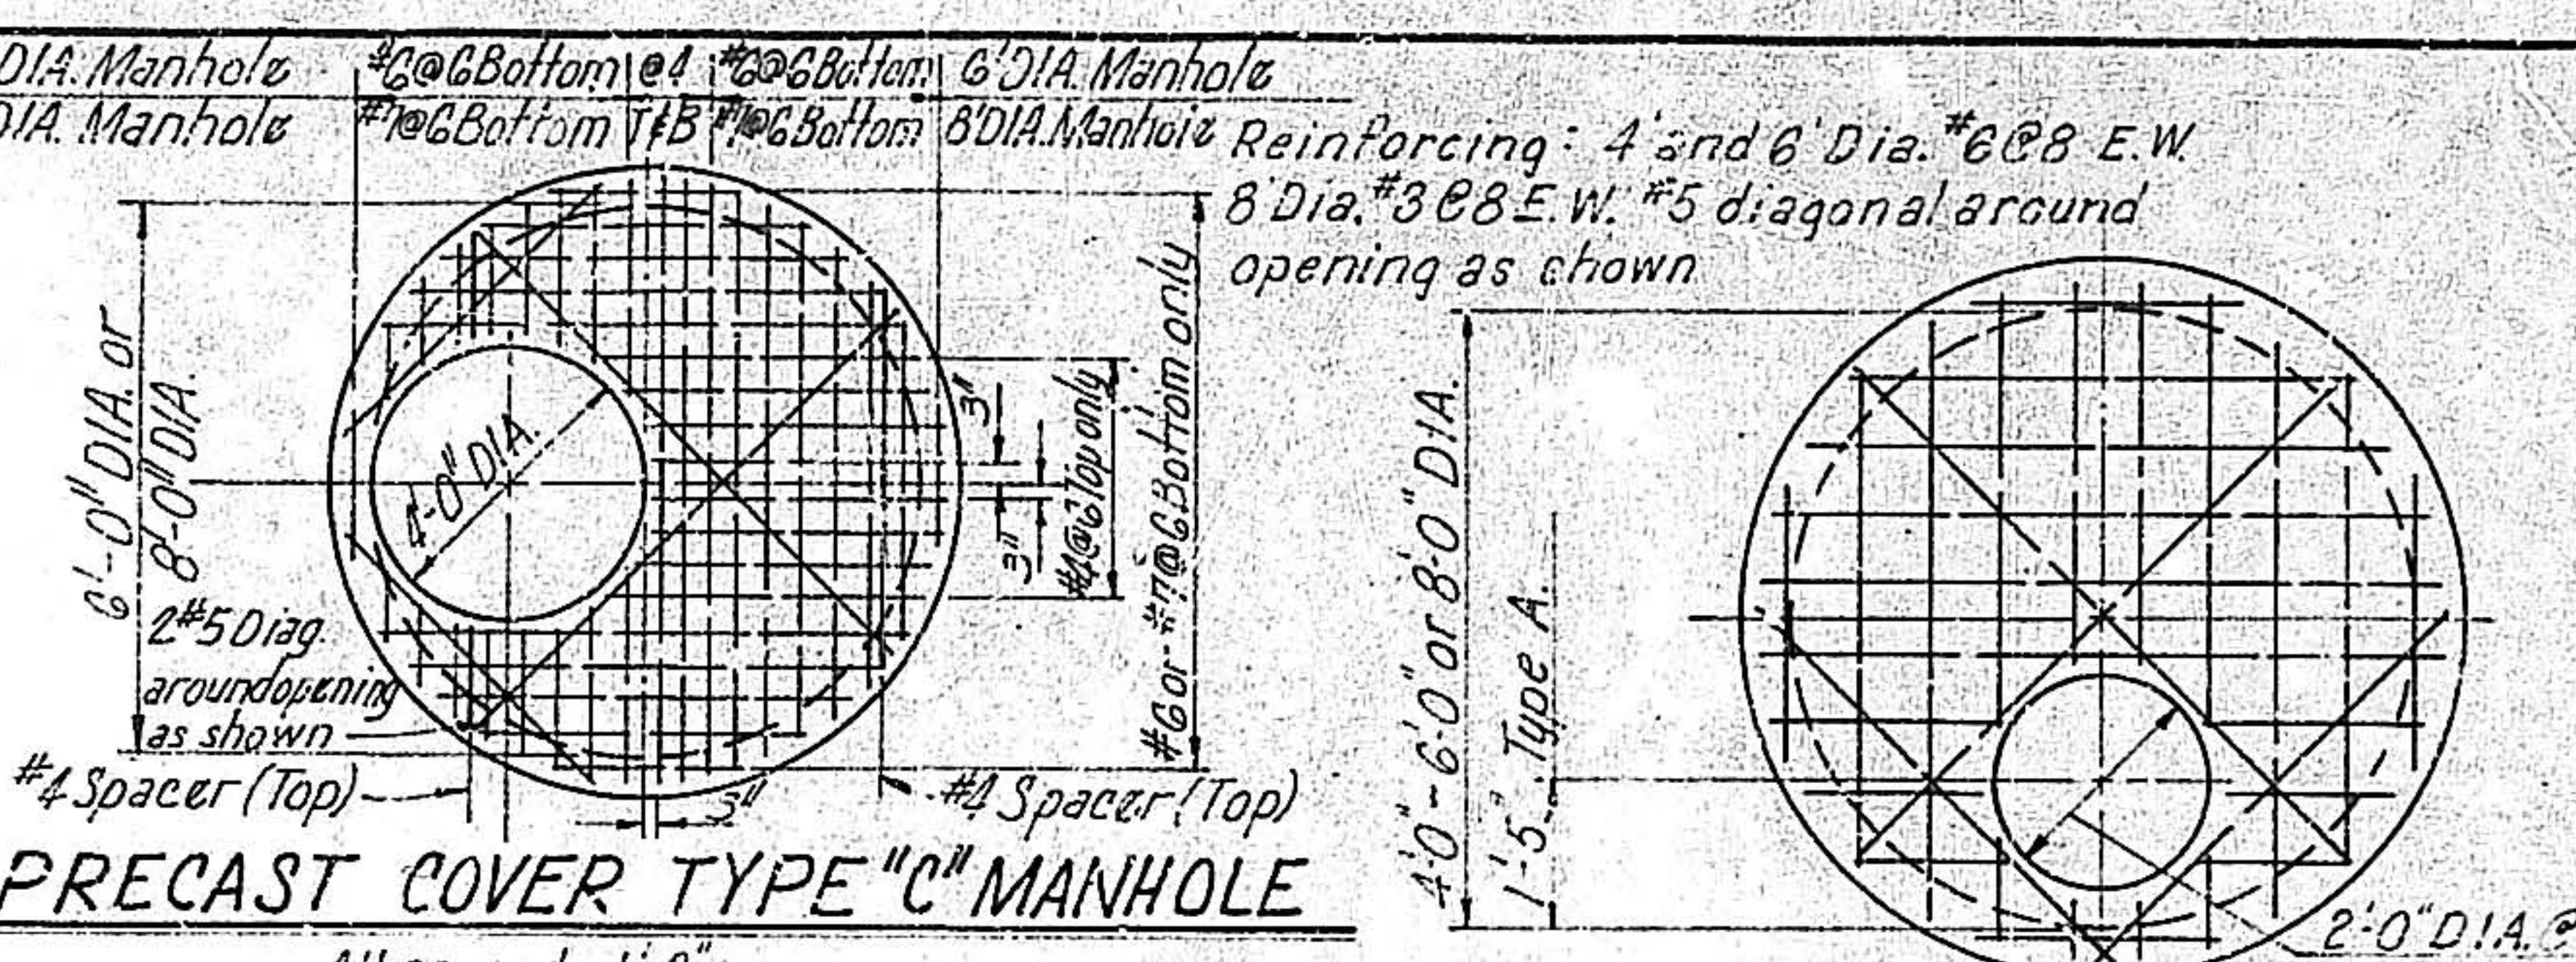


PRECAST COVER TYPE "C" MANHOLE

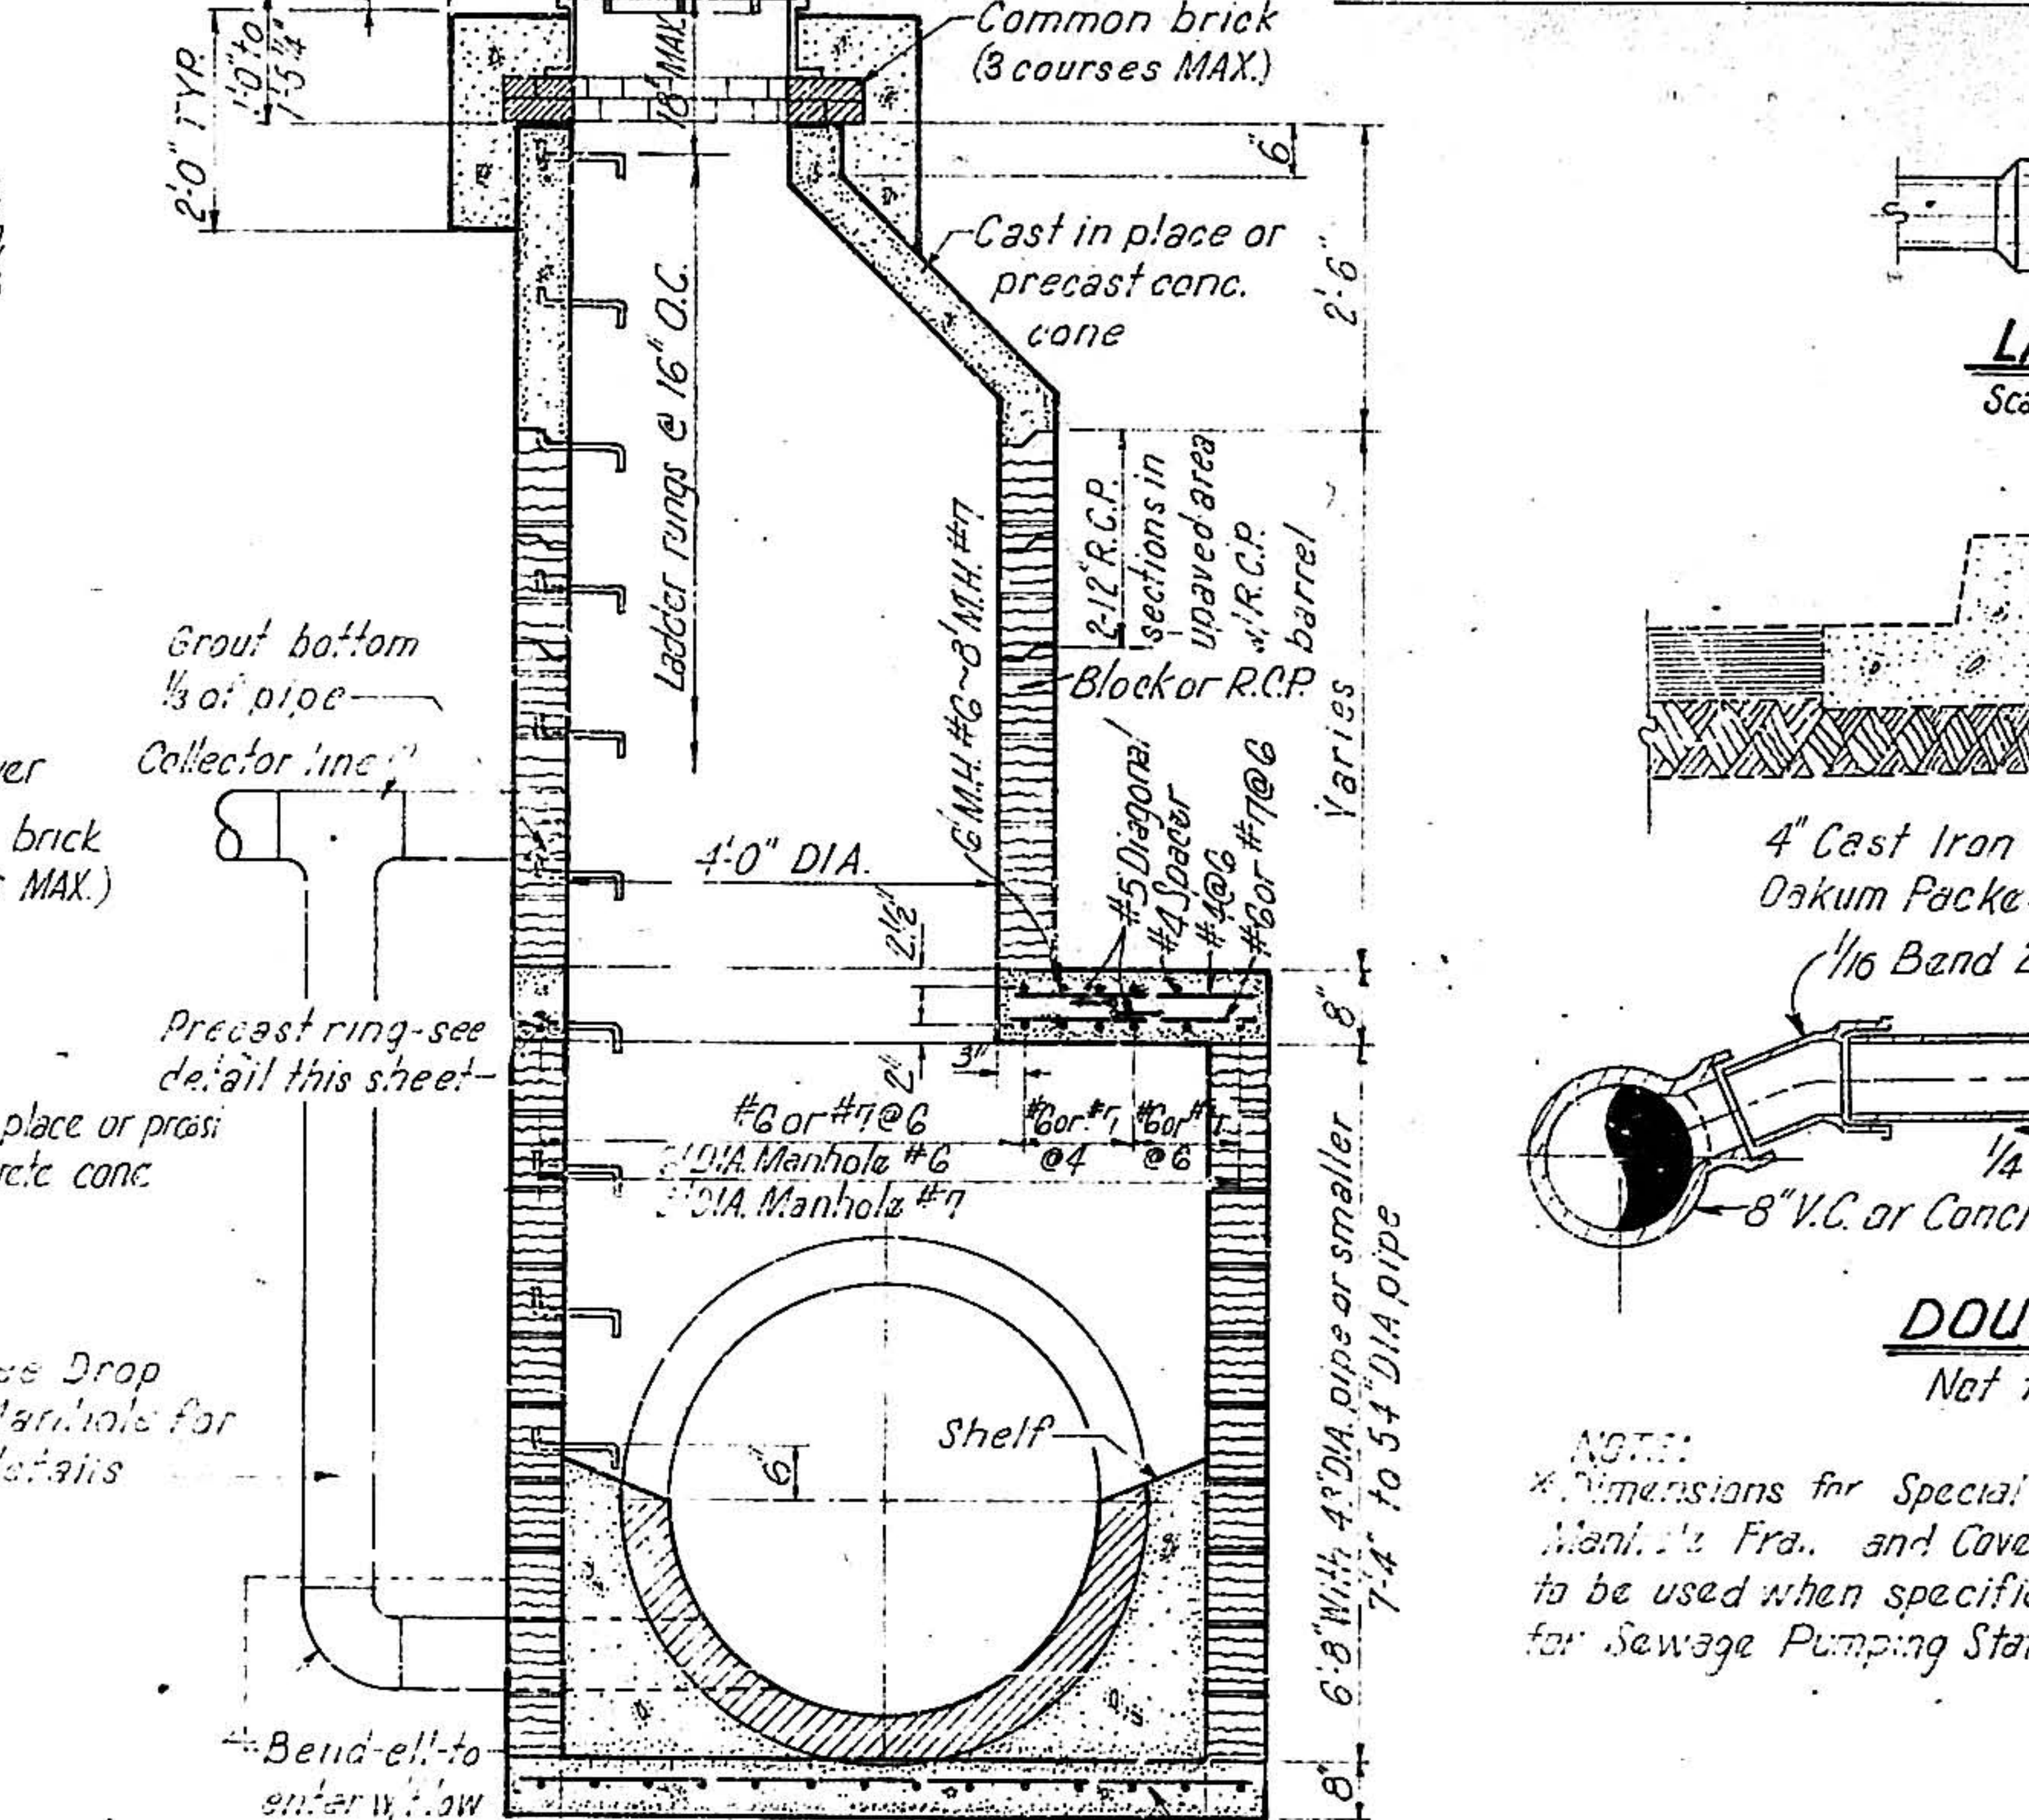


TYPE A MANHOLE
Scale: 1/2" = 1'-0"

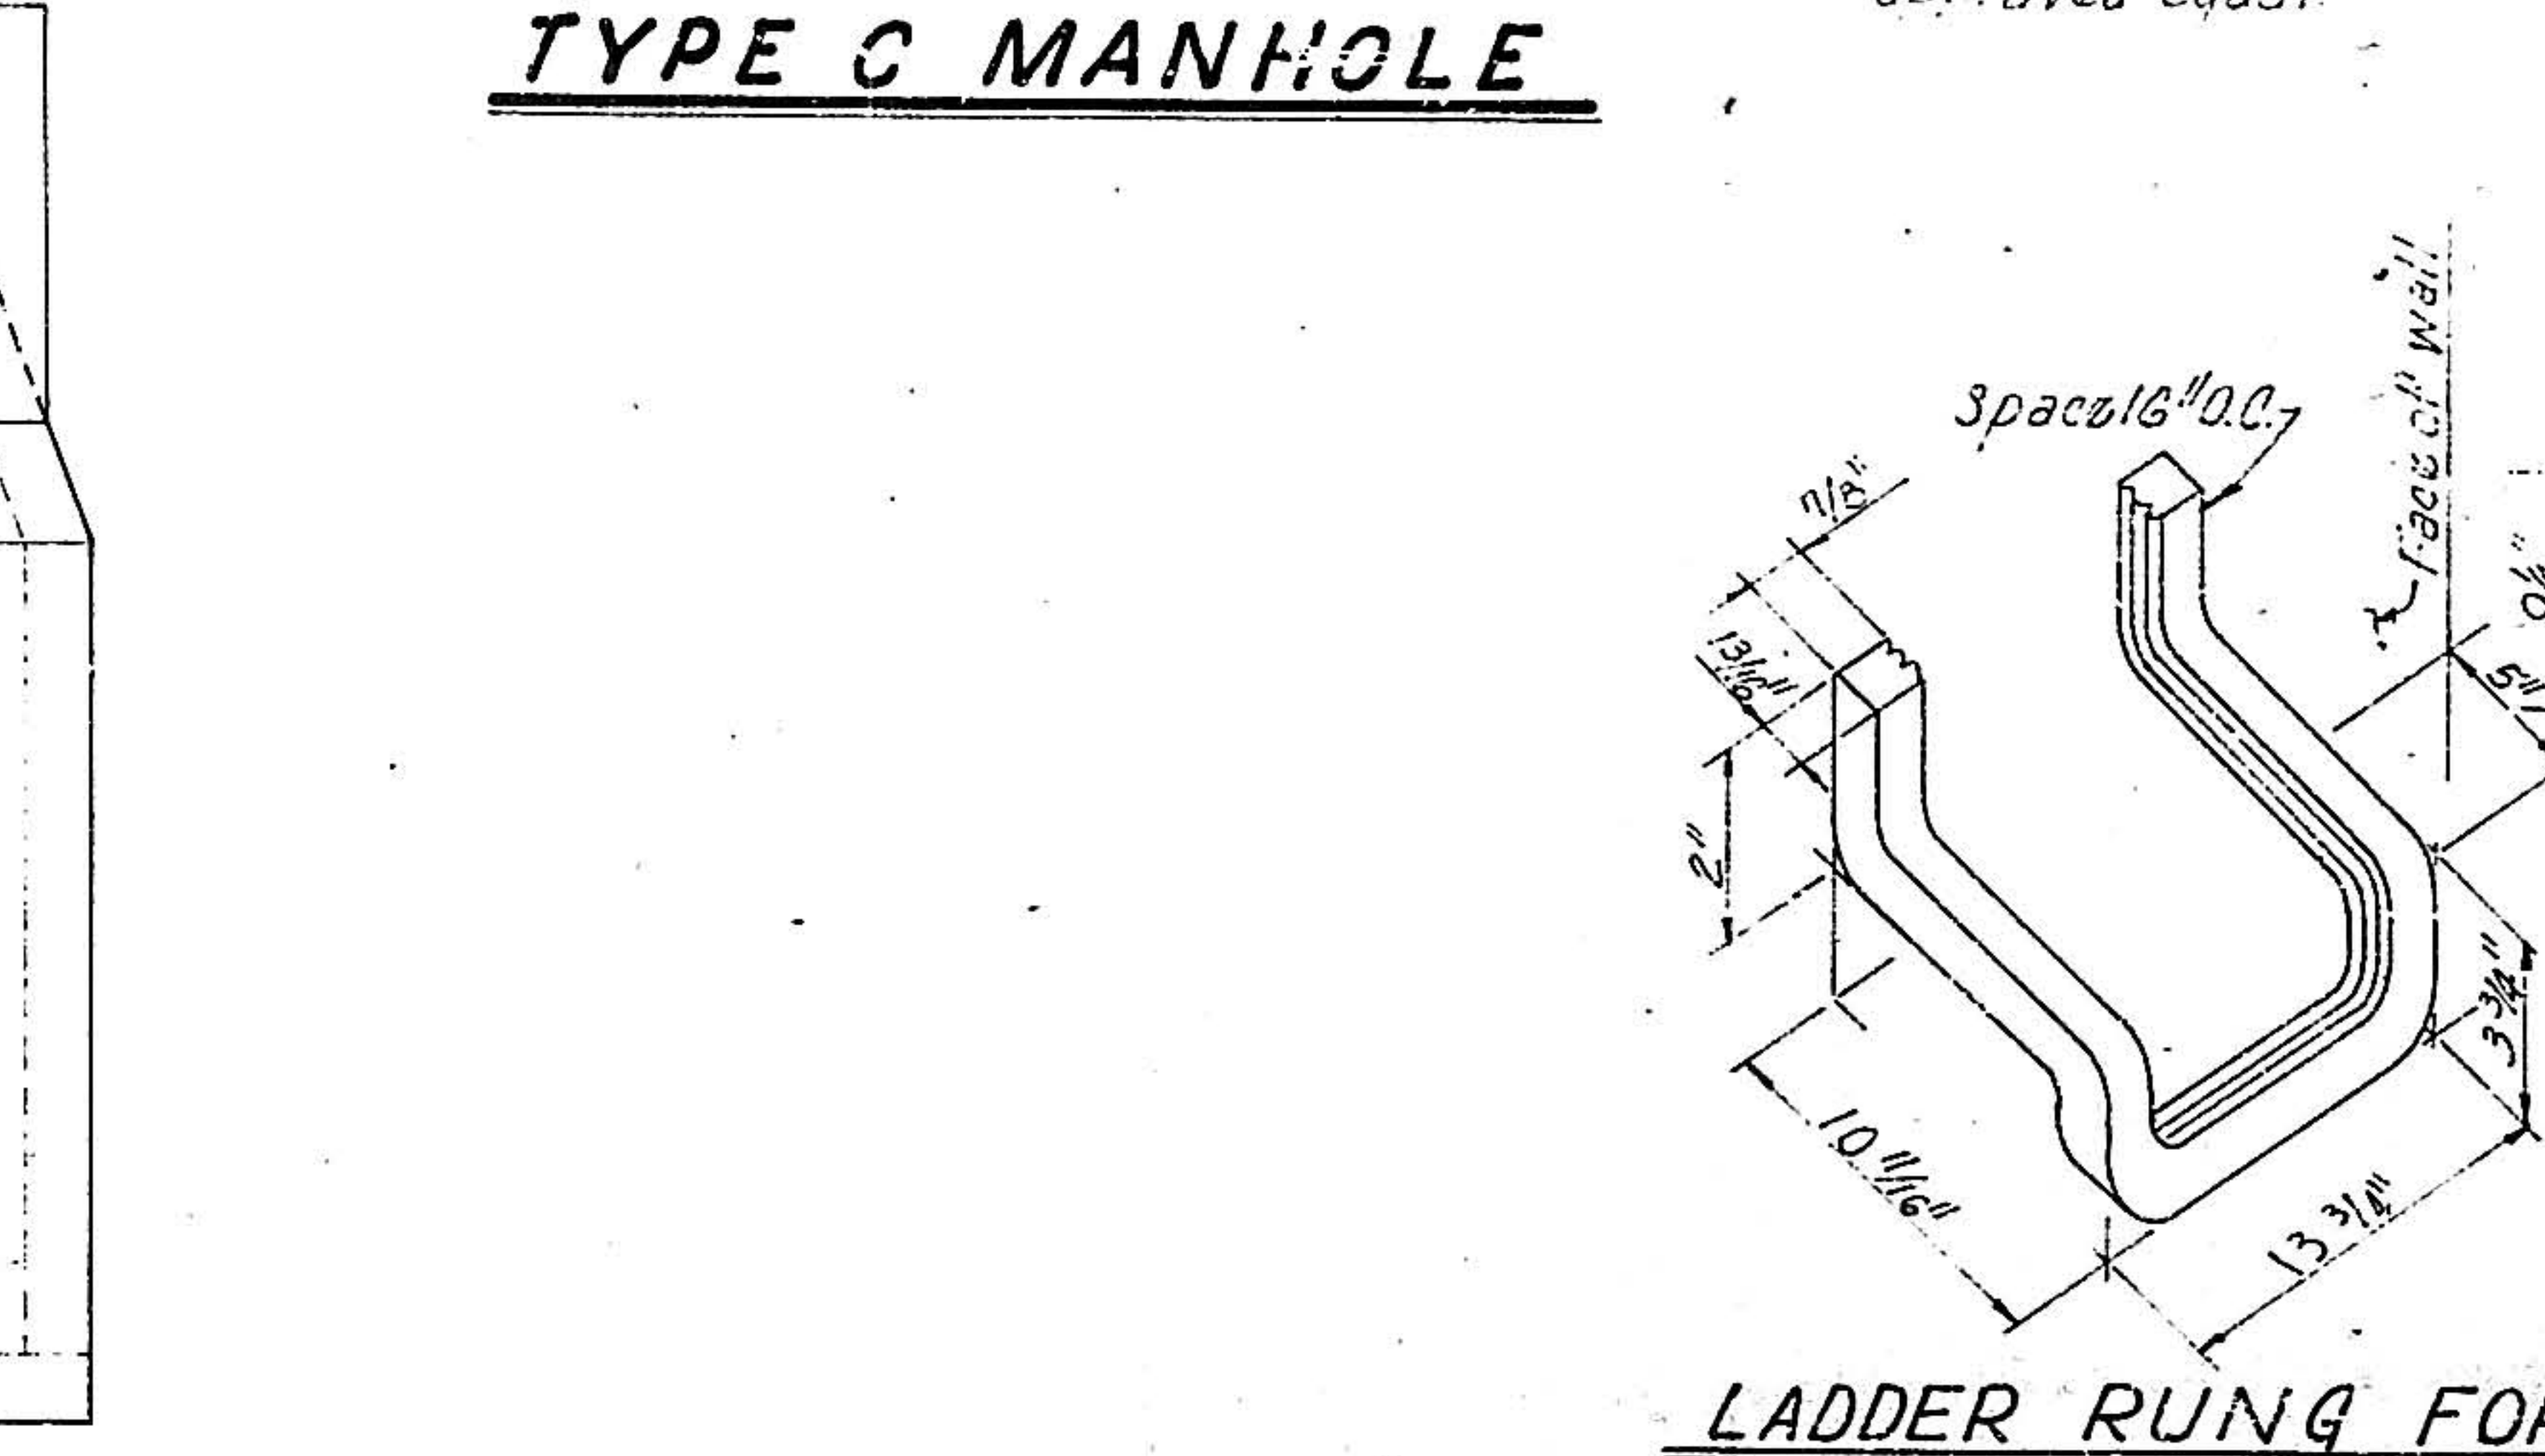


TYPE C MANHOLE
Scale: 1/2" = 1'-0"

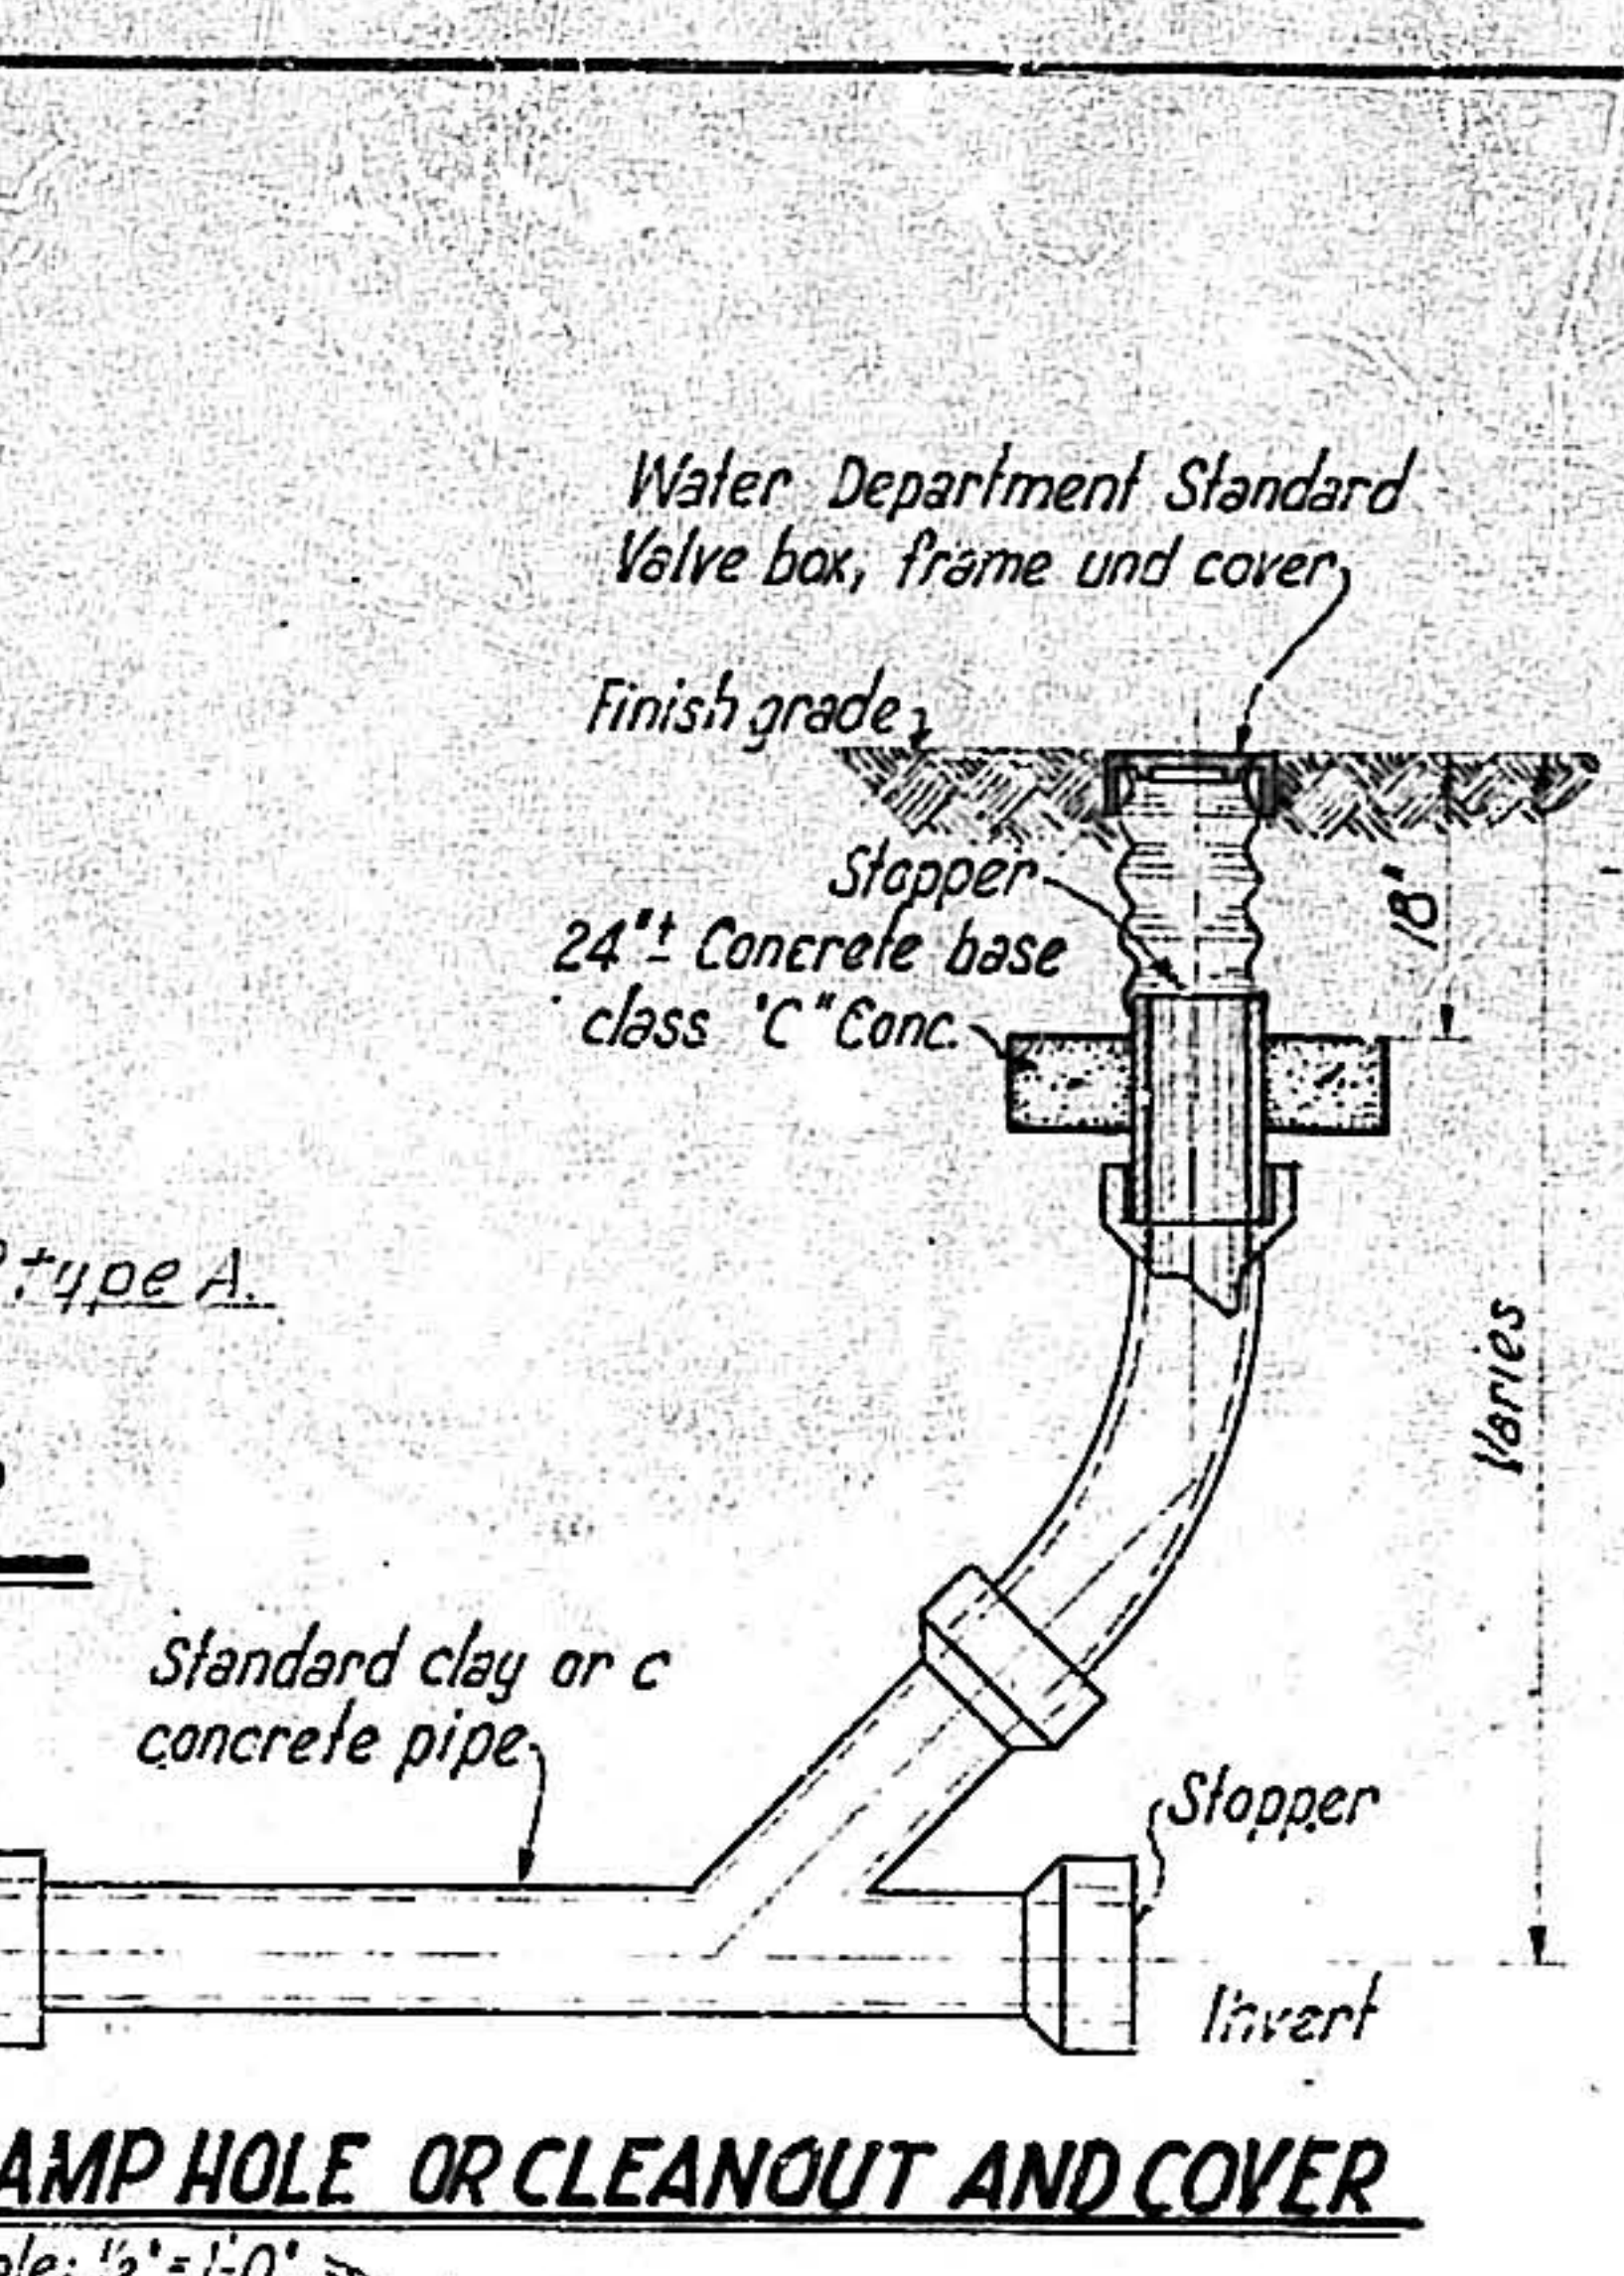


LAMP HOLE OR CLEANOUT AND COVER
Scale: 1/2" = 1'-0"

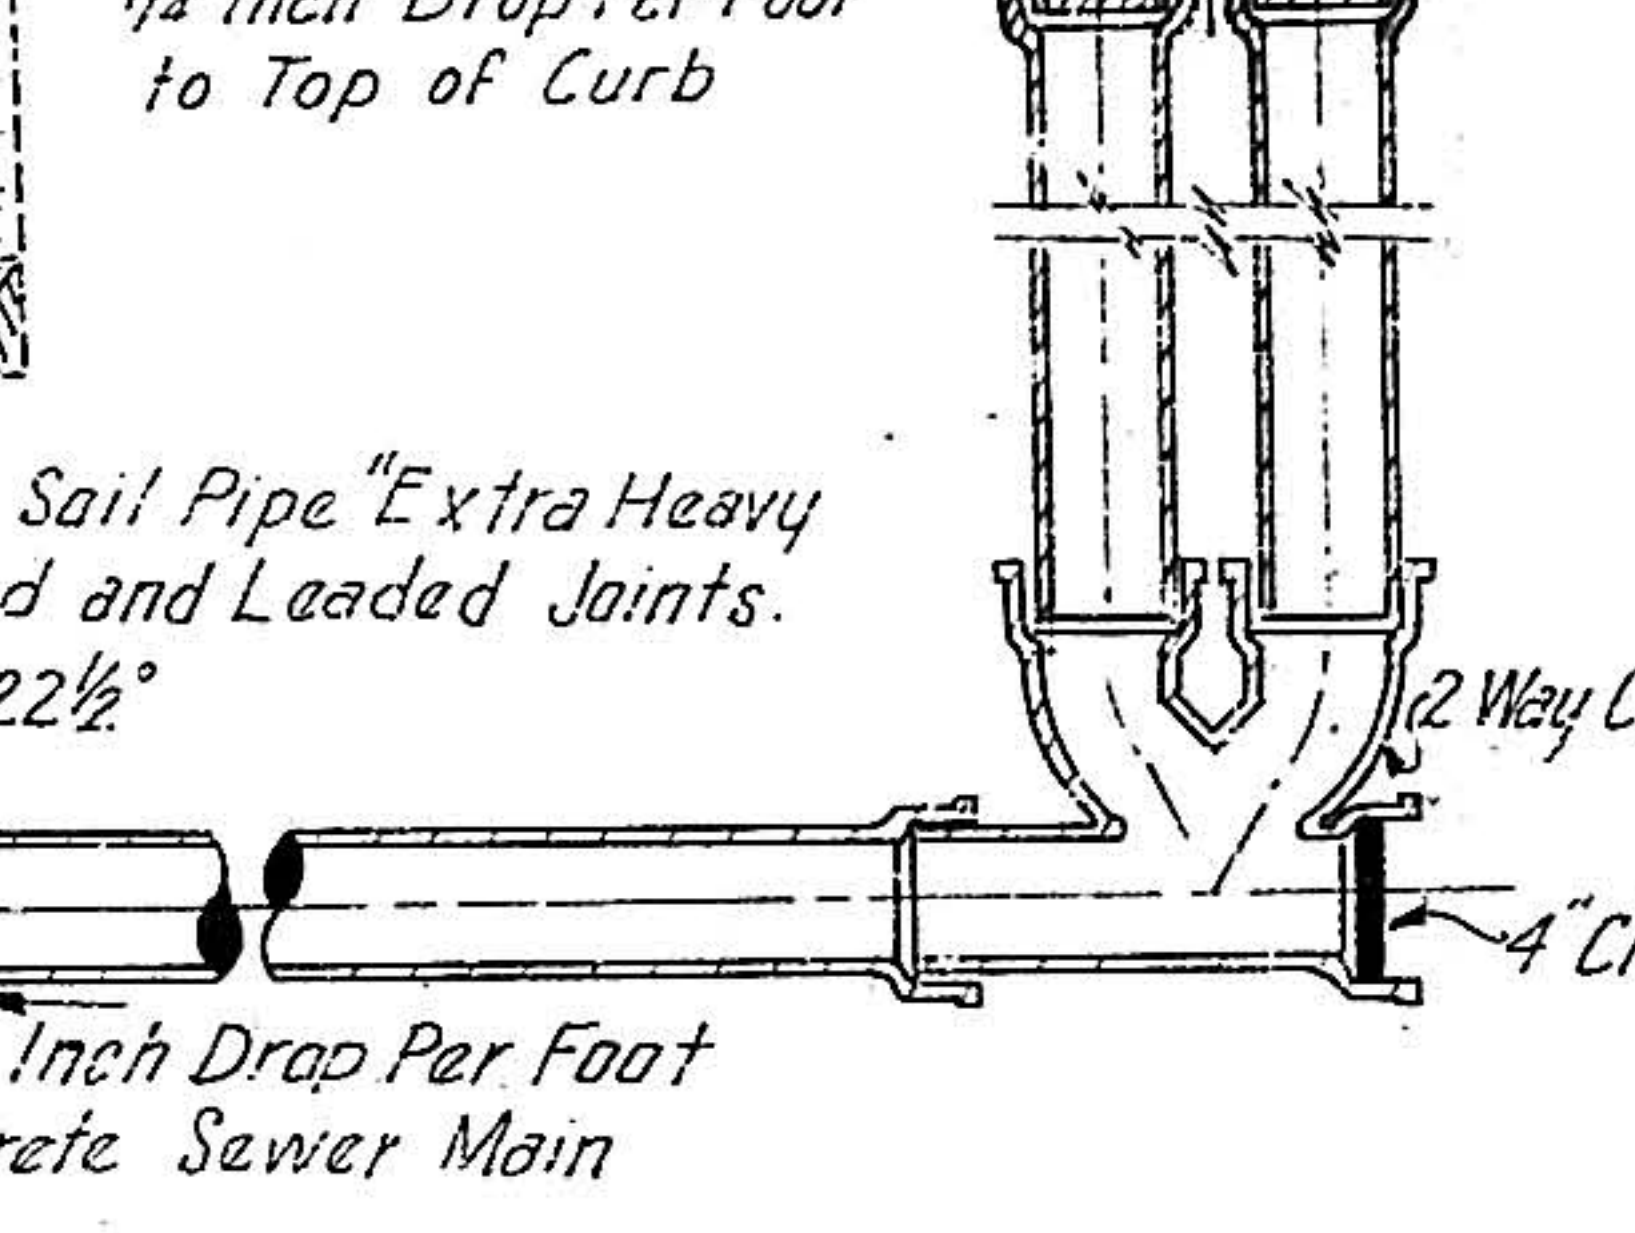


DOUBLE CLEANOUT DETAIL
Not to Scale

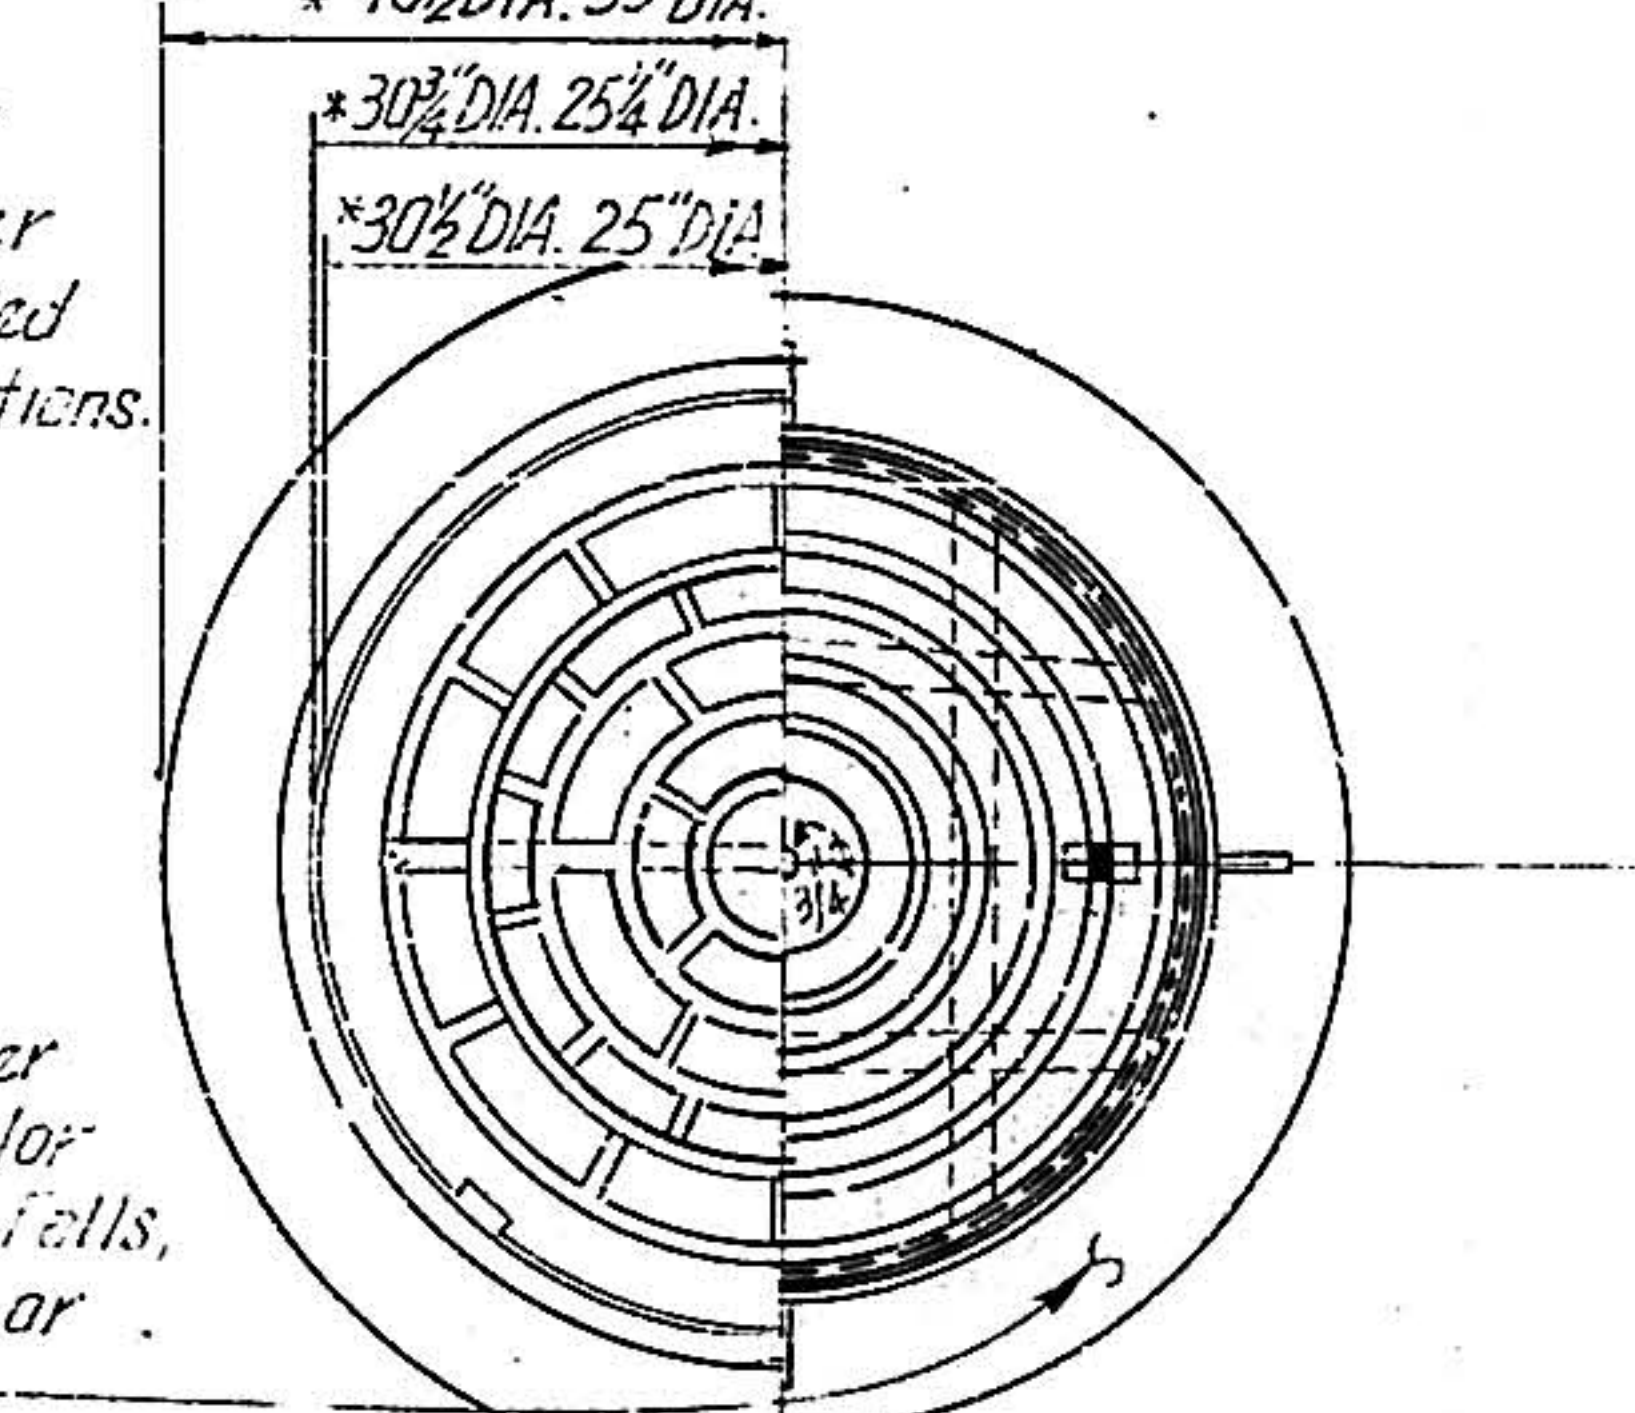


LADDER RUNG FOR MANHOLE OR JUNCTION BOX

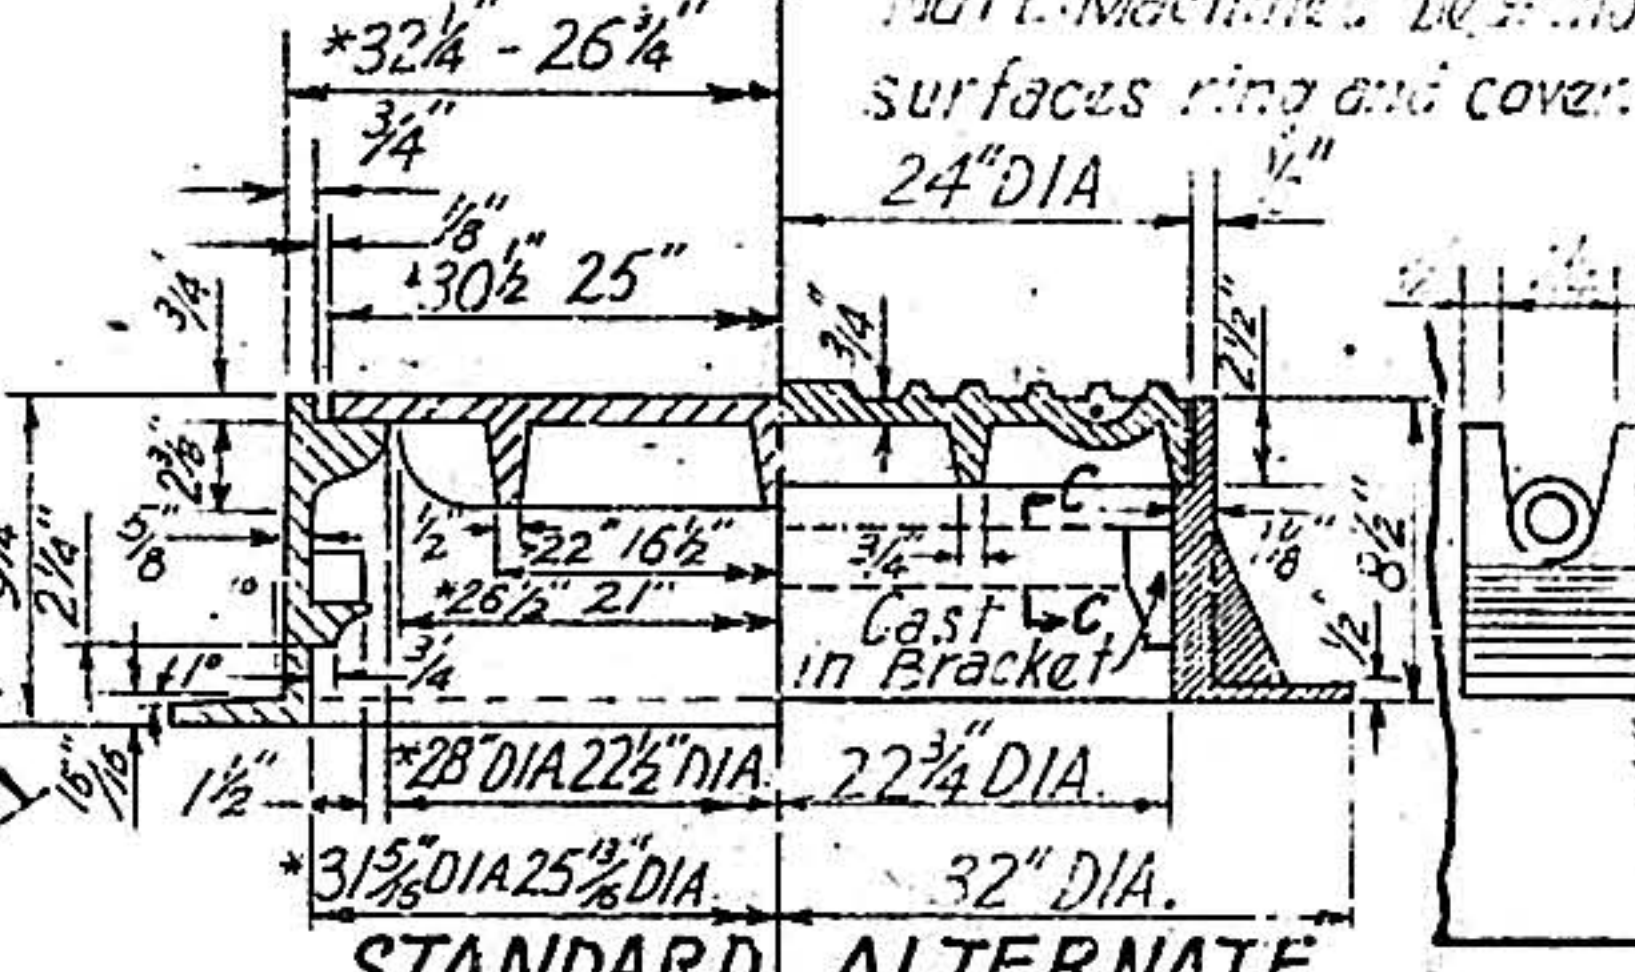


TYPICAL DETAILS OF CAST IRON MANHOLE RING AND COVER

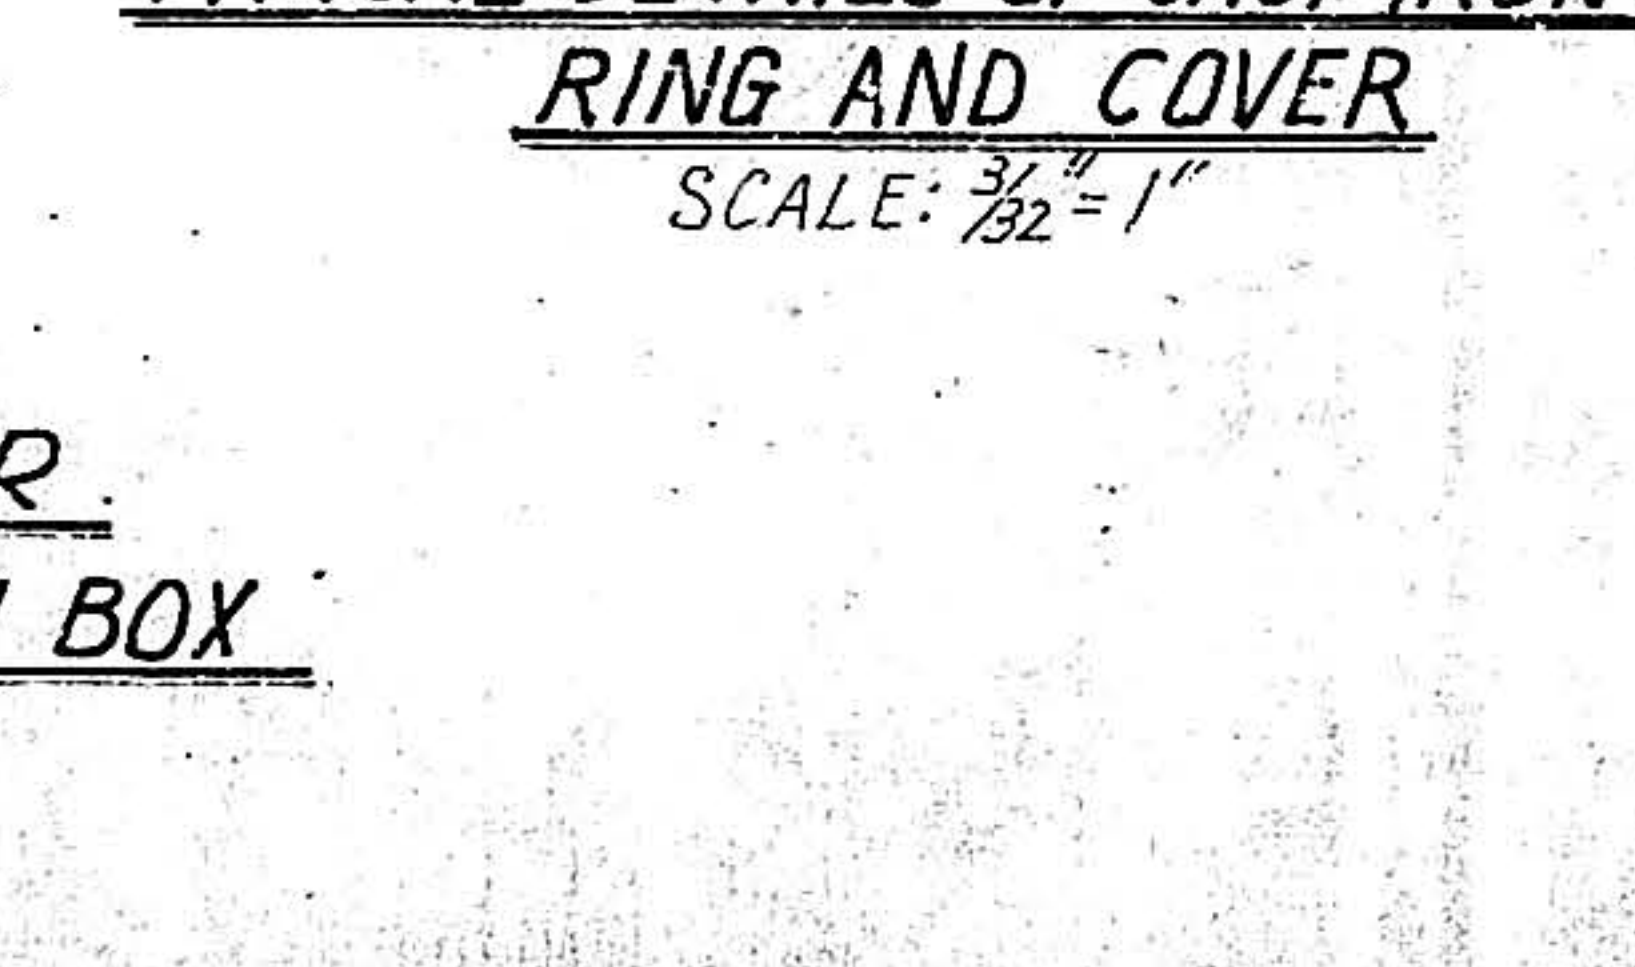


CONCRETE MANHOLE BLOCK DETAILS
Not to Scale

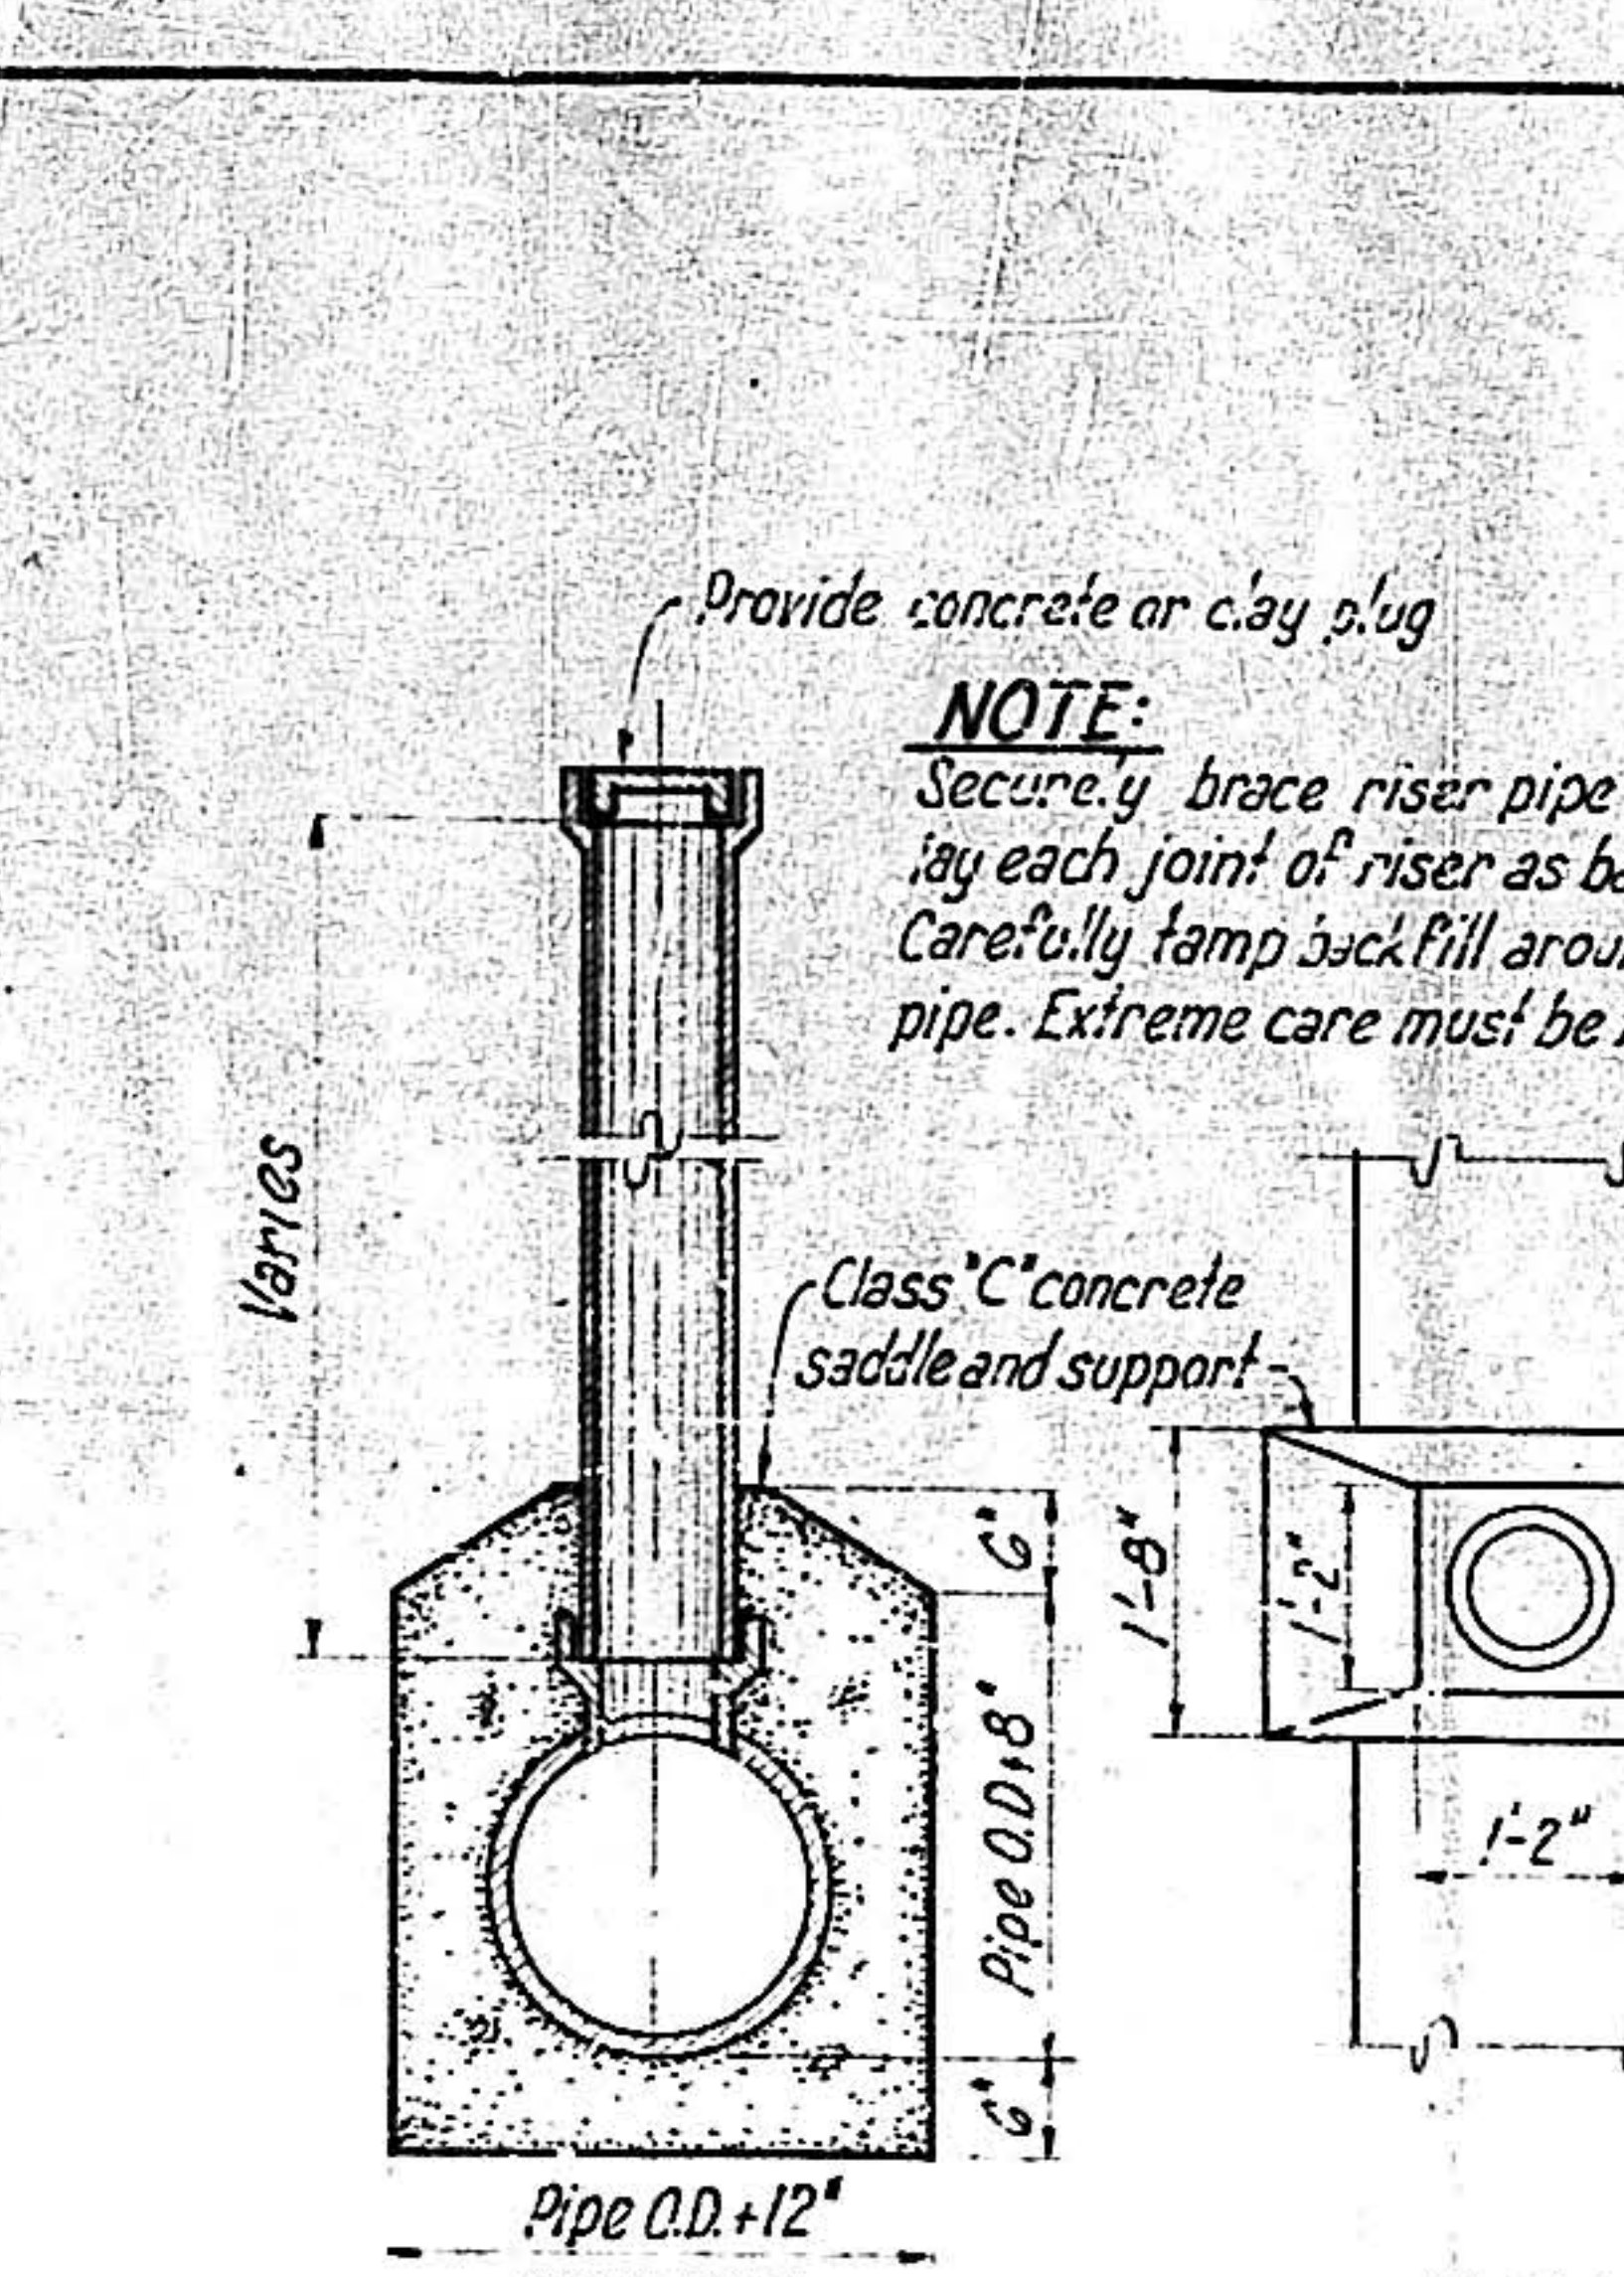


RISE DETAILS
Scale: 1/2" = 1'-0"

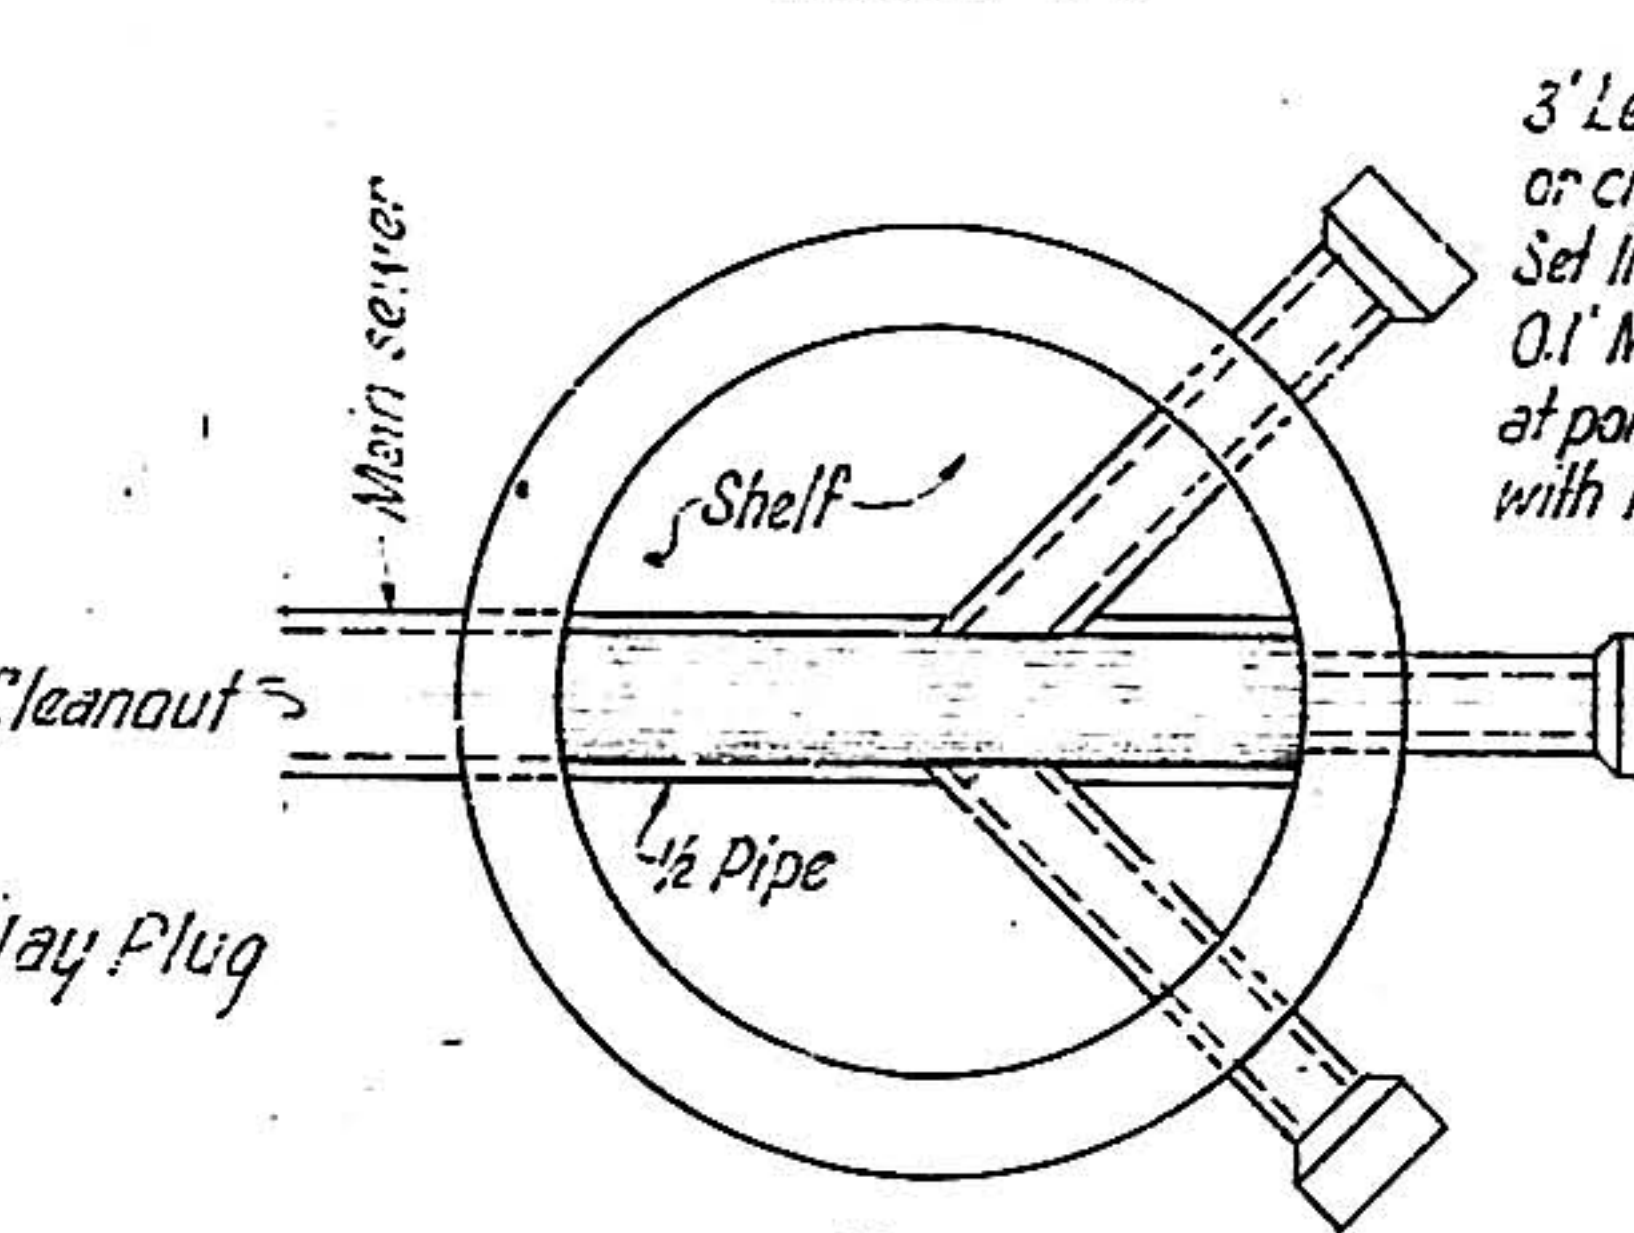


DETAIL OF HOUSE SERVICE LINES AT DEAD-END
Scale: 1/2" = 1'-0"

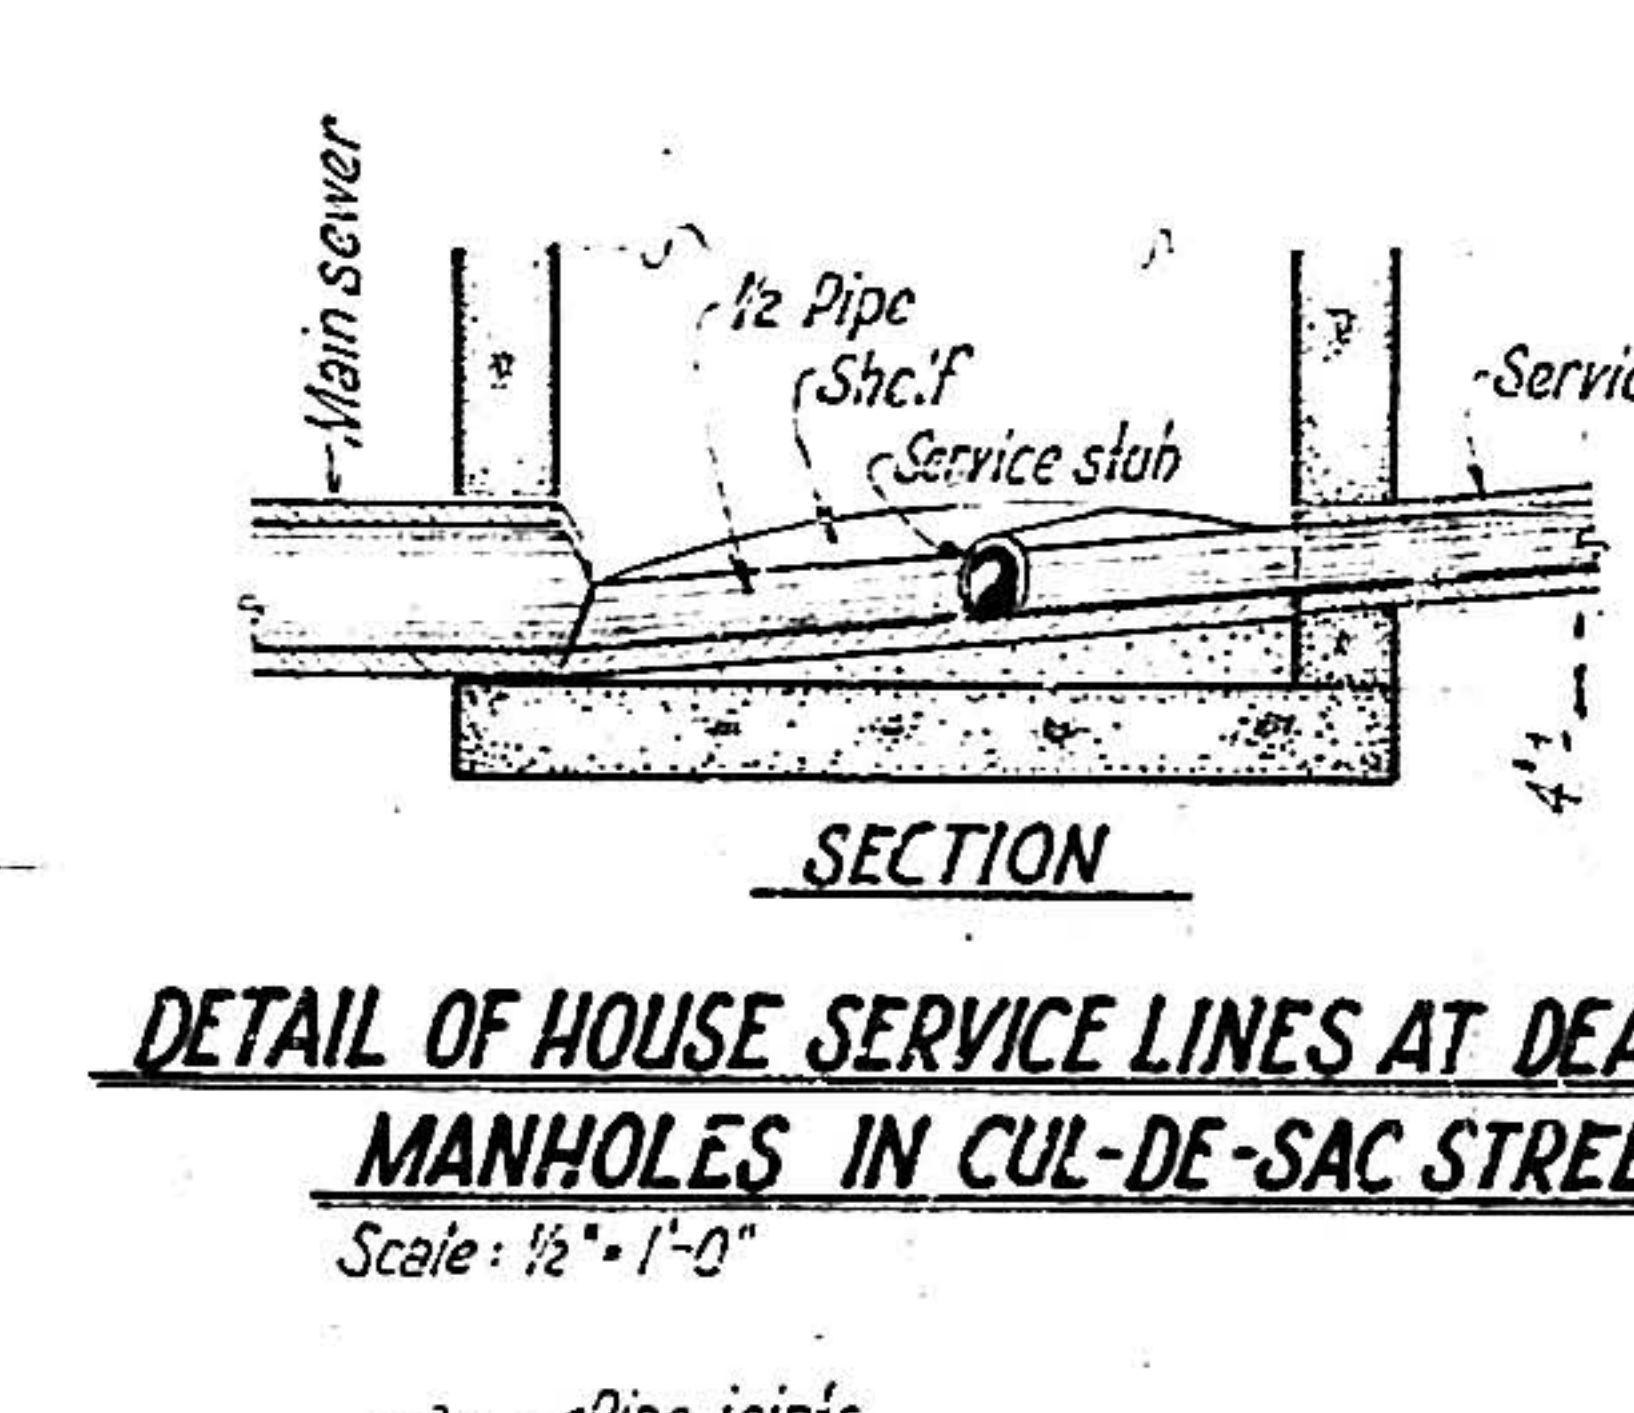


MANHOLES IN CUL-DE-SAC STREETS
Scale: 1/2" = 1'-0"

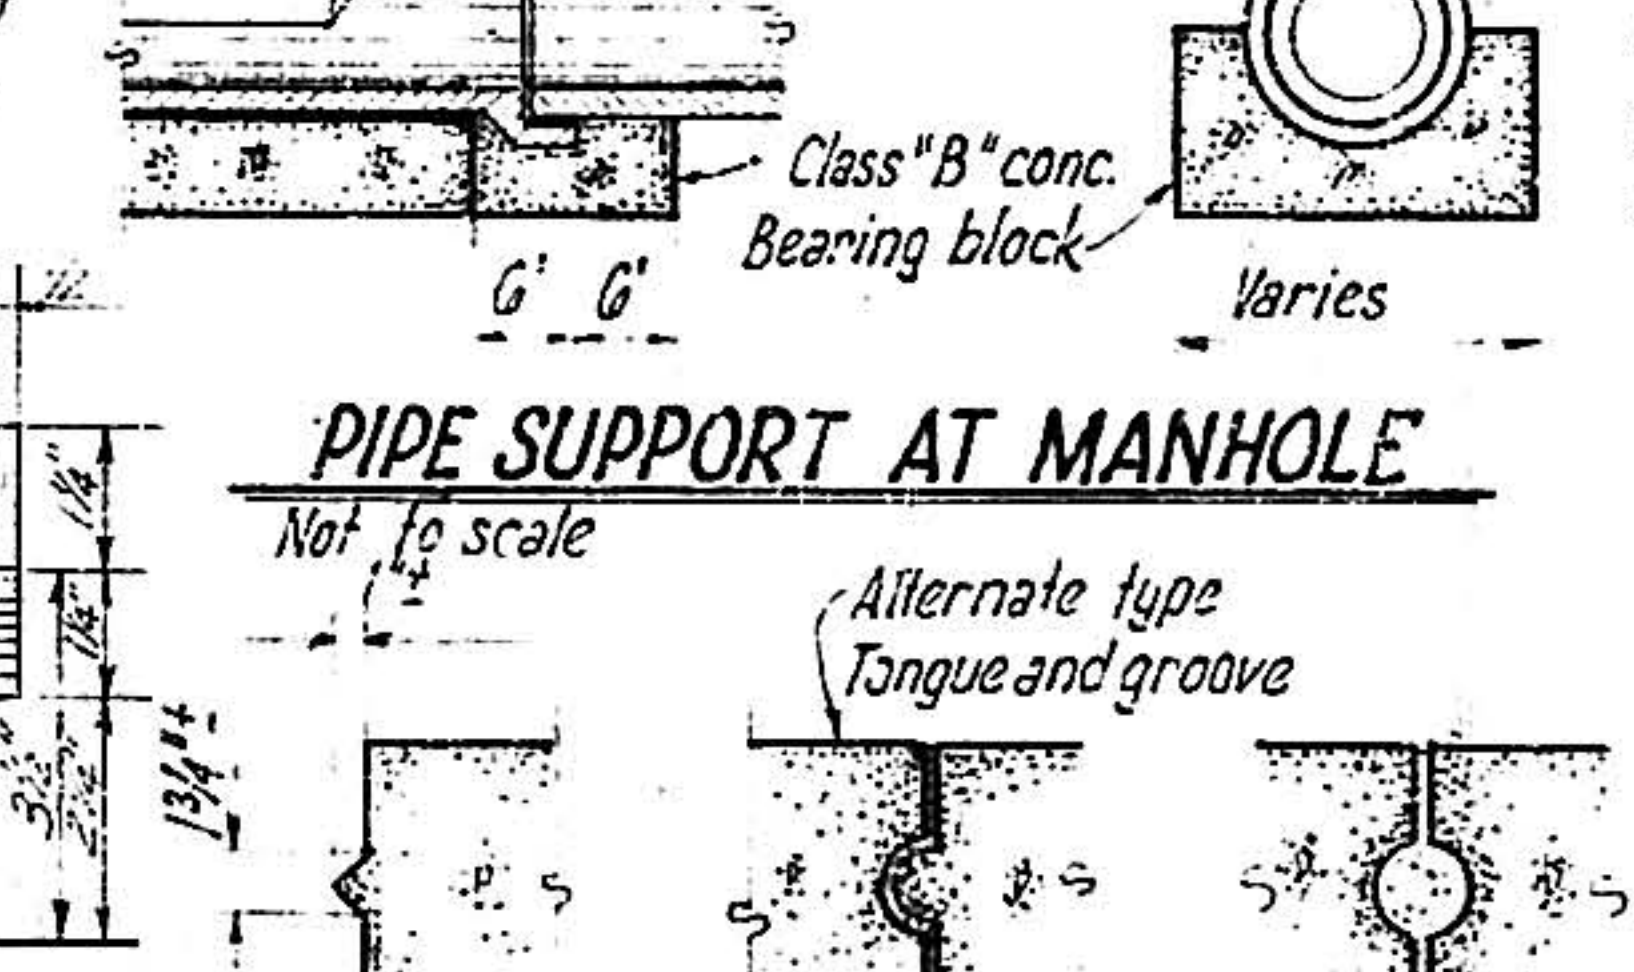


PIPE SUPPORT AT MANHOLE
Not to Scale

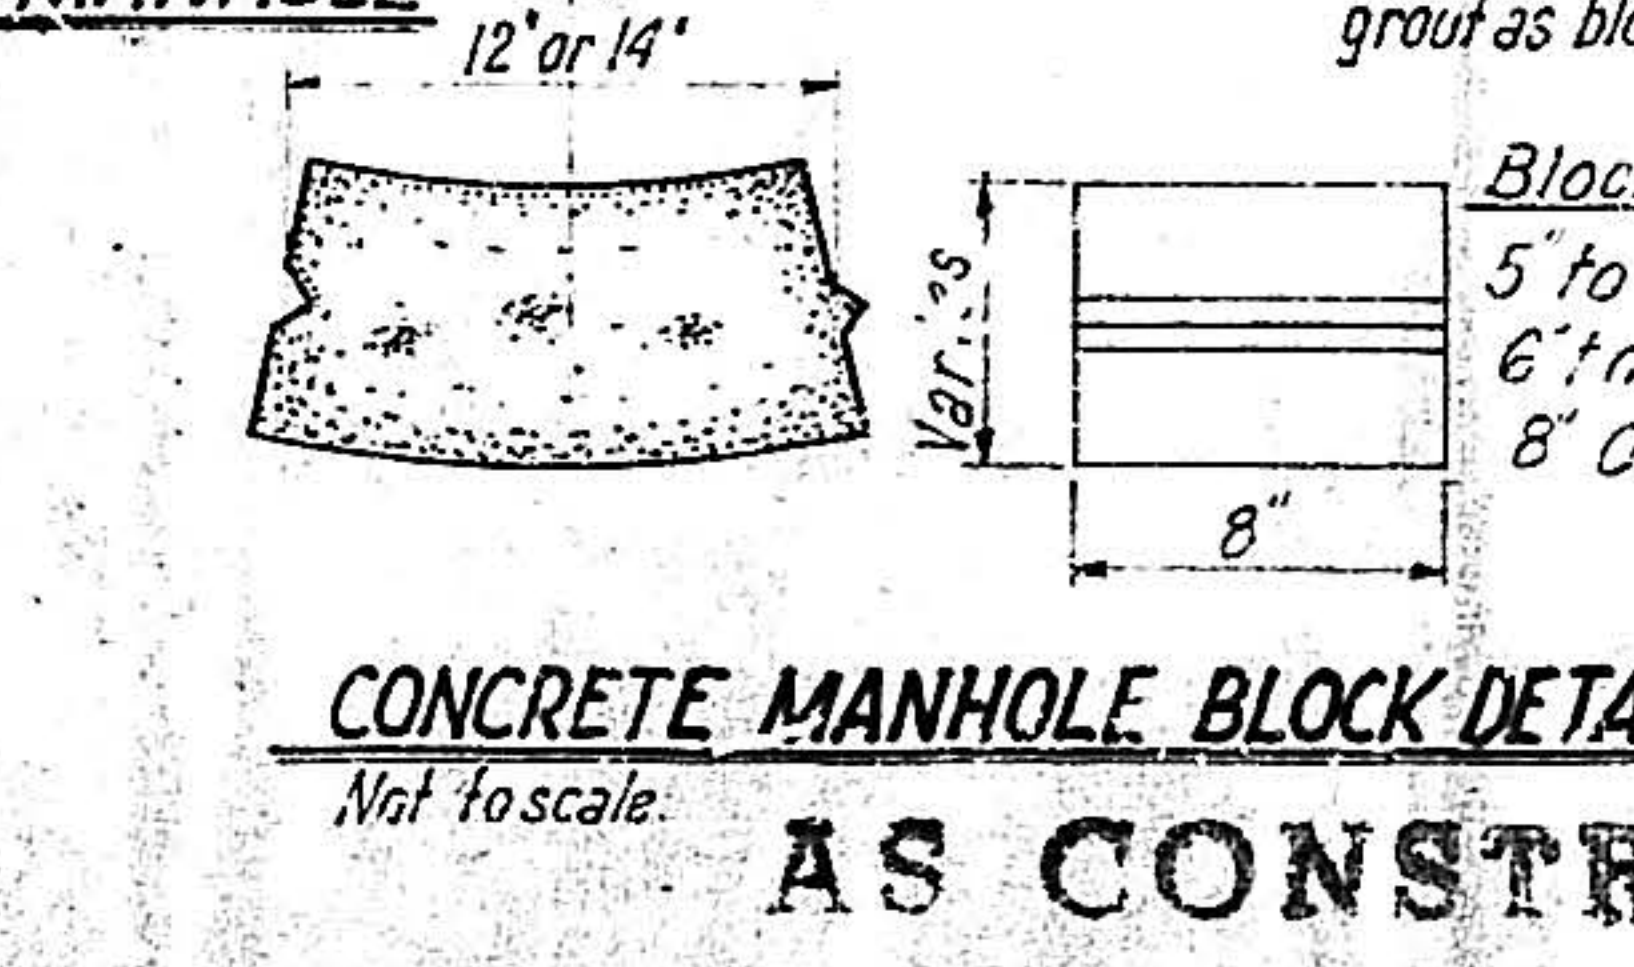


CONCRETE MANHOLE BLOCK DETAILS
Not to Scale

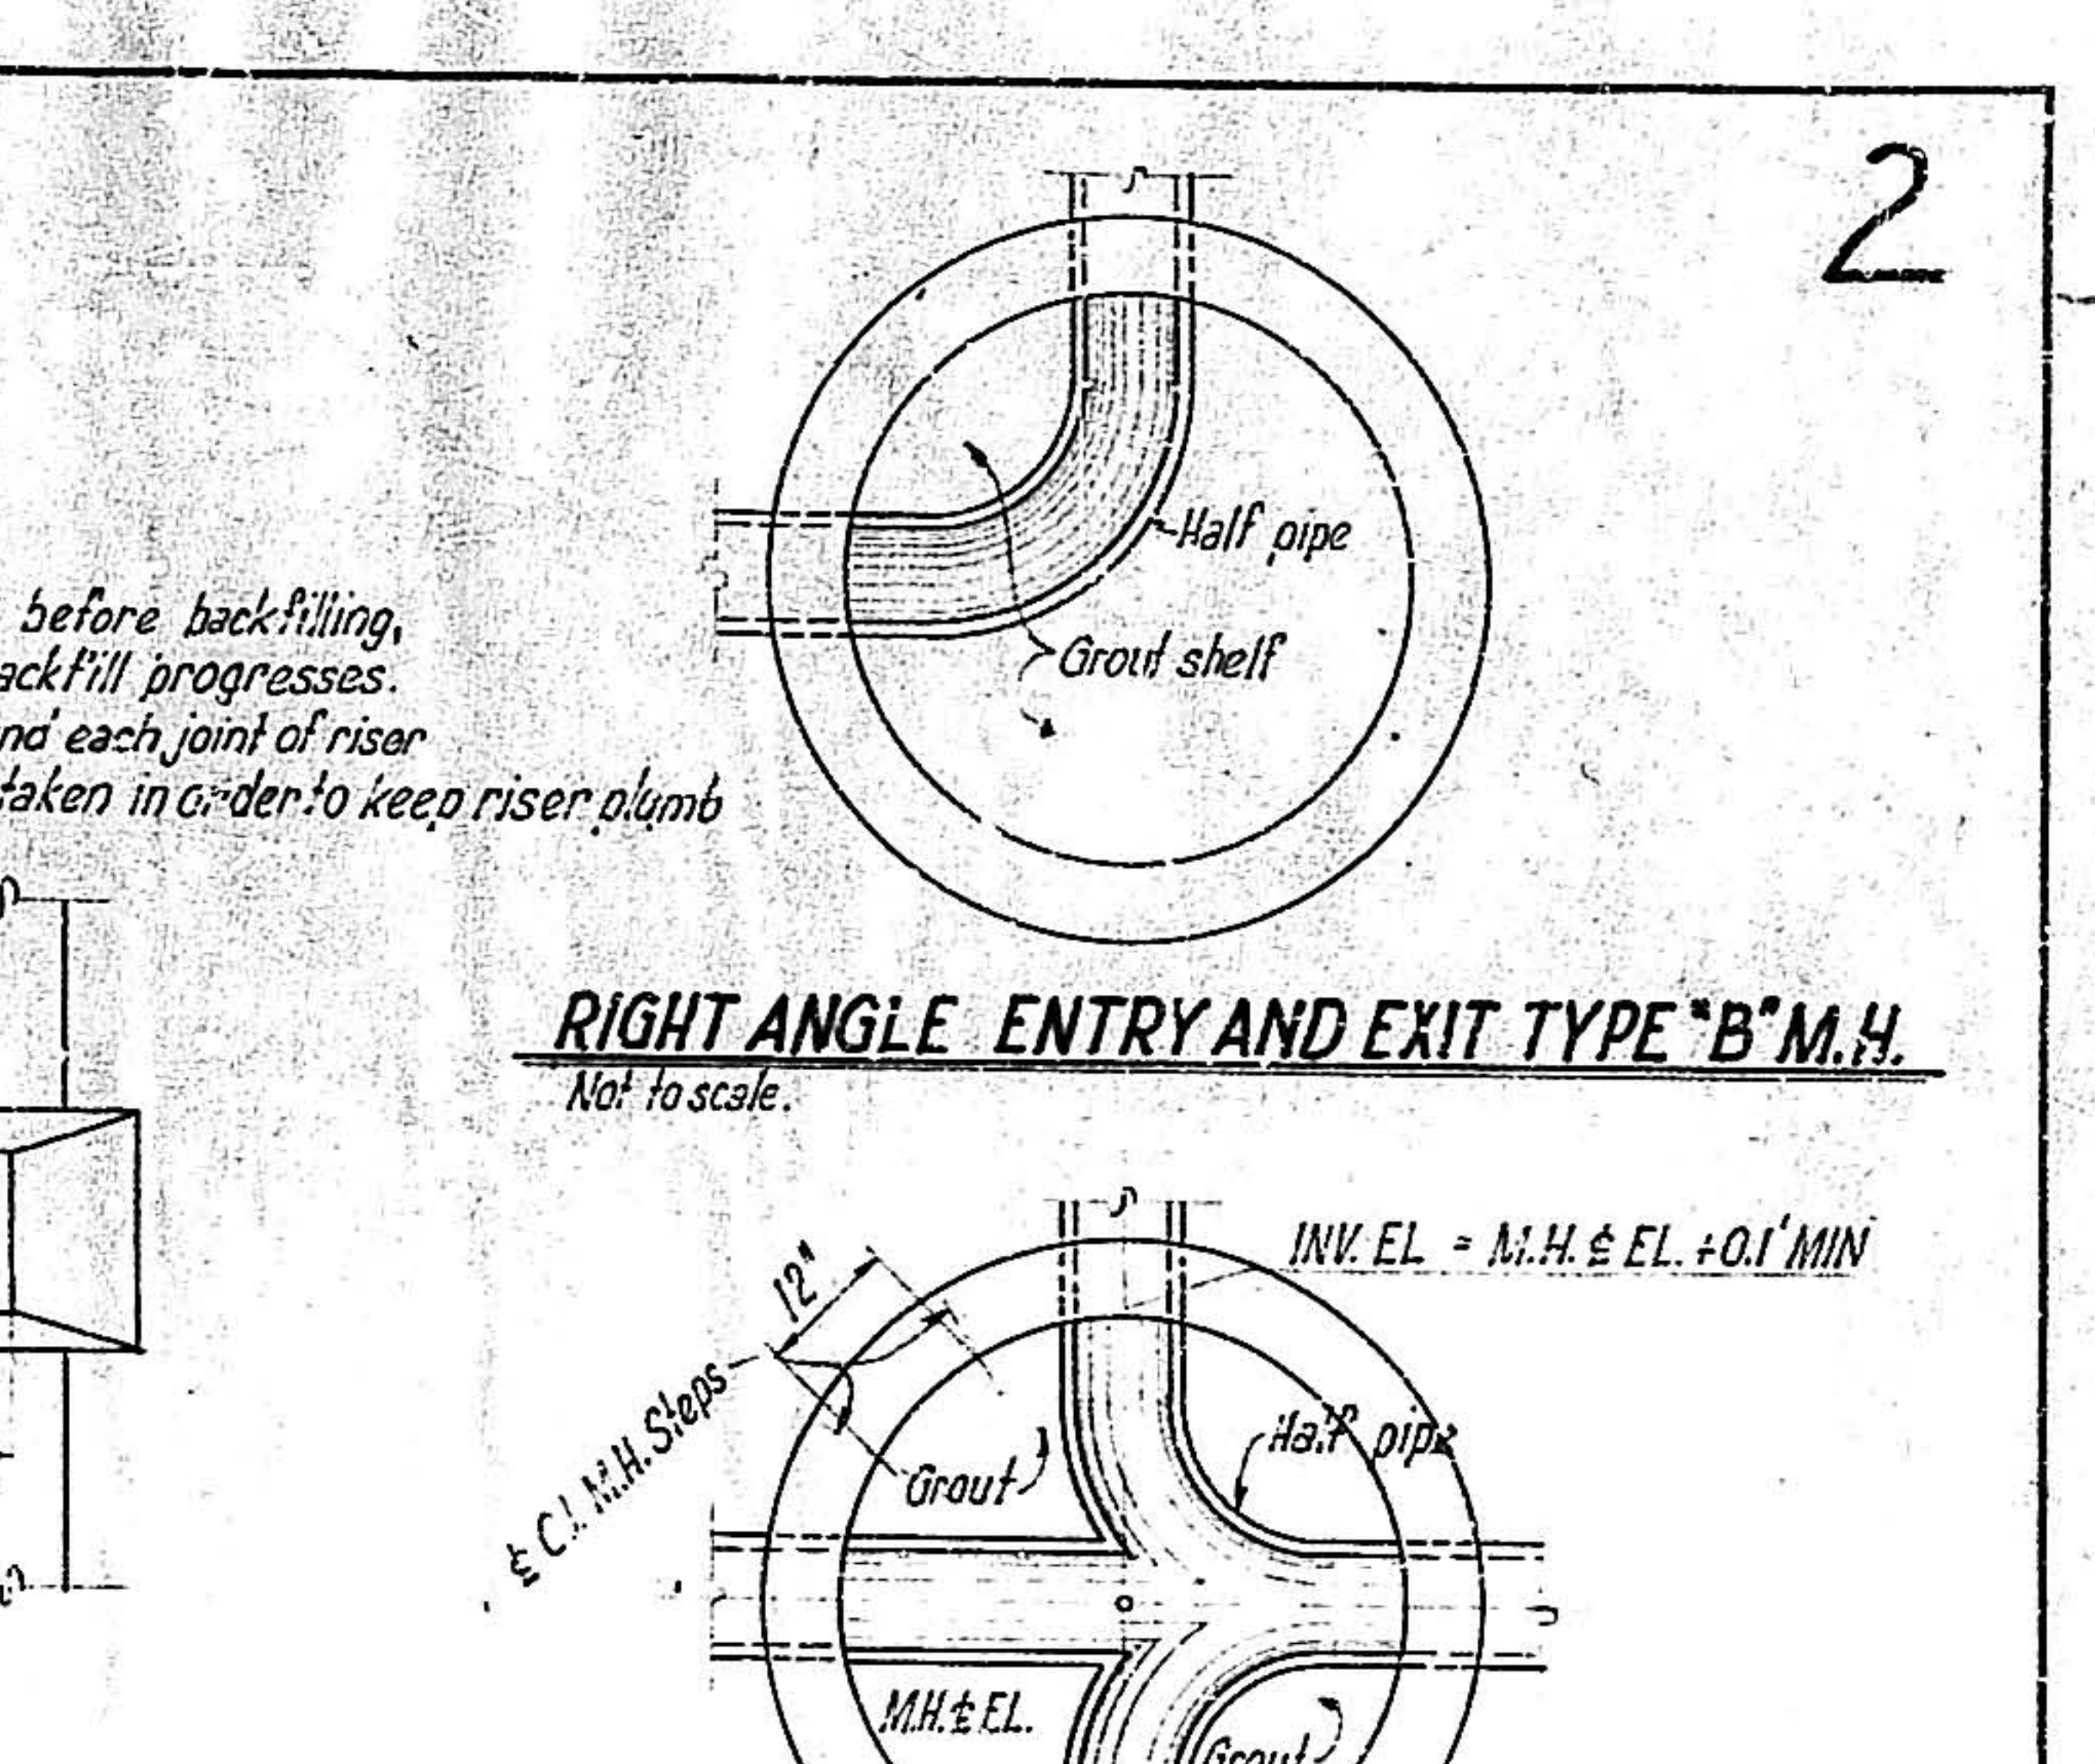


RIGHT ANGLE ENTRY AND EXIT TYPE "B" M.H.
Not to Scale

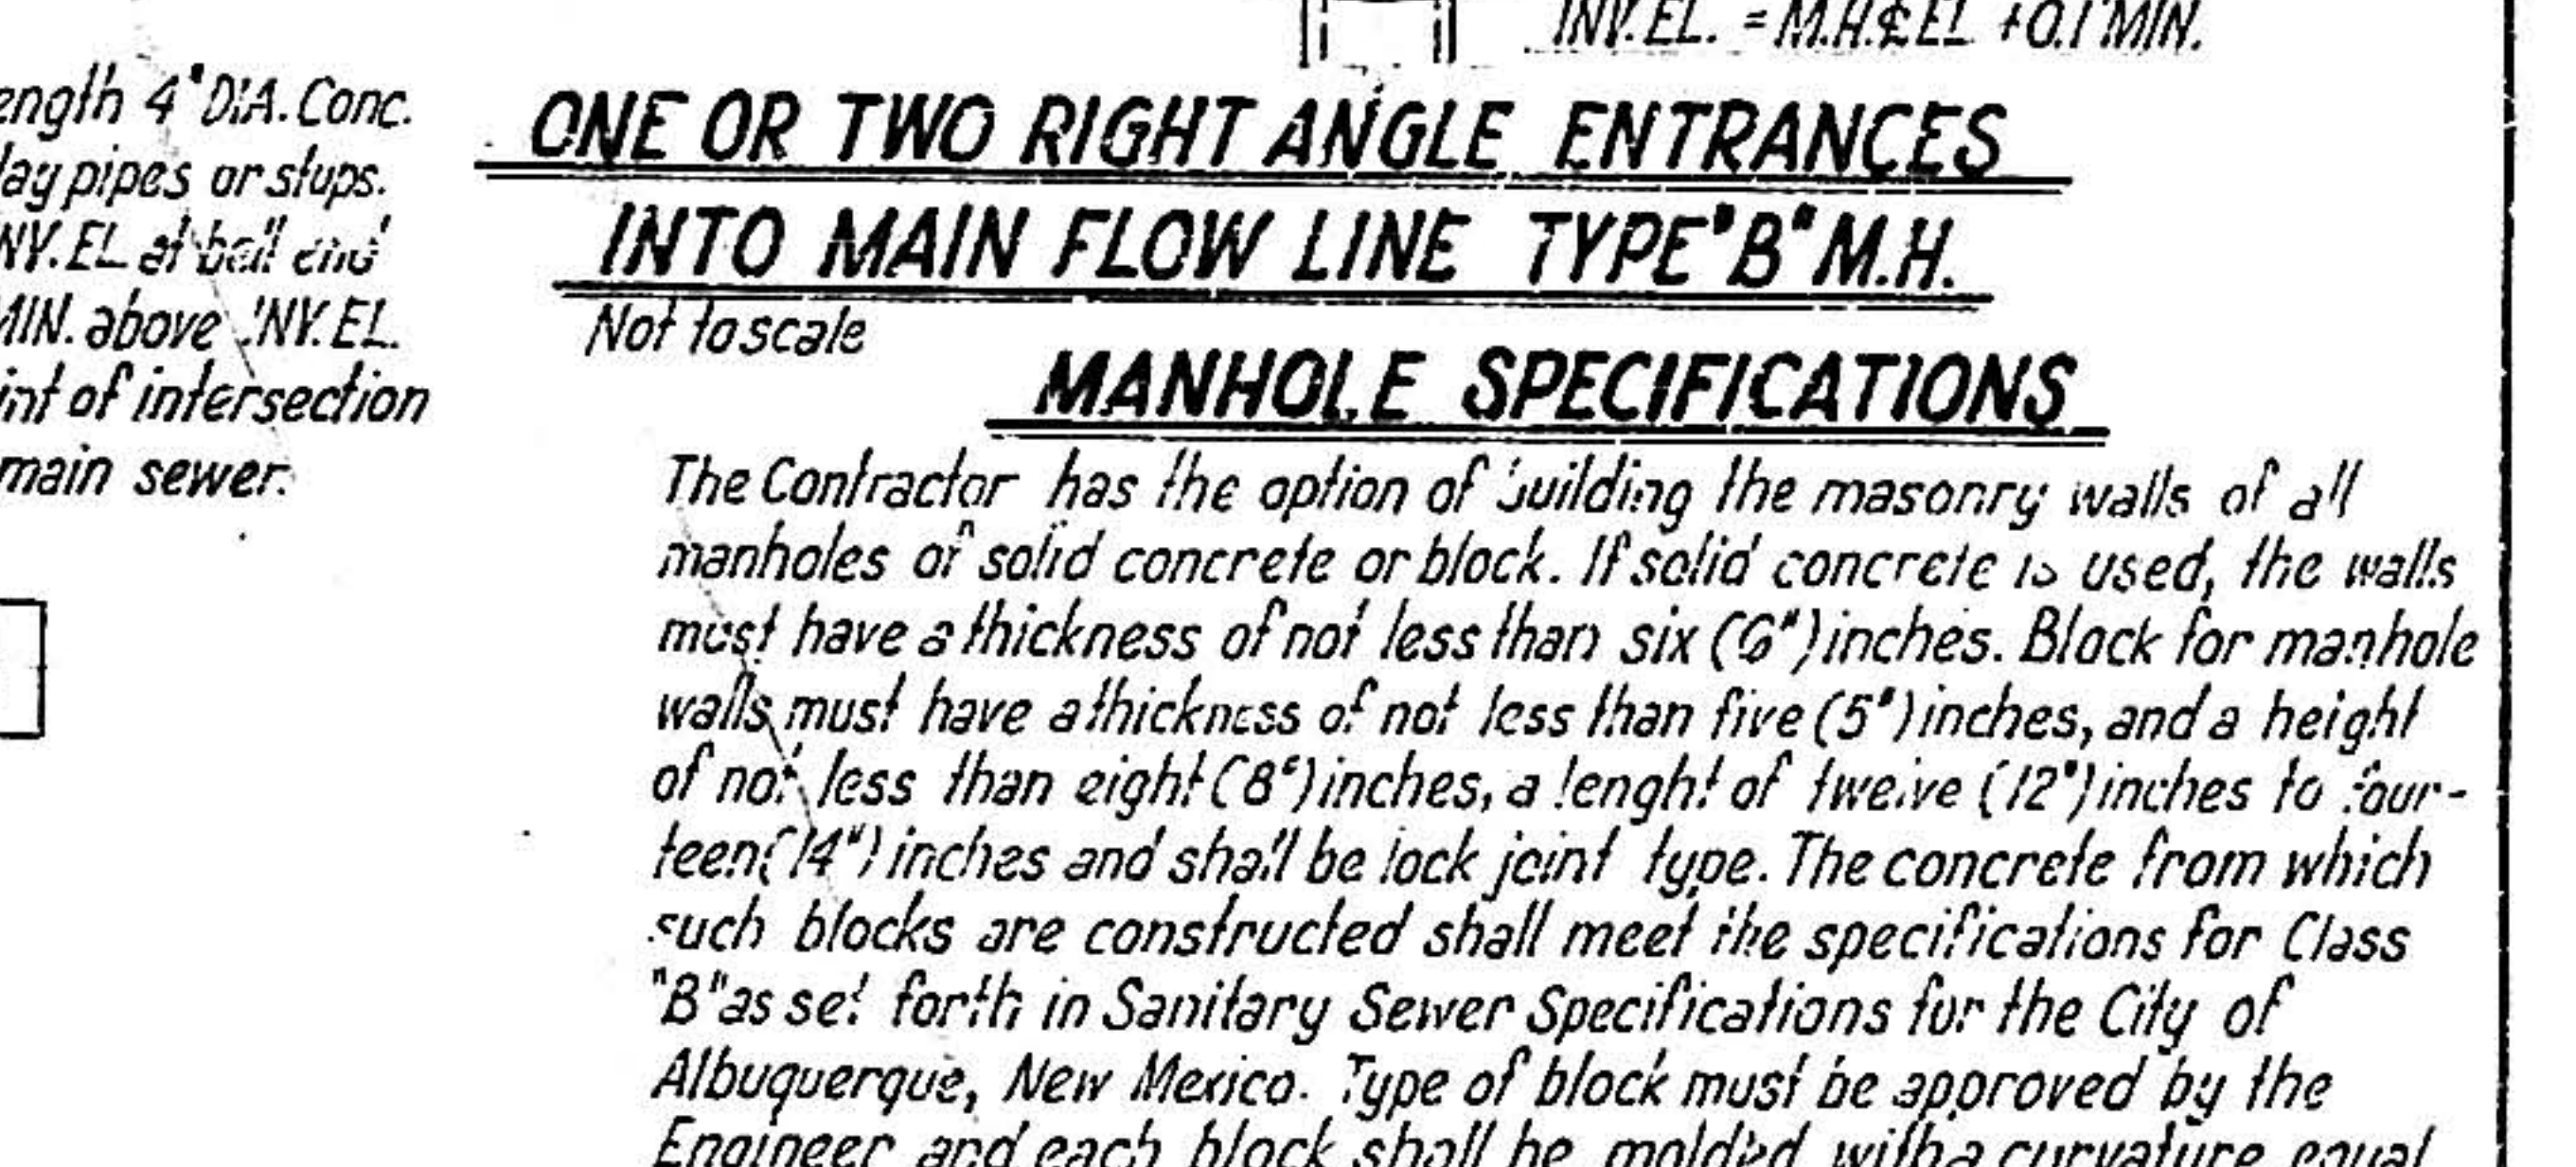

ONE OR TWO RIGHT ANGLE ENTRANCES INTO MAIN FLOW LINE TYPE "B" M.H.
Not to Scale

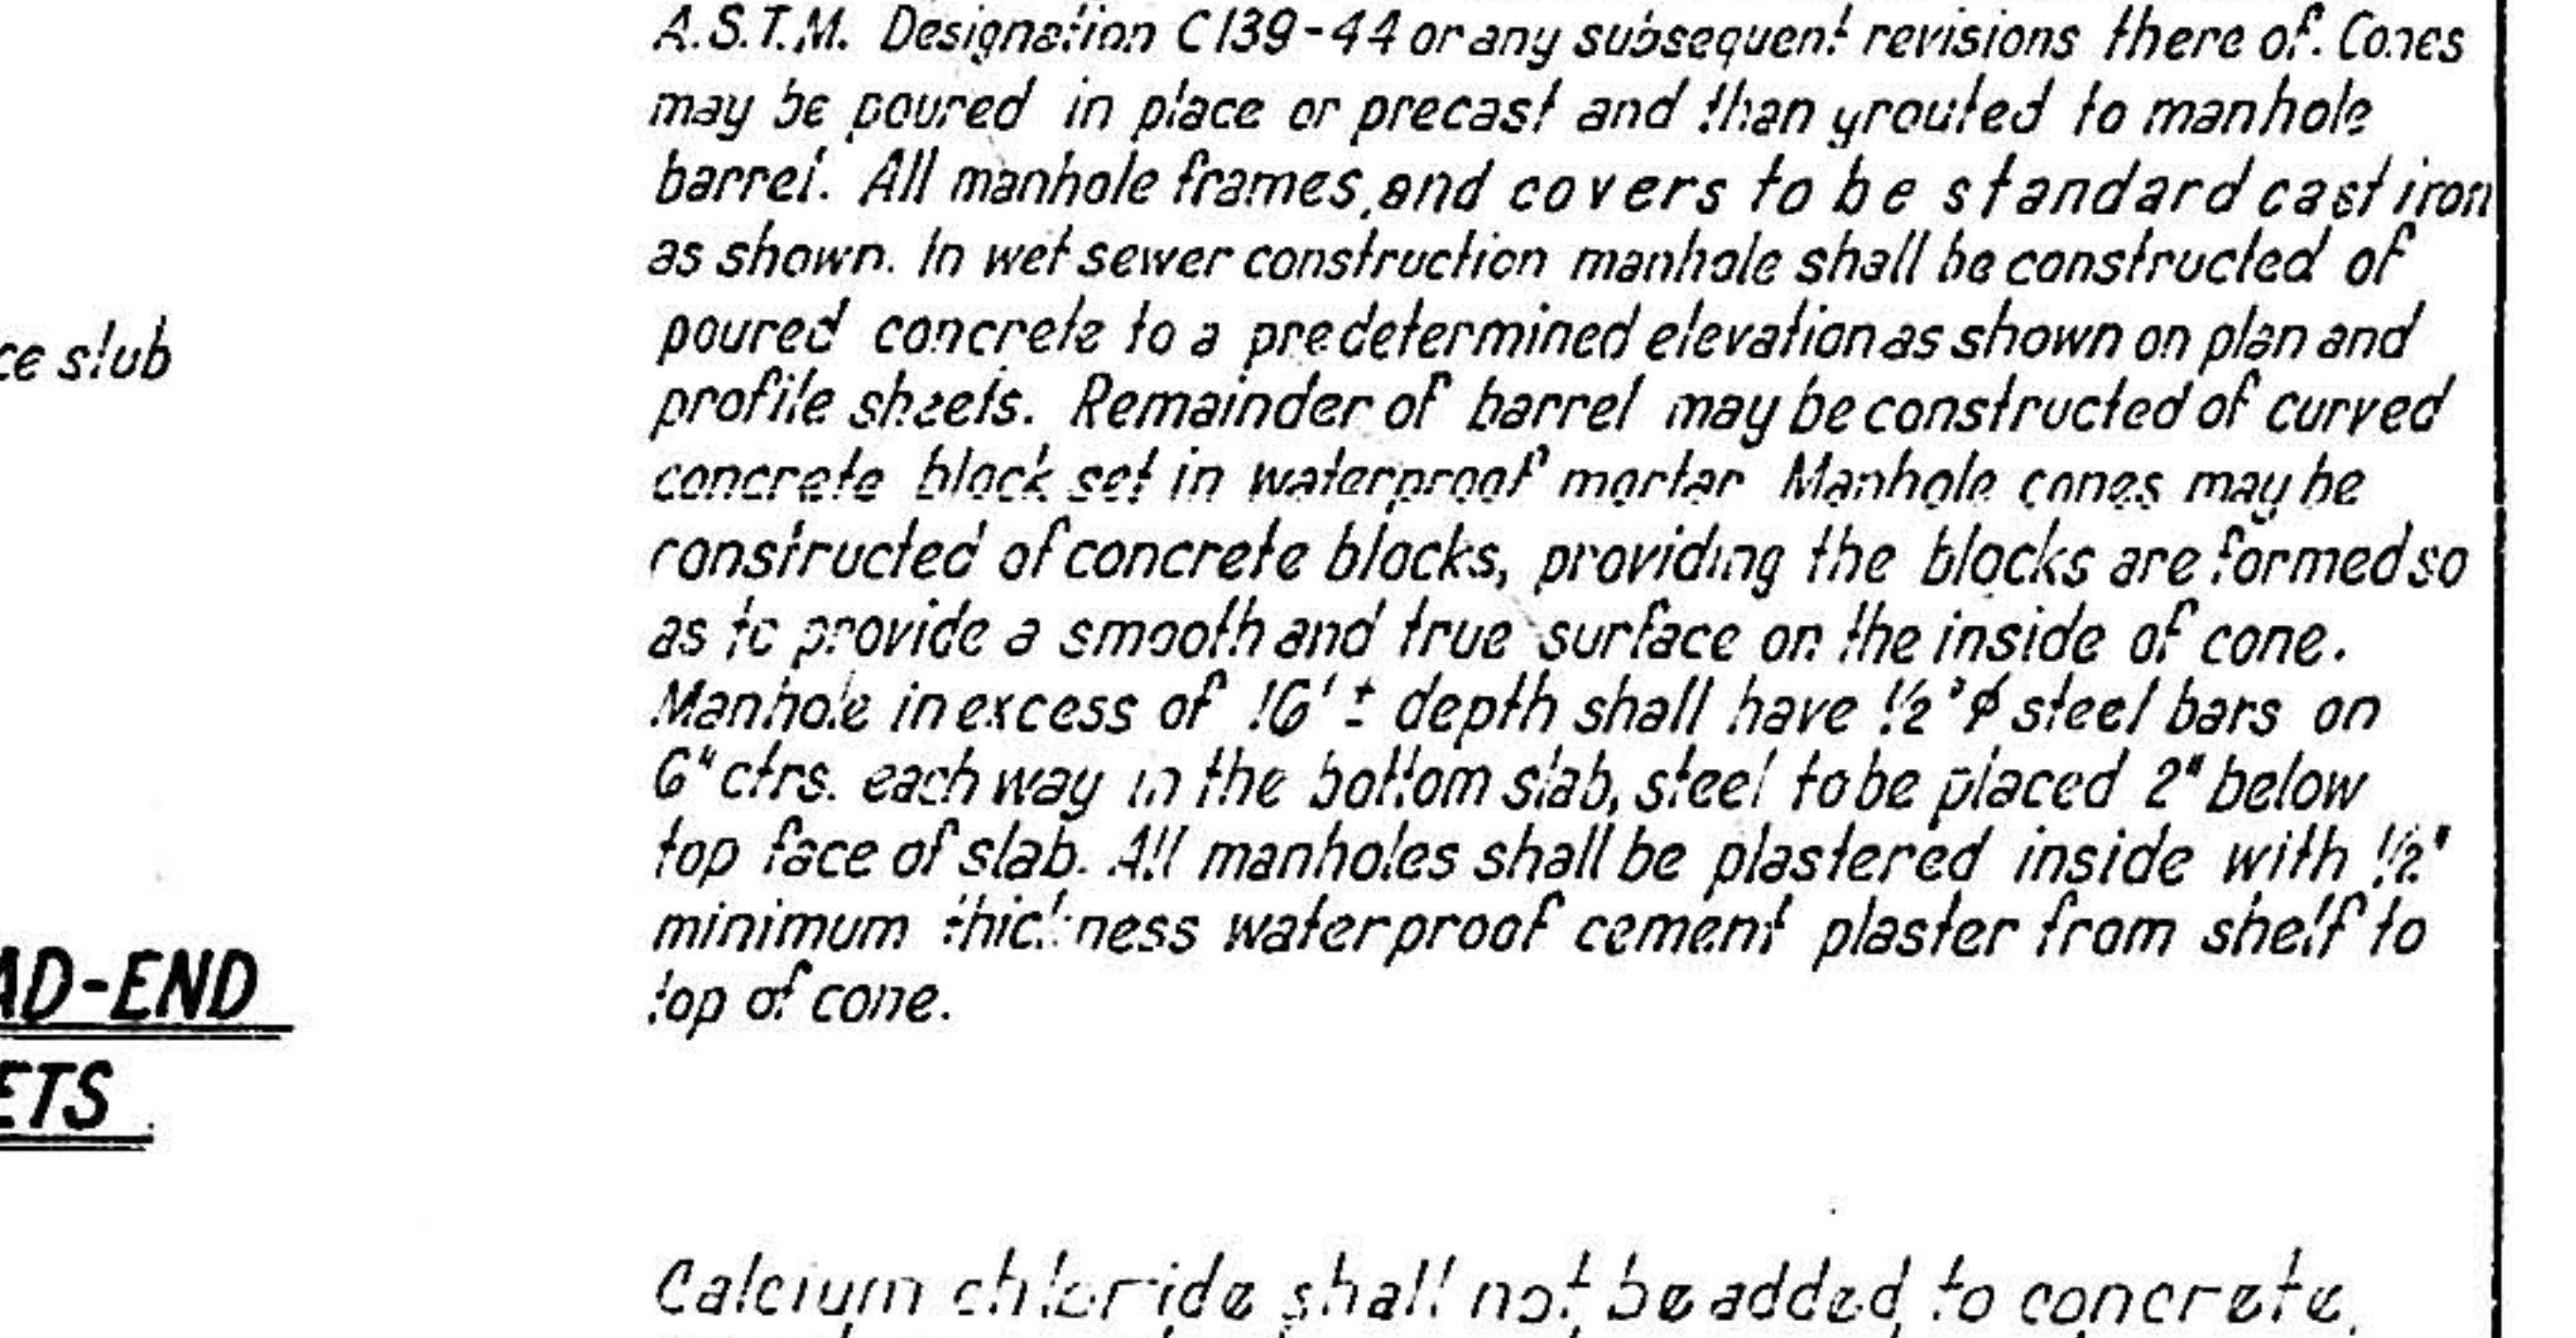

MANHOLE SPECIFICATIONS

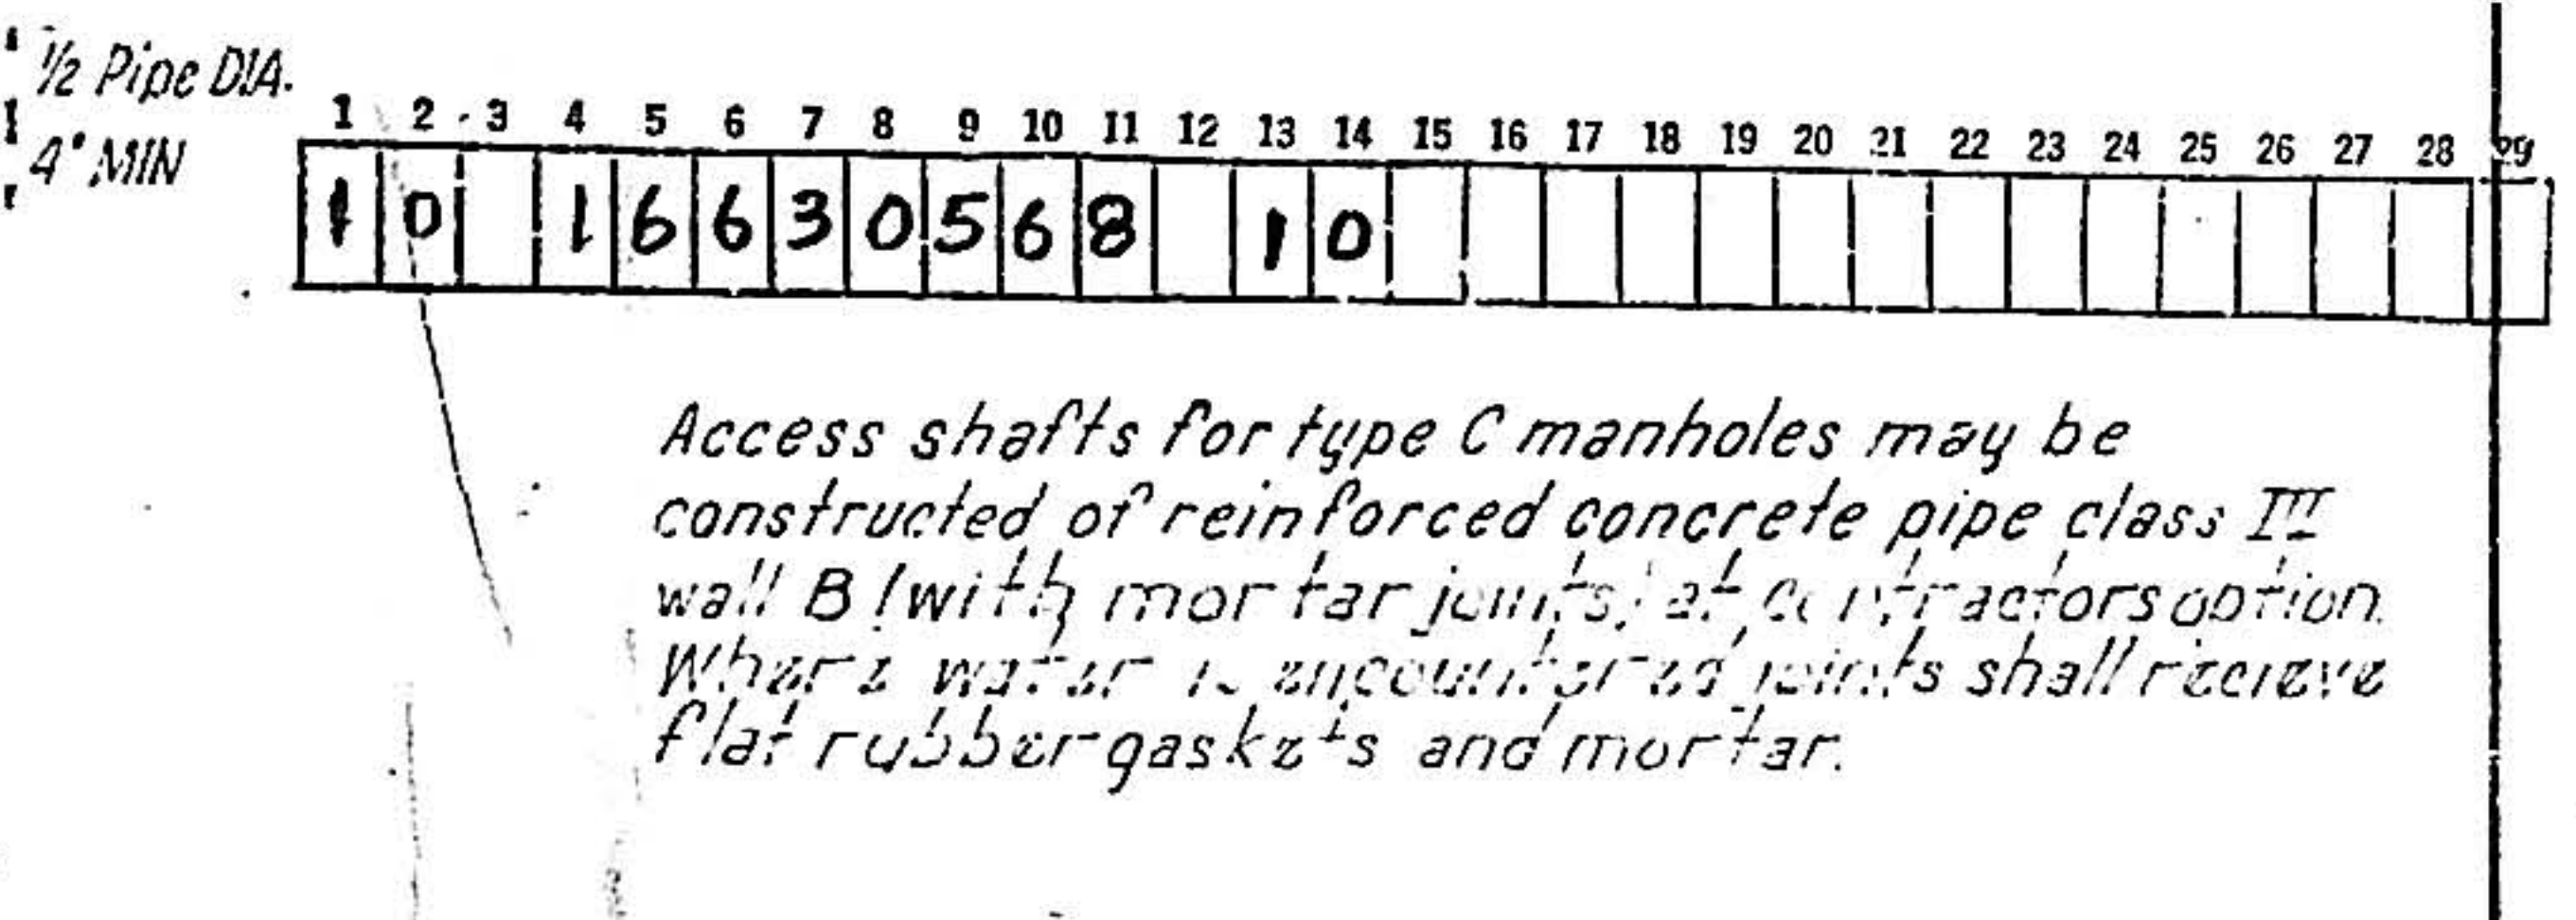

MANHOLE SPECIFICATIONS

ALBUQUERQUE, NEW MEXICO	
SANITARY SEWER STANDARDS	
MANHOLE DETAILS	
GORDON HERKENHOFF & ASSOCIATES, INC.	
CONSULTING ENGINEERS	
ALBUQUERQUE NEW MEXICO	
SCALE	DATE
AS SHOWN	1964
DRAWN: AOH	CHECKED: GAJ
SHEET 5	OF 14

