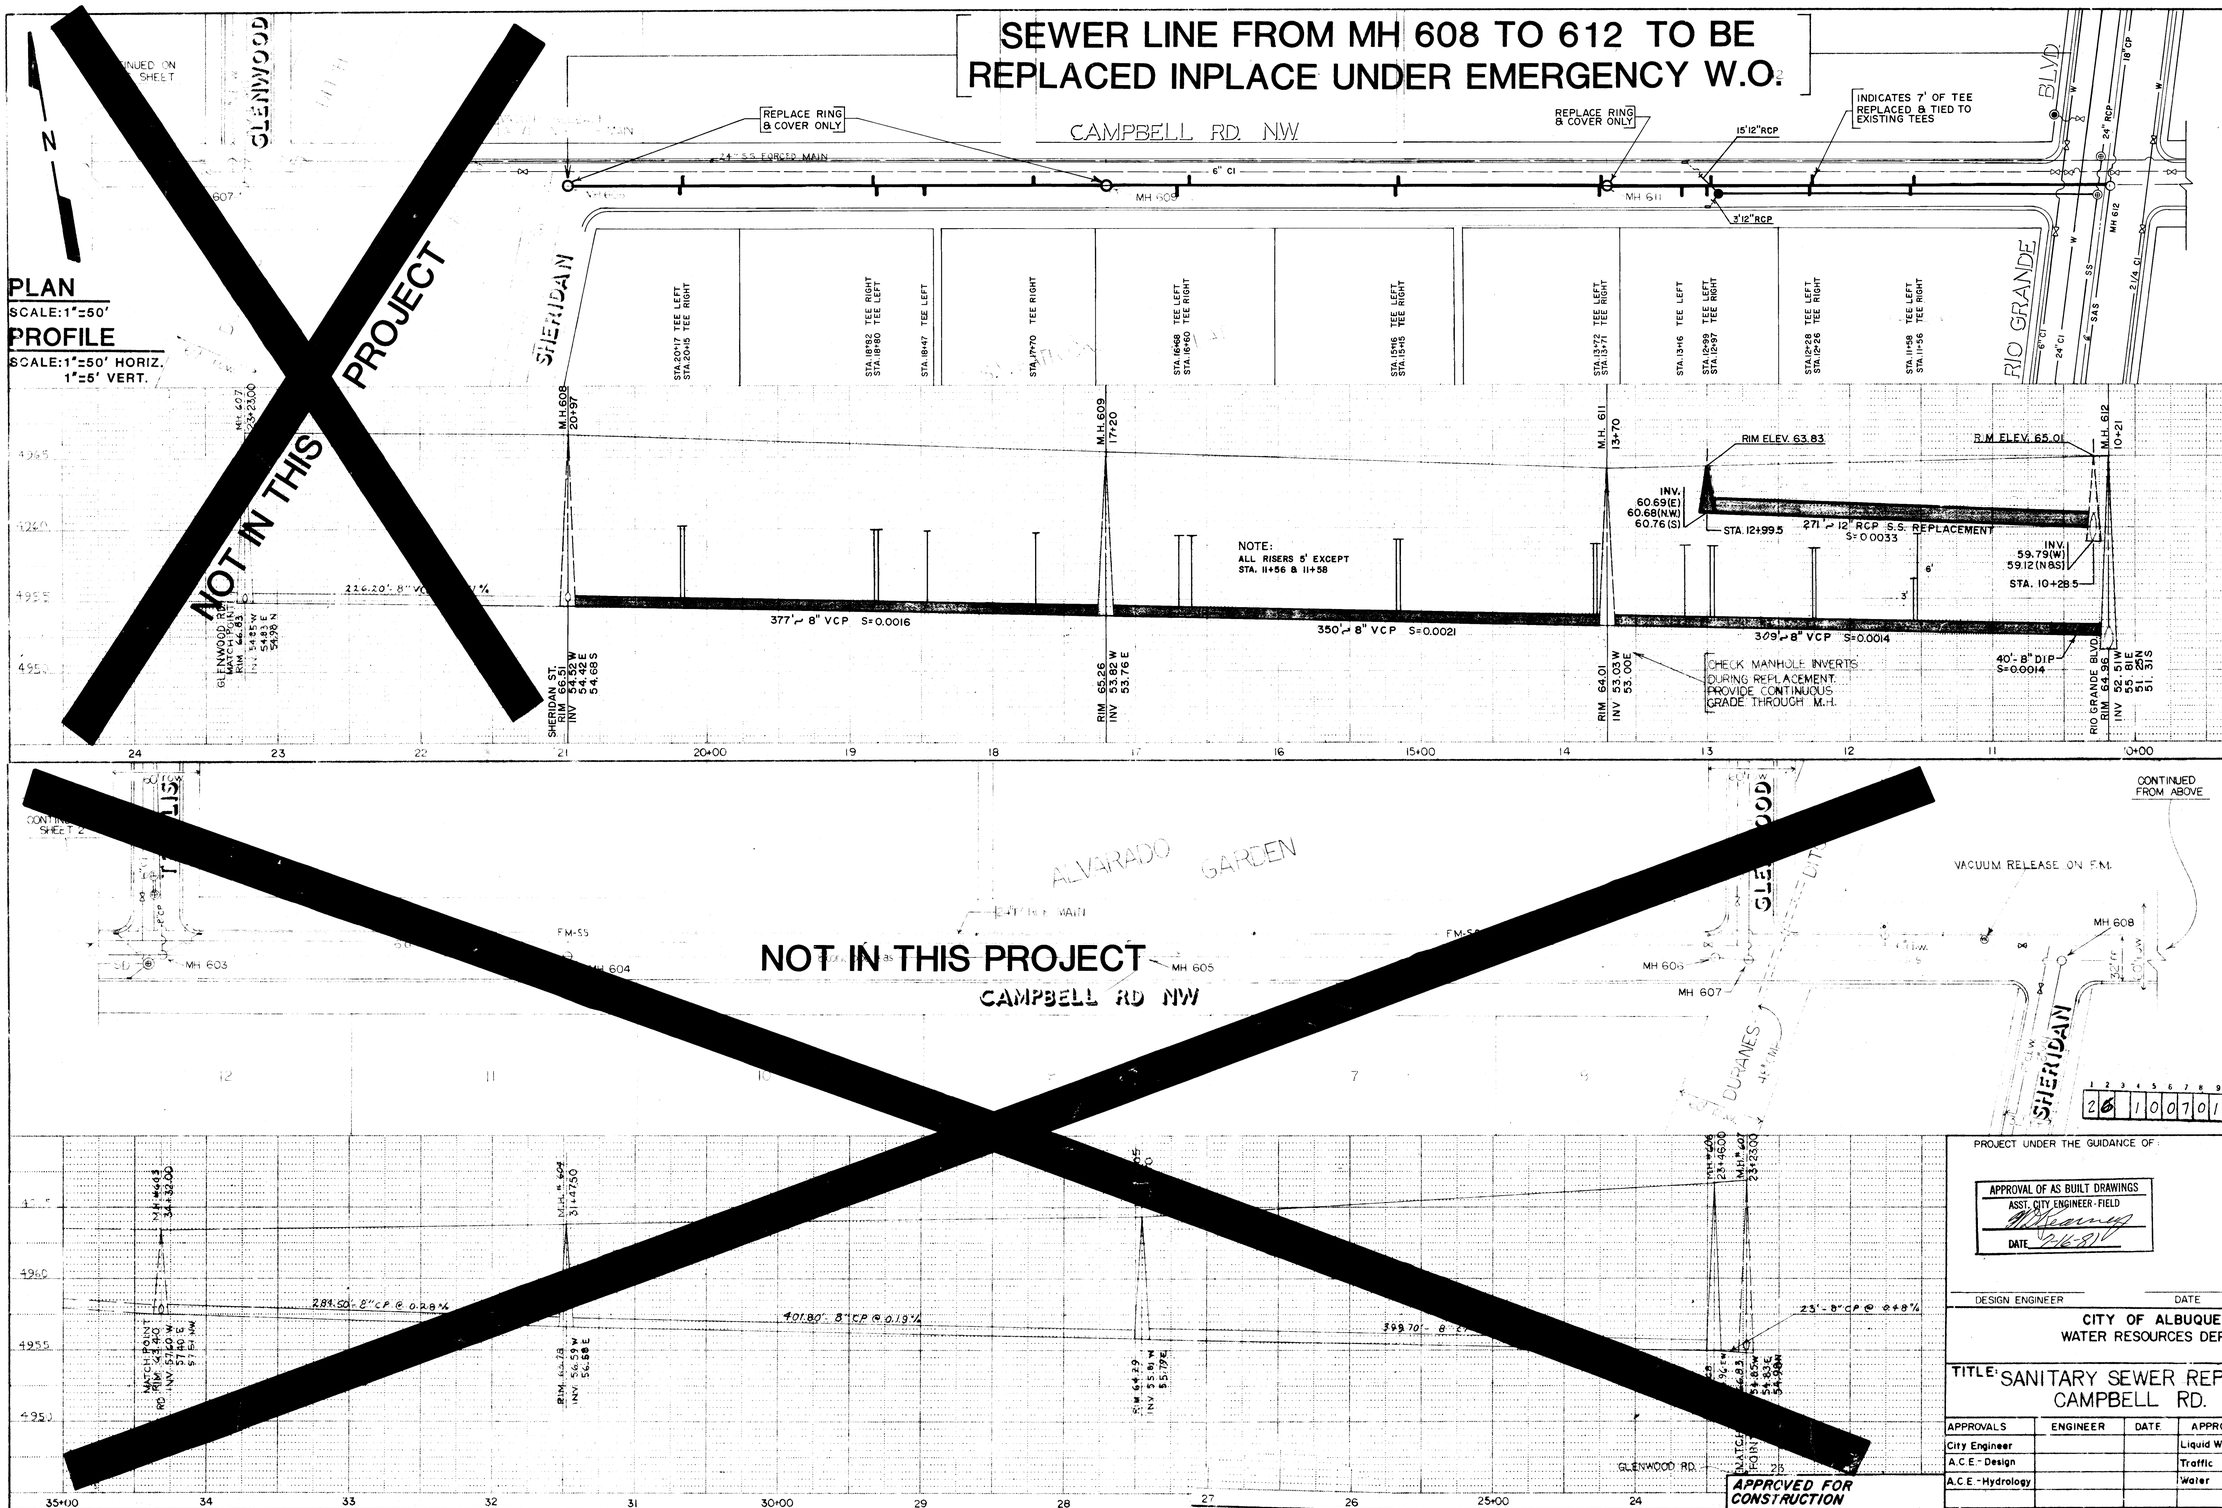
SEWER LINE FROM MH 608 TO 612 TO BE REPLACED INPLACE UNDER EMERGENCY W.O.
NOT IN THIS PROJECT
PLAN
SCALE: 1"=50'
PROFILE
SCALE: 1"=50' HORIZ.
1"=5' VERT.
CAMPBELL RD. NW
SHERIDAN
RIO GRANDE BLVD
GLENWOOD
REPLACE RING & COVER ONLY
INDICATES 7' OF TEE REPLACED & TIED TO EXISTING TEES
15" 12" RCP
3" 12" RCP
24" S.S. FORCED MAIN
6" CI
MH 609
MH 611
MH 612
M.H. 609 20+97
M.H. 609 17+20
M.H. 611 13+70
M.H. 612 10+21
RIM ELEV. 63.83
B.M. ELEV. 65.01
INV. 60.69(E) 60.68(N.W.) 60.76(S)
STA. 12+99.5
271' 12" RCP S.S. REPLACEMENT S=0.0033
INV. 59.79(W) 59.12(N&S)
STA. 10+28.5
NOTE: ALL RISERS 5' EXCEPT STA. 11+56 & 11+58
377' 8" VCP S=0.0016
350' 8" VCP S=0.0021
309' 8" VCP S=0.0014
40' 8" DIP S=0.0014
CHECK MANHOLE INVERTS DURING REPLACEMENT. PROVIDE CONTINUOUS GRADE THROUGH M.H.
SHERIDAN ST. RIM 66.53 INV 55.51 W 54.42 E 54.68 S
RIM 65.26 INV 53.82 W 53.76 E
RIM 64.01 INV 53.03 W 53.00 E
RIO GRANDE BLVD RIM 64.96 INV 52.51 W 55.81 E 51.20 N 51.31 S
STA. 20+17 TEE LEFT STA. 20+15 TEE RIGHT
STA. 18+92 TEE RIGHT STA. 18+90 TEE LEFT
STA. 18+47 TEE LEFT
STA. 17+70 TEE RIGHT
STA. 16+48 TEE LEFT STA. 16+60 TEE RIGHT
STA. 15+16 TEE LEFT STA. 15+15 TEE RIGHT
STA. 13+72 TEE LEFT STA. 13+71 TEE RIGHT
STA. 13+16 TEE LEFT
STA. 12+99 TEE LEFT STA. 12+97 TEE RIGHT
STA. 12+28 TEE LEFT STA. 12+26 TEE RIGHT
STA. 11+58 TEE LEFT STA. 11+56 TEE RIGHT
NOT IN THIS PROJECT
ALVARADO GARDEN
CAMPBELL RD NW
MH 603
MH 604
MH 605
MH 606
MH 607
MH 608
VACUUM RELEASE ON F.M.
CONTINUED FROM ABOVE
GLENWOOD RD.
SHERIDAN
284.50' 8" CP @ 0.28%
401.80' 8" CP @ 0.19%
23' 8" CP @ 0.8%
APPROVED FOR CONSTRUCTION
CHIEF ENGINEER, WRD DATE
PROJECT UNDER THE GUIDANCE OF:
APPROVAL OF AS BUILT DRAWINGS
ASST. CITY ENGINEER-FIELD
DATE 2-16-81
DESIGN ENGINEER DATE
CITY OF ALBUQUERQUE
WATER RESOURCES DEPARTMENT
TITLE: SANITARY SEWER REPLACEMENT CAMPBELL RD. N.W.
APPROVALS ENGINEER DATE APPROVALS ENGINEER DATE
City Engineer
A.C.E.-Design
A.C.E.-Hydrology
Liquid Waste
Traffic
Water
DRAWING NO. 1007
SHEET 1 OF 1
AS BUILT INFORMATION
CONTRACTOR: KENT NOWLIN
WORK STAKED BY
INSPECTORS
ACCEPTANCE BY B. ROMERO DATE 3-81
VERIFICATION BY
DRAWINGS CORRECTED BY L. KASPER DATE 4-81
MICRO-FILM INFORMATION
RECORDED BY DATE
NO.
BENCH MARKS
BM 2-G12 TOP OF CURB S. RET. S.E. CORNER OF RIO GRANDE & CAMPBELL RD. NW. EL. 4964.98
SURVEY INFORMATION
FIELD NOTES
NO. BY DATE
PS 16 ANGEL, J. LUJAN 12-10-80
J. GARCIA
REFERENCES
MAP NO. G-11
EST. NO.
W.O. NO.
REMARKS
REVISIONS
NO. DATE BY
DESIGN
DESIGNED BY RECORD DWG. DATE 12-29-80
DRAWN BY J.F.K., A.T.O. DATE
CHECKED BY DATE