


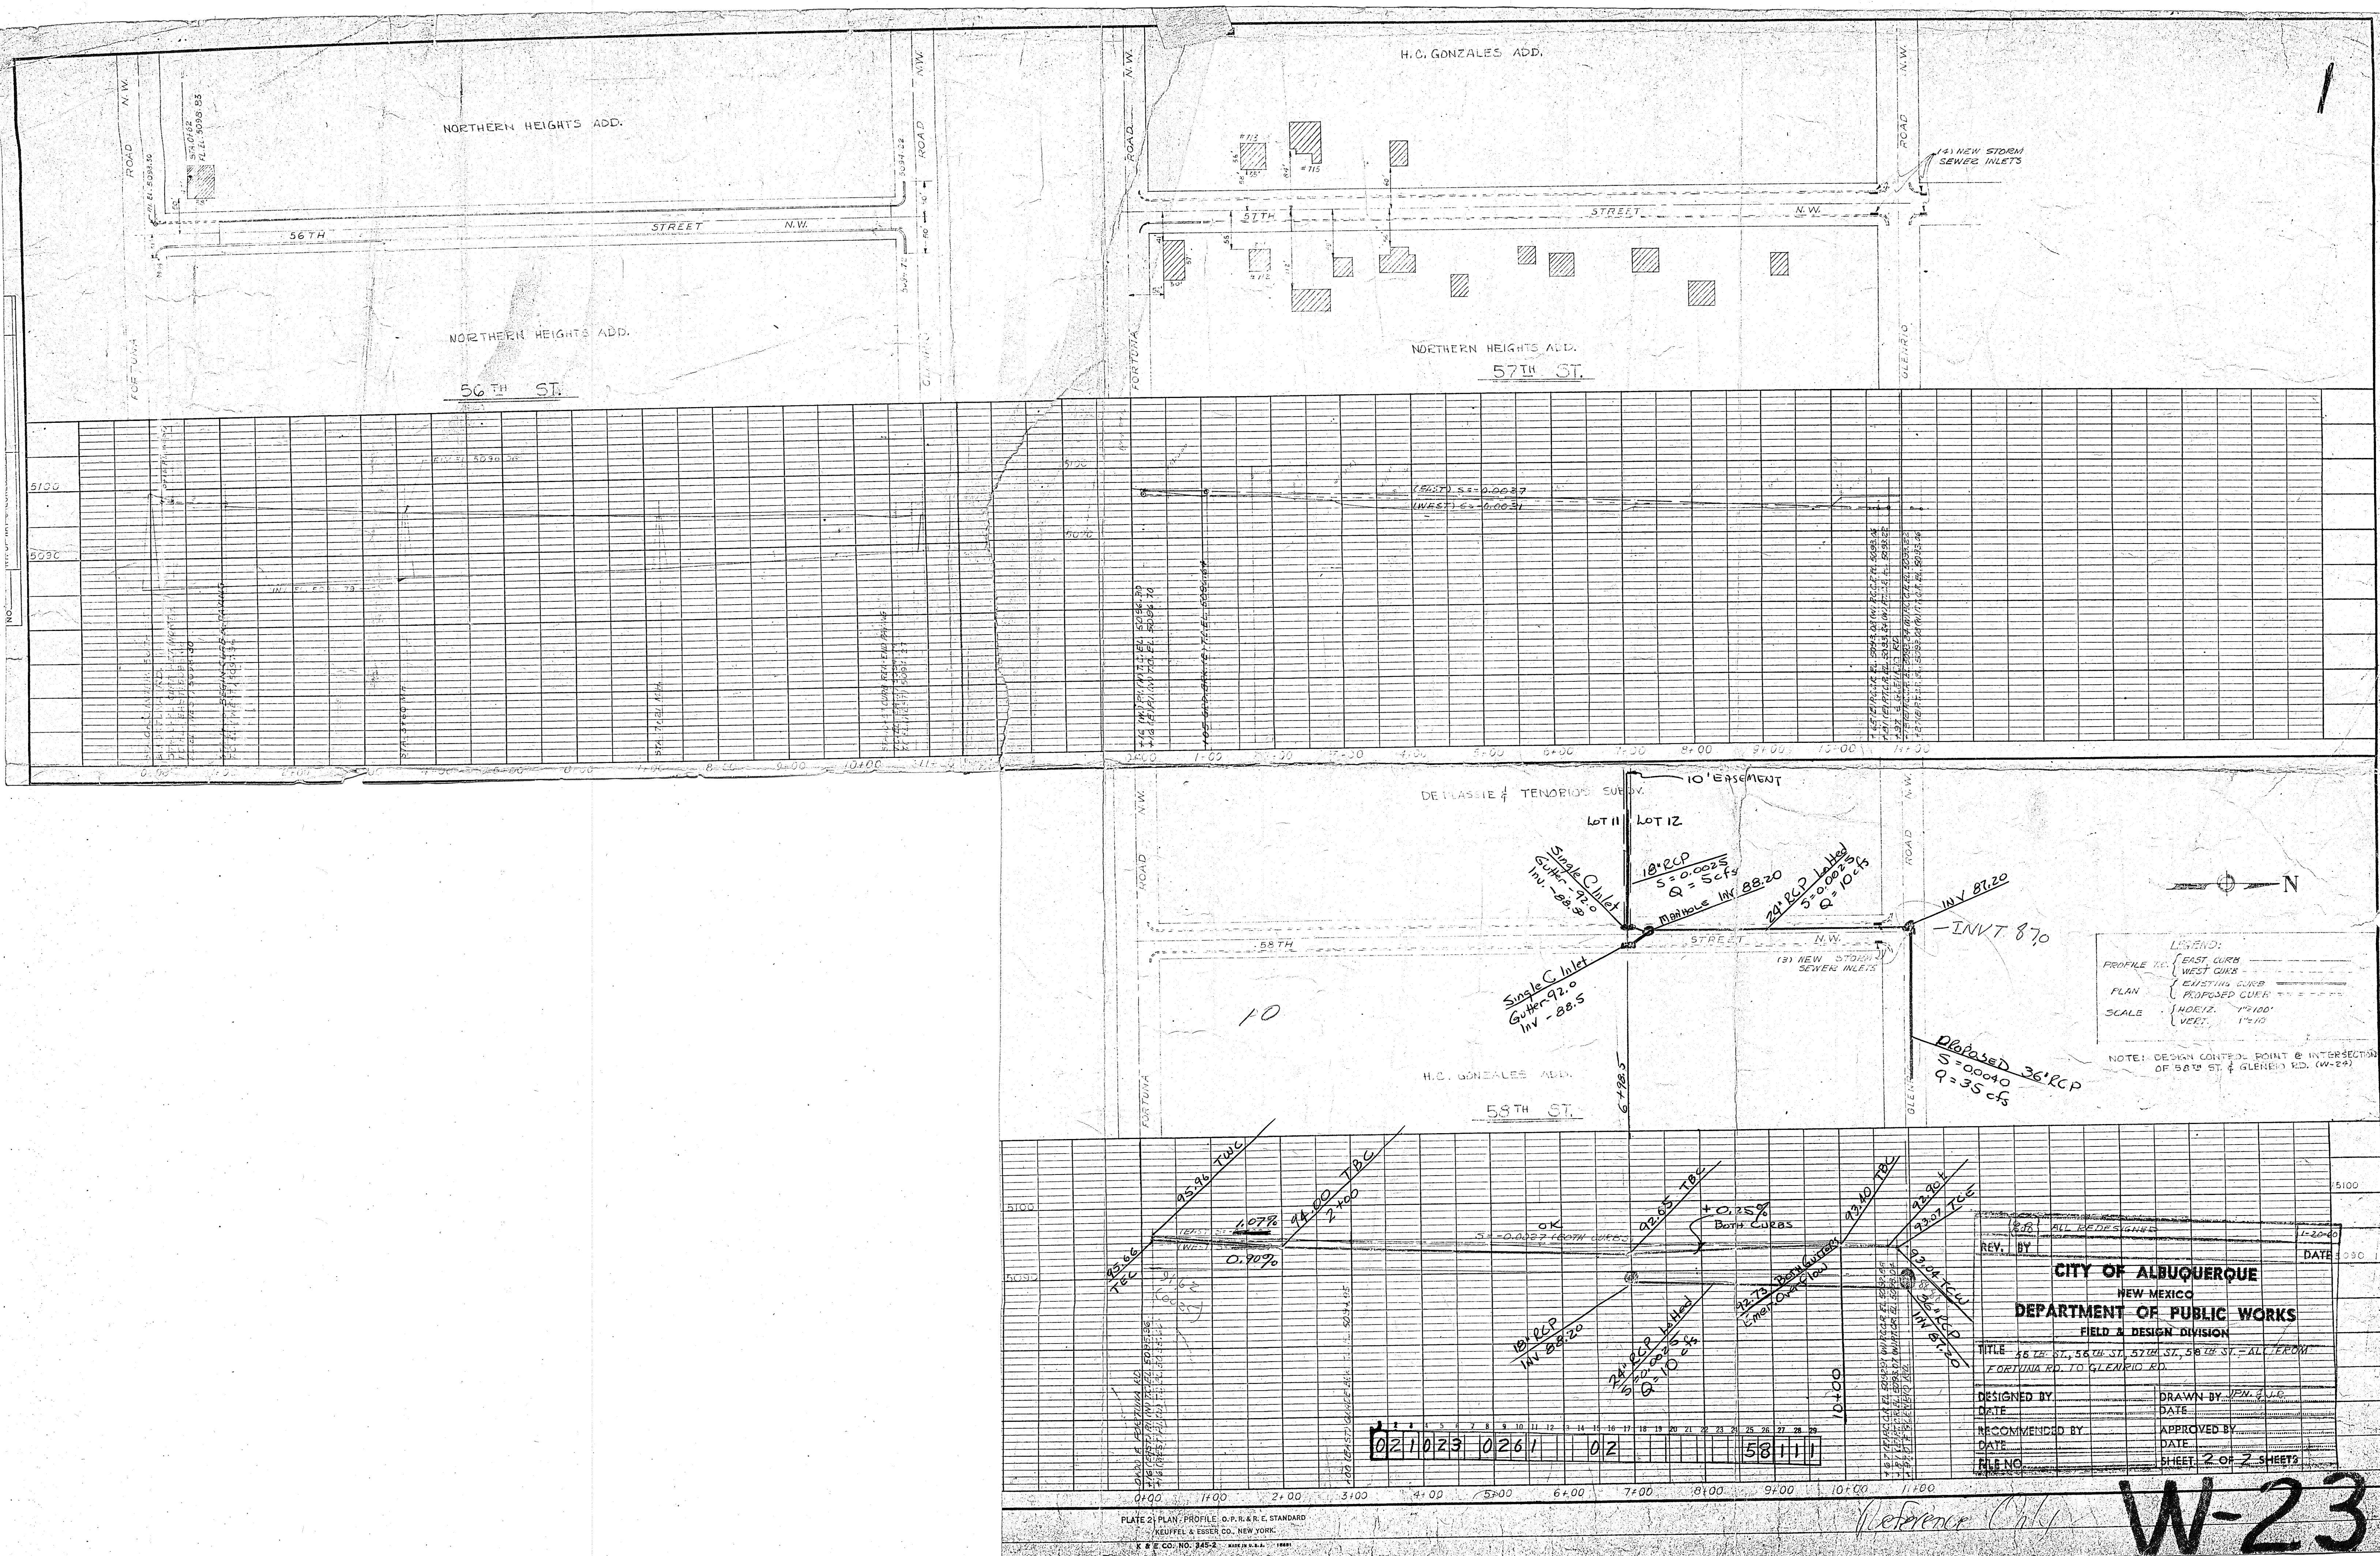

Reference Only
W-23