


PLAN	SURVEYED	DATE
	BY	
	ALIGNED	
	NOTE BOOK	
	NO.	

PROFILE	SURVEYED	DATE
	BY	
	GRADES CHECKED	
	NOTE BOOK	
	NO.	

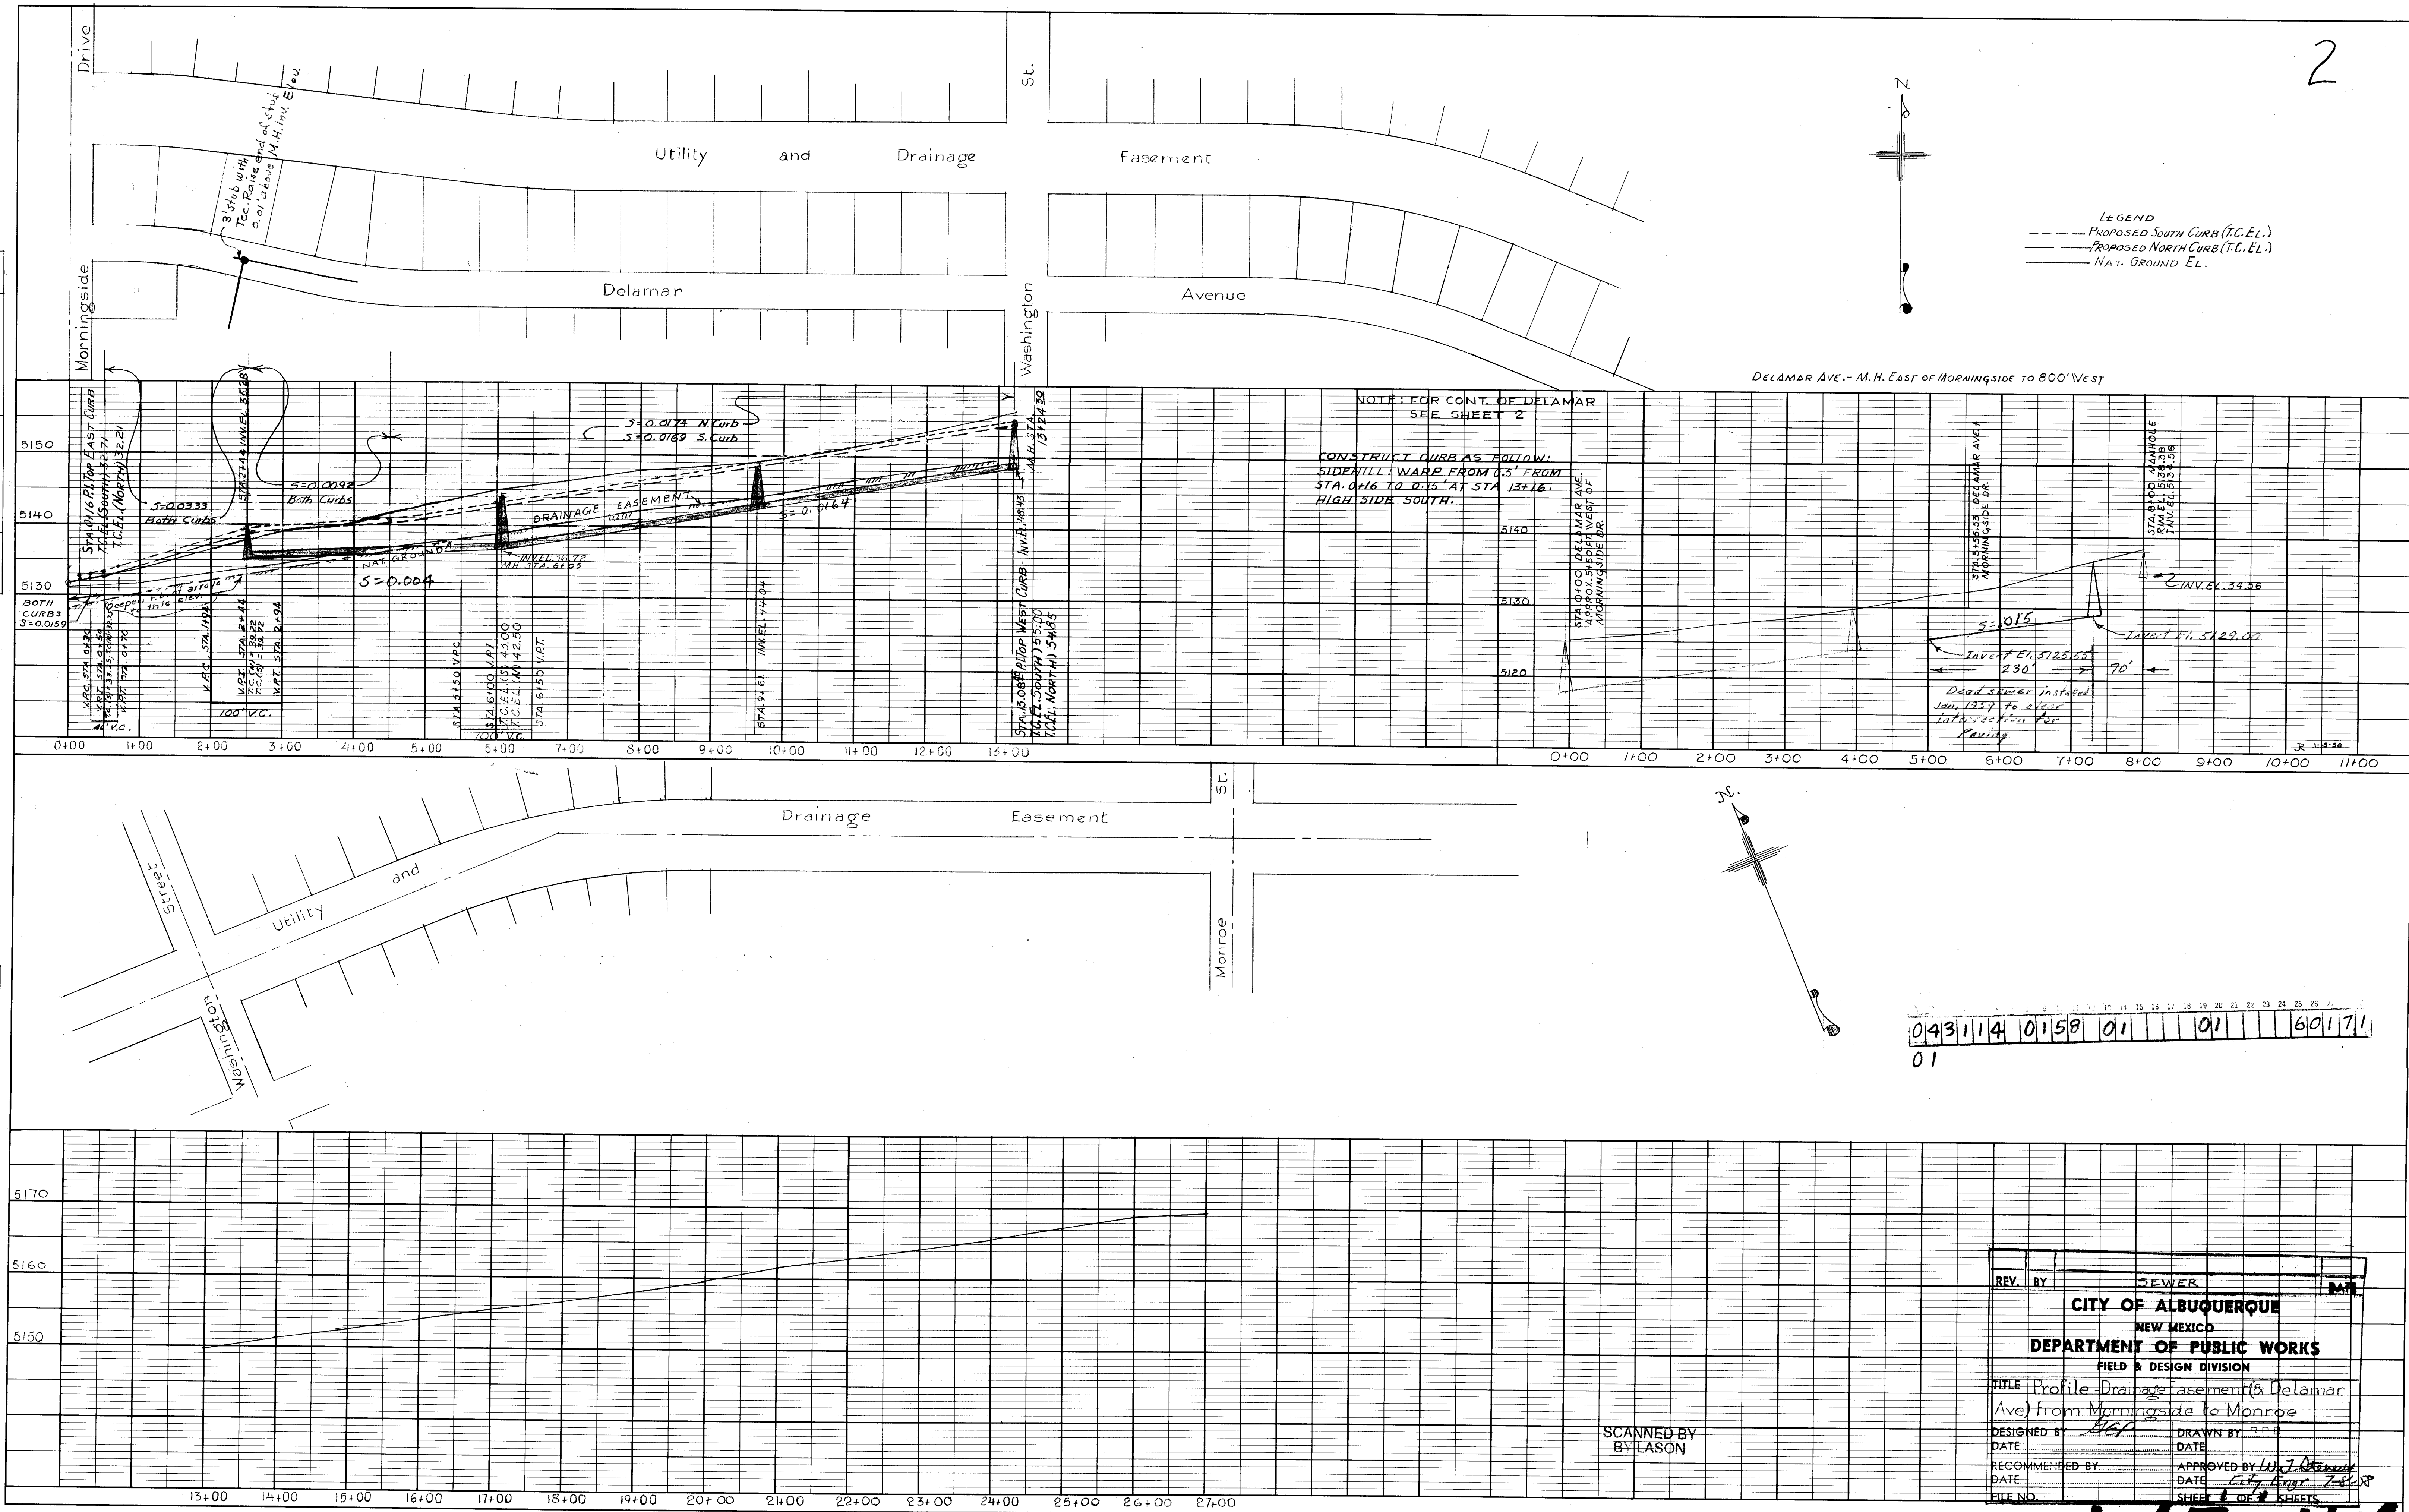

REV.	BY	SEWER	DATE
CITY OF ALBUQUERQUE NEW MEXICO DEPARTMENT OF PUBLIC WORKS FIELD & DESIGN DIVISION			
TITLE: Profile Drainage Easement (8' Delamar Ave) from Morningside to Monroe			
DESIGNED BY	DATE	DRAWN BY	DATE
RECOMMENDED BY	DATE	APPROVED BY	DATE
FILE NO.	SHEET 1 OF 1 SHEETS		

ME-114