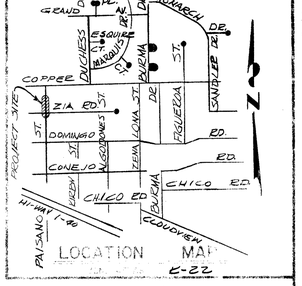

LA CUESTA ADDITION

SEWER EXTENSION ON PAISANO ST. NORTH OF ZIA RD.

INDEX

1. TITLE SHEET
2. PLAN & PROFILE

APPROVAL OF AS BUILT DRAWINGS
CITY ENGINEER - FIELD
DATE

Richard S. Heller 10/2/87	1193	SHEET 1 2