
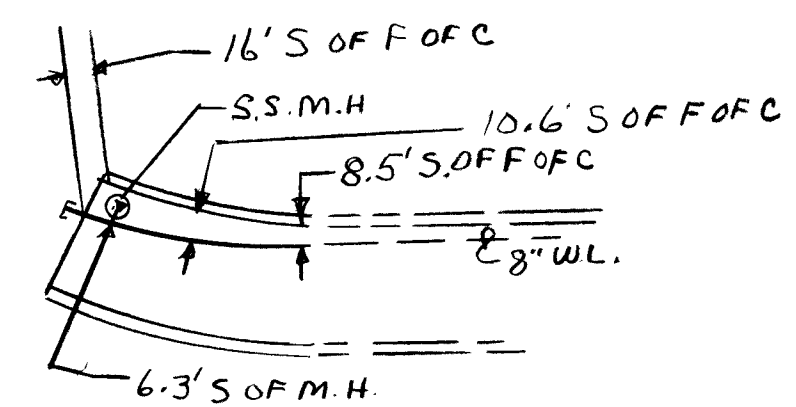
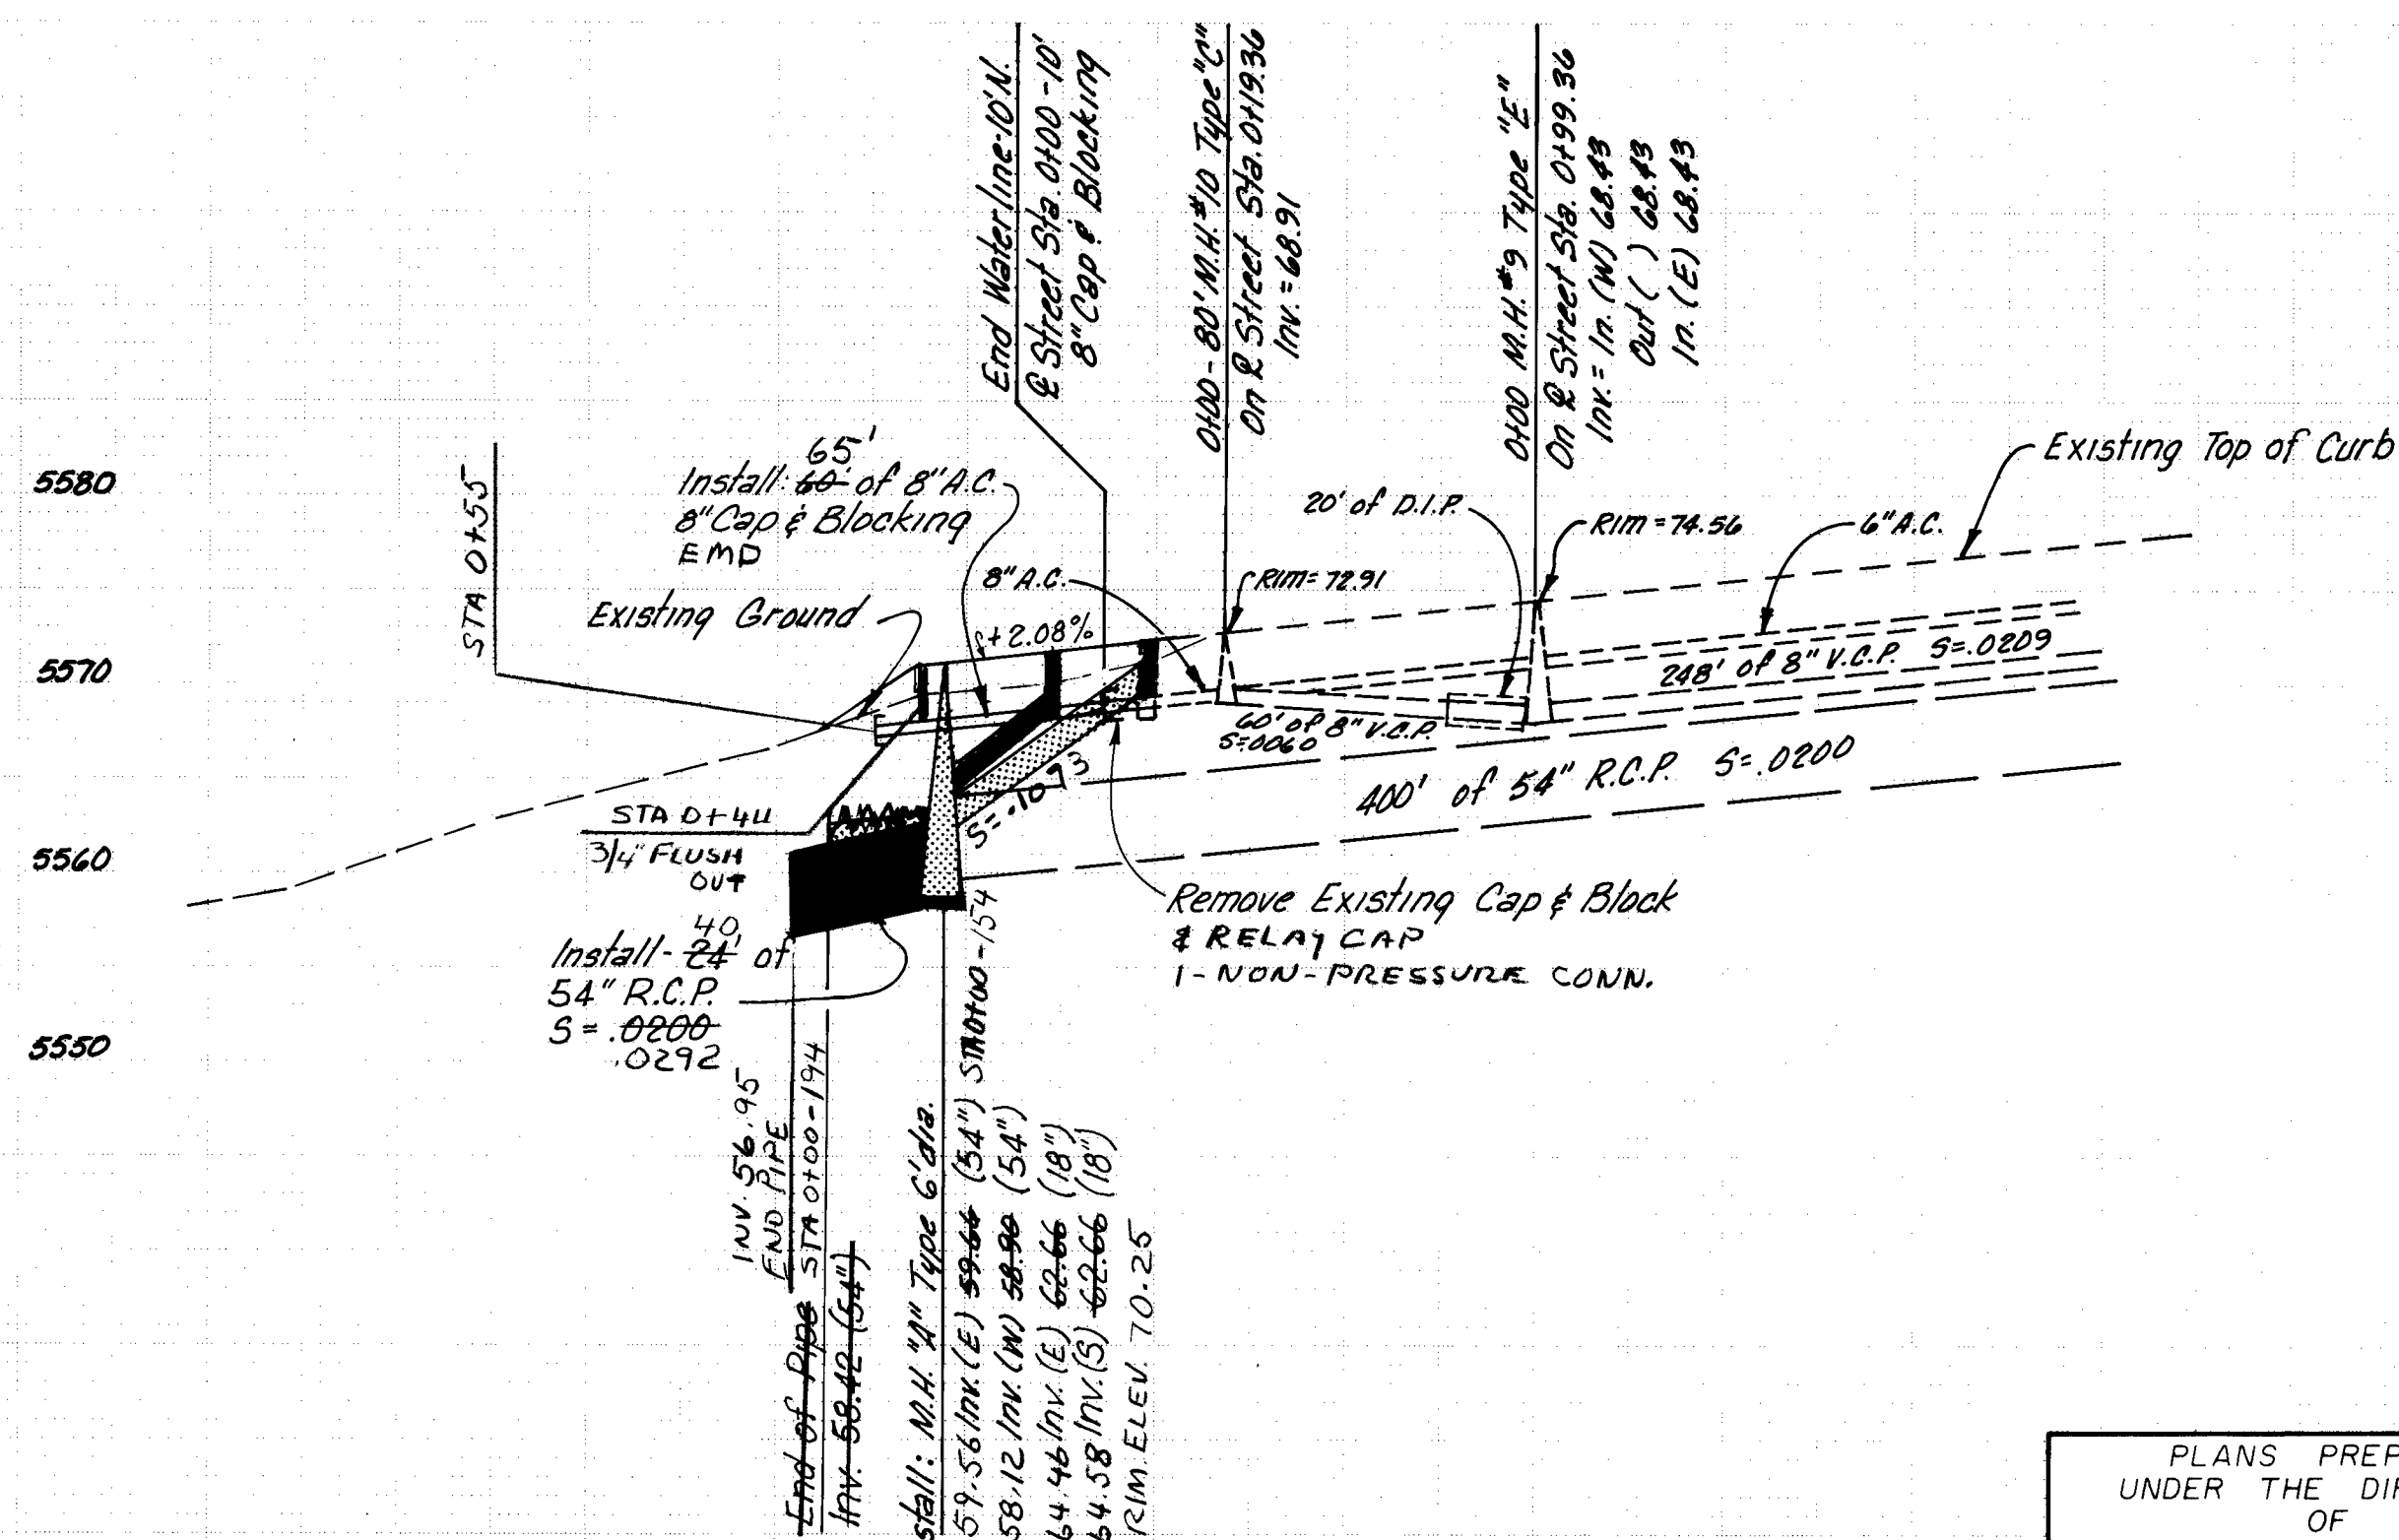
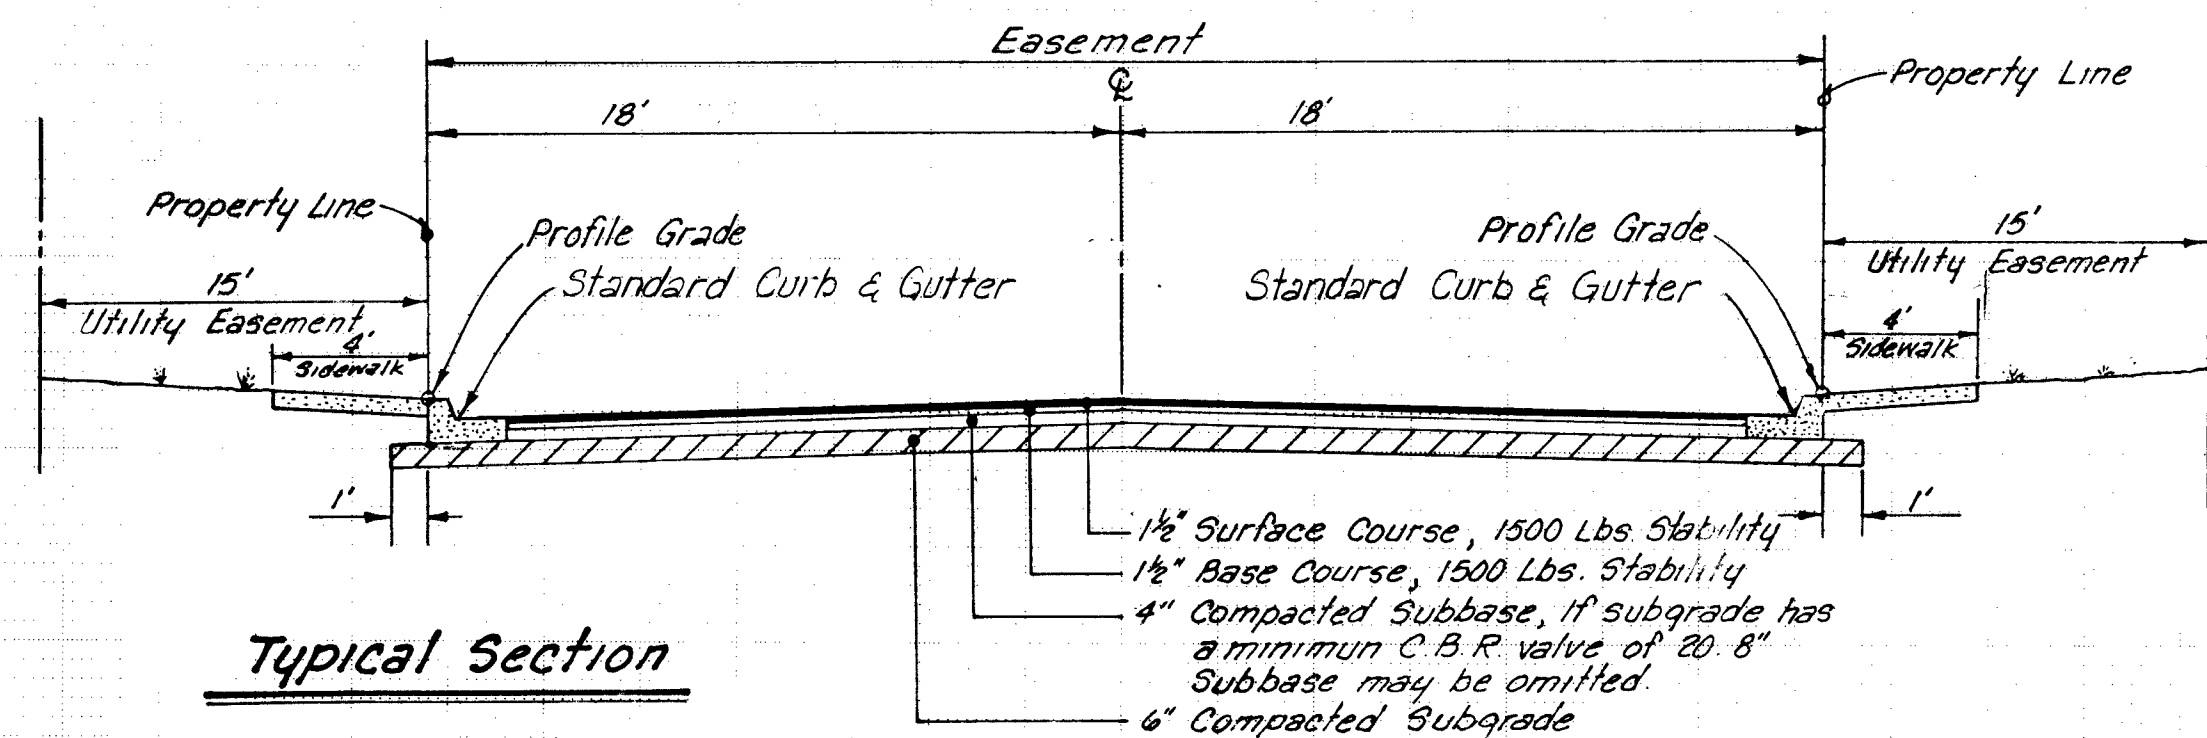


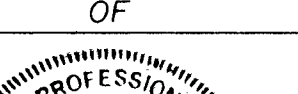

VILLAGE GREEN

[illegible]

Adam, Hamlyn, Anderson
Consulting Engineers Inc.
4055 Montgomery Blvd. N.E.
Albuquerque, New Mexico 87109 Ph.881-1808

PLANS PREPARED UNDER THE DIRECTION OF 	CITY OF ALBUQUERQUE PUBLIC WORKS DEPARTMENT ENGINEERING DIVISION TITLE: VILLAGE GREENS WEST STORM DRAIN <table border="1" style="width: 100%; border-collapse: collapse; margin-top: 10px;"> <thead> <tr> <th style="width: 25%;">APPROVALS</th> <th style="width: 25%;">ENGINEER</th> <th style="width: 10%;">DATE</th> <th style="width: 25%;">APPROVALS</th> <th style="width: 25%;">ENGINEER</th> <th style="width: 10%;">DATE</th> </tr> </thead> <tbody> <tr> <td>City Engineer</td> <td><i>[Signature]</i></td> <td>10/19/01</td> <td>Liquid Waste</td> <td><i>[Signature]</i></td> <td>10/19/01</td> </tr> <tr> <td>A.C.E. Design</td> <td><i>[Signature]</i></td> <td>10/22/01</td> <td>Traffic</td> <td><i>[Signature]</i></td> <td>10/19/01</td> </tr> <tr> <td>A.C.E. Hydrology</td> <td><i>[Signature]</i></td> <td>10/19/01</td> <td>Water</td> <td><i>[Signature]</i></td> <td>10/19/01</td> </tr>
