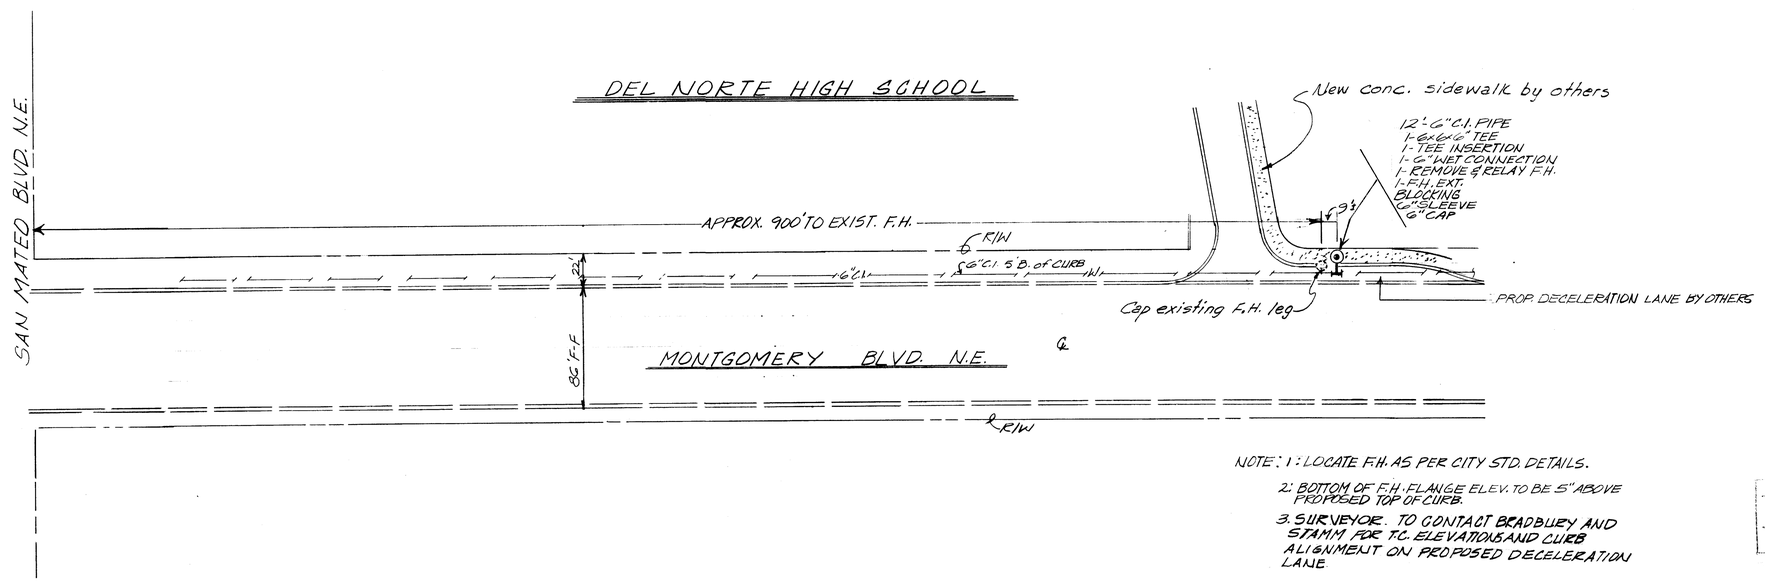

NOTE: 1: LOCATE F.H. AS PER CITY STD. DETAILS.

2: BOTTOM OF F.H. FLANGE ELEV. TO BE 5" ABOVE PROPOSED TOP OF CURB.

3. SURVEYOR. TO CONTACT BRADBURY AND STAMM FOR T.C. ELEVATIONS AND CURB ALIGNMENT ON PROPOSED DECELERATION LANE.

APPROVED AS-BUILT DRAWINGS
DATE

48 HOURS PRIOR TO ANY EXCAVATION, CONTRACTOR MUST CONTACT LINE AND CABLE LOCATING SERVICE, 765-1234, FOR LOCATION OF EXISTING UTILITIES.

AS BUILT INFORMATION

CONTRACTOR	CO-CON
WORK STAKED BY	DATE
INSPECTOR'S ACCEPTANCE BY	CHAVEZ, M.R. DATE 10-30-79
FIELD VERIFICATION BY	DATE
DRAWINGS CORRECTED BY	ORTEGA, P DATE 3-5-79

MICRO-FILM INFORMATION

RECORDED BY	DATE
NO. 23-129-0178-----18-----6118278	

SCANNED BY BY LASER

1	2	3	4	5	6	7	8	9	10	11	12
2	3	1	2	9	0	1	7	8			

APPROVED FOR CONSTRUCTION
7-24-78
CITY ENGINEER DATE

CITY OF ALBUQUERQUE
PUBLIC WORKS DEPARTMENT
ENGINEERING DIVISION

TITLE: F.H. RELOCATION - MONTGOMERY BLVD. EAST OF SAN MATEO BLVD.

APPROVALS	ENGINEER	DATE	APPROVALS	ENGINEER	DATE
City Engineer		7-24-78	Liquid Waste		
A.C.E.-Design		21 Jul 78	Traffic		
A.C.E.-Hydrology			Water		7-24-78

DRAWING NO. W-129-78 SHEET 1 OF 1

AS BUILT INFORMATION
CONTRACTOR
WORK STAKED BY
INSPECTOR'S ACCEPTANCE BY
FIELD VERIFICATION BY
DRAWINGS CORRECTED BY
DATE
MICRO-FILM INFORMATION
RECORDED BY
DATE
NO.

PLACES MARKS
N/A

SURVEY INFORMATION
FIELD NOTES
NO. BY DATE
N/A

REFERENCES
MAP NO. F-18
W.O. NO.
EST. NO. W-129-78

NO.	DATE	REMARKS	BY
		REVISIONS	
		DESIGN	

DESIGNED BY F. Gomez DATE 7/20/78
DRAWN BY D. Zamora DATE 7/20/78
CHECKED BY DATE