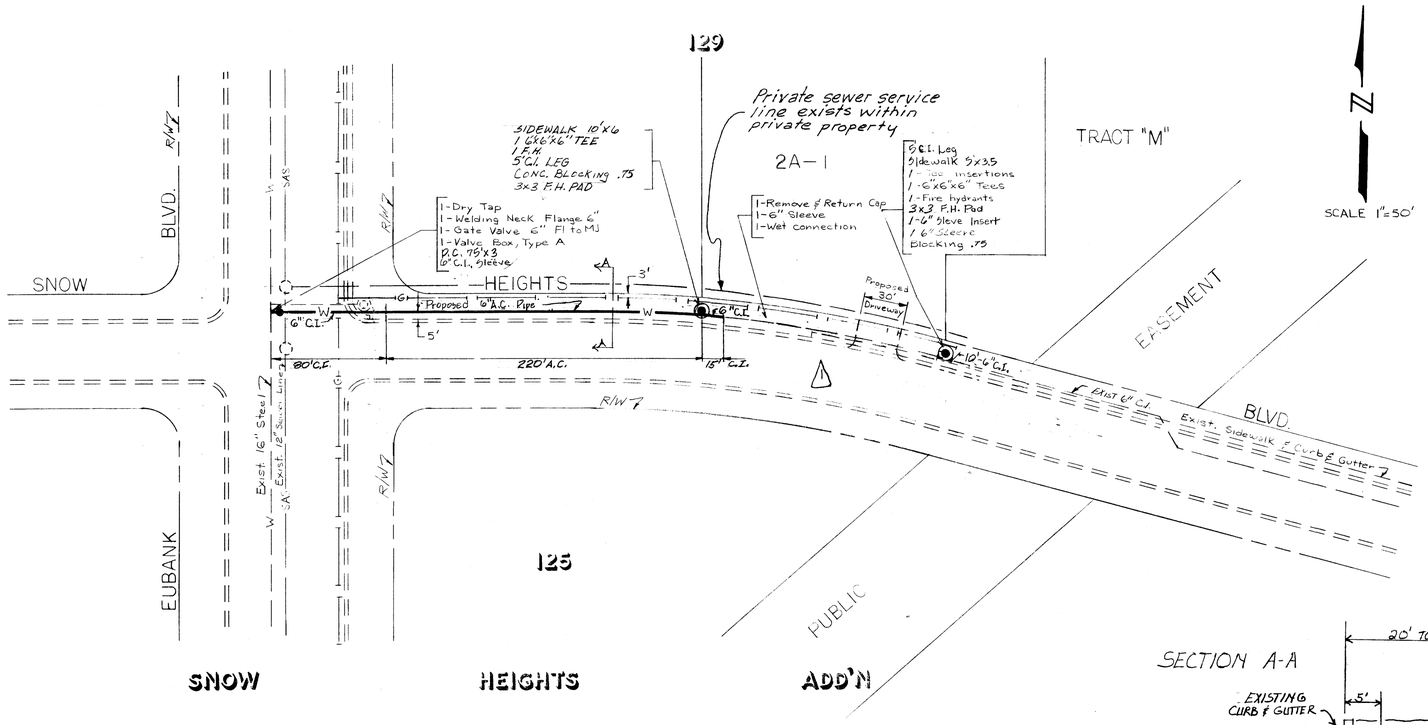

NOTES:

1) The applicant or developer will be responsible for repair or replacement of all curb and gutter which was damaged after approval by the City Engineer of work completed by the Contractor.
2) Elevation of the new Fire Hydrants at the bottom of the vertical flange will be 5" above top of curb.
3) 6" C.I. water line to be 3.67' min. cover to the top of pipe from top of curb.

LEGEND:

- —W— Exist. Water Line
- —W— Proposed Water Line
- —SAS— Exist. Sewer Line
- —G— Exist. Gas Line
- Exist. Sidewalk & Curb & Gutter
- Proposed Fire hydrant
- Exist. Fire hydrant

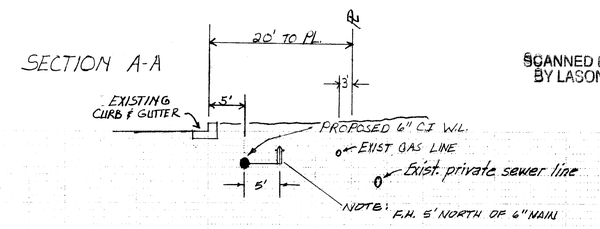

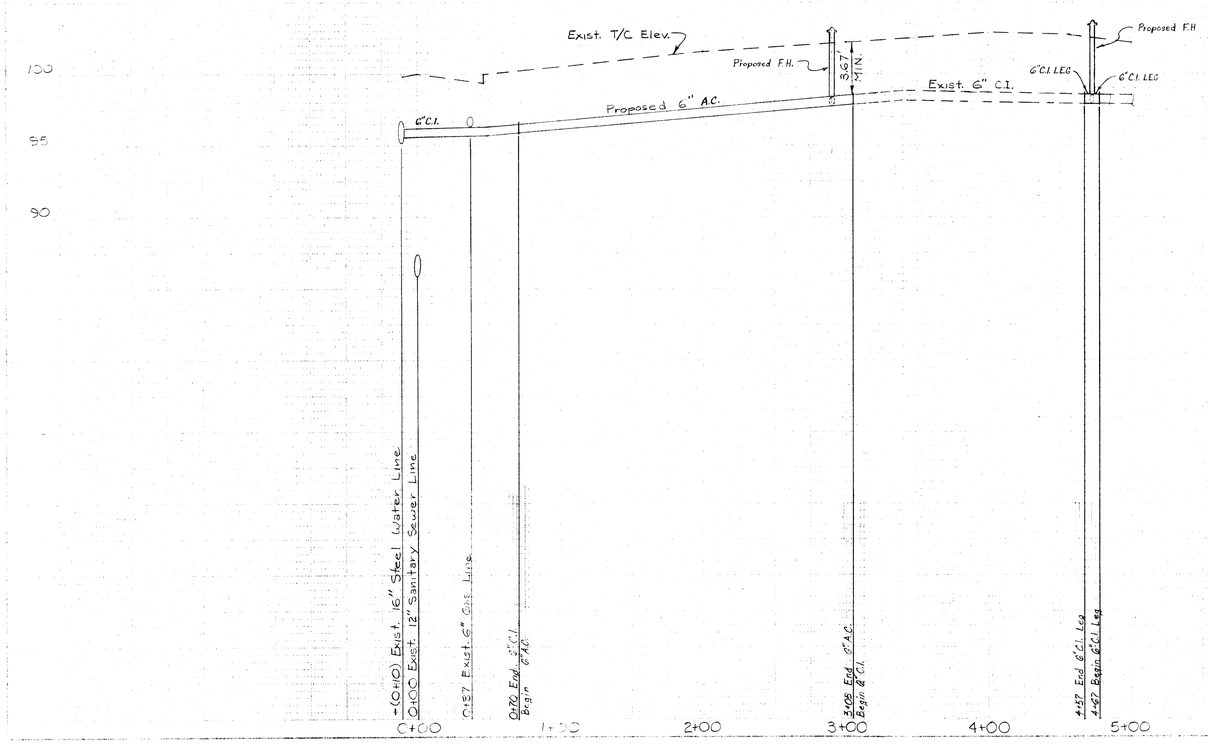

SCANNED BY BY LASON

48 HOURS PRIOR TO ANY EXCAVATION, CONTRACTOR MUST CONTACT LINE AND CABLE LOCATING SERVICE, TEL-556-0050, FOR LOCATION OF EXISTING UTILITIES.

AS BUILT INFORMATION

CHECKED BY	DATE		
FIELD CHECK	DATE		
CONSTRUCTION SP.	DATE		
CONSTRUCTION BY	DATE		
FIELD CHECK BY	DATE		
DRAWINGS	DATE		
REVISED TO MUDD FILM	DATE	INFORMATION	

BENCH MARKS

SURVEY INFORMATION

NO.	FIELD NOTES	BY	DATE

REFERENCES

MAP NO.	W-21-53	W.O. NO.
EST. NO.	W-44-78	

NO.	DATE	REMARKS REVISIONS	BY
△	9/8/78	RELOCATED F.H.S TO PROPERTY LINES	

DESIGNED BY C. TOMLINSON (FERED) DATE 8/17/78
DRAWN BY E. CASAUS DATE
CHECKED BY DATE

APPROVAL OF AS BUILT INFORMATION
ASST. CITY ENGINEER-FIELD
DATE 12-30-80

23 144 0178

CITY OF ALBUQUERQUE
PUBLIC WORKS DEPARTMENT
ENGINEERING DIVISION

TITLE: WATER LINE EXTENSION ON SNOW HEIGHTS BLVD. FROM EUBANK BLVD. TO 350' EAST OF EUBANK BLVD.; TWO FIRE HYDRANTS ON SNOW HEIGHTS BLVD. N.E.

APPROVALS	ENGINEER	DATE	APPROVALS	ENGINEER	DATE
City Engineer	C. A. Lujan	9/1/78	Liquid Waste		
A.C.E. - Design		23 Aug 78	Traffic		
A.C.E. - Hydrology			Water		

DRAWING NO. W-144-78 SHEET 1 OF 1

APPROVED FOR CONSTRUCTION
C. A. Lujan 11/3/78
CITY ENGINEER DATE