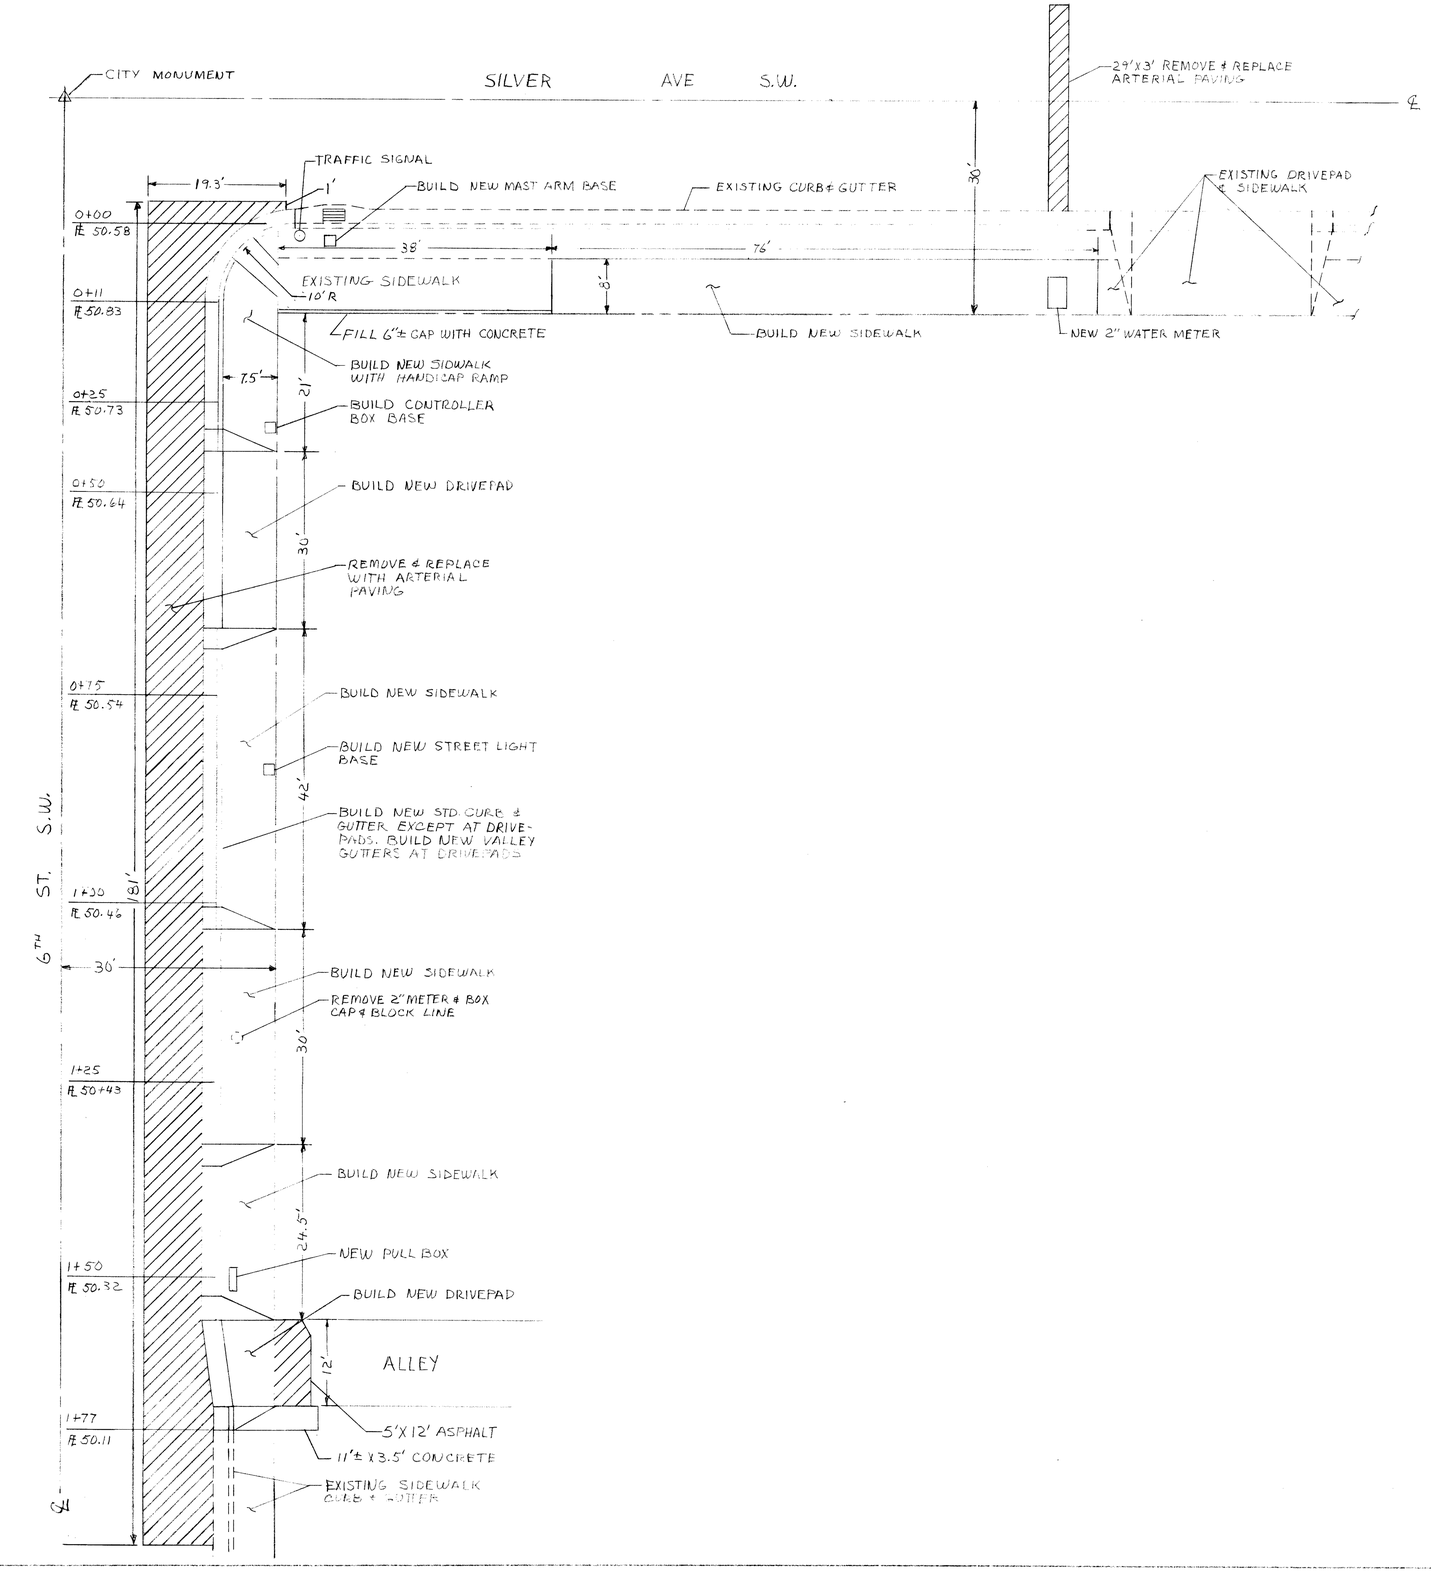

1	2	3	4	5	6	7	8	9	10	11	12
2	6		1	4	7	5	0	1	8	2	

APPROVAL OF AS BUILT DRAWINGS
ASST. CITY ENGINEER-FIELD
DATE 9-15-82

1	2	3	4	5	6	7	8	9	10	11	12
2	0		1	4	7	5	0	1	8	2	

THIS AS-BUILT COMPILED FROM FIELD NOTES AND/OR FIELD INSPECTION PLAN USE

AS BUILT INFORMATION
MICRO FILM INFORMATION
DATE
DATE

BENCH MARKS

SURVEY INFORMATION
FIELD NOTES
NO.
BY
CAT.

ENGINEER'S SEAL

NO.	DATE	REMARKS	BY
		REVISIONS	

DESIGN
DESIGNED BY
DRAWN BY Faith Gray
CHECKED BY
DATE 7/12/82
DATE
DATE

CITY OF ALBUQUERQUE
MUNICIPAL DEVELOPMENT DEPARTMENT
ENGINEERING DIVISION

TITLE: 6"ST WIDENING FROM SILVER AVE. SOUTH TO ALLEY

APPROVALS	ENGINEER	DATE	APPROVALS	ENGINEER	DATE
City Engineer			Public Works		
A.C.E. Design			Traffic		
A.C.E. Hydrology			Water		

DRAWING NO. 1475 | MAP NO. K-14 | SHEET 1 OF 1