

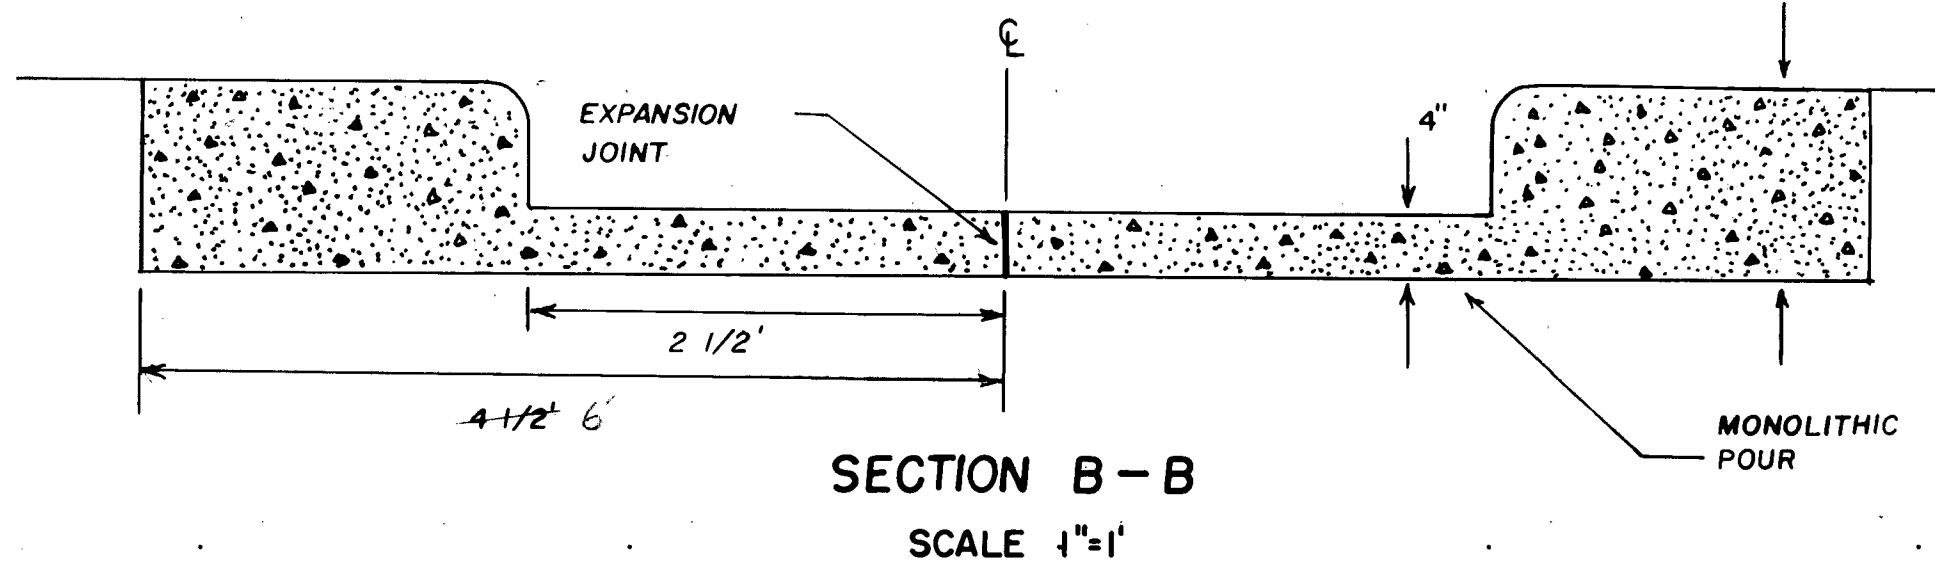
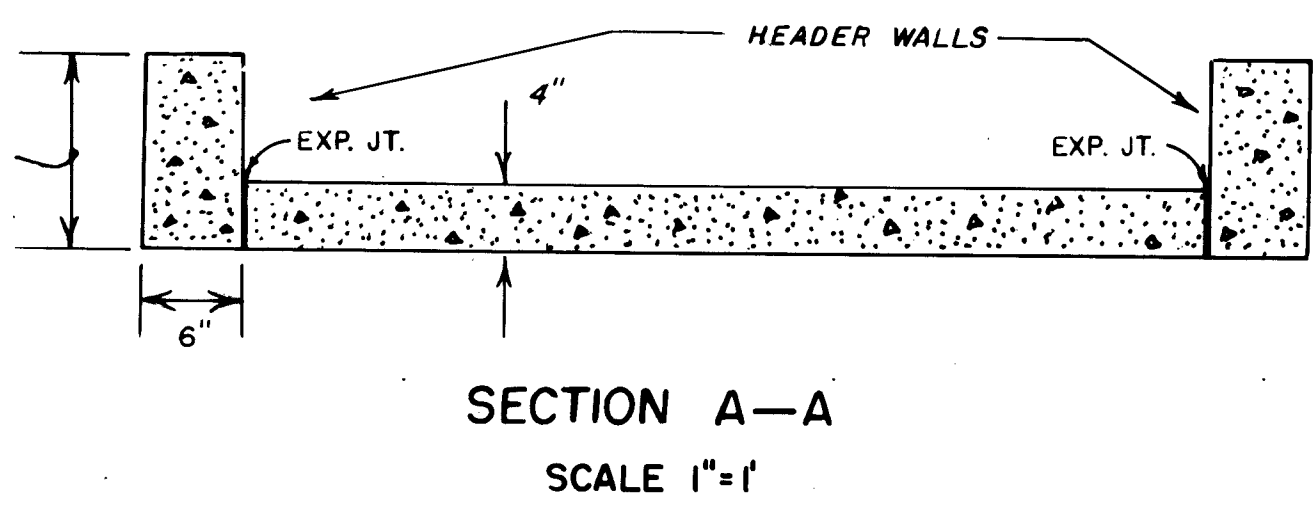
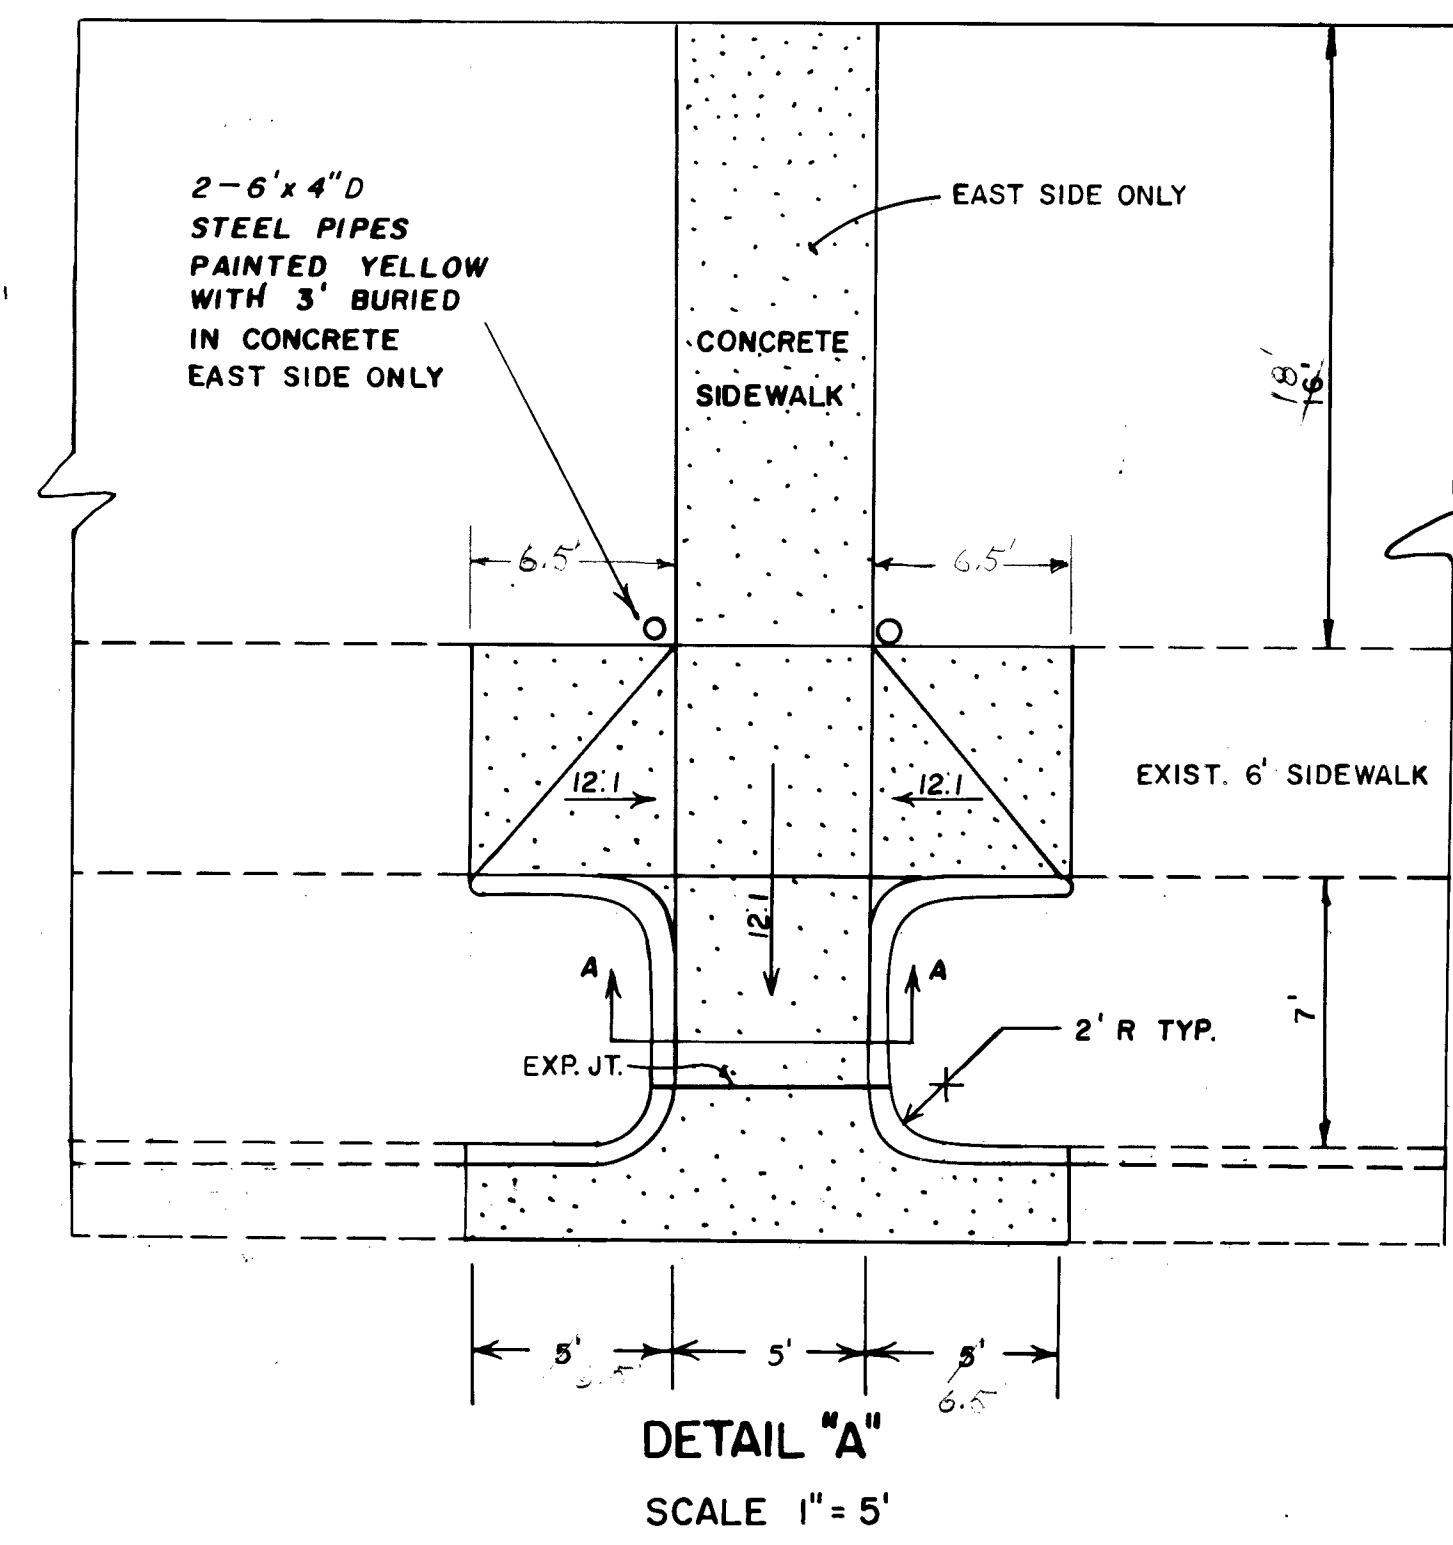


SCALE 1"=20'

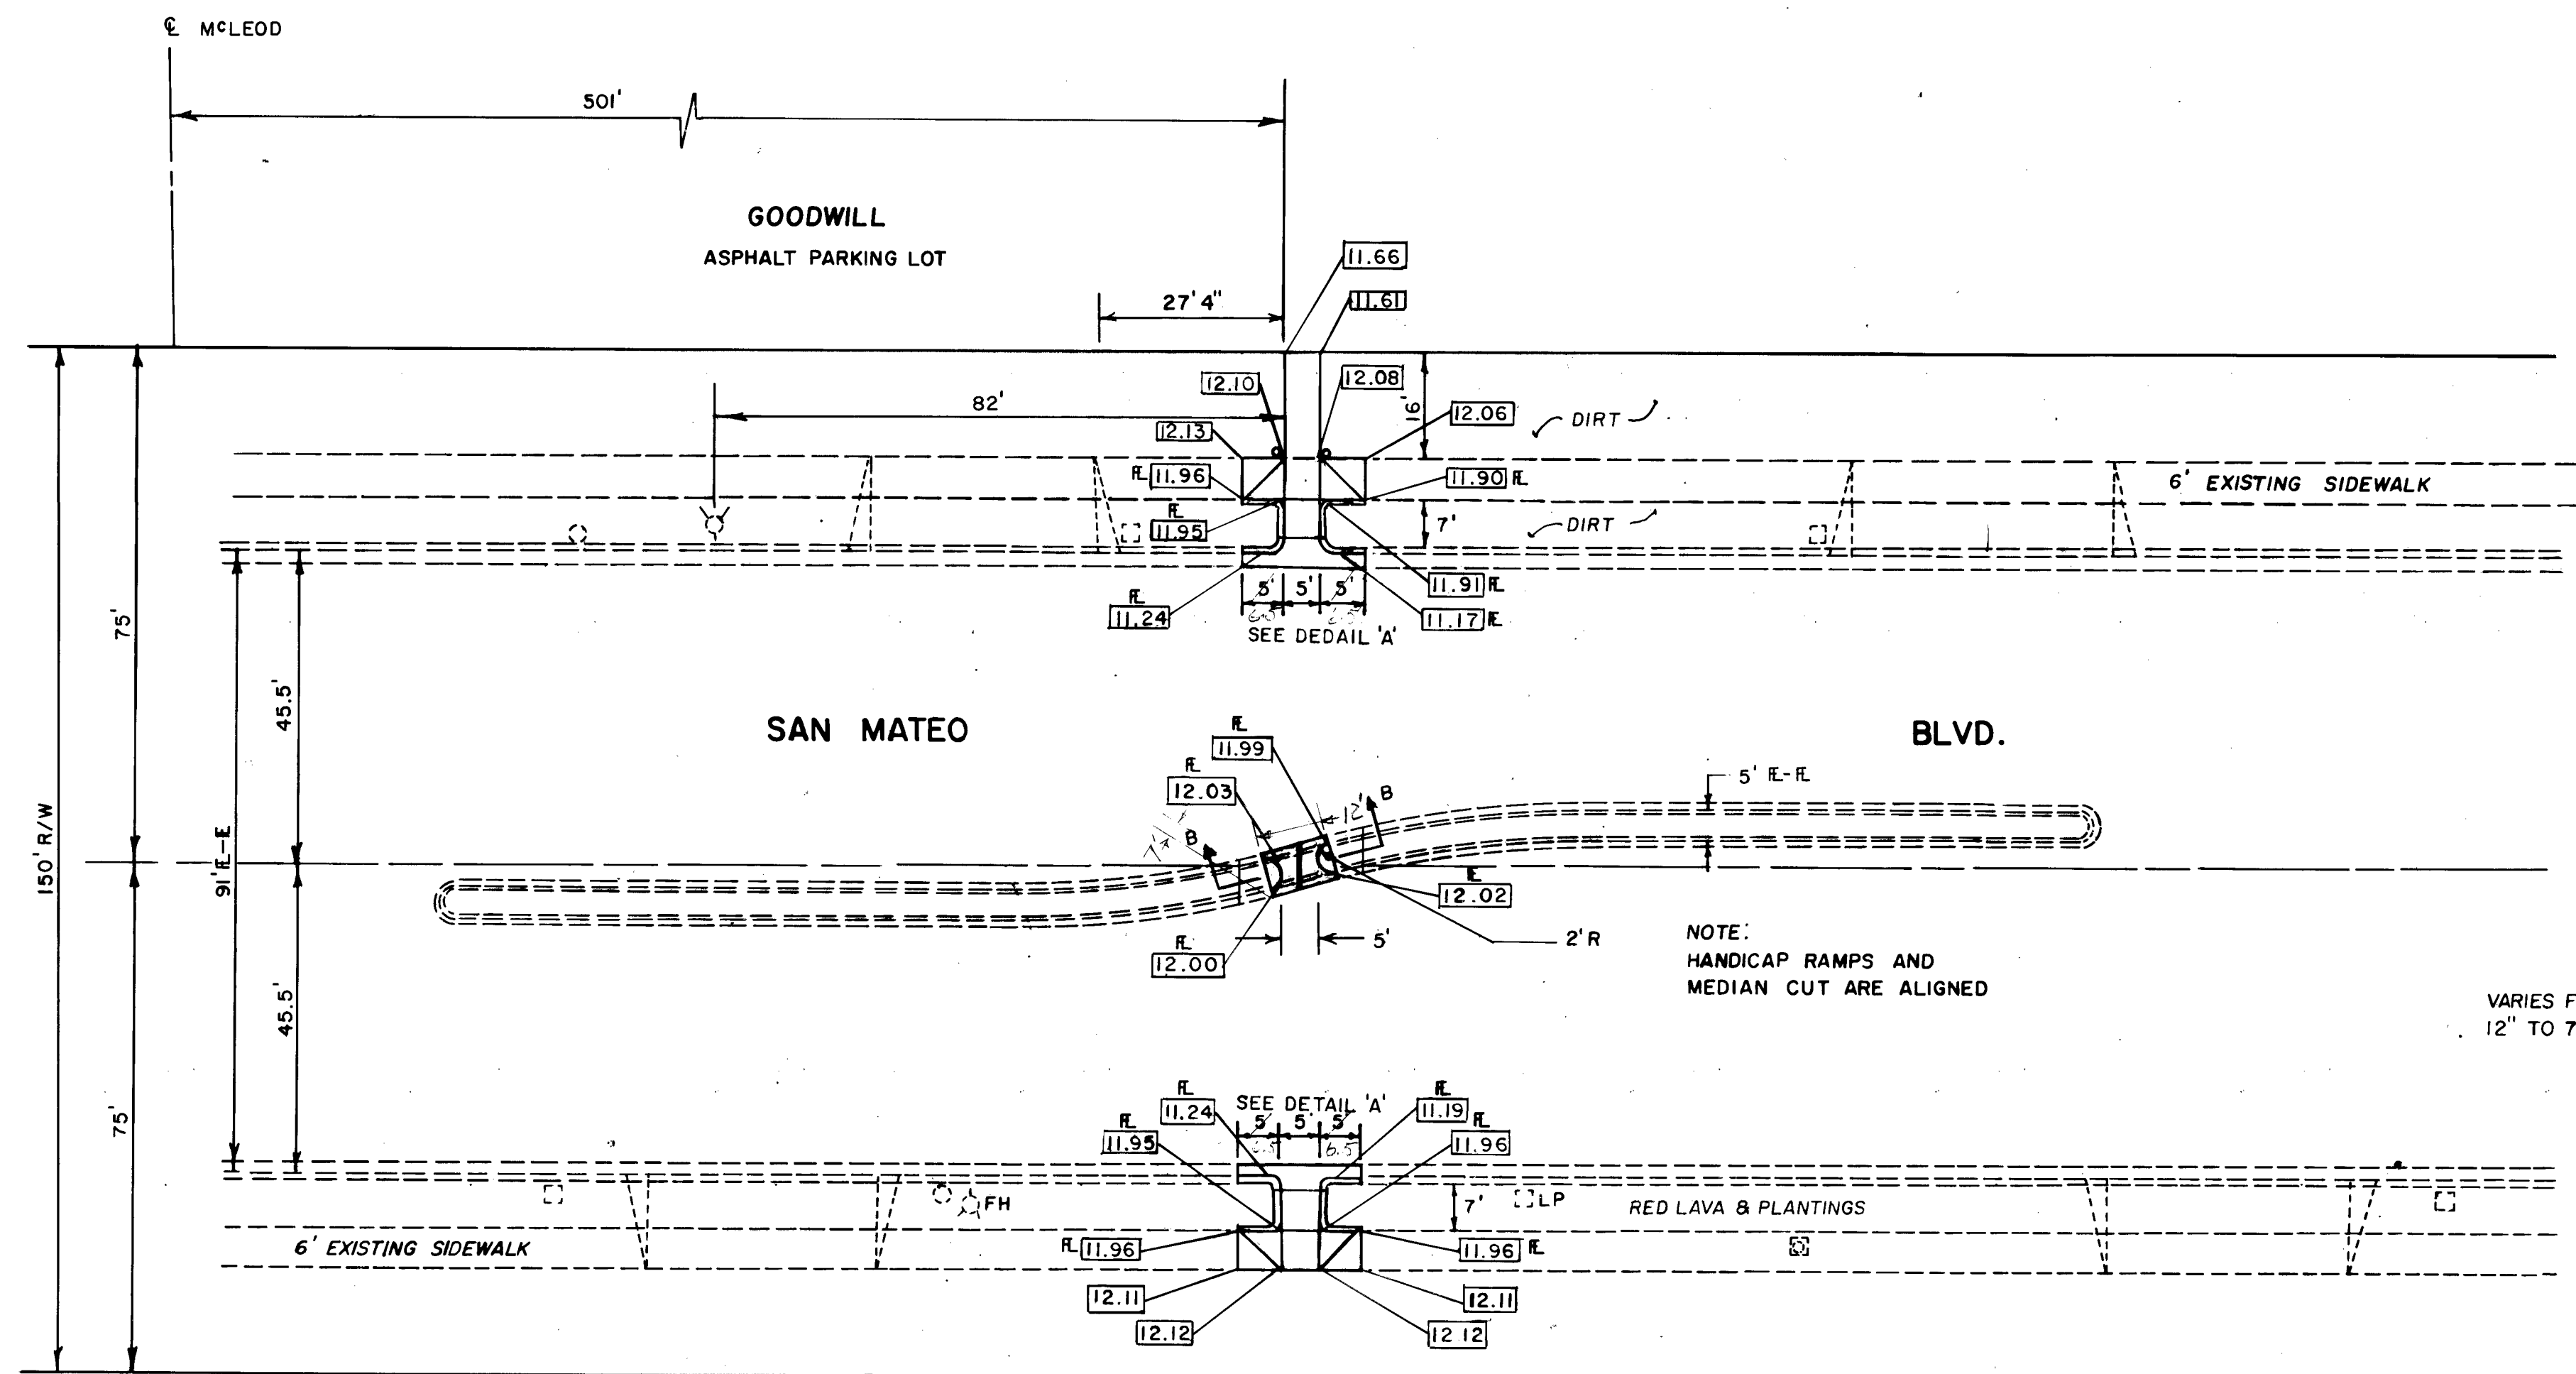

TRAFFIC HANDLING NOTES

1. CONTRACTOR MUST SUBMIT A CONSTRUCTION SIGNING AND BARRICADING PLAN TO TRAFFIC ENGINEERING DIVISION AND RECEIVE A BARRICADING PERMIT PRIOR TO CONSTRUCTION.
2. ALL CONSTRUCTION SIGNING AND BARRICADING TO COMPLY WITH MANUAL ON UNIFORM TRAFFIC CONTROL DEVICES, 1978 EDITION
3. CONTRACTOR'S OPERATION, BARRICADING AND SIGNING SHALL NOT AFFECT THRU LANES OF SAN MATEO BETWEEN 7 AM AND 9 AM OR 4 PM AND 6 PM.

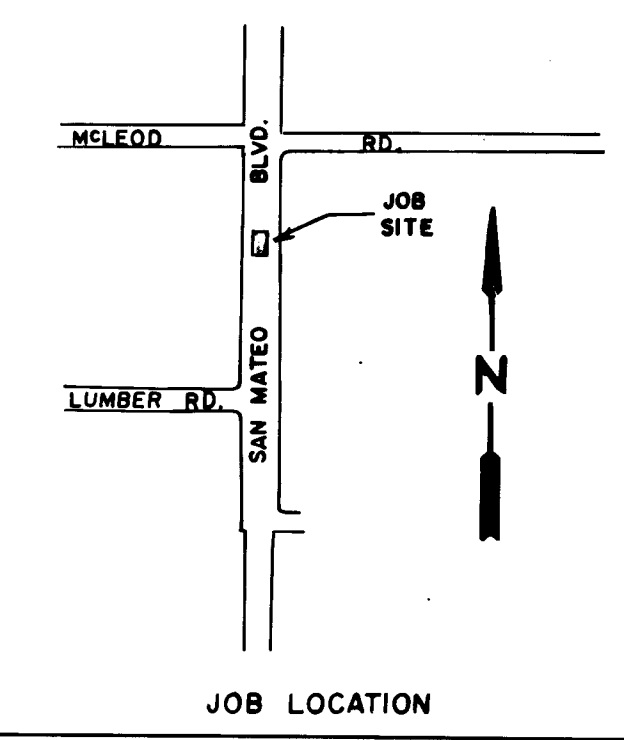

NOTICE TO CONTRACTORS

- 0 New Mexico Standard Specifications for Public Works Construction - 1979 Edition will be referred to herein as the "Standard Specifications."
- 2) All work detailed on these plans to be performed under contract shall, except as otherwise stated or provided for herein, be constructed in accordance with "Contract Documents for City-Wide Utilities and Cash Paving No. 31 and the Standard Specifications."
- 3) Two working days prior to any excavation, contractor must contact Line Locating Service, 765-1234, for location of existing utilities.
- 4) Prior to construction, the contractor shall excavate and verify the horizontal and vertical locations of all obstructions. Should a conflict exist, the contractor shall notify the engineer or survey so that the conflict can be resolved with minimum of delay.

THE FOLLOWING NOTES APPLY
WHEN CHECKED :

- ☐ All utilities and utility service lines shall be installed prior to paving.
- ☐ Backfill compaction shall be according to specified street use.
- ☒ Tack coat requirements shall be determined by the City Engineer.
- ☒ Sidewalks and wheelchair ramps within the curb returns shall be constructed wherever a new curb return is constructed.
- ☐ If curb is depressed for a driveway, the driveway shall be constructed prior to acceptance of the curb and gutter.
- ☐ All storm drain facilities shall be com-

[illegible]

W. K. K. K.
1.14.83

Richard S. Bell 11/23/82

CITY OF ALBUQUERQUE
MUNICIPAL DEVELOPMENT DEPARTMENT
ENGINEERING DIVISION

TITLE: HANDICAP RAMPS ON SAN MATEO
APPROX. 620' N OF LUMBER

APPROVALS	ENGINEER	DATE	APPROVALS	ENGINEER	DATE
City Engineer	<i>[Signature]</i>	11/22/82	Liquid Waste	N.A. Jones	10-28-82
A.C.E. - Design	<i>[Signature]</i>	9 Nov 82	Traffic	<i>[Signature]</i>	11/1/82
A.C.E. - Hydrology	<i>[Signature]</i>	11/1/82	Water	N.A. Jones	10-28-82

DRAWING NO.	1499	MAP NO. <u>11</u> F-18	SHEET	OF
----------------	------	---------------------------	-------	----