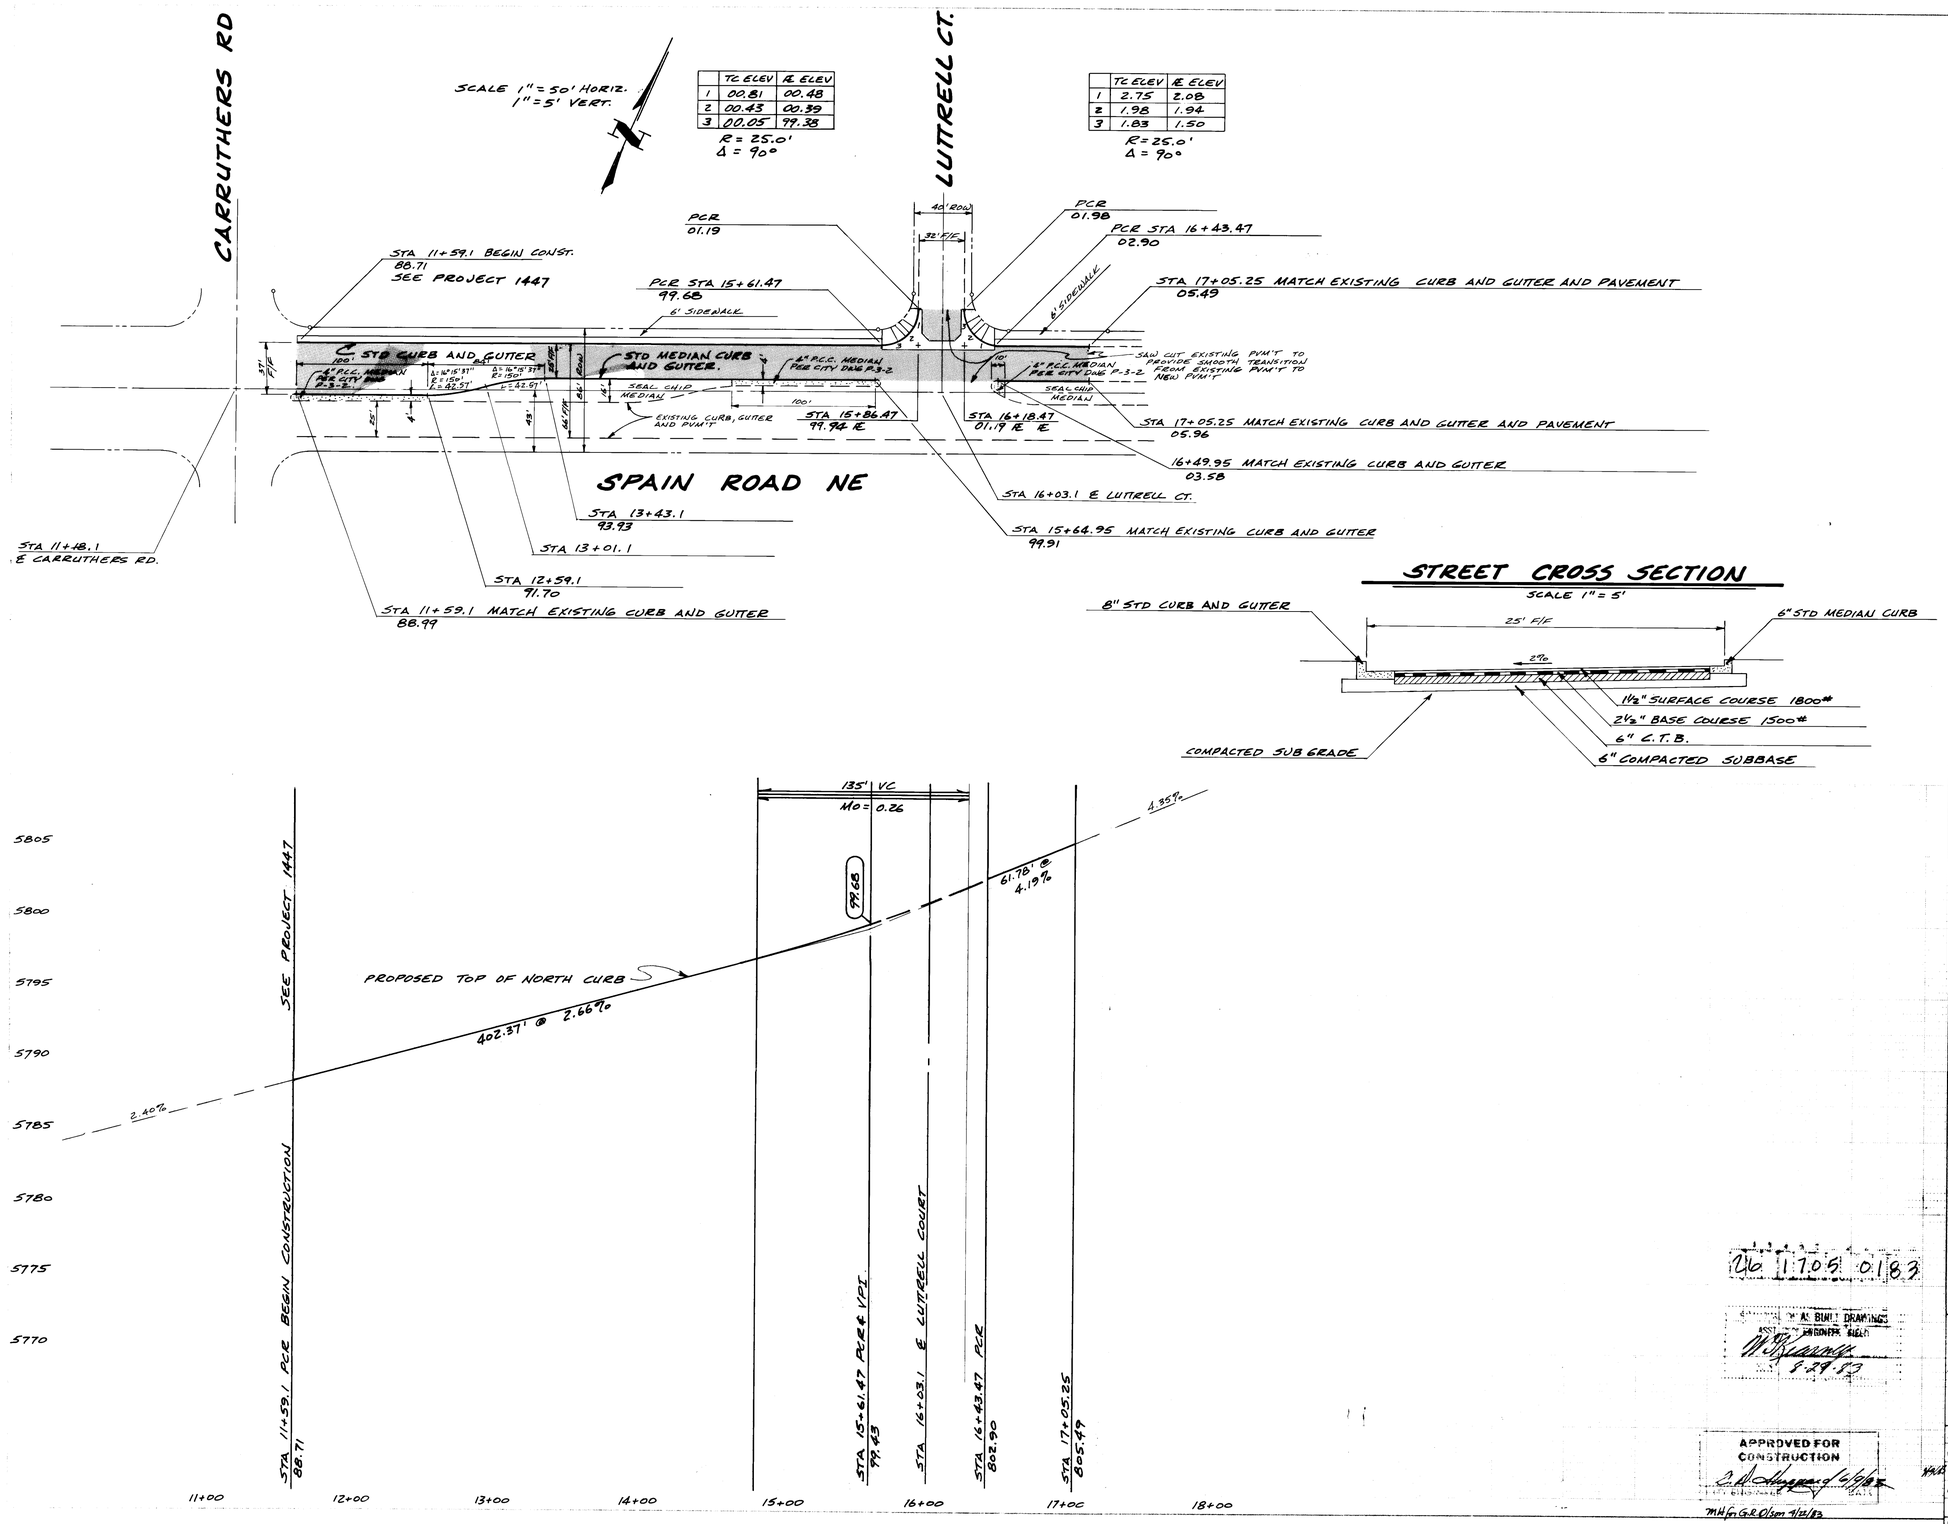

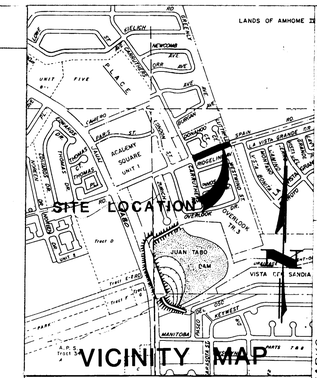

NOTICE TO CONTRACTORS

1) New Mexico Standard Specifications for Public Works Construction-1979 Edition will be referred to hereon as the "Standard Specifications".

2) All work detailed on these plans to be performed under contract shall, except as otherwise stated or provided hereon, be constructed in accordance with "Contract Documents for City-Wide Utilities and Cash Paving No. 31 and the Standard Specifications".

3) Two working days prior to any excavation, contractor must contact Line Locating Service, 765-1234, for location of existing utilities.

4) Prior to construction, the contractor shall excavate and verify the horizontal and vertical locations of all obstructions. Should a conflict exist, the contractor shall notify the engineer or surveyor so that the conflict can be resolved with minimum of delay.

5) Backfill compaction shall be according to specified street use (ARTERIAL).

6) Tack coat requirements shall be determined by the City Engineer.

7) Sidewalks and wheelchair ramps within the curb returns shall be constructed wherever a new curb return is constructed.

NOTES

1) Construct the median curbs at north side of medians only. T.C. elev. to be 0.33' higher than the curbs on the north side of the road.

2) Pave the north part of Spain Rd. from Sta. 11+59.1 to Sta. 17+05.25 using arterial paving per Std. Dwg. P-3-2. Elevations to match existing paving elevations.

3) Pave medians per Std. Dwg. T-2-2, T-3-2, AND P-3-2.

4) For mountable curb to standard curb transition, see City St. Dwg. P-18-2.

5) For concrete valley gutter see City Std. Dwg. P-9-2.

6) For wheelchair ramps see City Std. Dwg. P-17.

7) All curb elevations are top of curb elevations unless otherwise noted.

THIS DRAWING IS A COMPOSITE OF DRAWINGS C-29-24 SHEET 10, C-28-13 SHEET 4 & FIELD INFORMATION.

Academy Engineering, Inc.
5353 Wyoming Blvd. N.E., Suite 3
Albuquerque, New Mexico 87109
(505) 821-8008

BENCH MARKS
ACS BENCH MARK 13-F22
LOCATED AT THE INTERSECTION OF CARRUTHERS RD. AND DOUGLAS CT. NE IN THE NORTHEAST QUADRANT OF THE INTERSECTION. A □ CUT ON THE TOP OF CONCRETE CURB AT THE NNE CURB RETURN.
ELEVATION = 5787.30

AS BUILT INFORMATION
REVISIONS BY R. GALLO DATE 8/83
CORRECTED BY MICRO-FILM DATE
INFORMATION

SURVEY INFORMATION
FIELD NOTES
NO BY DATE

ENGINEER'S SEAL
Jim Polumbus 3-3-83

NO	DATE	REMARKS	BY
		REVISIONS	
		DESIGN	

DESIGNED BY TED WITEK DATE MAR. 1983
DRAWN BY TED WITEK DATE MAR. 1983
CHECKED BY JAMES BLACKWELL DATE MAR. 1983

CITY OF ALBUQUERQUE
MUNICIPAL DEVELOPMENT DEPARTMENT
ENGINEERING DIVISION

TITLE: SPAIN ROAD PAVING
FROM CARRUTHERS RD. TO LUTTRELL CT.

APPROVALS	ENGINEER	DATE	APPROVALS	ENGINEER	DATE
City Engineer	RS Wells	4/25/83	Liquid Waste	NA	4-12-83
A.C.E. Design		25 Apr 83	Traffic	NA	9-12-83
A.C.E. Hydrology	4-26-83		Water	NA	9-12-83

DRAWING NO 1705 | MAP NO F-22 | SHEET 1 OF 1

26 1705 0183

AS BUILT DRAWINGS
CONTRACT FIELD
M. Burns 8-29-83

APPROVED FOR CONSTRUCTION
CITY ENGINEER DATE
MH for G.R. Olsen 4/21/83