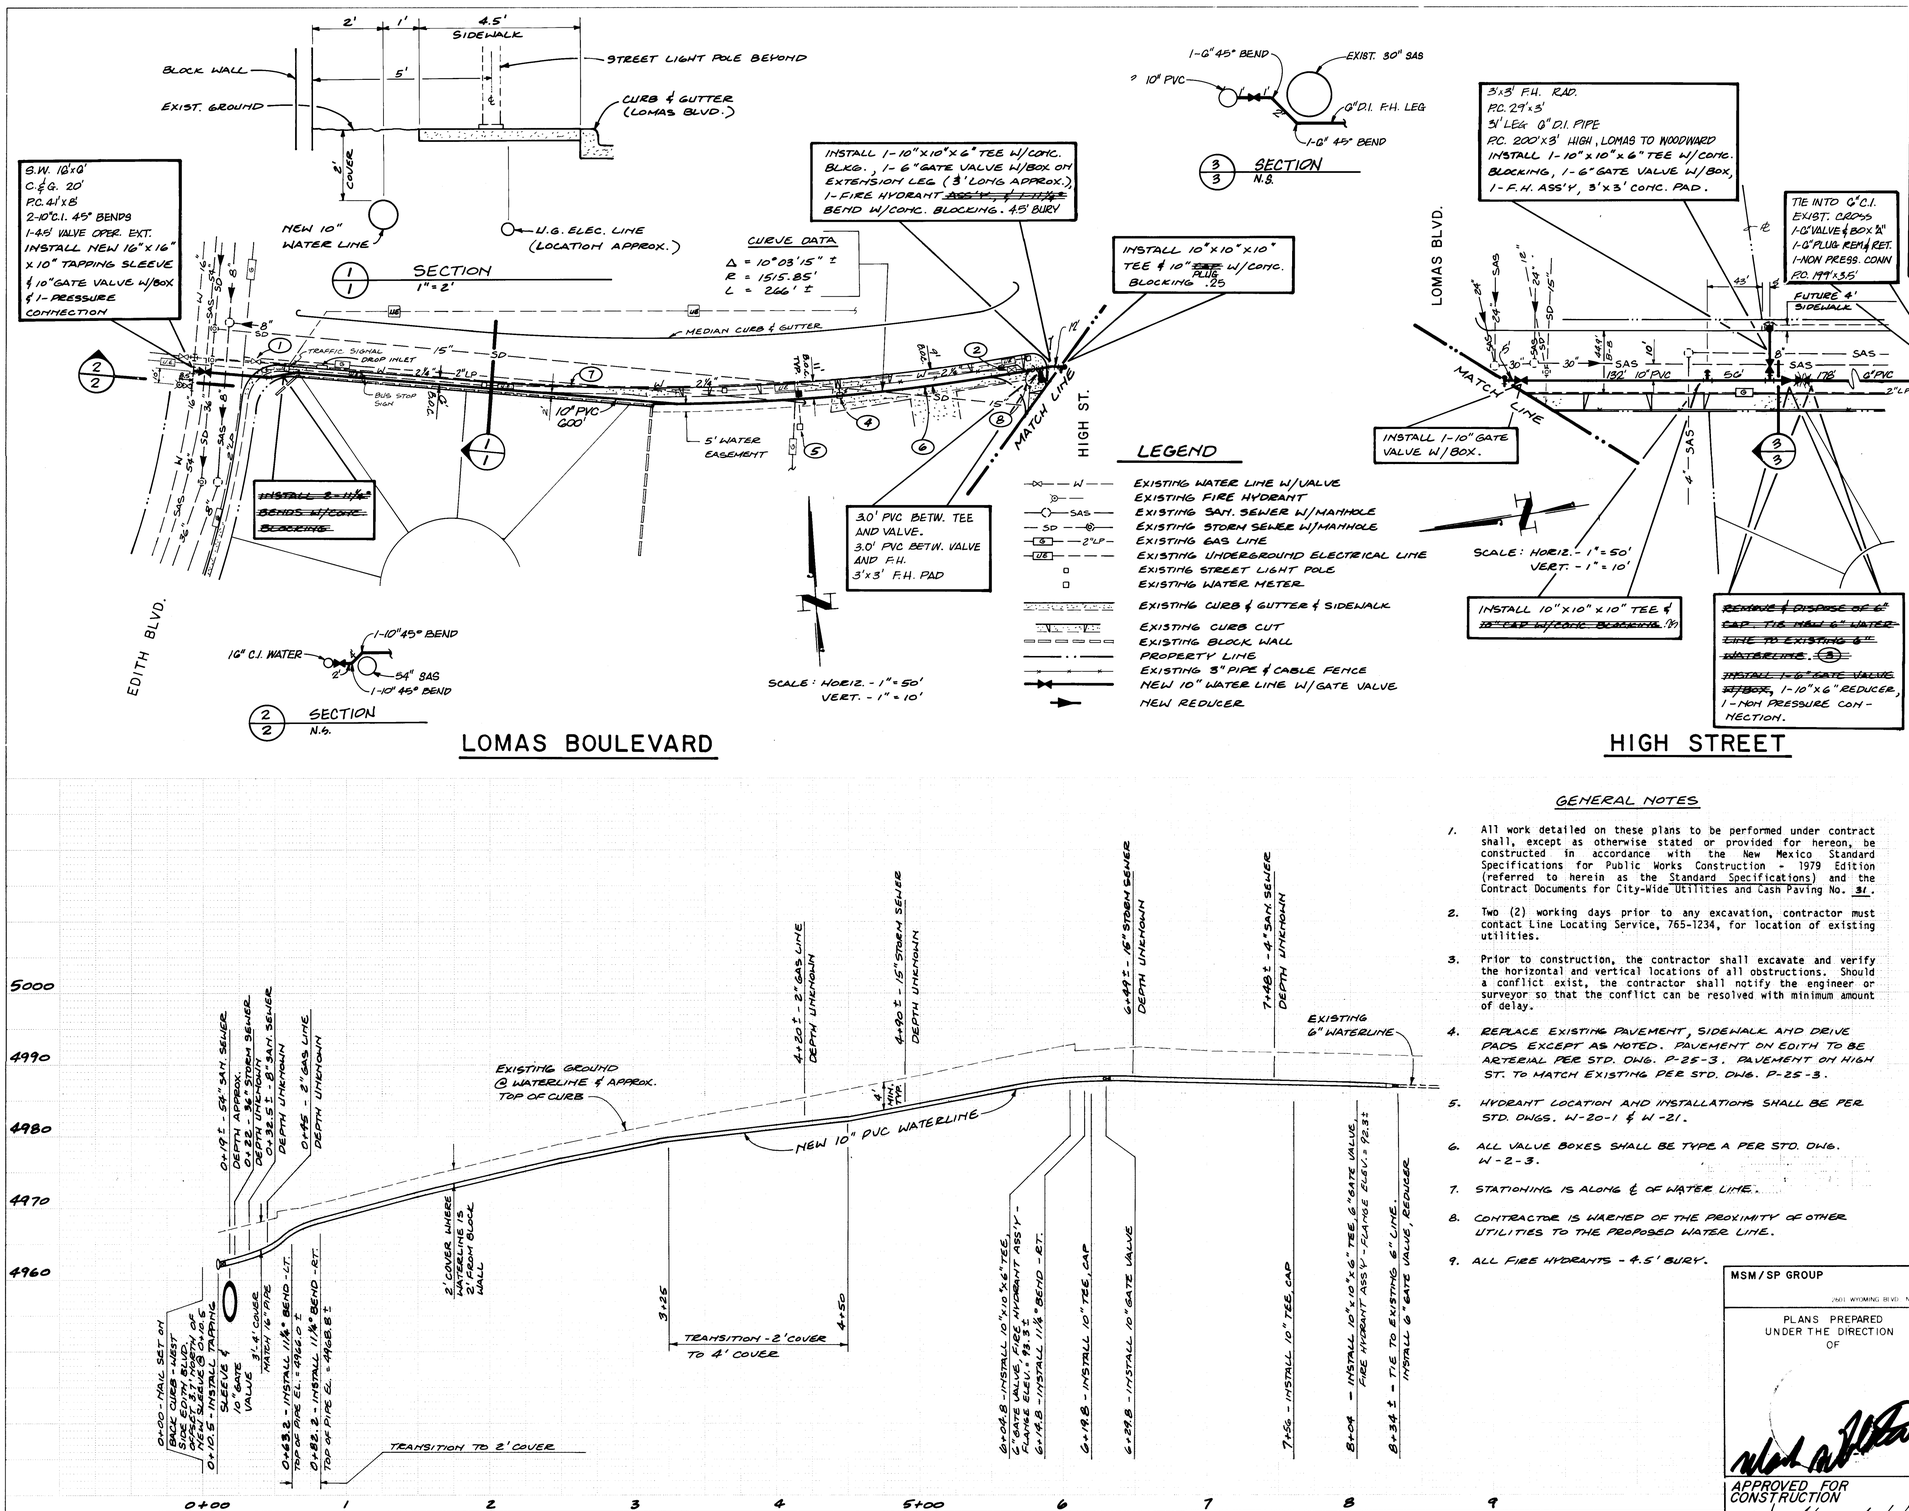

KEYED NOTES

1. SHUT VALVE ON 2½" LINE. REM. CAP ~~WITH CONC. WITH CAP SIGN~~.
2. REMOVE & RETURN 2½" GATE VALVE.
3. ~~REMOVE EXISTING 6" WATER LINE AS REQUIRED TO LAY 10" LINE TO FIRE HYDRANT. LOCATION OF 6" CAP IS APPROXIMATE.~~
4. REMOVE & DISPOSE OF EXIST. 1" SERVICE & METER BOX. RETURN METER TO CITY W.R.D. (STA. 4+62.5)
5. RELOCATE METER BOX TO SIDEWALK PER CITY STD. DWG. W-11-1. INSTALL 1½" METER PROVIDED BY CITY W.R.D. RETURN EXISTING METER TO CITY W.R.D. (STA. 4+32)
6. DO NOT REPLACE EXISTING CONCRETE PAD FROM 4+60± TO 6+10±.
7. EXISTING 2½" WATER LINE TO BE ABANDONED IN PLACE.
8. REPLACE EXISTING SIDEWALK ADJACENT TO HIGH ST. REPLACE WITH BUBBLE AROUND FIRE HYDRANT PER STD. DWG. P-14-1.

GENERAL NOTES

1. All work detailed on these plans to be performed under contract shall, except as otherwise stated or provided for hereon, be constructed in accordance with the New Mexico Standard Specifications for Public Works Construction - 1979 Edition (referred to herein as the Standard Specifications) and the Contract Documents for City-Wide Utilities and Cash Paving No. 31.
2. Two (2) working days prior to any excavation, contractor must contact Line Locating Service, 765-1234, for location of existing utilities.
3. Prior to construction, the contractor shall excavate and verify the horizontal and vertical locations of all obstructions. Should a conflict exist, the contractor shall notify the engineer or surveyor so that the conflict can be resolved with minimum amount of delay.
4. REPLACE EXISTING PAVEMENT, SIDEWALK AND DRIVE PADS EXCEPT AS NOTED. PAVEMENT ON EDITH TO BE ARTERIAL PER STD. DWG. P-25-3. PAVEMENT ON HIGH ST. TO MATCH EXISTING PER STD. DWG. P-25-3.
5. HYDRANT LOCATION AND INSTALLATIONS SHALL BE PER STD. DWGS. W-20-1 & W-21.
6. ALL VALVE BOXES SHALL BE TYPE A PER STD. DWG. W-2-3.
7. STATIONING IS ALONG ℄ OF WATER LINE.
8. CONTRACTOR IS WARNED OF THE PROXIMITY OF OTHER UTILITIES TO THE PROPOSED WATER LINE.
9. ALL FIRE HYDRANTS - 4.5' BURY.

26 1783 0184

APPROVAL OF AS BUILT DRAWINGS
ASST. CITY ENGINEER - FIELD
5/10/84

MSM/SP GROUP
CONSULTING ENGINEERS · SURVEYORS · PLANNERS
2601 WYOMING BLVD. N.E. SUITE I ALBUQUERQUE, NEW MEXICO 87112 (505) 292-1936

PLANS PREPARED UNDER THE DIRECTION OF

APPROVED FOR CONSTRUCTION
10/19/83
CITY ENGINEER — DATE
MH for 8/1/83

CITY OF ALBUQUERQUE
WATER RESOURCES DEPARTMENT

TITLE: **LOMAS-HIGH WATERLINE**

APPROVALS	ENGINEER	DATE	APPROVALS	ENGINEER	DATE
City Engineer		8/2/83	Liquid Waste		6-30-83
A.C.E.-Design		8/01/83	Traffic		7/15/83
A.C.E.-Hydrology		7/4/83	Water		6-30-83

DRAWING NO. 1783 SHEET 1 OF 1

AS BUILT INFORMATION
CONTRACTOR NEW CONCEPTS DATE
WORK STAKED BY DATE
INSPECTORS ACCEPTANCE BY M.R. CHAVEZ DATE 4-84
FIELD VERIFICATION BY DATE
DRAWINGS CORRECTED BY R. DURAN DATE 5-84
MICRO-FILM INFORMATION
RECORDED BY DATE
NO.

BENCH MARKS
ACS B.M. #5-J15: CHISEL CUT ON WHW RETURN OF LOMAS & EDITH. ELEV. = 4967.34

SURVEY INFORMATION

FIELD NOTES NO.	BY	DATE
16/5	T. ALDRICH	3-7-83
16/5	T. ALDRICH	4-11-83

REFERENCES
MAP NO. J-145, J-155
EST NO. W.O. NO.

NO.	DATE	REMARKS	BY

REVISIONS
DESIGN
DESIGNED BY M. HOLSTAD, F. HAAS DATE 6-83
DRAWN BY K. MORRIS DATE 6-83
CHECKED BY M. HOLSTAD DATE 6-83

1783