PUEBLO ALTO SUBD.

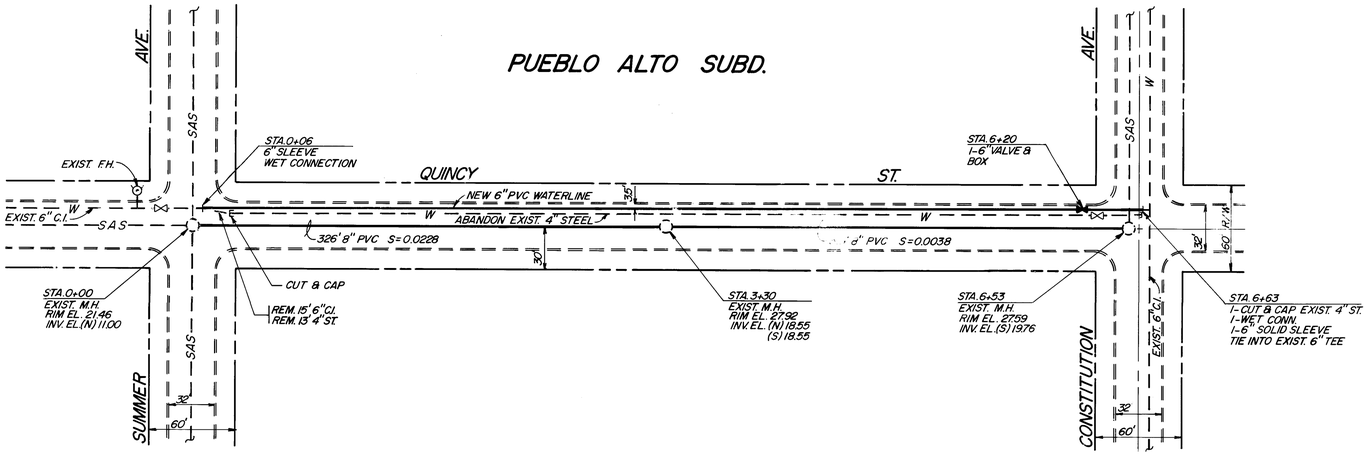

PLAN
SCALE 1" = 50'

PROFILE
SCALE VERT. 1" =
HOR. 1" = 50'

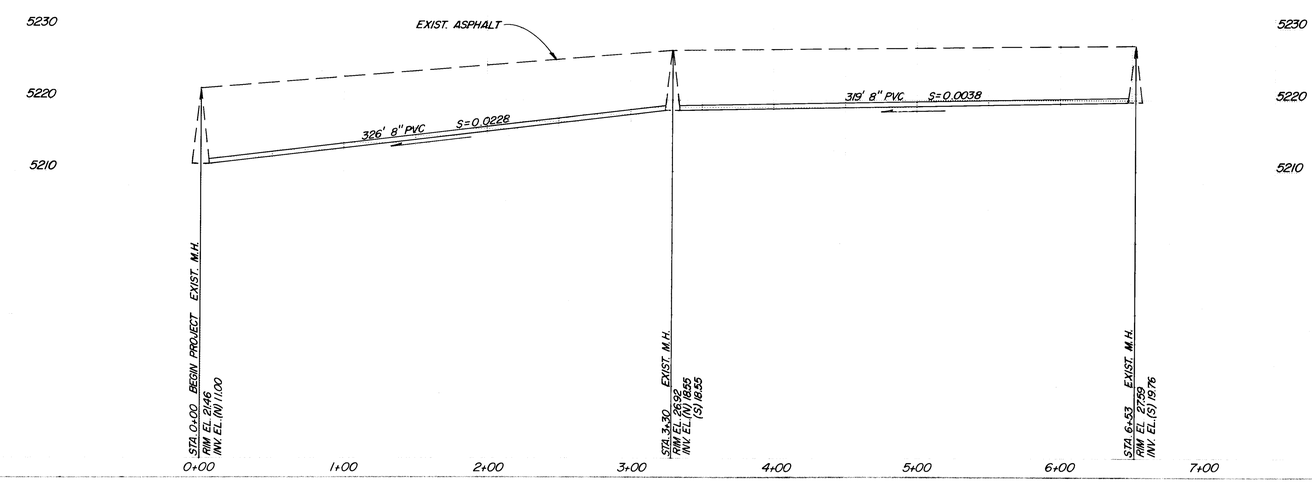

AS BUILT INFORMATION
DRAWN BY D. HERRERA DATE 4-84
MODIFICATION
BENCH MARK
SURVEY INFORMATION
FIELD NOTES BY DATE
NO

9/19/84

NO	DATE	REMARKS	BY
		REVISIONS	
		DESIGN	DATE 4-84
		DRAWN BY R. DURAN	DATE 4-84
		CHECKED BY H. BENNINGHOFF	

2c 1923 C1E4

CITY OF ALBUQUERQUE
MUNICIPAL DEVELOPMENT DEPARTMENT
ENGINEERING DIVISION

TITLE WATER & SEWER REPLACEMENT ALONG QUINCY ST. BETWEEN CONSTITUTION AVE & SUMMER AVE.

APPROVALS	ENGINEER	DATE	APPROVALS	ENGINEER	DATE
City Engineer			Utilities		
Traffic					
Water					

DRAWING NO 1923
MAP NO J-17
SHEET 1 OF 1

ESS1