


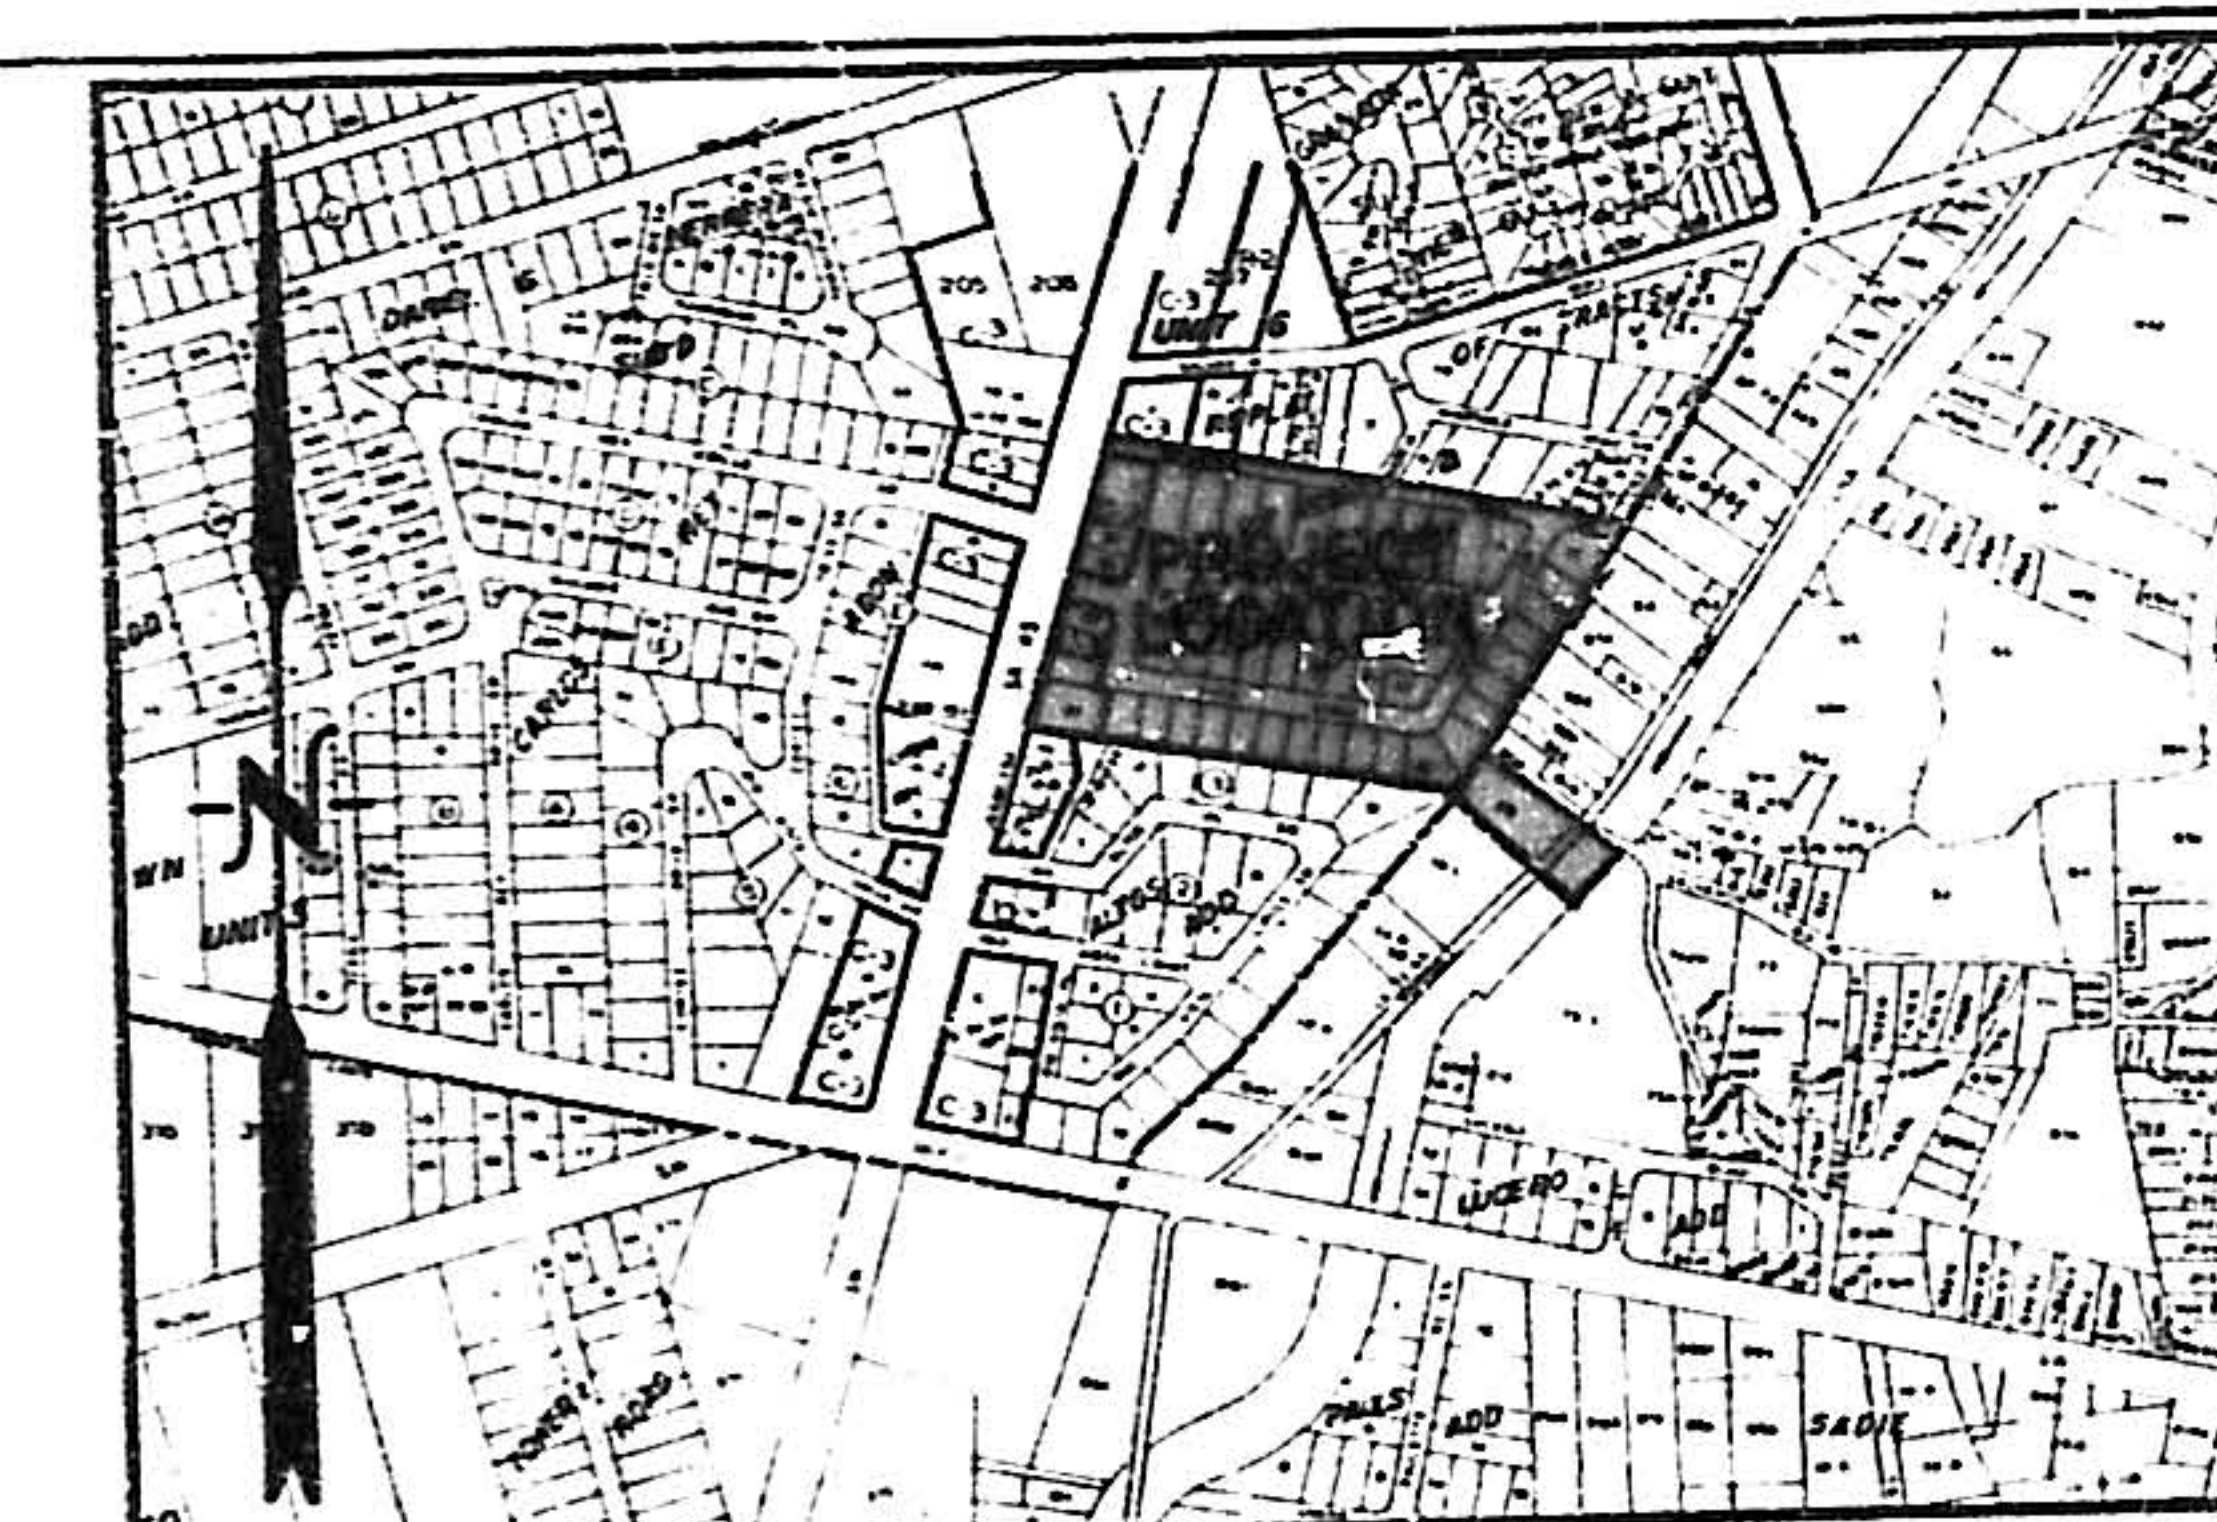

VICINITY MAP
SCALE 1" = 800'

L-11

CONSTRUCTION PLANS FOR

VISTA ALTA ADDITION

STORM DRAINAGE FACILITIES


INDEX TO DRAWINGS

SHEET NO.	DESCRIPTION
1	COVER SHEET, GENERAL NOTES
2	OVERALL STORM DRAINAGE FACILITIES PLAN, SYMBOL LEGEND
	<u>DRAINAGE FACILITIES - PLAN AND PROFILE</u>
3	LINE 'A' AND POND
4	ALTA VISTA COURT
5	GALLEGOS ROAD - BOHEMIO COURT
6	DETAILS

GENERAL NOTES



- All work detailed on these plans to be performed under contract shall, except otherwise stated or provided for herein, be constructed in accordance with the New Mexico Standard Specifications for Public Works Construction - 1979 Edition (referred herein as the Standard Specifications) and the contract documents for Public Works Contract No. 85-1.
- Two (2) working days prior to any excavation, Contractor must contact line locating service, 765-1234, for location of existing utilities.
- Prior to construction, the Contractor shall excavate and verify the horizontal and vertical locations of all potential obstructions. Should a conflict exist, the Contractor shall notify the Engineer so that the conflict can be resolved with a minimum amount of delay.
- All work on this project shall be performed in accordance with applicable Federal, State and Local laws, rules, and regulations concerning construction safety and health.
- Contractor shall maintain access to adjacent properties during construction.
- All gas, electric, telephone lines, cables, and appurtenances encountered during construction that require relocation, shall be done by the responsible utility. Contractor shall be responsible for coordination of all necessary utility adjustments.
- It will be the Contractor's responsibility to protect and maintain in service all existing utilities.
- The Contractor will be required to confine his work within the construction limits and/or public right-of-way to preserve existing vegetation and private property. Overnight parking of construction equipment shall not obstruct driveways or designated traffic lanes.
- A disposal site for all excess excavation material, asphaltic paving, concrete curbs and sidewalks, etc., shall be obtained by the Contractor in compliance with applicable environmental regulations and approved by the Field Engineer. All costs incurred in obtaining a disposal site and haul thereto shall be considered incidental to the project and no separate measurement or payment shall be made.
- Where removal of existing curbs and gutters, sidewalk or pavement is required, Contractor shall sawcut and/or remove to the nearest joint. Curb and gutter shown on these plans as existing and not to be removed under this contract, which is damaged or displaced by the Contractor shall be removed and replaced at the Contractor's expense.
- When abutting new pavement to existing, sawcut existing pavement to a straight edge and at a right angle, or as approved by the Project Engineer, to remove any broken or cracked pavement.
- All stationing shown on these plans is based on street centerline unless noted otherwise.
- The Contractor must submit a construction signing and barricading plan to Traffic Engineering a minimum of three (3) working days prior to construction to receive a barricading permit.
- Backfill compaction shall be according to specified street use.
- All trench backfill shall be compacted to a minimum 90% maximum density as per ASTM -D1557.
- Any existing utility service lines that do not require relocation and are damaged by the Contractor shall be removed and replaced at the Contractor's expense. This expense shall be considered incidental to the project and no separate payment shall be made.

26 19660185

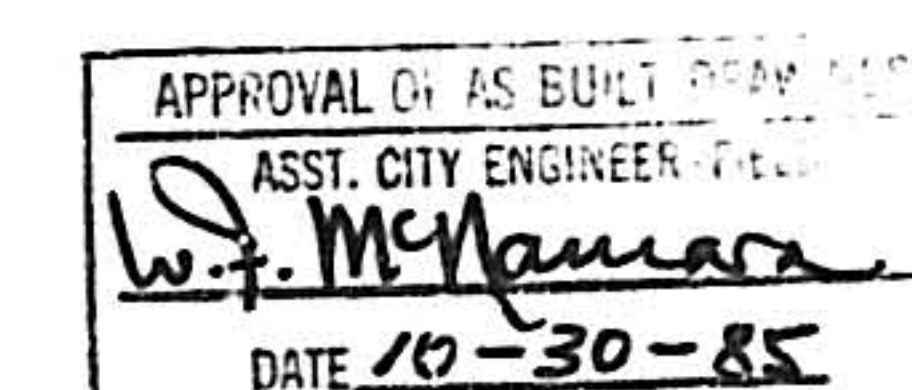


REV	SHEETS	CITY	ENGR.	DATE	USER	DEPT	DATE	USER	DEPT	DATE
23,6				1/10/85						
APPROVAL OF REVISIONS										

ENGINEERS SEAL 	ESPEY, HUSTON & ASSOC., INC. Engineering & Environmental Consultants 4801 INDIAN SCHOOL ROAD NE SUITE 204 ALBUQUERQUE, NEW MEXICO 87110 PHONE (505) 255-1625	APPROVED FOR CONSTRUCTION
PROJECT NUMBER 1966		SHEET 1 OF 6

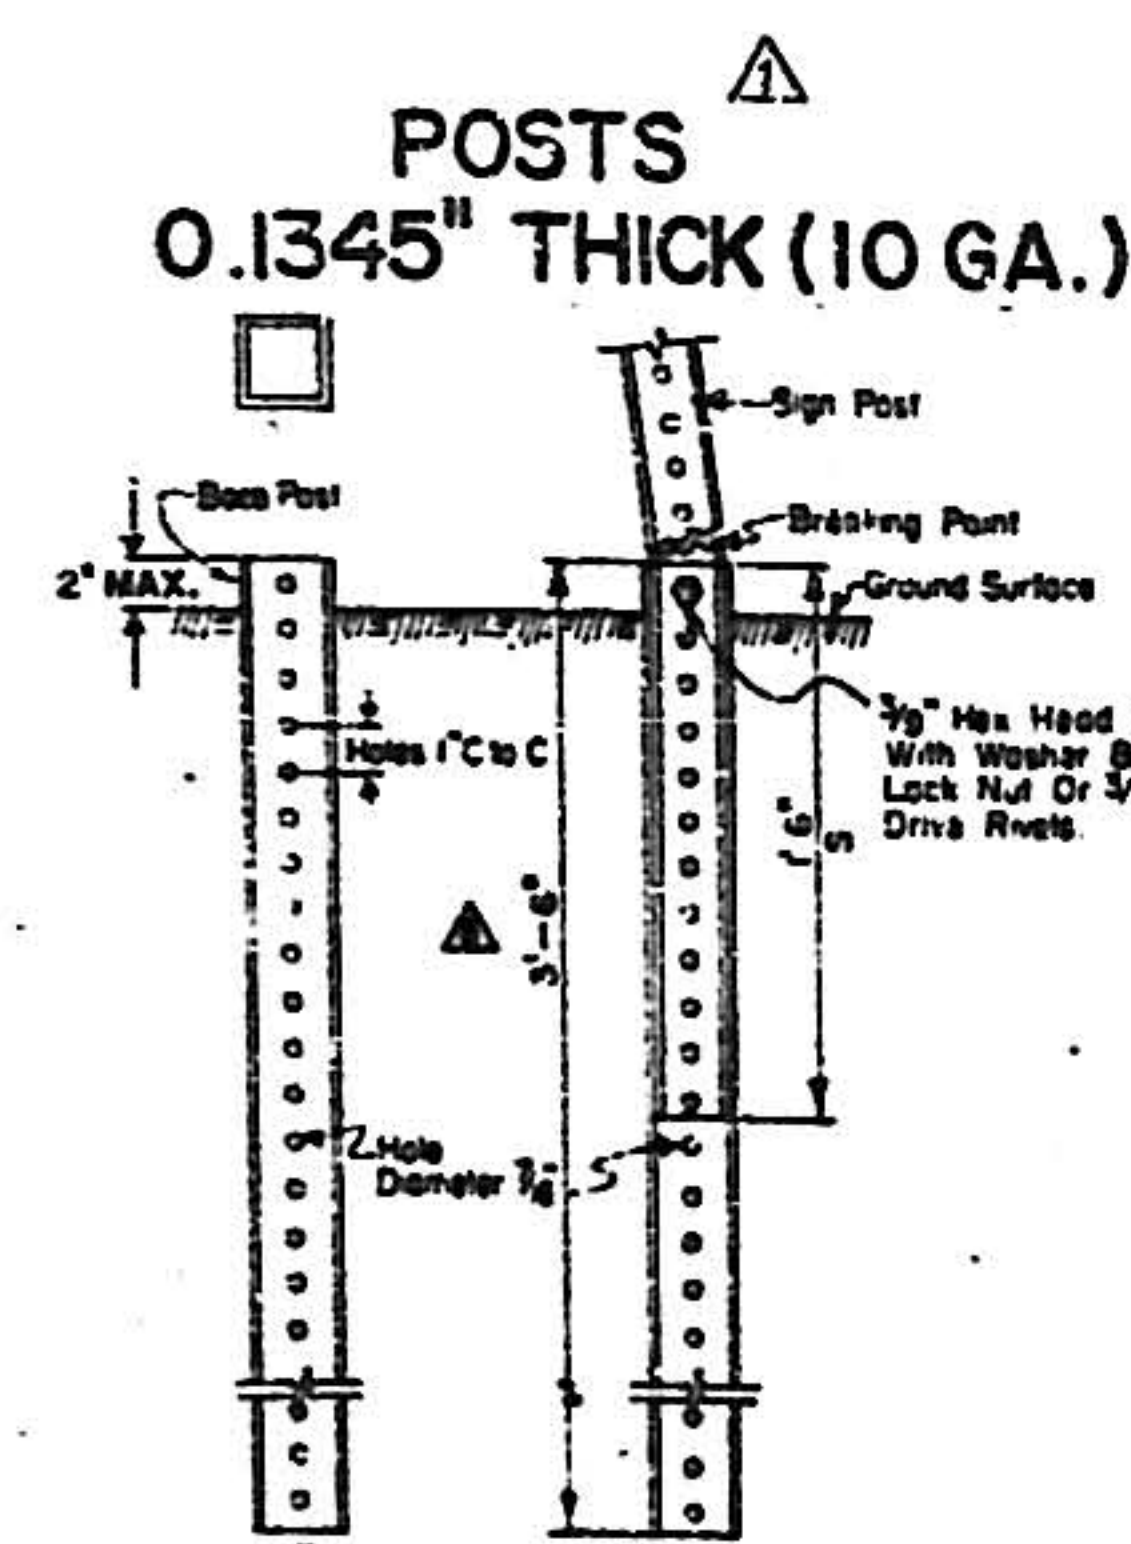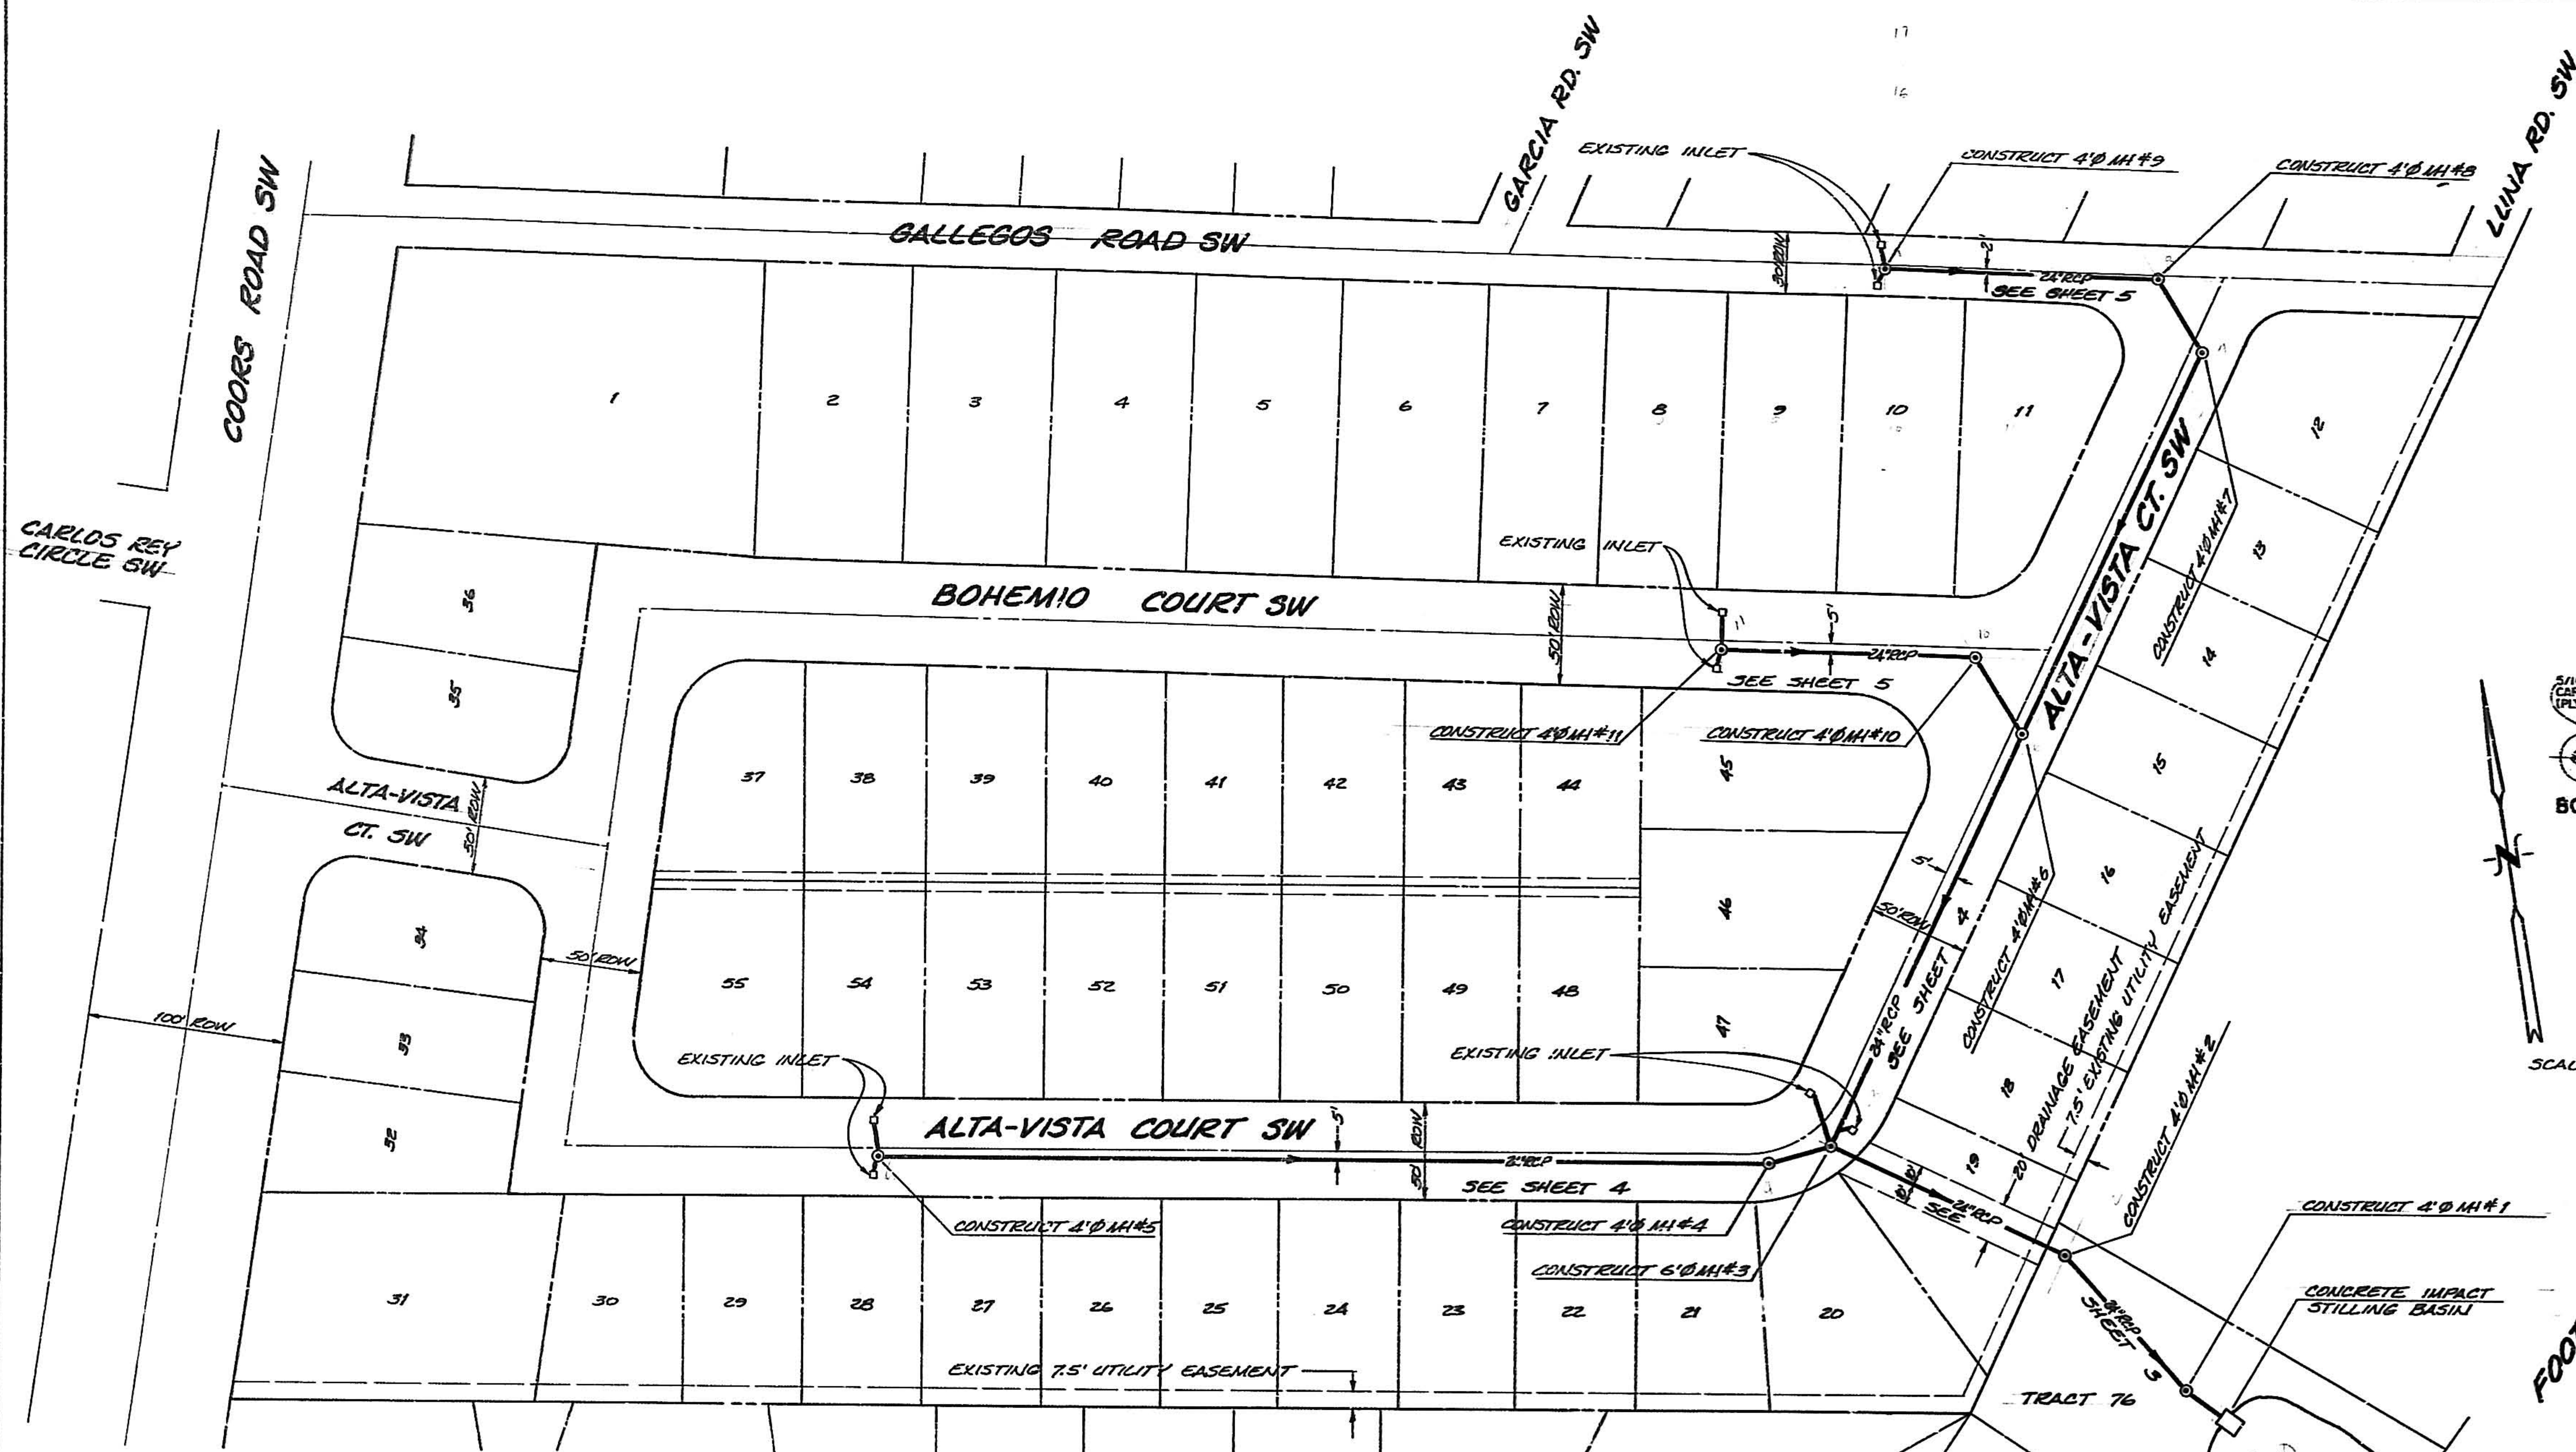

GROUND INSTALLATION

1. DRIVE BASE POST UNTIL ONE HOLE IS EXPOSED ABOVE GROUND FOR RIVET OR BOLT INSTALLATION.
2. INSERT SIGN POST (6" AND FASTEN WITH 2 EACH 3/8" ϕ DRIVE RIVET OR 1/4" BOLT.
3. THE HOLE PATTERN SHOWN IS ONLY REQUIRED IN THE AREA OF THE BREAKAWAY INFLUENCE AND AT THE SIGN PANEL LOCATION (LINES MAY BE FIELD DRILLED).
4. 3" X 5" X 4'-0" BASE POST OF 3/8" WALL THICKNESS TO BE USED WITH 2 1/2" X 2 1/2" O.1348 POST.

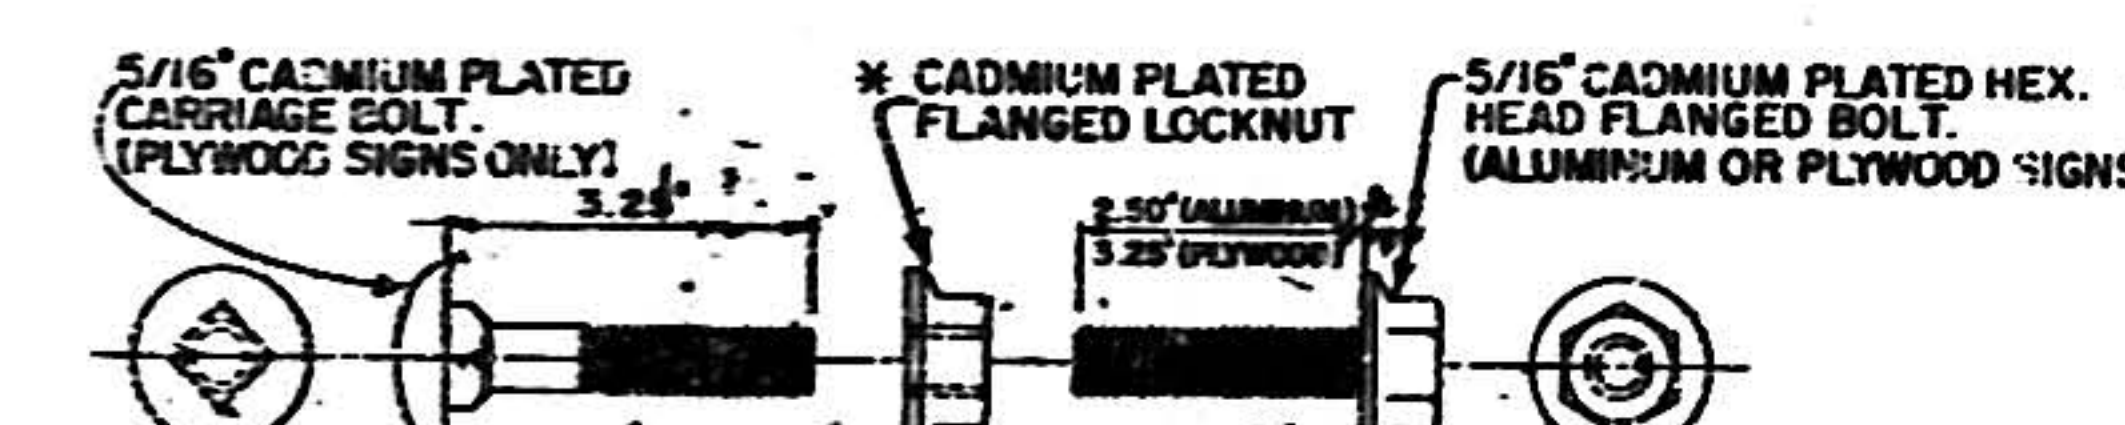


BOLTS AND LOCKNUT-SIGN ATTACHMENT[△]


* FLANGED LOCKNUT REQUIRED FOR CARRIAGE AND
HEX. HEAD FLANGE BOLT.

Bolts shall be 3/8" x 16 UNC x 2 1/2" long hex. integral flange conforming to ASTM A-354 grade B9. Nuts shall be 3/8" x 16 UNC hex head, integral flange conforming to ASTM A-562 grade DH. Lockwashers shall be 3/8" extra duty helical spring. Bolts, nuts and lockwashers shall mechanically galvanized to ASTM A-455, Class 25.

SCALE 1"=50


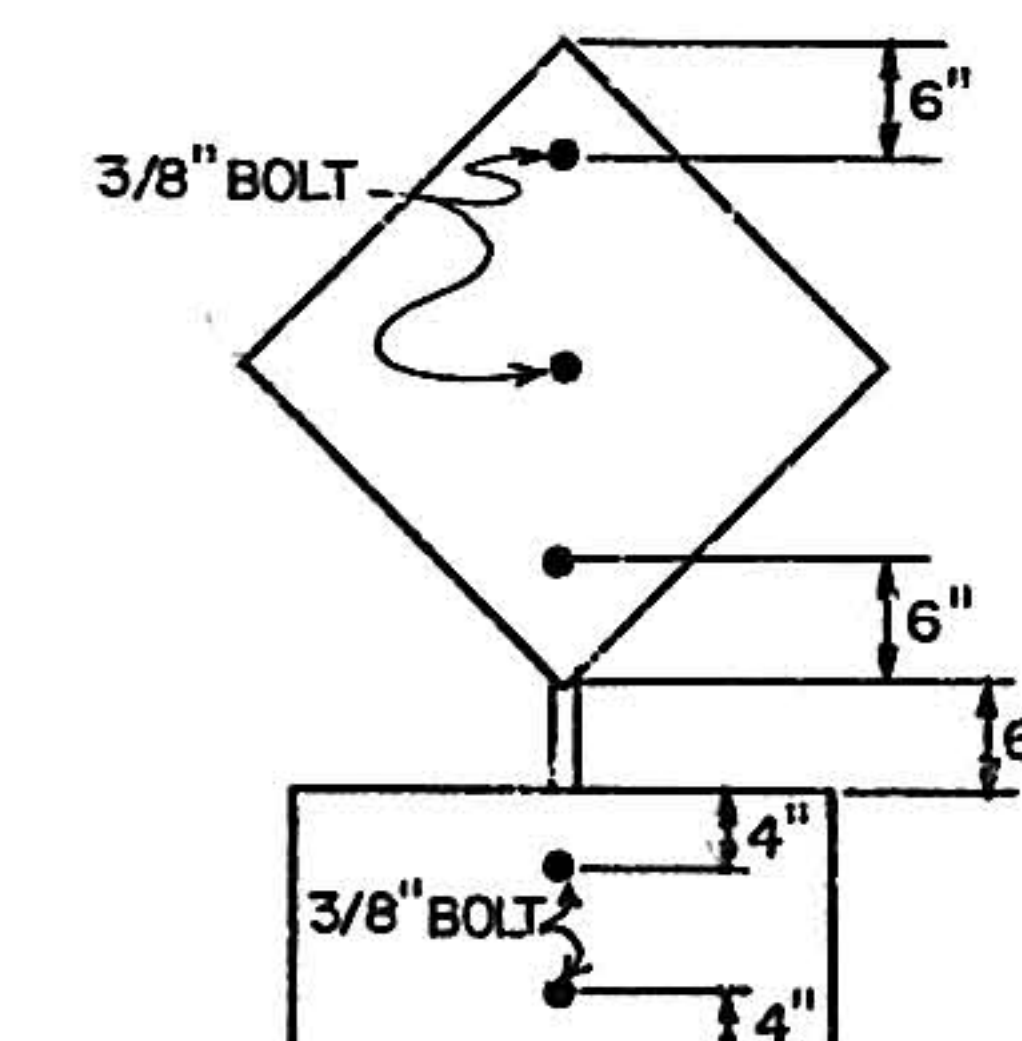


BOLT PATTERN & SIGN SPACING
NO SCALE

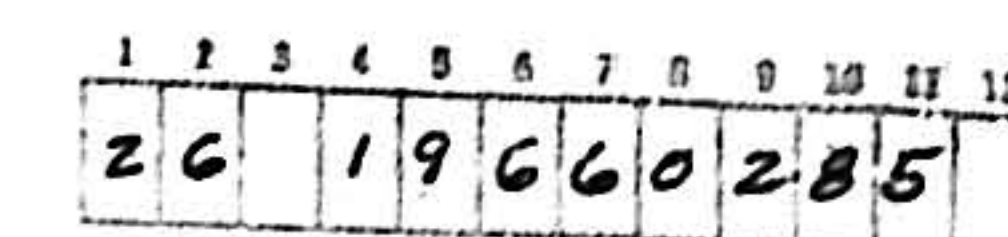

eh **ESPEY, HUSTON & ASSOC., INC.**
Engineering & Environmental Consultants
4801 INDIAN SCHOOL ROAD W.E. SUITE 204
ALBUQUERQUE, NEW MEXICO 87110
PHONE (505) 255-8225

LEGEND

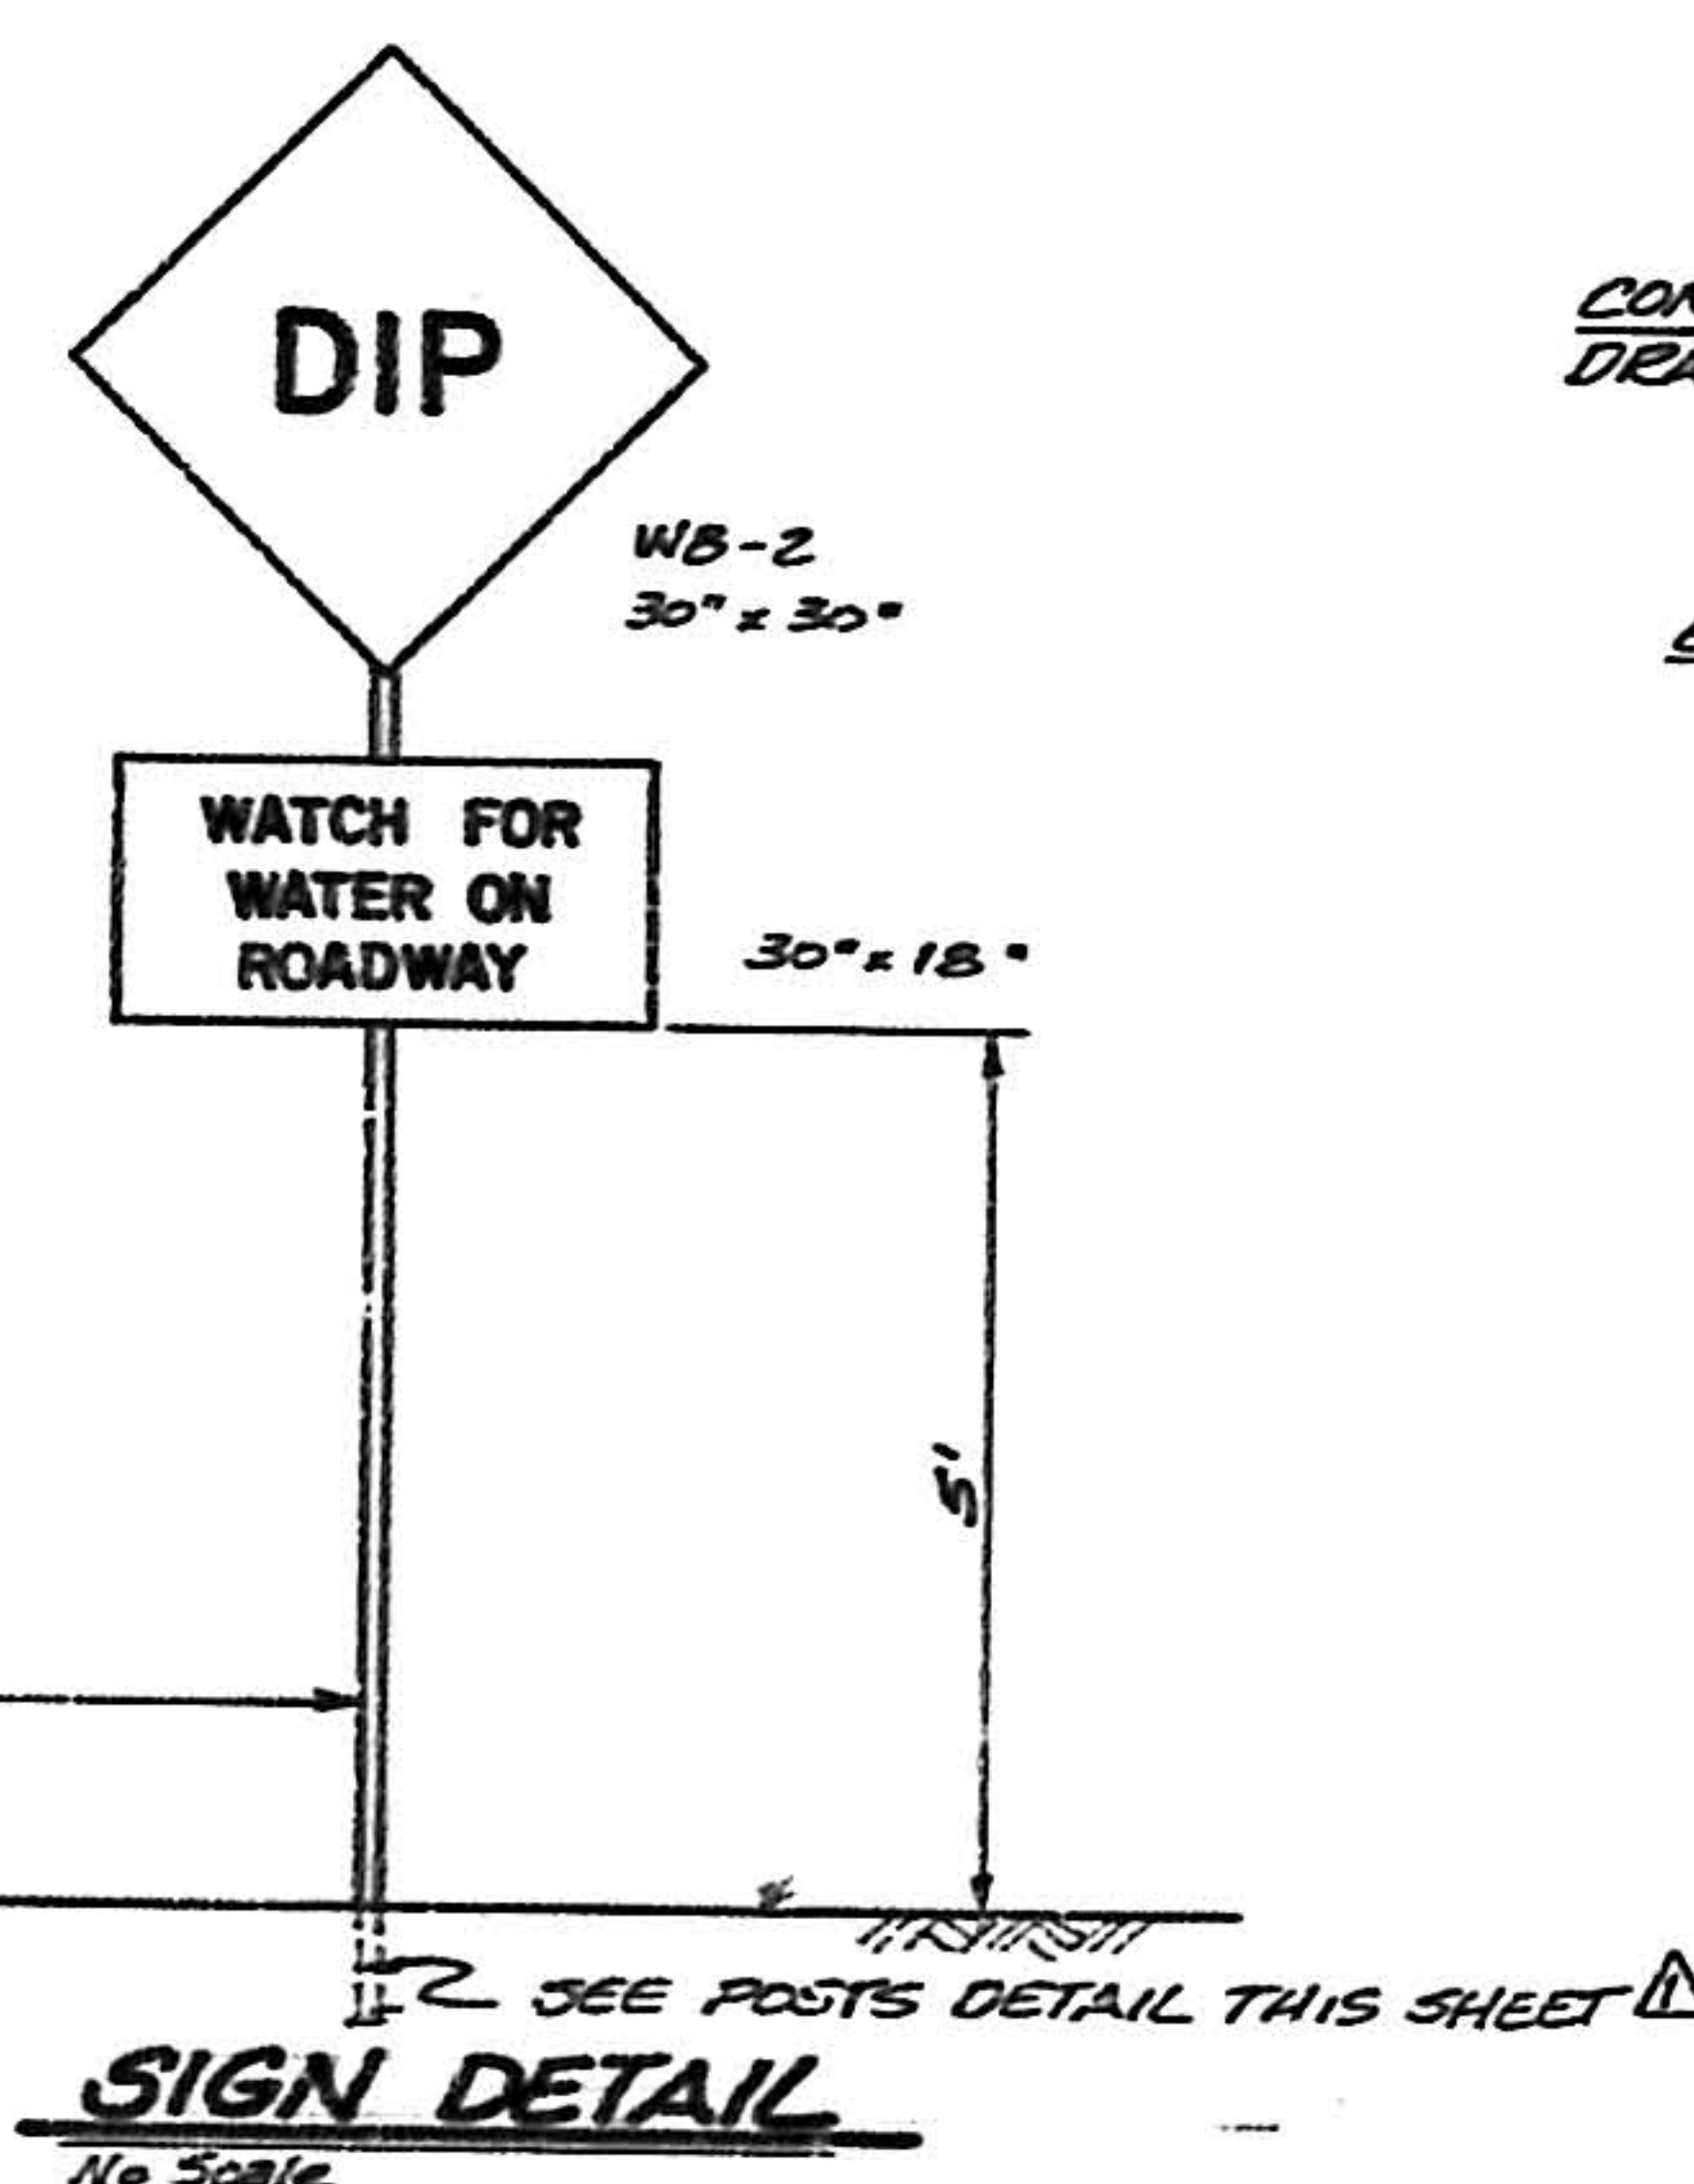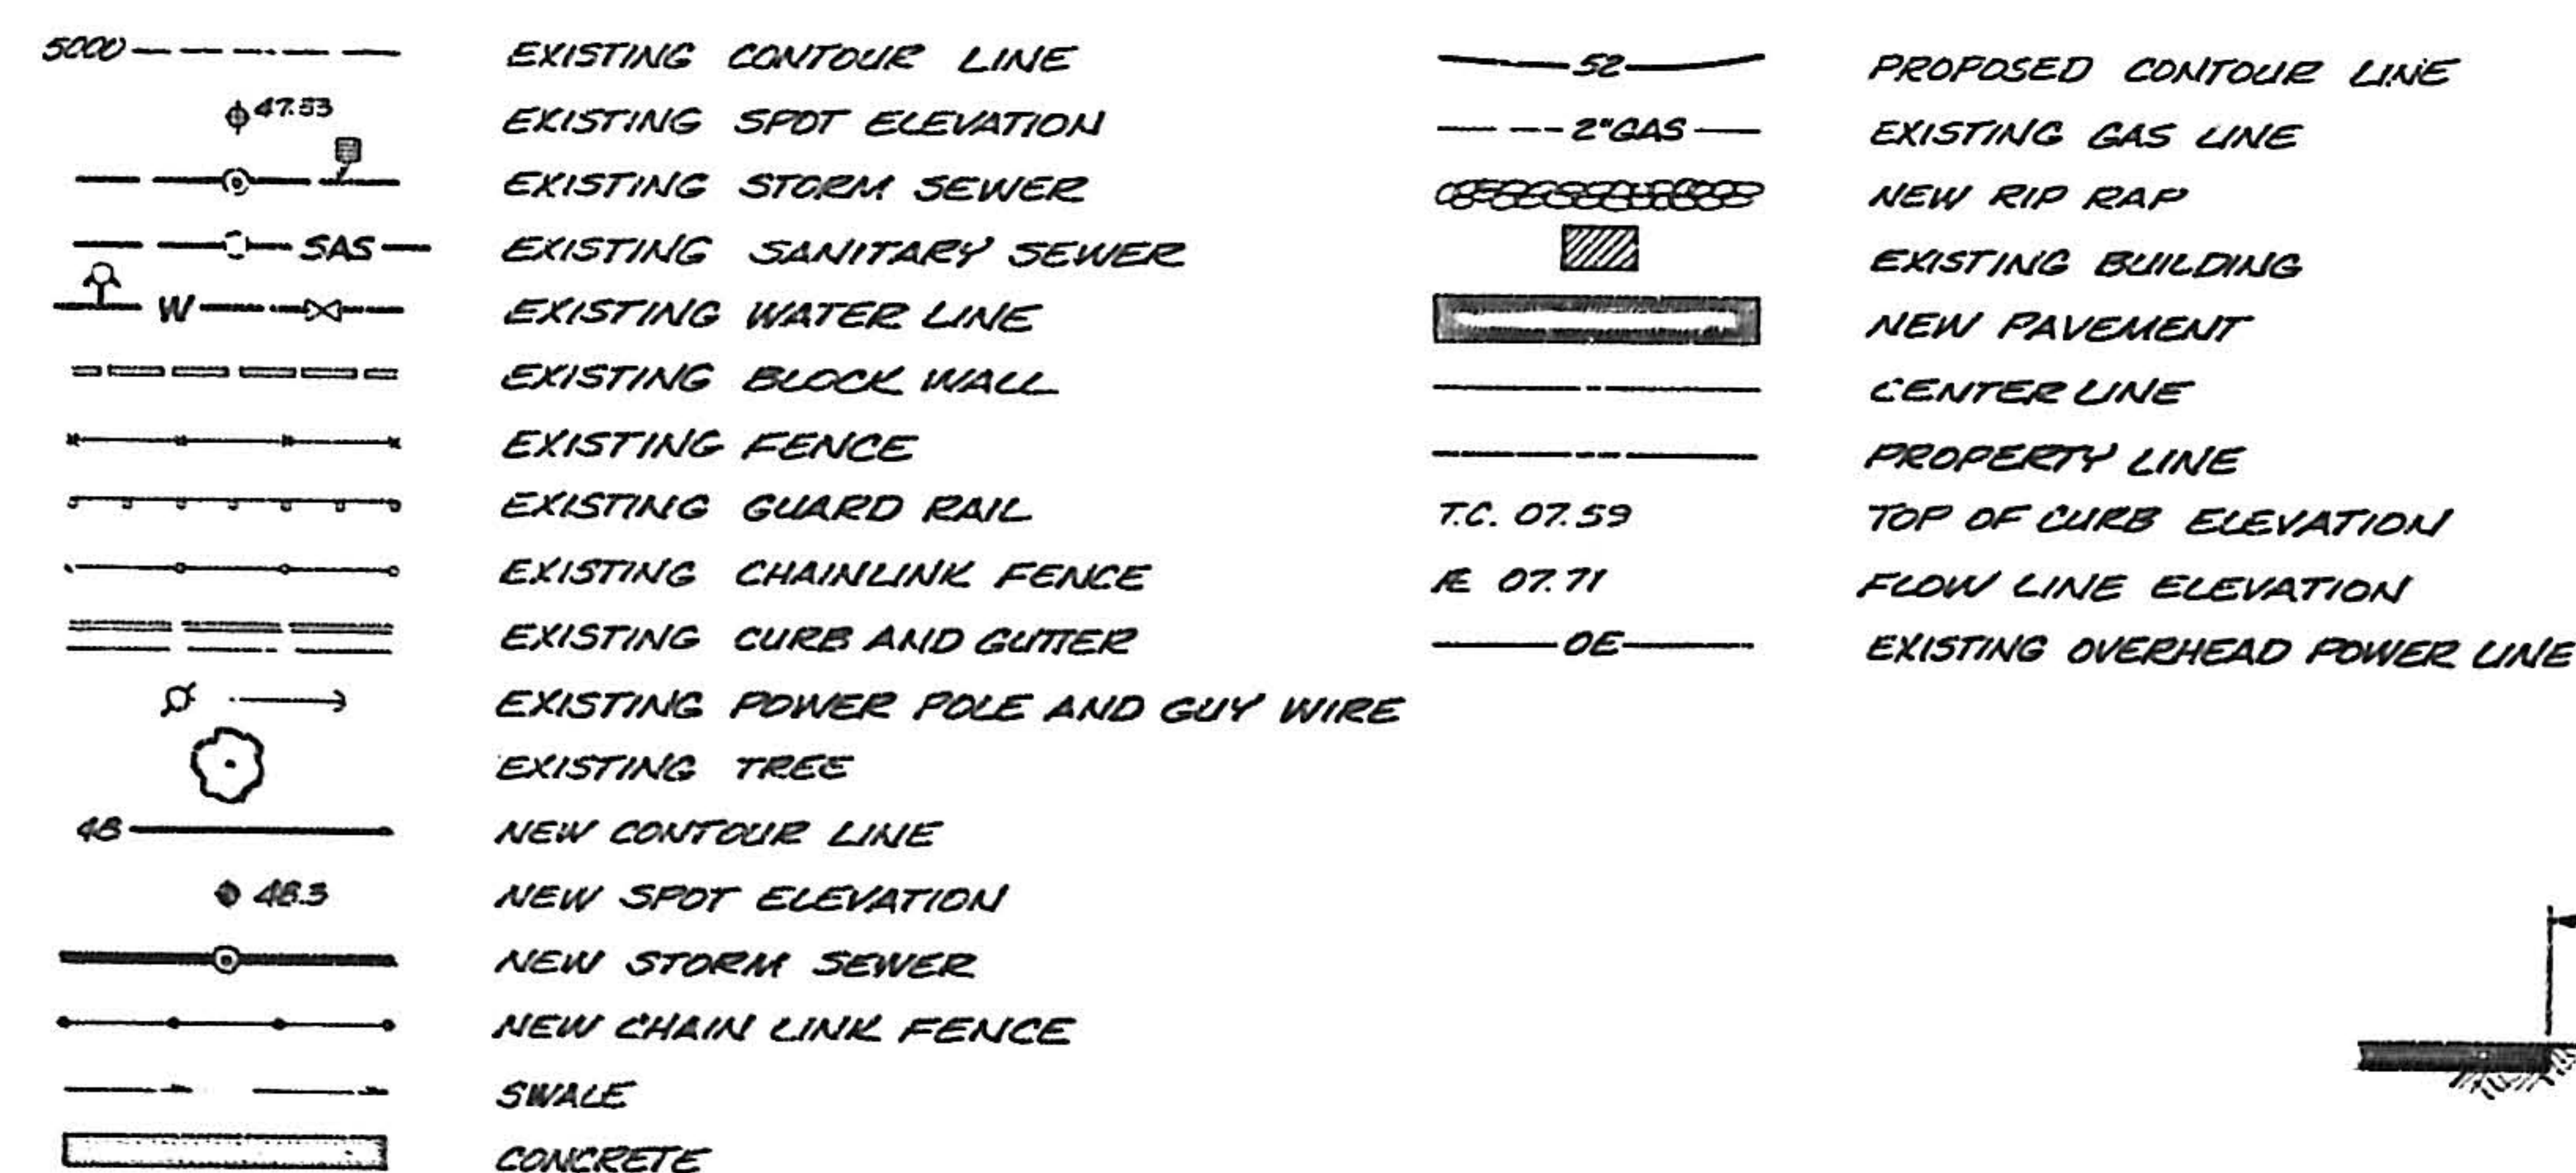[illegible]

CITY OF ALBUQUERQUE
MUNICIPAL DEVELOPMENT DEPARTMENT
ENGINEERING DIVISION

TITLE:
VISTA - ALTA ADDITION STORM DRAINAGE FACILITIES
OVERALL STORM DRAINAGE FACILITIES PLAN


APPROVALS	ENGINEER	DATE	APPROVALS	ENGINEER	DATE

DRAWING NO.	1966	MAP NO.	E-11	SHEET	2	OF	
-------------	------	---------	------	-------	---	----	--

SCALE HORIZ. 1" = 20'
VERT. 1" = 5'

K.N.C.
J. TOWNSON
E. HAZ



ACS BENCH MARK 2-111 LOCATED AT THE NW
QUADRANT OF THE INTERSECTION OF BRIDGE
AND FOOTHILL SW A 60-PENNY MAIL IN
POWER POLE
ELEVATION = 4966.175 FEET (MSLD)

 

E CURVE DATA

1	$\Delta = 26^\circ 02' 08''$ $R = 55.00'$ $L = 24.99'$
2	$\Delta = 40^\circ 26' 52''$ $R = 55.00'$ $L = 38.83'$
3	$\Delta = 66^\circ 29' 00''$ $R = 55.00'$ $L = 63.82'$

- NOTE
- 1) SOME SAS SERVICES MAY BE IN CONFLICT. SEE GENERAL NOTES SHEET 1, NOTE 3.
 - 2) ALL PAVEMENT CUTS FOR STORM SEWER CONSTRUCTION SHALL BE AS PER CITY OF ALBUQUERQUE STD DMB P-25.3.
 - 3) ALL PAVEMENT REPLACEMENT SHALL BE RESIDENTIAL AS PER CITY OF ALBUQUERQUE STD DMB P-1-1 & P-7-2.

  

ASSUMED OR AS-BUILT
LOCATED SAS SERVICE

FIELD VERIFIED SAS
SERVICE

26 19660485

ESPEY, HUSTON & ASSOC., INC.
Engineering & Environmental Consultants
4801 BRIAN SCHOOL ROAD NE SUITE 204
ALBUQUERQUE, NEW MEXICO 87110
PHONE (505) 255-1625


VISTA-ALTA ADDITION STORM DRAINAGE FACILITIES
ALTA VISTA COURT

12/15/84
12/15/84
12/15/84
12/15/84

MRGCD

5010
5005
5000

5010
5005
5000

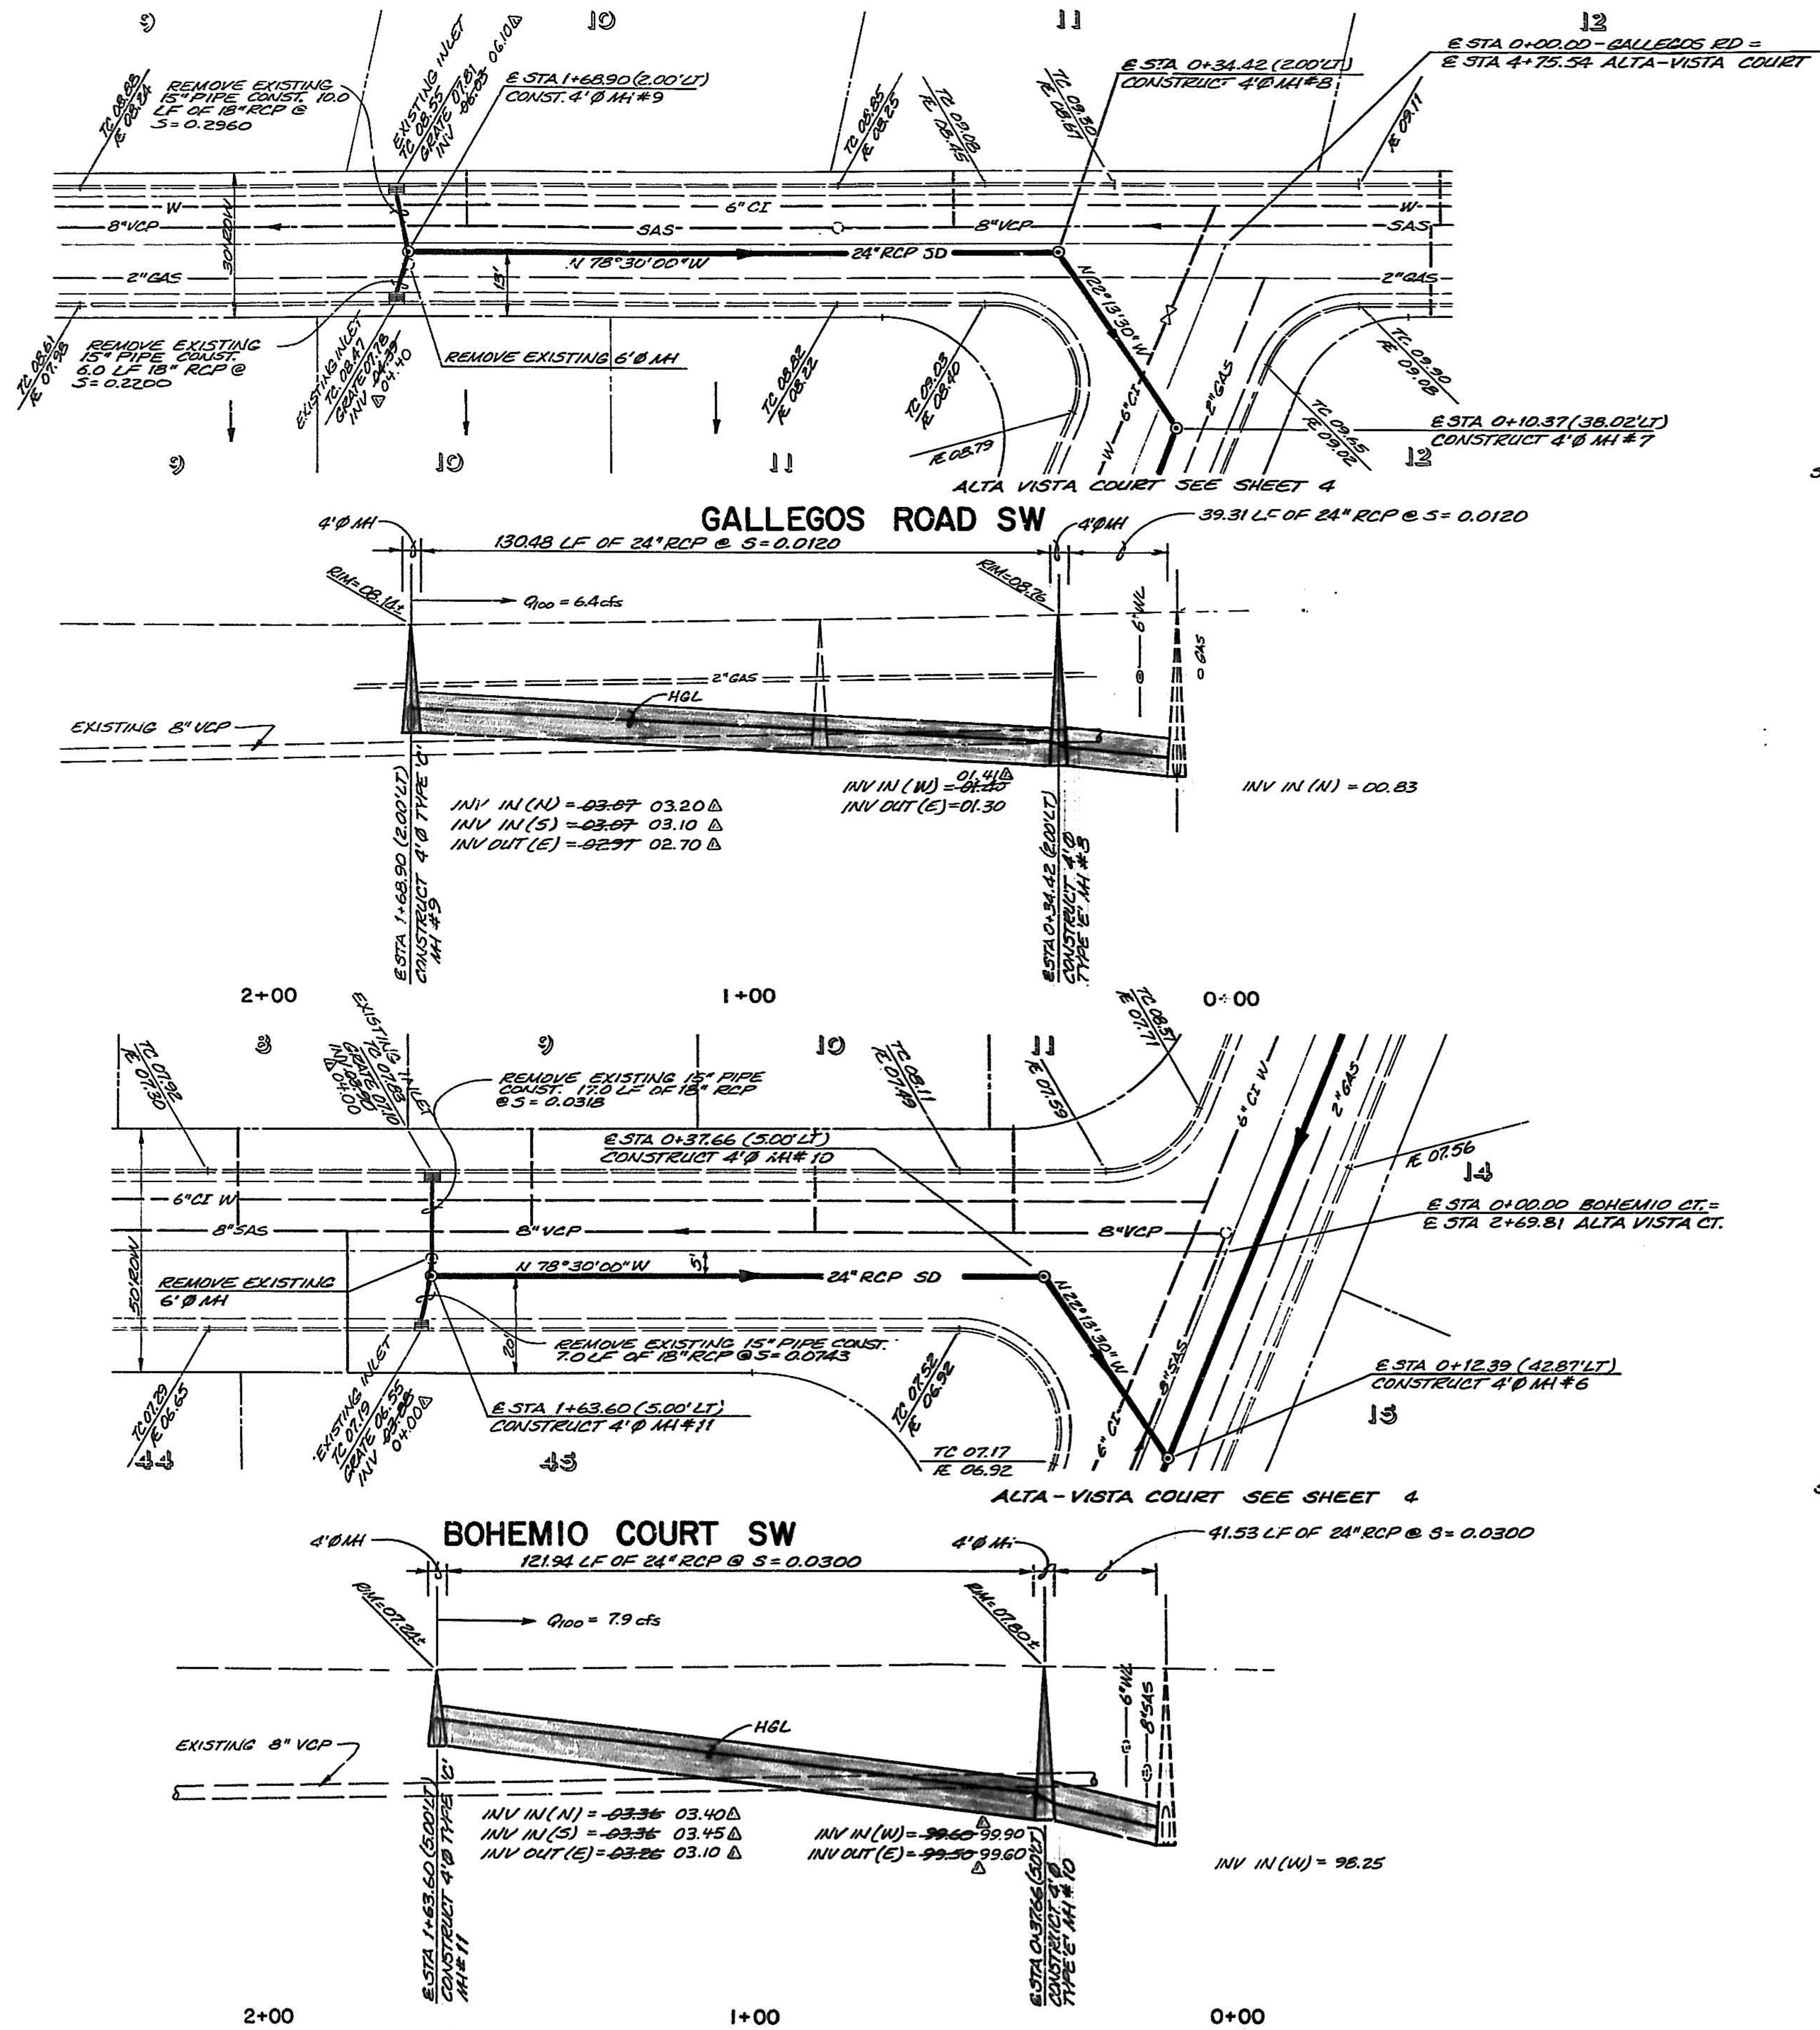

NOTE
1) SOME SAS SERVICES MAY BE IN CONFLICT. SEE GENERAL NOTES SHEET 1, NOTE 3.
2) ALL PAVEMENT CUTS FOR STORM SEWER CONSTRUCTION SHALL BE AS PER CITY OF ALBUQUERQUE STD DWG P-25-3.
3) ALL PAVEMENT REPLACEMENT SHALL BE RESIDENTIAL AS PER CITY OF ALBUQUERQUE STD. DWGS P-1-1 AND P-7-2.

--- ASSUMED OR AS-BUILT LOCATED SAS SERVICE
--- FIELD VERIFIED SAS SERVICE

SCALE HORIZ. 1"=20'
VERT. 1"=5'

SCALE HORIZ. 1"=20'
VERT. 1"=5'

ACS BENCH MARK 8-L11 LOCATED AT THE NW QUADRANT OF THE INTERSECTION OF BRIDGE AND FOOTHILL DR SW, A 60-PENNY NAIL IN POWER POLE
ELEVATION = 4956.135 FEET (MSLD)



DESIGNED BY DAL DATE SEPT/1984
DRAWN BY TJO DATE SEPT/1984
CHECKED BY DAL DATE SEPT/1984

VISTA-ALTA ADDITION STORM DRAINAGE FACILITIES
GALLEGOS ROAD - BOHEMIO COURT

County Road Dept. 1966 L-11 5 6




NOTE: ALL REINFORCING STEEL SHALL BE PLACED 2" CLEAR FROM FACE OF CONCRETE

[illegible]

COVER PER
R. DWG 5-3-2

NEW DISCHARGE
PIPE 10" DIP

12" MAX

INV = 44.3

1/2" POLYETHYLENE
JOINT FILLER*

1/2" URETHANE
SEALANT

W.S. EL. = 43.3

SEE DETAIL 'A'

SECTION C-C

WELD 10" -
16° BEND
TO 10" DIP

10" DIP

NEW DISCHARGE PIPE

EXISTING CANAL SIDEWALL

SAWCUT EXISTING CHANNEL
SEE EXPANSION JOINT
DETAIL 'A'

OUTFALL DETAIL

[illegible]

EMERGENCY SPILLWAY DETAIL

SECTION H-H FOOT HILL DR. (SEE SHEET 3)

EMERGENCY SPILLWAY OUTFALL DETAIL

ASPHALT RUINDOWN

3'-0"

#4 REBAR @ 12" O.C. E.W.

SEE DETAIL A

SECTION G-G

POND BOTTOM AND SIDE SHALL
CONSIST OF 12" THICK ROCK

D₅₀ = 6"

6" THICK GRANULAR
BEDDING MATERIAL

POND LINING

[illegible]

26 19660685

ESPEY, HUSTON & ASSOC., INC.
Engineering & Environmental Consultants
4801 INDIAN SCHOOL ROAD NE SUITE 204
ALBUQUERQUE, NEW MEXICO 87110
PHONE (505) 255-1625

CITY OF ALBUQUERQUE
MUNICIPAL DEVELOPMENT DEPARTMENT
ENGINEERING DIVISION

TITLE: VISTA-ALTA ADDITION STORM DRAINAGE FACILITIES
DETAILS

APPROVALS	ENGINEER	DATE	APPROVALS	ENGINEER	DATE
City Engineer	<i>[Signature]</i>	12/22/64	Liquid Waste	<i>R. Pate</i>	12/6/64
A.C.E. - Design	<i>[Signature]</i>	12/16/64	Traffic	<i>D.B. Dutt</i>	12/3/64
A.C.E. - Hydrology	<i>[Signature]</i>	12/15/64	Water	<i>R. Pate</i>	12/5/64
County Road Dept.	<i>[Signature]</i>	12/14/64	M/RGCD	<i>A. Schell</i>	10/16/64
DRAWING NO. 1966	MAP NO. L-11		SHEET 6 OF 6		