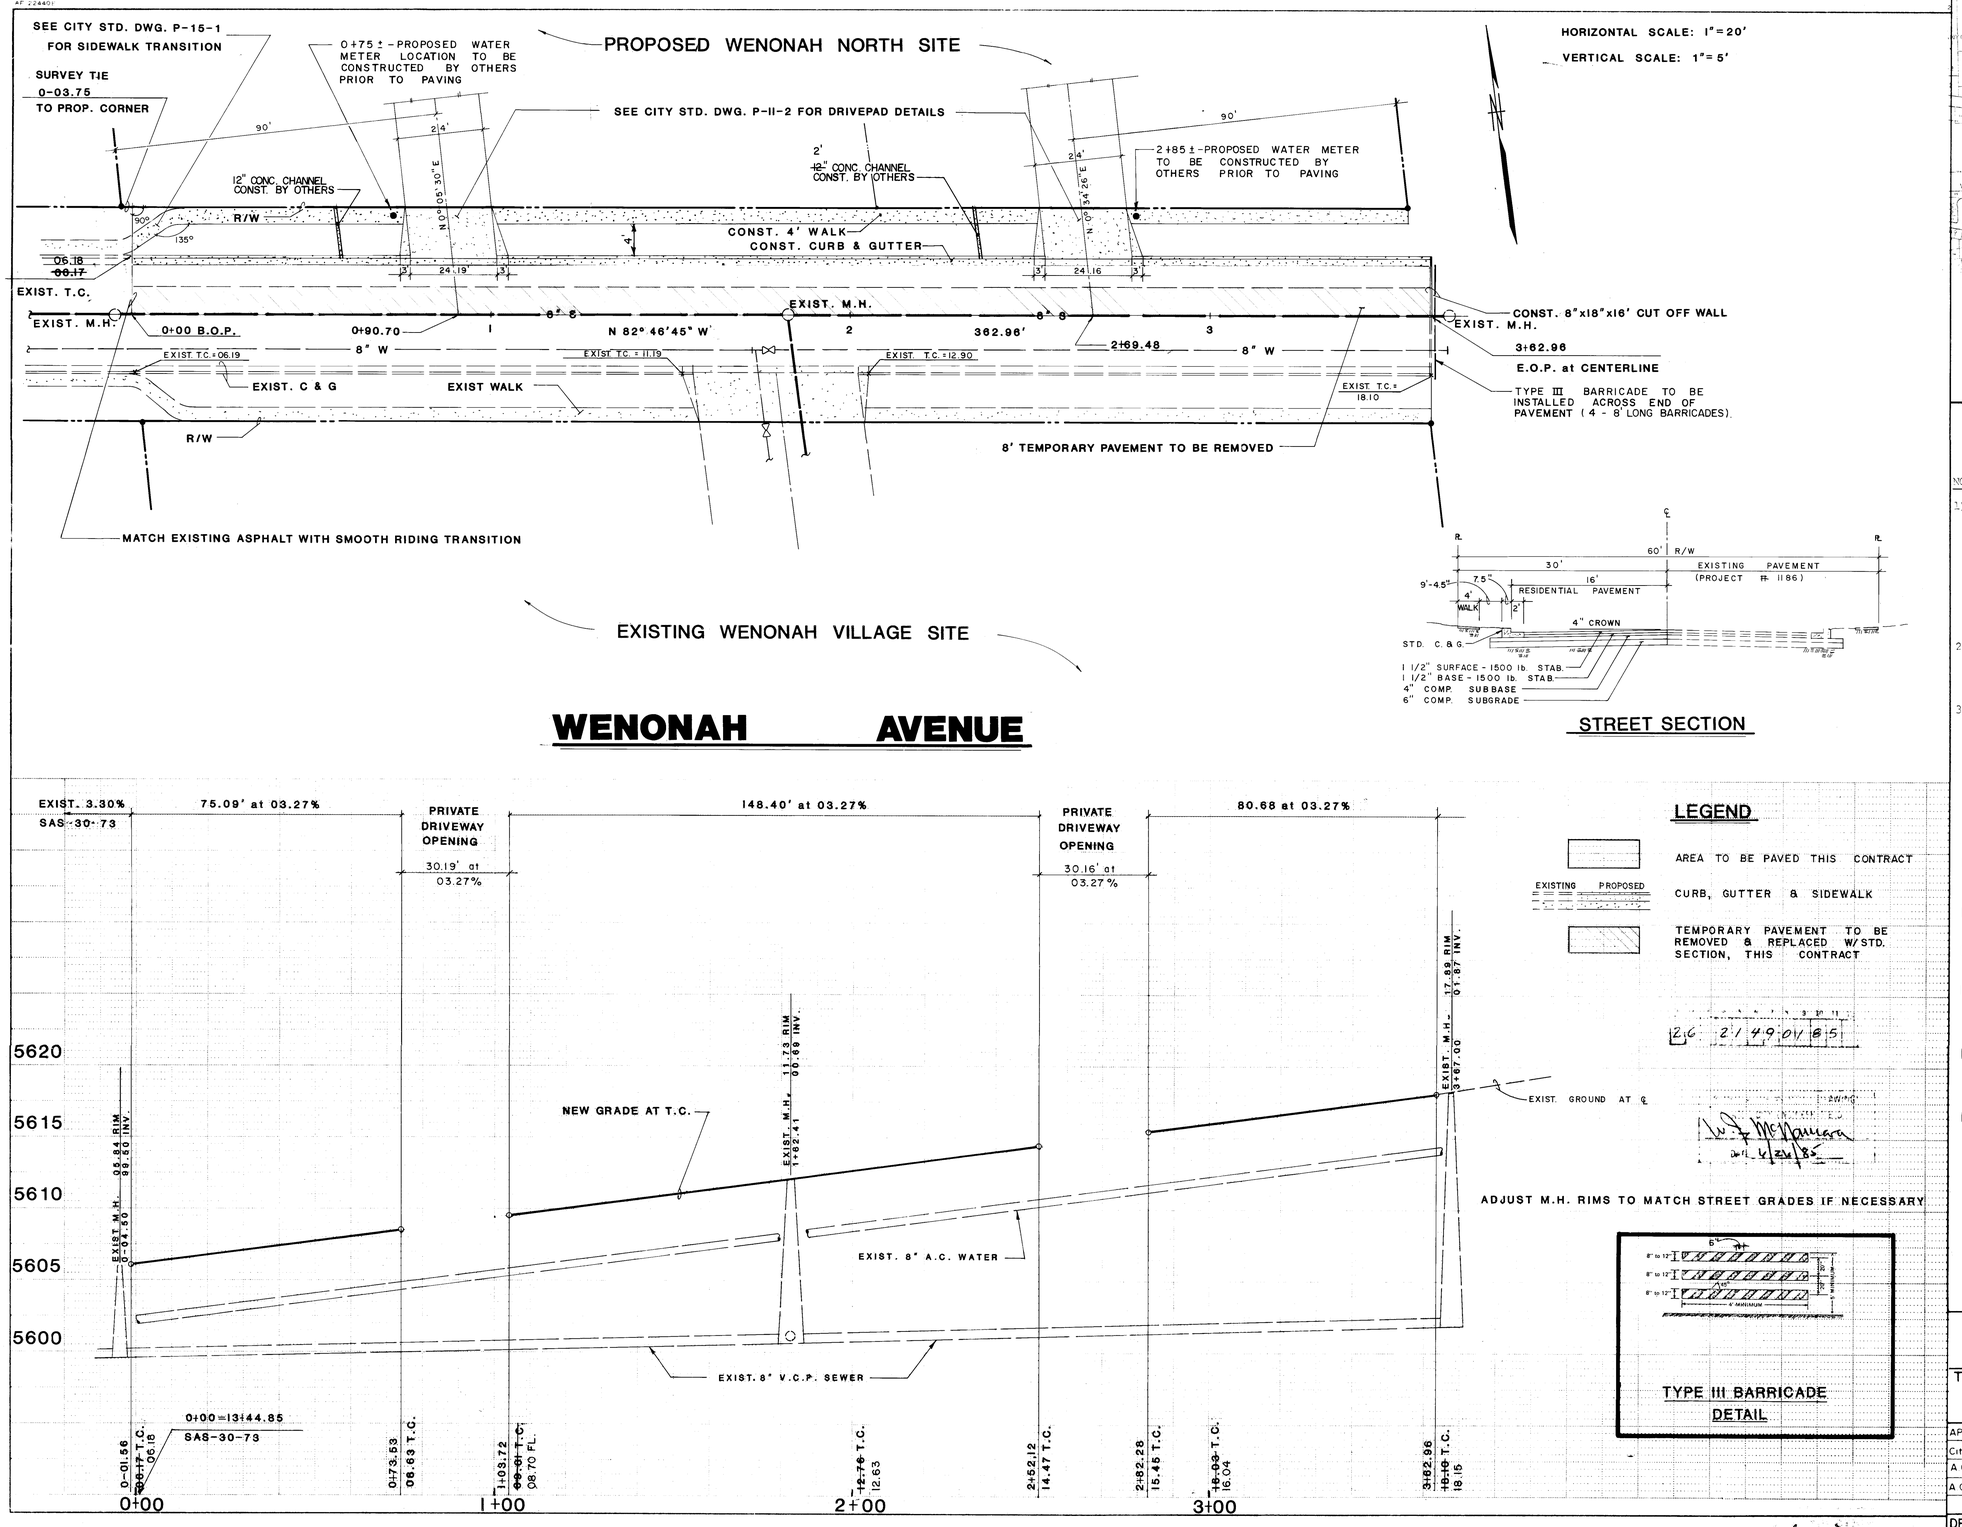

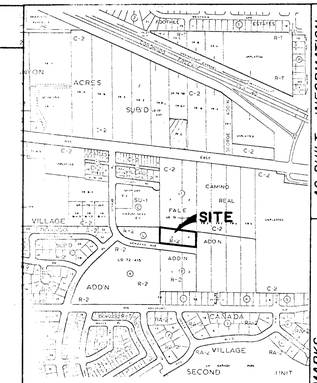

VICINITY MAP

NOTICE TO CONTRACTORS

1) All work detailed on these plans to be performed under contract shall, except as otherwise stated or provided for hereon, be constructed in accordance with the New Mexico Standard Specifications for Public Works Construction - 1979 Edition (referred to herein as the Standard Specifications) and the Contract Documents for Public Works Contract 84-1.

2) Two (2) working days prior to any excavation, contractor must contact Line Locating Service, 765-1234, for location of existing utilities.

3) Prior to construction, the contractor shall excavate and verify the horizontal and vertical locations of all obstructions. Should a conflict exist, the contractor shall notify the engineer or surveyor so that the conflict can be resolved with minimum amount of delay.

THE FOLLOWING NOTES APPLY WHEN CHECKED:

- ☐ All utilities and utility service lines shall be installed prior to paving.
- ☐ Backfill compaction shall be according to specified street use.
- ☒ Tack coat requirements shall be determined by the City Engineer.
- ☐ Sidewalks and wheelchair ramps within the curb returns shall be constructed wherever a new curb return is constructed.
- ☒ If curb is depressed for a drivepad or a handicap ramp, the drivepad or ramp shall be constructed prior to acceptance of the curb and gutter.
- ☐ All storm drainage facilities shall be completed prior to final acceptance.

NOTE: South half of Wenonah Street has been paved (Project # 1186). For existing centerline elevations, refer to Project #1186 Drawings and/or Street Section as shown on this page.

AS BUILT INFORMATION — INSPECTOR'S A.BK. 7-24-85 — ASBUILT DATE 8-26-85 BY T. TAFOYA — DATE — FIELD VERIFICATION BY I.E.L. — DATE 8-27-85 — CORRECTED BY — DATE — MICRO-FILM INFORMATION — RECORDED BY — DATE — NO.

BENCH MARKS — B.C. 2-L22 AT CENTRAL & TRAMWAY — ELEVATION = 5659.96

SURVEY INFORMATION — FIELD NOTES — NO. — BY — DATE

ENGINEER'S SEAL — FOR C.T.S. ENGINEERING, INC.

NO.	DATE	REMARKS	BY
△	6-27-85	AS-BUILT	I.E.L.

REVISIONS

DESIGN — DESIGNED BY — DATE — DRAWN BY — DATE — CHECKED BY — DATE

CITY OF ALBUQUERQUE
MUNICIPAL DEVELOPMENT DEPARTMENT
ENGINEERING DIVISION

TITLE: **STREET PLAN & PROFILE**
WENONAH AVENUE

APPROVALS	ENGINEER	DATE	APPROVALS	ENGINEER	DATE
City Engineer	C. D. Alvarez		Liquid Waste	R. Peña	6/27/84
A.C.E. - Design	M. E. Chavez	7/26/84	Traffic	Jack de Hermosa	6/27/84
A.C.E. - Hydrology	Billy J. Rodeby	6/27/84	Water	R. Peña	6/27/84

DRAWING NO. **2149** — MAP NO. L 22 — SHEET 1 OF 1

C. D. Alvarez 9/5/84

AS